
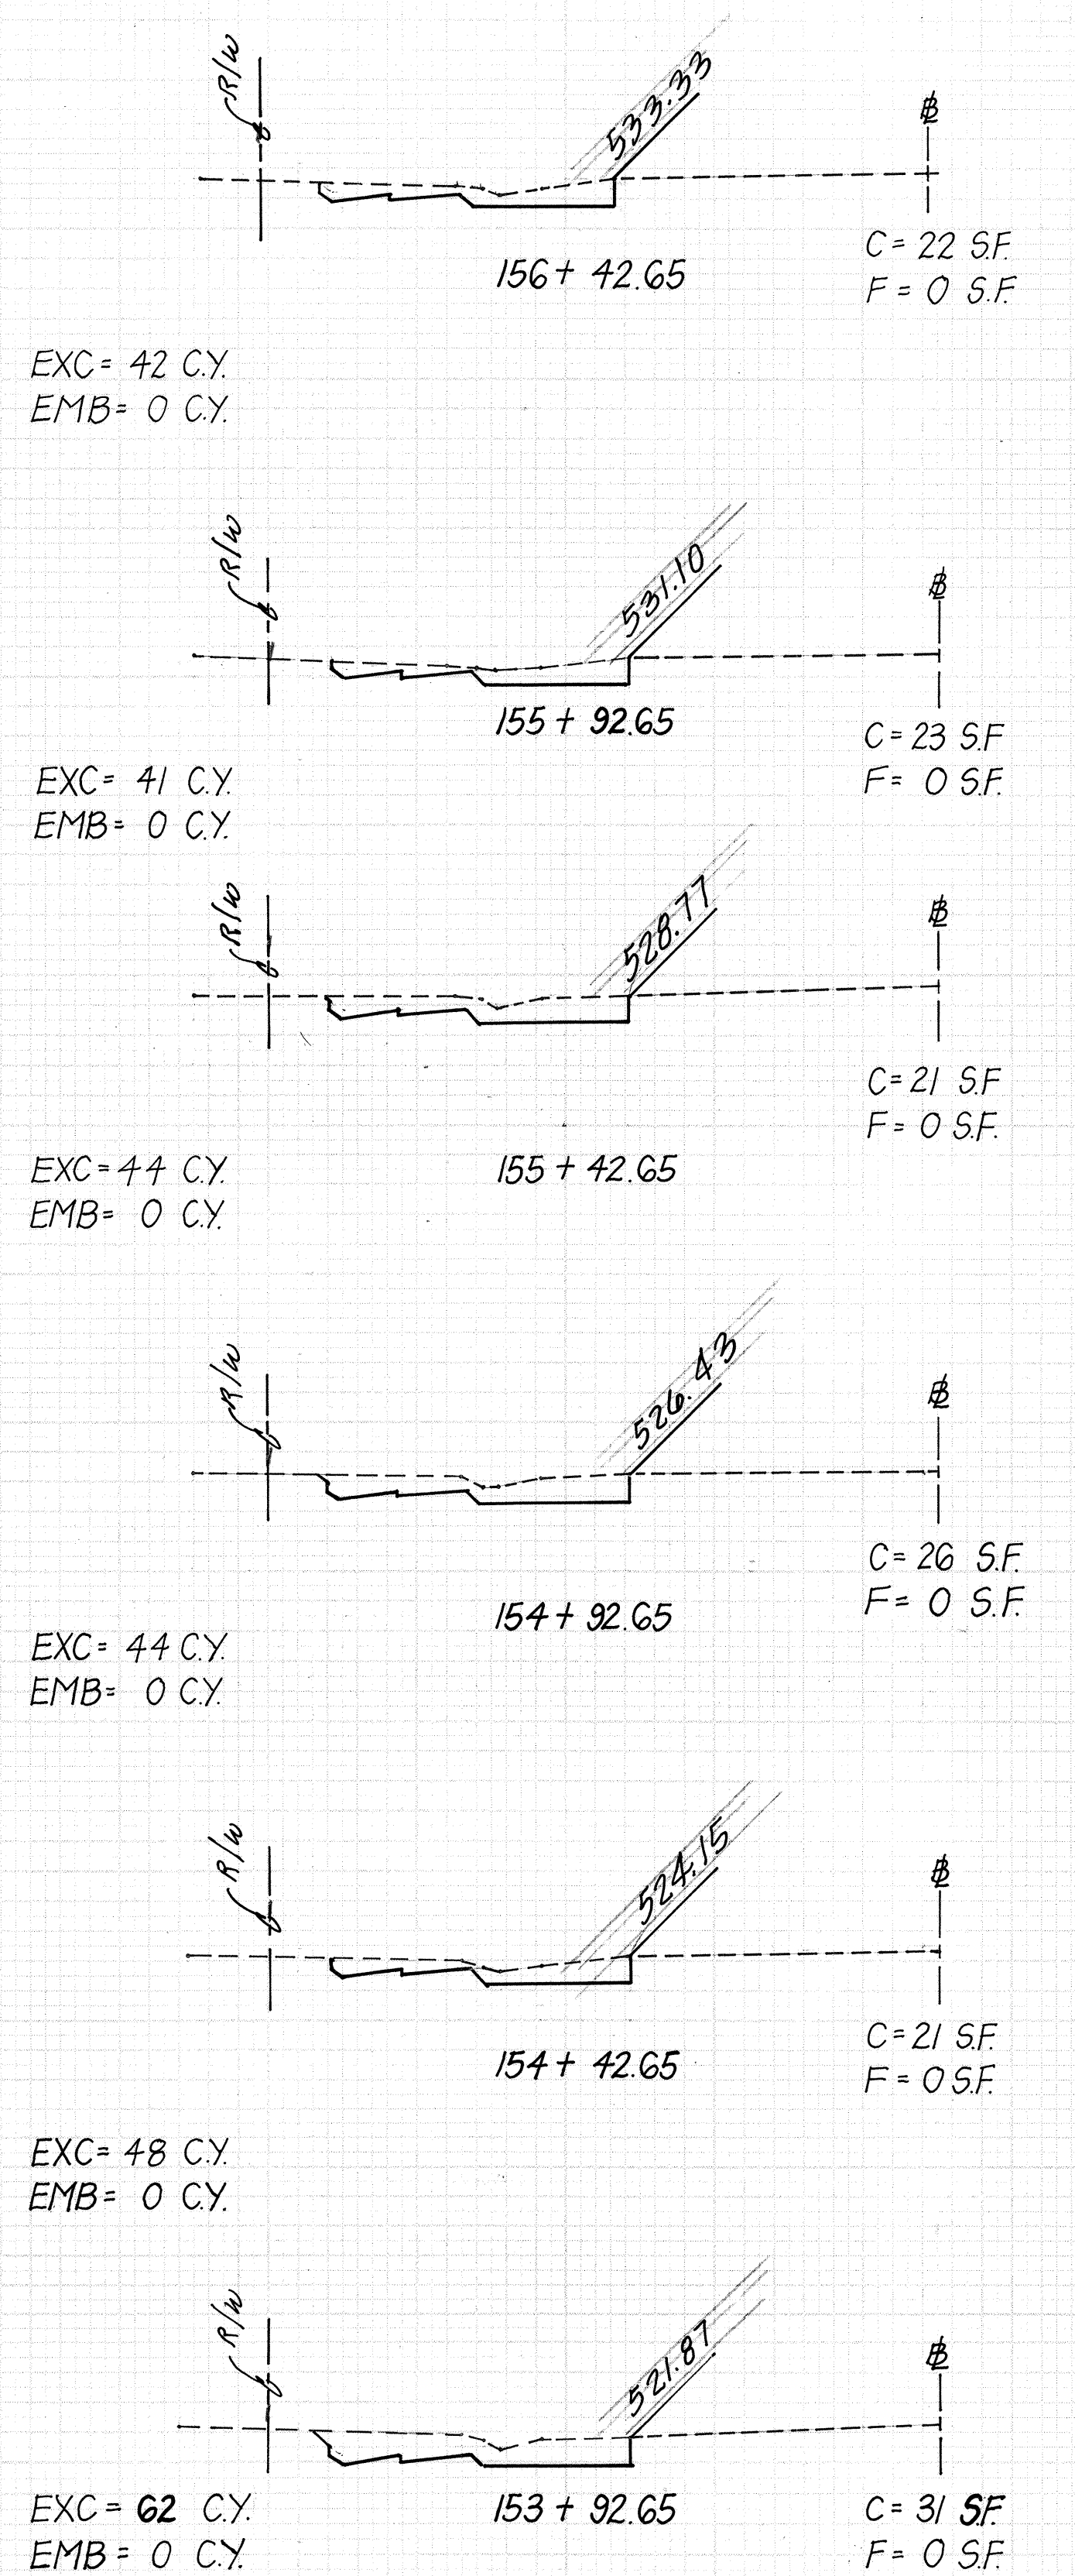
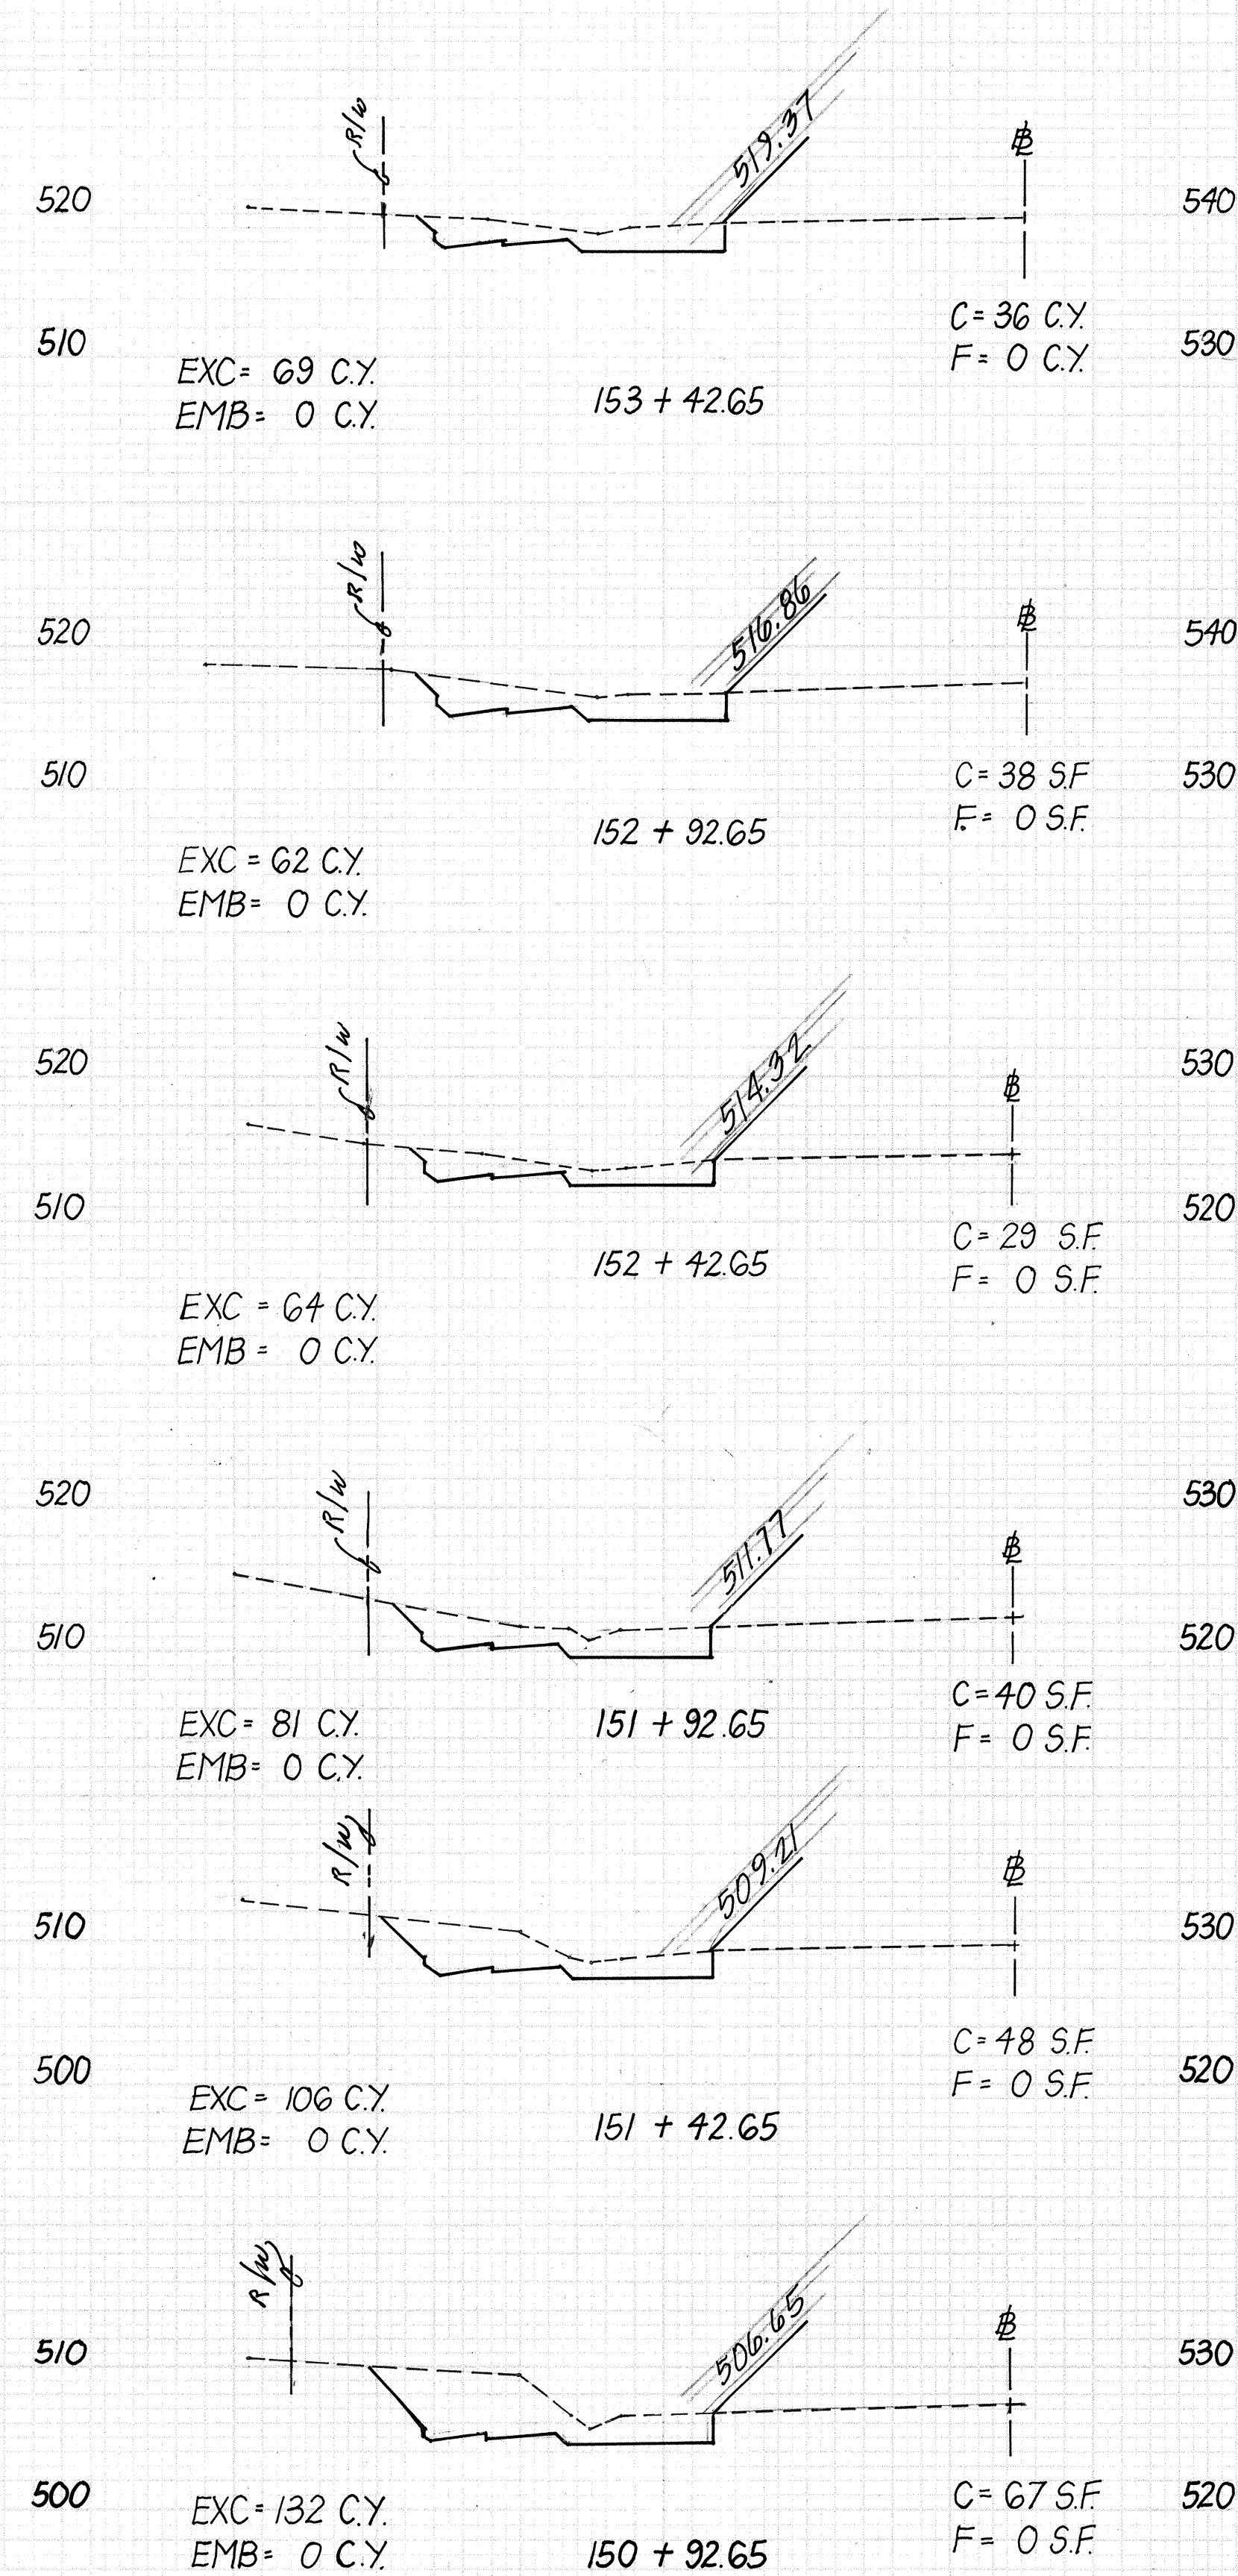
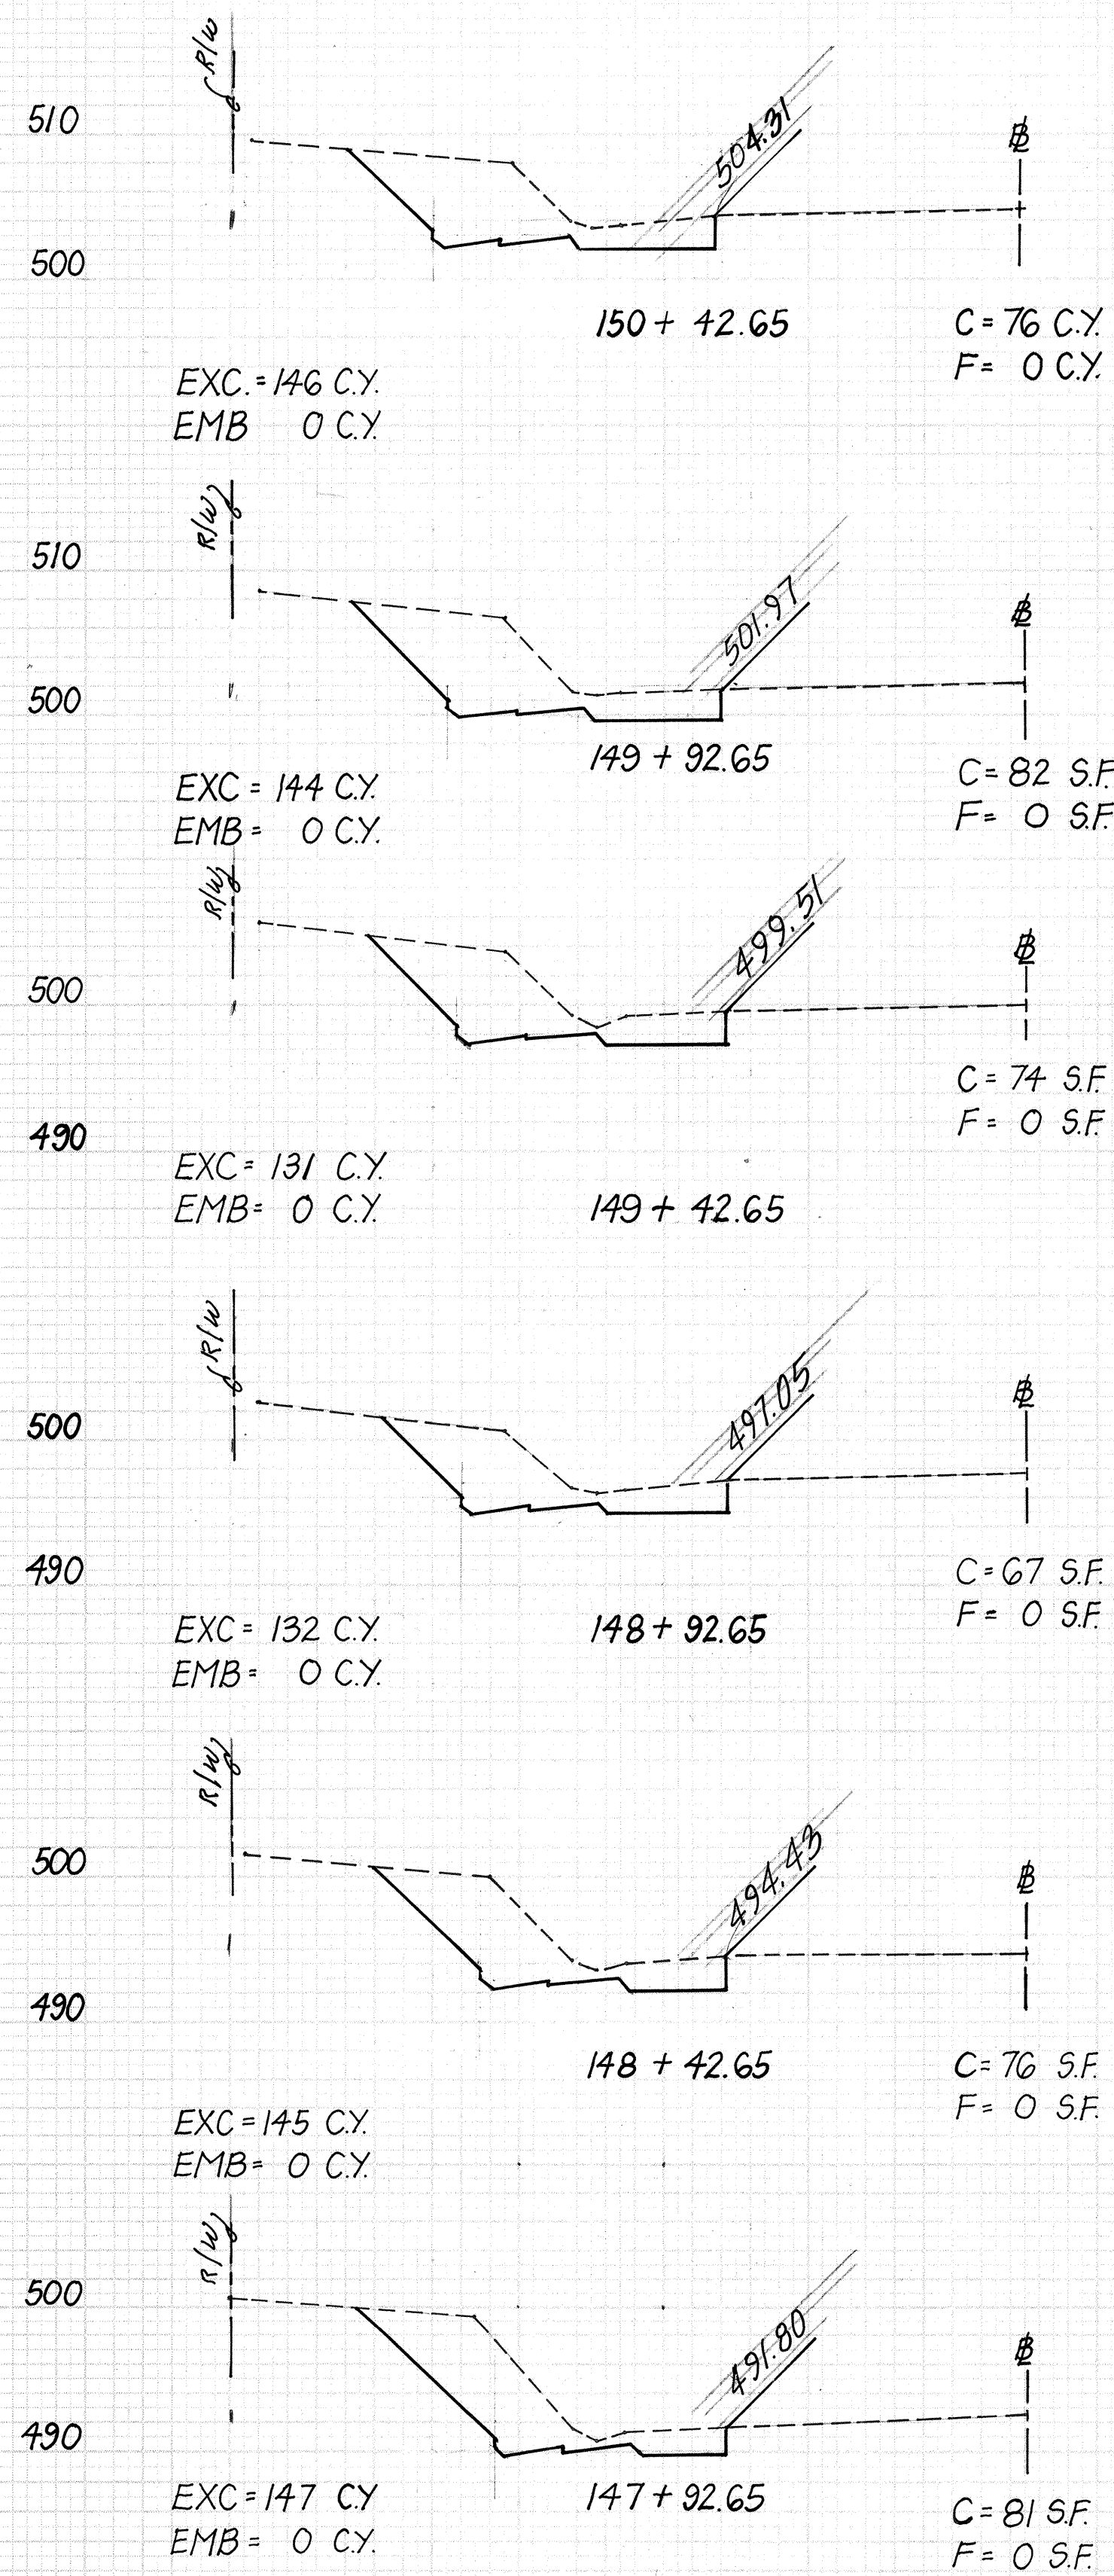


| FED. ROAD DIST. NO. | STATE | PROJ. NO.  | FISCAL YEAR | SHEET NO. | TOTAL SHEETS |
|---------------------|-------|------------|-------------|-----------|--------------|
| HAWAII              | HAW.  | 50D-01-90M | 1990        | 9         | 10           |

| DATE                 | BY |
|----------------------|----|
|                      |    |
| FINAL SURVEY PLOTTED |    |
| NOTE BOOK NO.        |    |
| AREAS CHECKED        |    |

| DATE                    | BY |
|-------------------------|----|
|                         |    |
| ORIGINAL SURVEY PLOTTED |    |
| NOTE BOOK NO.           |    |
| AREAS CHECKED           |    |


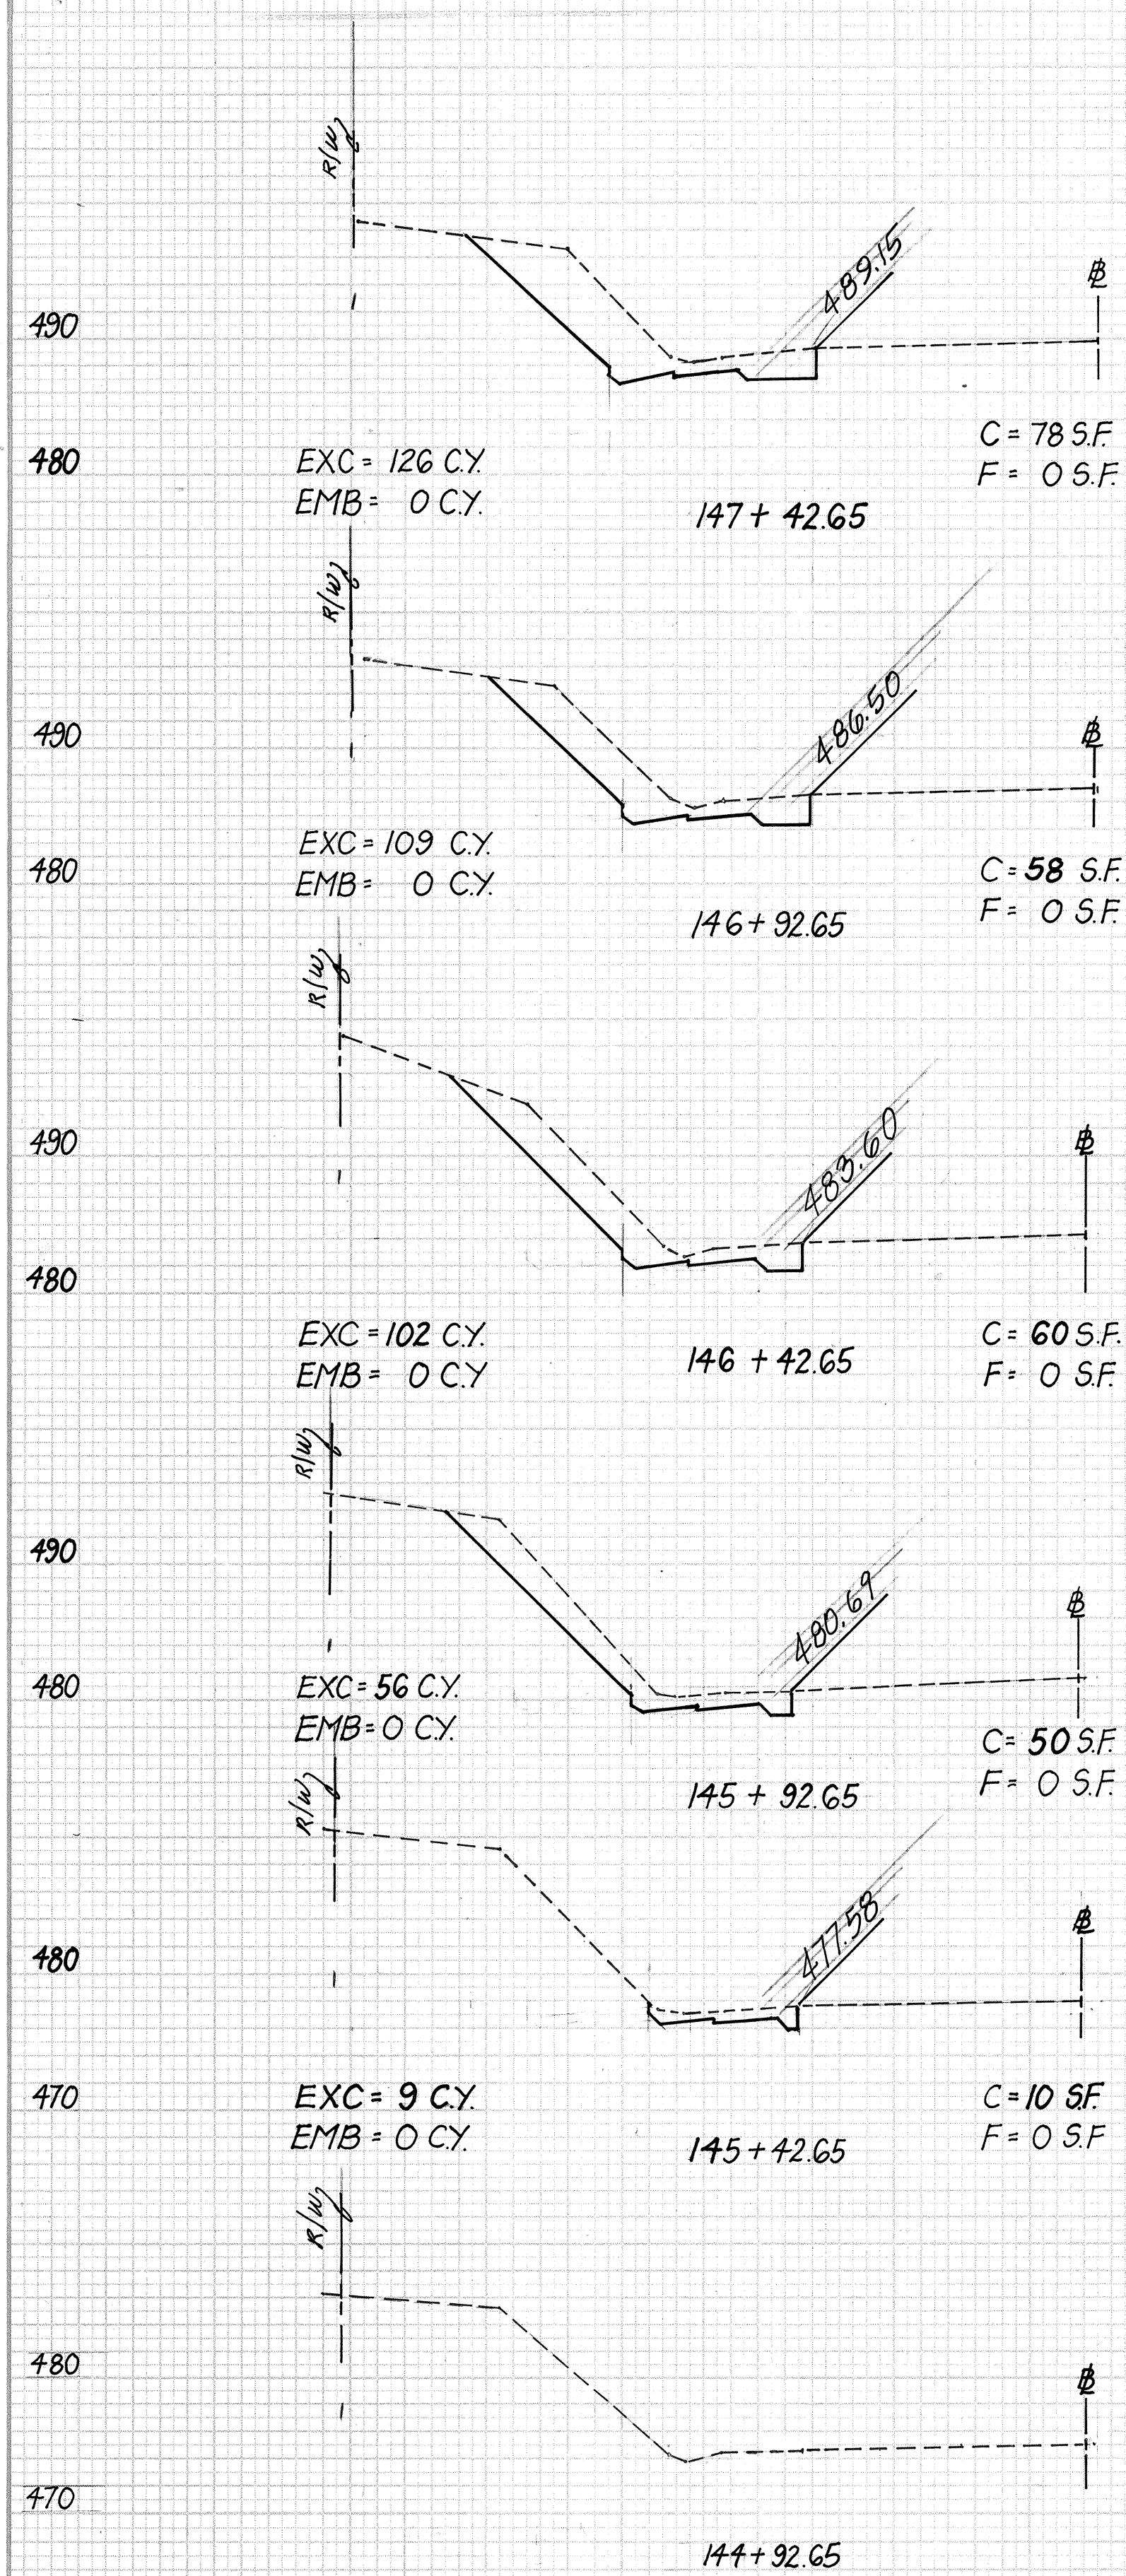


| FED. ROAD DIST. NO. | STATE | PROJ. NO.  | FISCAL YEAR | SHEET NO. | TOTAL SHEETS |
|---------------------|-------|------------|-------------|-----------|--------------|
| HAWAII              | HAW.  | 50D-01-90M | 1990        | 10        | 10           |

TOTAL EXCAVATION QUANTITIES:  
 Roadway Reconstruction = 2496 C.Y.  
 Field Road Reconstruction = 126 C.Y.

|           |  |
|-----------|--|
| DATE      |  |
| BY        |  |
| REVIEWED  |  |
| PLOTTED   |  |
| NOTE BOOK |  |
| NO        |  |

|           |  |
|-----------|--|
| DATE      |  |
| BY        |  |
| REVIEWED  |  |
| PLOTTED   |  |
| NOTE BOOK |  |
| NO        |  |

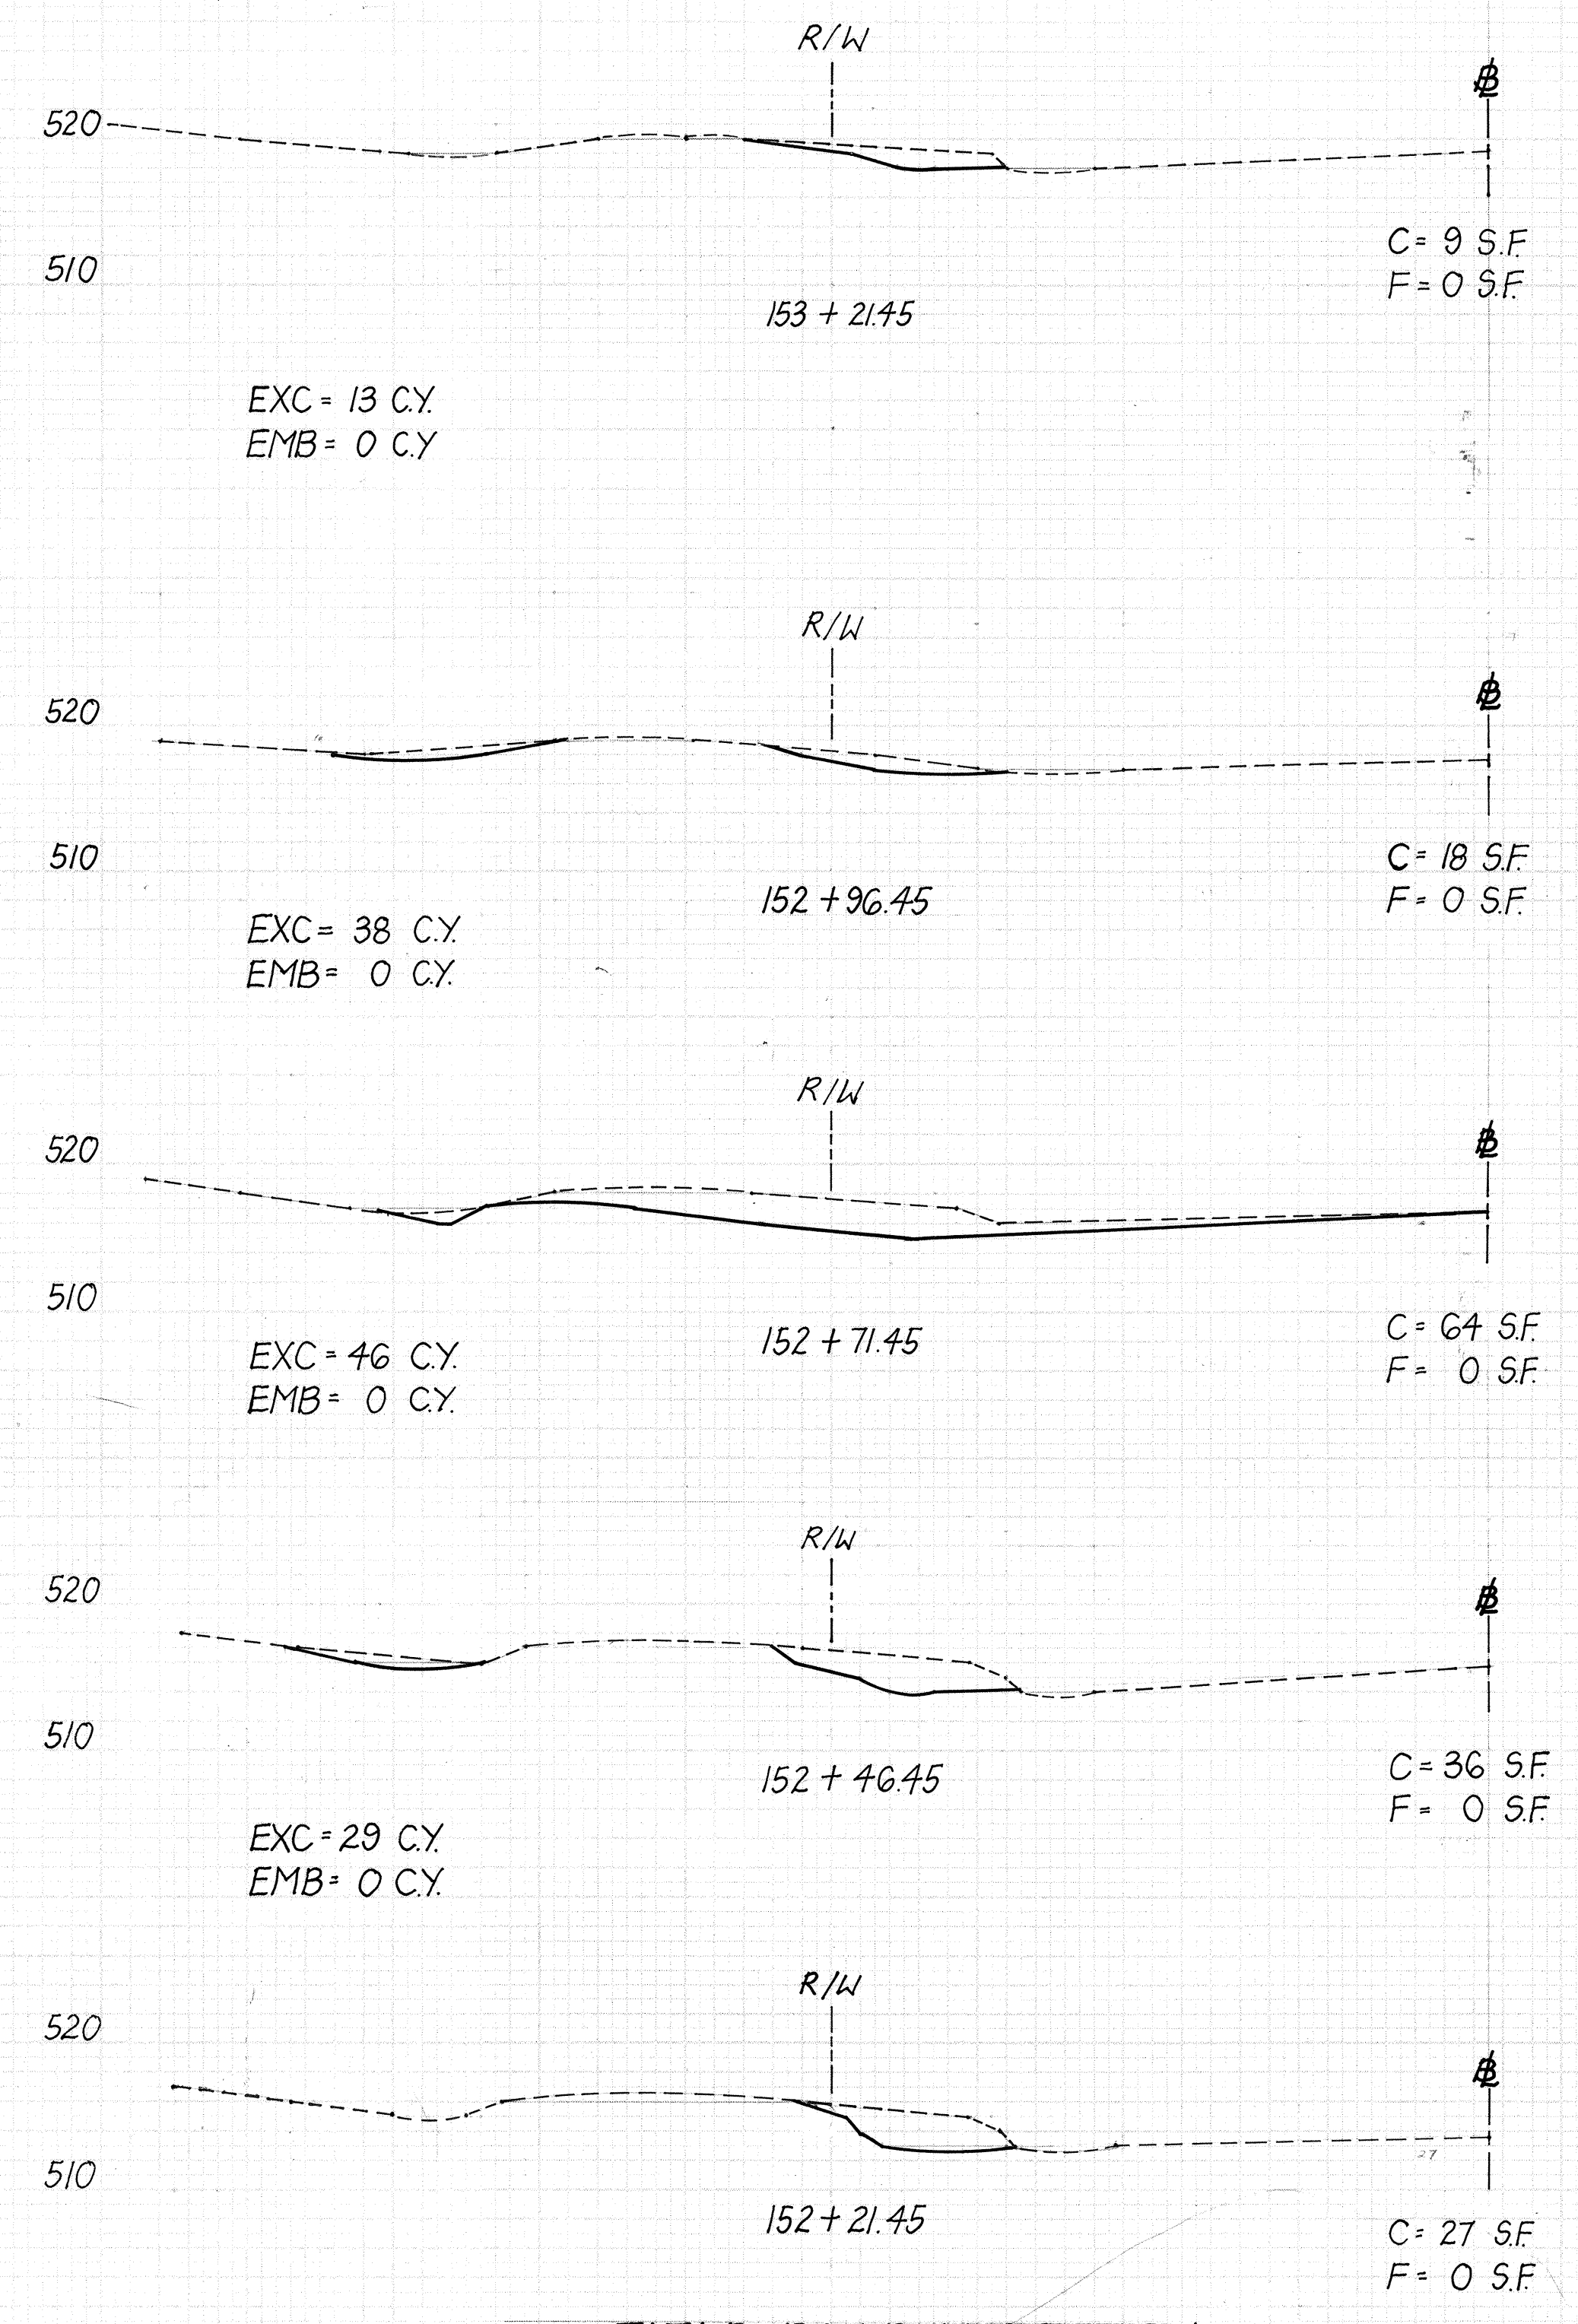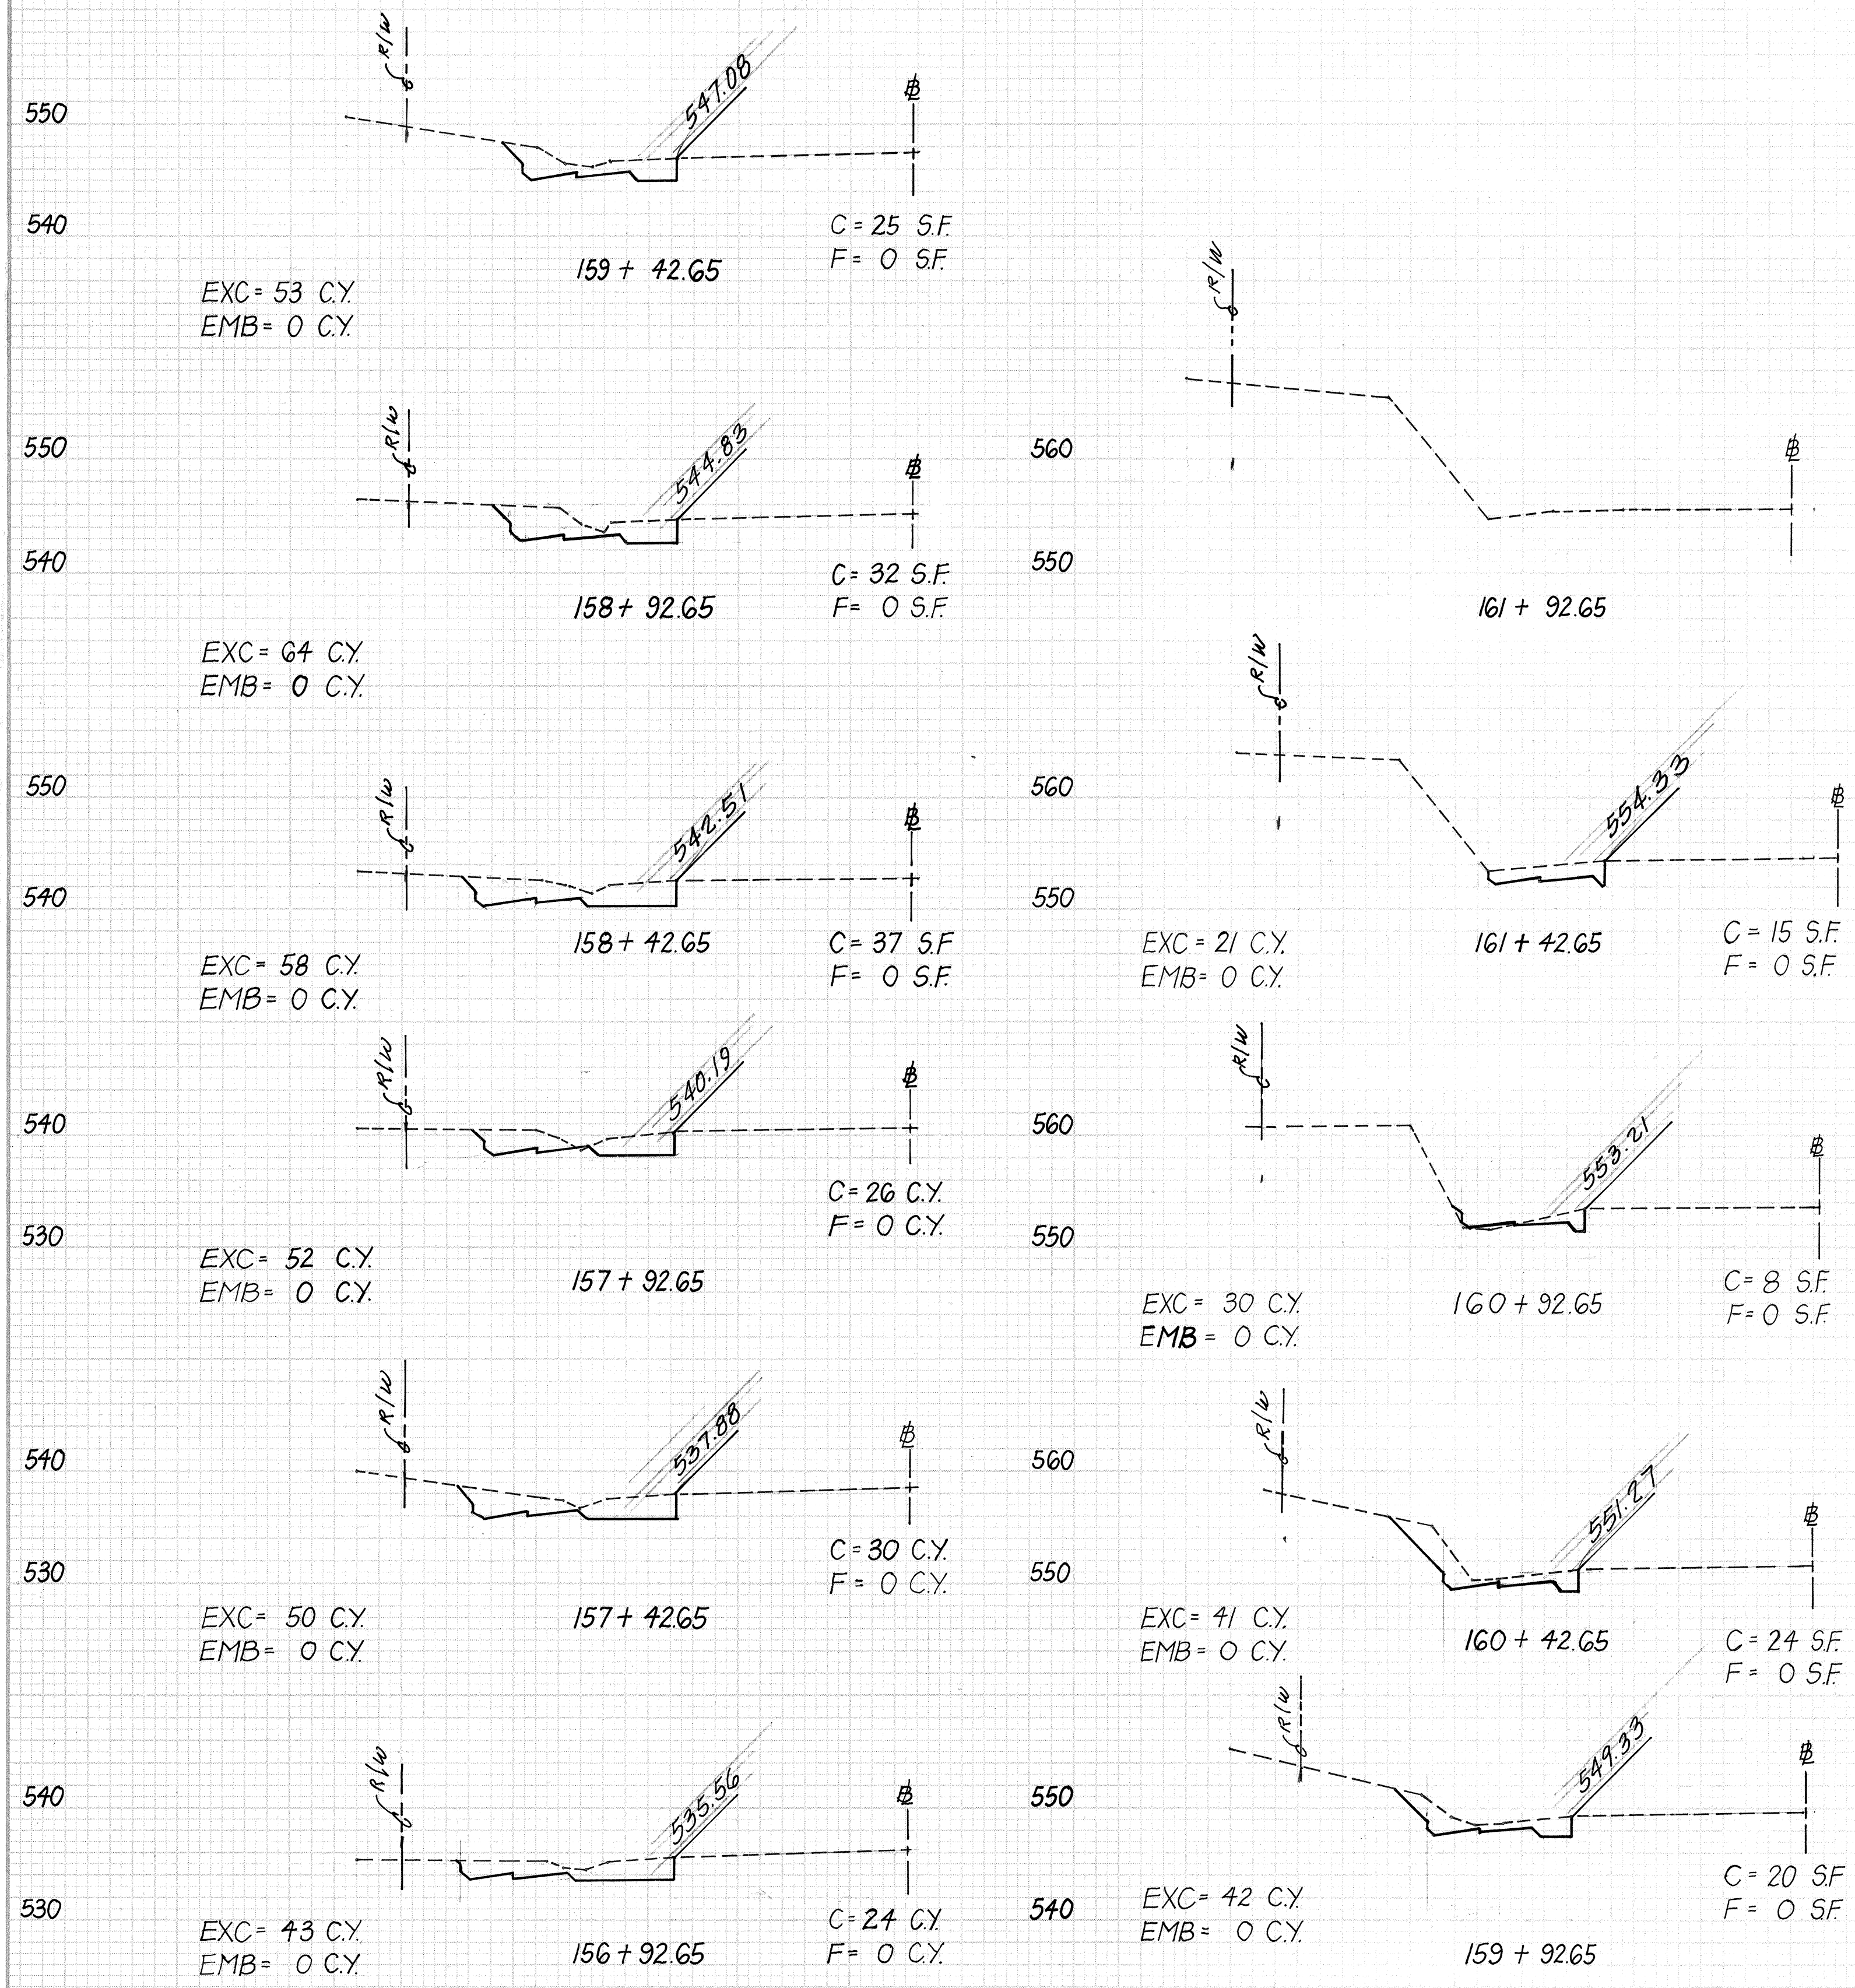

FIELD ROAD X-SECTION