
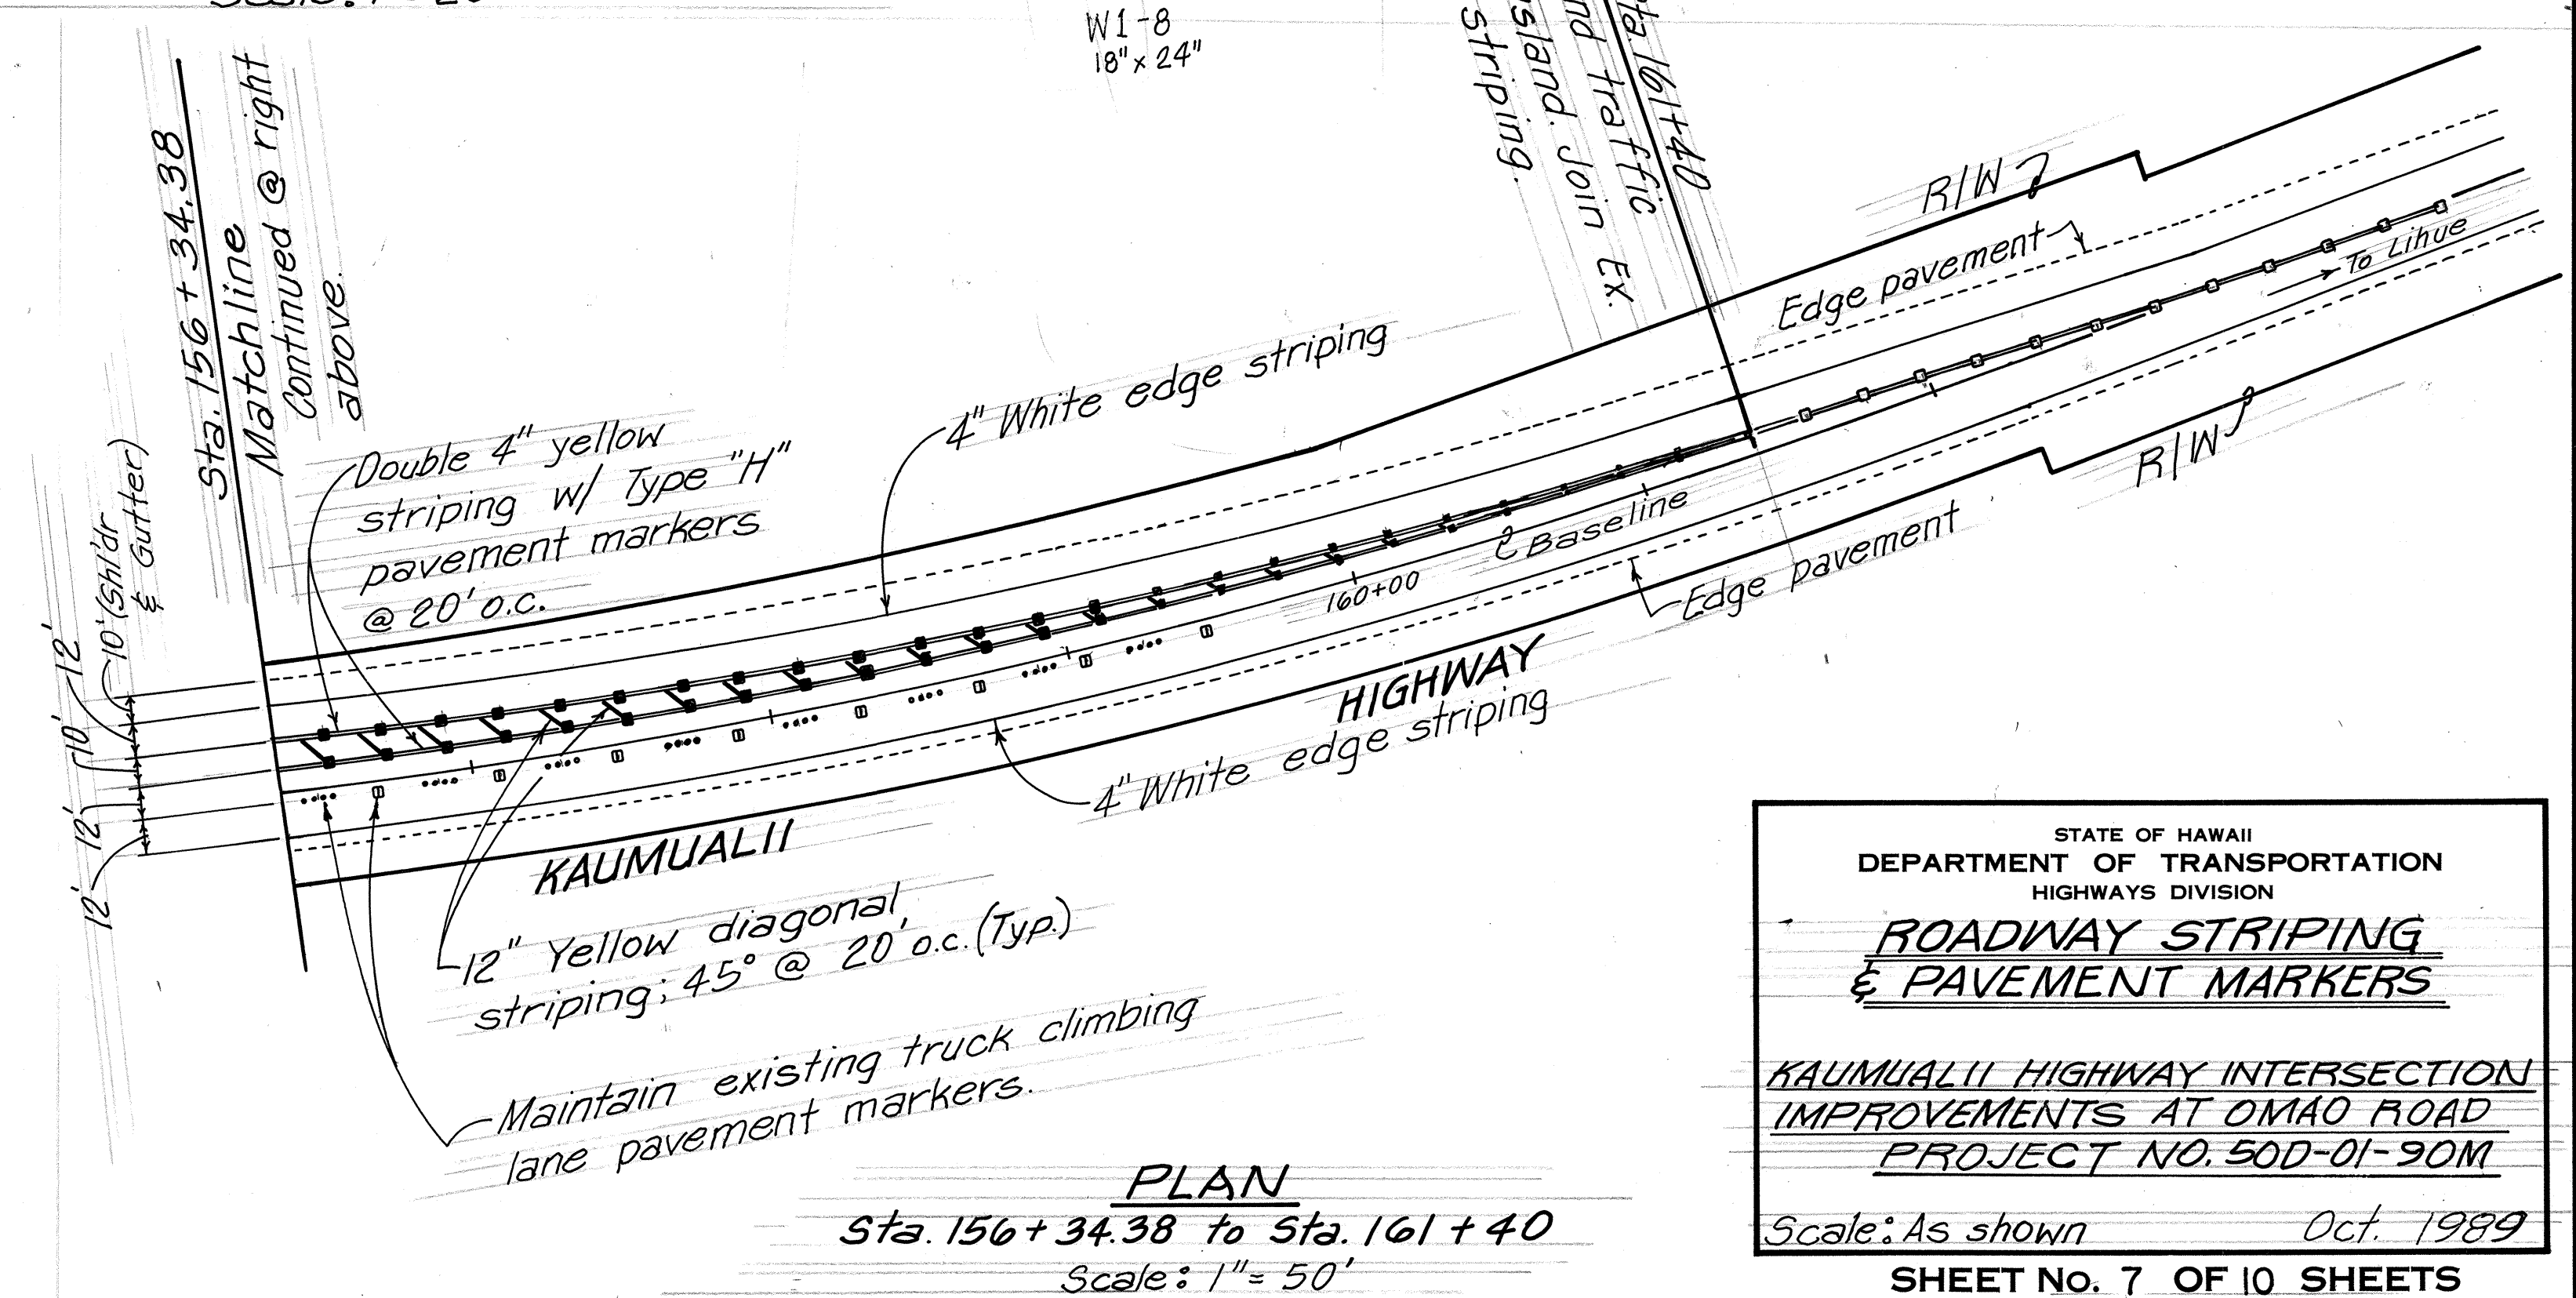
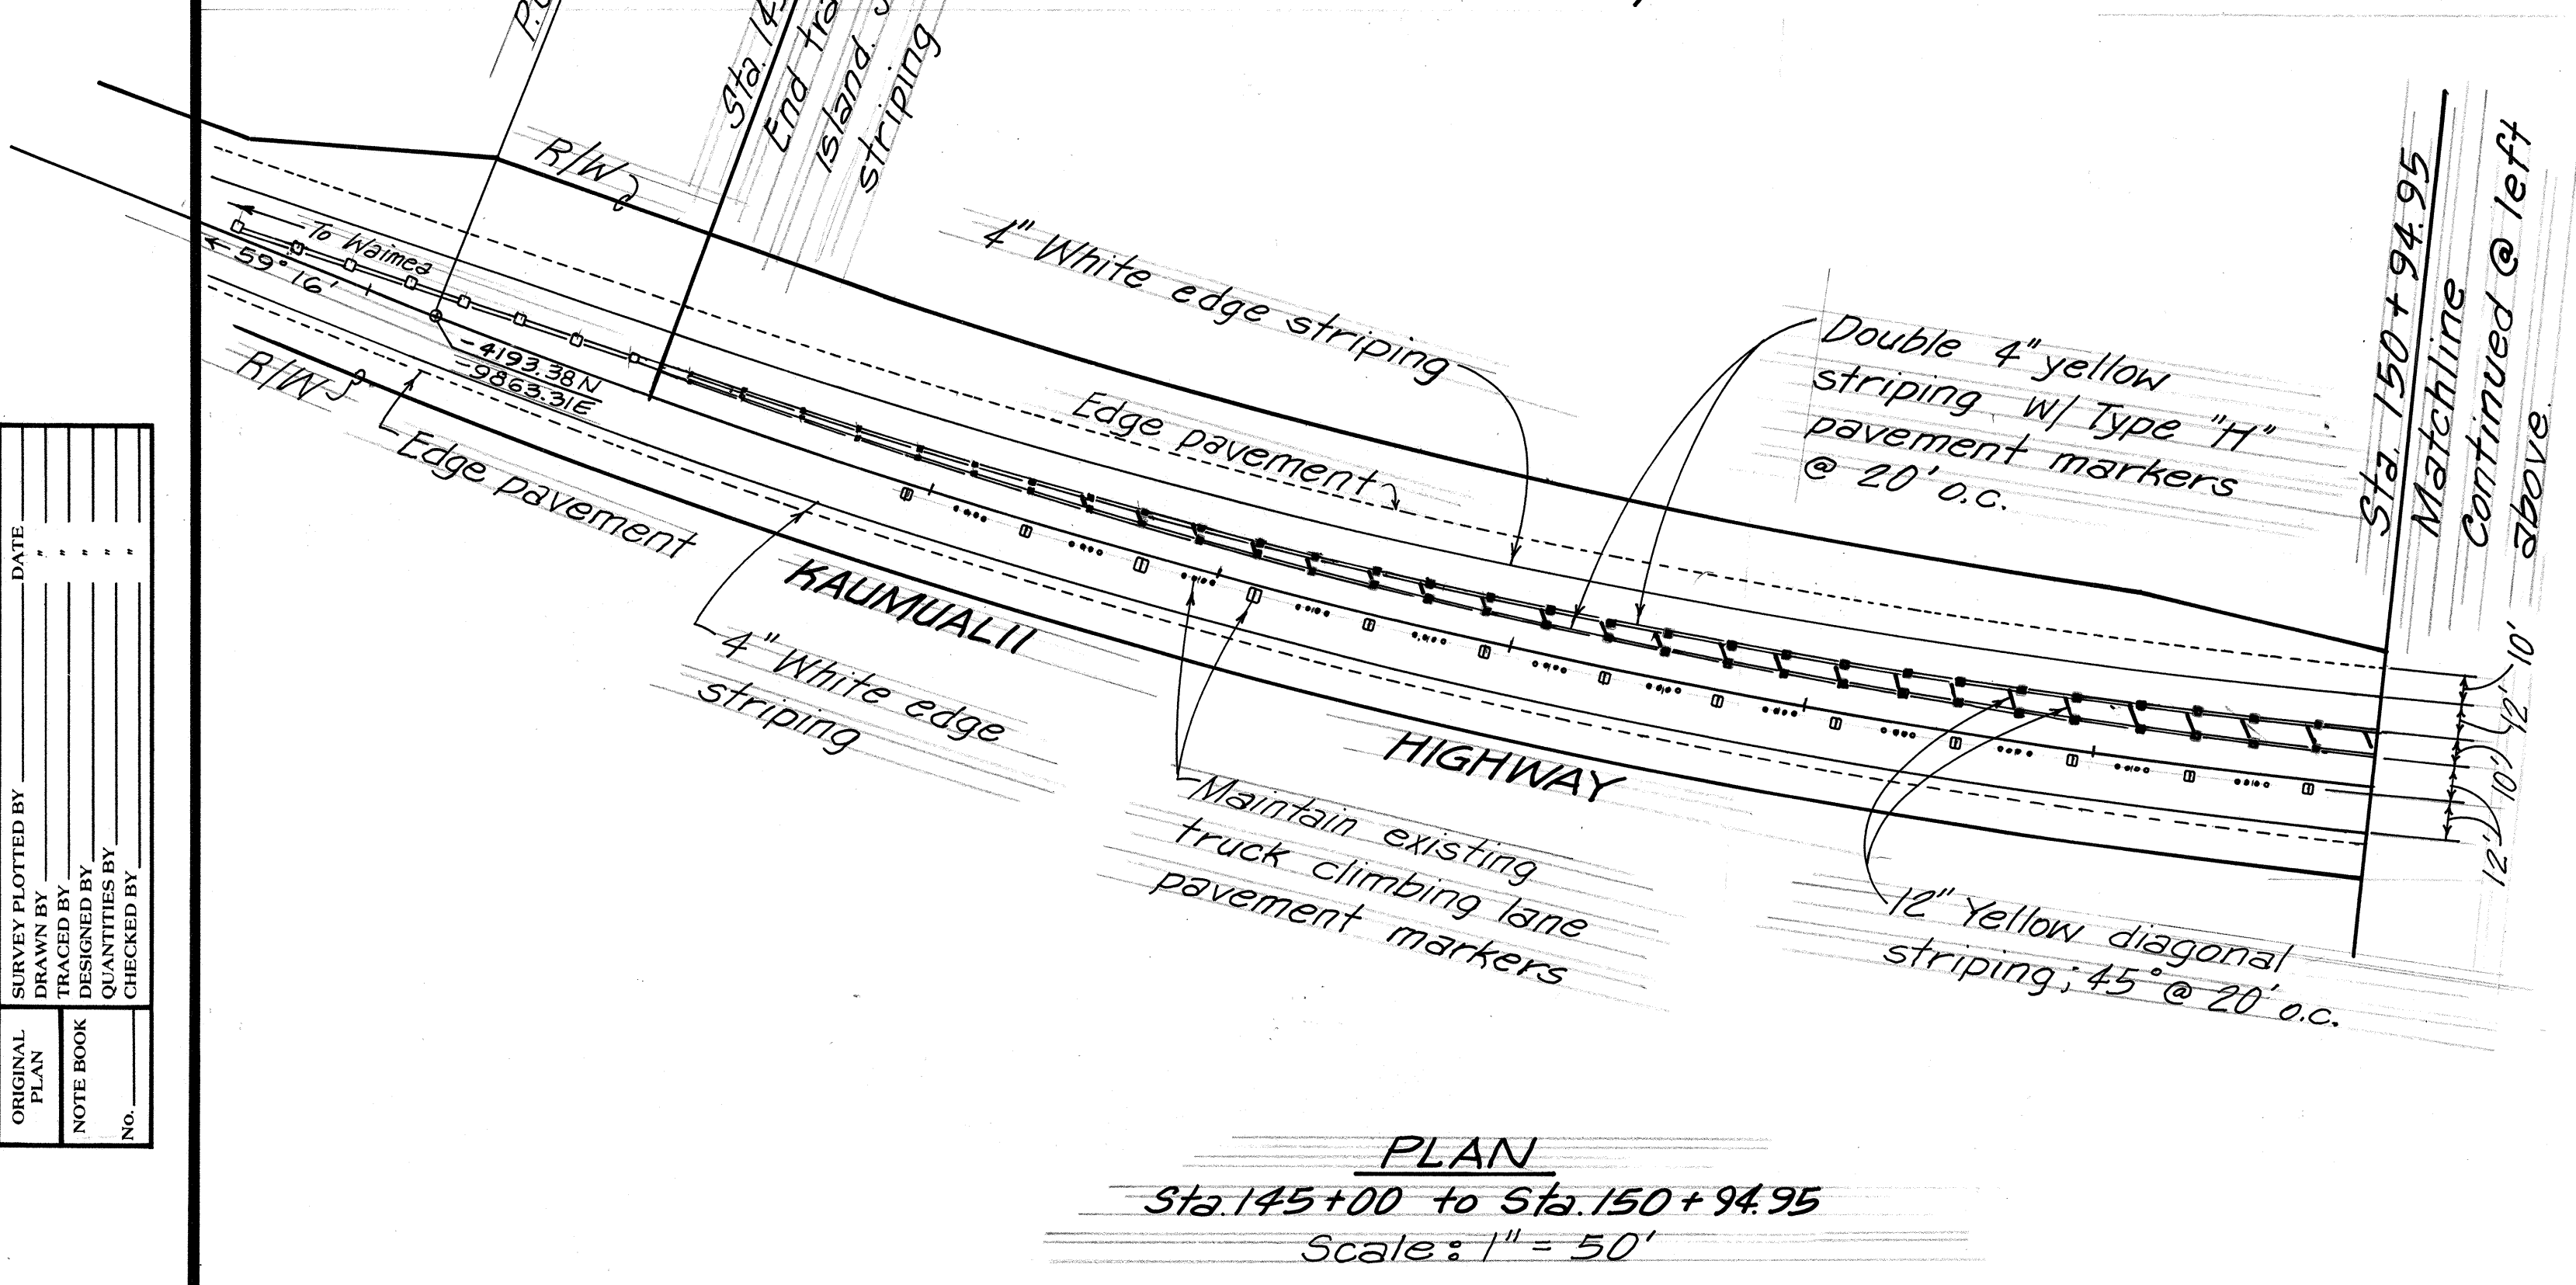


FED. ROAD DIST. NO.	STATE	PROJ. NO.	FISCAL YEAR	SHEET NO.	TOTAL SHEETS
HAWAII	HAW.	50D-01-90M	1990	7	10

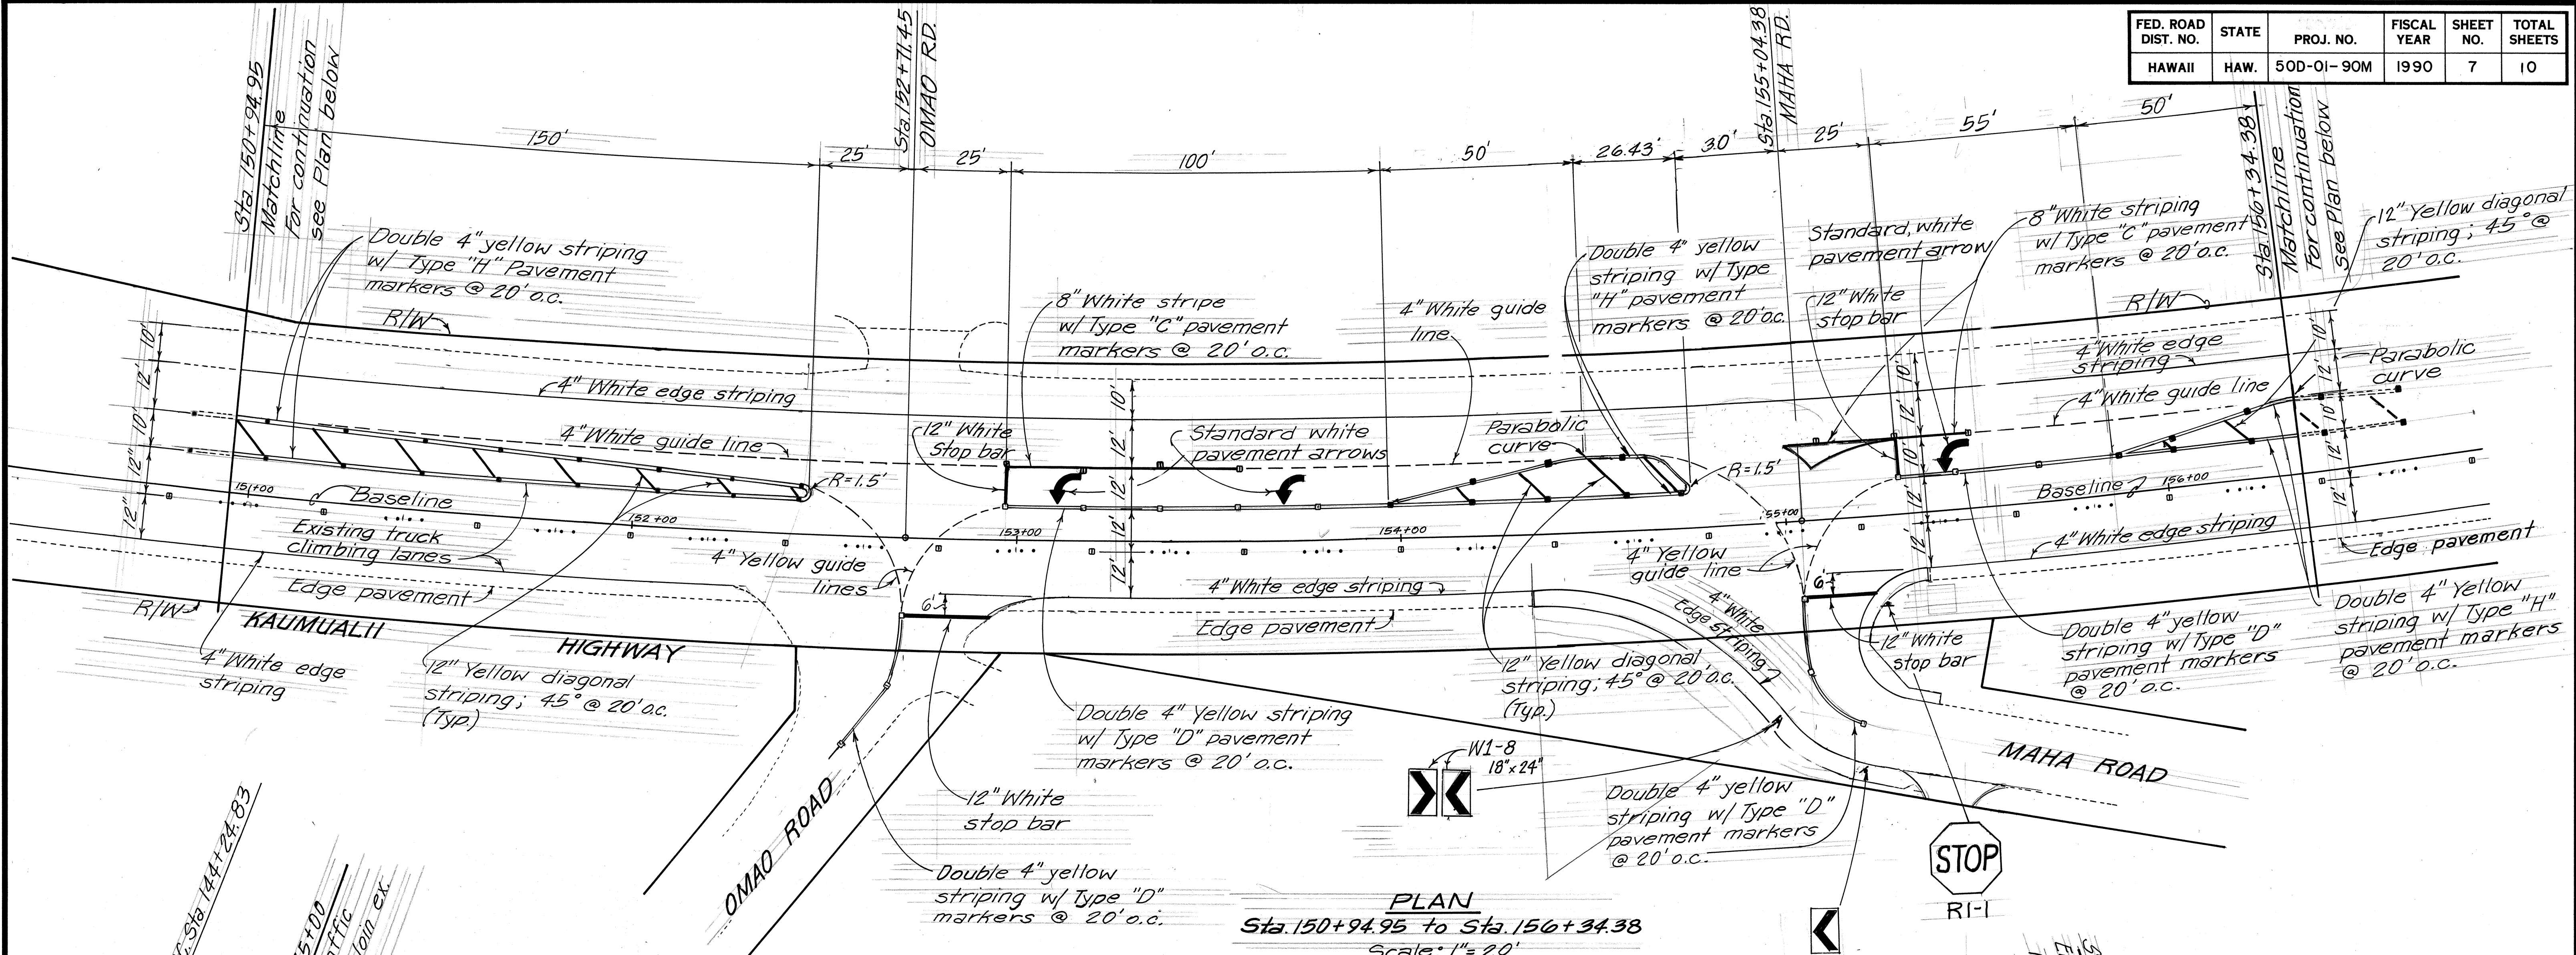

STATE OF HAWAII
DEPARTMENT OF TRANSPORTATION
HIGHWAYS DIVISION

ROADWAY STRIPING & PAVEMENT MARKERS

KAUMUALII HIGHWAY INTERSECTION IMPROVEMENTS AT OMAO ROAD
PROJECT NO. 50D-01-90M

Scale: As shown Oct. 1989
SHEET NO. 7 OF 10 SHEETS

ORIGINAL PLAN	DATE
DRAWN BY	
CHECKED BY	
NOTED BY	
QUANTITIES BY	
CHECKED BY	
NO.	