	INDEX TO DRAWINGS
SHEET NO.	DESCRIPTION
	TITLE SHEET
2	STANDARD PLANS SUMMARY
3	GENERAL NOTES & TYPICAL
	SECTION
4-6	PLAN
· · ·	
•	

548-7534 PHONE

KAUAI DISTRICT DESIGNED BY

STATE OF HAWAII


DEPARTMENT OF TRANSPORTATION HIGHWAYS DIVISION HONOLULU, HAWAII "AS-BUILT" PLANS FOR

## KAUMUALII HIGHWAY, GUARDRAIL AND SHOULDER IMPROVEMENTS

KAUMAKANI TO MAKAWELI


FEDERAL-AID PROJECT NO. HES-050-1(8) DISTRICT OF WAIMEA ISLAND OF KAUAI


BEEN INCORPORATED ON THESE PLANS EXCEPT CHANGES IN THE ORIGINAL THEORETICAL QUANTITIES. FOR ACTUAL QUANTITIES, REFER TO PROJECT LEDGER AND/OR COMPUTATION BOOK.

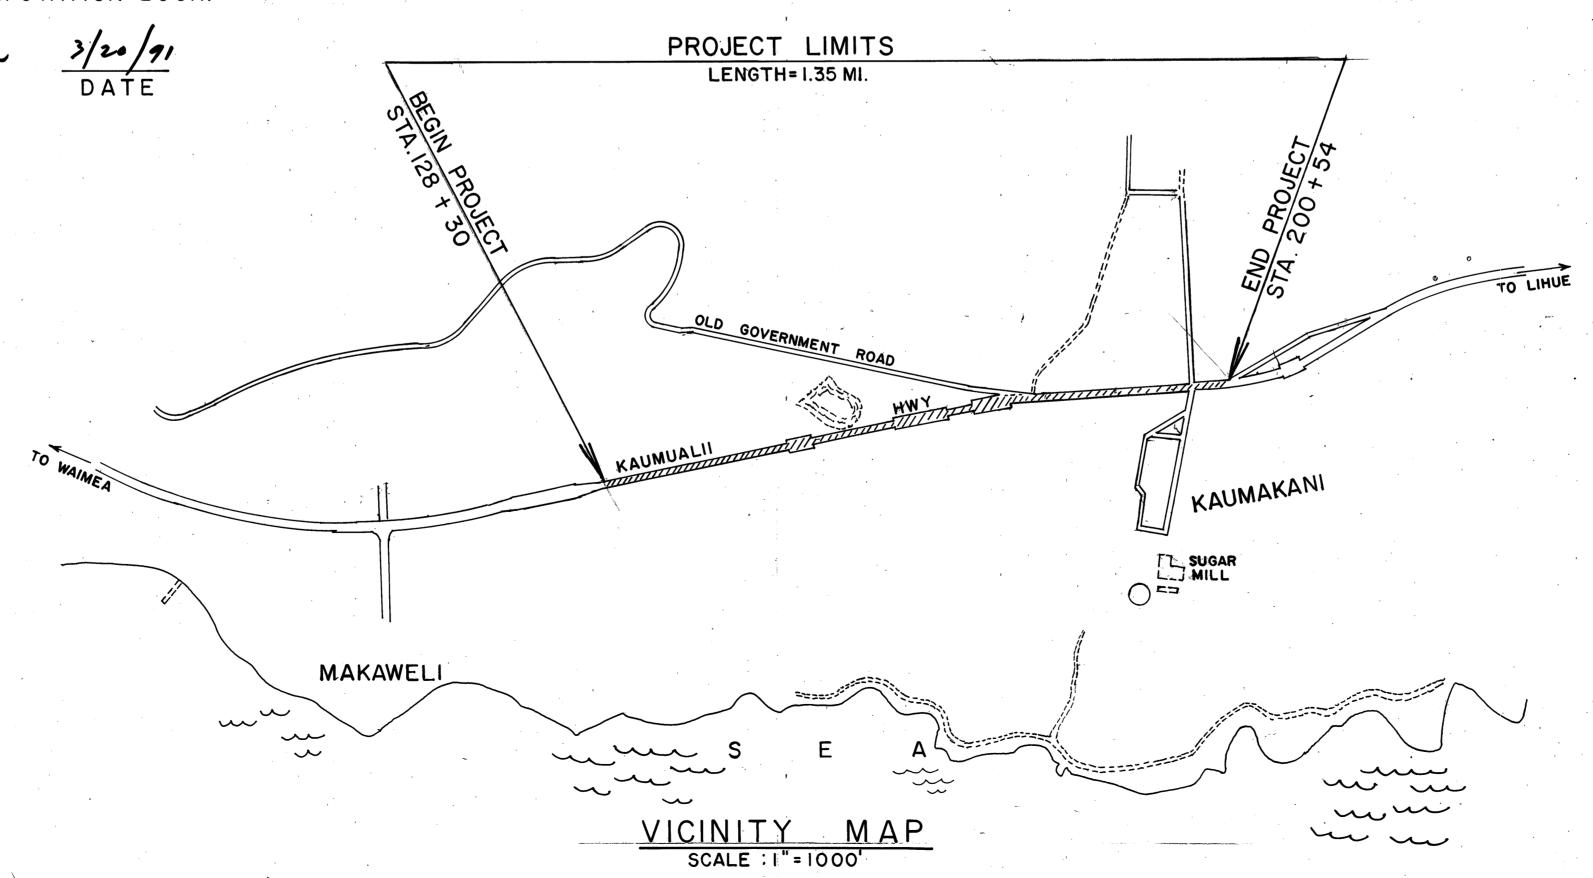

FED. AID PROJ. NO. DIST. NO. HES-050-1(8)



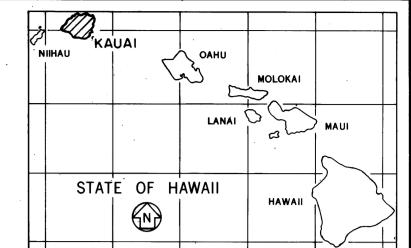

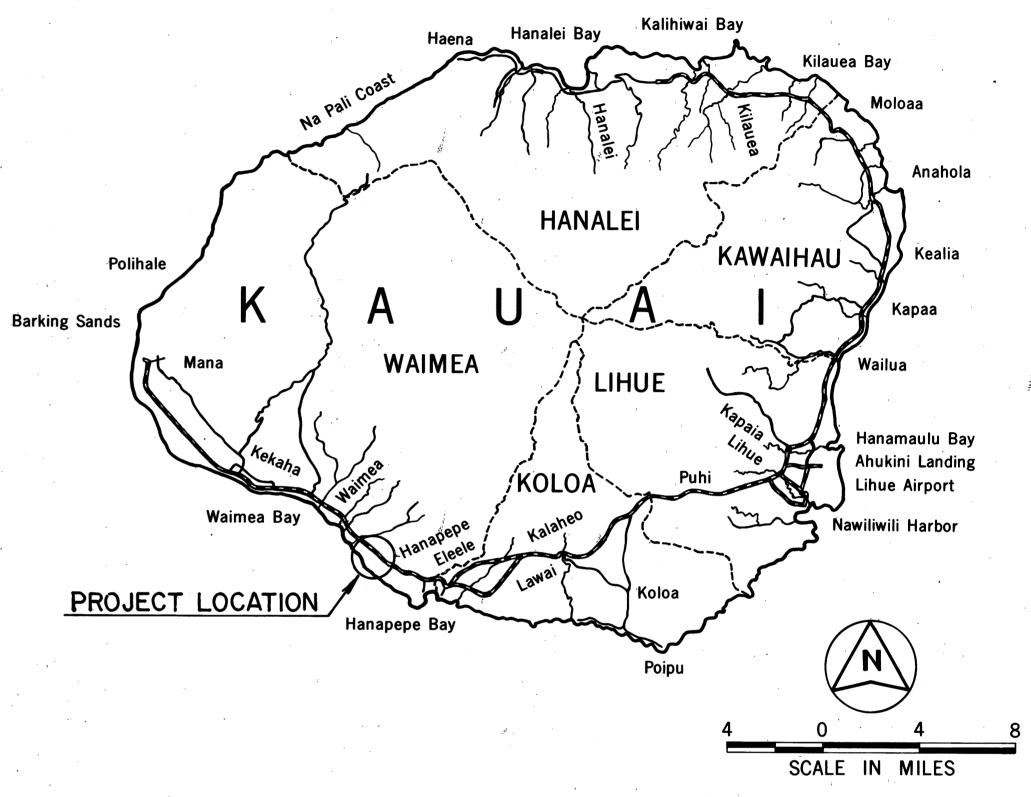

FEDERAL AID PROJECTS PREVIOUSLY CONSTRUCTED OR UNDER CONSTRUCTION

MILE POST 19.02 TO MILE POST 20.37

## DESIGN DESIGNATION

CURRENT ADT (1989). . . 9,200 DESIGN ADT (2009). . . . 15,900

DEPARTMENT OF TRANSPORTATION FEDERAL HIGHWAY ADMINISTRATION APPROVED: 10/6/89 DATE

DIVISION ADMINISTRATOR

DEPARTMENT OF TRANSPORTATION STATE OF HAWAII