
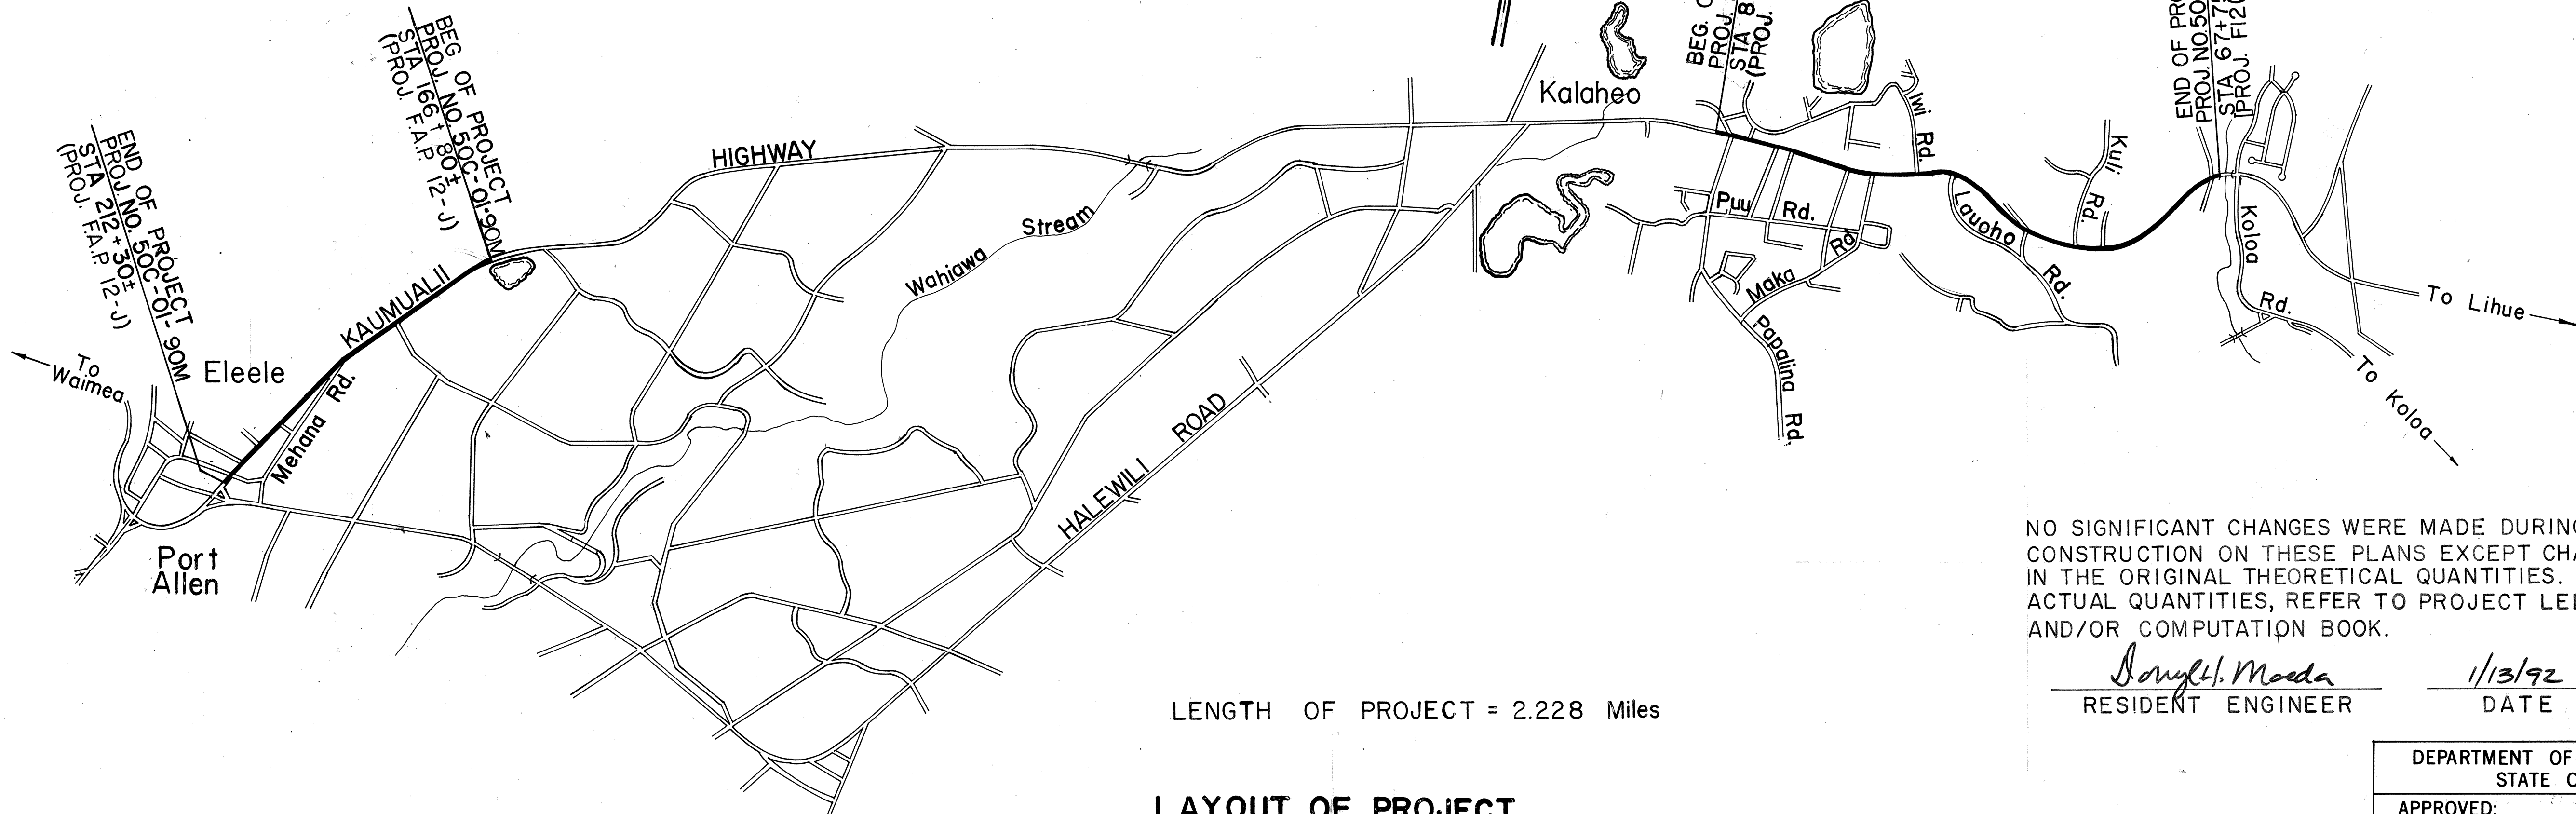


| INDEX TO DRAWINGS | |
|-------------------|--|
| SHEET NO. | DESCRIPTION |
| 1 | TITLE SHEET |
| 2 | STANDARD SUMMARY SHT. |
| 3 | NOTES, DETAILS, ESTIMATED QUANTITIES & SUMMARY |
| 4 | TYPICAL SECTIONS |
| 5 | PLAN - HANAPEPE LOOKOUT TO ELEELE |
| 6 | PLAN - KALAHEO TO LAWAI BRIDGE |

| FED. ROAD DIST. NO. | STATE | PROJ. NO. | FISCAL YEAR | SHEET NO. | TOTAL SHEETS |
|---------------------|-------|------------|-------------|-----------|--------------|
| HAWAII | HAW. | 50C-01-90M | 1991 | 1 | 6 |

STATE OF HAWAII
DEPARTMENT OF TRANSPORTATION
HIGHWAYS DIVISION

"AS-BUILT"
PLANS FOR
KAUMUALII HIGHWAY RESURFACING
KALAHEO TO LAWAI BRIDGE
AND
HANAPEPE LOOKOUT TO ELEELE
PROJECT NO. 50C-01-90M
DISTRICT OF KOLOA
ISLAND OF KAUAI

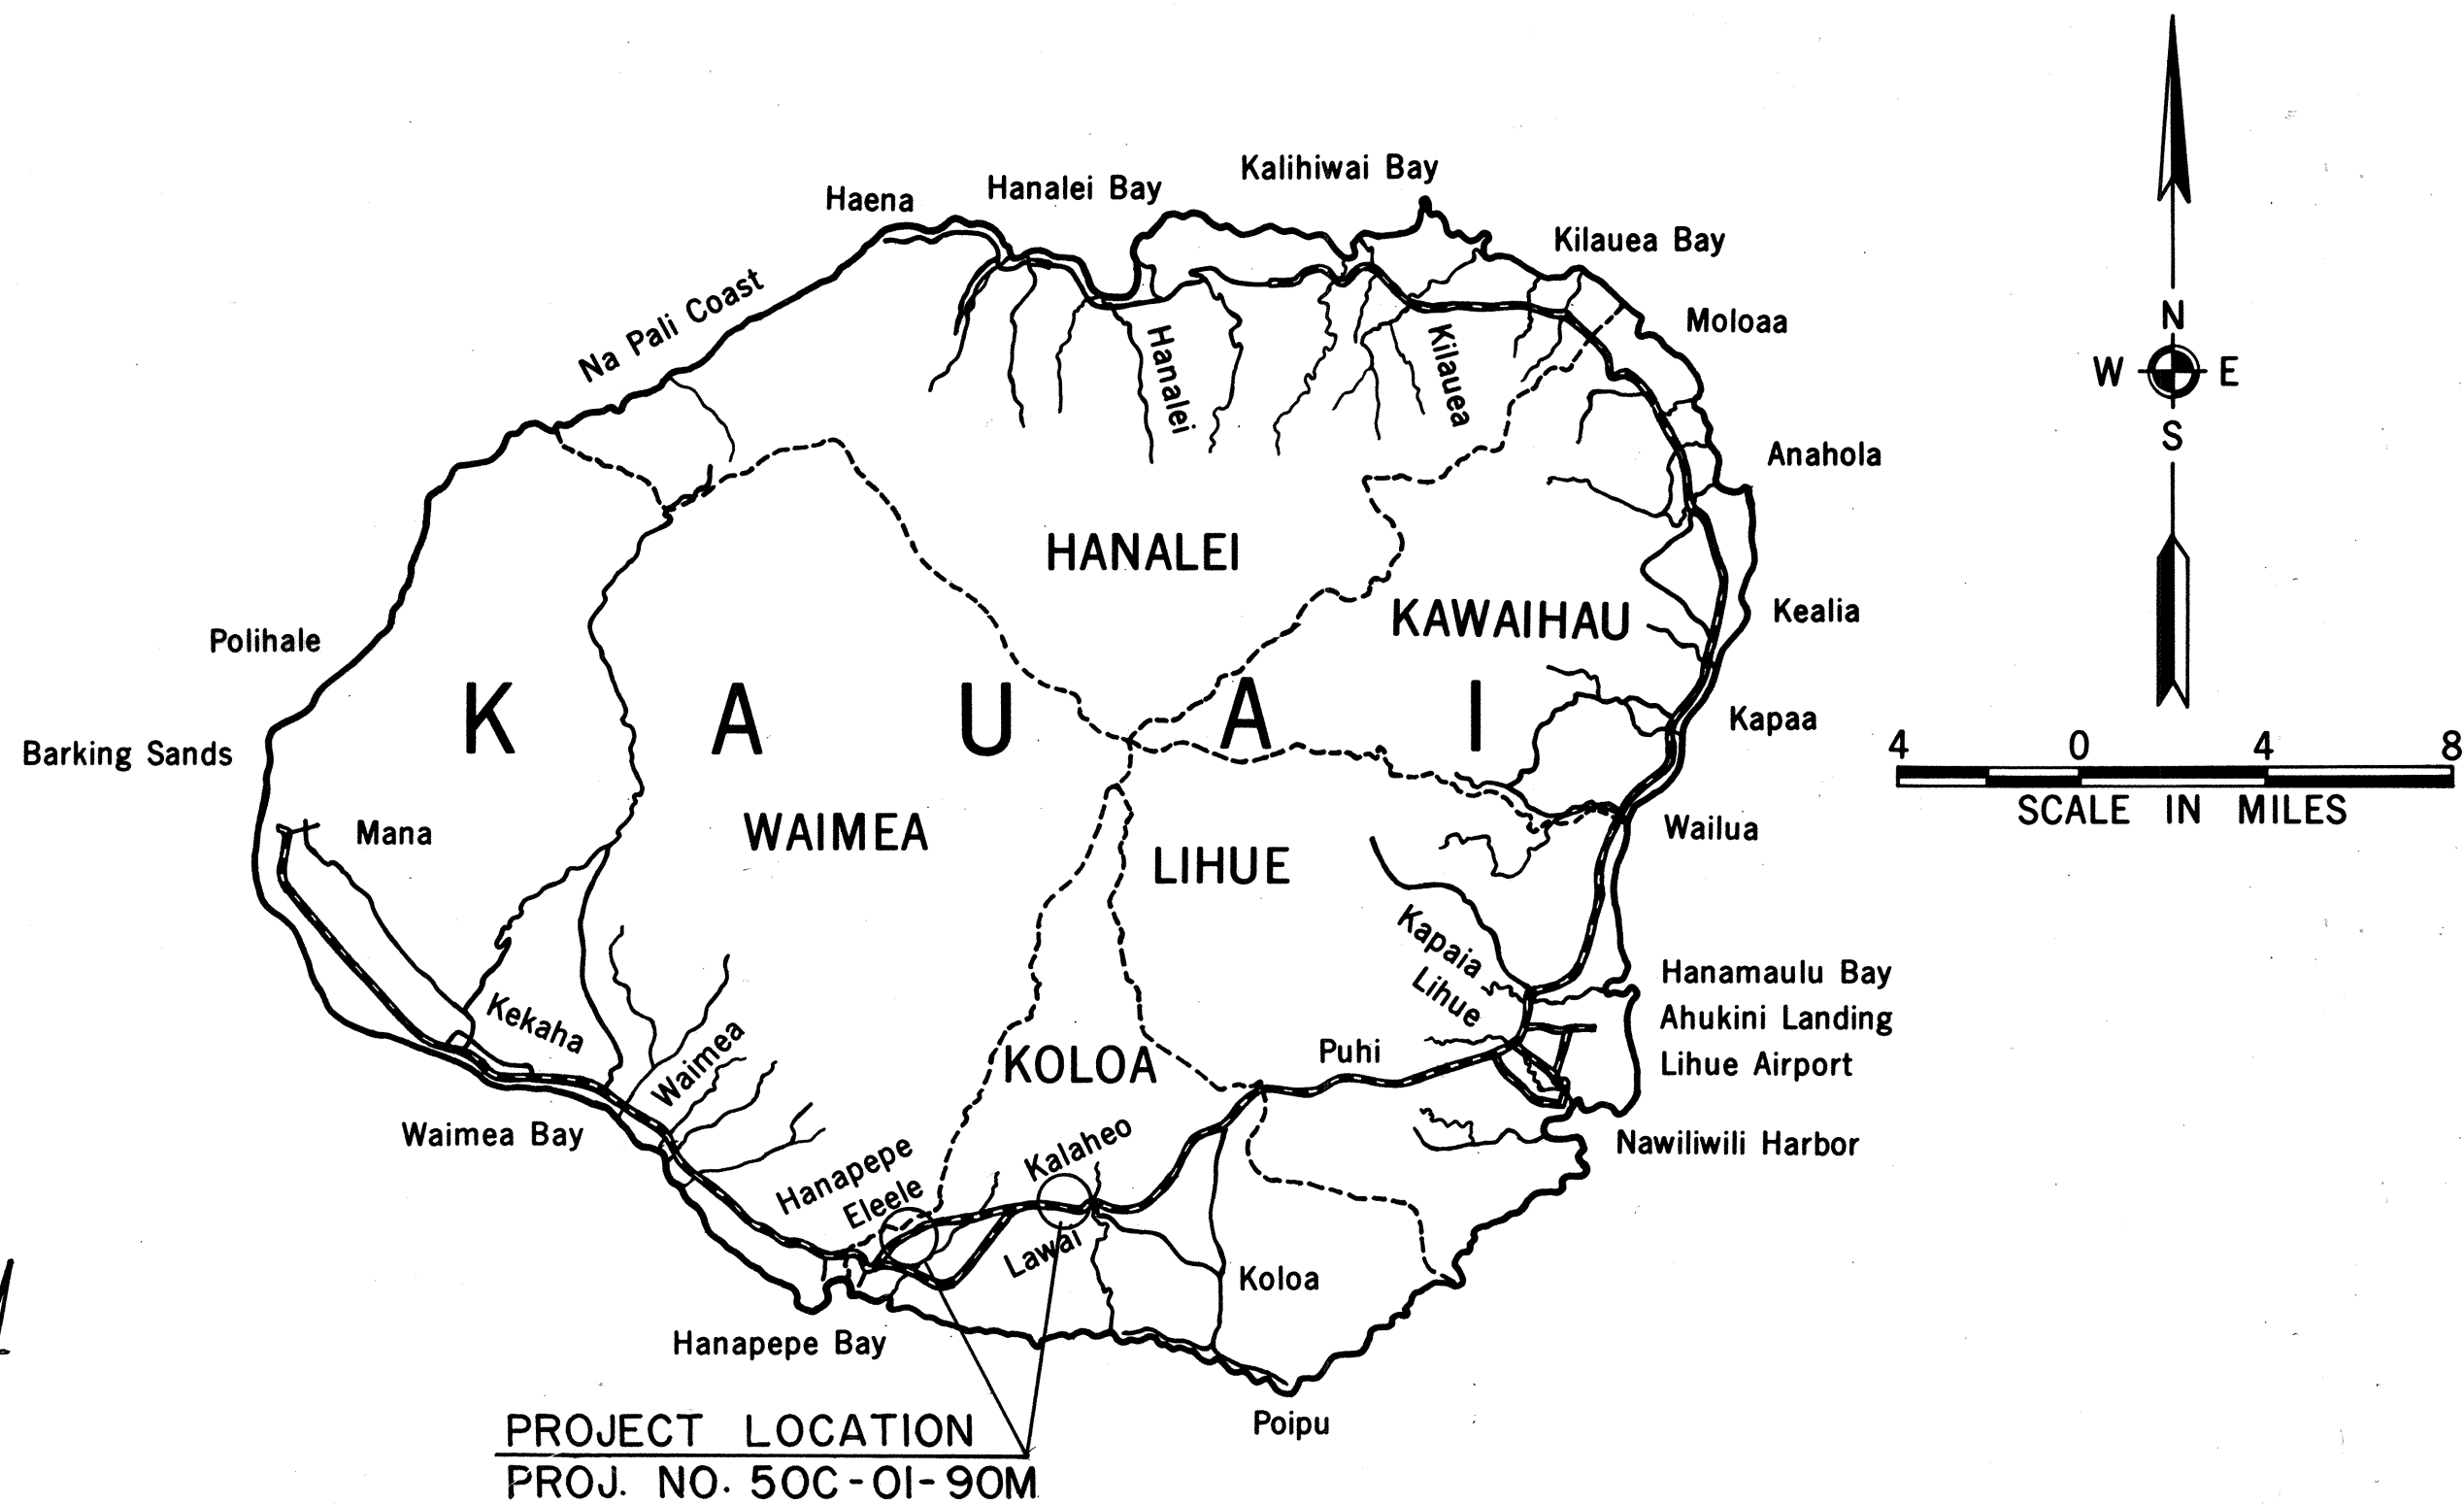

LENGTH OF PROJECT = 2.228 Miles

LAYOUT OF PROJECT
SCALE : 1" = 1500'

NO SIGNIFICANT CHANGES WERE MADE DURING CONSTRUCTION ON THESE PLANS EXCEPT CHANGES IN THE ORIGINAL THEORETICAL QUANTITIES. FOR ACTUAL QUANTITIES, REFER TO PROJECT LEDGER AND/OR COMPUTATION BOOK.

Songhtl. Maeda
RESIDENT ENGINEER

1/13/92
DATE

| | |
|---|--------|
| DEPARTMENT OF TRANSPORTATION STATE OF HAWAII | |
| APPROVED: | |
| <i>Edwards</i> | 5/1/90 |
| DIR. OF TRANSPORTATION | DATE |

KAUAI DISTRICT
DESIGNED BY
A. YAMAGUCHI
P. S. & E. BY
548-7534
PHONE
MAY 1990
DATE