

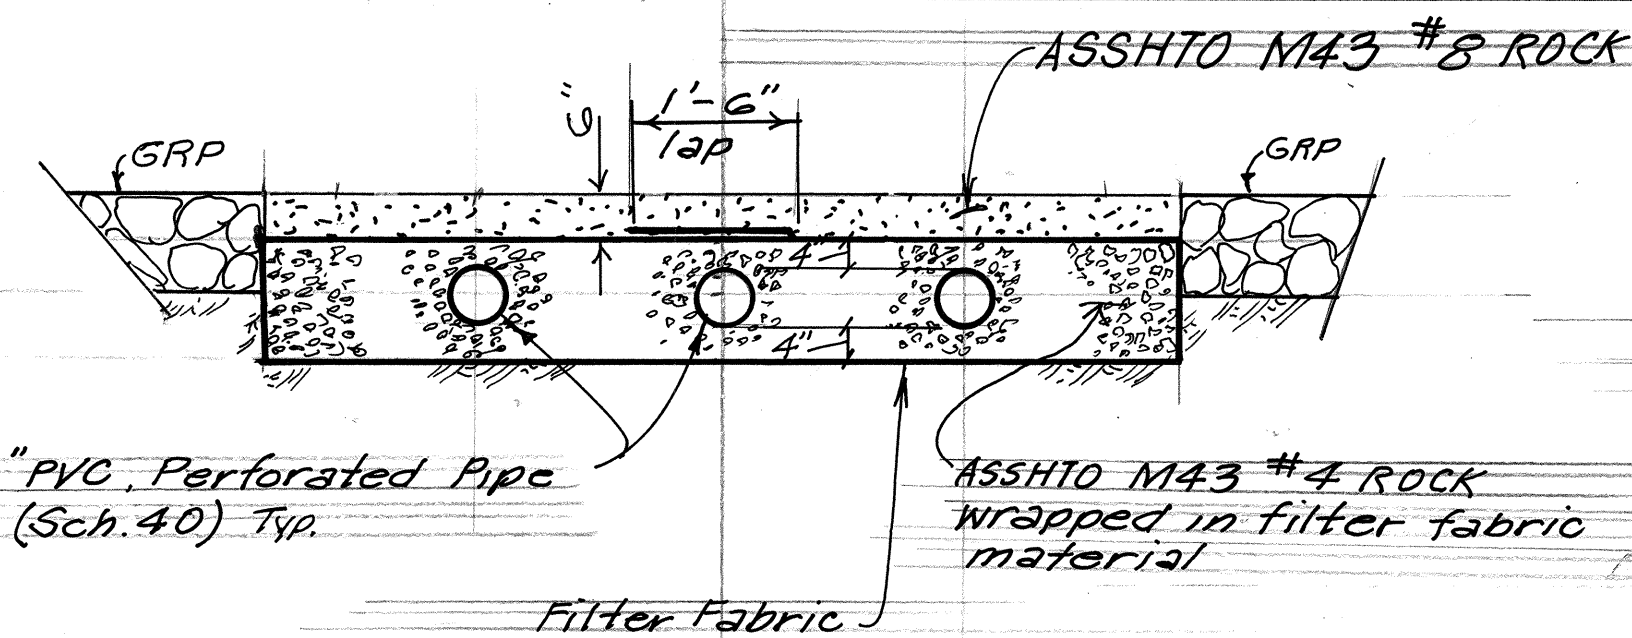


NOTE: ELEVATIONS SHOWN
HEREON ARE RELATIVE ELEV.
& NOT ACTUAL ELEVATIONS.
REFERENCE ELEVATION IS TOP
OF EXISTING CONC. HEADWALL.
EL. = 200.00 (ASSUMED)

FED. ROAD DIST. NO.	STATE	FED. AID PROJ. NO.	FISCAL YEAR	SHEET NO.	TOTAL SHEETS
HAWAII	HAW.	50B-02-92M	1992	4	4

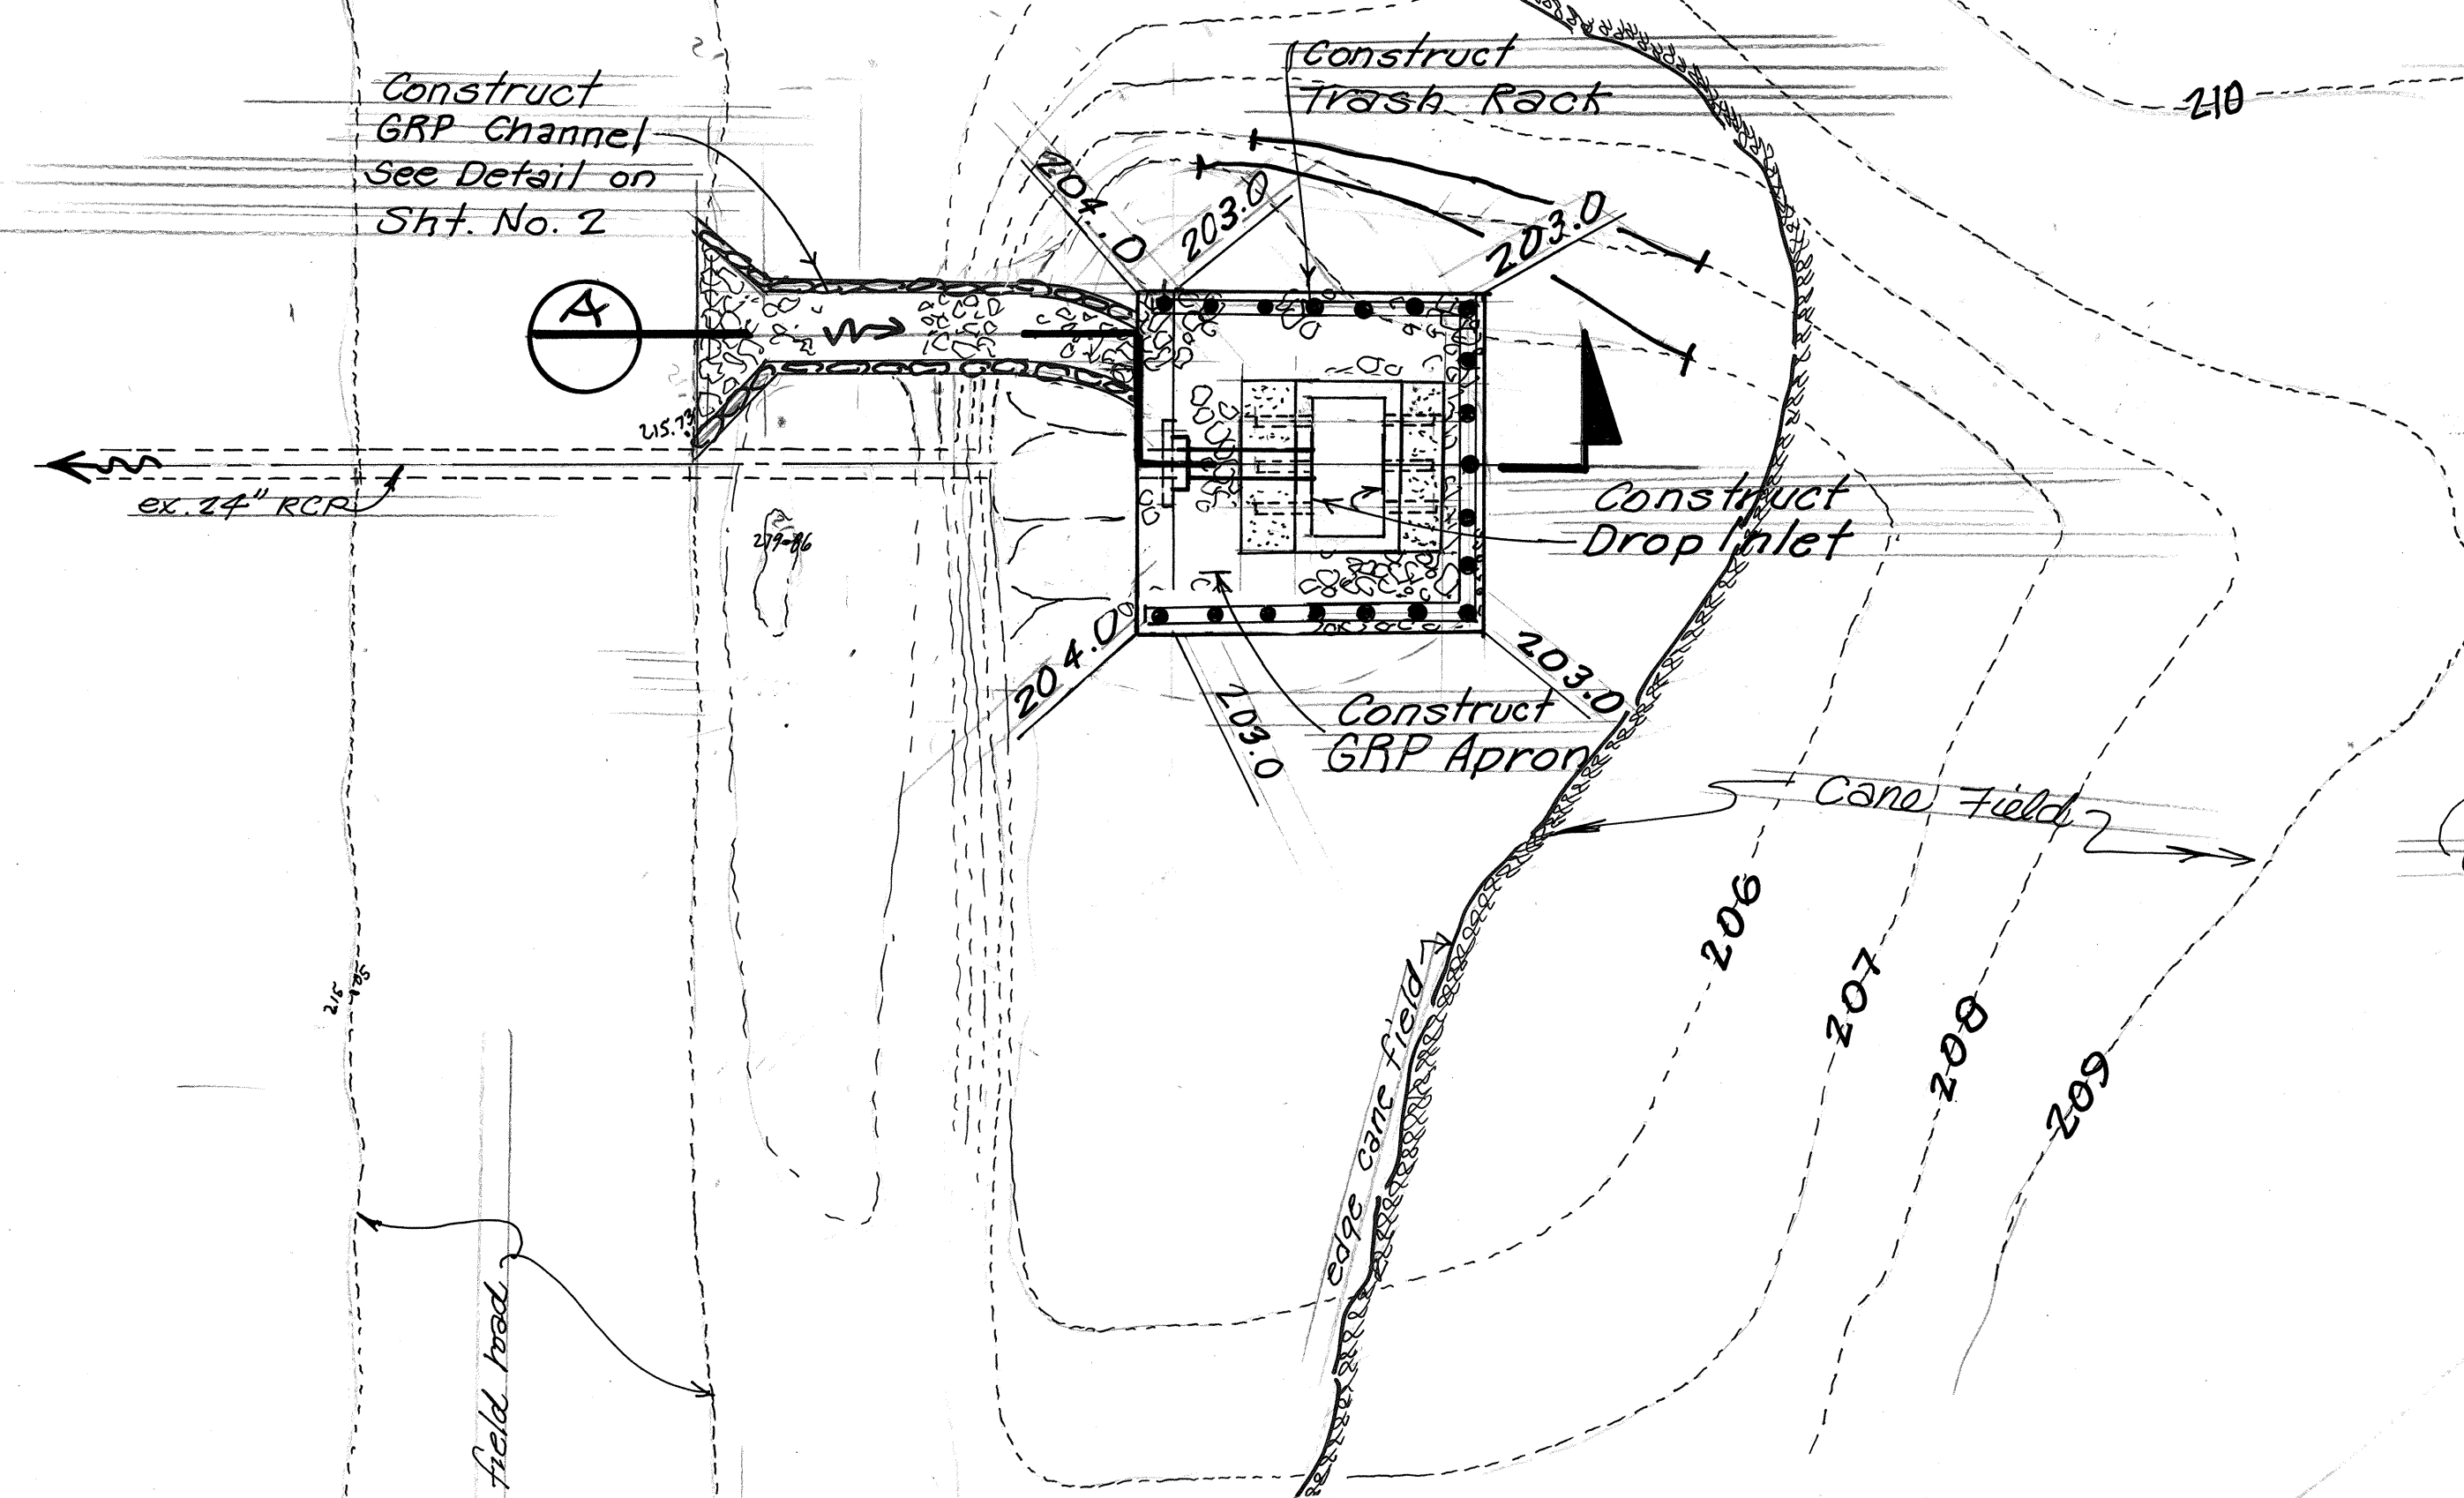


SECTION C
Scale: 1/2" = 1'-0"

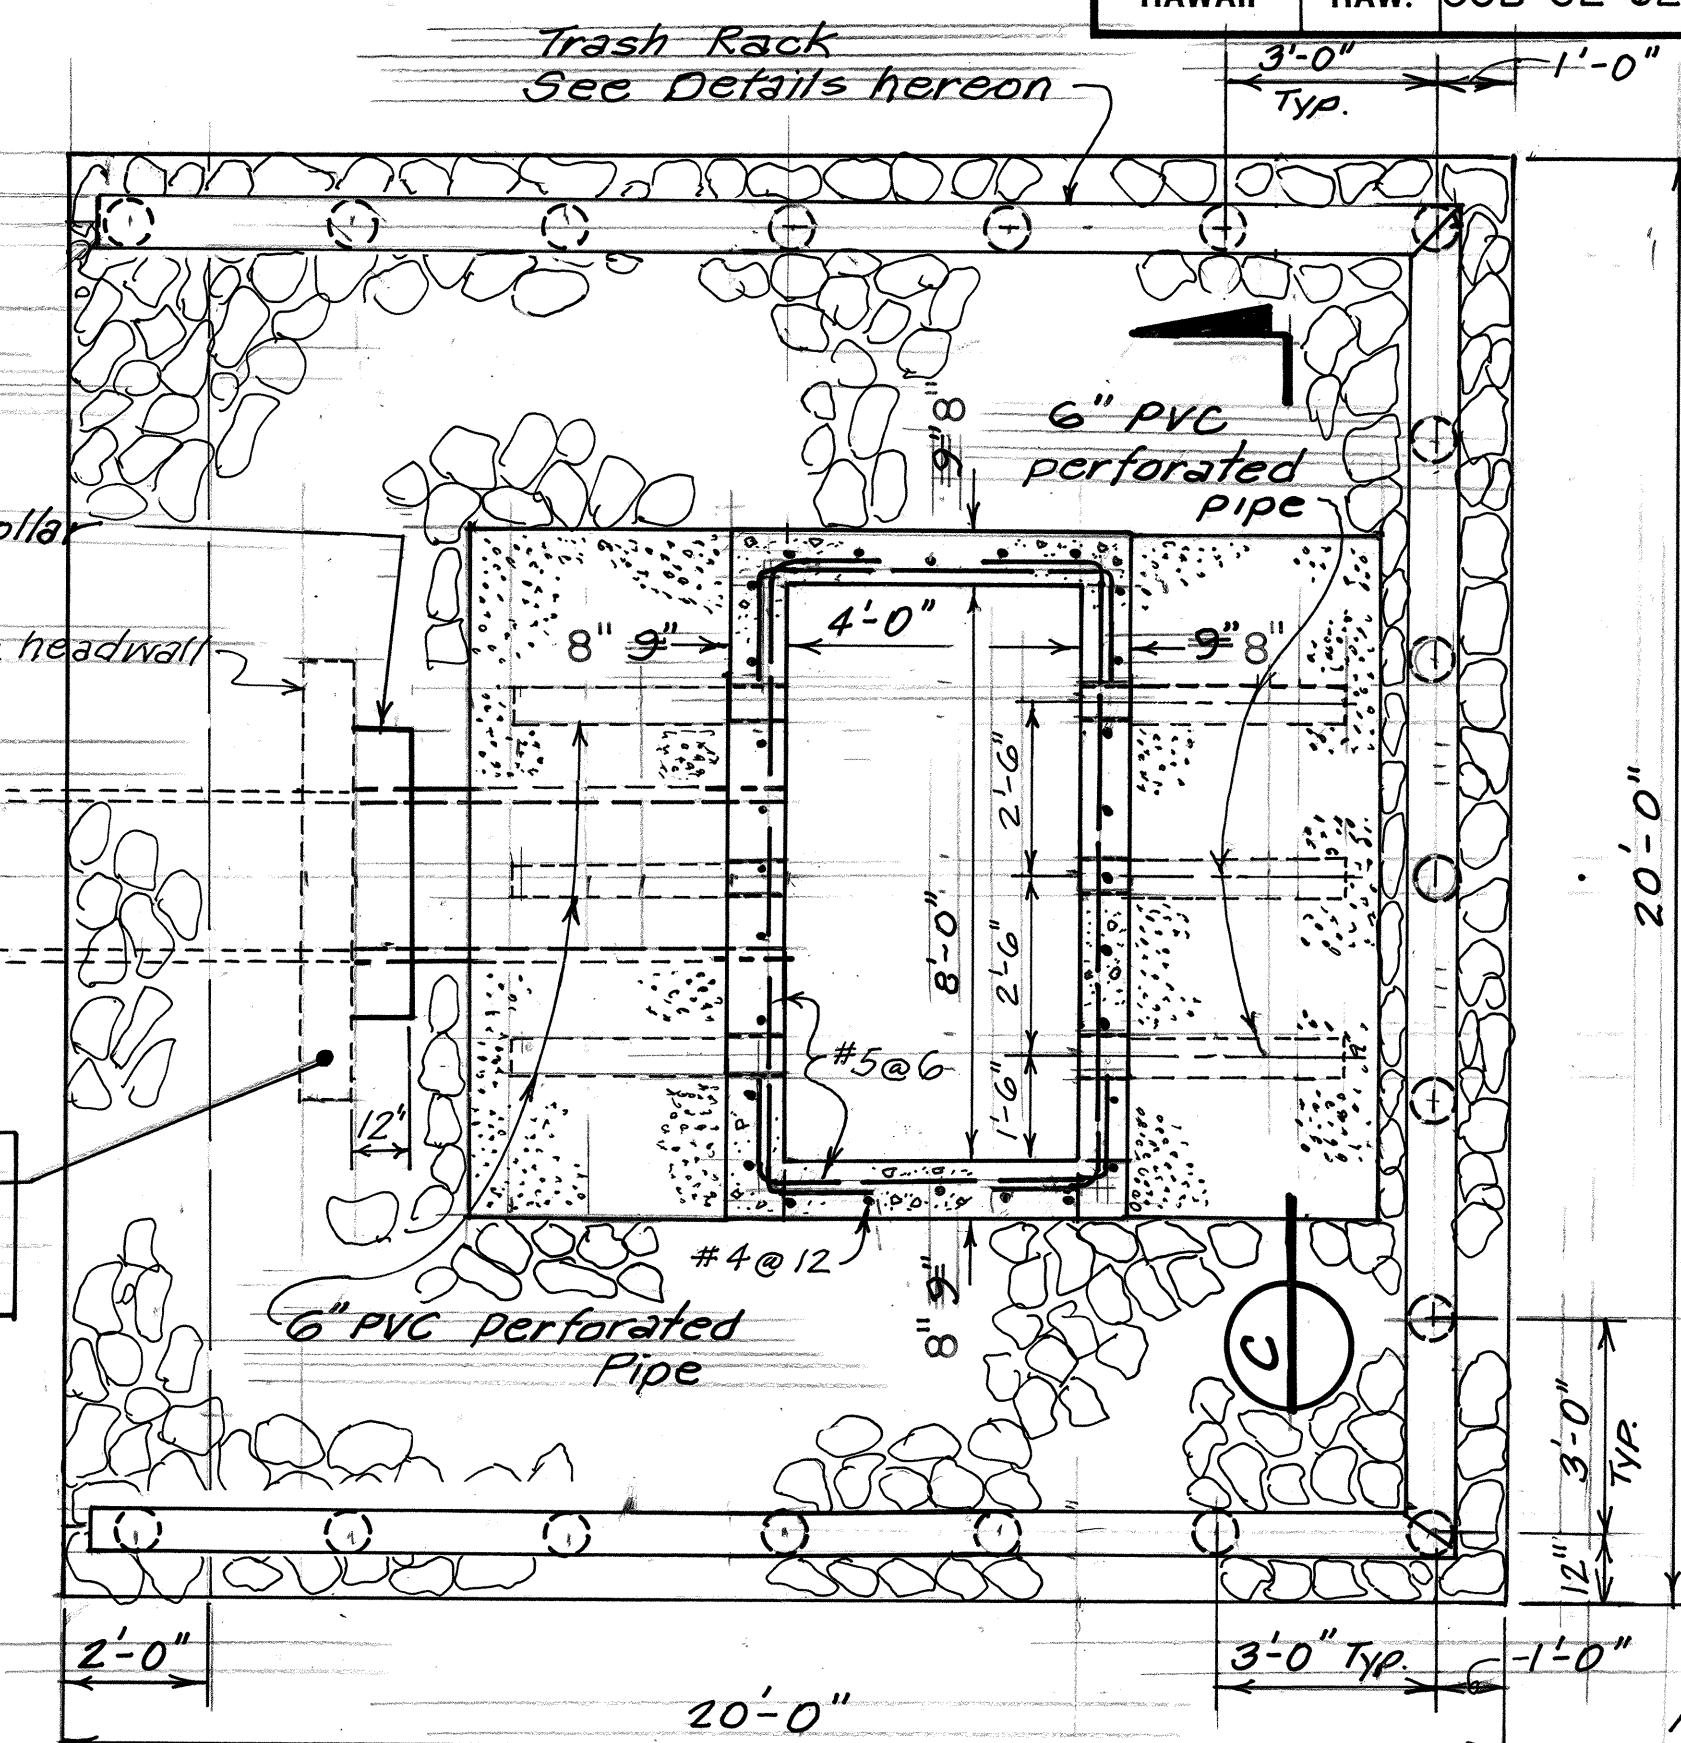


PLAN - DROP INLET
Scale: 3/8" = 1'-0"

Note:
for Drop Inlet
grating details, see
Sht. No. 3.
Manhole rungs per
Std. Plan H-08.

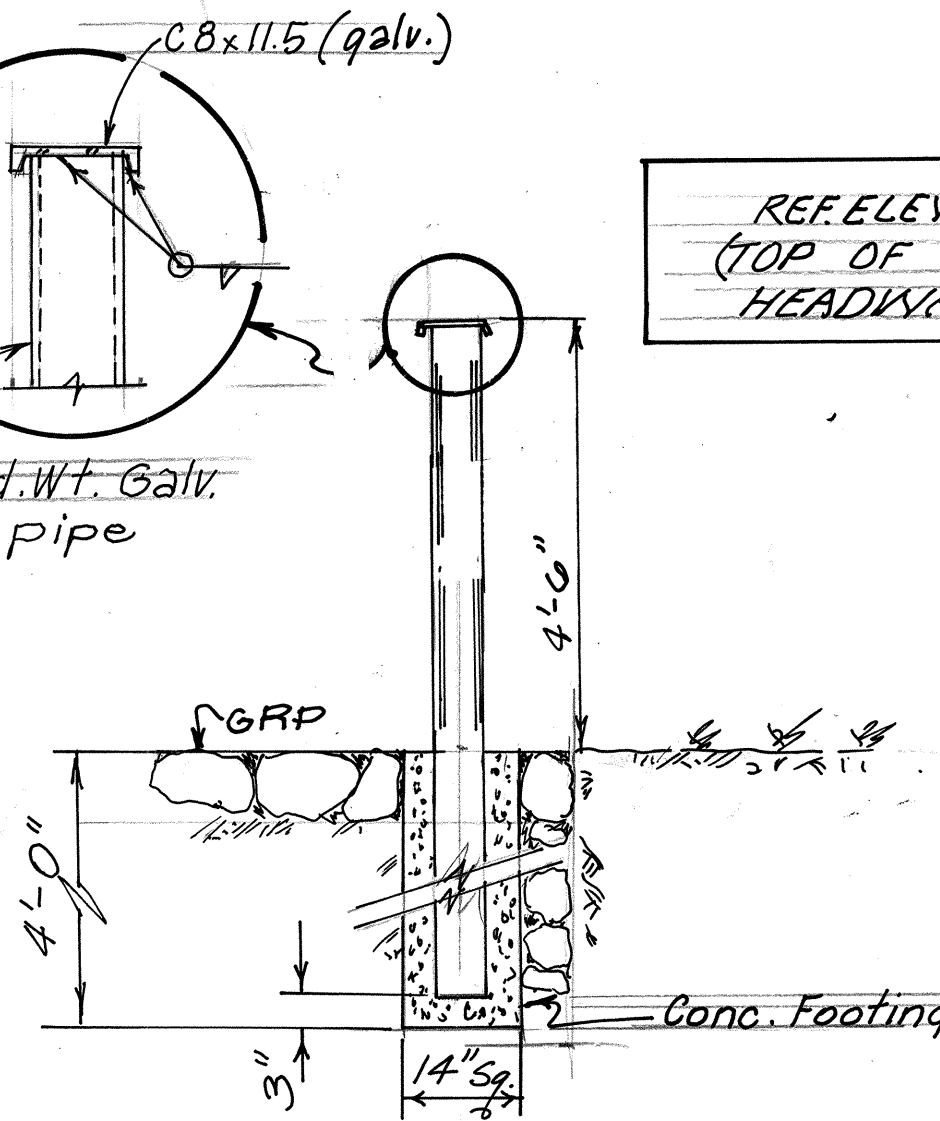


TRASH RACK DETAIL
Scale: 1/2" = 1'-0"

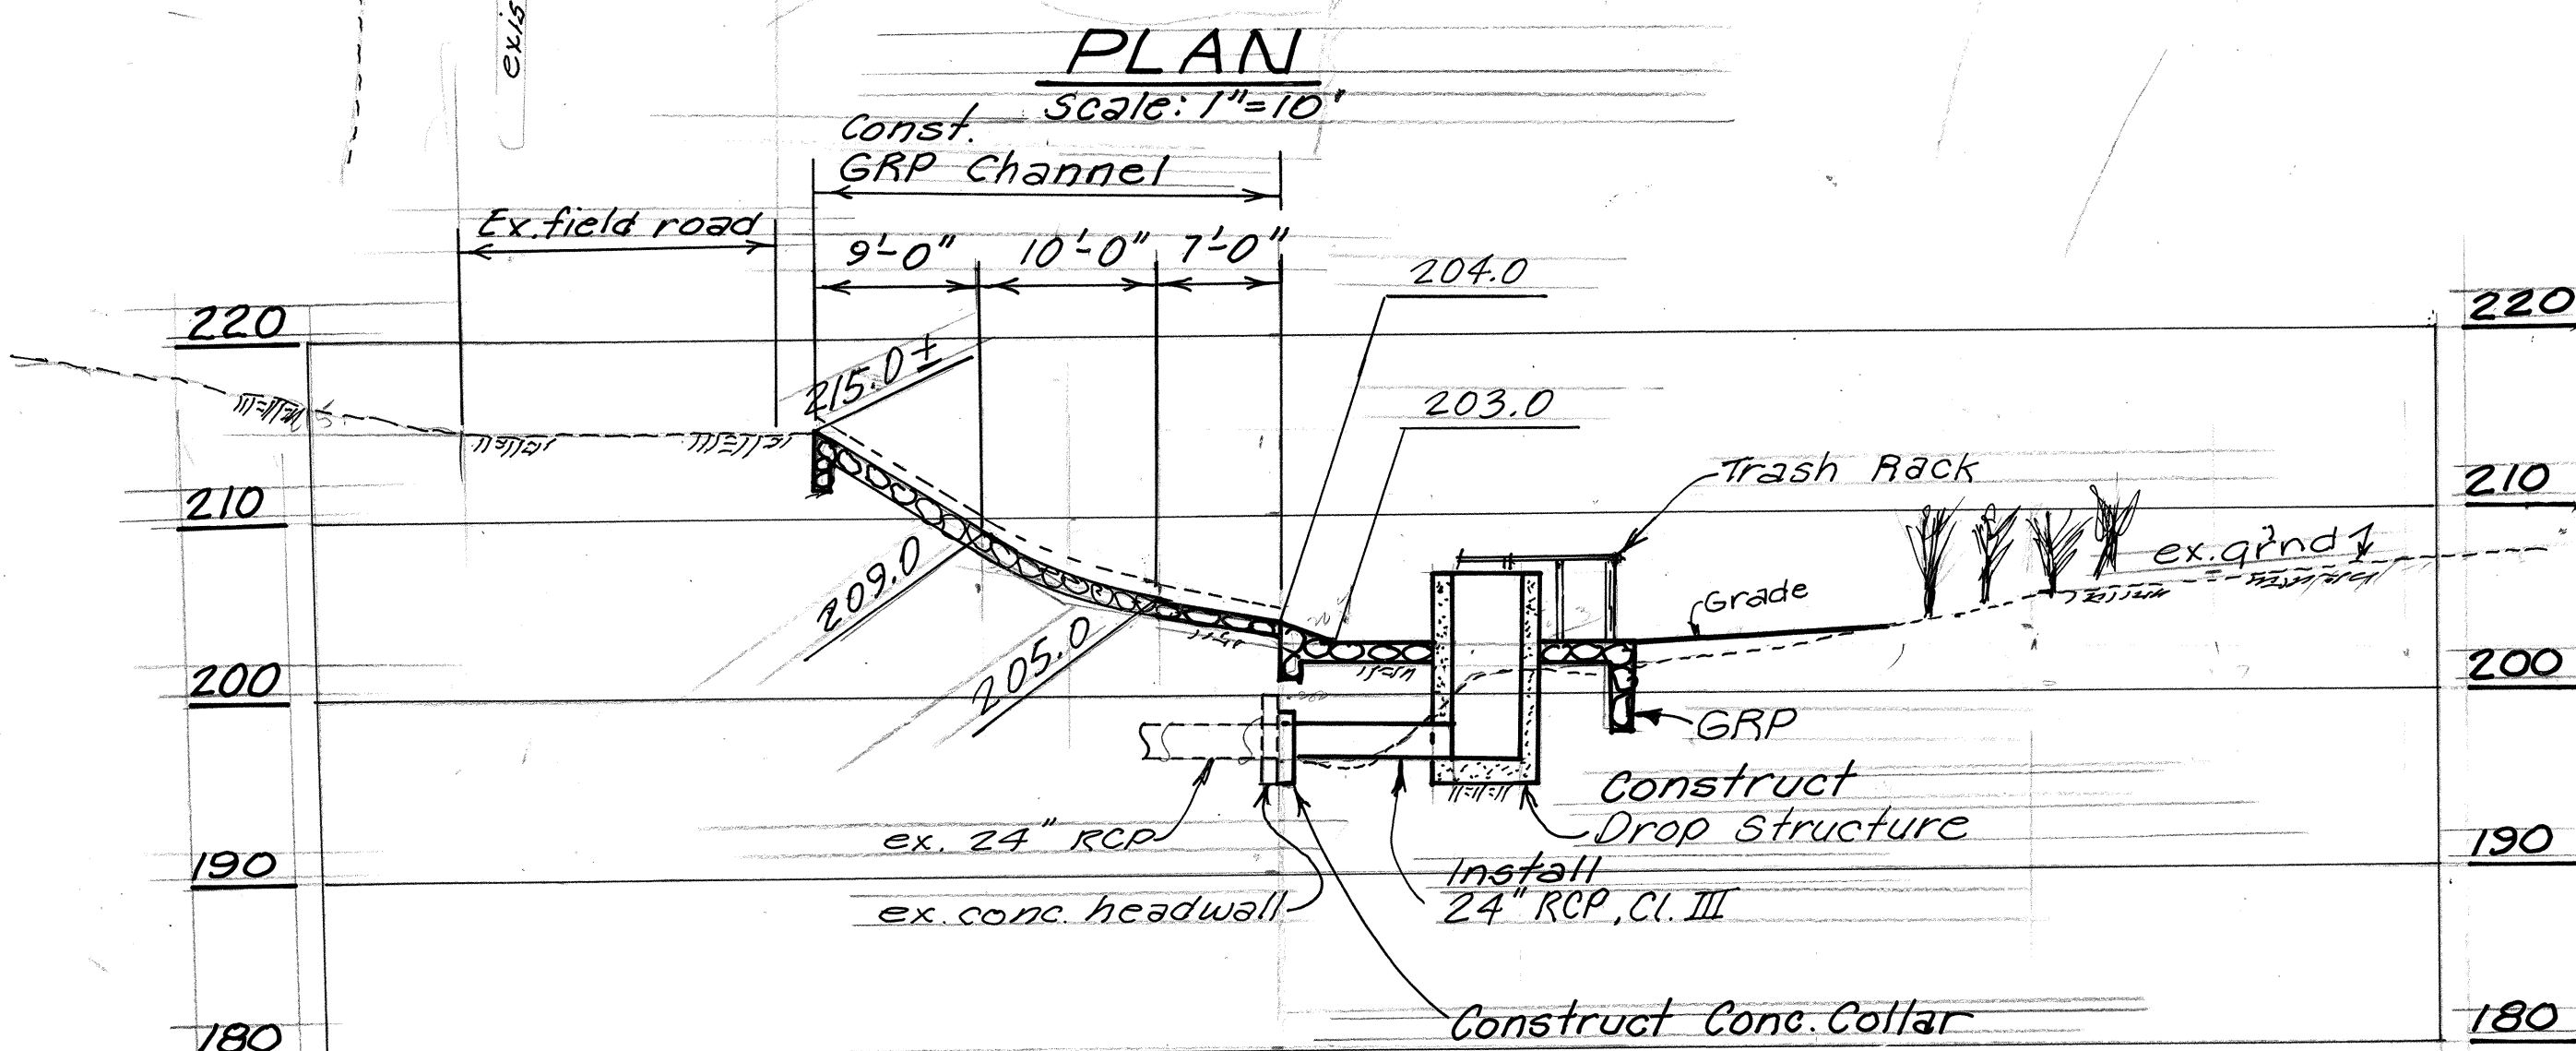

SECTION A
Scale: 1" = 10'

NOTE: REFERENCE ELEVATION IS
TOP OF EXISTING CONCRETE
HEADWALL. EL. = 200.00
THIS ELEV. IS AN ASSUMED
ELEV.

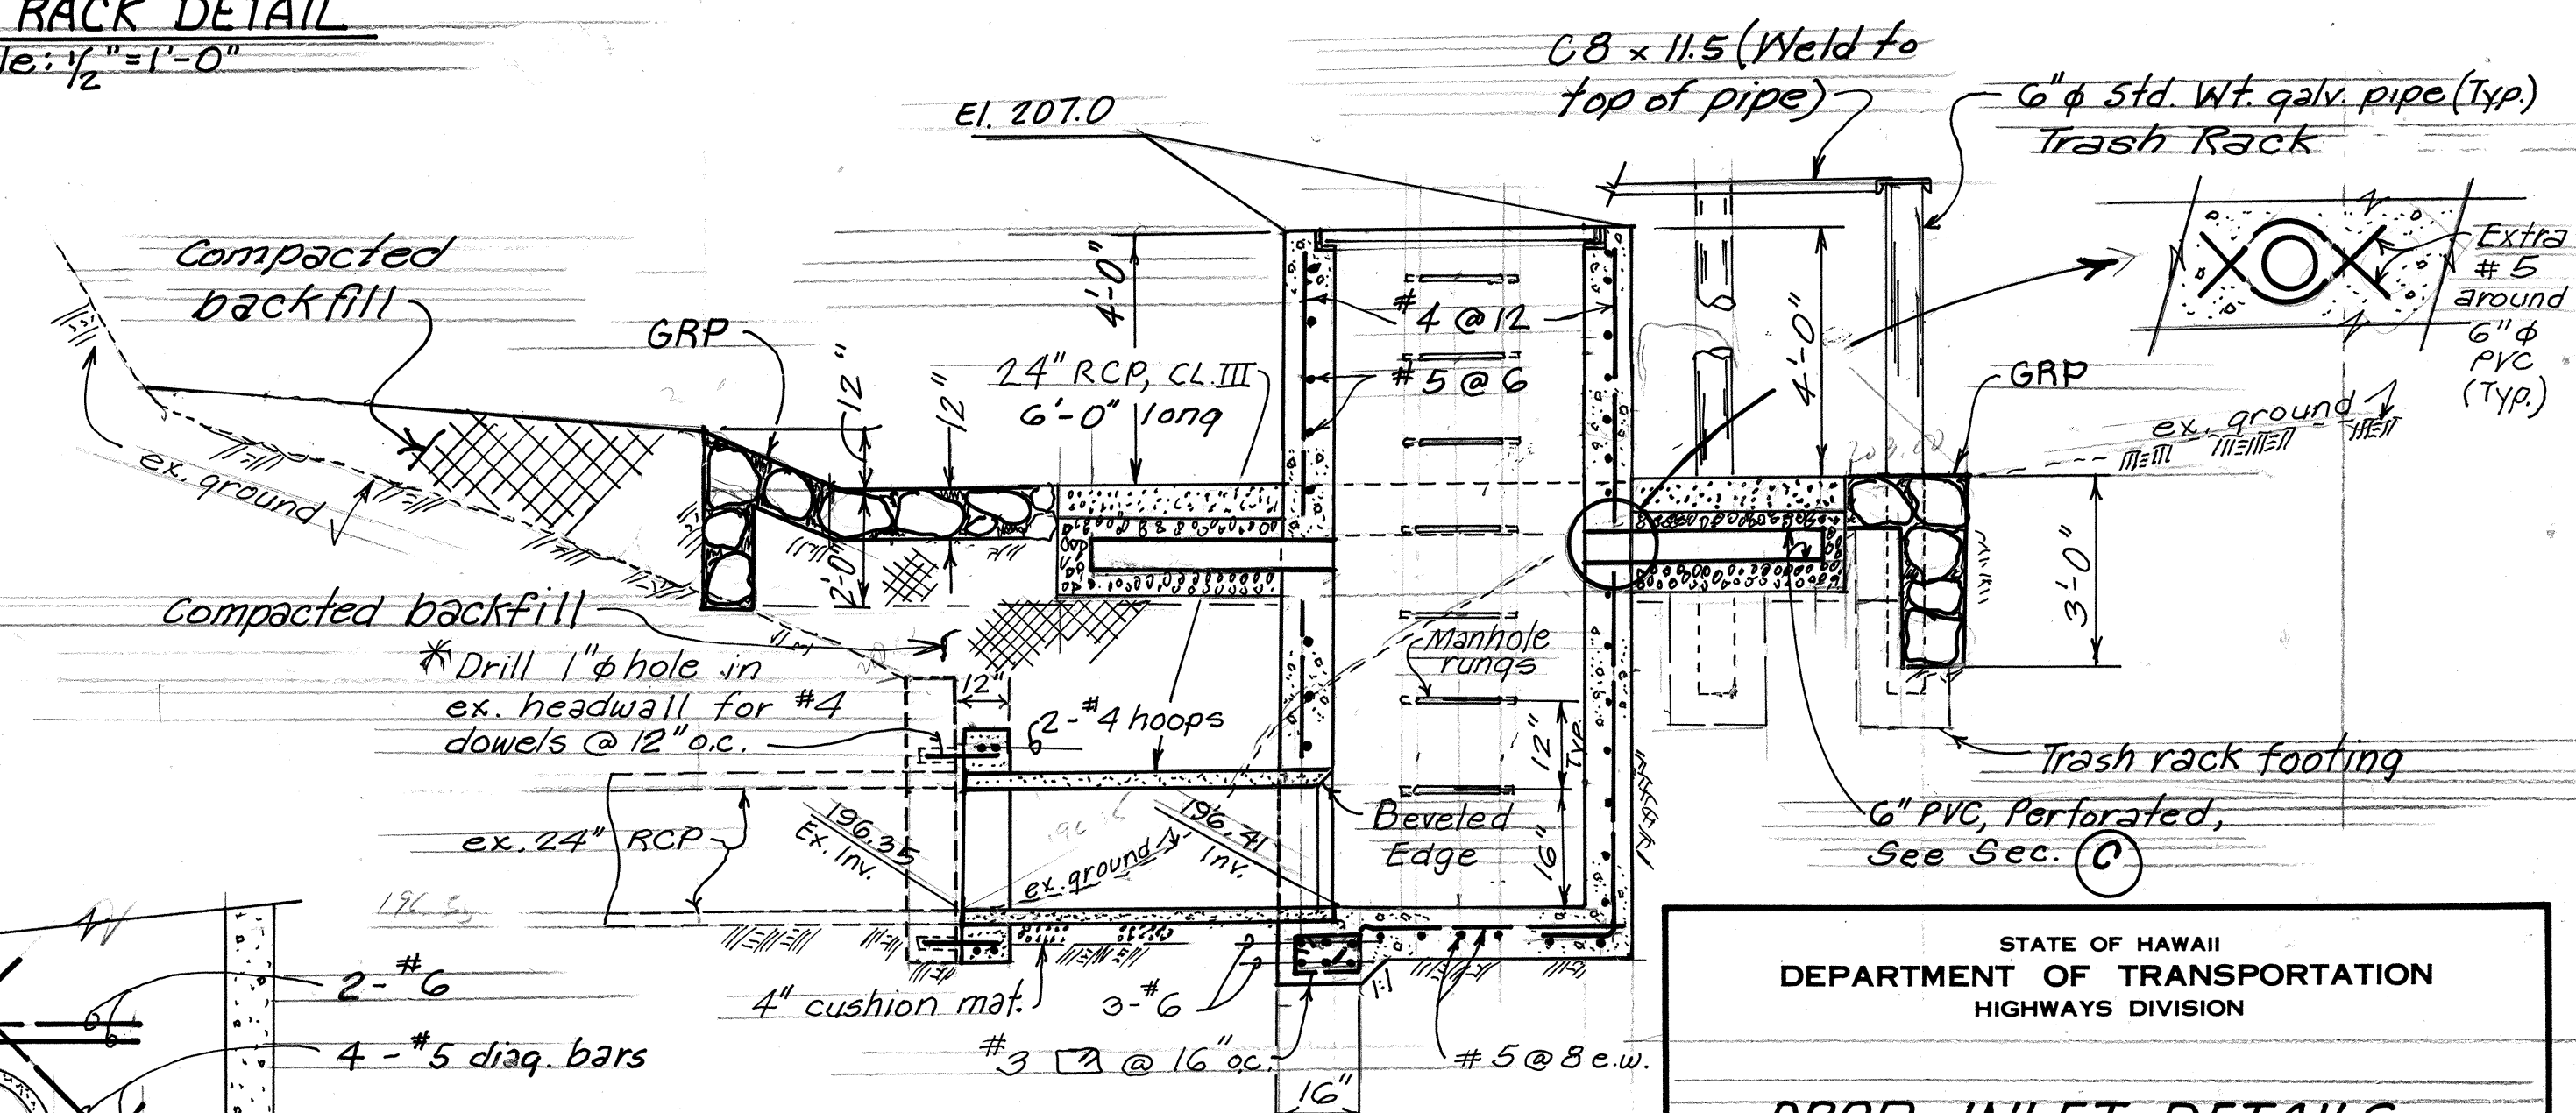

SECTION B
Scale: 3/8" = 1'-0"

ADDITIONAL REINF. @ CULVERT OP'NG
Scale: 3/8" = 1'-0"

STATE OF HAWAII
DEPARTMENT OF TRANSPORTATION
HIGHWAYS DIVISION

DROP INLET DETAILS

KAUAI HIGWAY
DRAINAGE IMPROVEMENTS AT
AT MILE MARKER 19.4+
PROJ. NO. 50B-02-92M
FEB. 1992

SHEET No. 1 OF 1 SHEETS

AS-BUILT