The second secon	INDEX TO DRAWINGS
SHEET NO.	DESCRIPTION
nemmenten a. valend similarises del hannos sistematik y accordina del sistematik sistematik valenda sistematik	TITLE SHEET
	STANDARD PLAN SUMMARY
<b>3</b>	GENERAL NOTES &
	MISCELLANEOUS DE TAILS
4	DROP INLET DETAILS
	The state of the s
and the second s	
No. Other	
Pooland	

587-2246 PHONE

JULIUS FRONDA P. S. & E. BY STATE OF HAWAII


DEPARTMENT OF TRANSPORTATION

HIGHWAYS DIVISION
HONOLULU, HAWAII
"AS-BUILT"
PLANS FOR

## KAUMUALII HIGHWAY DRAINAGE IMPROVEMENTS AT MILE MARKER 19.4


PROJECT NO. 50B-02-92M

DISTRICT OF WAIMEA
ISLAND OF KAUAI

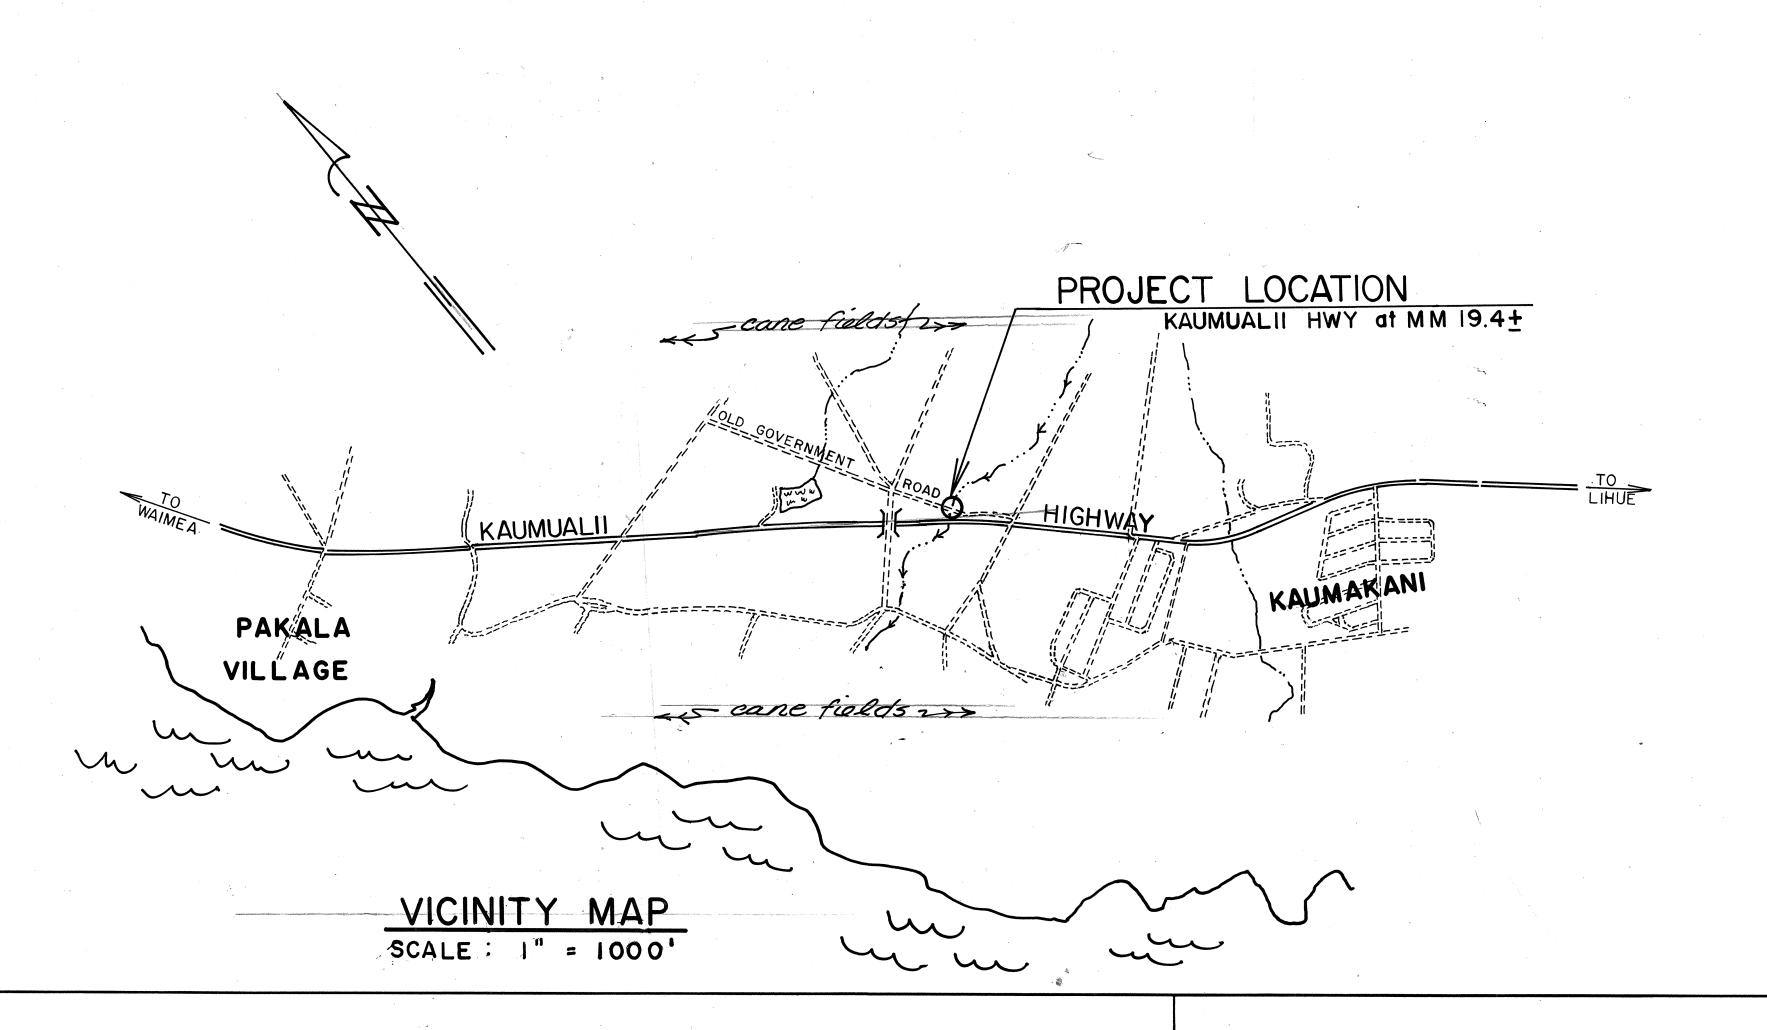

FED. ROAD DIST. NO. STATE PROJ. NO. FISCAL SHEET NO. SHEETS

HAWAII HAW. 50B-02-92M 1992 1 4

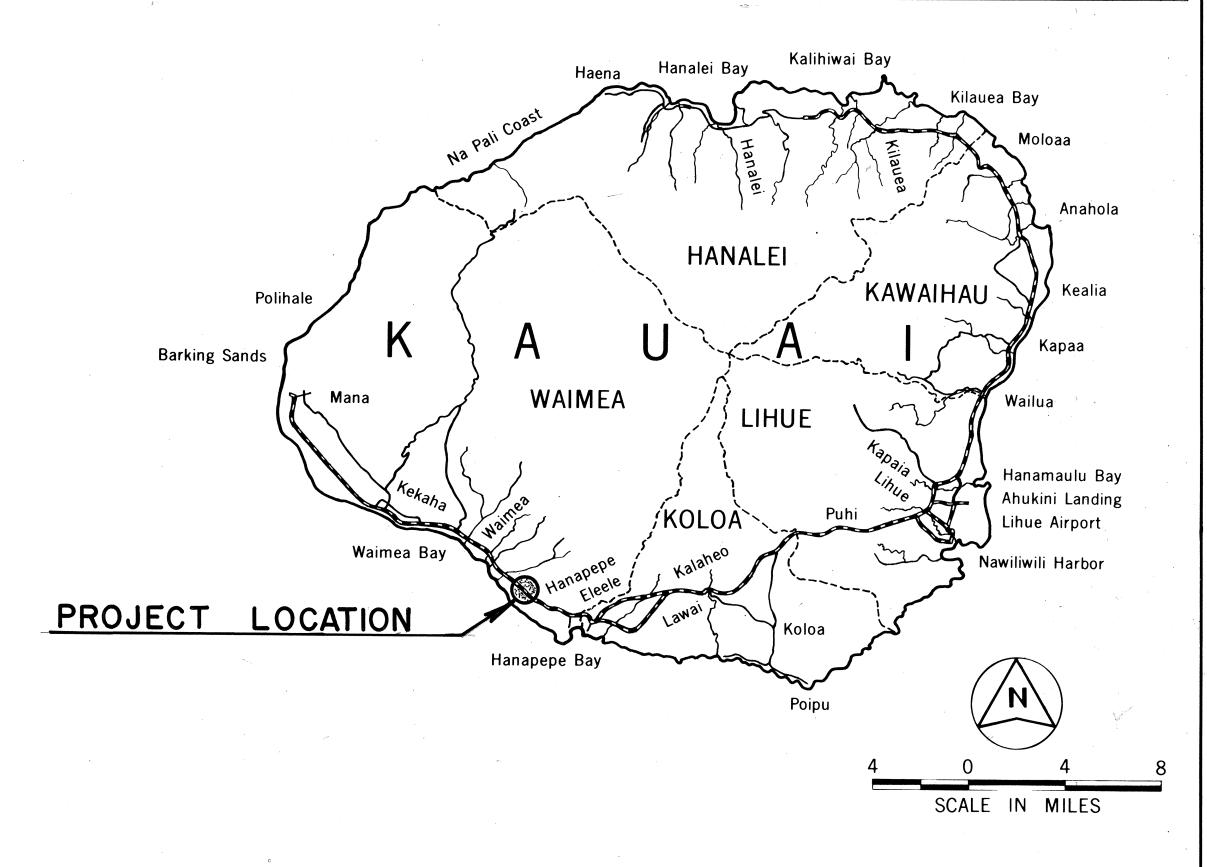

FEDERAL AID PROJECTS PREVIOUSLY CONSTRUCTED
OR UNDER CONSTRUCTION

AT MILE POST 19.4

NO SIGNIFICANT CHANGES WERE MADE DURING CONSTRUCTION ON THESE PLANS EXCEPT CHANGES IN THE ORIGINAL THEORETICAL QUANTITIES. FOR ACTUAL QUANTITIES, REFER TO PROJECT LEDGER AND/OR COMPUTATION BOOK.

RESIDENT ENGINEER

3/15/93 DATE

DEPARTMENT OF TRANSPORTATION
STATE OF HAWAII

APPROVED:

4/9/92

TOTAL DIR. OF TRANSPORTATION

DATE