·	INDEX TO DRAWINGS
SHEET NO.	DESCRIPTION
1	TITLE SHEET
.2	STANDARD PLAN SUMMARY
3	GENERAL NOTES AND DETAILS
4	WAIMEA BRIDGE REPAIRS AND ESTIMATED QUANTITIES
5	HANAPEPE BRIDGE AND LAWAI BRIDGE REPAIRS
4	

MAY, 1992 DATE

587-2250 PHONE

KASAMOTO P. S. & E. BY

STATE OF HAWAII

DEPARTMENT OF TRANSPORTATION


HIGHWAYS DIVISION HONOLULU, HAWAII


"AS-BUILT"

PLANS FOR

KAUMUALII HIGHWAY REPAIR SPALLS WAIMEA, HANAPEPE AND LAWAI BRIDGES PROJECT NO. 50BC-01-92M

> DISTRICTS OF WAIMEA AND KOLOA ISLAND OF KAUAI

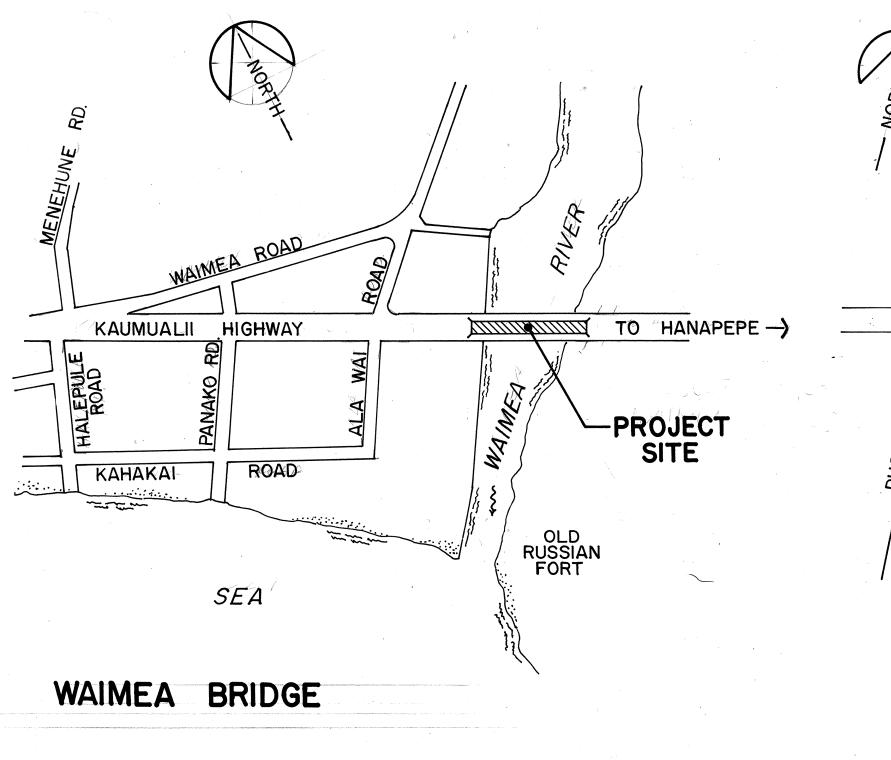

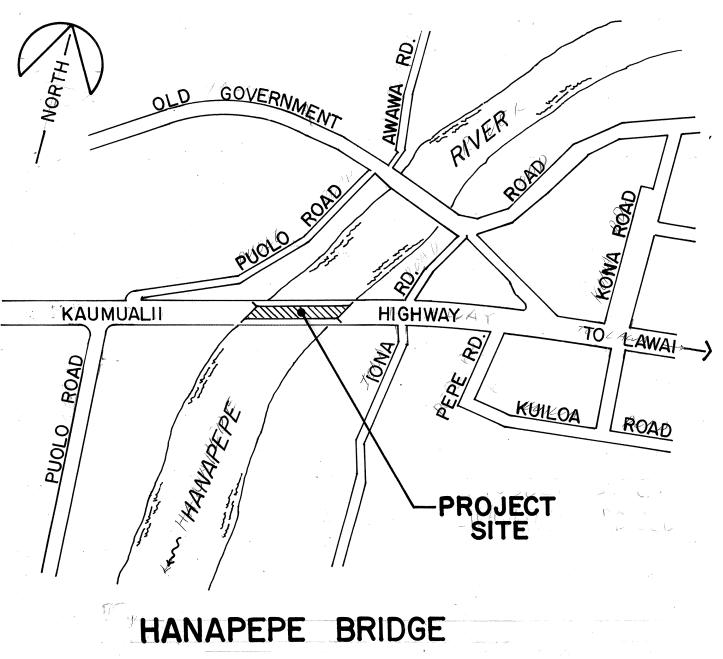



LAYOUT OF PROJECT

1000 FEET


FED. ROAD DIST. NO. FISCAL SHEET YEAR NO. PROJ. NO. 50BC-01-92M 1992



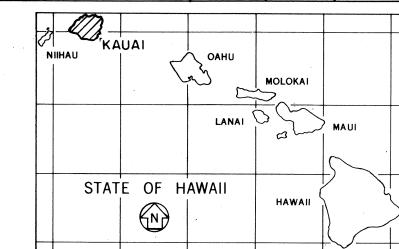

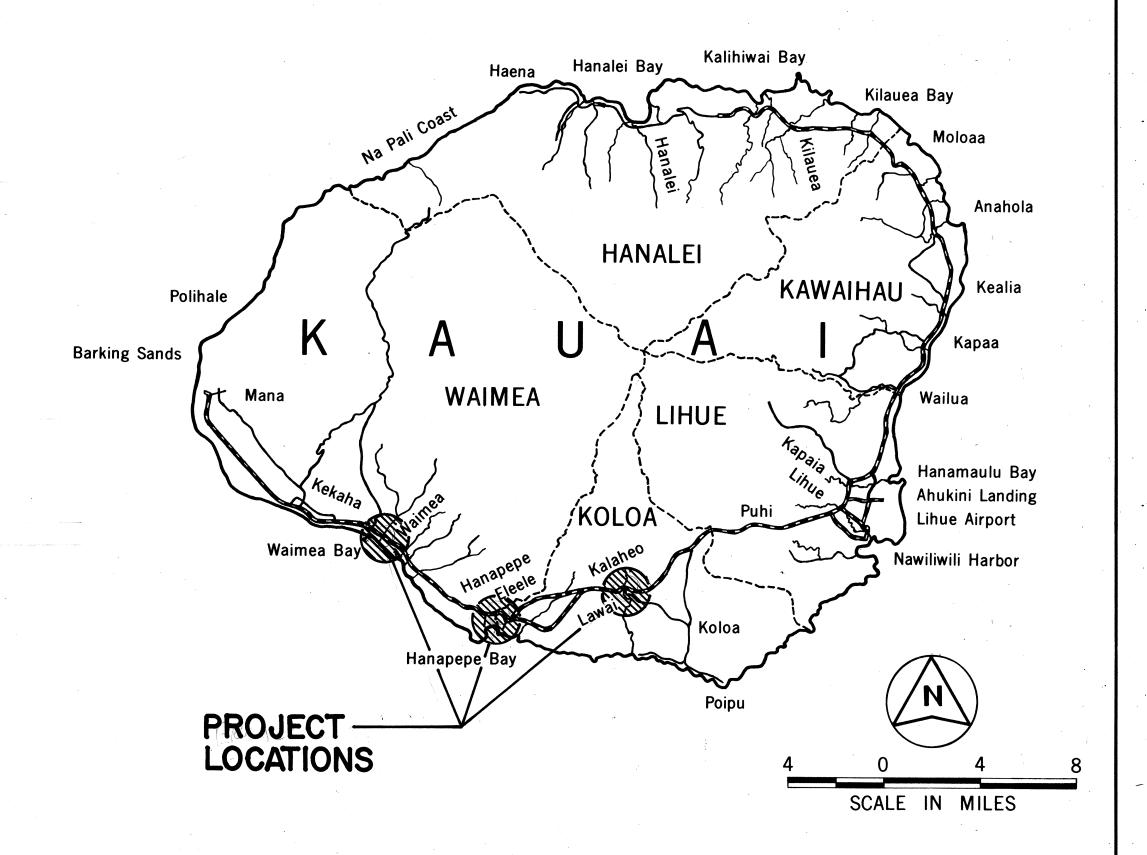

FEDERAL AID PROJECTS PREVIOUSLY CONSTRUCTED OR UNDER CONSTRUCTION

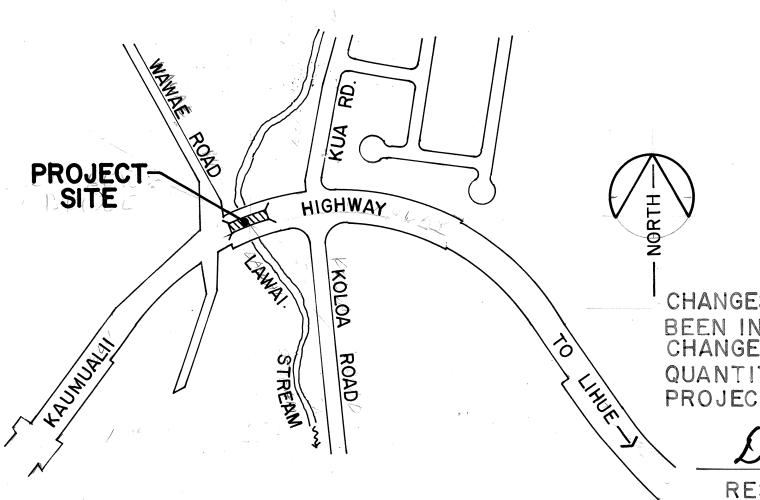

QUANTITIES. FOR ACTUAL QUANTITIES, REFER TO PROJECT LEDGER AND/OR COMPUTATION BOOK.

Donne H March RESIDENT ENGINEER

6/9/93 DATE

LAWAI BRIDGE

DEPARTMENT OF TRANSPORTATION STATE OF HAWAII APPROVED: