

[illegible]

STATE OF HAWAII

DEPARTMENT OF TRANSPORTATION

HIGHWAYS DIVISION

"AS-BUILT"



PLANS FOR

ROUTE 50: KAUMUALII HIGHWAY

GUARDRAIL AND SHOULDER IMPROVEMENTS

AT VARIOUS LOCATIONS

FEDERAL AID PROJECT NO. STP-050-1(12)

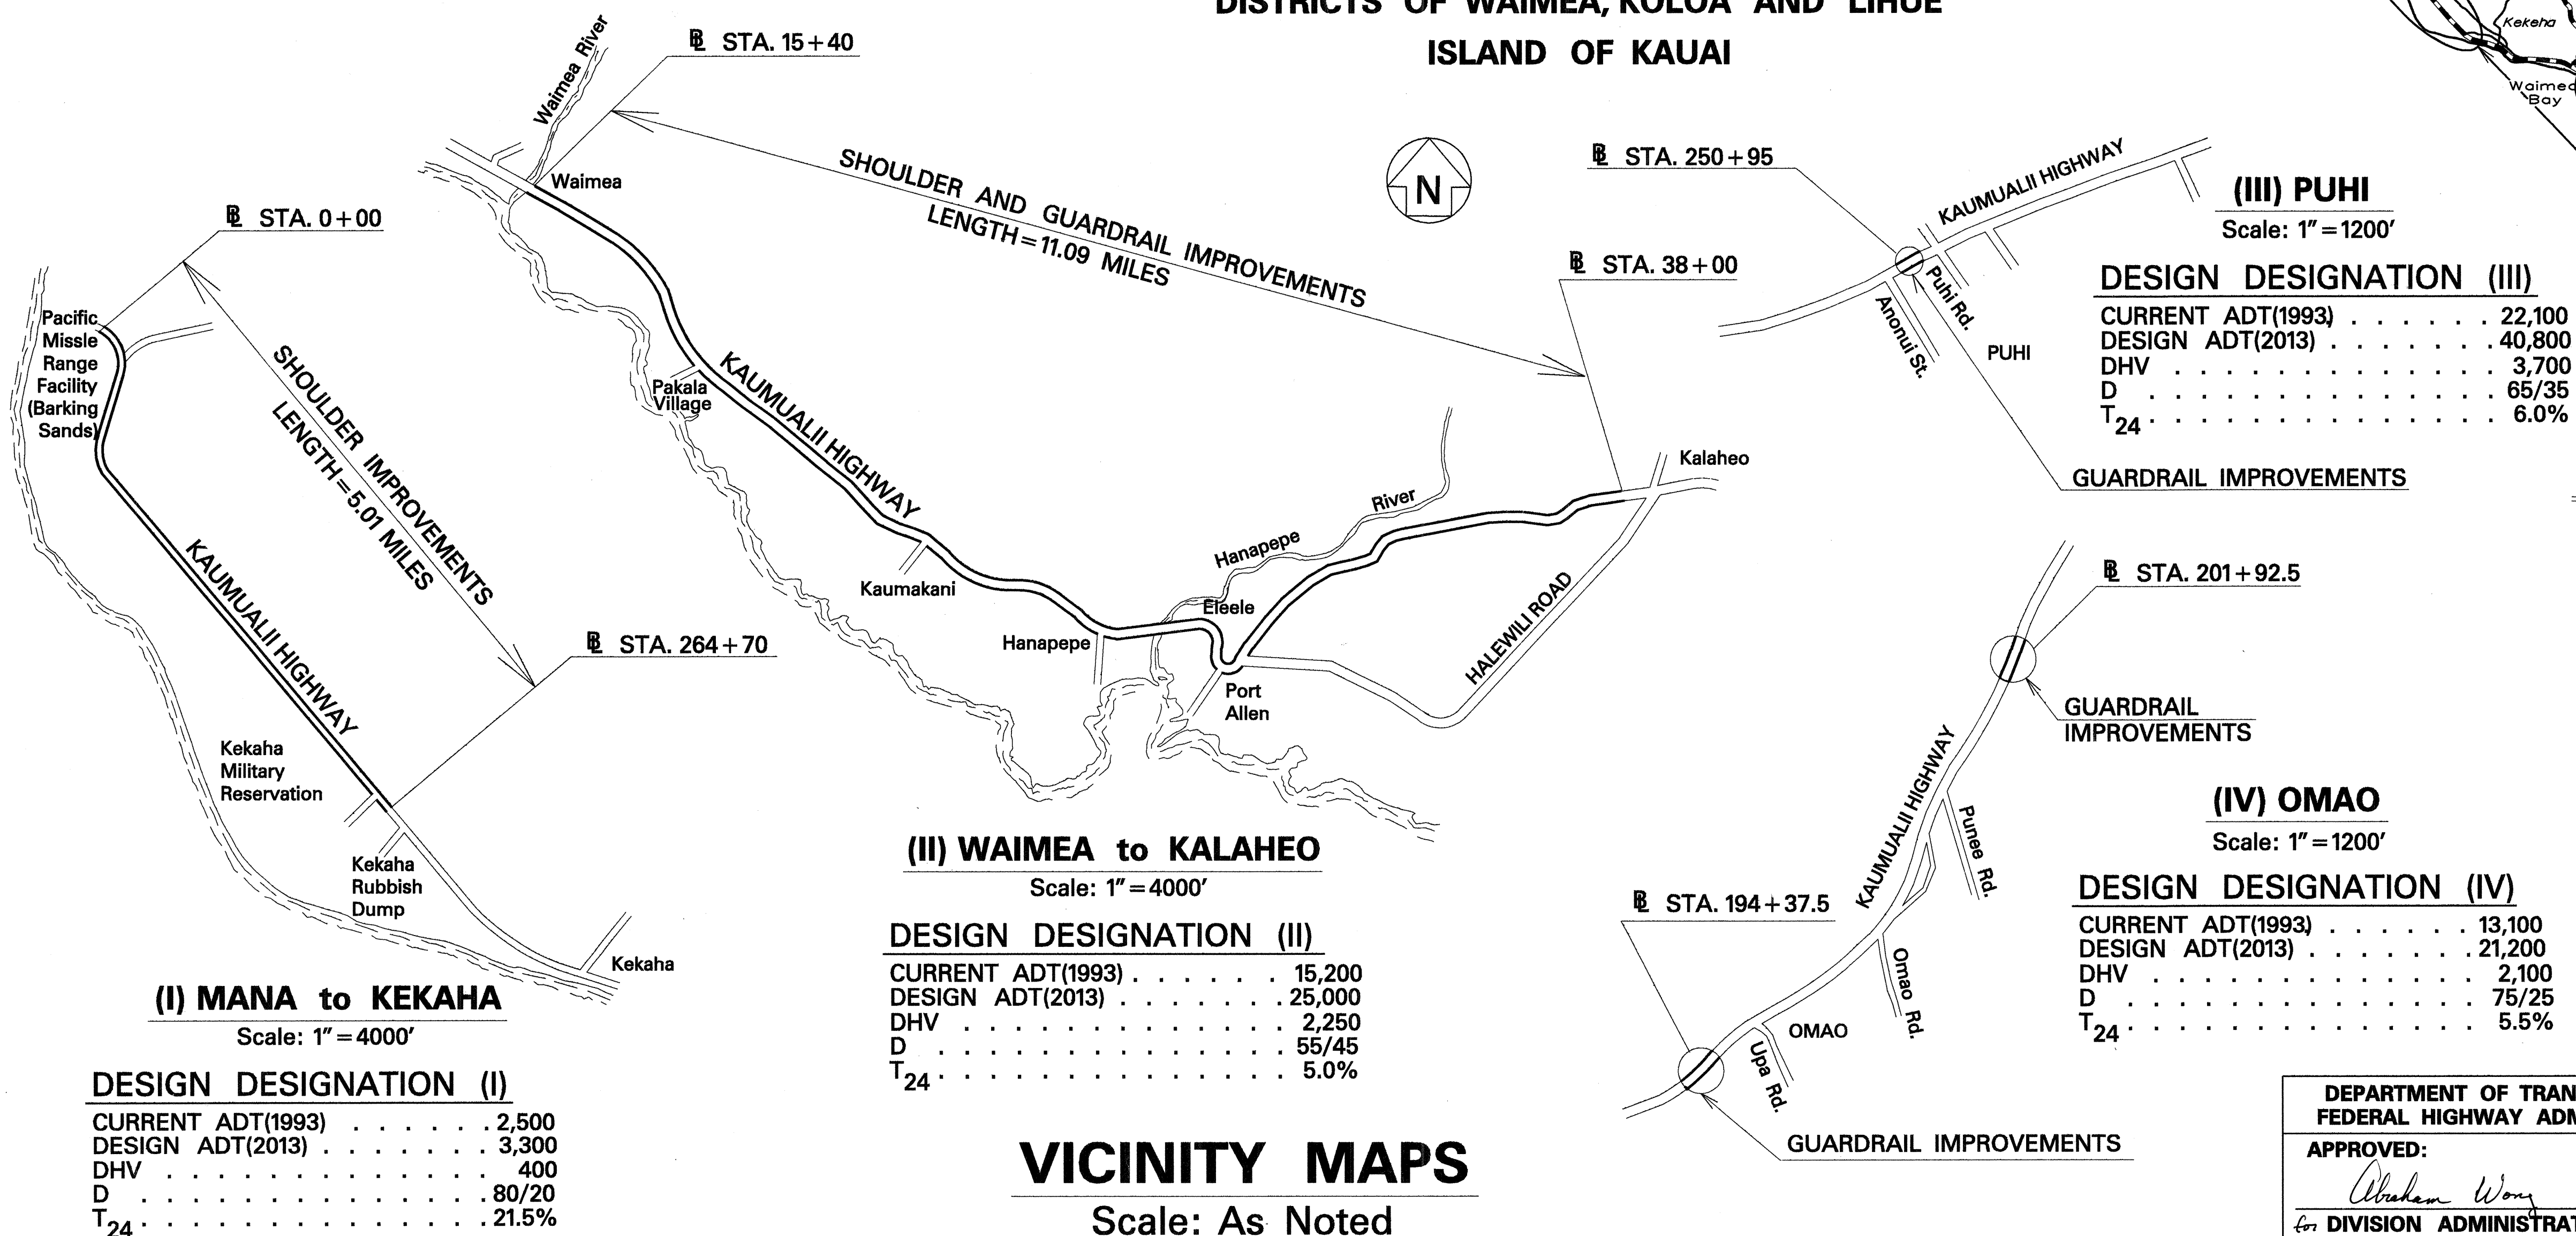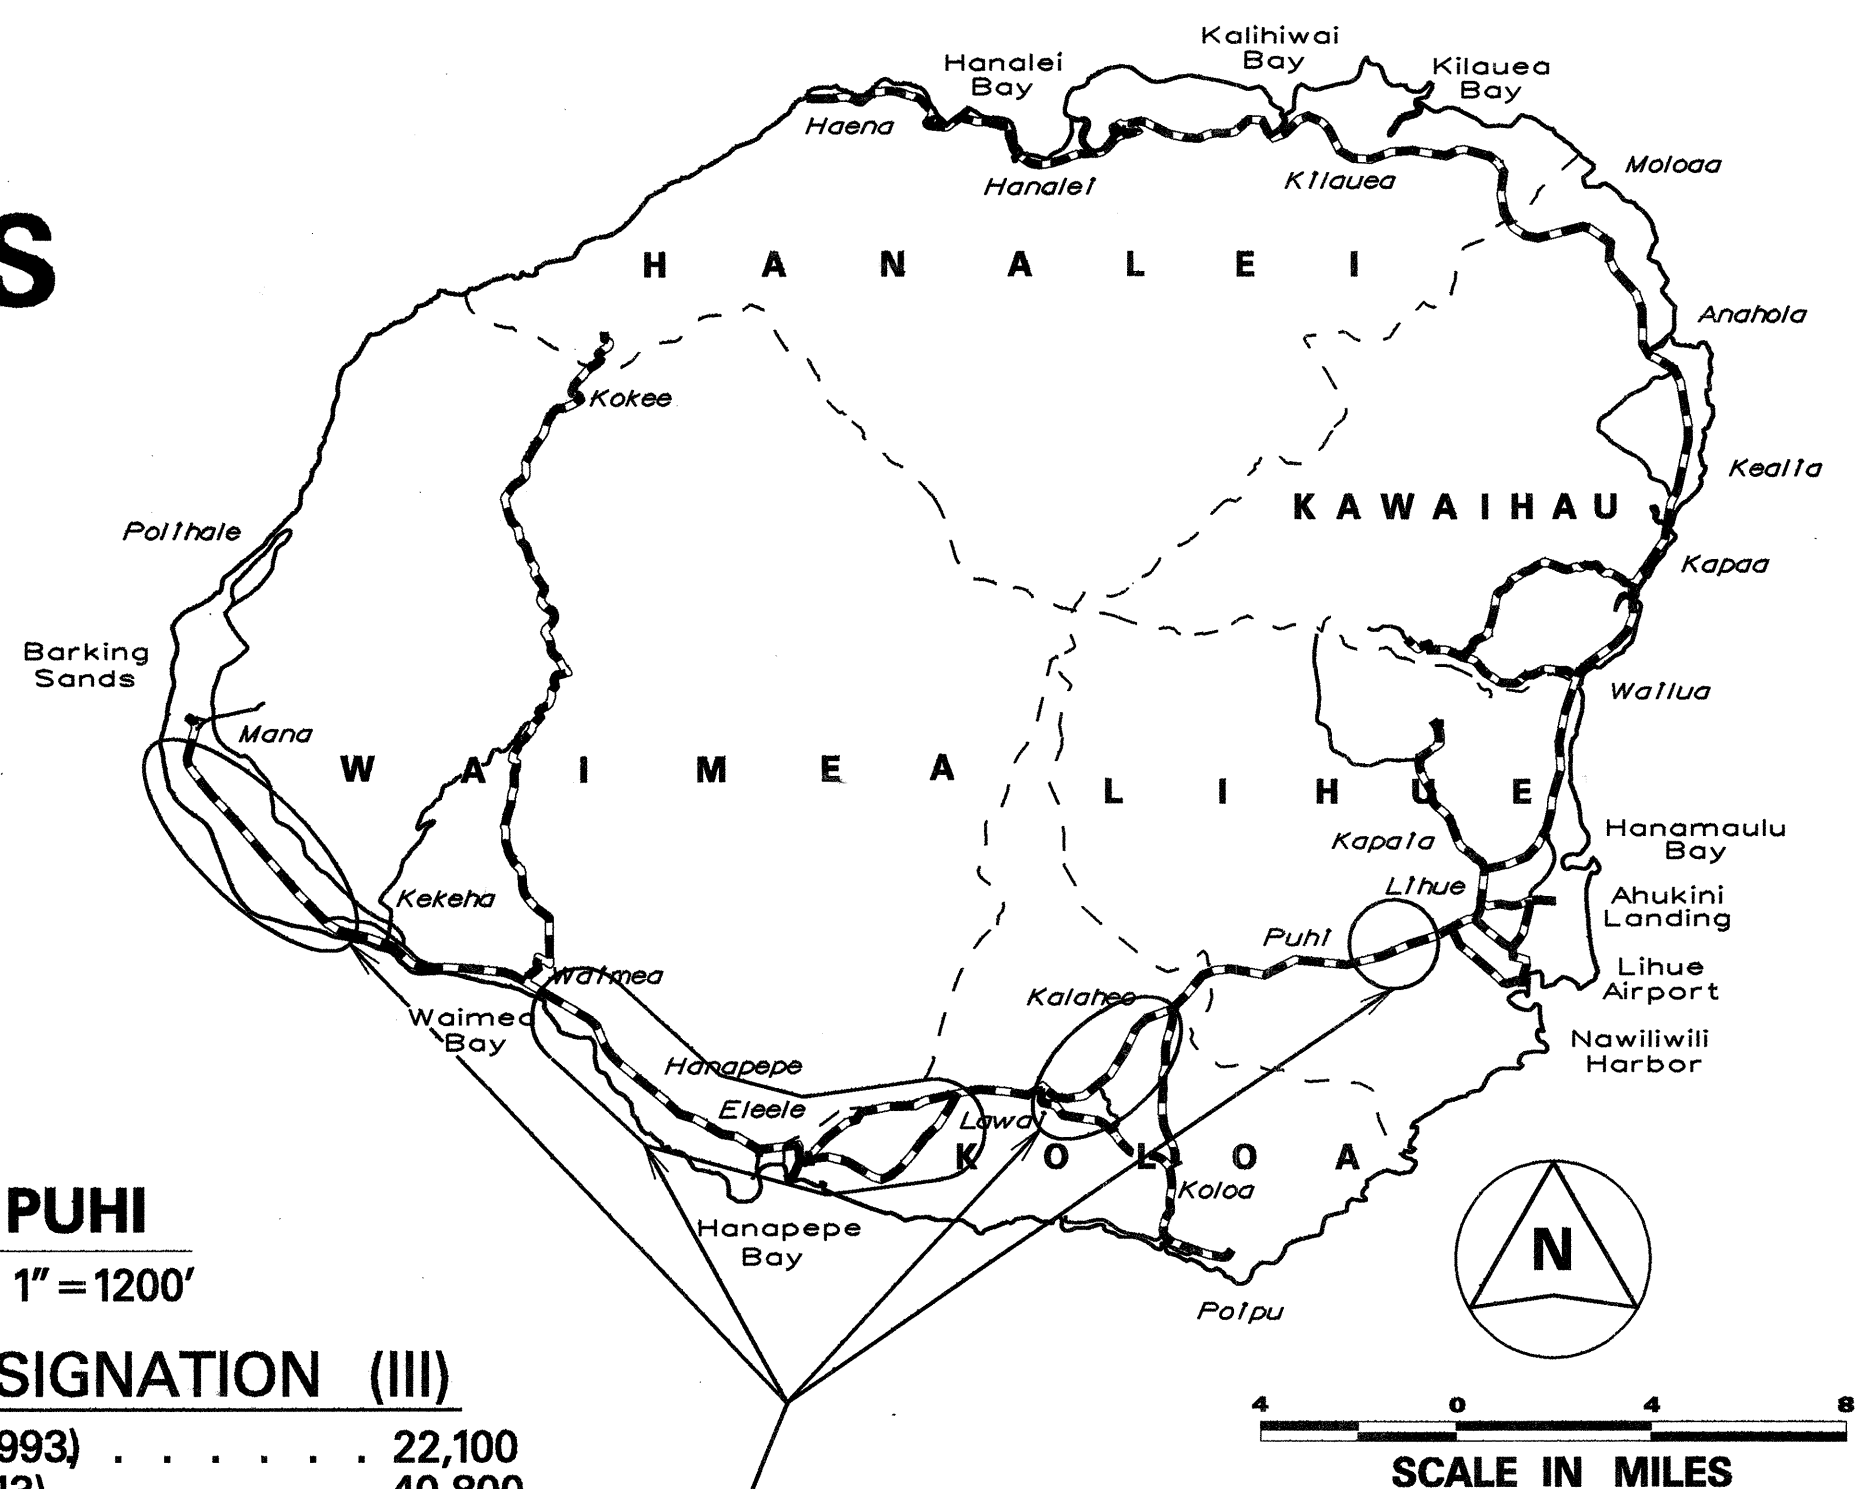

MILE POST 32.99 TO MILE POST 23.48

MILE POST 22.53 TO MILE POST 12.42

10 **11** **12** **13** **474**

MILE POST 8.00

MILE POST 1.87

CHANGES MADE DURING CONSTRUCTION HAVE
BEEN NOTED ON THESE PLANS AND CHECKED BY:

Donal H. Maeda 1/8/96

RESIDENT ENGINEER DATE

DEPARTMENT OF TRANSPORTATION
FEDERAL HIGHWAY ADMINISTRATION

APPROVED:

Abraham Wong 3/8/93
for **DIVISION ADMINISTRATOR** **DATE**

**DEPARTMENT OF TRANSPORTATION
STATE OF HAWAII**

APPROVED:

FOR A. H. H. H. H. H. 3/2/93
DIR. OF TRANSPORTATION DATE

KAUAI DISTRICT _____ JULIUS B. FRONDA 587-2246 _____ SEPT. 1992
DESIGNED BY _____ P. S. & E. BY _____ PHONE _____ DATE _____