



FED. ROAD DIST. NO.	STATE	FED. AID PROJ. NO.	FISCAL YEAR	SHEET NO.	TOTAL SHEETS
HAWAII	HAW.	STP 050-1 (II)	1993	6	12

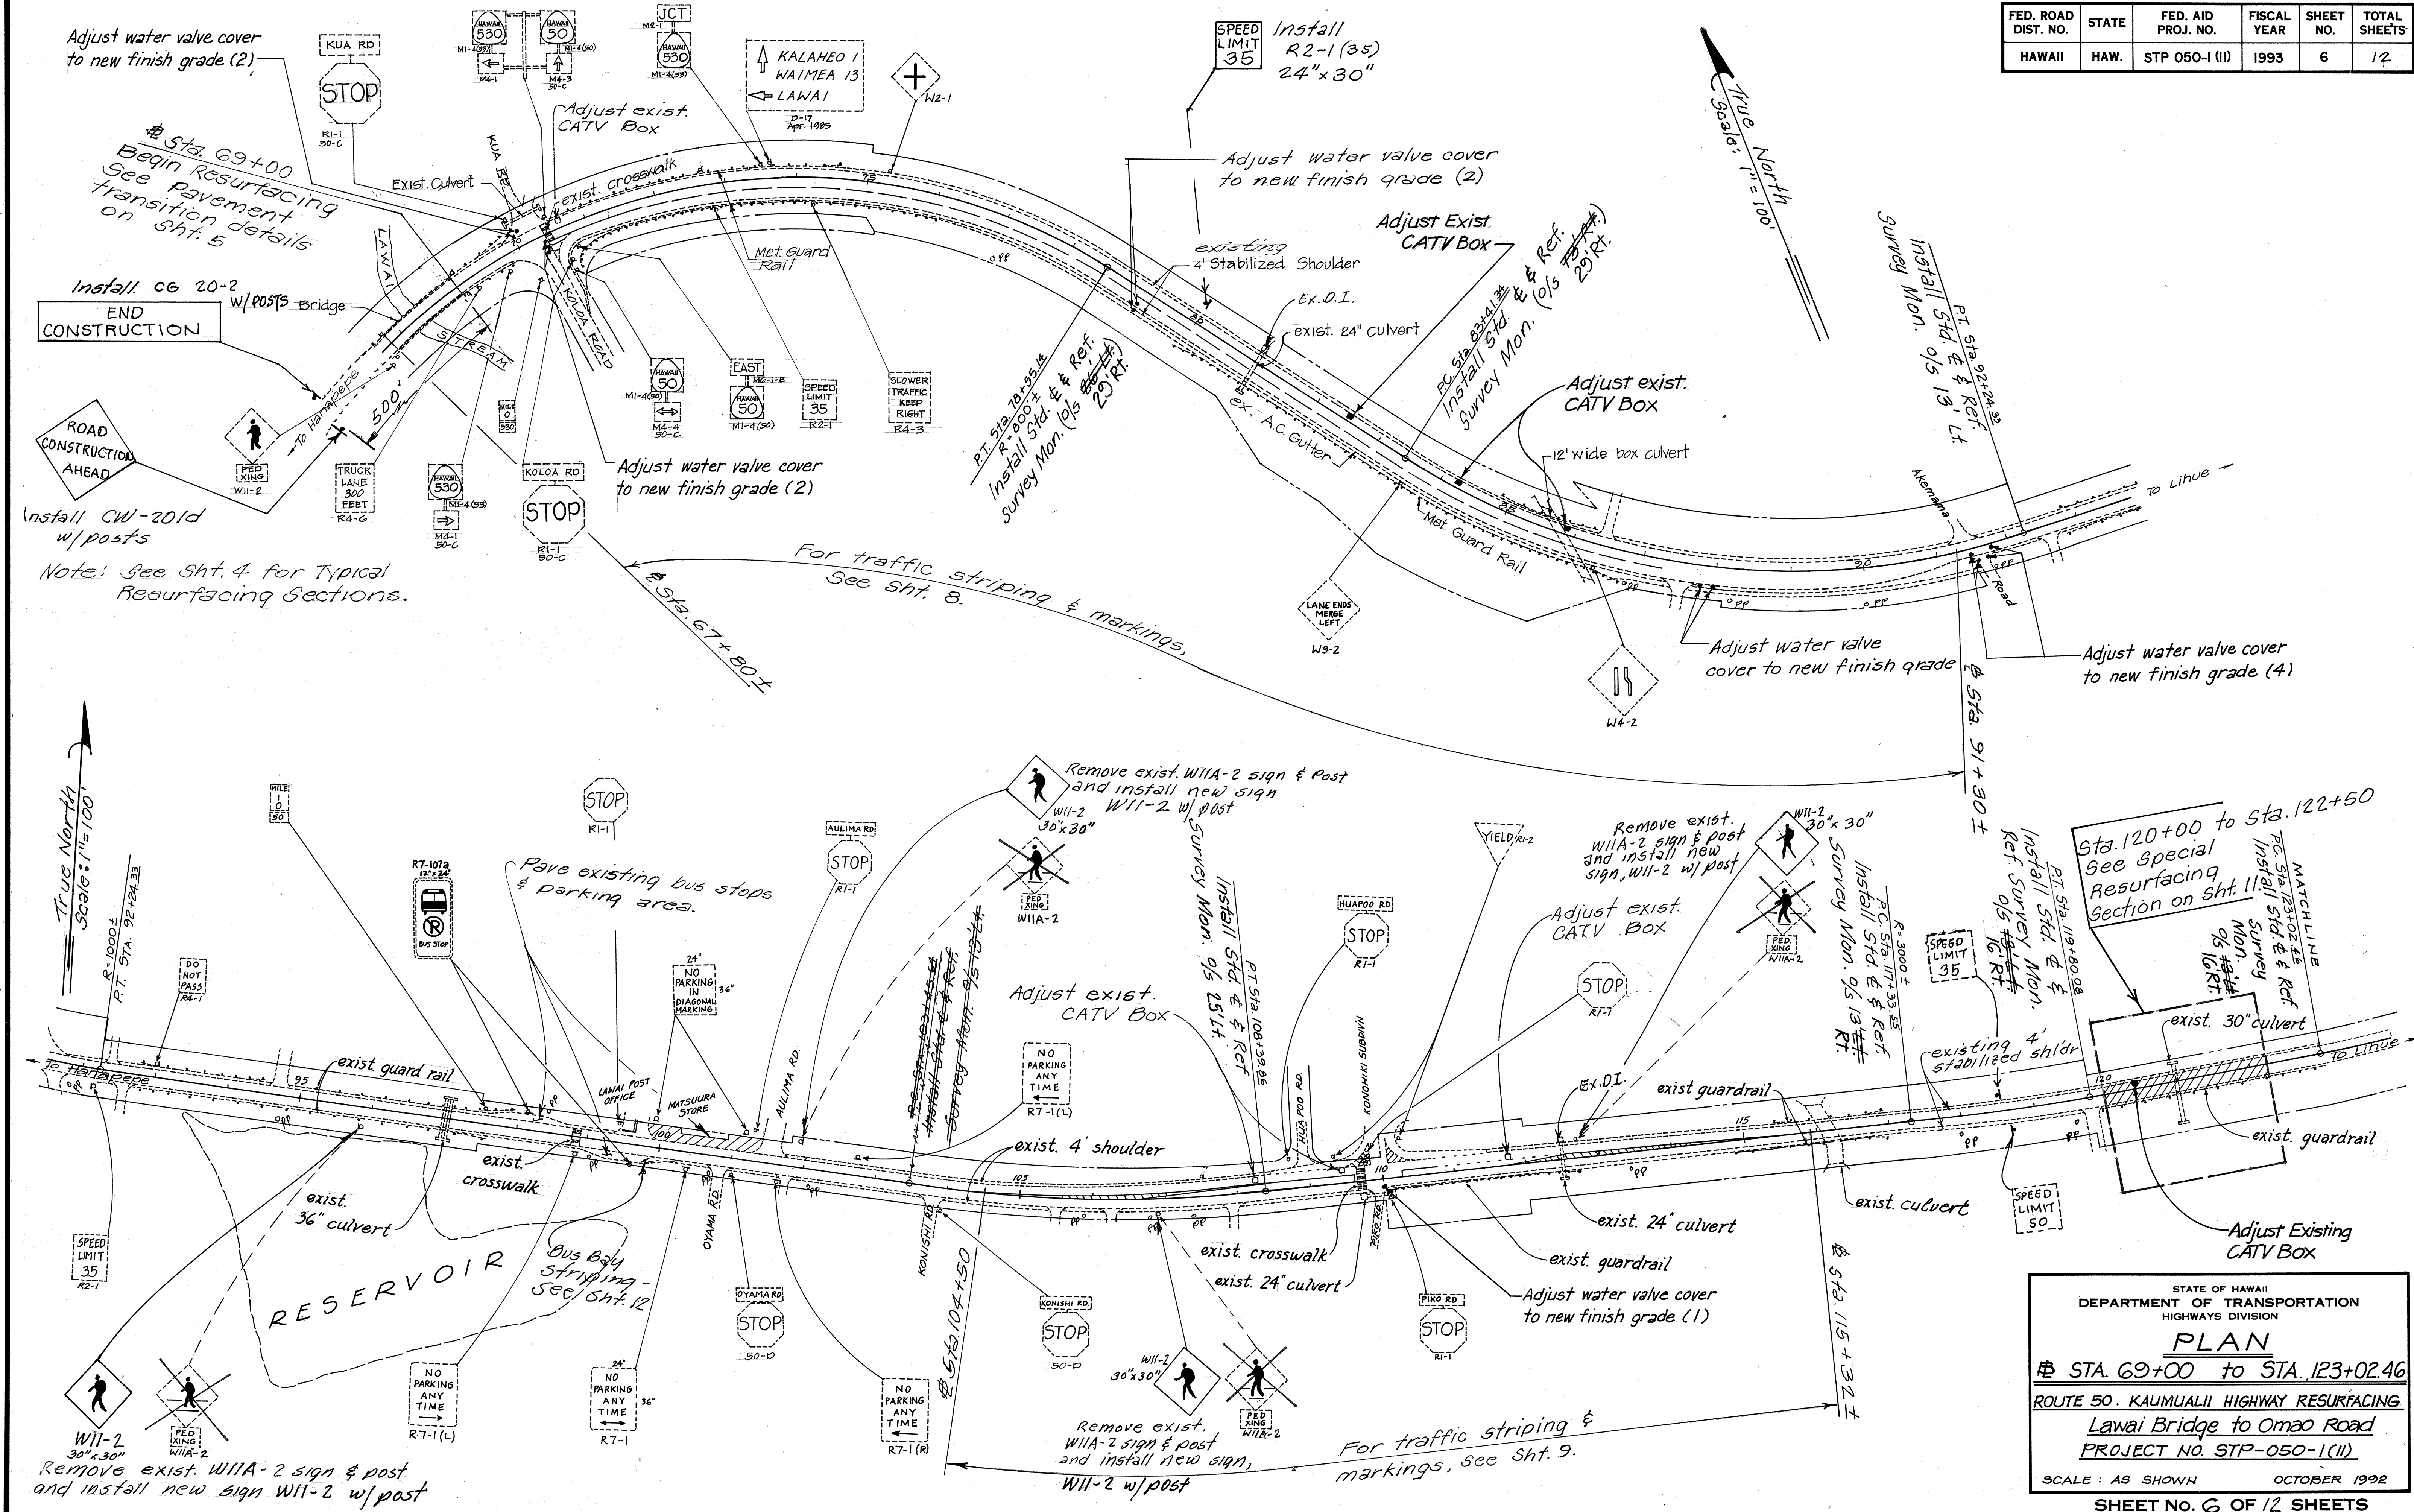

DATE	_____
SURVEY PLOTTED BY	_____
PLAN	_____
DRAWN BY	_____
DESIGNED BY	_____
CHECKED BY	_____
ORIGINAL	_____
NO.	_____

FED. ROAD DIST. NO.	STATE	FED. AID PROJ. NO.	FISCAL YEAR	SHEET NO.	TOTAL SHEETS
HAWAII	HAW.	STP 050-1 (11)	1993	7	12

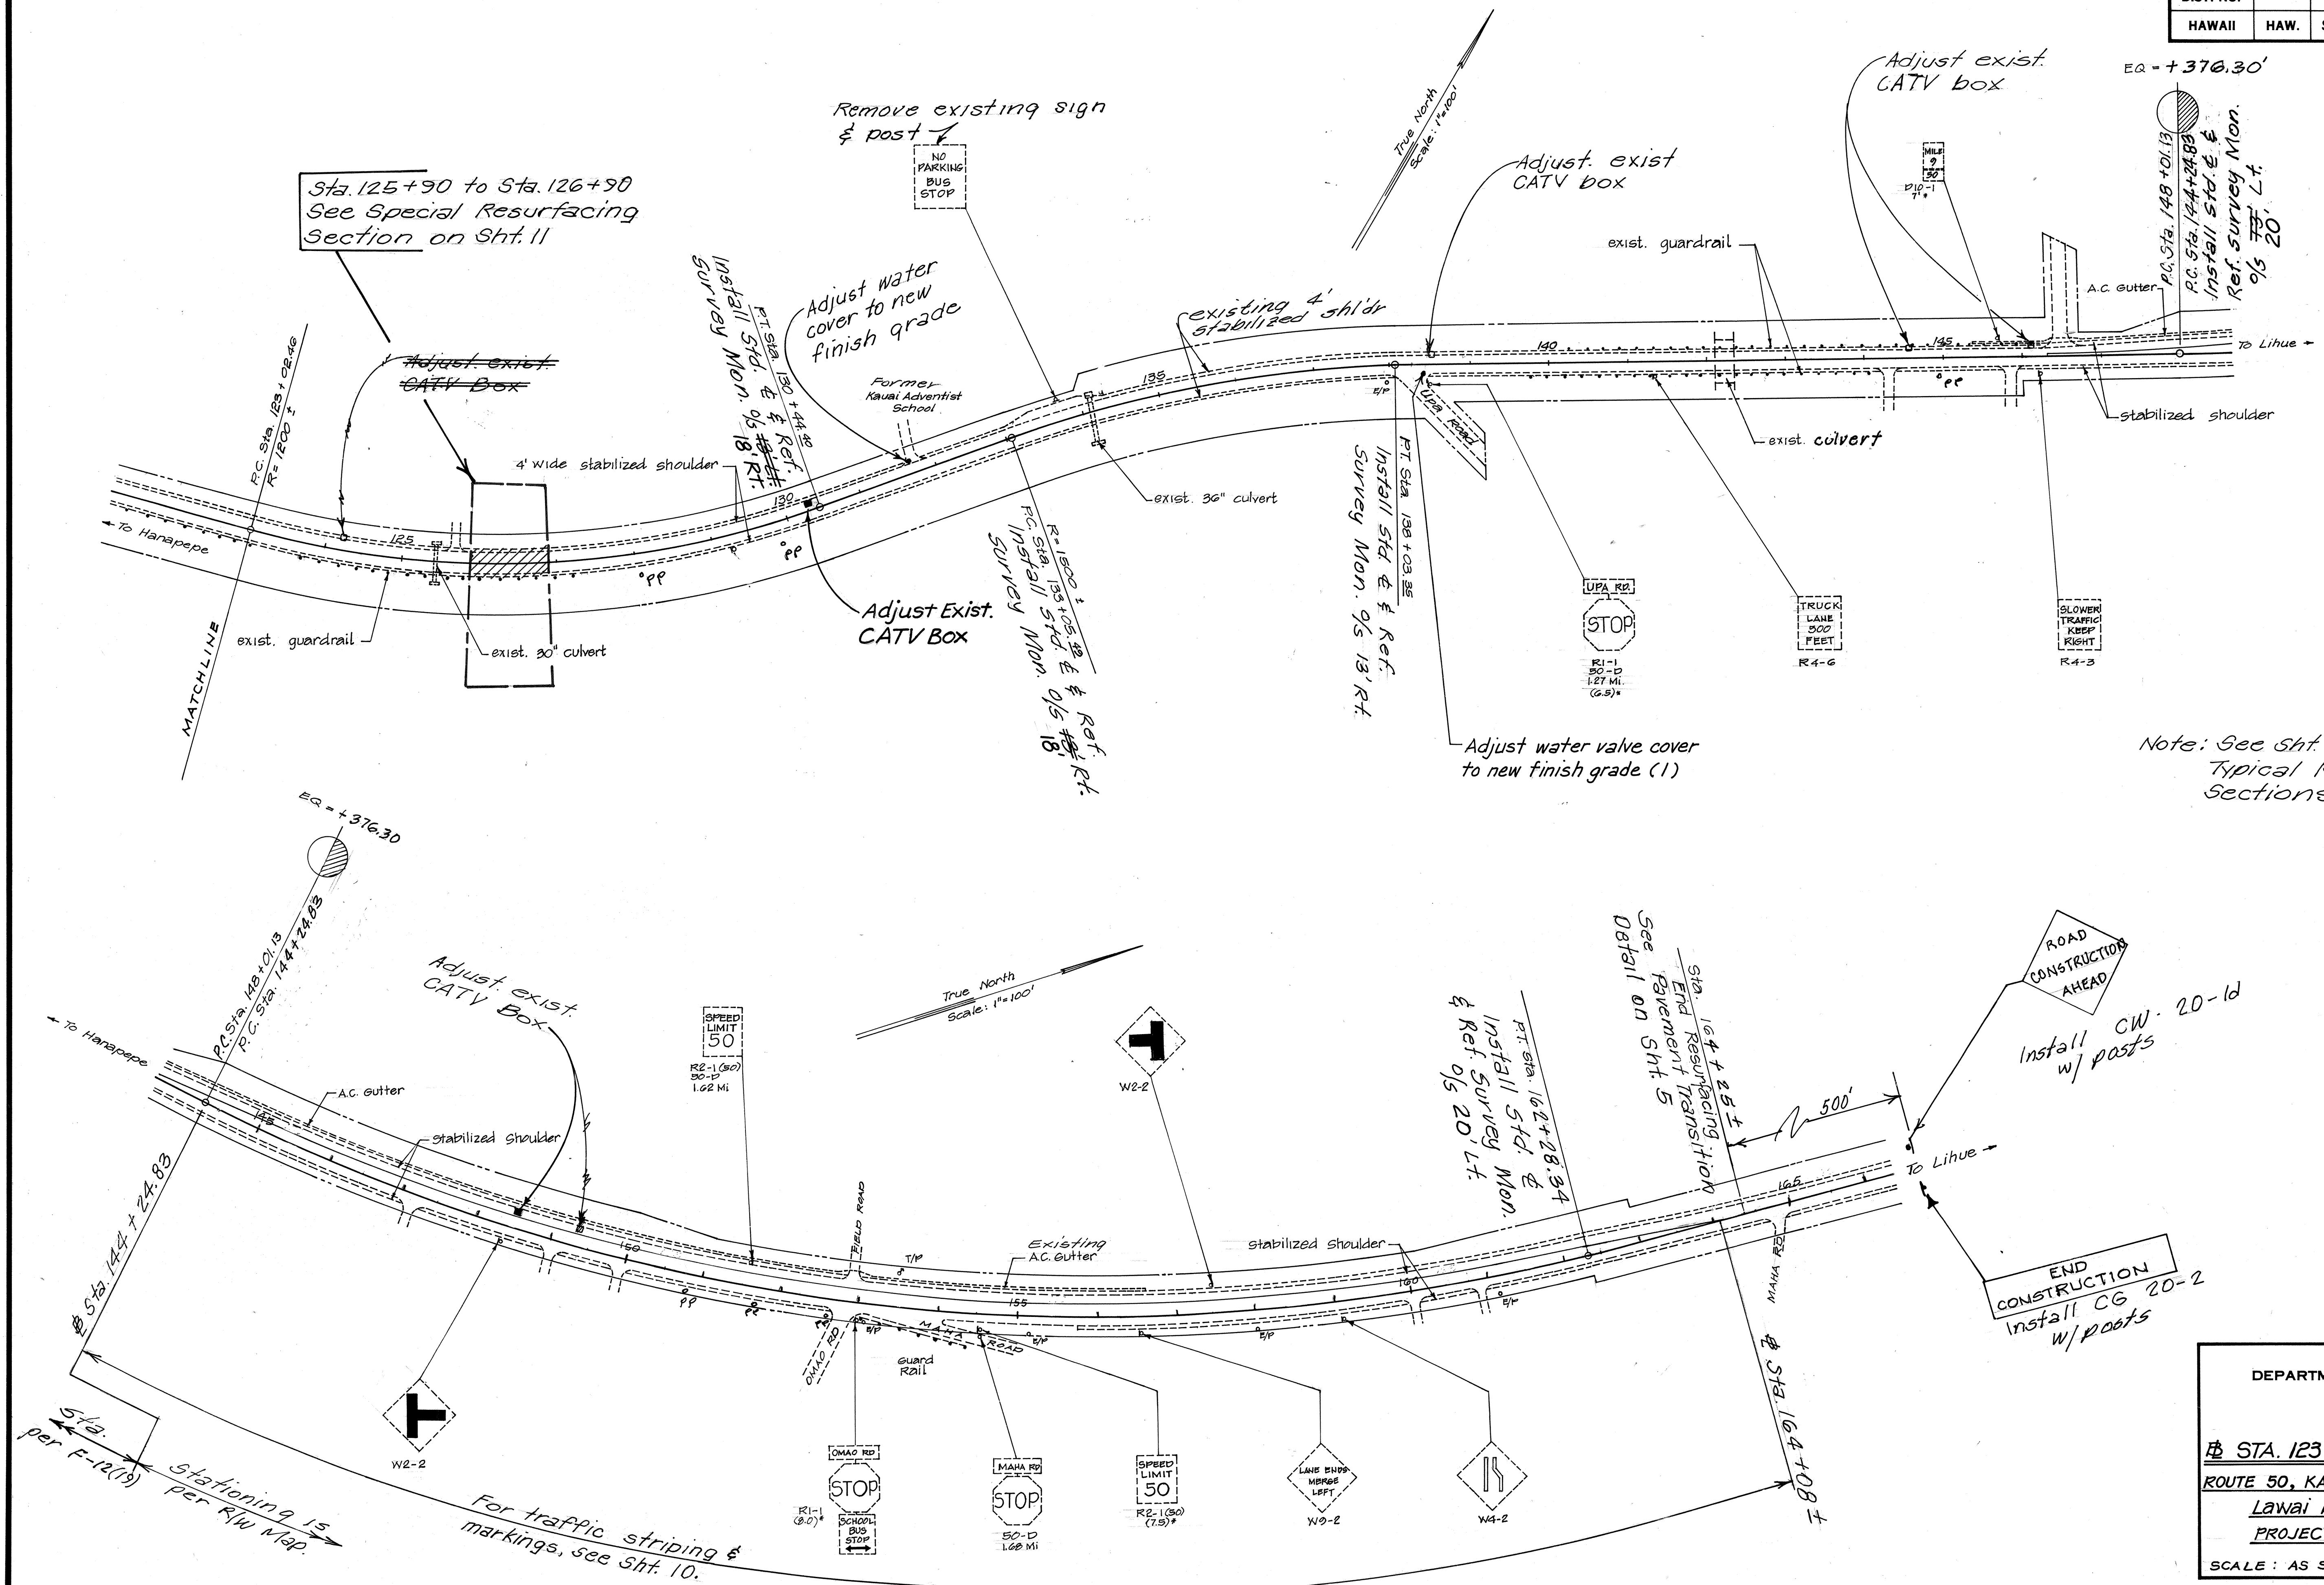

ORIGINAL PLAN	DATE
SURVEY PLOTTED BY	
DRAWN BY	
DESIGNED BY	
QUANTITIES BY	
CHECKED BY	

STATE OF HAWAII
DEPARTMENT OF TRANSPORTATION
HIGHWAYS DIVISION

PLAN

STA. 123+02.46 TO STA. 164+25

ROUTE 50, KAUMUALII HIGHWAY RESURFACING

Lawai Bridge to Omao Road

PROJECT NO. STP-050-1(11)

SCALE: AS SHOWN OCTOBER 1992

SHEET No. 7 OF 12 SHEETS

"AS-BUILT"