	INDEX TO DRAWINGS
SHEET NO.	DESCRIPTION
	TITLE SHEET 10 6 7
2	STANDARD PLANS SUMMARY SHEET
3	GENERAL NOTES
4-5	TYPICAL SECTIONS
6-7 5	PLAN
8-10	PAVEMENT STRIPING & RAISED
1	PAVEMENT MARKER PLAN
11	SPECIAL RESURFACING SECTION &
	PAVEMENT STRIPING AND
	PAVEMENT MARKER SUMMARY
12	ESTIMATED QUANTITIES
*	

587-2244 MAR. 1993 PHONE DATE

ALLAN NISHIMURA P. S. & E. BY STATE OF HAWAII


DEPARTMENT OF TRANSPORTATION
HIGHWAYS DIVISION
HONOLULU, HAWAII

"AS-BUILT"
PLANS FOR

ROUTE 50, KAUMUALII HIGHWAY RESURFACING


LAWAI BRIDGE TO OMAO ROAD PROJECT NO. STP-050-I(II)


DISTRICT OF KOLOA ISLAND OF KAUAI

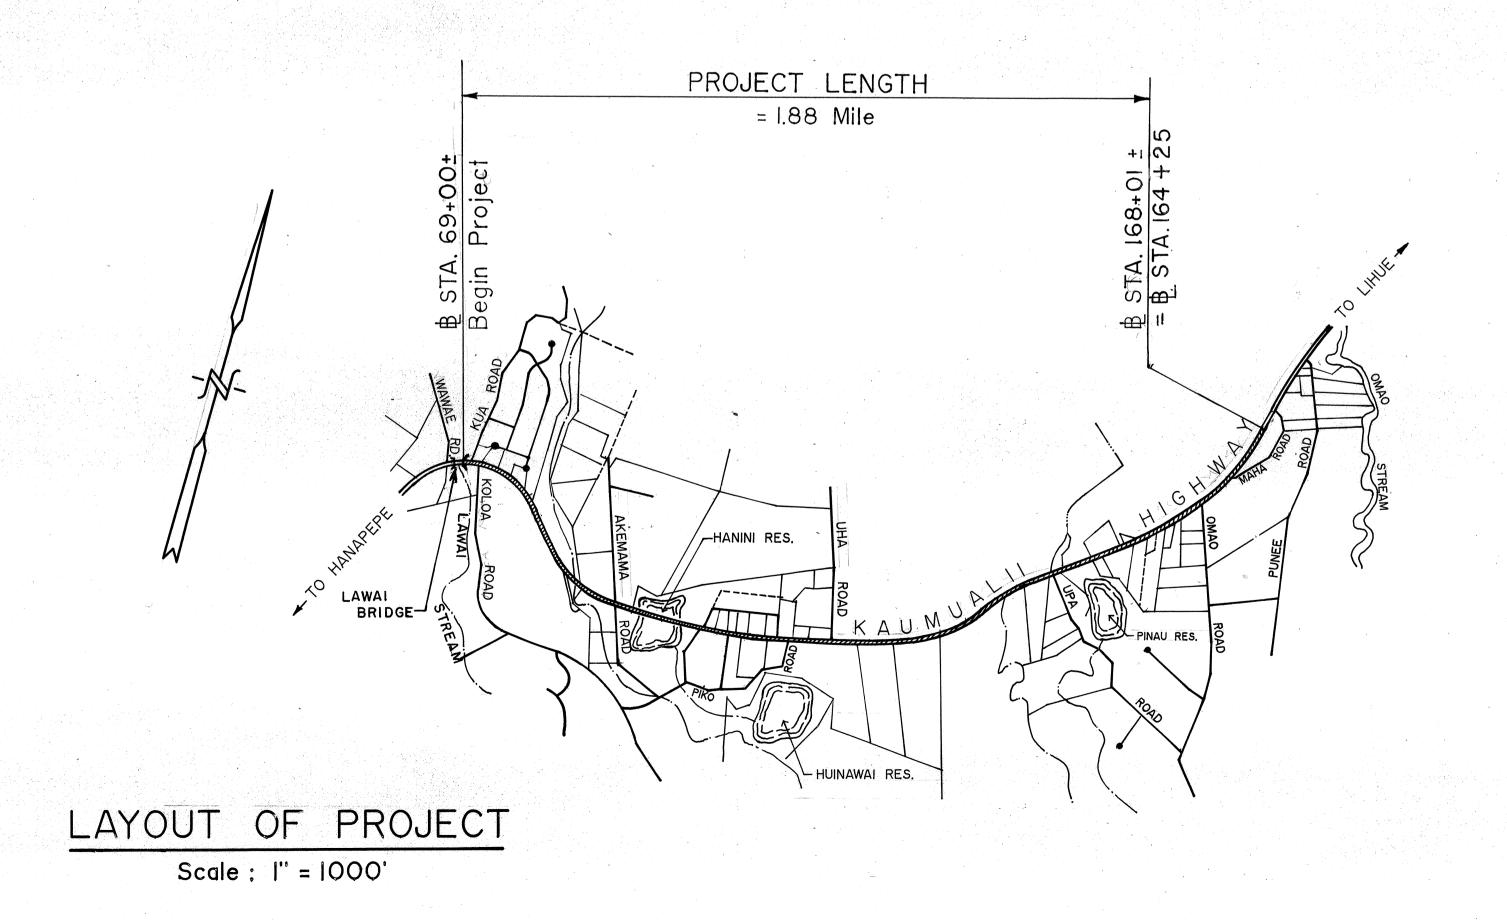


FED. ROAD DIST. NO. STATE FED. AID PROJ. NO. FISCAL SHEET NO. SHEETS

HAWAII HAW. STP- の50(同日) 1993 I 12

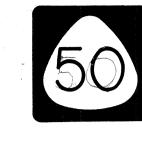

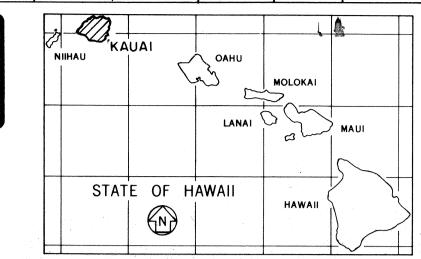

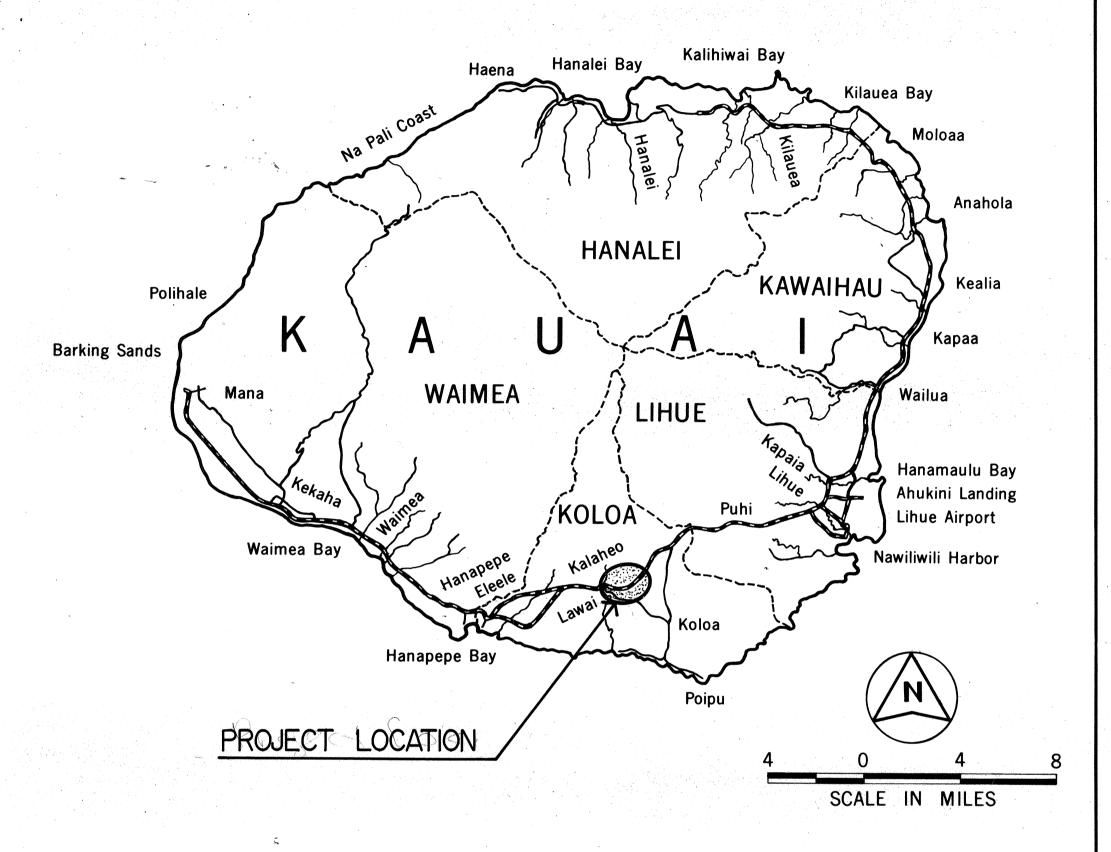

FEDERAL AID PROJECTS PREVIOUSLY CONSTRUCTED
OR UNDER CONSTRUCTION

MILE POST 8.57 TO MILE POST 10.45

DESIGN DESIGNATION

CURRENT ADT (1991)12,283

V_____50 MPH

CHANGES MADE DURING CONSTRUCTION HAVE BEEN INCORPORATED ON THESE PLANS IN RED.

RESIDENT ENGINEER

12/1/95

DEPARTMENT OF TRANSPORTATION
STATE OF HAWAII

APPROVED:

JOIR. OF TRANSPORTATION DATE

"AS-BUILT"