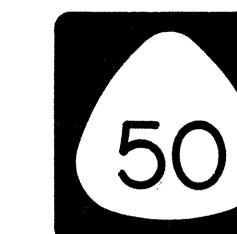

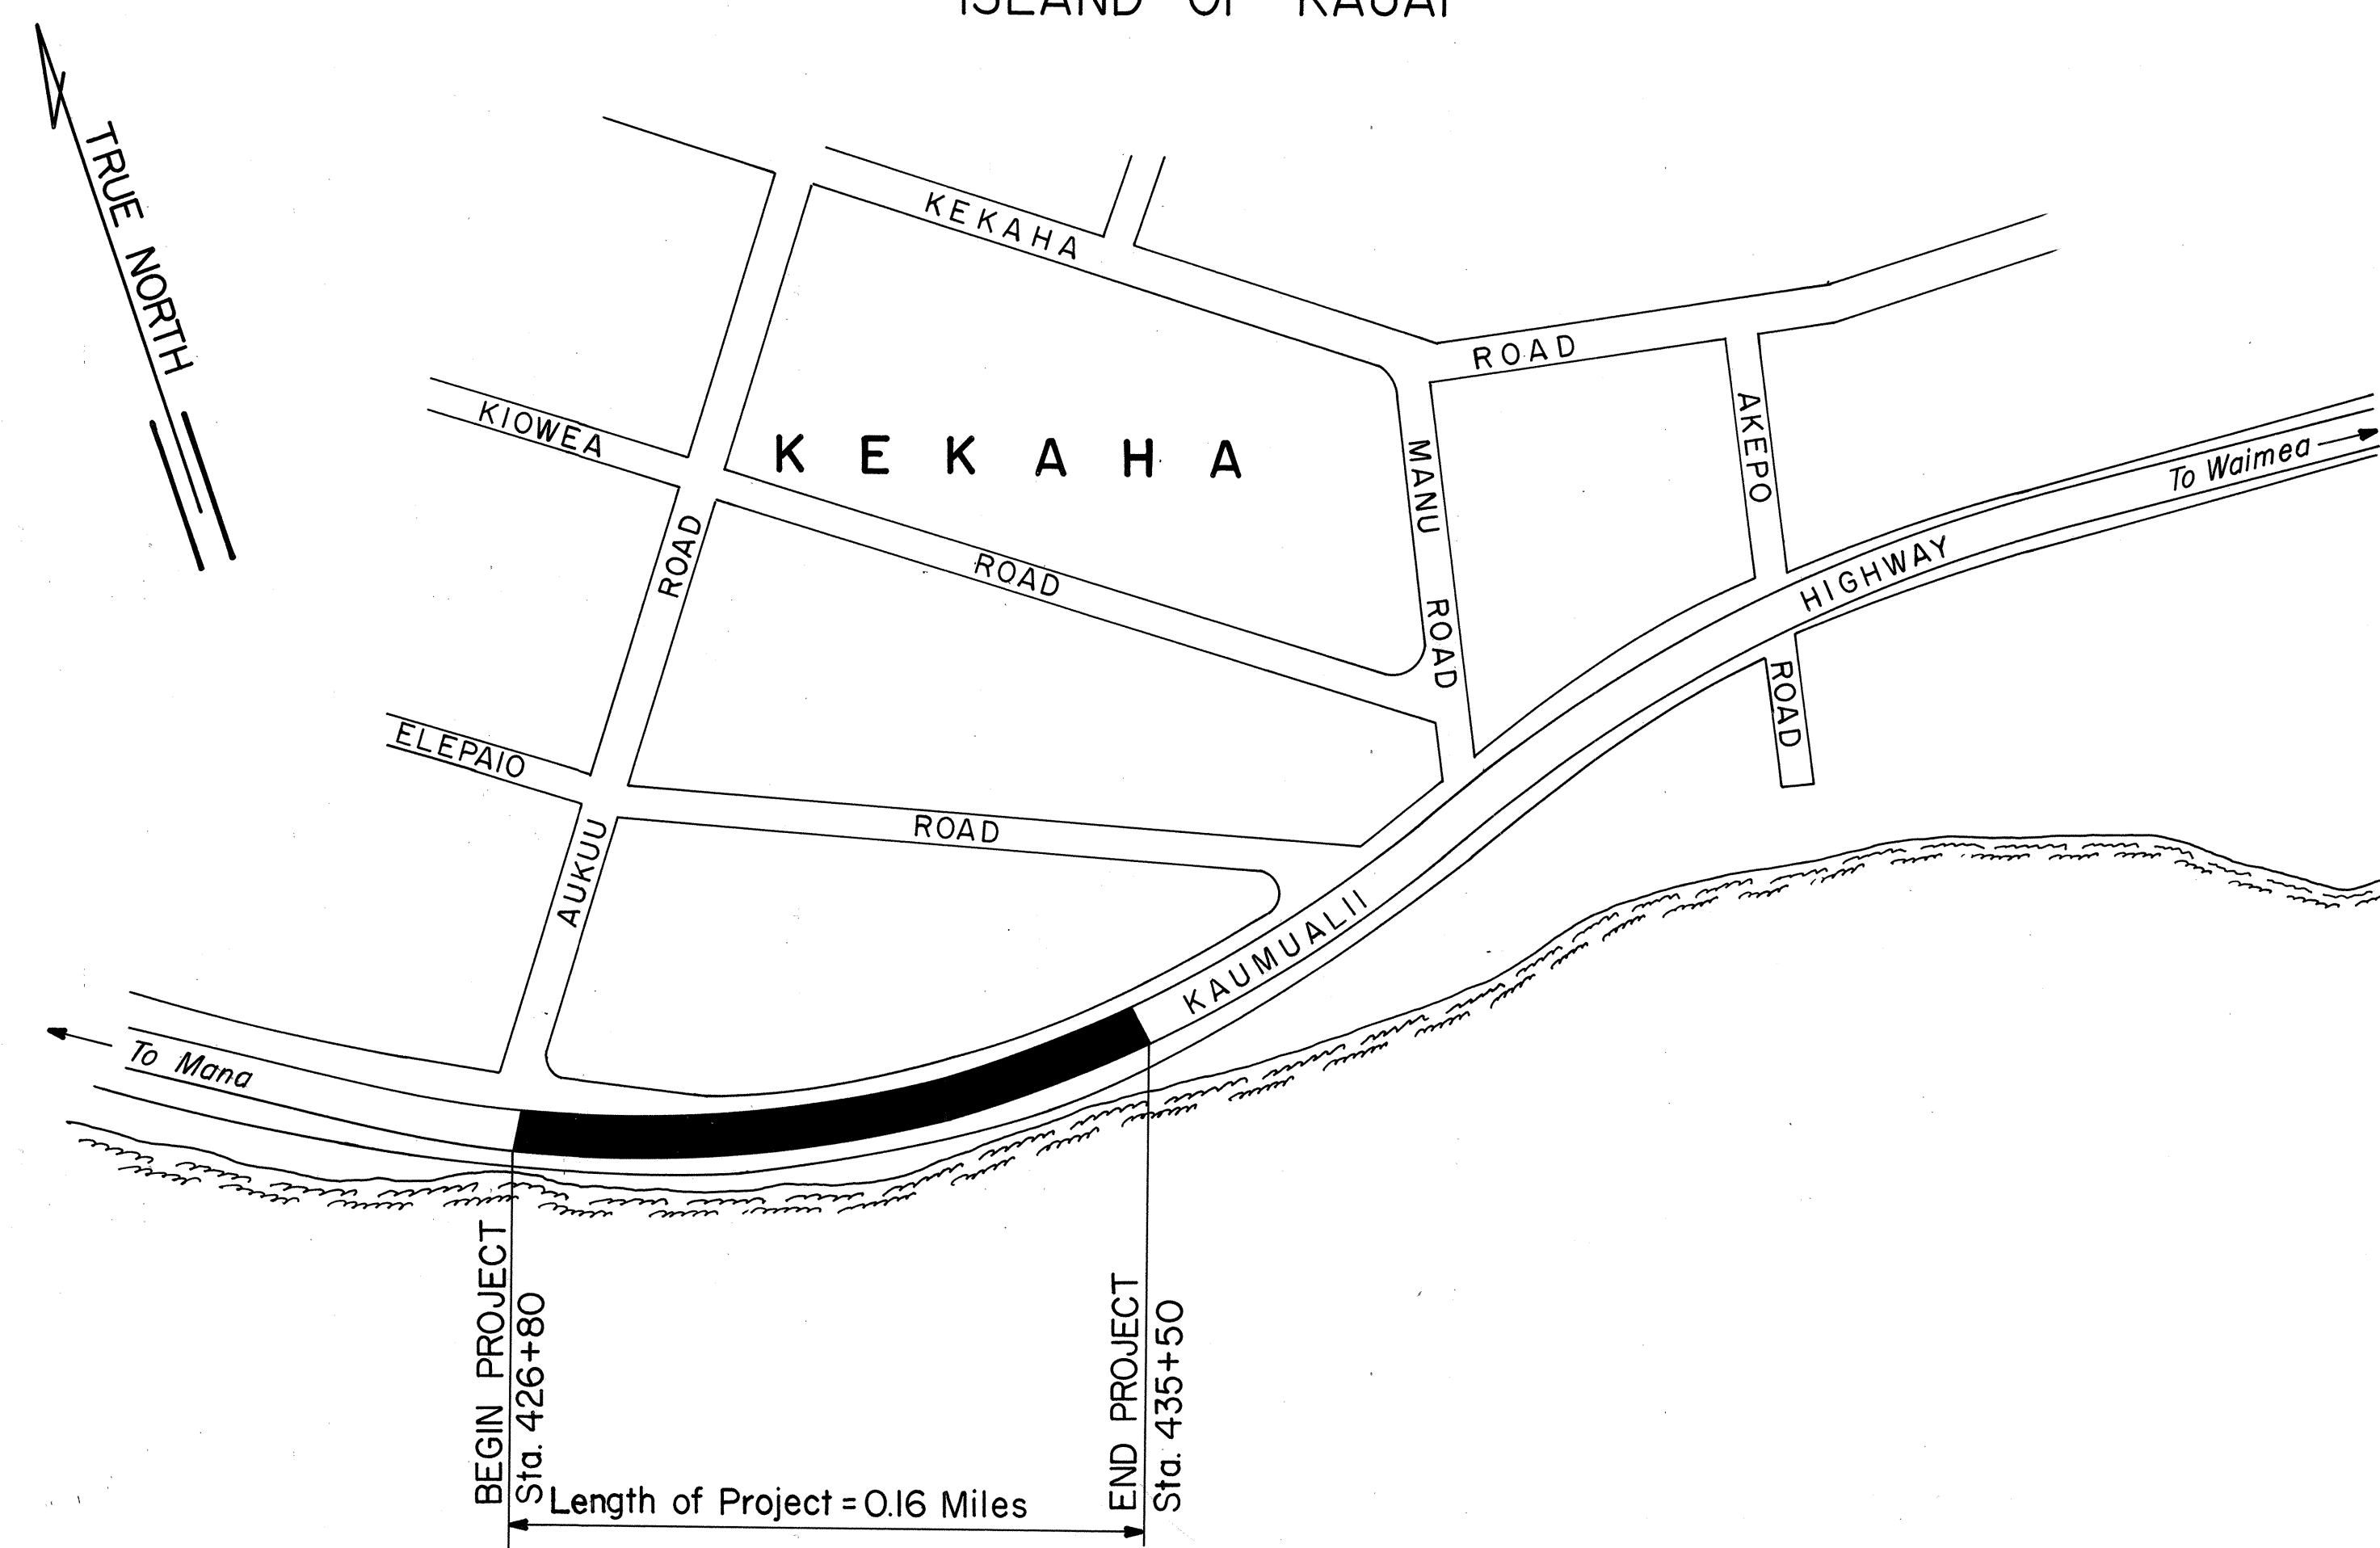



[illegible]

STATE OF HAWAII  
DEPARTMENT OF TRANSPORTATION  
HIGHWAYS DIVISION  
HONOLULU, HAWAII

 FEDERAL AID PROJECTS PREVIOUSLY CONSTRUCTED  
OR UNDER CONSTRUCTION

MILE POST 25.42 TO MILE POST 25.26



DEPARTMENT OF TRANSPORTATION FEDERAL HIGHWAY ADMINISTRATION	
APPROVED:	
	
for	<div style="display: flex; justify-content: space-between;"> <div>DIVISION ADMINISTRATOR</div> <div>3/15/51</div> </div>
DATE	

HWY K \_\_\_\_\_  
DESIGNED BY \_\_\_\_\_  
ALLAN NISHIMURA  
P. S. & E. BY 587-2244  
PHONE MARCH, 1993  
DATE