



| FED. ROAD DIST. NO. | STATE | FED. AID PROJ. NO. | FISCAL YEAR | SHEET NO. | TOTAL SHEETS |
|---------------------|-------|--------------------|-------------|-----------|--------------|
| HAWAII              | HAW.  | NH-050-1(31)       | 2009        | 11        | 452          |

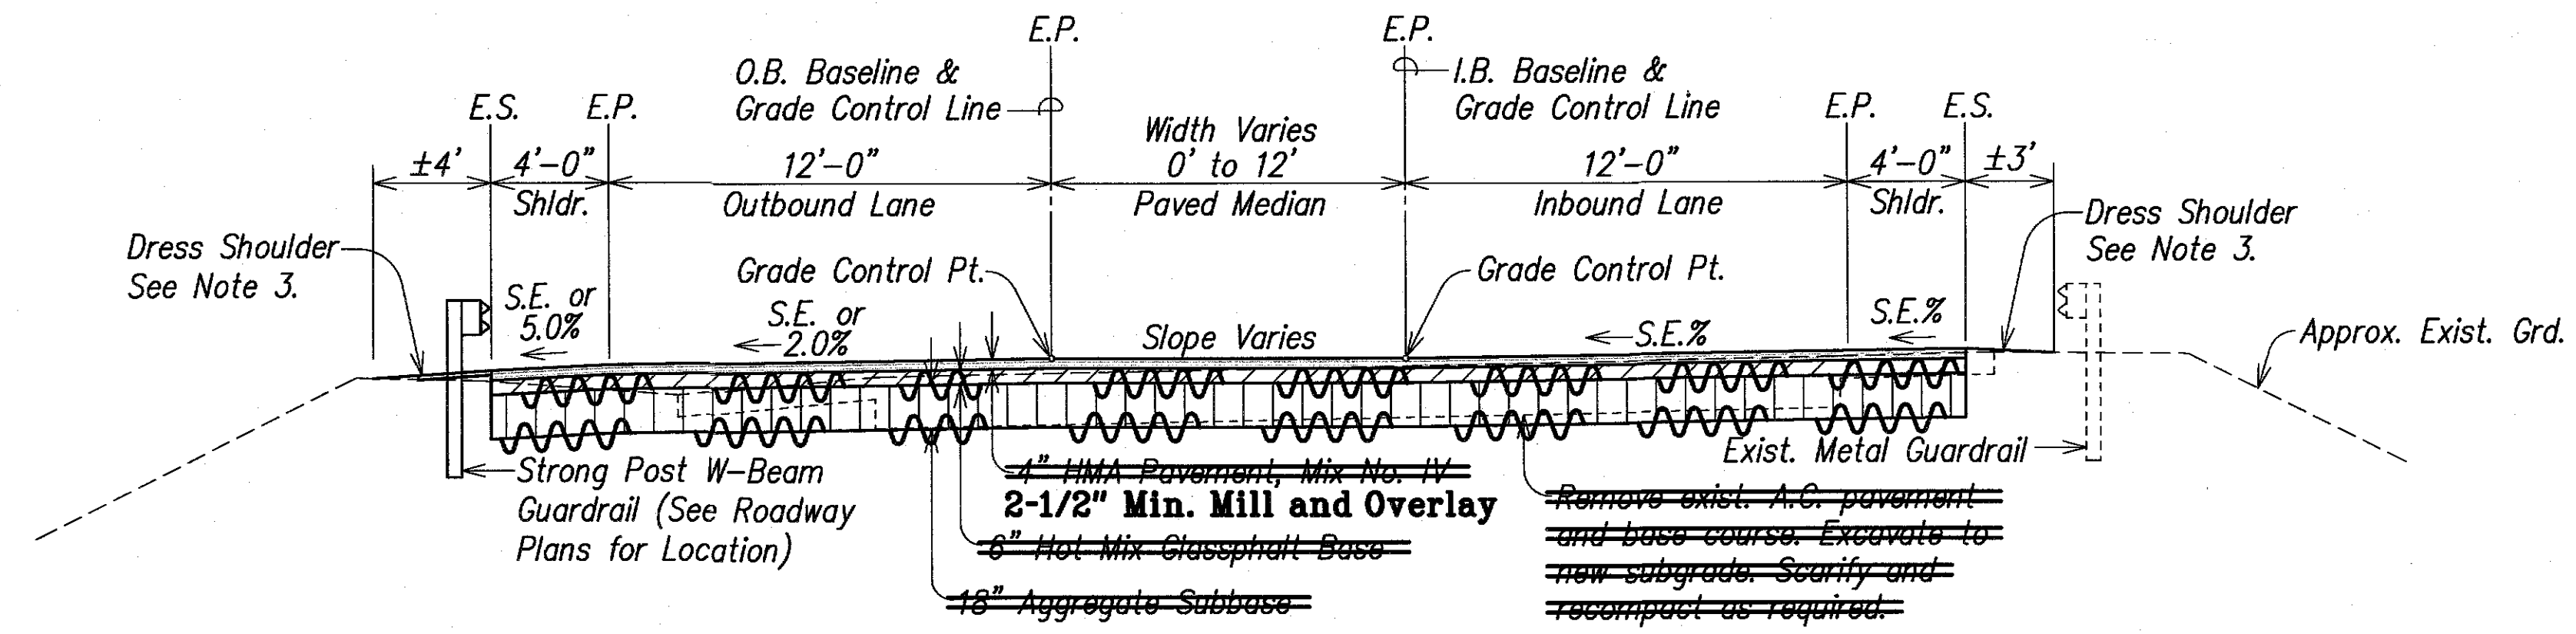

**TYPICAL HIGHWAY SECTION**  
**# Sta. 274+96± to # Sta. 277+40±**  
Scale: 1" = 5'-0"

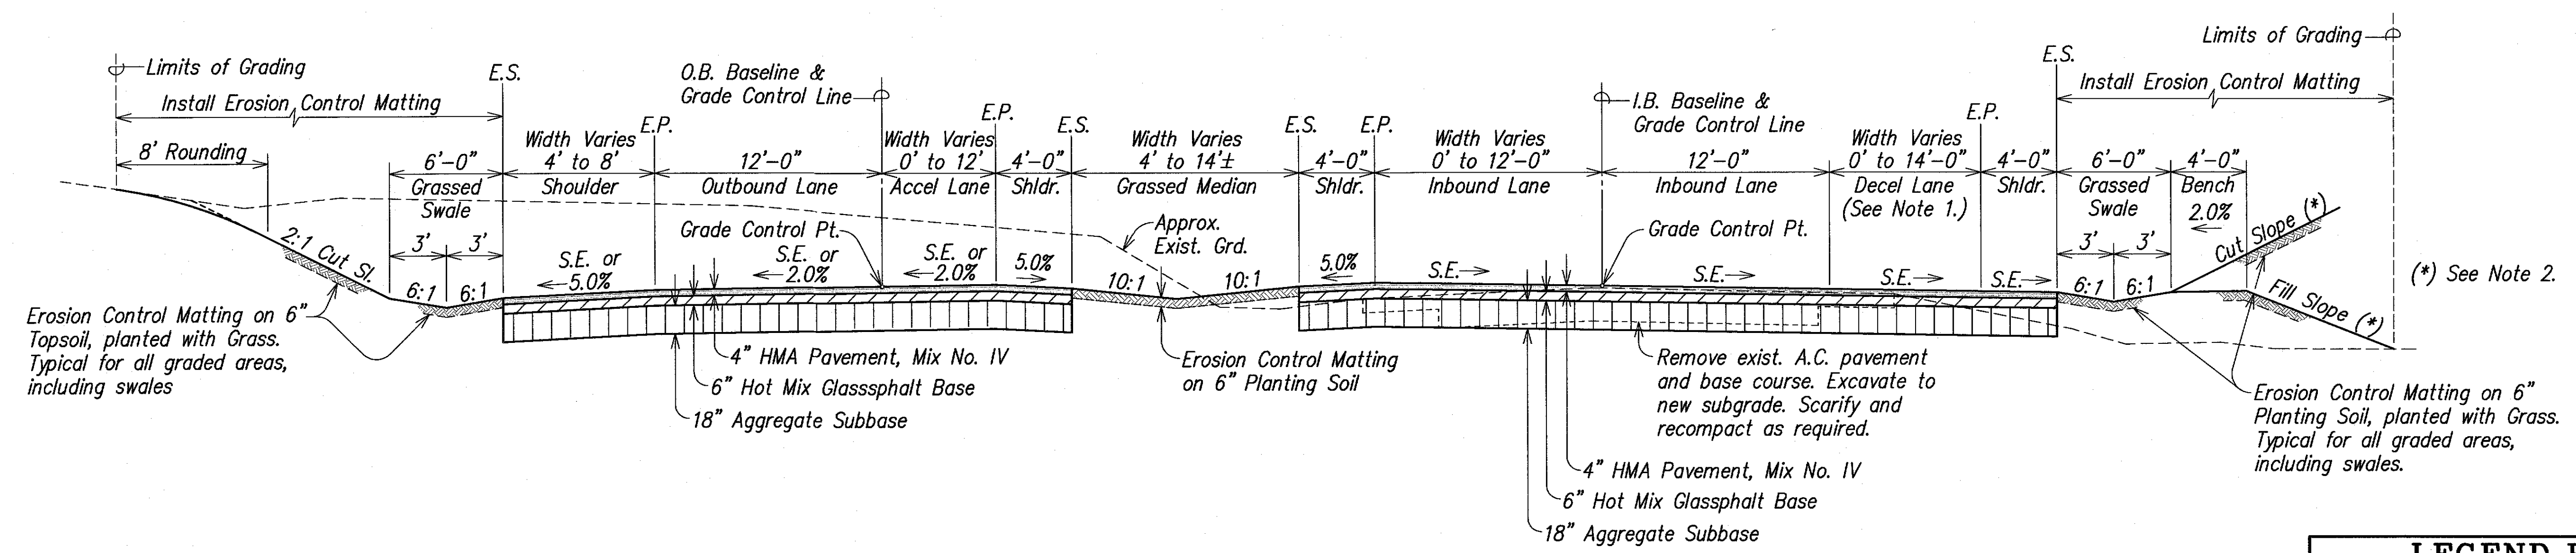

**TYPICAL HIGHWAY SECTION**  
**# Sta. 277+40± to # Sta. 281+50**  
Scale: 1" = 5'-0"

- Typical Section Notes:**
- Where Present. See Roadway Plans.
  - The slope of the cut or fill embankment varies with location. Unless otherwise noted, the cut or fill slope shall be maximum 2H:1V. See Grading Plans for location of various conditions.
  - Dressing of shoulder shall consist of clearing, grubbing, grading reshaping and compacting the unpaved shoulders with suitable material as shown on the plans and/or as directed by the Engineer. This work shall be considered incidental to the various contract items.

- Abbreviations:**
- E.P. Edge of New Pavement
  - E.S. Edge of New Shoulder
  - G.C. Grade Control
  - I.B. Inbound
  - O.B. Outbound
  - S.E. Superelevation


**LEGEND FOR AS-BUILT POSTINGS**

Squiggly line for as-built deletion

Double line for as-built deletion

**Roadway** Text for as-built posting

|                   |      |
|-------------------|------|
| SURVEY PLOTTED BY | DATE |
| DRAWN BY          |      |
| TRACED BY         |      |
| CHECKED BY        |      |
| ORIGINAL PLAN     |      |
| NOTE BOOK         |      |
| No.               |      |

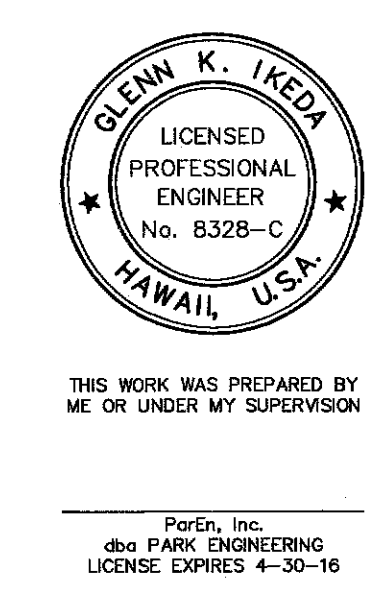


STATE OF HAWAII  
DEPARTMENT OF TRANSPORTATION  
HIGHWAYS DIVISION

**TYPICAL SECTIONS**


KAUMUALI' HIGHWAY WIDENING  
Vicinity of Anonui Street to Vicinity of Lihue Mill Bridge  
FEDERAL-AID PROJECT NO. NH-050-1(31)

Scale: 1" = 5'  
Date: JAN. 2010  
SHEET No. T1 OF T18 SHEETS

| FED. ROAD DIST. NO. | STATE | FED. AID PROJ. NO. | FISCAL YEAR | SHEET NO. | TOTAL SHEETS |
|---------------------|-------|--------------------|-------------|-----------|--------------|
| HAWAII              | HAW.  | NH-050-1(31)       | 2009        | C.O. 12   | 452          |

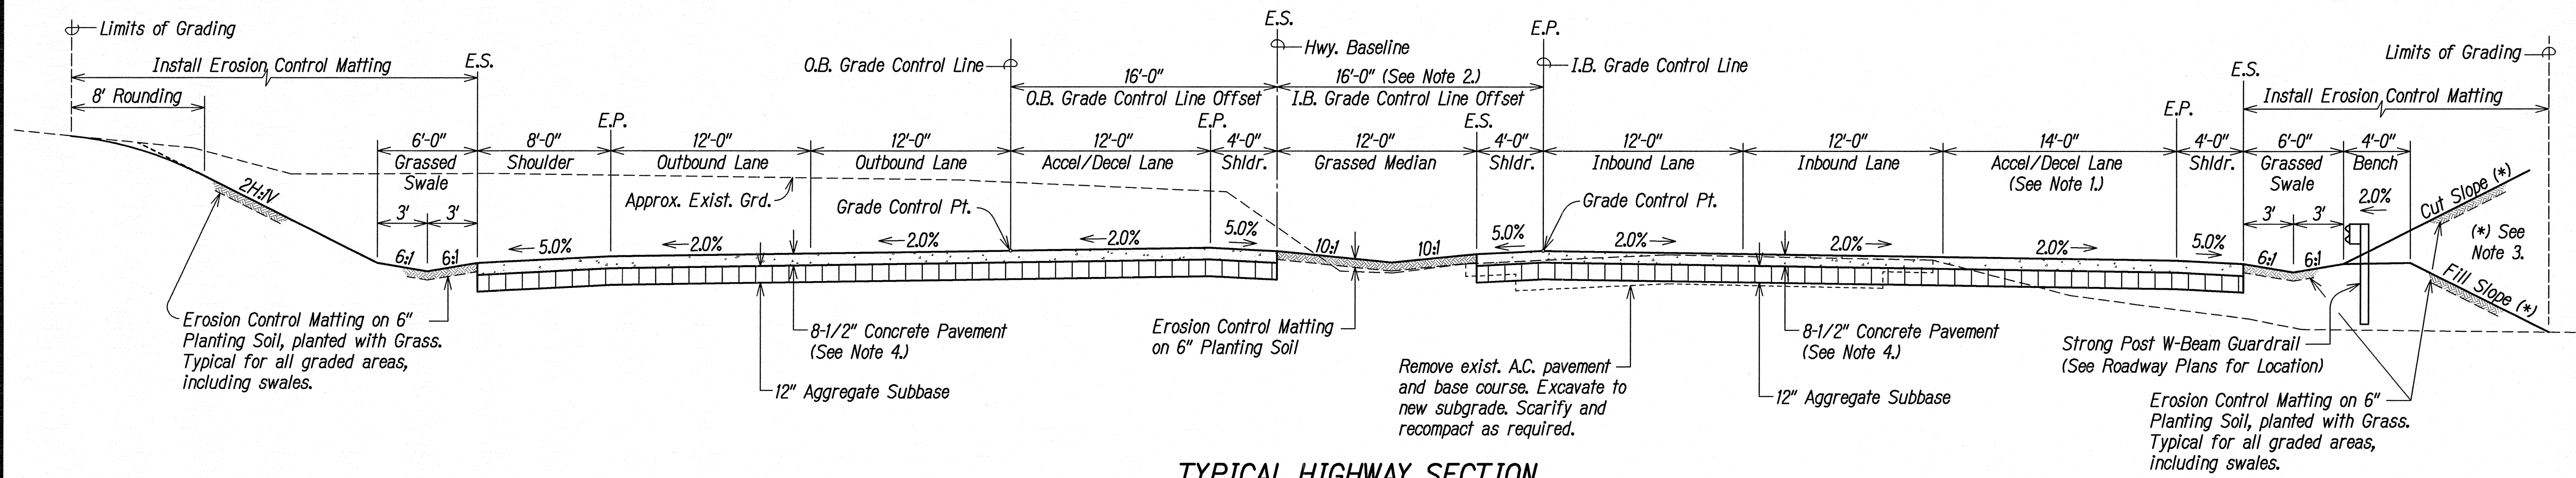


**TYPICAL HIGHWAY SECTION**  
 @ Sta. 281+50 to @ Sta. 283+83±  
 Scale: 1"= 5'-0"

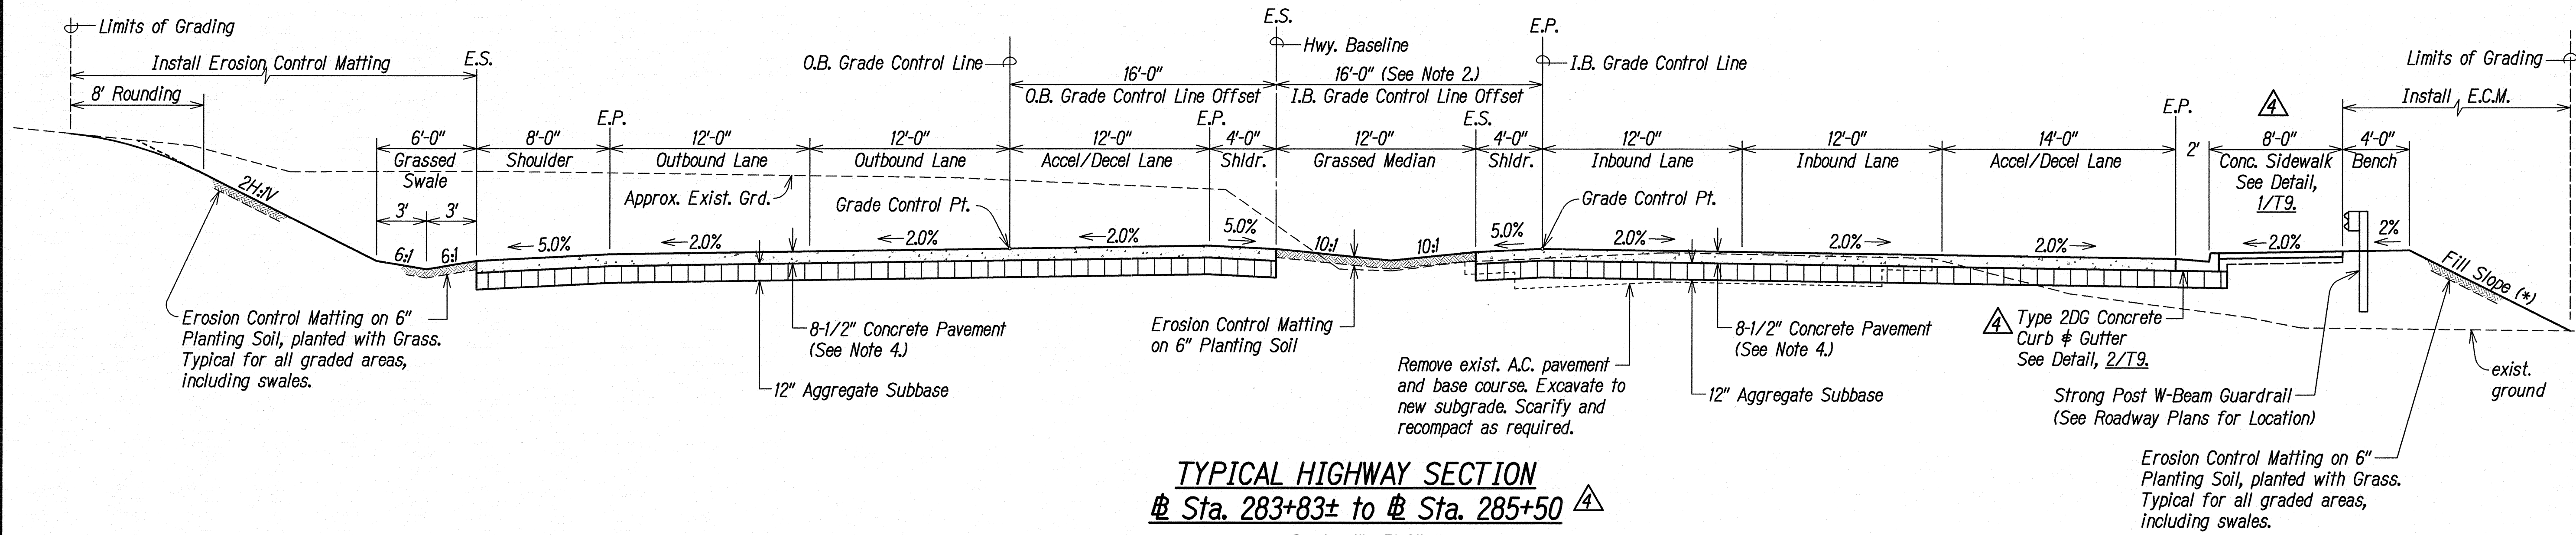

**TYPICAL HIGHWAY SECTION**  
 @ Sta. 283+83± to @ Sta. 285+50  
 Scale: 1"= 5'-0"

- Typical Section Notes:**
- Where Present. See Roadway Plans.
  - Inbound Grade Control Line offset varies from 16' at Sta. 284+00 to 12' at Sta. 288+00.
  - The slope of the cut or fill embankment varies with location. Unless otherwise noted, the cut or fill slope shall be maximum 2H:1V. See Grading Plans for location of various conditions.
  - For Typical PCC Pavement details, see Sheets T13 and T14.

- Abbreviations:**
- E.P. Edge of New Pavement
  - E.S. Edge of New Shoulder
  - G.C. Grade Control
  - I.B. Inbound
  - O.B. Outbound

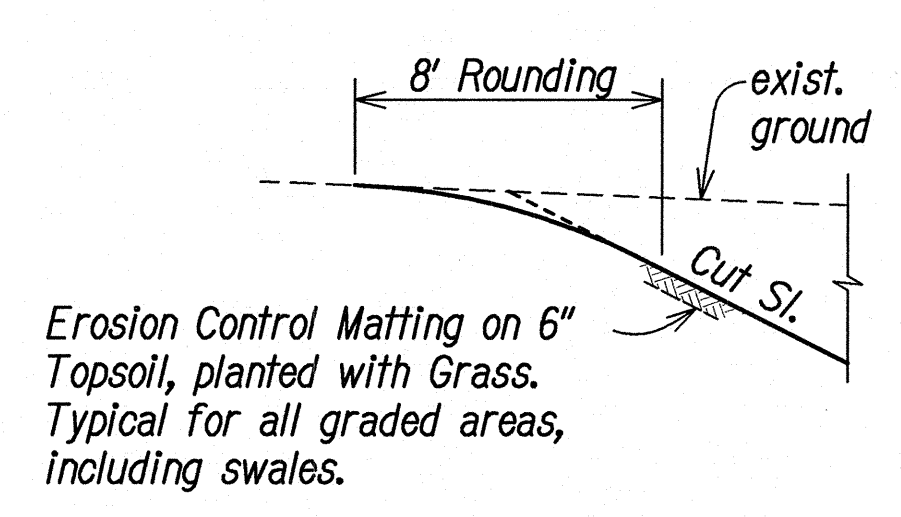

**TYPICAL CUT-SLOPE DETAIL**  
 Scale: 1"= 5'-0"


|                   |      |
|-------------------|------|
| SURVEY PLOTTED BY | DATE |
| DRAWN BY          |      |
| DESIGNED BY       |      |
| QUANTITIES BY     |      |
| CHECKED BY        |      |
| ORIGINAL PLAN     |      |
| NOTE BOOK         |      |
| NO.               |      |

LIB2: STATE DOT KAUAI/MAUI/1/PHASE1A REVISION PLANS / CD-012-152.dwg 1/05/10

**GLEN K. IKEDA**  
 LICENSED PROFESSIONAL ENGINEER  
 No. 8328-C  
 HAWAII, U.S.A.  
 2-1-10  
 THIS WORK WAS PREPARED BY ME OR UNDER MY SUPERVISION  
**Glen K. Ikeda**  
 P.E., Inc.  
 480 PARK ENGINEERING  
 LICENSE EXPIRES 4-30-10

| 2/01/10   | Revised Limits of Typical Sections. Added Conc. Curb, Gutter & Sidewalk. Revised Notes. |
|---|---|
| DATE  | REVISION  |
| STATE OF HAWAII<br>DEPARTMENT OF TRANSPORTATION<br>HIGHWAYS DIVISION  |   |
| <b>TYPICAL SECTIONS</b>   |   |
| KAUAI/MAUI HIGHWAY WIDENING<br>Vicinity of Anonui Street to Vicinity of Lihue Mill Bridge<br>FEDERAL-AID PROJECT NO. NH-050-1(31) |   |
| Scale: 1" = 5'  | Date: JAN. 2010   |
| SHEET No. T2 OF T18 SHEETS  |   |

| FED. ROAD DIST. NO. | STATE | FED. AID PROJ. NO. | FISCAL YEAR | SHEET NO.   | TOTAL SHEETS |
|---------------------|-------|--------------------|-------------|-------------|--------------|
| HAWAII              | HAW.  | NH-050-1(31)       | 2009        | C.O. 12 S-1 | 452          |

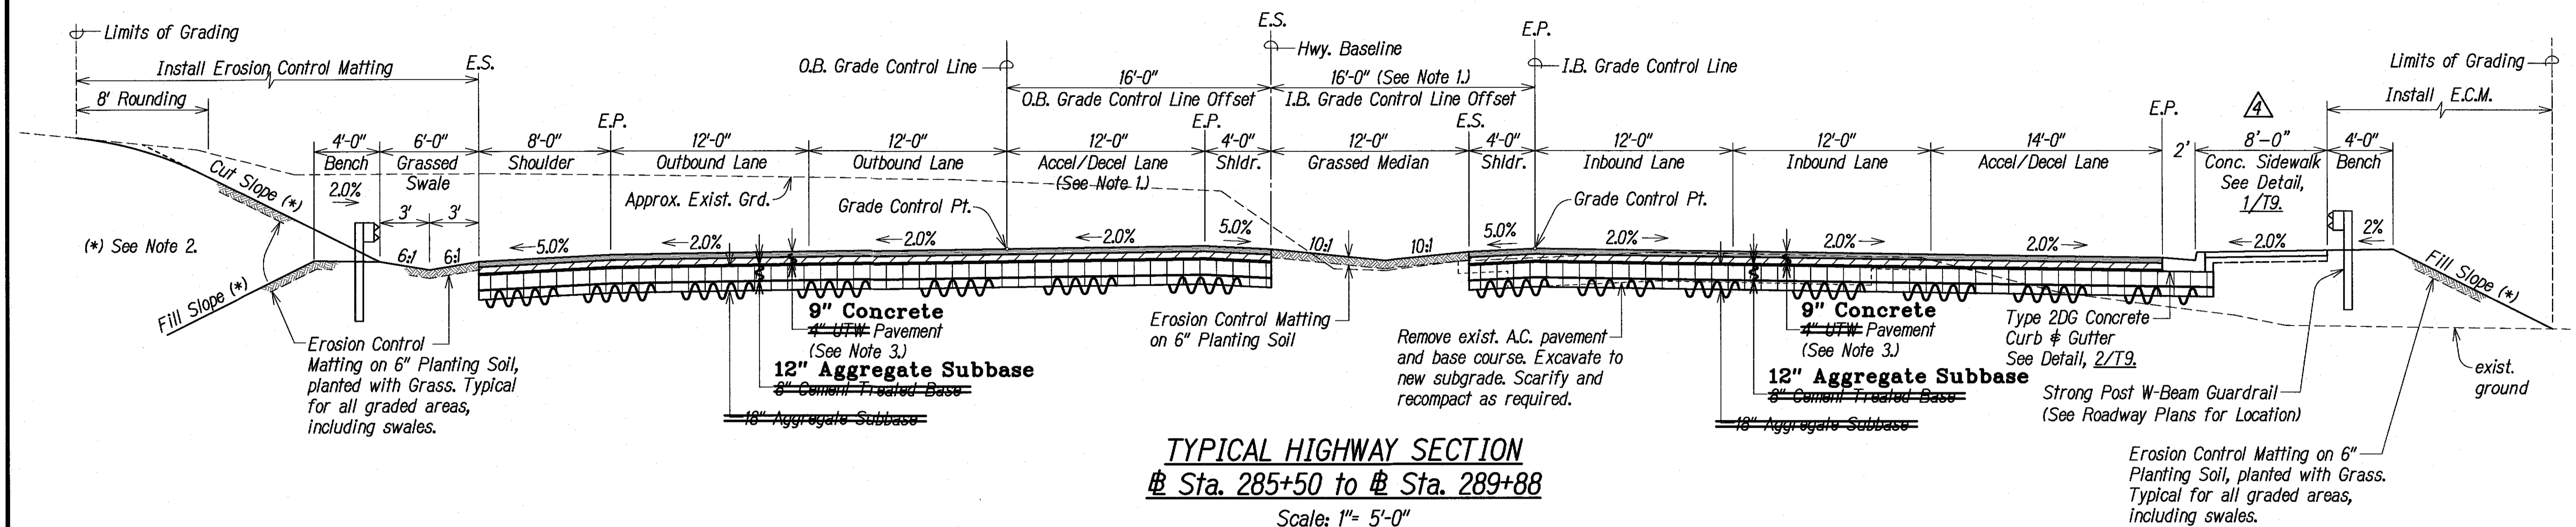

| LEGEND FOR AS-BUILT POSTINGS |                                     |
|------------------------------|-------------------------------------|
|                              | Squiggly line for as-built deletion |
|                              | Double line for as-built deletion   |
| Roadway                      | Text for as-built posting           |


#### Typical Section Notes:

- Inbound Grade Control Line offset varies from 16' at Sta. 284+00 to 12' at Sta. 288+00.
- The slope of the cut or fill embankment varies with location. Unless otherwise noted, the cut or fill slope shall be maximum 2H:1V. See Grading Plans for location of various conditions.
- For Typical PCC Pavement details, see Sheets ~~T13~~ and ~~T14~~  
**T13 T14**

#### Abbreviations:

|      |                      |
|------|----------------------|
| E.P. | Edge of New Pavement |
| E.S. | Edge of New Shoulder |
| G.C. | Grade Control        |
| I.B. | Inbound              |
| O.B. | Outbound             |

|                   |      |
|-------------------|------|
| SURVEY PLOTTED BY | DATE |
| DESIGNED BY       |      |
| TRACED BY         |      |
| DESIGNED BY       |      |
| QUANTITIES BY     |      |
| CHECKED BY        |      |
| ORIGINAL PLAN     |      |
| NOTE BOOK         |      |
| No.               |      |

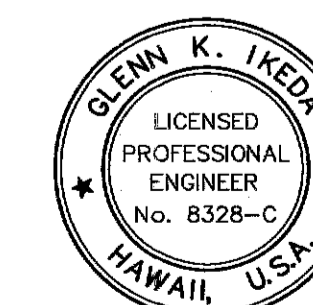

THIS WORK WAS PREPARED BY ME OR UNDER MY SUPERVISION


Park, Inc.  
404 PARK ENGINEERING  
LICENSE EXPIRES 4-30-16

|  |                 |
|--|-----------------|
| 2/01/10  | New Sheet.      |
| DATE   | REVISION        |
| STATE OF HAWAII<br>DEPARTMENT OF TRANSPORTATION<br>HIGHWAYS DIVISION   |                 |
| <b>TYPICAL SECTIONS</b>  |                 |
| KAUMUALI HIGHWAY WIDENING<br>Vicinity of Anonui Street to Vicinity of Lihu'e Mill Bridge<br>FEDERAL-AID PROJECT NO. NH-050-1(31) |                 |
| Scale: 1" = 5'   | Date: JAN. 2010 |
| SHEET No. T2A OF T18 SHEETS  |                 |

"AS-BUILT"

C.O. 12S-1

| FED. ROAD DIST. NO. | STATE | FED. AID PROJ. NO. | FISCAL YEAR | SHEET NO.   | TOTAL SHEETS |
|---------------------|-------|--------------------|-------------|-------------|--------------|
| HAWAII              | HAW.  | NH-050-1(31)       | 2009        | C.O. 12 S-1 | 452          |

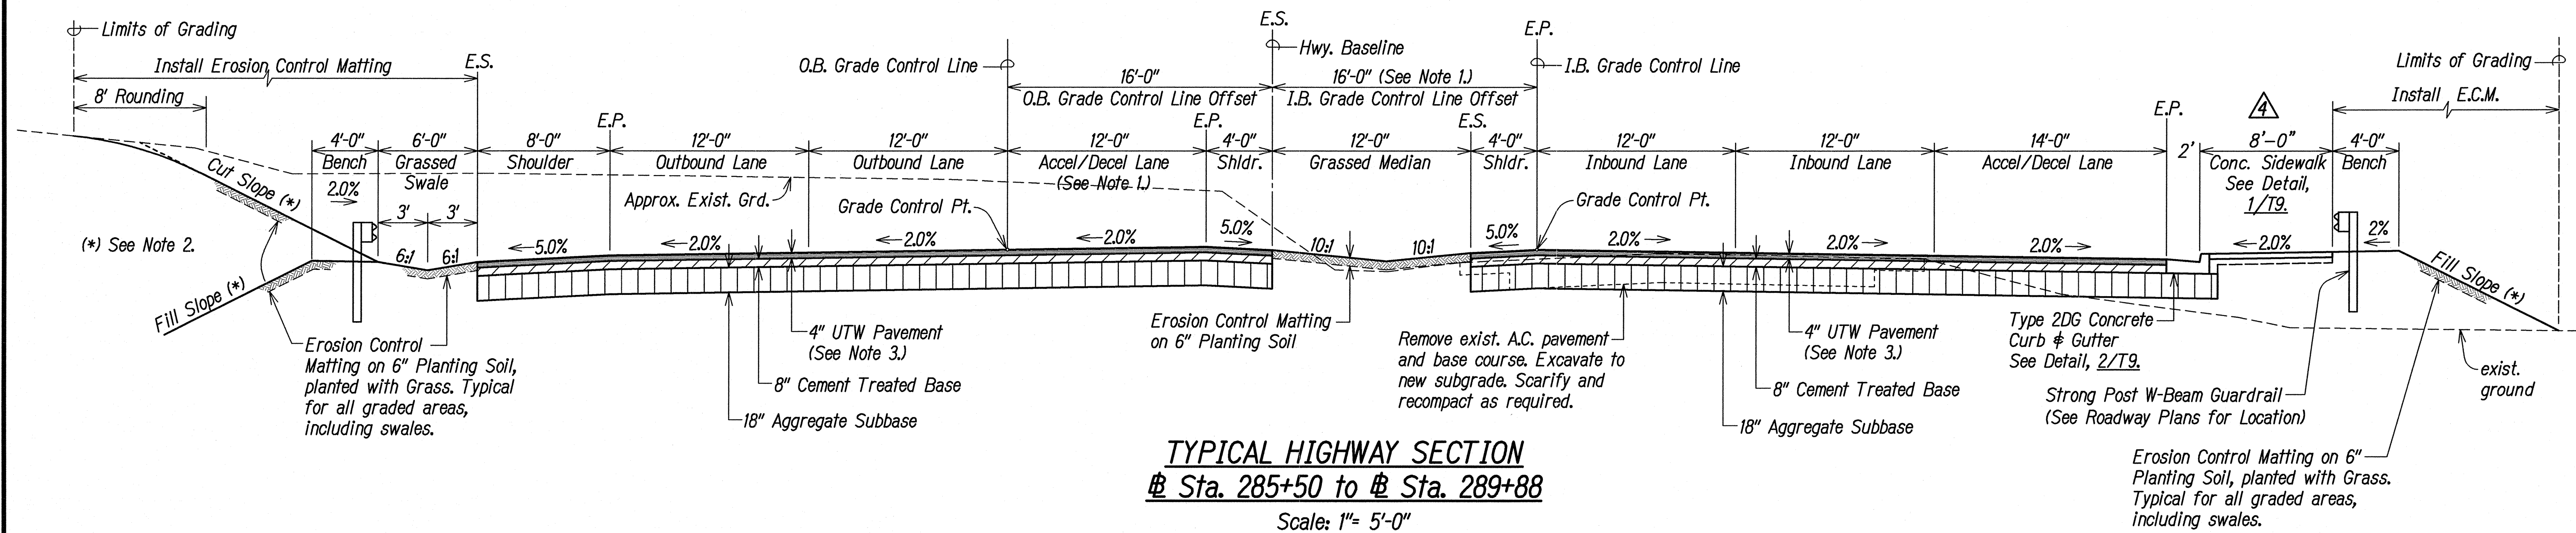

**Typical Section Notes:**

1. Inbound Grade Control Line offset varies from 16' at # Sta. 284+00 to 12' at # Sta. 288+00.
2. The slope of the cut or fill embankment varies with location. Unless otherwise noted, the cut or fill slope shall be maximum 2H:1V. See Grading Plans for location of various conditions.
3. For Typical PCC Pavement details, see Sheets T16 and T17.

**Abbreviations:**

E.P. Edge of New Pavement  
E.S. Edge of New Shoulder  
G.C. Grade Control  
I.B. Inbound  
O.B. Outbound

|                   |      |
|-------------------|------|
| SURVEY PLOTTED BY | DATE |
| DRAWN BY          |      |
| TRACED BY         |      |
| CHECKED BY        |      |
| NOTE BOOK         |      |
| No.               |      |

USE: STATE OF HAWAII - HIGHWAY DIVISION - REVISION PLANS - CDR-002-152.dwg 1/07/10




THIS WORK WAS PREPARED BY  
ME OR UNDER MY SUPERVISION  
*Glenn K. Ikeda*  
P.E., Inc.  
480 PARK ENGINEERING  
LICENSE EXPIRES 4-30-10


|  |                 |
|--|-----------------|
| 2/01/10  | New Sheet.      |
| DATE   | REVISION        |
| STATE OF HAWAII<br>DEPARTMENT OF TRANSPORTATION<br>HIGHWAYS DIVISION   |                 |
| <b>TYPICAL SECTIONS</b>  |                 |
| KAUMUALII HIGHWAY WIDENING<br>Vicinity of Anonui Street to Vicinity of Lihue Mill Bridge<br>FEDERAL-AID PROJECT NO. NH-050-1(31) |                 |
| Scale: 1" = 5'   | Date: JAN. 2010 |
| SHEET No. T2A OF T18 SHEETS  |                 |

C.O. 12 S-1



| FED. ROAD DIST. NO. | STATE | FED. AID PROJ. NO. | FISCAL YEAR | SHEET NO. | TOTAL SHEETS |
|---------------------|-------|--------------------|-------------|-----------|--------------|
| HAWAII              | HAW.  | NH-050-1(31)       | 2009        | 13        | 452          |

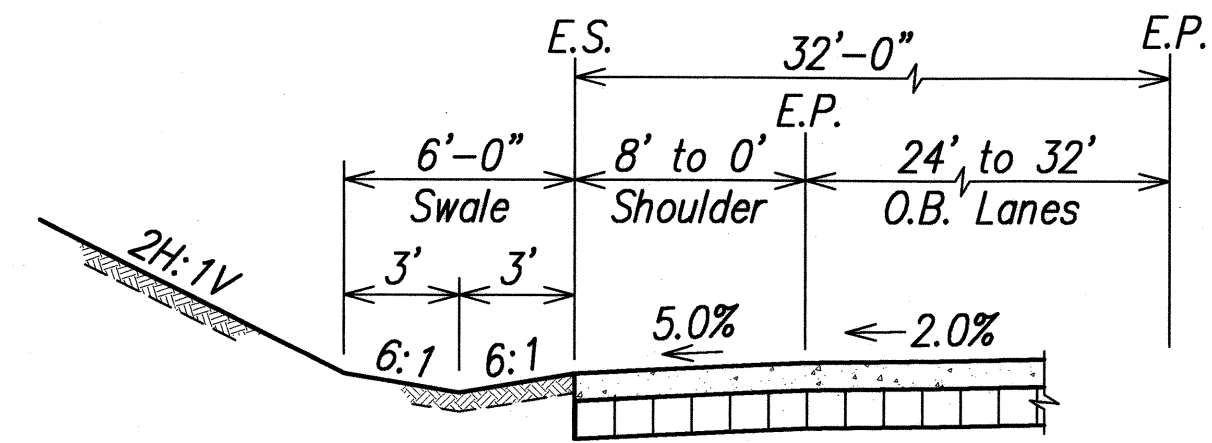

**SHOULDER CONDITION**  
 Sta. 290+88.43 to Sta. 291+83.03

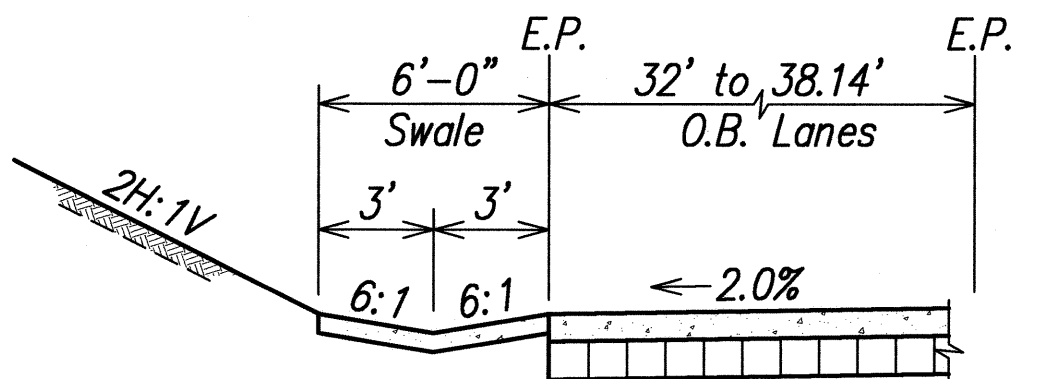

**SHOULDER CONDITION**  
 Sta. 291+83.03 to Sta. 292+55.59

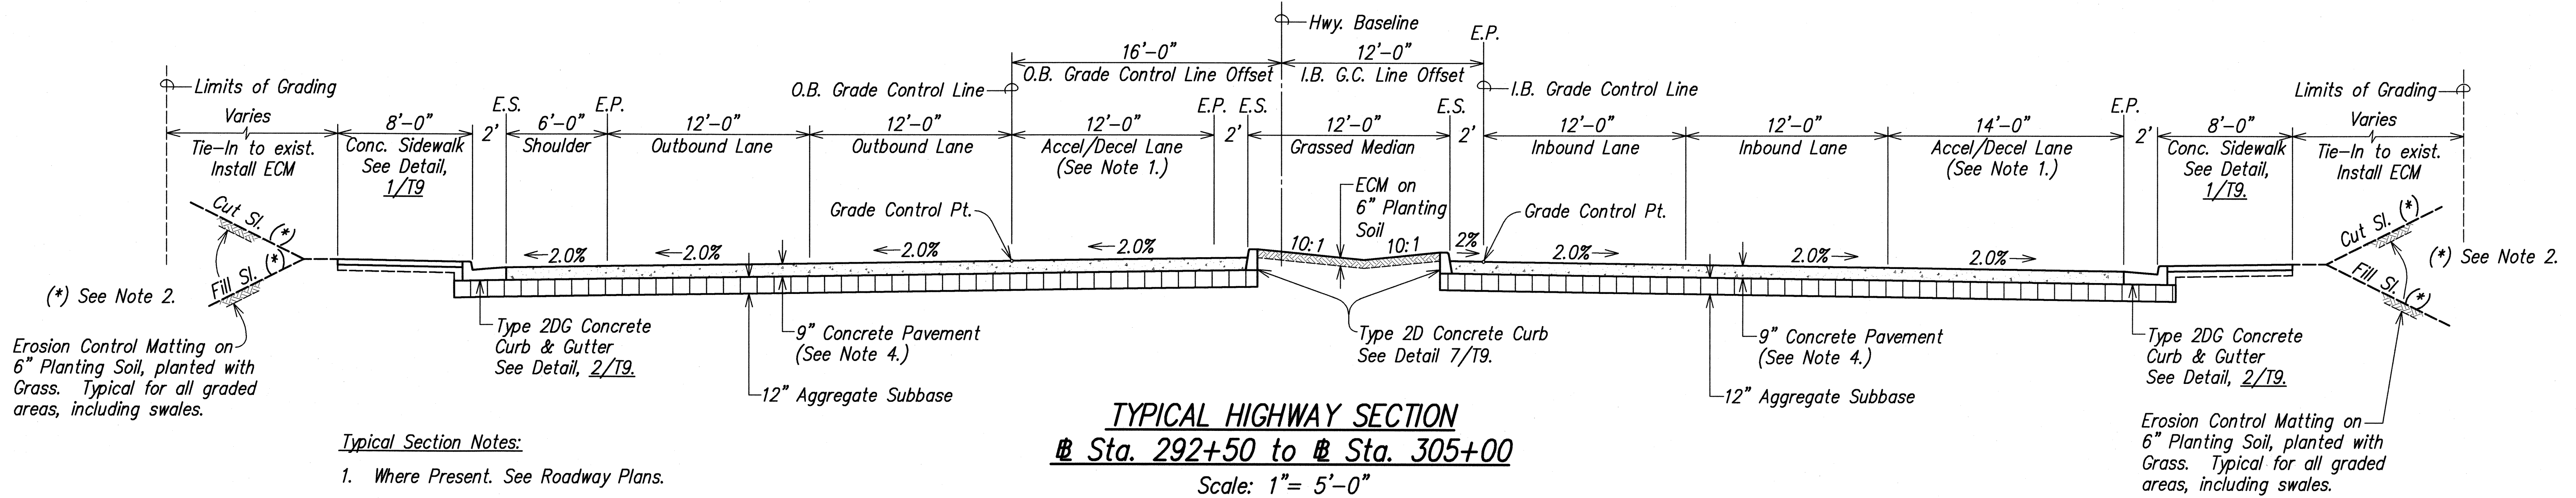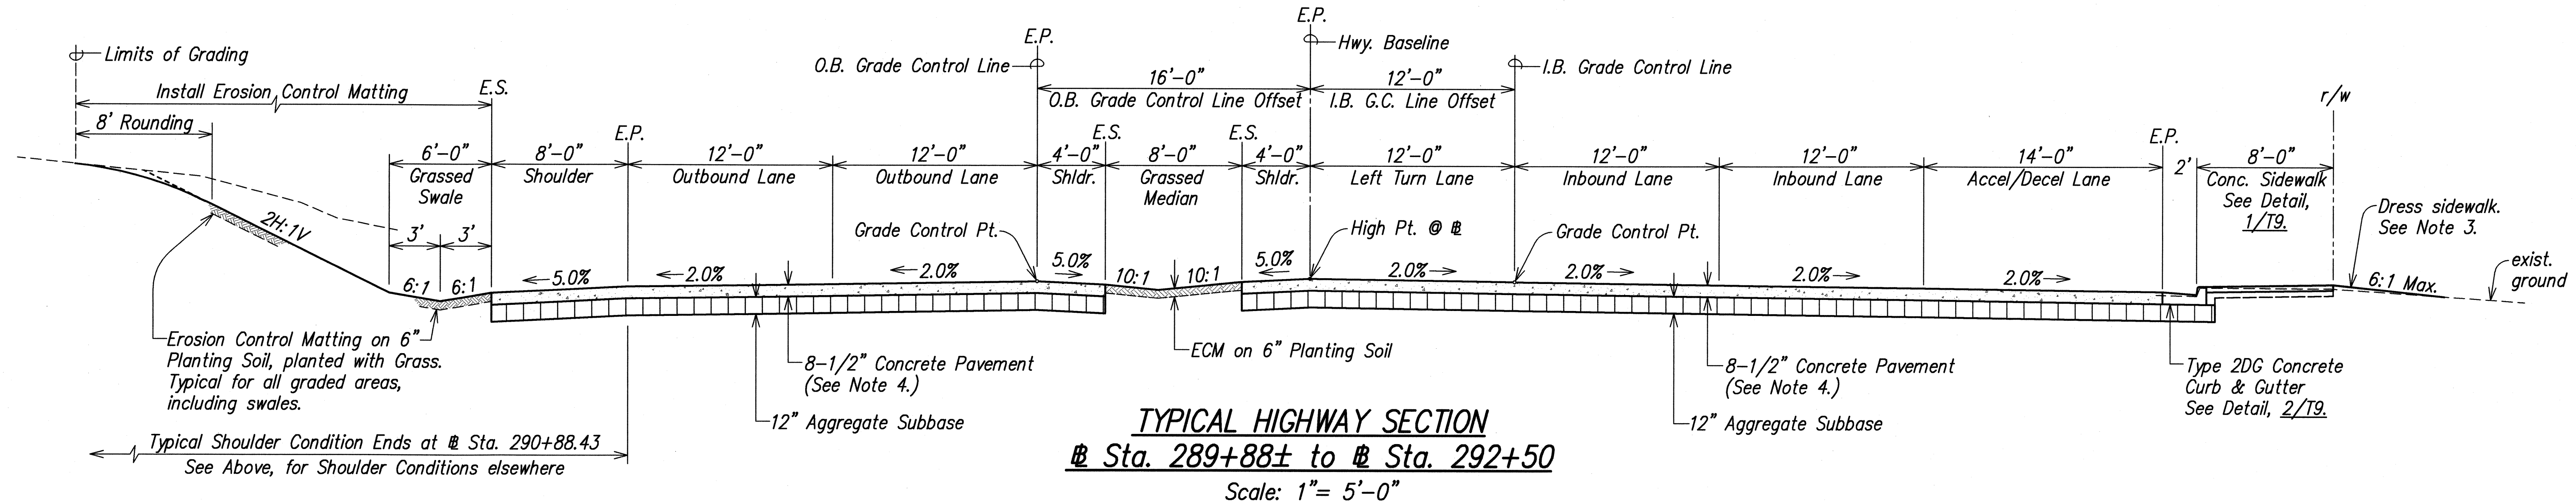


- Typical Section Notes:**
- Where Present. See Roadway Plans.
  - The slope of the cut or fill embankment varies with location. Unless otherwise noted, the cut or fill slope shall be maximum 2H:1V. See Grading Plans for location of various conditions.
  - Dressing of sidewalk shall consist of clearing, grubbing, grading, reshaping and compacting the unpaved shoulders with suitable material as shown on the plans and/or as directed by the Engineer. This work shall be considered incidental to the various contract items. See Detail 6/T9.
  - For Typical PCC Pavement details, see Sheets T13 and T14.

- Abbreviations:**
- E.P. Edge of New Pavement
  - E.S. Edge of New Shoulder
  - G.C. Grade Control
  - I.B. Inbound
  - O.B. Outbound
  - S.E. Superelevation
  - ECM Erosion Control Matting

|                   |      |
|-------------------|------|
| SURVEY PLOTTED BY | DATE |
| DRAWN BY          |      |
| DESIGNED BY       |      |
| CHECKED BY        |      |
| NOTE BOOK         |      |
| No.               |      |

100% STATE DOT KAUMUALII HIGHWAY REVISION PLANS, KAWAII, HAWAII, 11/29/08


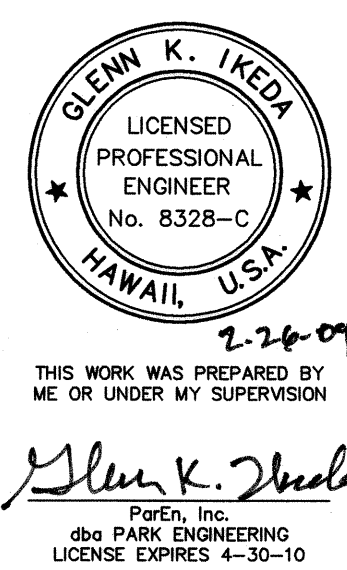


STATE OF HAWAII  
DEPARTMENT OF TRANSPORTATION  
HIGHWAYS DIVISION

**TYPICAL SECTIONS**  
  
KAUMUALII HIGHWAY WIDENING  
Vicinity of Anonui Street to Vicinity of Lihue Mill Bridge  
FEDERAL-AID PROJECT NO. NH-050-1(31)  
Scale: 1" = 5'  
Date: FEB. 2009

SHEET No. T3 OF T18 SHEETS

| FED. ROAD DIST. NO. | STATE | FED. AID PROJ. NO. | FISCAL YEAR | SHEET NO. | TOTAL SHEETS |
|---------------------|-------|--------------------|-------------|-----------|--------------|
| HAWAII              | HAW.  | NH-050-1(31)       | 2009        | 14        | 452          |

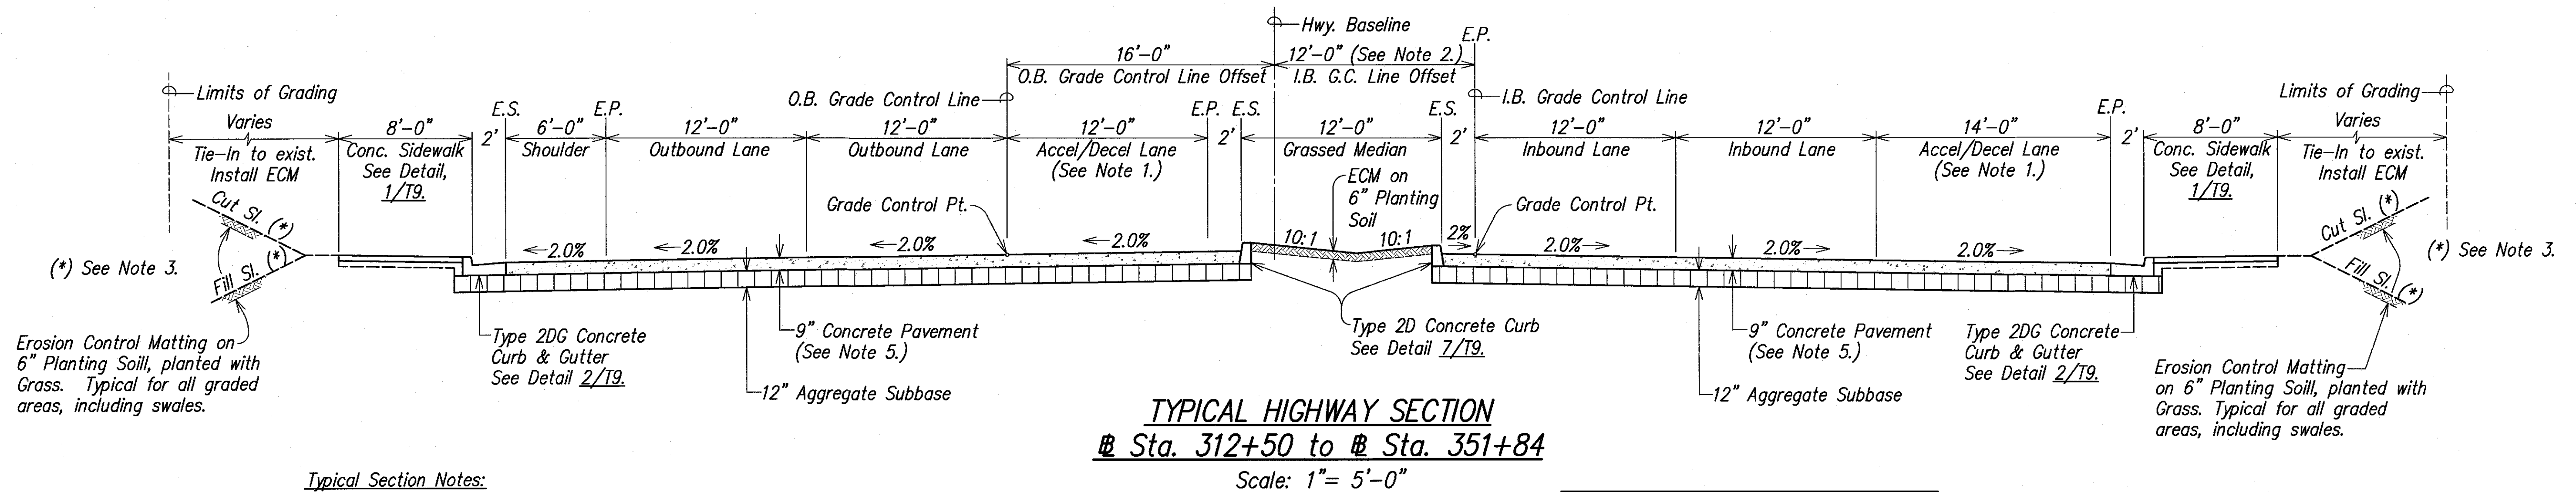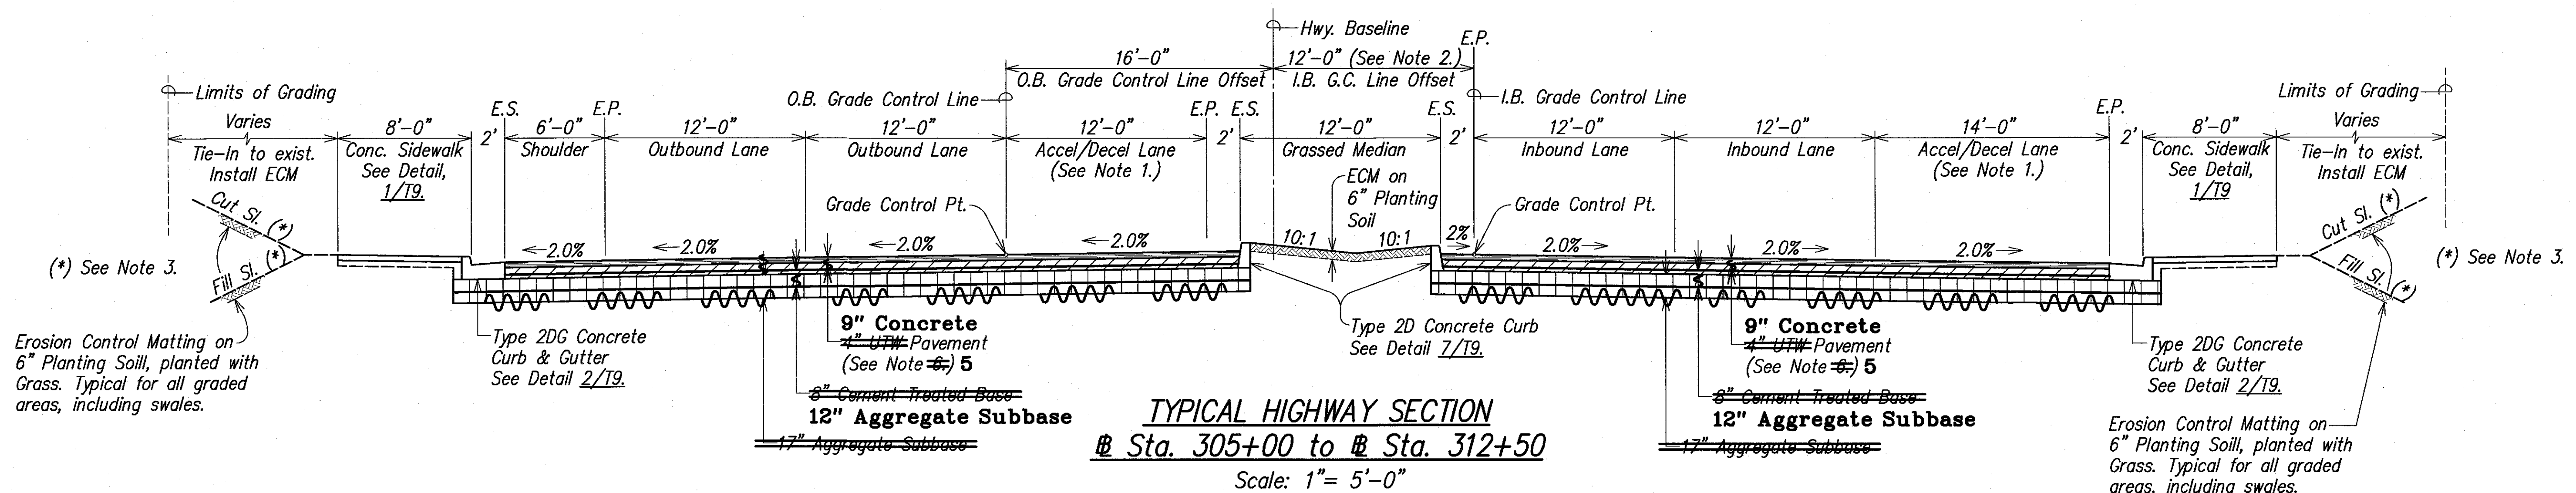

**Typical Section Notes:**

- Where Present. See Roadway Plans.
- Inbound Grade Control Line offset varies from 12' at Sta. 310+50 to 16' at Sta. 314+50.
- The slope of the cut or fill embankment varies with location. Unless otherwise noted, the cut or fill slope shall be maximum 2H:1V. See Grading Plans for location of various conditions.
- Remove exist. A.C. pavement and base course. Excavate to new subgrade. Scarify and recompact as required.
- For Typical PCC Pavement details, see Sheets T13 and T14.
- For Typical UTW Pavement details, see Sheets T16 and T17.

**Abbreviations:**


- E.P. Edge of New Pavement  
E.S. Edge of New Shoulder  
G.C. Grade Control  
I.B. Inbound  
O.B. Outbound  
S.E. Superelevation  
ECM Erosion Control Matting

**LEGEND FOR AS-BUILT POSTINGS**

Squiggly line for as-built deletion

Double line for as-built deletion

Text for as-built posting

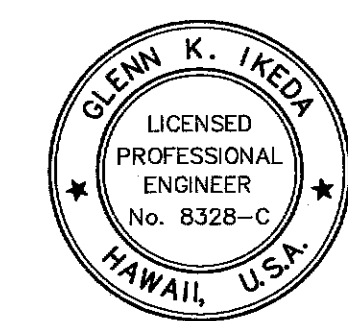

THIS WORK WAS PREPARED BY ME OR UNDER MY SUPERVISION

Glenn K. Ikeda  
Professional Engineer  
License Expires 4-30-16

STATE OF HAWAII  
DEPARTMENT OF TRANSPORTATION  
HIGHWAYS DIVISION

**TYPICAL SECTIONS**



KAUMUALI'1 HIGHWAY WIDENING  
Vicinity of Anonui Street to Vicinity of Lihue Mill Bridge  
FEDERAL-AID PROJECT NO. NH-050-1(31)

Scale: 1" = 5'

Date: JAN. 2010

SHEET No. T4 OF T18 SHEETS

| FED. ROAD DIST. NO. | STATE | FED. AID PROJ. NO. | FISCAL YEAR | SHEET NO. | TOTAL SHEETS |
|---------------------|-------|--------------------|-------------|-----------|--------------|
| HAWAII              | HAW.  | NH-050-1(31)       | 2009        | 14        | 452          |

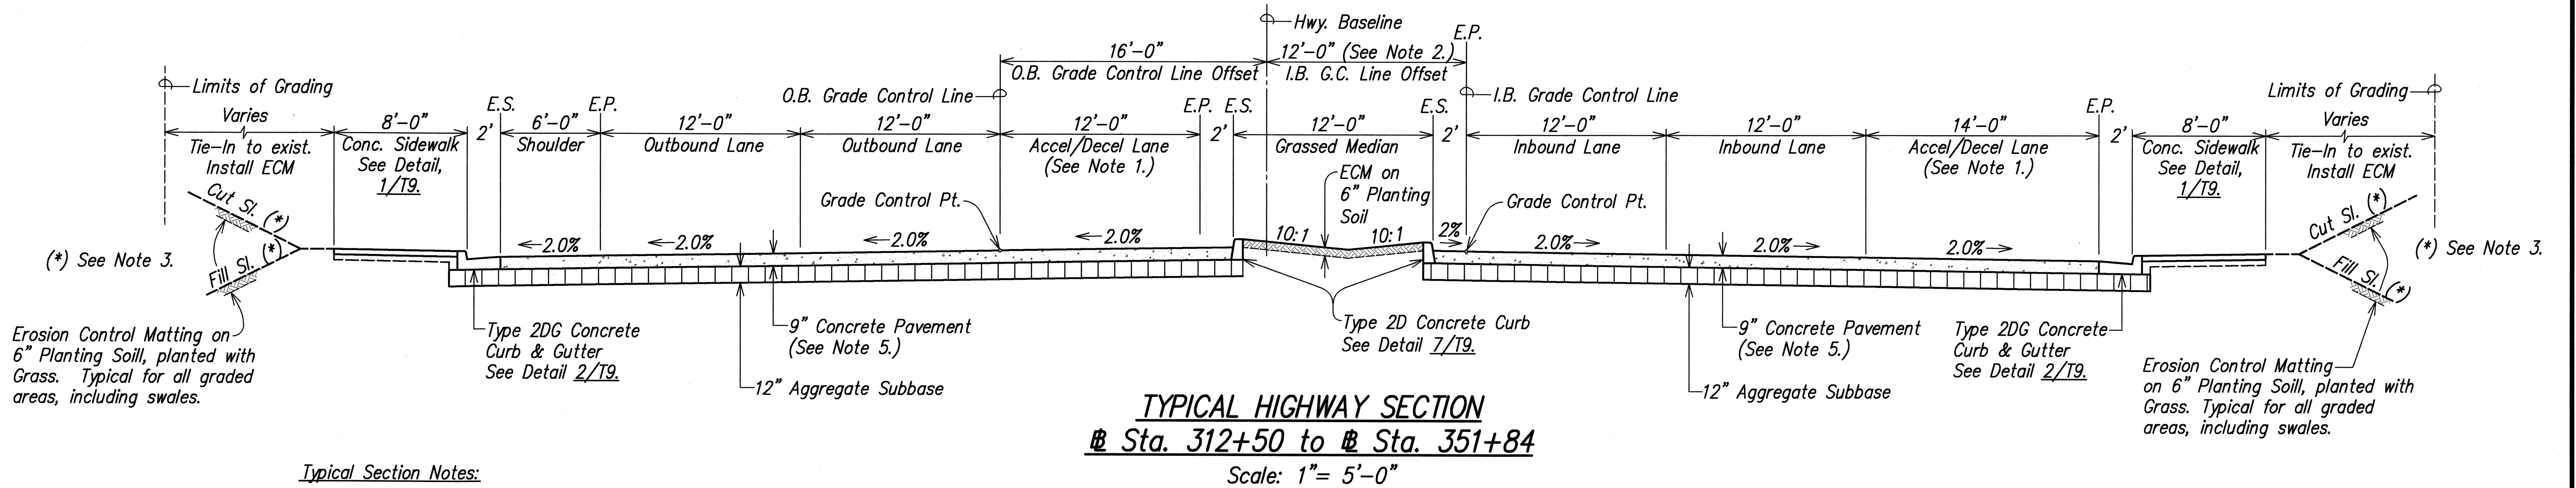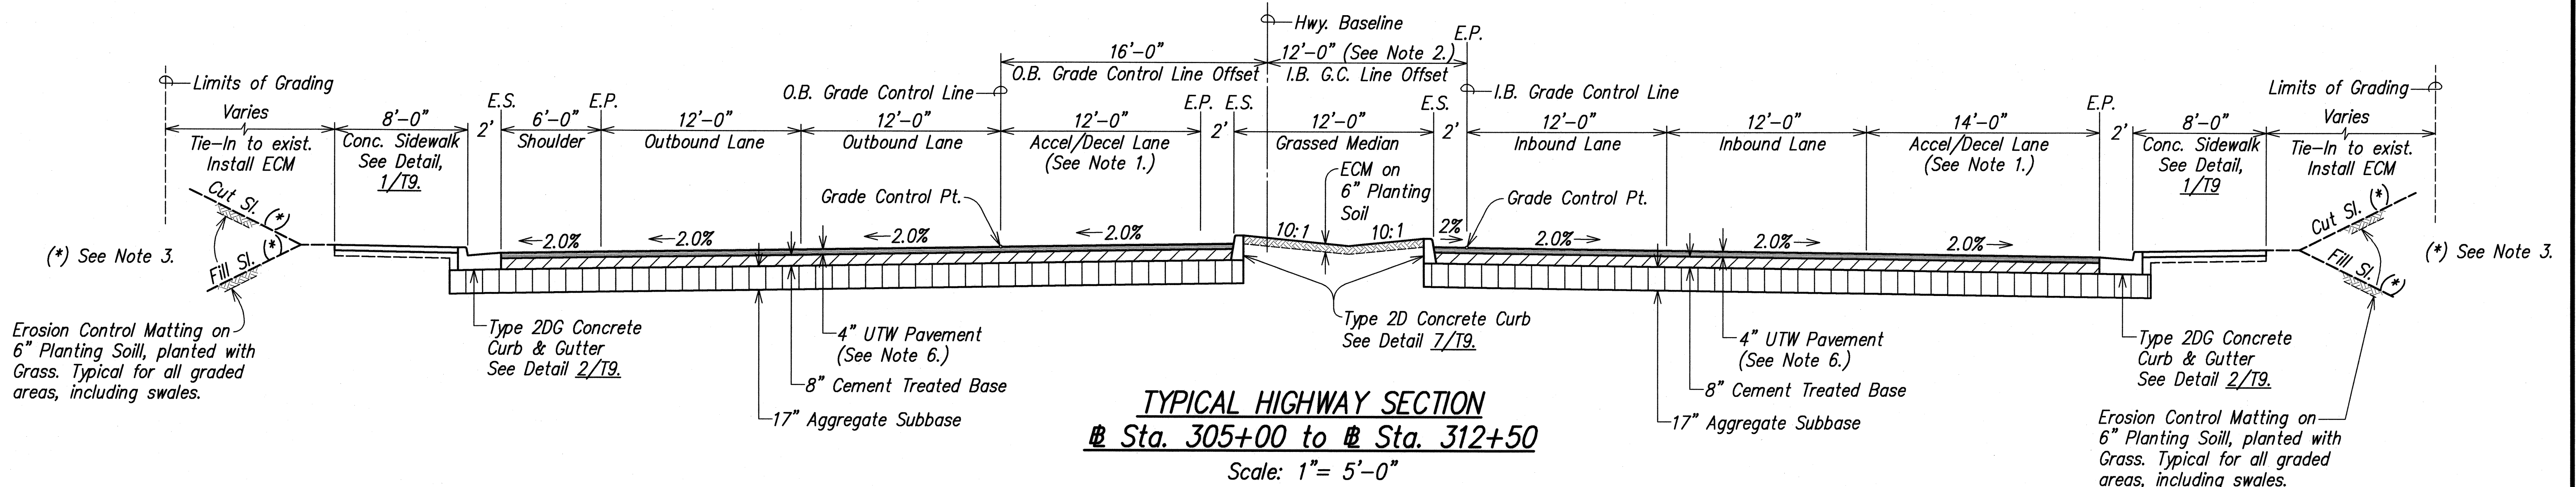


- Typical Section Notes:**
- Where Present. See Roadway Plans.
  - Inbound Grade Control Line offset varies from 12' at # Sta. 310+50 to 16' at # Sta. 314+50.
  - The slope of the cut or fill embankment varies with location. Unless otherwise noted, the cut or fill slope shall be maximum 2H:1V. See Grading Plans for location of various conditions.
  - Remove exist. A.C. pavement and base course. Excavate to new subgrade. Scarify and recompact as required.
  - For Typical PCC Pavement details, see Sheets T13 and T14.
  - For Typical UTW Pavement details, see Sheets T16 and T17.

- Abbreviations:**
- E.P. Edge of New Pavement
  - E.S. Edge of New Shoulder
  - G.C. Grade Control
  - I.B. Inbound
  - O.B. Outbound
  - S.E. Superelevation
  - ECM Erosion Control Matting

|                   |      |
|-------------------|------|
| SURVEY PLOTTED BY | DATE |
| DRAWN BY          |      |
| CHECKED BY        |      |
| NOTED BY          |      |
| QUANTITIES BY     |      |
| CHECKED BY        |      |
| ORIGINAL PLAN     |      |
| NOTE BOOK         |      |
| NO.               |      |

LIB. STATE DOT KAUNALANI REVISION PLAN, KAHALA, HI, 12/25/08

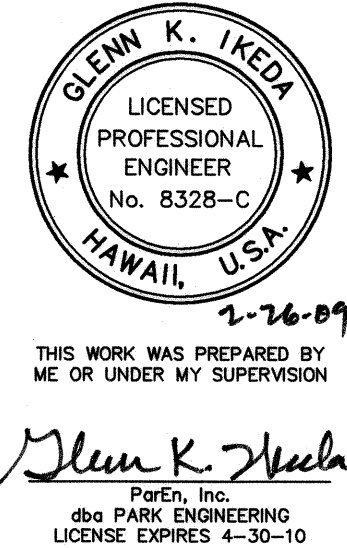

STATE OF HAWAII  
 DEPARTMENT OF TRANSPORTATION  
 HIGHWAYS DIVISION



**TYPICAL SECTIONS**

KAUNALANI HIGHWAY WIDENING  
 Vicinity of Anonui Street to Vicinity of Lihue Mill Bridge  
 FEDERAL-AID PROJECT NO. NH-050-1(31)

Scale: 1" = 5'  
 Date: FEB. 2009

SHEET No. T4 OF T18 SHEETS

| FED. ROAD DIST. NO. | STATE | FED. AID PROJ. NO. | FISCAL YEAR | SHEET NO. | TOTAL SHEETS |
|---------------------|-------|--------------------|-------------|-----------|--------------|
| HAWAII              | HAW.  | NH-050-1(31)       | 2009        | 15        | 452          |

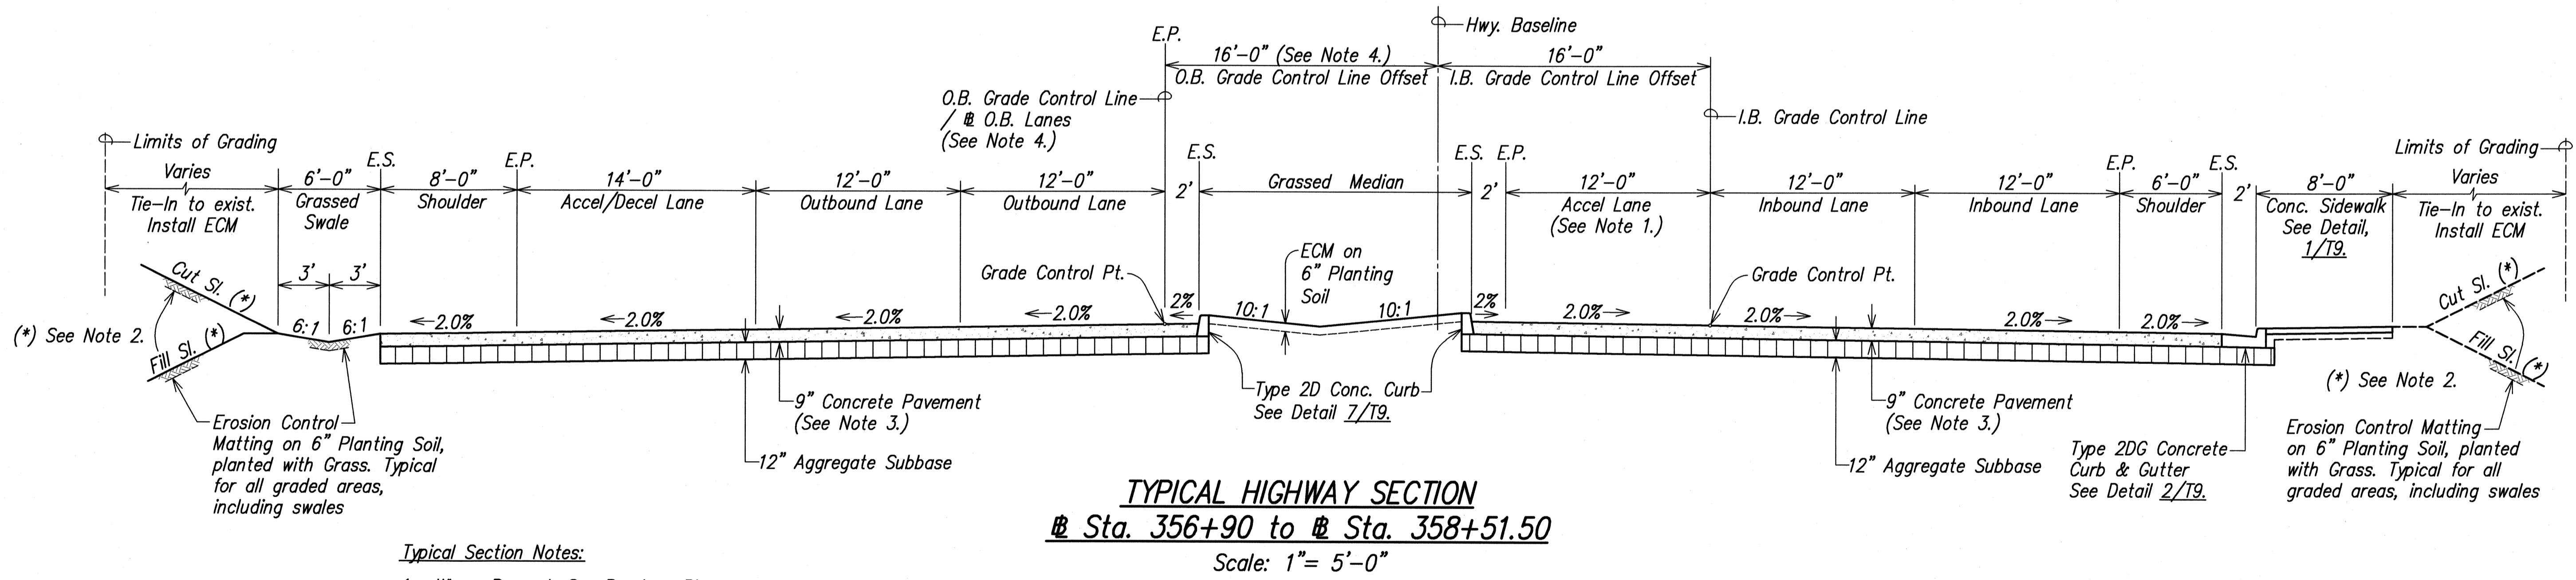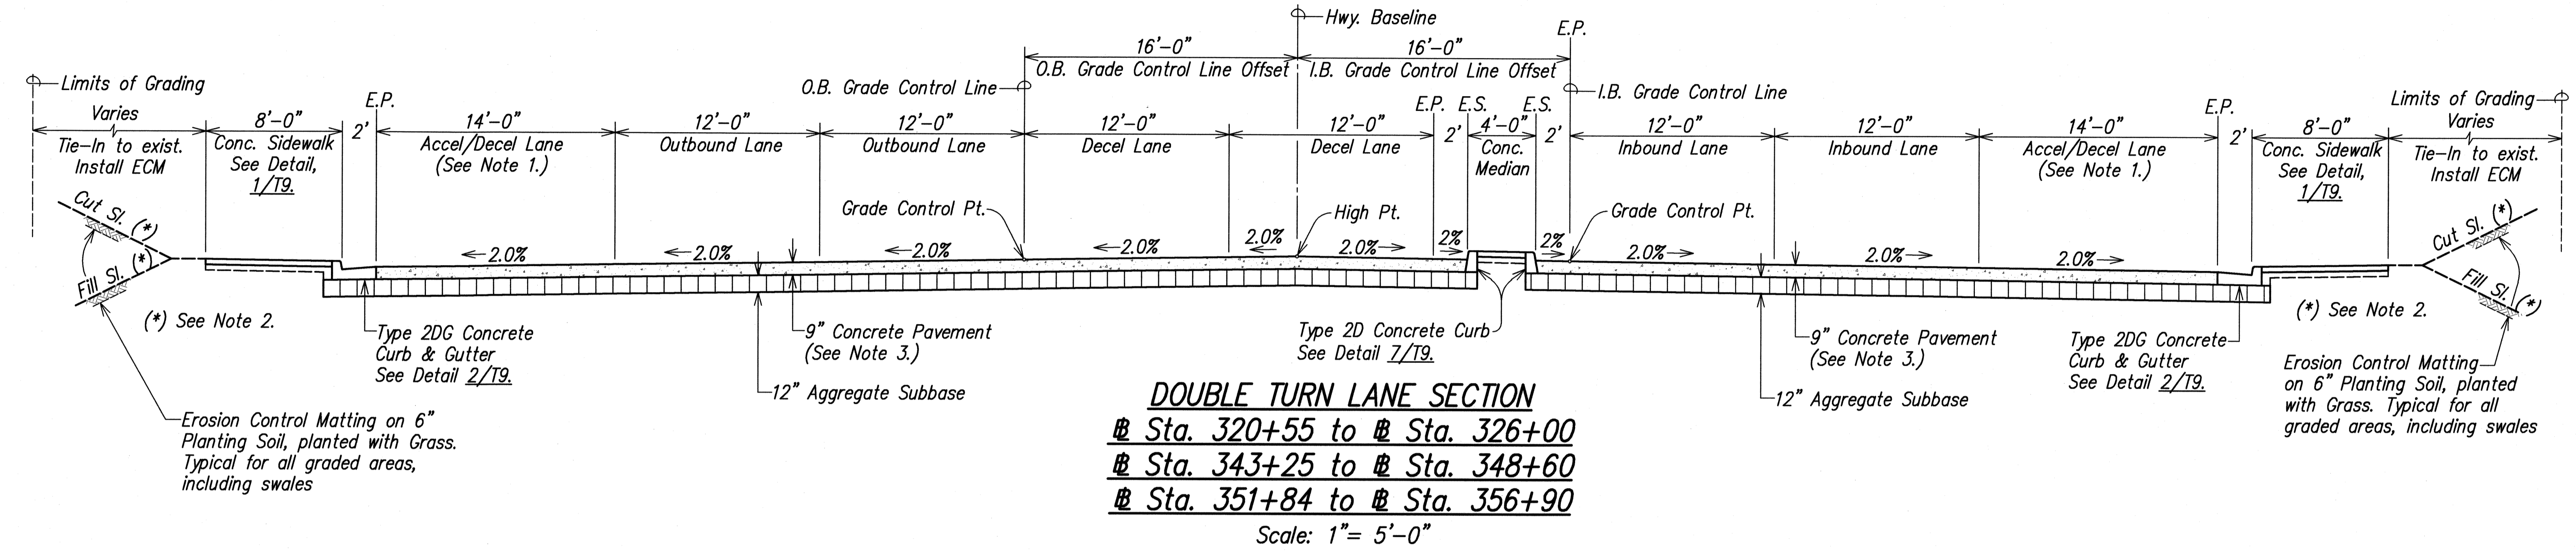


- Typical Section Notes:**
- Where Present. See Roadway Plans.
  - The slope of the cut or fill embankment varies with location. Unless otherwise noted, the cut or fill slope shall be maximum 2H:1V. See Grading Plans for location of various conditions.
  - For Typical PCC Pavement details, see Sheets T13 and T14.
  - The Highway Baseline ends at @ Sta. 358+51.50. The O.B. grade control line offset is 16'-0" at @ Sta. 356+94.42, whereafter an O.B. baseline starts and is used thereafter to establish location of outbound lanes.

- Abbreviations:**
- E.P. Edge of New Pavement
  - E.S. Edge of New Shoulder
  - G.C. Grade Control
  - I.B. Inbound
  - O.B. Outbound
  - S.E. Superelevation
  - ECM Erosion Control Matting

|               |      |
|---------------|------|
| ORIGINAL PLAN | DATE |
| NOTE BOOK     |      |
| DESIGNED BY   |      |
| CHECKED BY    |      |
| NO.           |      |

1002 STATE/0001/KAUAI/1/PHASE1/REVISION/1/28/08


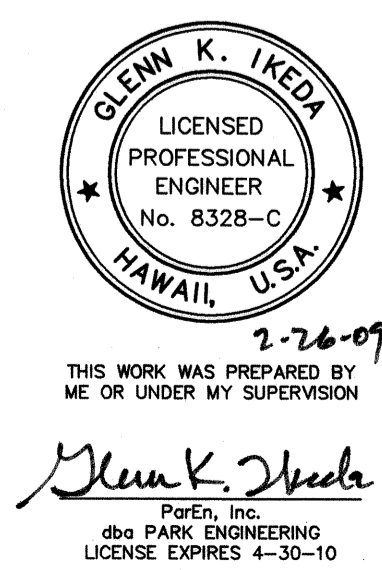


STATE OF HAWAII  
 DEPARTMENT OF TRANSPORTATION  
 HIGHWAYS DIVISION

**TYPICAL SECTIONS**

KAUAI/0001/KAUAI/1/PHASE1/REVISION/1/28/08  
 Vicinity of Anonui Street to Vicinity of Lihue Mill Bridge  
 FEDERAL-AID PROJECT NO. NH-050-1(31)  
 Scale: 1" = 5' Date: FEB. 2009  
 SHEET No. T5 OF T18 SHEETS

| FED. ROAD DIST. NO. | STATE | FED. AID PROJ. NO. | FISCAL YEAR | SHEET NO. | TOTAL SHEETS |
|---------------------|-------|--------------------|-------------|-----------|--------------|
| HAWAII              | HAW.  | NH-050-1(31)       | 2009        | 16        | 452          |

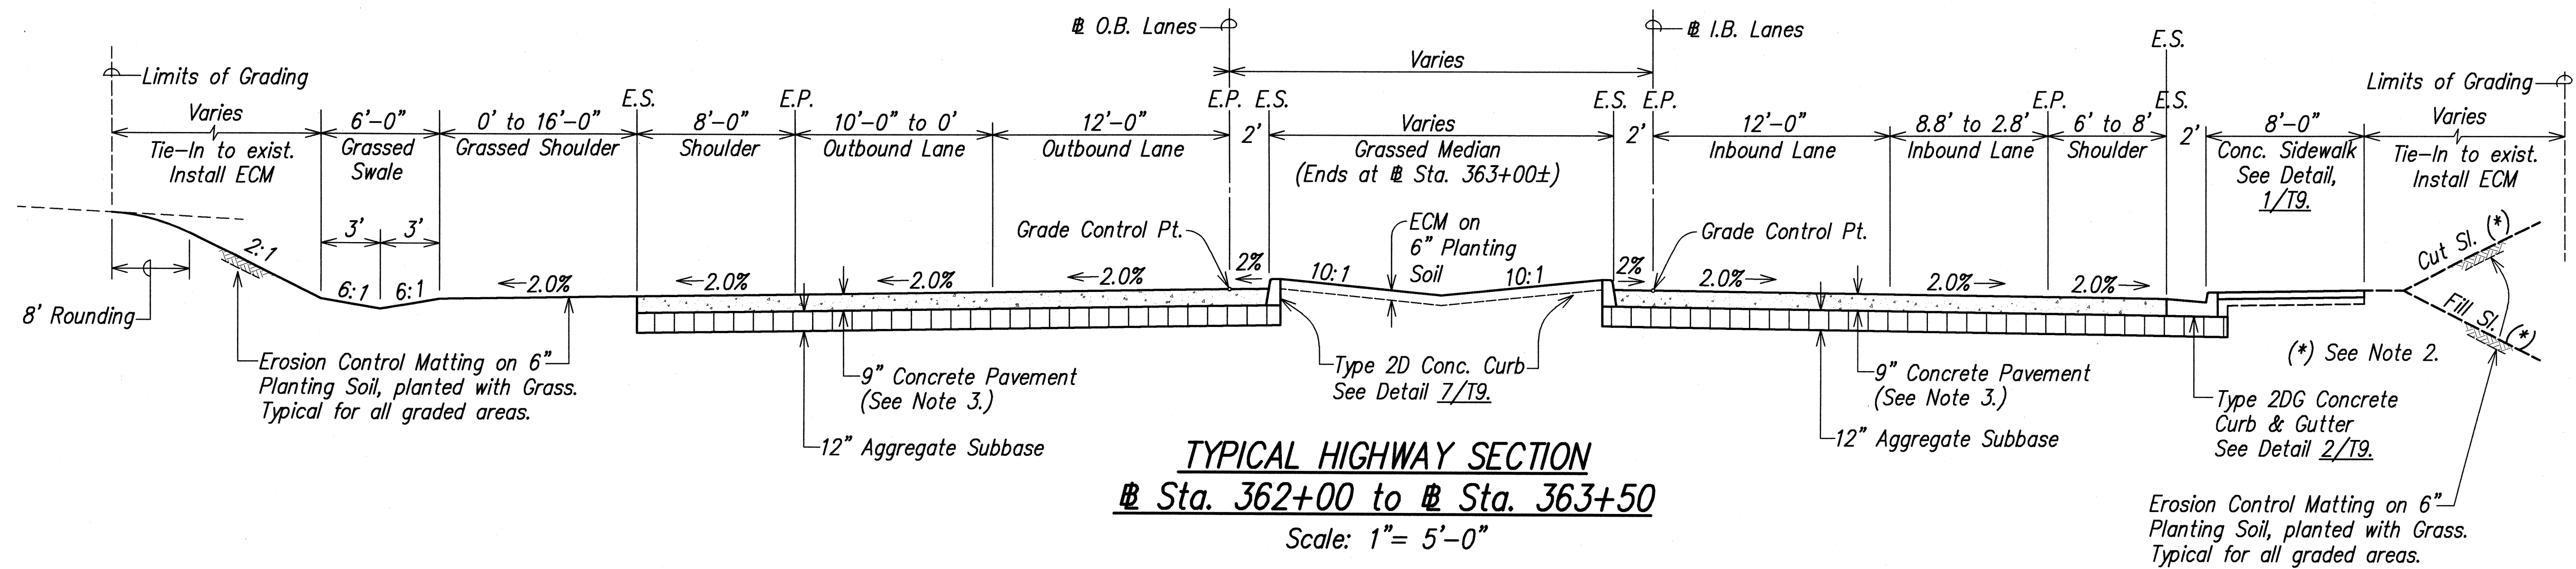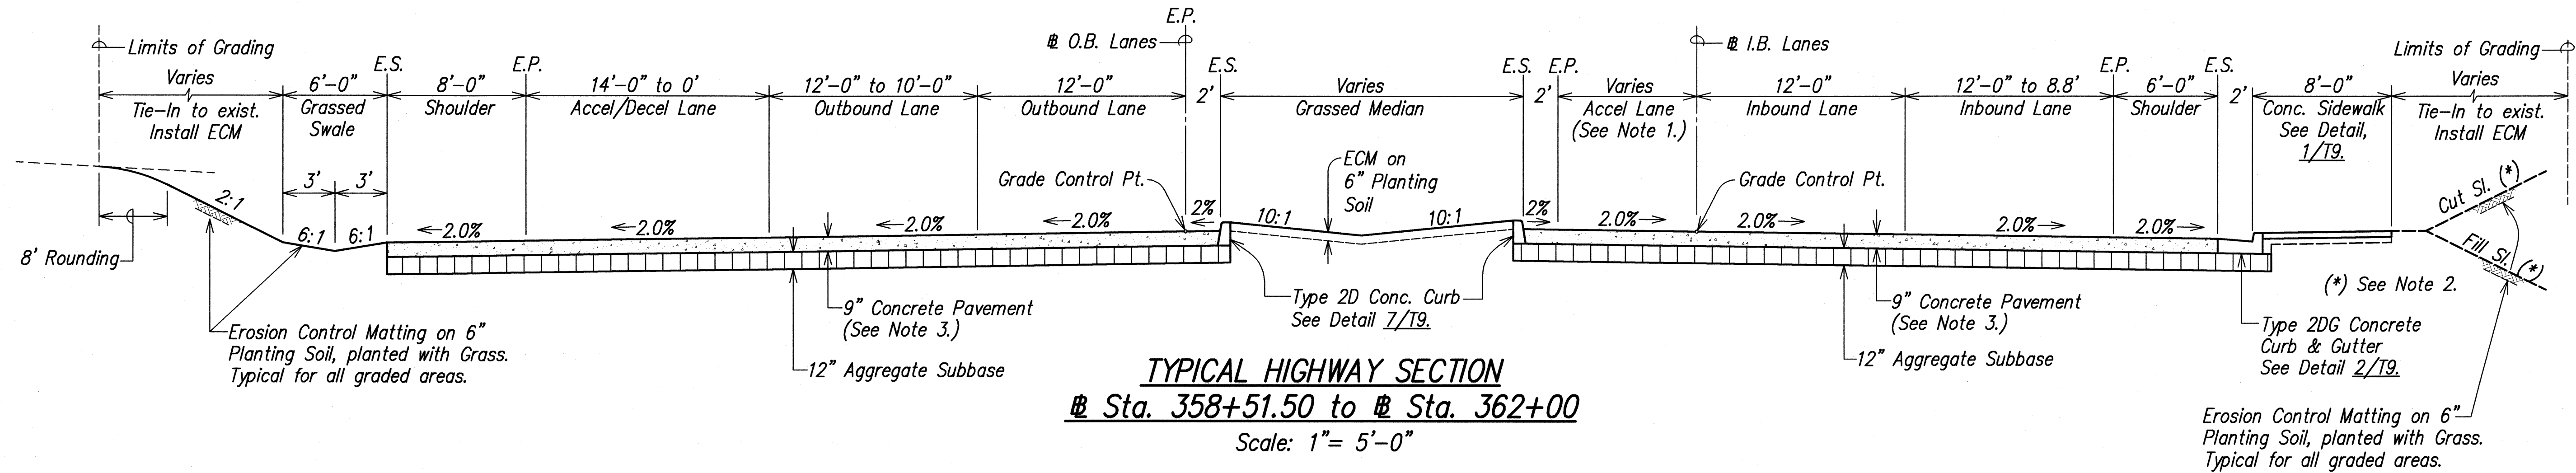

Typical Section Notes:

- Where Present. See Roadway Plans.
- The slope of the cut or fill embankment varies with location. Unless otherwise noted, the cut or fill slope shall be maximum 2H:1V. See Grading Plans for location of various conditions.
- For Typical PCC Pavement details, see Sheets T13 and T14.

Abbreviations:

- E.P. Edge of New Pavement
- E.S. Edge of New Shoulder
- G.C. Grade Control
- I.B. Inbound
- O.B. Outbound
- S.E. Superelevation

|               |      |
|---------------|------|
| ORIGINAL PLAN | DATE |
| NOTE BOOK     |      |
| DESIGNED BY   |      |
| QUANTITIES BY |      |
| CHECKED BY    |      |
| No.           |      |


LIB2: STATE DOT\KAMUALII HIGHWAY WIDENING\PROJECTS\NH-050-1(31)\TYPICAL SECTIONS\TYPICAL SECTIONS\T16.dwg 11/28/08



THIS WORK WAS PREPARED BY ME OR UNDER MY SUPERVISION  
Glenn K. Ikeda  
P.E., Inc.  
dba PARK ENGINEERING  
LICENSE EXPIRES 4-30-10


STATE OF HAWAII  
DEPARTMENT OF TRANSPORTATION  
HIGHWAYS DIVISION  
  
**TYPICAL SECTIONS**  
  
KAUMUALII HIGHWAY WIDENING  
Vicinity of Anonui Street to Vicinity of Lihue Mill Bridge  
FEDERAL-AID PROJECT NO. NH-050-1(31)  
Scale: 1" = 5' Date: FEB. 2009  
SHEET No. T6 OF T18 SHEETS



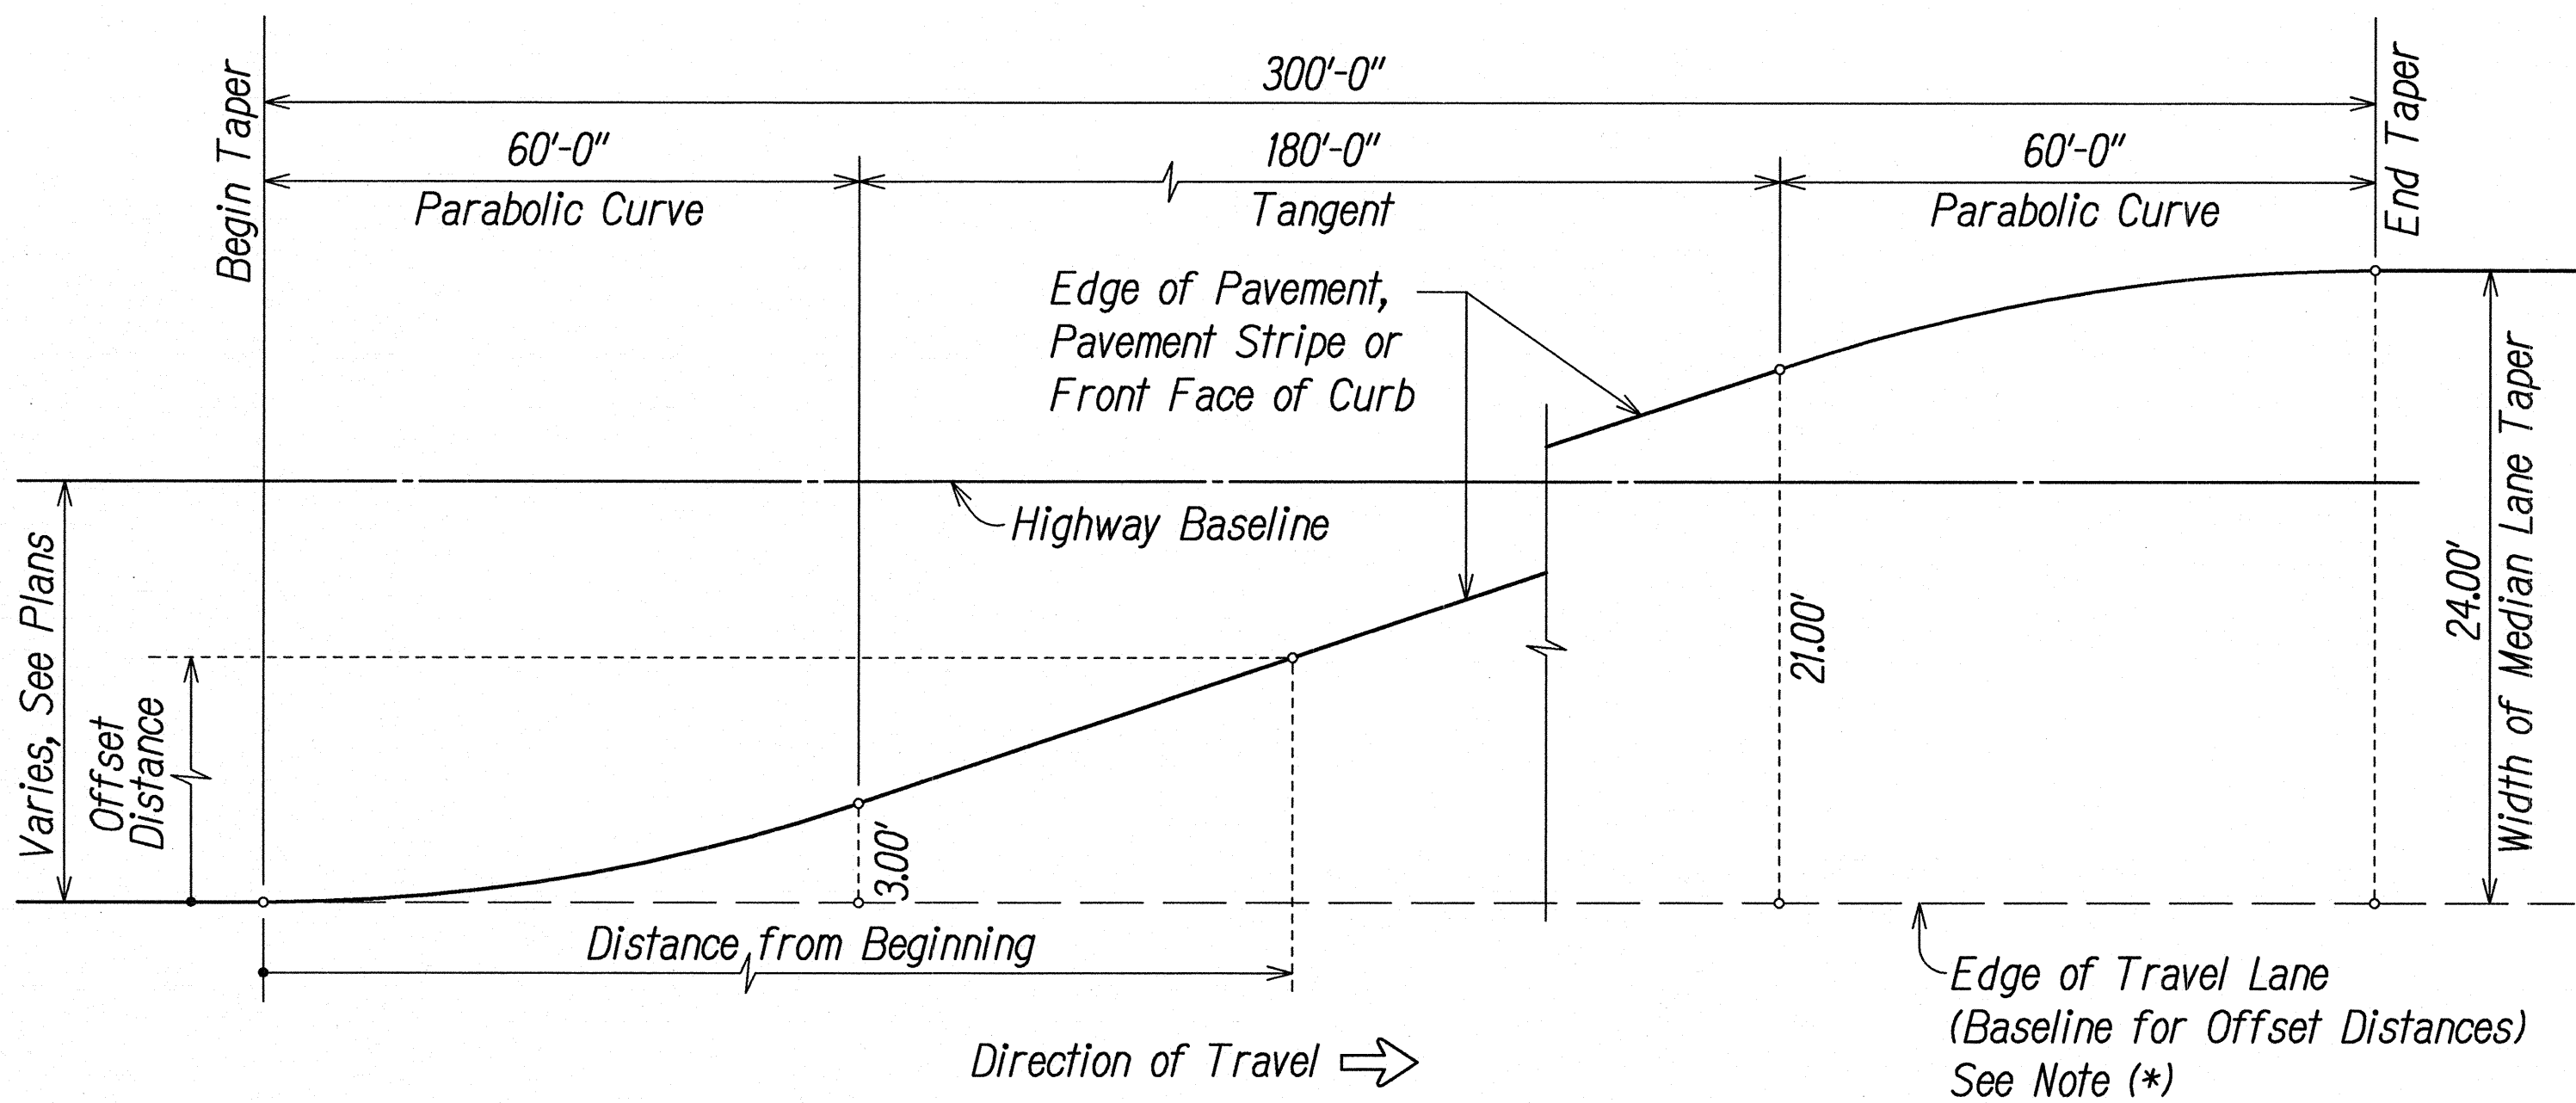

Taper Plan (300-Ft Length)

*Note (\*):*  
Where edge of travel lane is a curve, neither baseline or taper along tangent section will be a tangent. Use proportional offsets within this section.

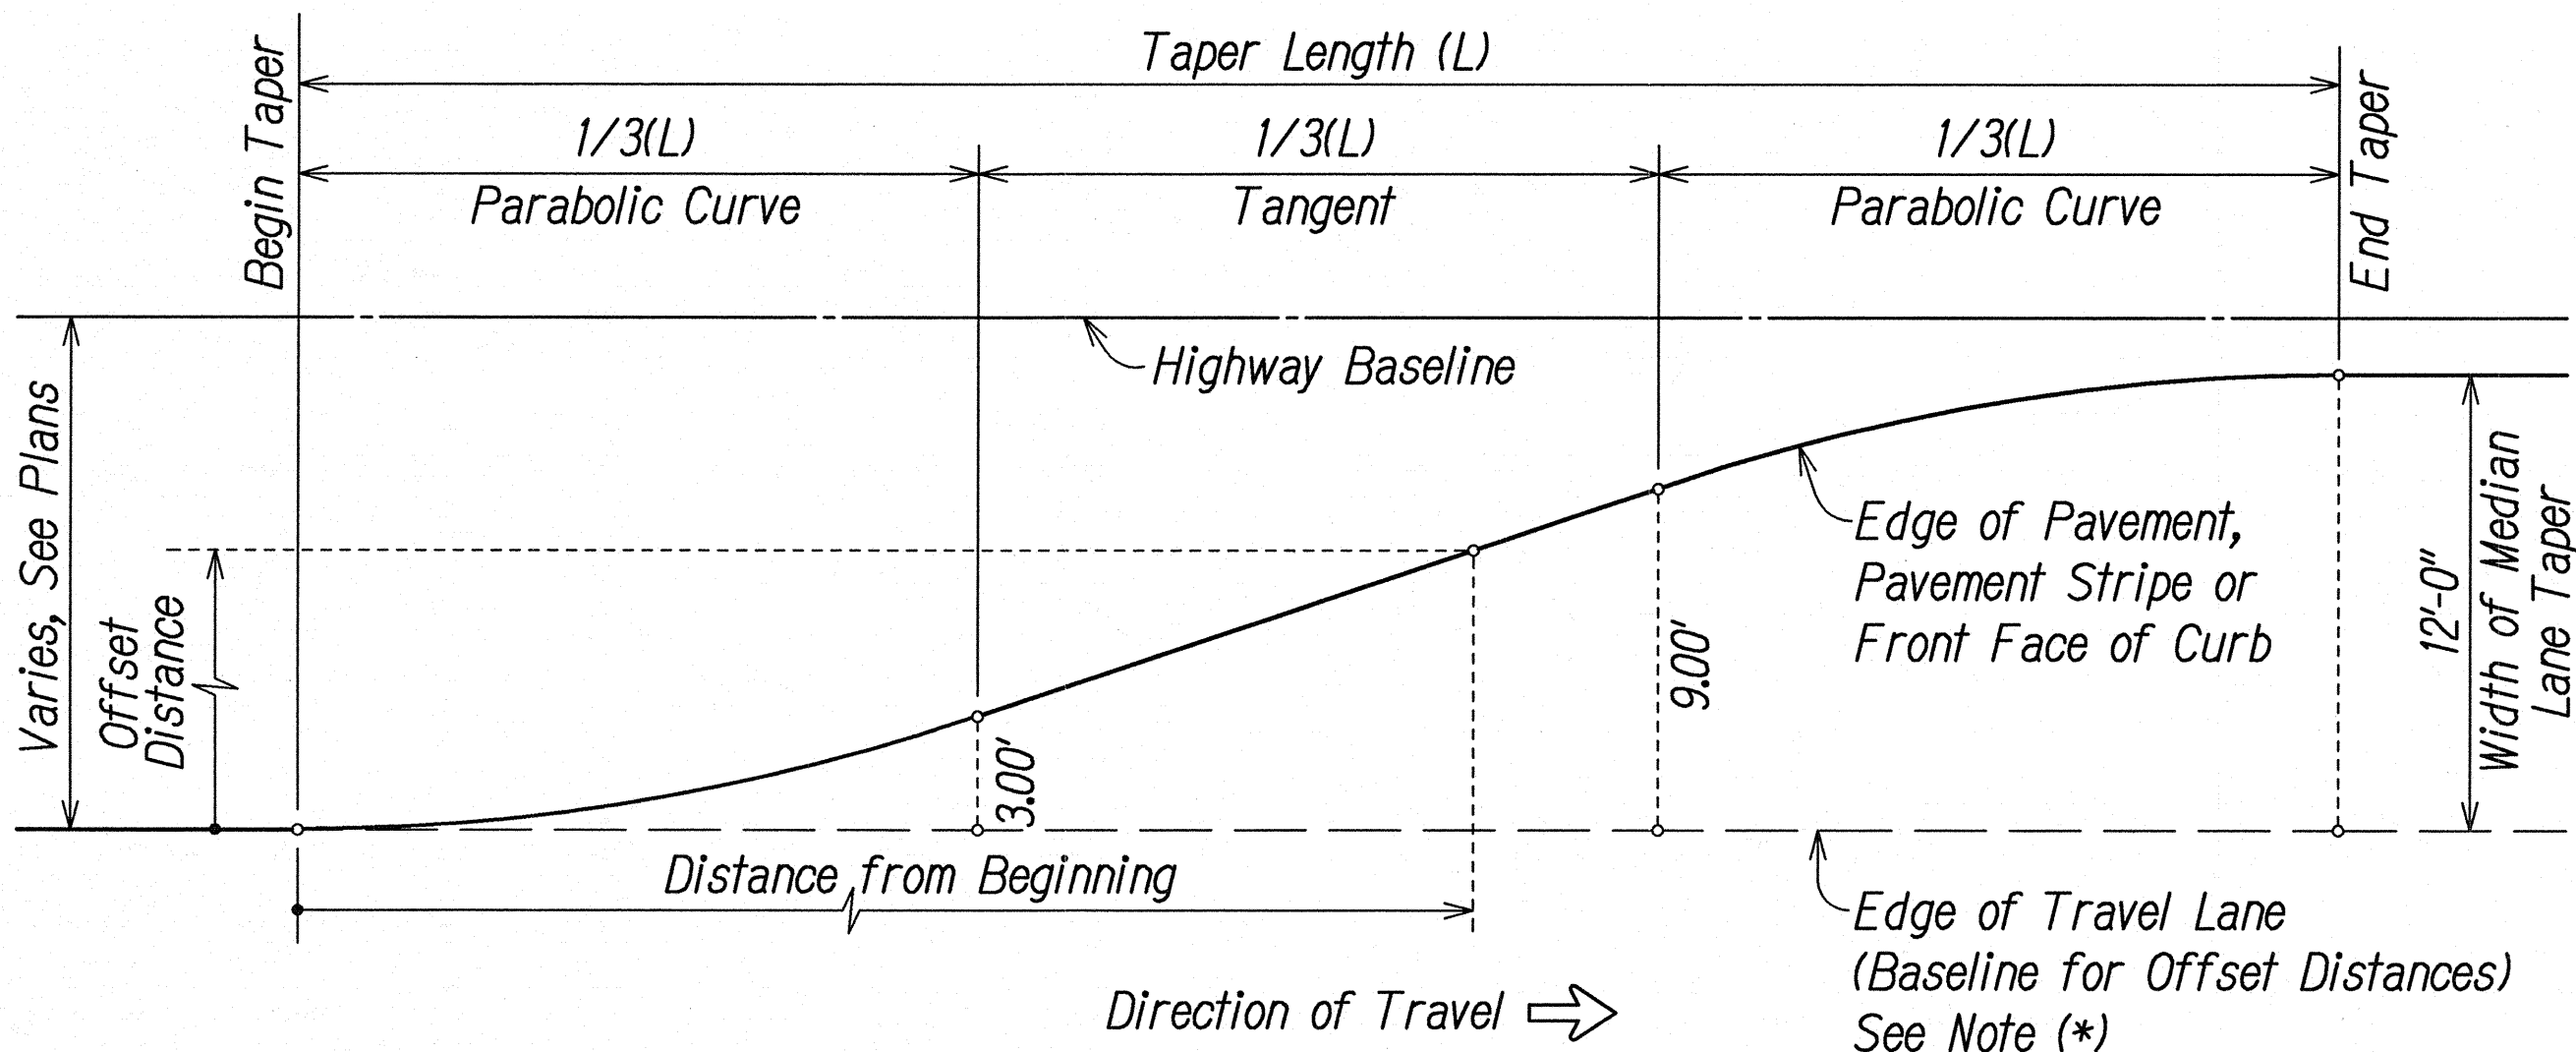

Taper Plan (90-Ft, 120-Ft or 180-Ft Length)

**TYPICAL MEDIAN LANE TAPER DETAIL**

Not to Scale

CL1 to CL10, C5.8

1  
T8

| Table of Offset Distances for Median Taper |                 |                         |                 |                         |                 |                         |                 |
|--|-----------------|-------------------------|-----------------|-------------------------|-----------------|-------------------------|-----------------|
| 90-Ft. Long Taper                          |                 | 120-Ft. Long Taper      |                 | 180-Ft. Long Taper      |                 | 300-Ft. Long Taper      |                 |
| Distance from Beginning                    | Offset Distance | Distance from Beginning | Offset Distance | Distance from Beginning | Offset Distance | Distance from Beginning | Offset Distance |
| 0  | 0.00            | 0                       | 0.00            | 0                       | 0.00            | 0                       | 0.00            |
| 7.5  | 0.19            | 10                      | 0.19            | 15                      | 0.19            | 15                      | 0.19            |
| 15   | 0.75            | 20                      | 0.75            | 30                      | 0.75            | 30                      | 0.75            |
| 22.5                                       | 1.69            | 30                      | 1.69            | 45                      | 1.69            | 45                      | 1.69            |
| 30   | 3.00            | 40                      | 3.00            | 60                      | 3.00            | 60                      | 3.00            |
| 45   | 6.00            | 60                      | 6.00            | 90                      | 6.00            | 150                     | 12.00           |
| 60   | 9.00            | 80                      | 9.00            | 120                     | 9.00            | 240                     | 21.00           |
| 67.5                                       | 10.31           | 90                      | 10.31           | 135                     | 10.31           | 255                     | 22.31           |
| 75   | 11.25           | 100                     | 11.25           | 150                     | 11.25           | 270                     | 23.25           |
| 82.5                                       | 11.81           | 110                     | 11.81           | 165                     | 11.81           | 285                     | 23.81           |
| 90   | 12.00           | 120                     | 12.00           | 180                     | 12.00           | 300                     | 24.00           |

|                   |      |
|-------------------|------|
| SURVEY PLOTTED BY | DATE |
| DRAWN BY          |      |
| DESIGNED BY       |      |
| QUANTITIES BY     |      |
| CHECKED BY        |      |
| ORIGINAL PLAN     |      |
| NOTE BOOK         |      |
| No.               |      |

LIB2: STATE/DOH/KAUAI/1-1/PHASE1A/REVISION/PLANS/CD1-108-800ET.dwg 1/15/10




THIS WORK WAS PREPARED BY ME OR UNDER MY SUPERVISION  
Glen K. Ikeda  
Professional Engineer  
License Expires 4-30-10

|  |                                    |
|--|------------------------------------|
| 2/01/10  | Added Data for 90-Foot Long Taper. |
| DATE   | REVISION                           |
| STATE OF HAWAII<br>DEPARTMENT OF TRANSPORTATION<br>HIGHWAYS DIVISION   |                                    |
| <b>ROADWAY DETAILS</b>   |                                    |
| KAUAI/KAUAI HIGHWAY WIDENING<br>Vicinity of Anonui Street to Vicinity of Lihue Mill Bridge<br>FEDERAL-AID PROJECT NO. NH-050-1(31) |                                    |
| Scale: As Noted  | Date: JAN. 2010                    |
| SHEET No. T8 OF T18 SHEETS   |                                    |




| FED. ROAD DIST. NO. | STATE | FED. AID PROJ. NO. | FISCAL YEAR | SHEET NO. | TOTAL SHEETS |
|---------------------|-------|--------------------|-------------|-----------|--------------|
| HAWAII              | HAW.  | NH-050-1(31)       | 2009        | 19        | 452          |


1. For location, placement and spacing of Transverse Contraction Joints, see Detail 3/T9.
2. For location and placement of Isolation Joints at Manholes, Poles, Structure, etc. within sidewalk, see Detail 4/T9.

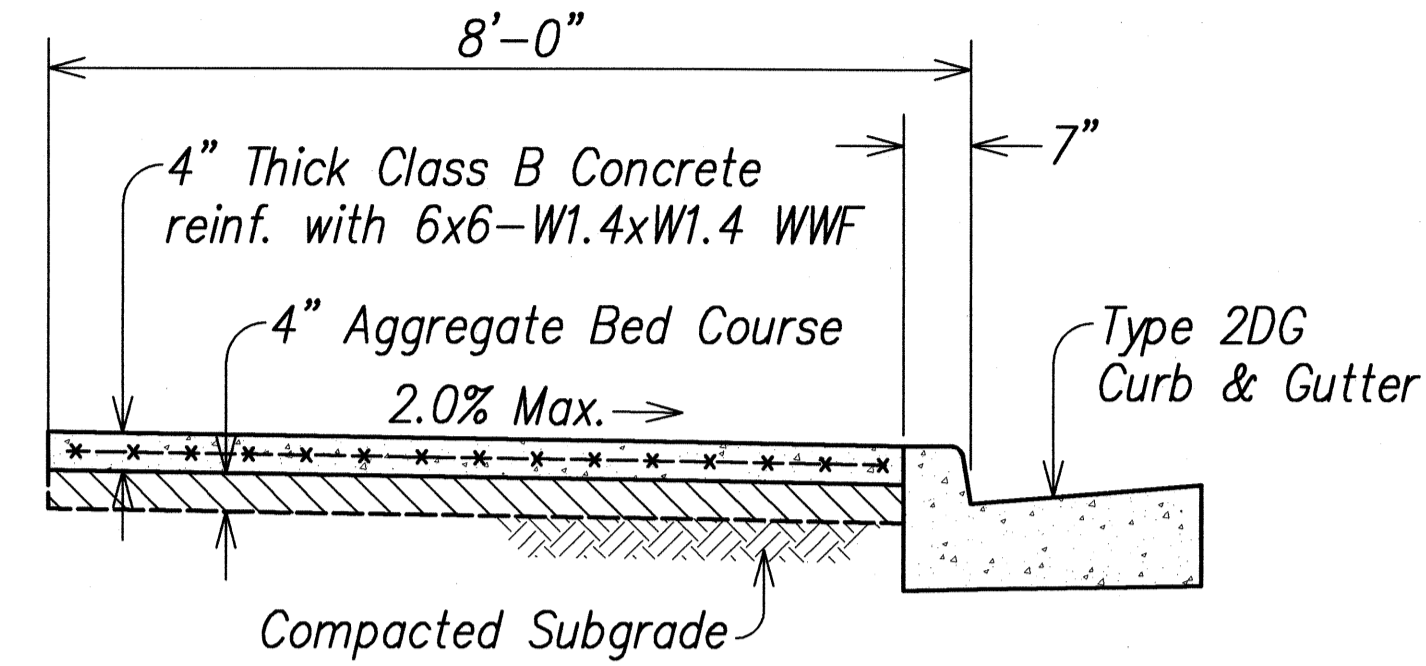


**TYPICAL CONCRETE SIDEWALK DETAIL**  
Scale: 1/2" = 1'-0"  
T3 to T7

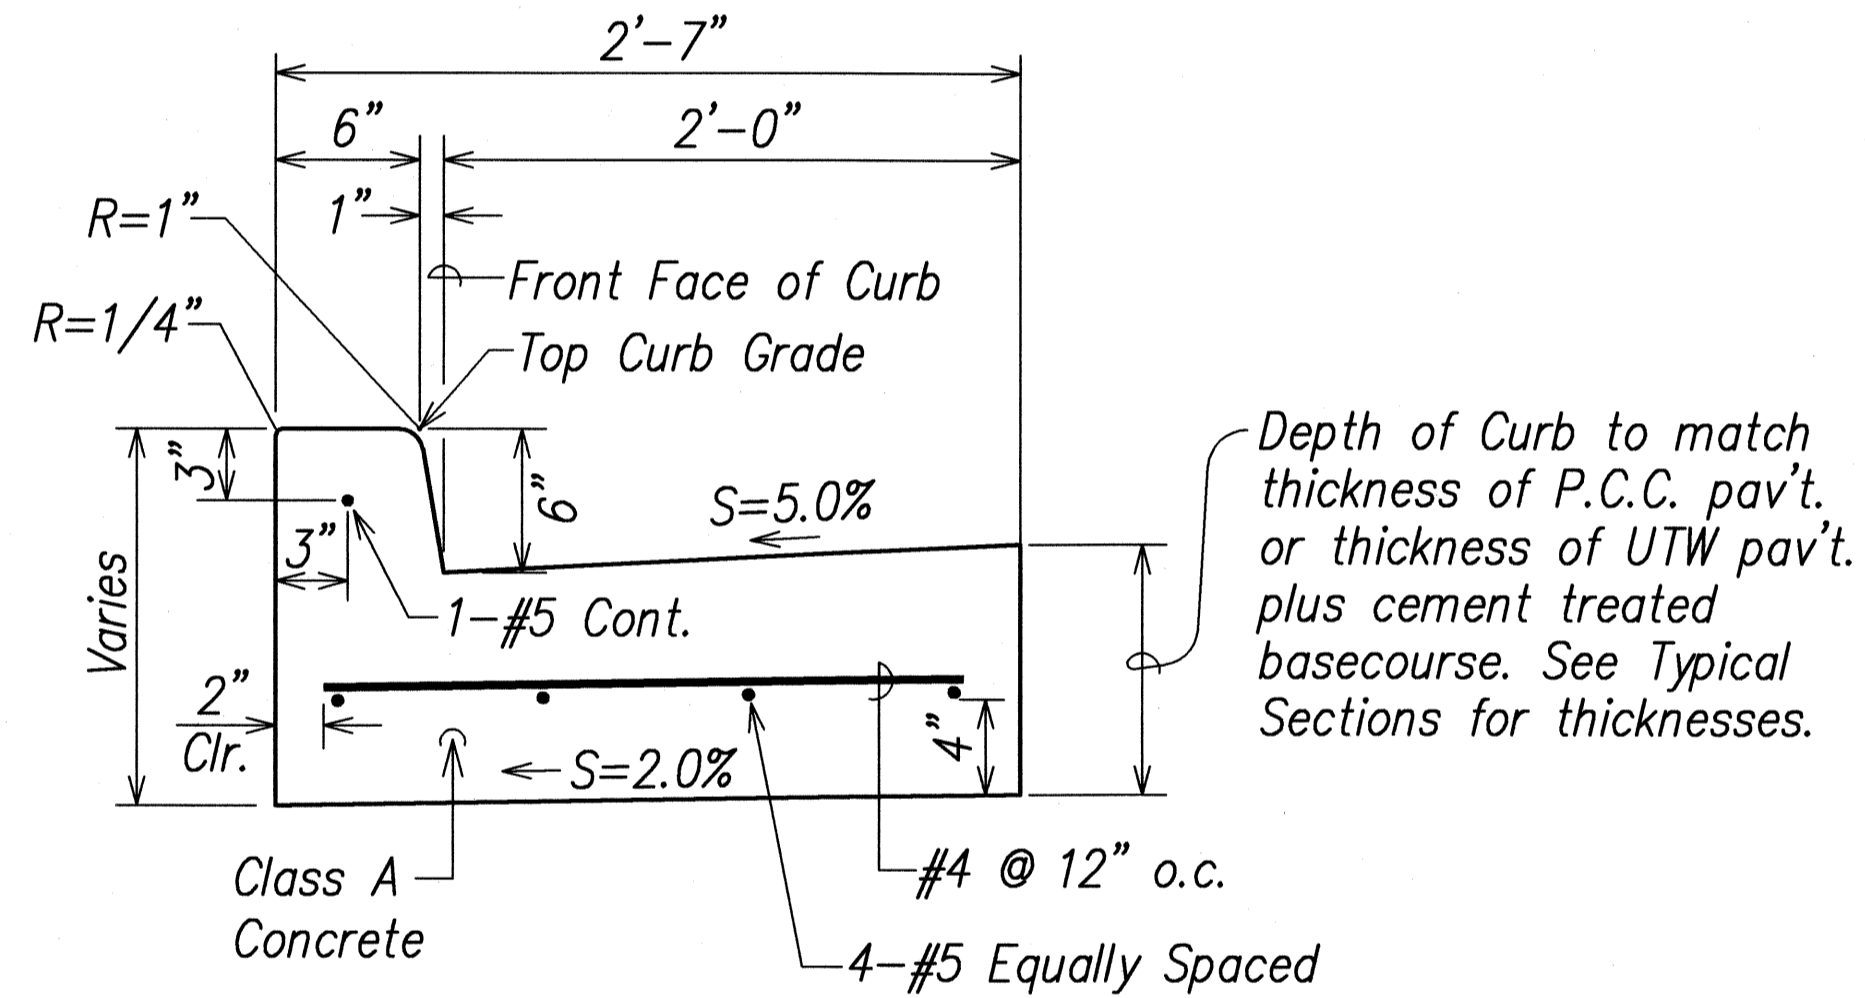


**REINFORCED TYPE 2DG CONCRETE CURB & GUTTER DETAIL**  
Scale: 1-1/2" = 1'-0"  
T3 to T7

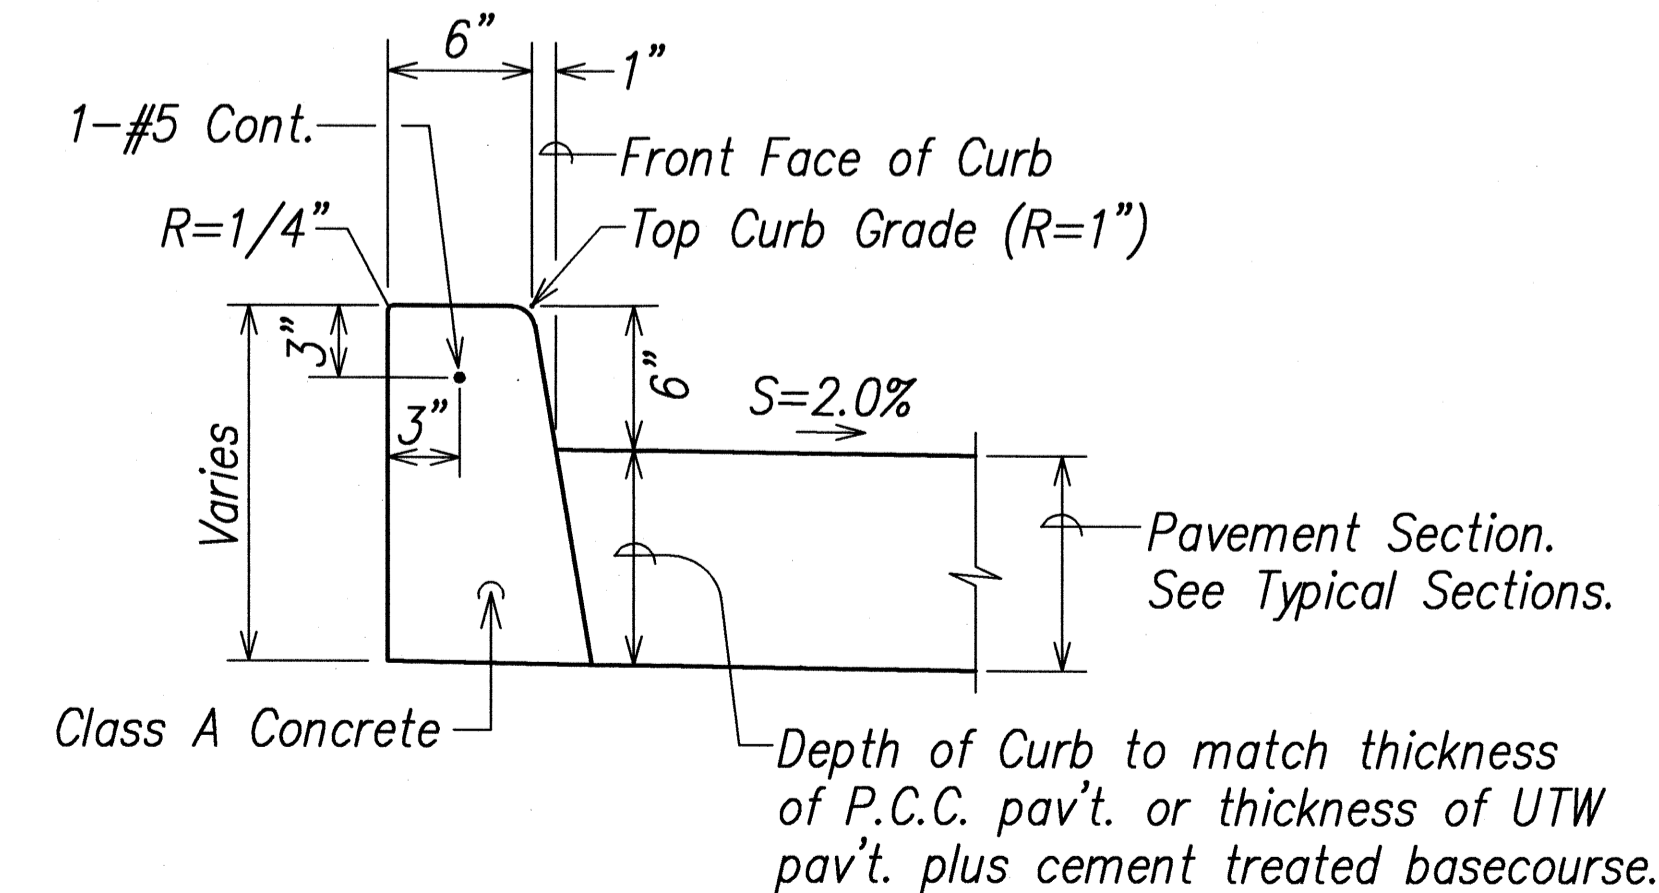


**REINFORCED TYPE 2D CONCRETE CURB DETAIL**  
Scale: 1-1/2" = 1'-0"  
T3 to T7

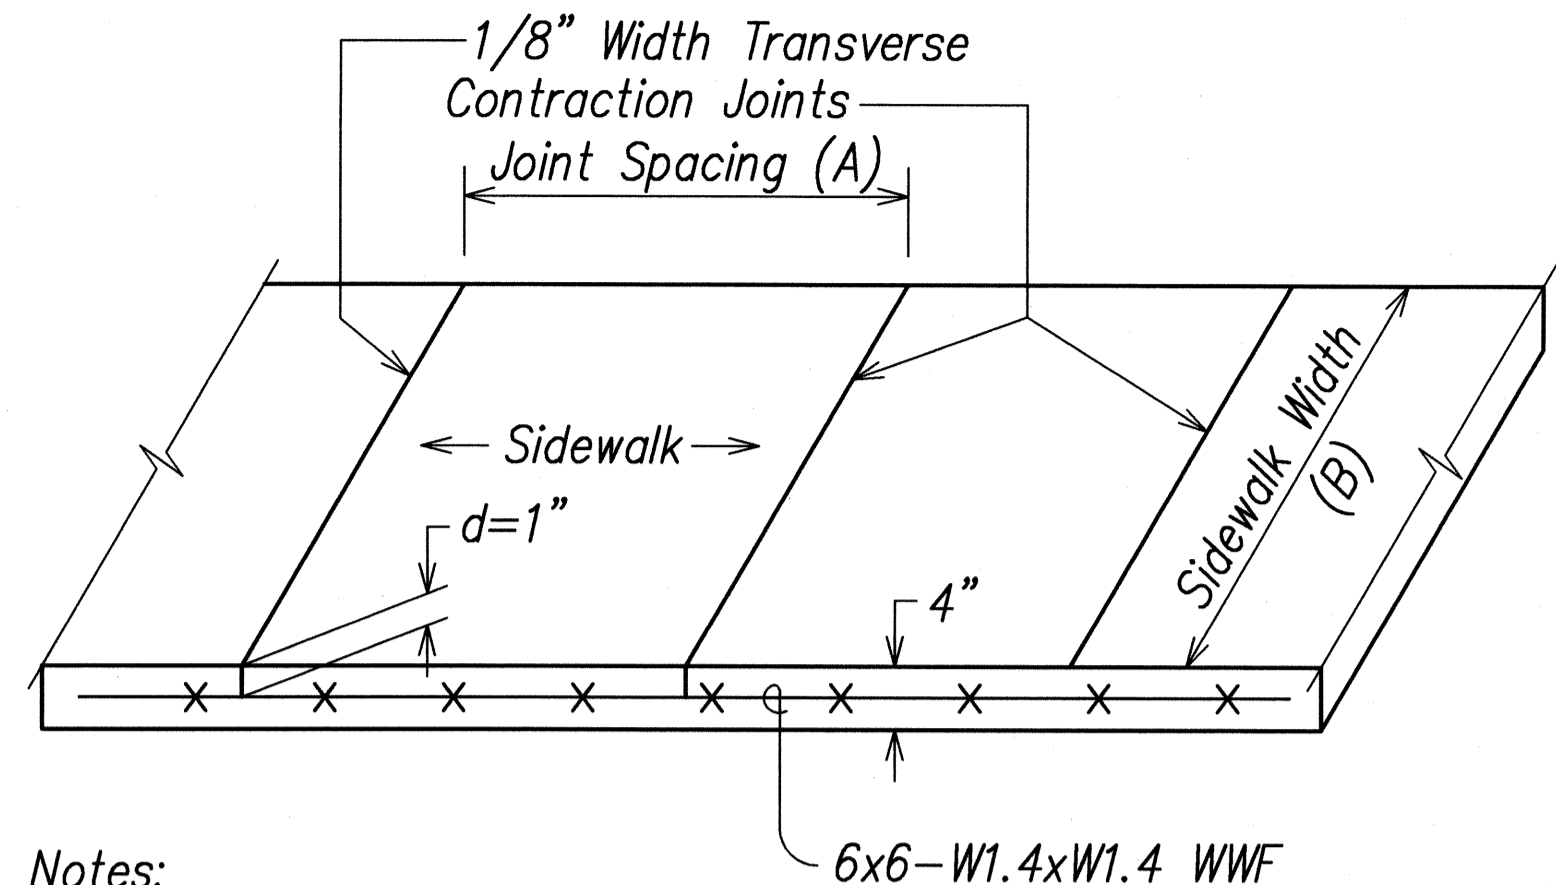

- Notes:**
1. Joint dimension ratios (B/A or A/B) < 1.25 and (A or B) not to exceed 7'.
2. Longitudinal contraction joints similar to transverse contraction joints.

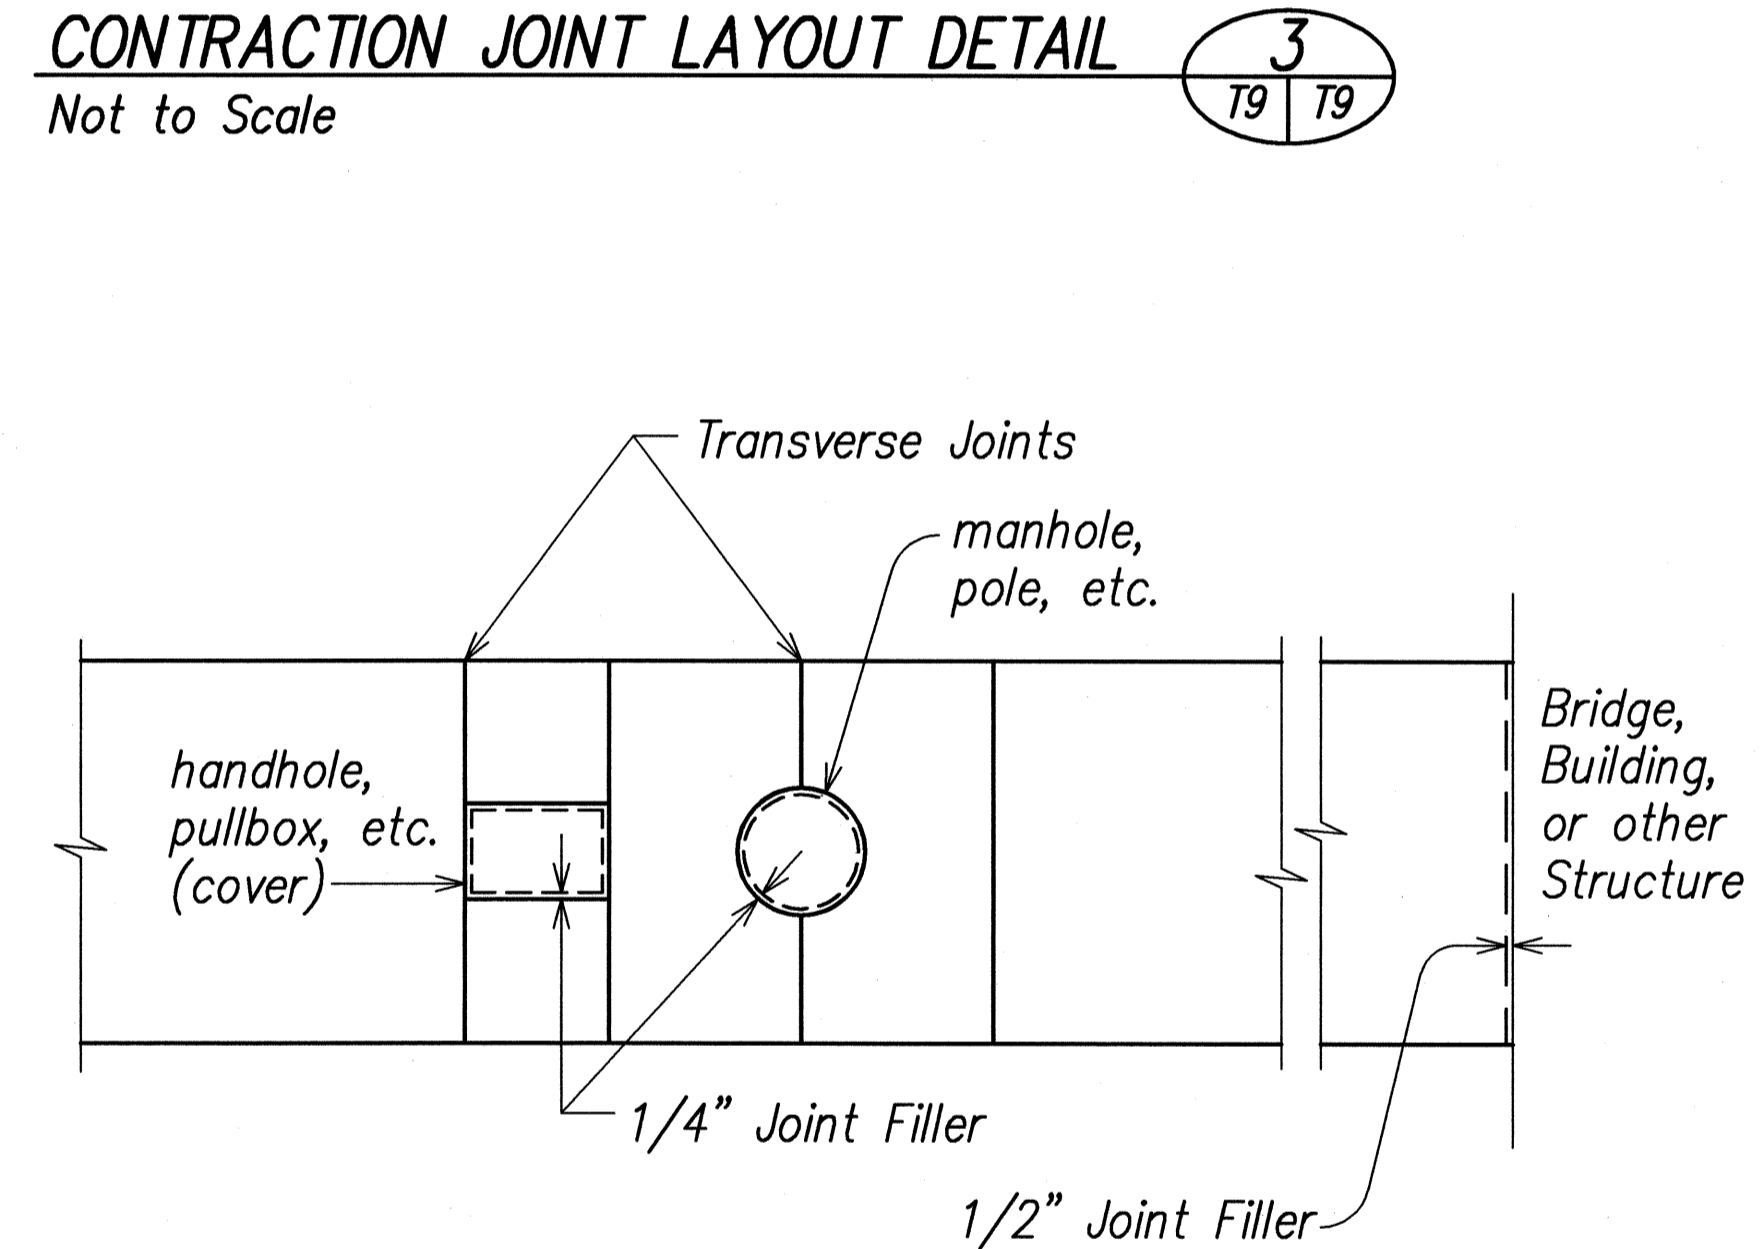


**SIDEWALK ISOLATION JOINT DETAIL**  
Not to Scale

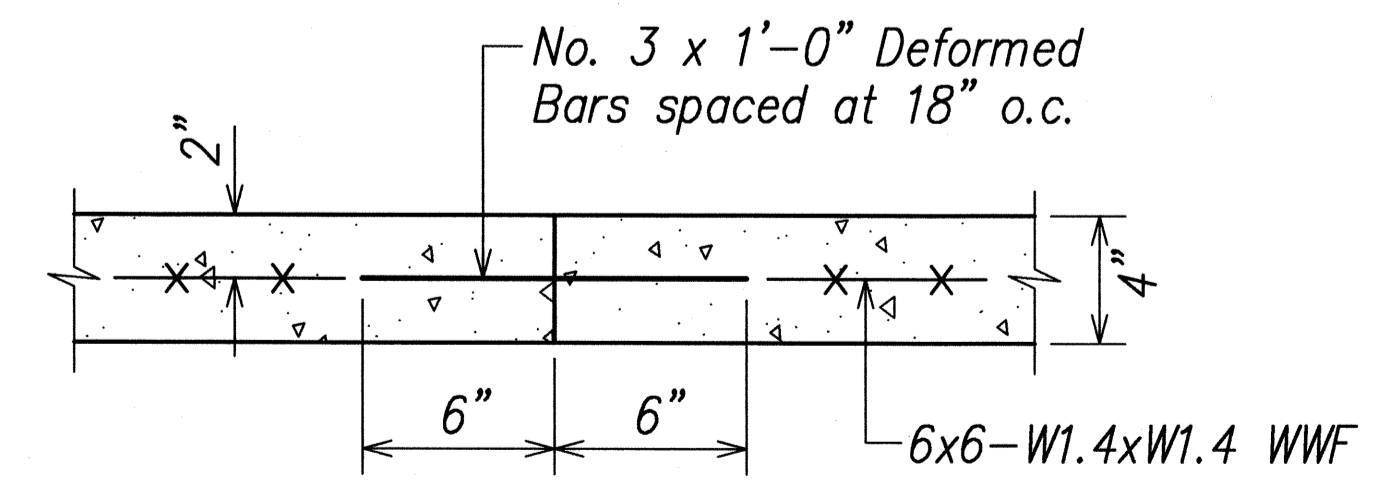


**TRANSVERSE CONSTRUCTION JOINT DETAIL**  
Not to Scale

**SIDEWALK NOTES:**

1. All sidewalks shall provide a minimum clear width of 3'-0" (excluding curb) for pedestrian circulation. If this cannot be met, a minimum 32-inch clear width is allowed for a distance of 24-inches.
2. Narrow sidewalks (3'-0" min. width, excluding curb) may prohibit the installation of any sign posts, utility poles, fire hydrants, traffic signal standards, light poles, etc. in the sidewalk.
3. Passing spaces along new sidewalks with 5' clear width or less shall be provided at maximum 200' intervals as required by ADA guidelines. The passing area shall be a minimum 5' wide by 5' long as feasible.
4. For new construction, the minimum sidewalk width shall be 5'-0" (excluding curb). The cross slope shall not exceed 2%.
5. If possible, install utility poles, fire hydrants, light poles, sign posts, pullboxes, etc. off of sidewalk but within the right-of-way, and will be subject to Engineer's approval.
6. Objects protruding from utility poles and walls adjacent to the sidewalks (i.e. wall mounted fire hydrants, telephones, meters on poles, etc.) shall be mounted to meet the current American with Disabilities Act Accessibility Guidelines (ADAAG) and will be subject to Engineer's approval.
7. Transverse and longitudinal weakened Plane Joints for sidewalk shall be considered incidental to New Sidewalk.
8. Installation of tie bars including drilling, and epoxy grout shall be considered incidental to New Sidewalk.
9. Dressing of sidewalk shall consist of clearing, grubbing, grading, reshaping compacting, and grassing the area adjacent to the improvement with suitable material as shown on the plans and/or as directed by the Engineer. If existing ground is asphalt or concrete surface, dress sidewalk with A.C. pavement, Mix No. V. This work shall be considered incidental to New Sidewalk.

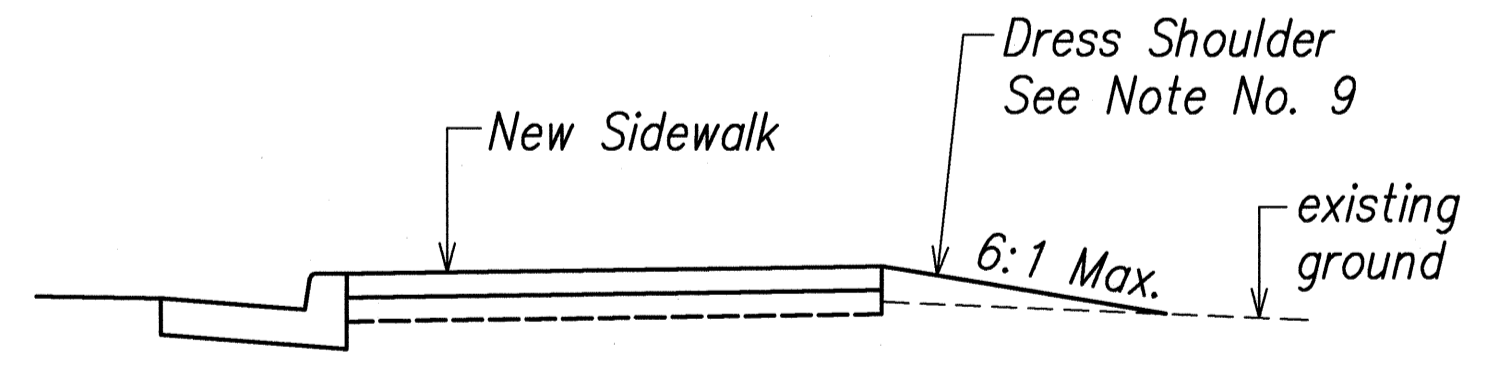

**TYPICAL SIDEWALK DRESSING DETAIL**  
Not to Scale

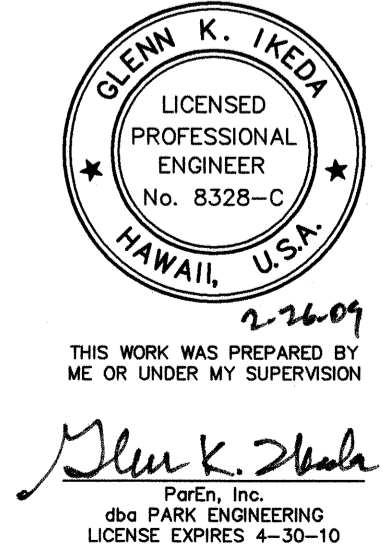

STATE OF HAWAII  
DEPARTMENT OF TRANSPORTATION  
HIGHWAYS DIVISION

**ROADWAY DETAILS**

KAUMUALII HIGHWAY WIDENING  
Vicinity of Anonui Street to Vicinity of Lihue Mill Bridge  
FEDERAL-AID PROJECT NO. NH-050-1(31)


Scale: As Noted Date: FEB. 2009

SHEET NO. T9 OF T18 SHEETS



|                   |      |
|-------------------|------|
| SURVEY PLOTTED BY | DATE |
| DRAWN BY          |      |
| CHECKED BY        |      |
| DESIGNED BY       |      |
| QUANTITIES BY     |      |
| CHECKED BY        |      |
| ORIGINAL PLAN     |      |
| NOTE BOOK         |      |
| No.               |      |

LIBRARY STATE OF HAWAII DEPARTMENT OF TRANSPORTATION HIGHWAYS DIVISION 2/18/09


| FED. ROAD DIST. NO. | STATE | FED. AID PROJ. NO. | FISCAL YEAR | SHEET NO. | TOTAL SHEETS |
|---------------------|-------|--------------------|-------------|-----------|--------------|
| HAWAII              | HAW.  | NH-050-1(31)       | 2009        | 20        | 452          |

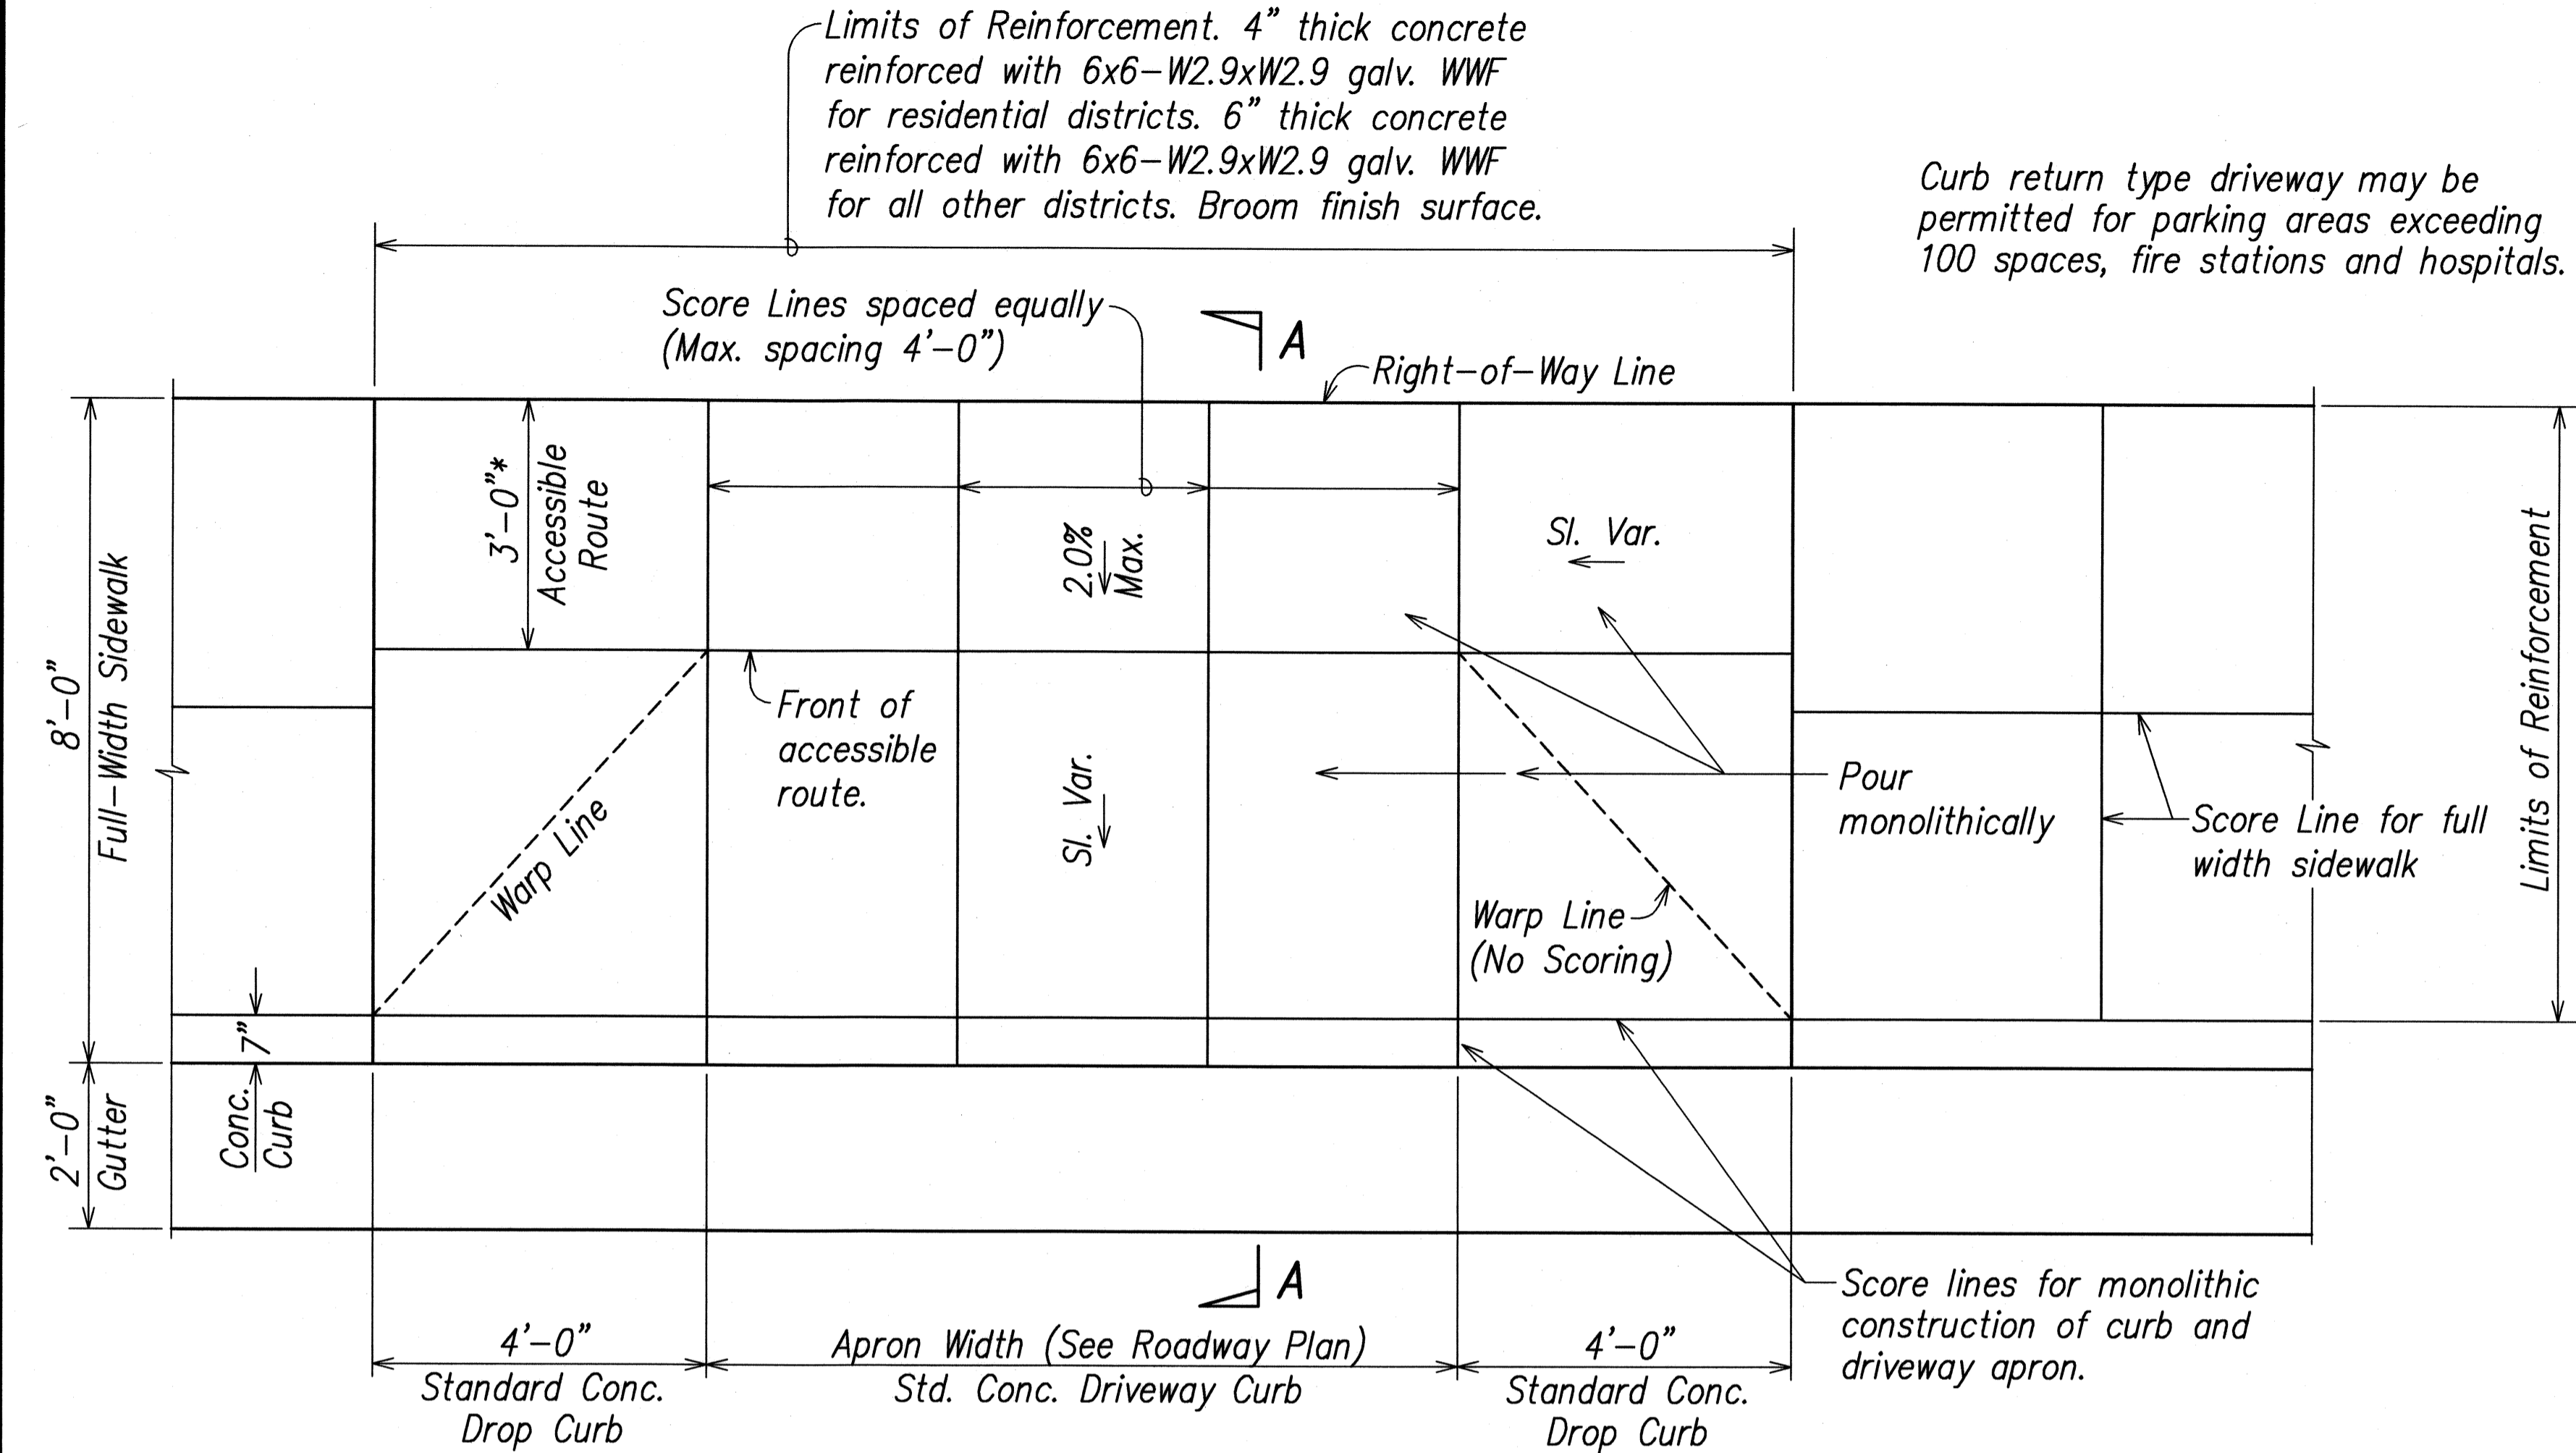

- Notes:**
1. Minimum thickness of concrete for driveway apron is 4" for residential driveways and 6" for all other applications (e.g. commercial).
  2. Thickness of aggregate subbase course beneath concrete pavement may be revised if deemed necessary by the Engineer.
  3. P.C.C. Gutters shall be longitudinally broom finished.
  4. The top of all types of Concrete Curbs, including Driveway Curbs shall be longitudinally broom finished.
  5. See Std. Plan D-05 for details of Drop Curb and Driveway Curb.
  6. For extension to existing driveway, scoring and finish shall match existing scoring and finish. For driveway constructed in built up areas, scoring conforming to scoring at adjacent driveways may be authorized.

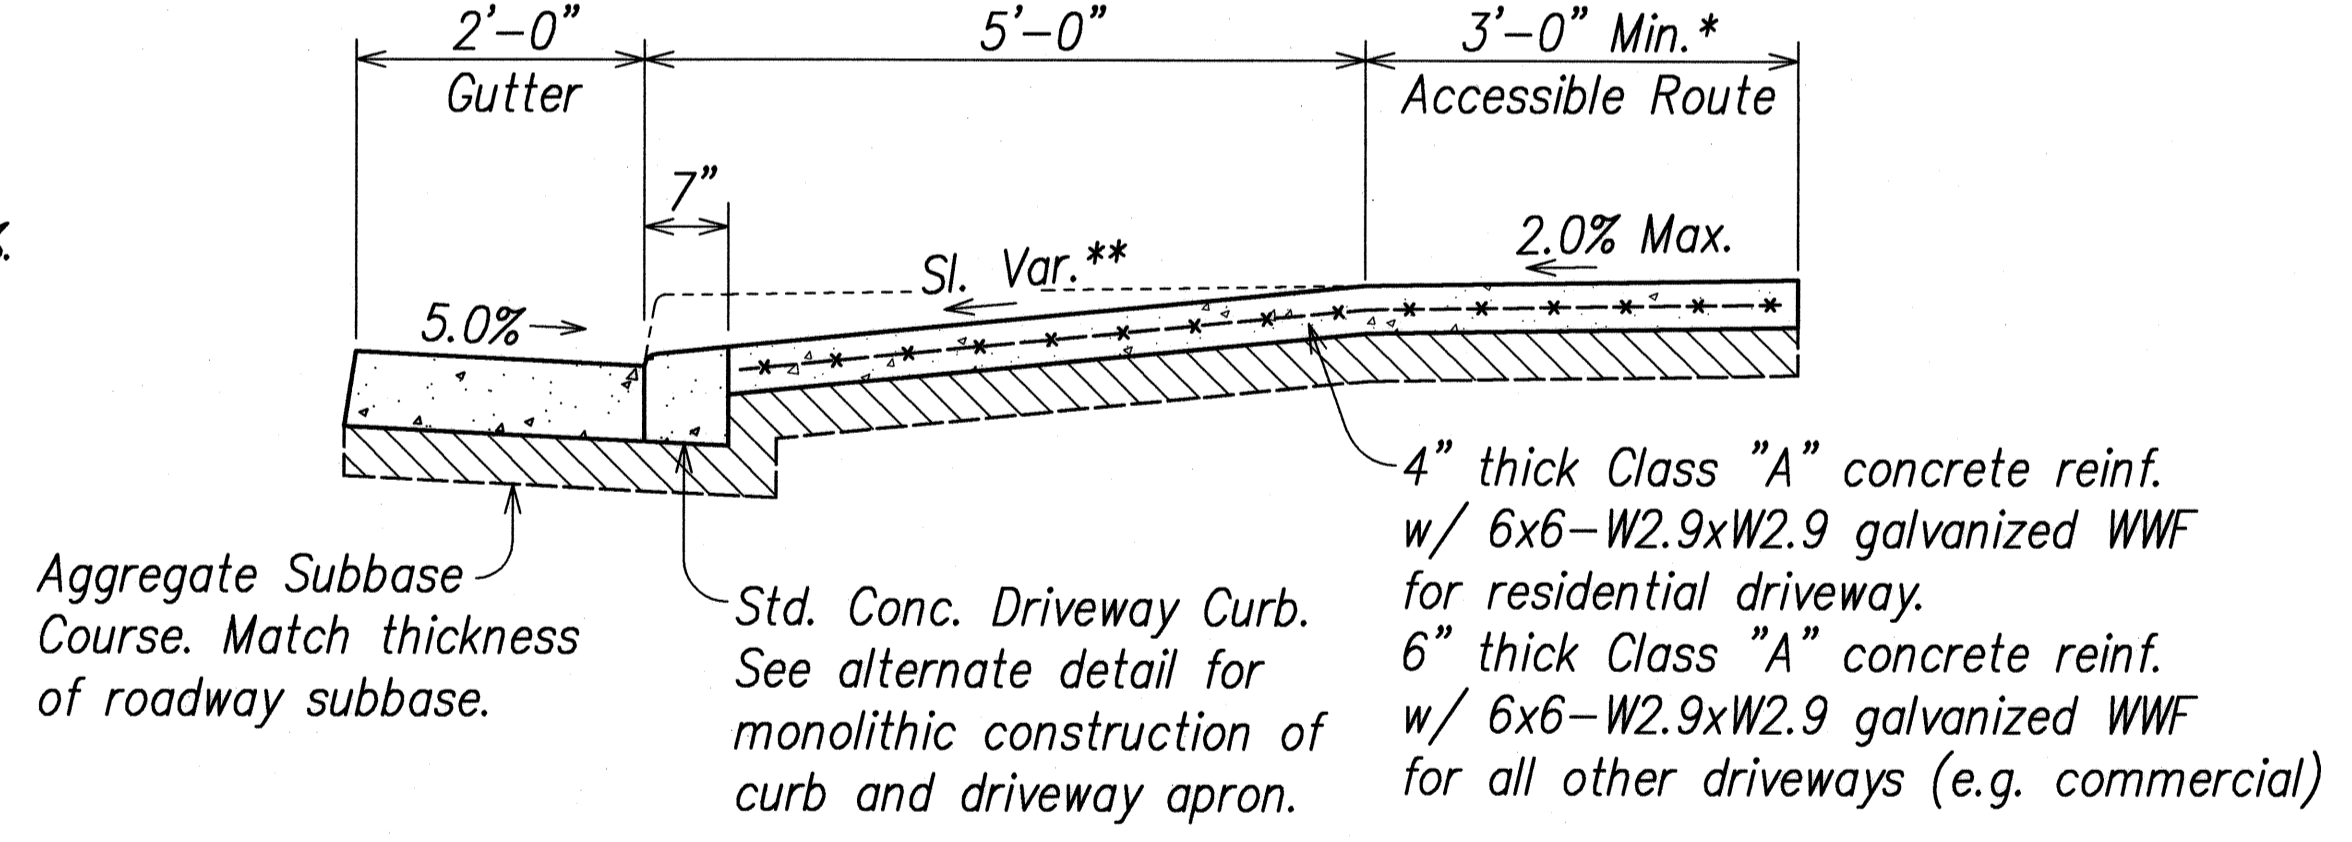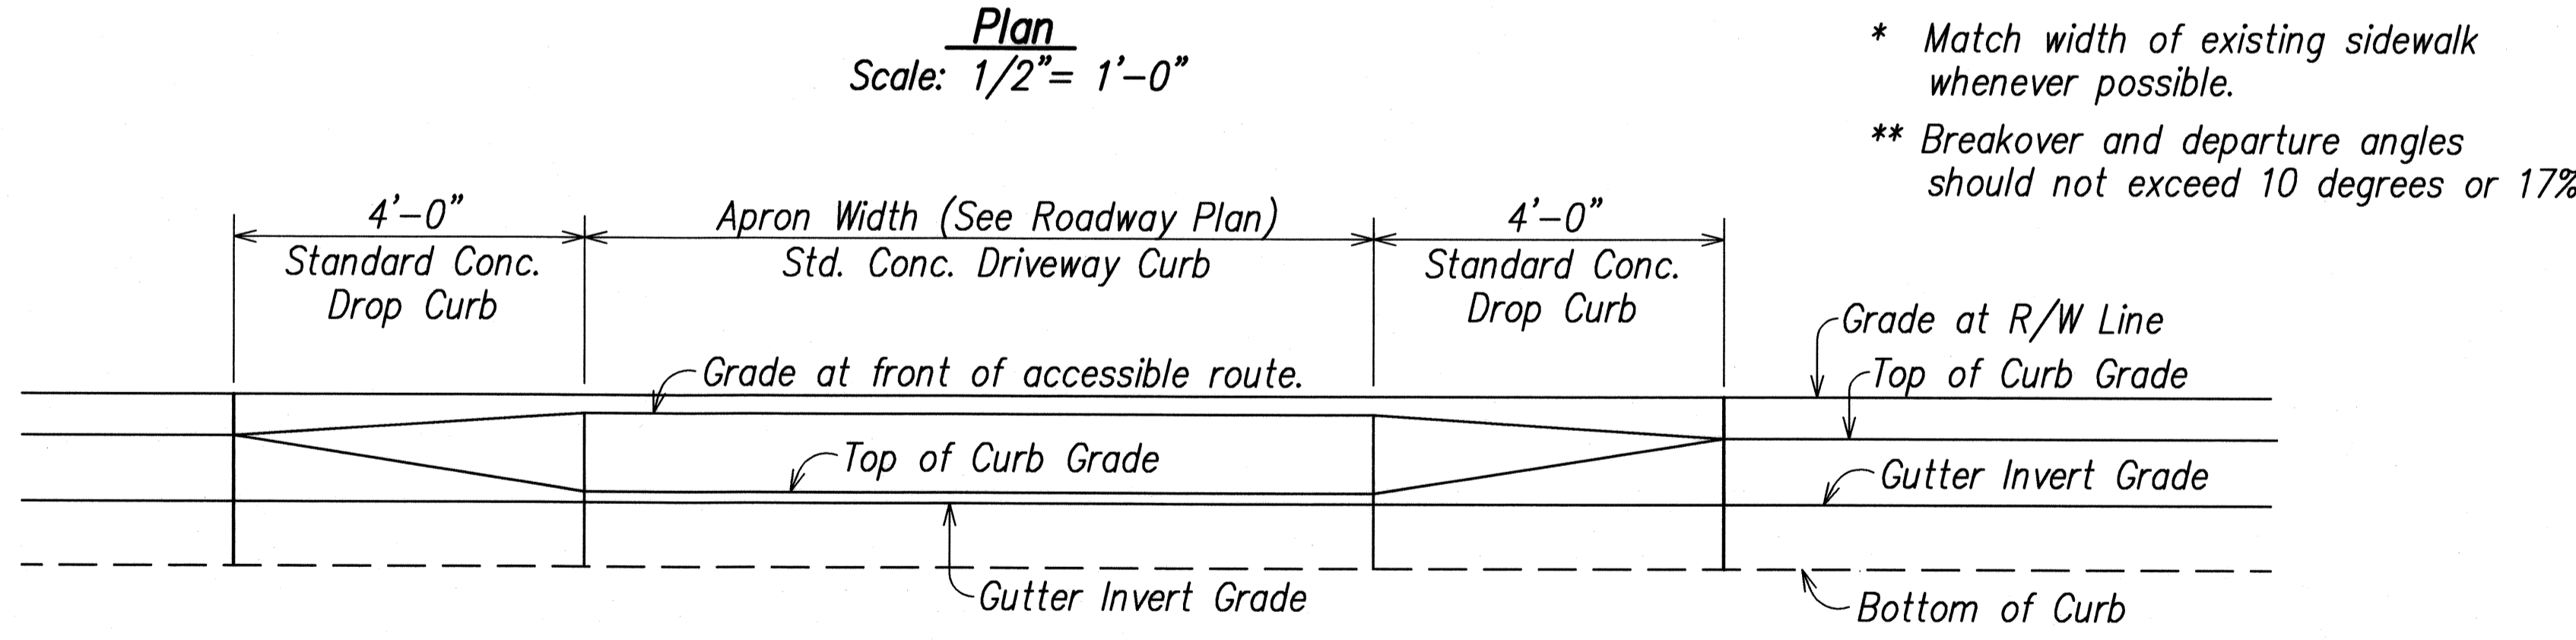


**TYPICAL DRIVEWAY APRON DETAIL**  
Scale As Noted

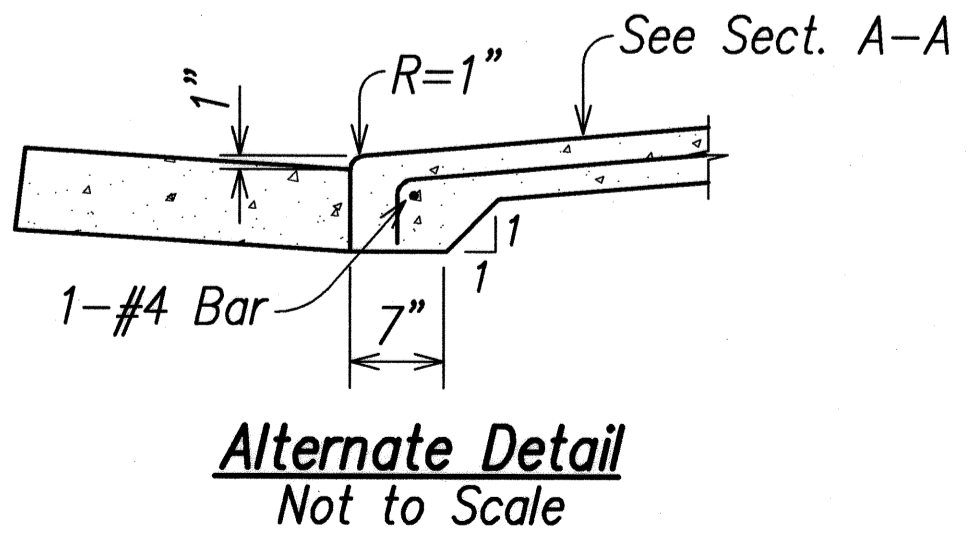

**Section A-A**  
Not to Scale



|                   |      |
|-------------------|------|
| SURVEY PLOTTED BY | DATE |
| DRAWN BY          |      |
| DESIGNED BY       |      |
| QUANTITIES BY     |      |
| CHECKED BY        |      |
| ORIGINAL PLAN     |      |
| NOTE BOOK         |      |
| No.               |      |

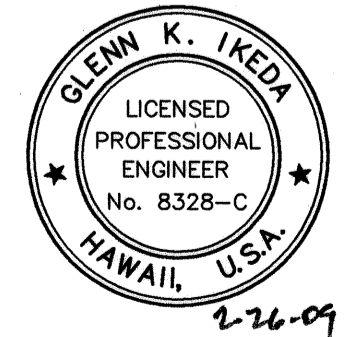




STATE OF HAWAII  
DEPARTMENT OF TRANSPORTATION  
HIGHWAYS DIVISION

**ROADWAY DETAILS**  
  
KAUMUALII HIGHWAY WIDENING  
Vicinity of Anonui Street to Vicinity of Lihue Mill Bridge  
FEDERAL-AID PROJECT NO. NH-050-1(31)  
Scale: As Noted Date: FEB. 2009

| FED. ROAD DIST. NO. | STATE | FED. AID PROJ. NO. | FISCAL YEAR | SHEET NO. | TOTAL SHEETS |
|---------------------|-------|--------------------|-------------|-----------|--------------|
| HAWAII              | HAW.  | NH-050-1(31)       | 2009        | 21        | 452          |

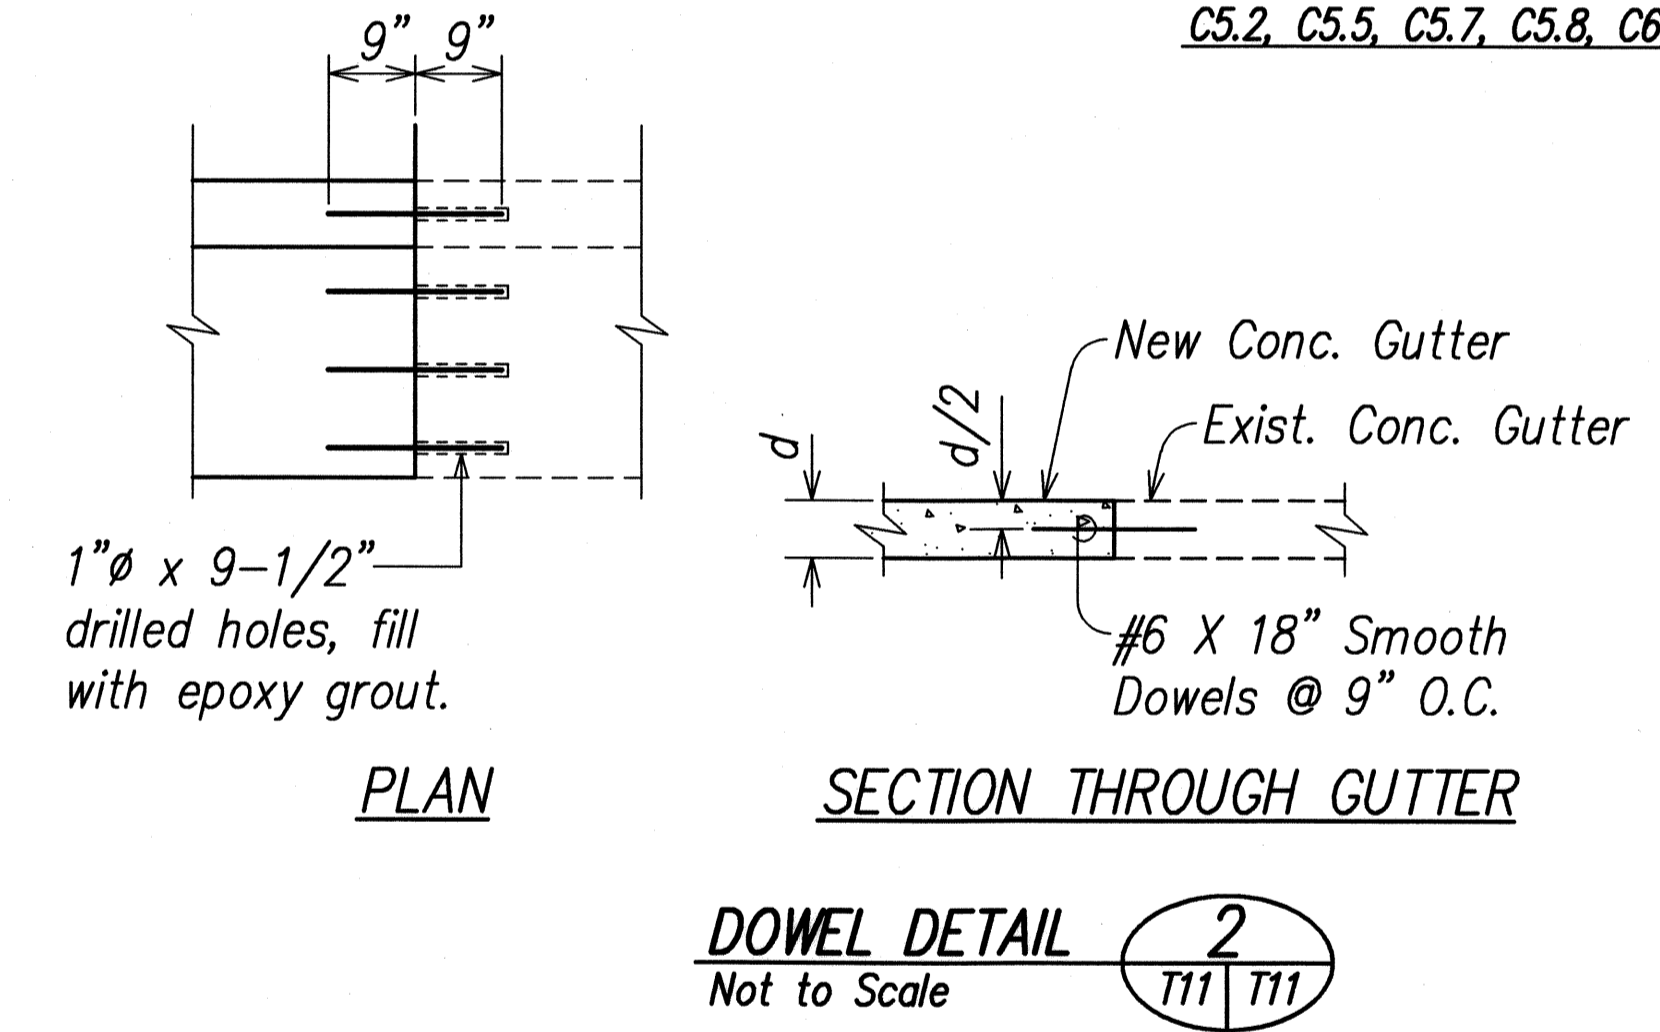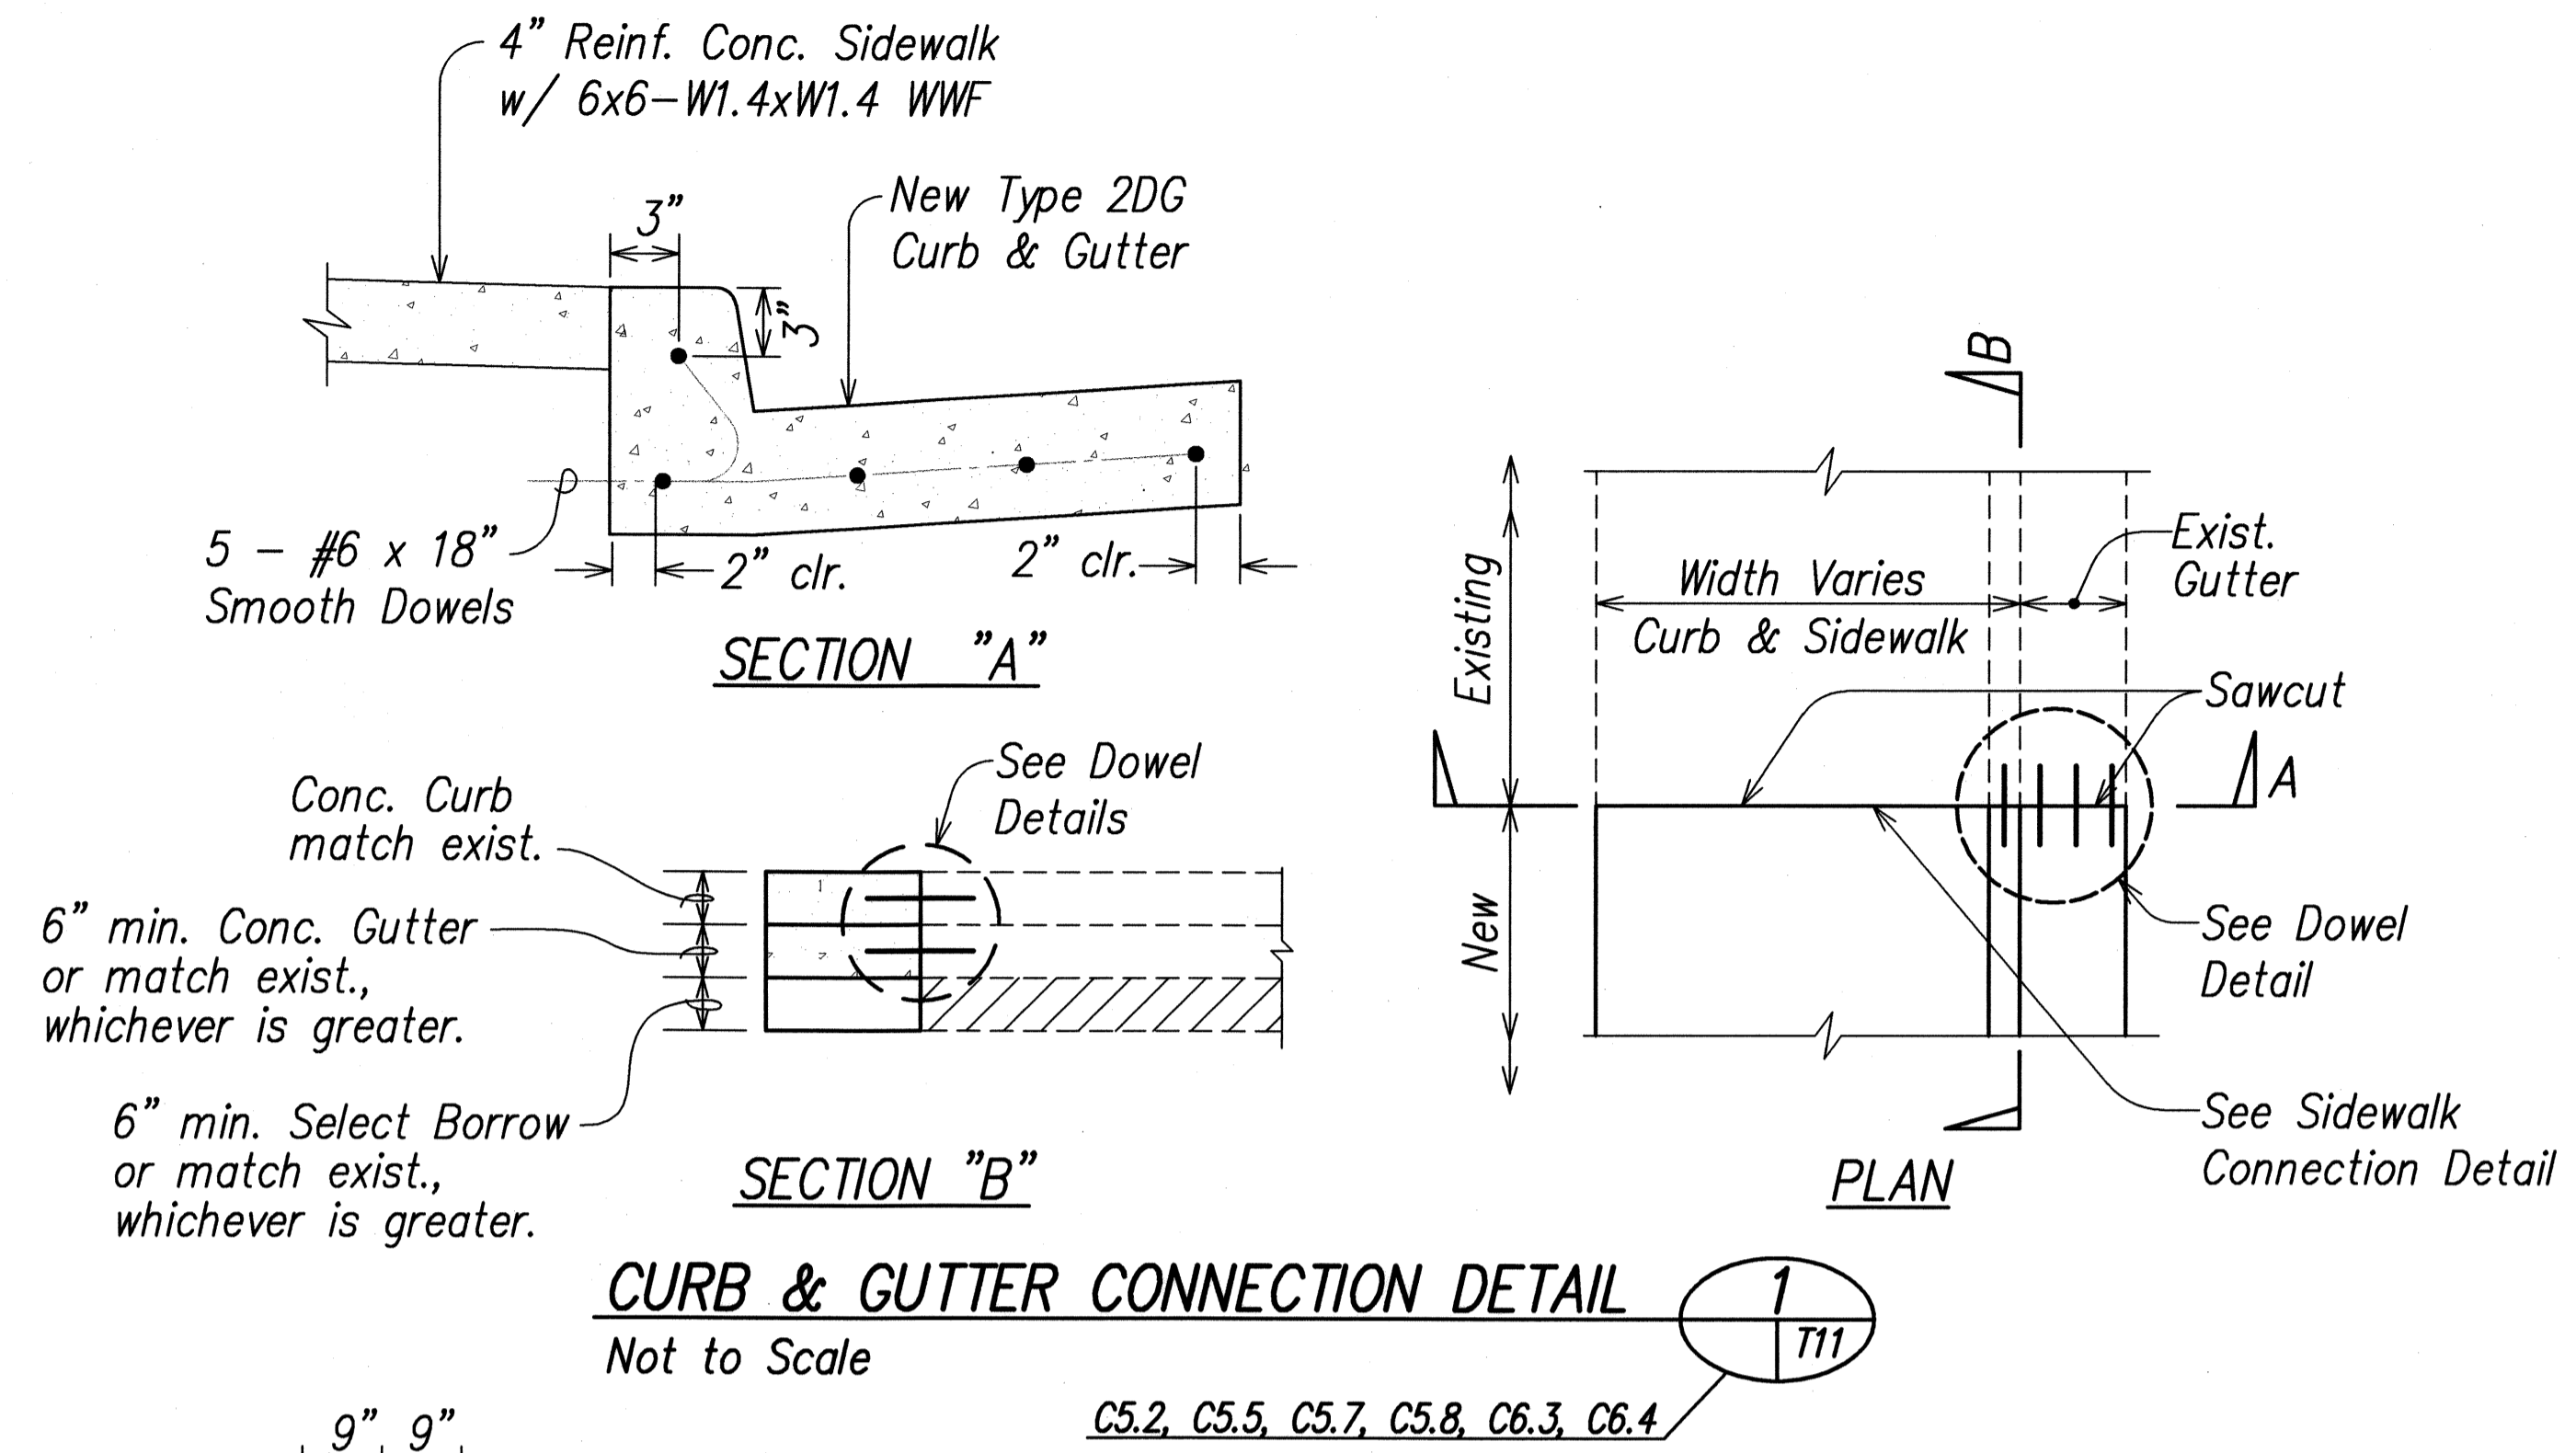


- Doweling Notes:
1. Provide dowels as shown.
  2. Drill holes as shown, in the existing curb and gutter and/or sidewalk. Clean hole of dust and debris. Fill hole completely with epoxy grout, and install dowel.
  3. Epoxy grout shall be two-component, epoxy-resin system and shall comply with the requirements of AASHTO M 235 (ASTM C-881).

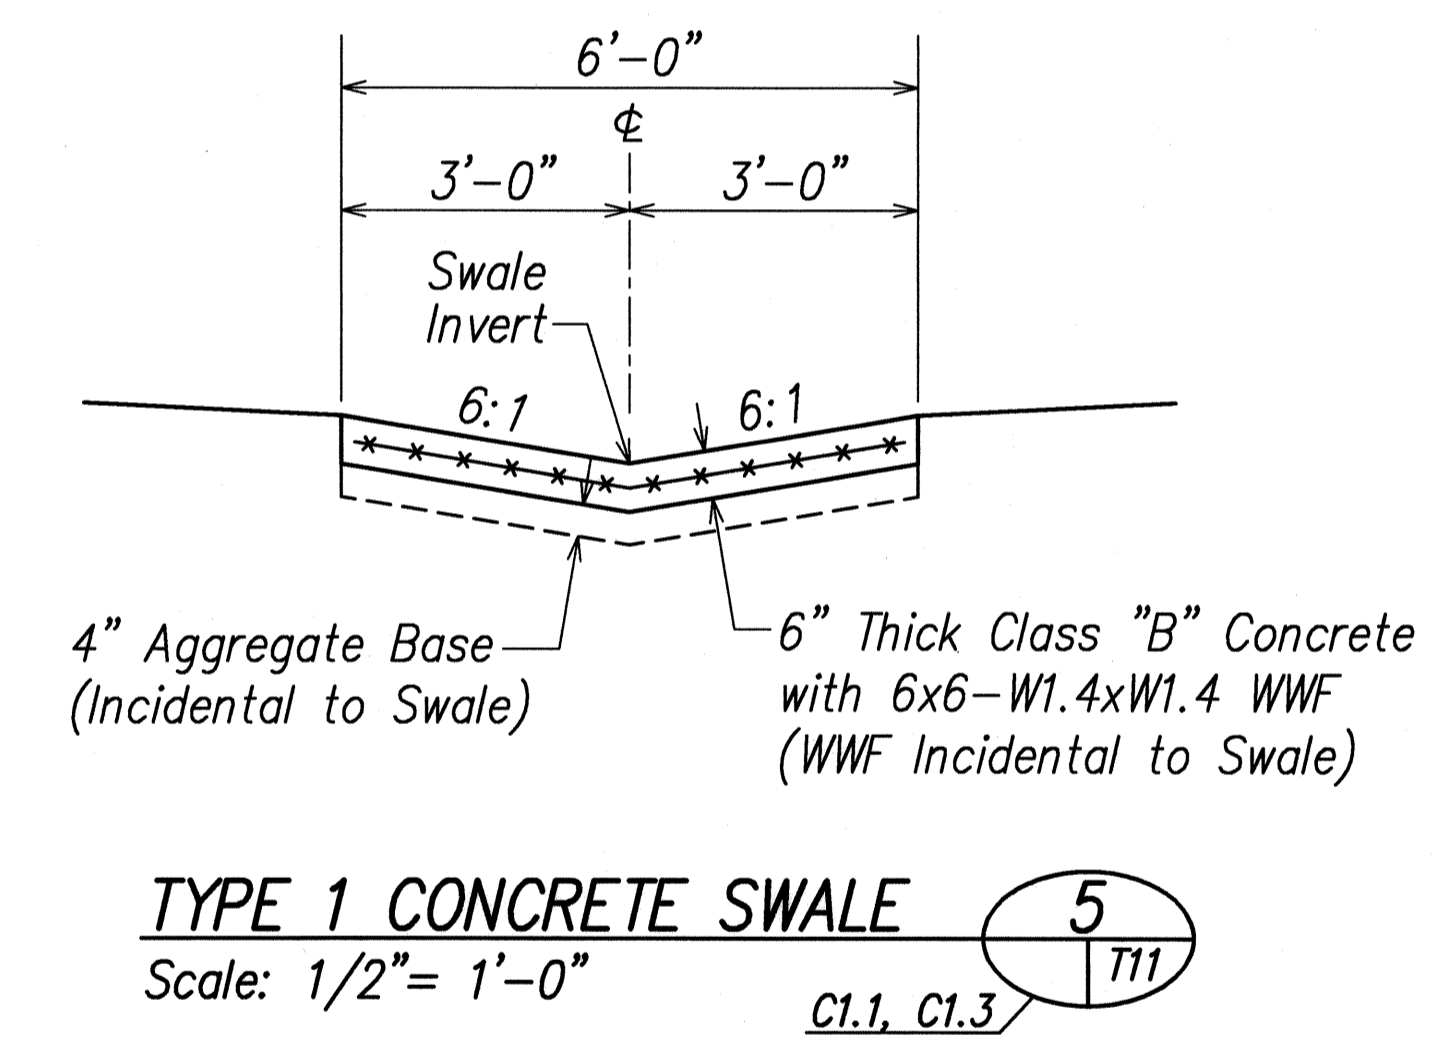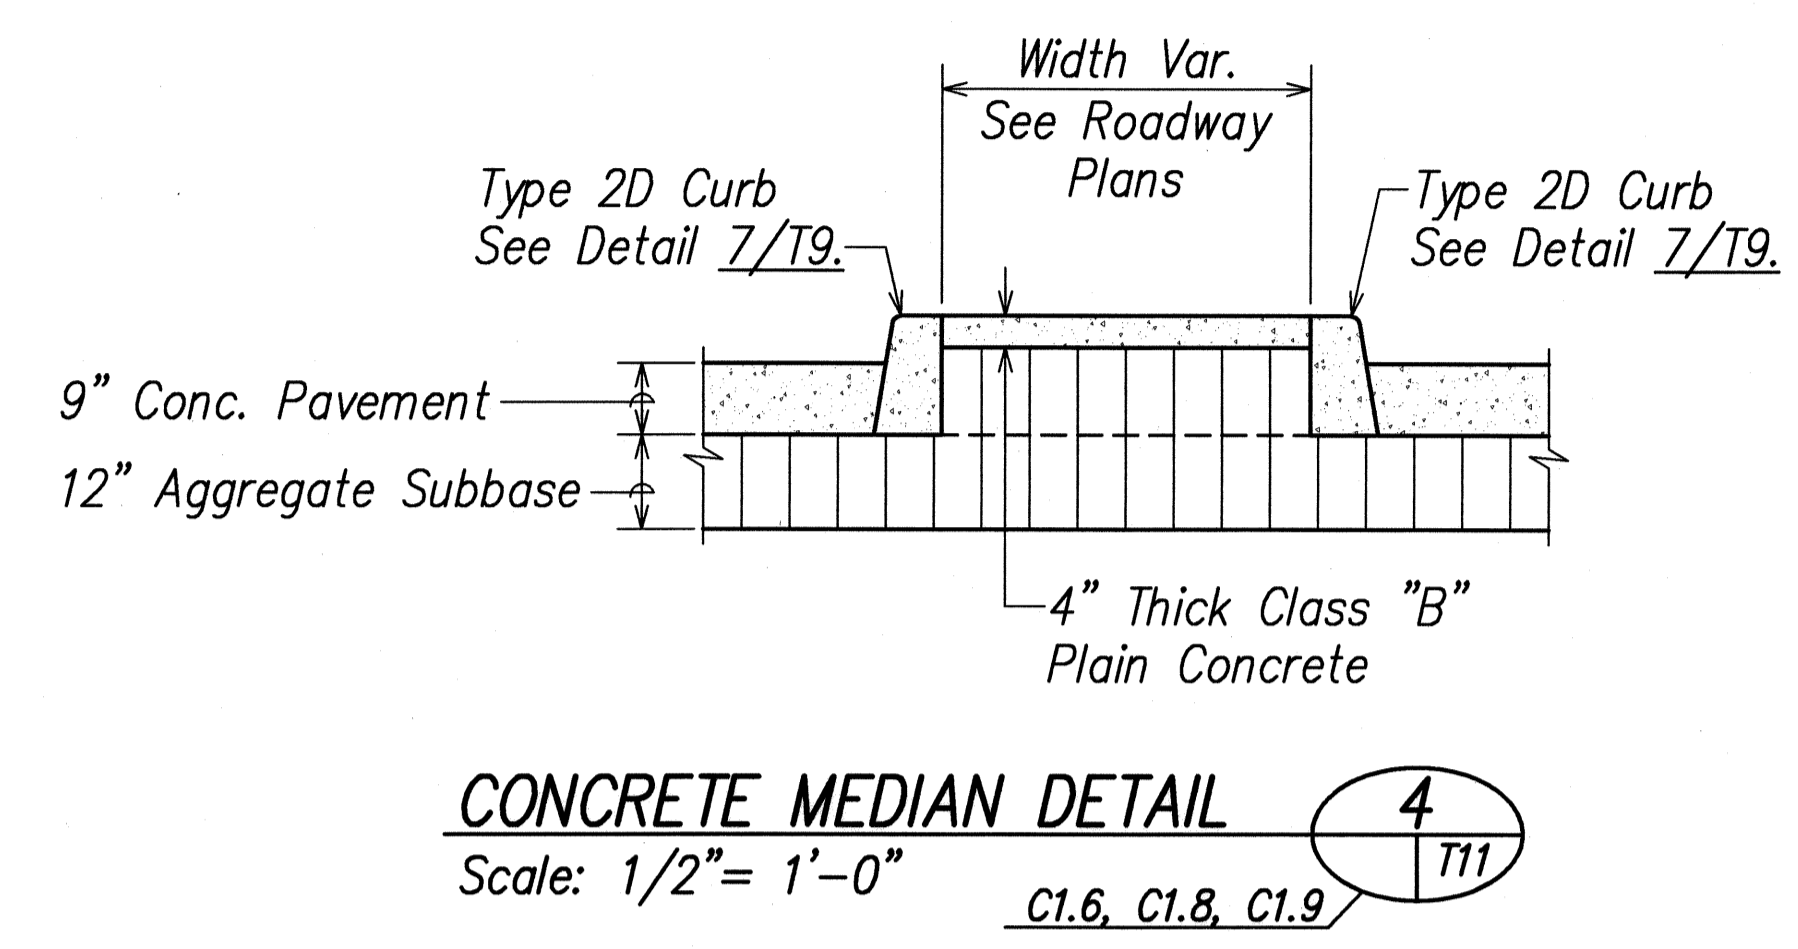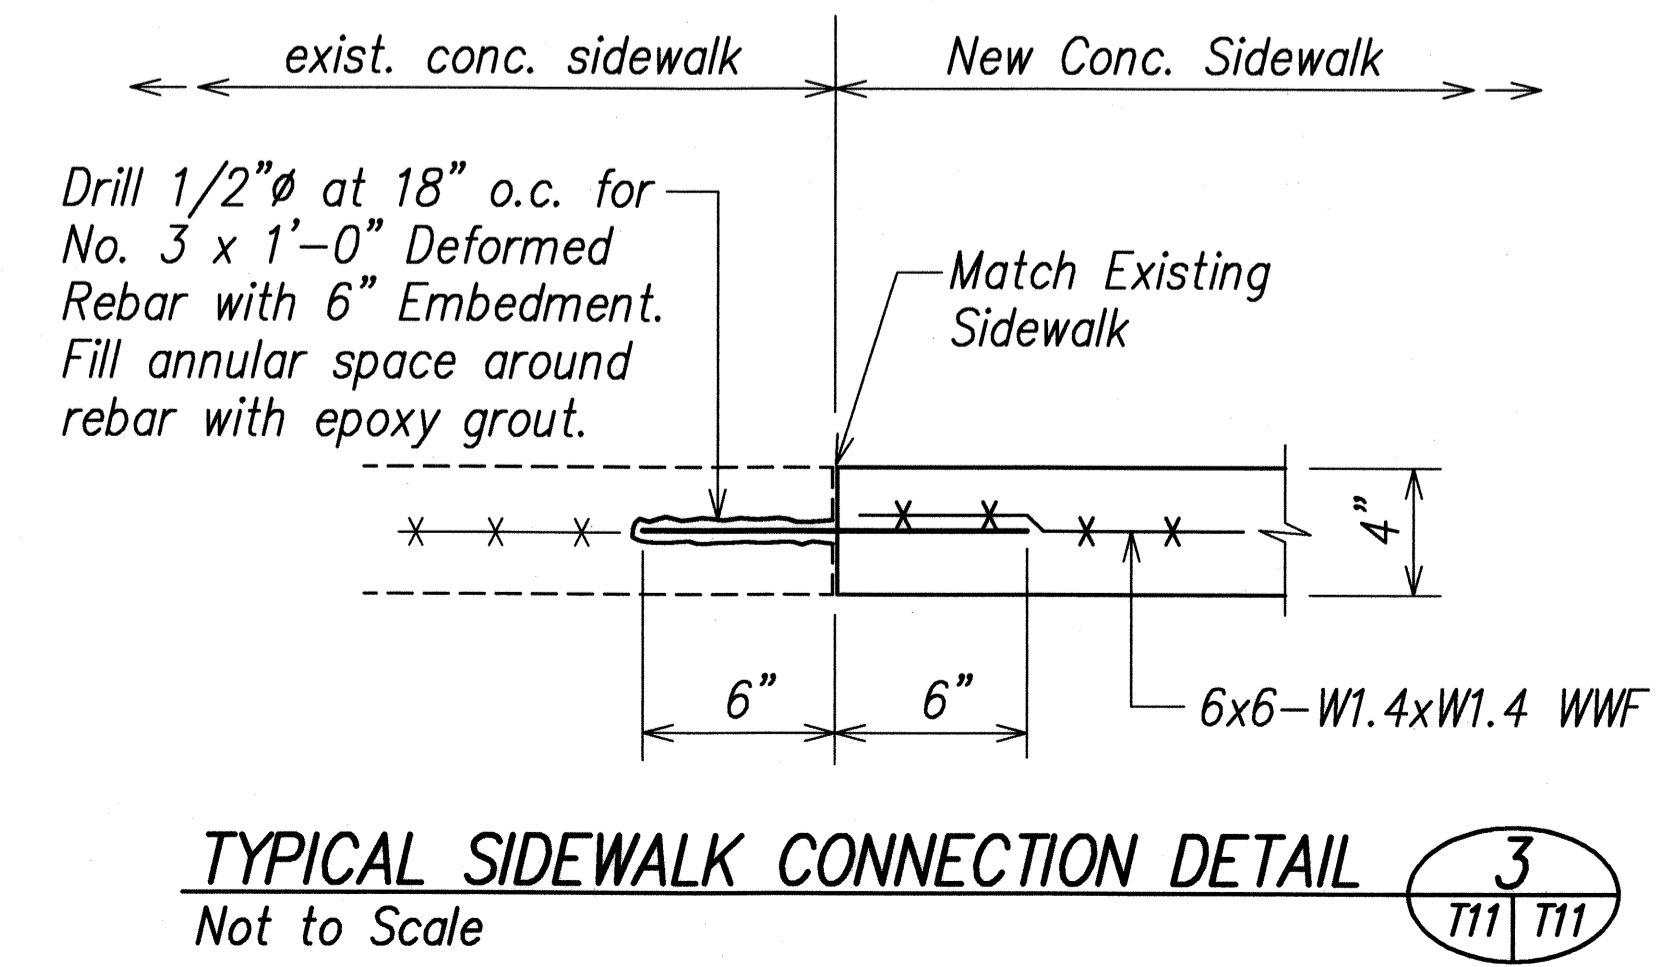


|               |      |
|---------------|------|
| ORIGINAL PLAN | DATE |
| DRAWN BY      |      |
| CHECKED BY    |      |
| DESIGNED BY   |      |
| QUANTITIES BY |      |
| NOTES BY      |      |
| NO.           |      |

100% STATE VOTER KAMAHALA - WYPAHELE REGION PLANS KAWAII - T11 - RDDET1.dwg 11/28/08

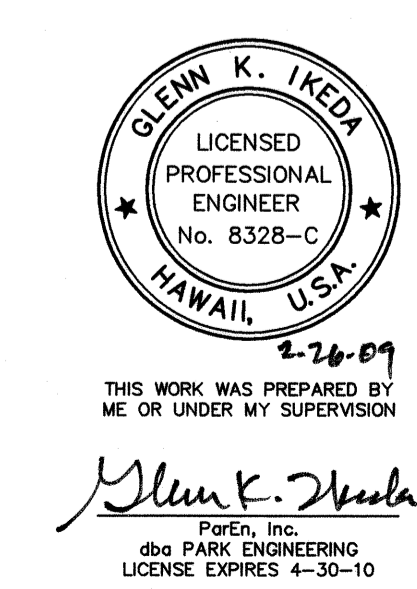


STATE OF HAWAII  
DEPARTMENT OF TRANSPORTATION  
HIGHWAYS DIVISION  
  
**ROADWAY DETAILS**  
  
KAUMUALII HIGHWAY WIDENING  
Vicinity of Anonui Street to Vicinity of Lihue Mill Bridge  
FEDERAL-AID PROJECT NO. NH-050-1(31)  
Scale: As Noted Date: FEB. 2009  
SHEET No. T11 OF T18 SHEETS

| FED. ROAD DIST. NO. | STATE | FED. AID PROJ. NO. | FISCAL YEAR | SHEET NO. | TOTAL SHEETS |
|---------------------|-------|--------------------|-------------|-----------|--------------|
| HAWAII              | HAW.  | NH-050-1(31)       | 2009        | 22        | 452          |

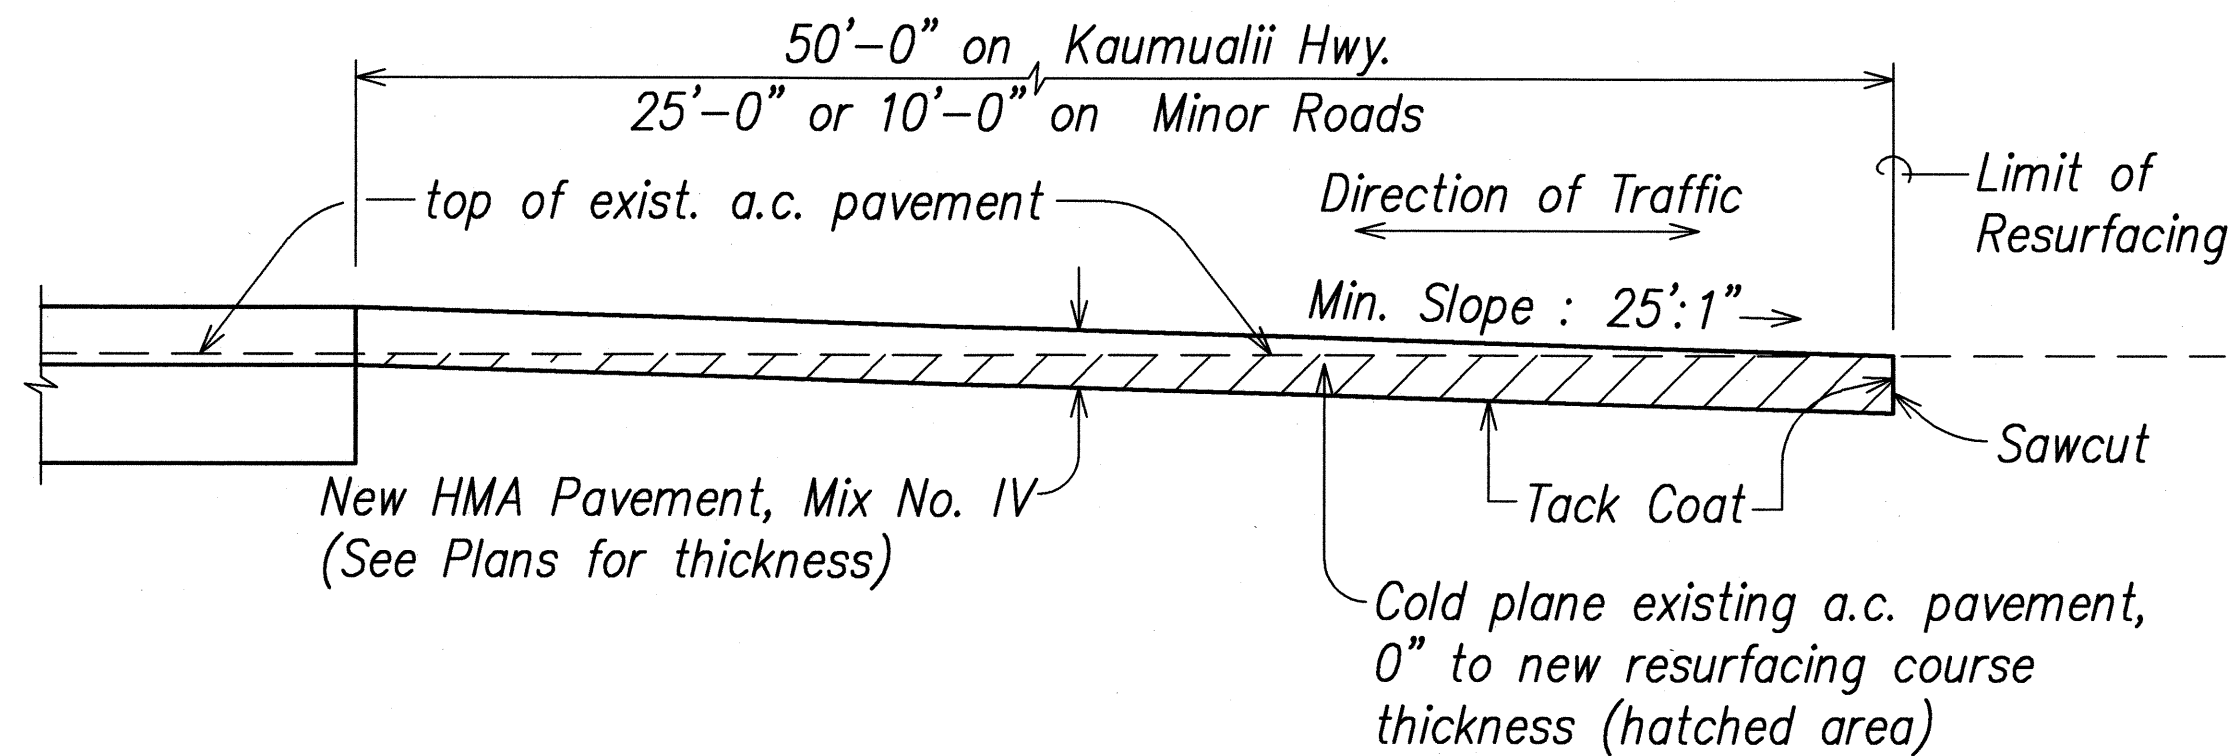

**COLD PLANED TRANSITION TO EXISTING A.C. PAVEMENT DETAIL**  
Not to Scale

C1.1 to C1.4, C1.6, C1.8 to C1.10

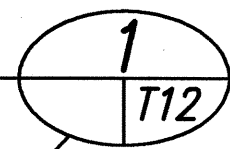

**Cold Planing Notes:**

1. All saw cutting work for cold planing shall be considered incidental to Cold Planing and will not be paid for separately.
2. The exact locations and limits of areas to be cold planed shall be determined by the Engineer.
3. Exposure of existing aggregate base is expected when cold planing deeper than 4-inches. Remove any remaining pavement less than 1/2" thick before paving. The Contractor shall pave over exposed existing aggregate base with glassphalt concrete base at the end of each day. The Contractor shall compact the existing aggregate base in accordance with Section 304 - Aggregate Base Course and apply tack coat in accordance with Section 407 - Tack Coat, prior to laying the new glassphalt concrete base. This work shall be considered incidental to the new Glassphalt Concrete Base and will not be paid for separately.
4. The vertical pavement drop-off shall not exceed 3-inches. If a vertical pavement drop-off exists at the end of each day's cold planning and paving, the Contractor shall provide a wedge with a 48:1 minimum transition taper for transverse drop-off and no steeper than 6:1 for longitudinal drop-off, as approved by the Engineer. All transition tapers shall be removed before the next layer of pavement is installed. This work shall be considered incidental to Cold Planing.
5. All cold planing work shall be followed immediately with paving, temporary striping, and re-establishment of traffic detector loops before re-opening the lanes to traffic. The Contractor shall install temporary loop detector sensing units to replace any loops taken out of service. The cost for temporary loop detector sensing units shall be considered incidental to the various contract items.
6. All cold planed material shall be the property of the State of Hawaii and shall be hauled directly to the Lihue Airport and not stored on site within the project limit.

|               |                   |      |
|---------------|-------------------|------|
| ORIGINAL PLAN | SURVEY PLOTTED BY | DATE |
| NOTE BOOK     | DRAWN BY          |      |
| No.           | TRACED BY         |      |
|               | CHECKED BY        |      |
|               | QUANTITIES BY     |      |

102 STATE OF HAWAII - TRANSPORTATION DIVISION - KAHULUI - T12 - RD050-1(31) - FEB. 2009



THIS WORK WAS PREPARED BY  
ME OR UNDER MY SUPERVISION  
*Glenn K. Ikeda*  
Park, Inc.  
dba PARK ENGINEERING  
LICENSE EXPIRES 4-30-10

STATE OF HAWAII  
DEPARTMENT OF TRANSPORTATION  
HIGHWAYS DIVISION


**ROADWAY DETAILS**

KAUMUALII HIGHWAY WIDENING  
Vicinity of Anonui Street to Vicinity of Lihue Mill Bridge  
FEDERAL-AID PROJECT NO. NH-050-1(31)

Scale: As Noted Date: FEB. 2009

SHEET No. T12 OF T18 SHEETS

| FED. ROAD DIST. NO. | STATE | FED. AID PROJ. NO. | FISCAL YEAR | SHEET NO. | TOTAL SHEETS |
|---------------------|-------|--------------------|-------------|-----------|--------------|
| HAWAII              | HAW.  | NH-050-1(31)       | 2009        | 23        | 452          |

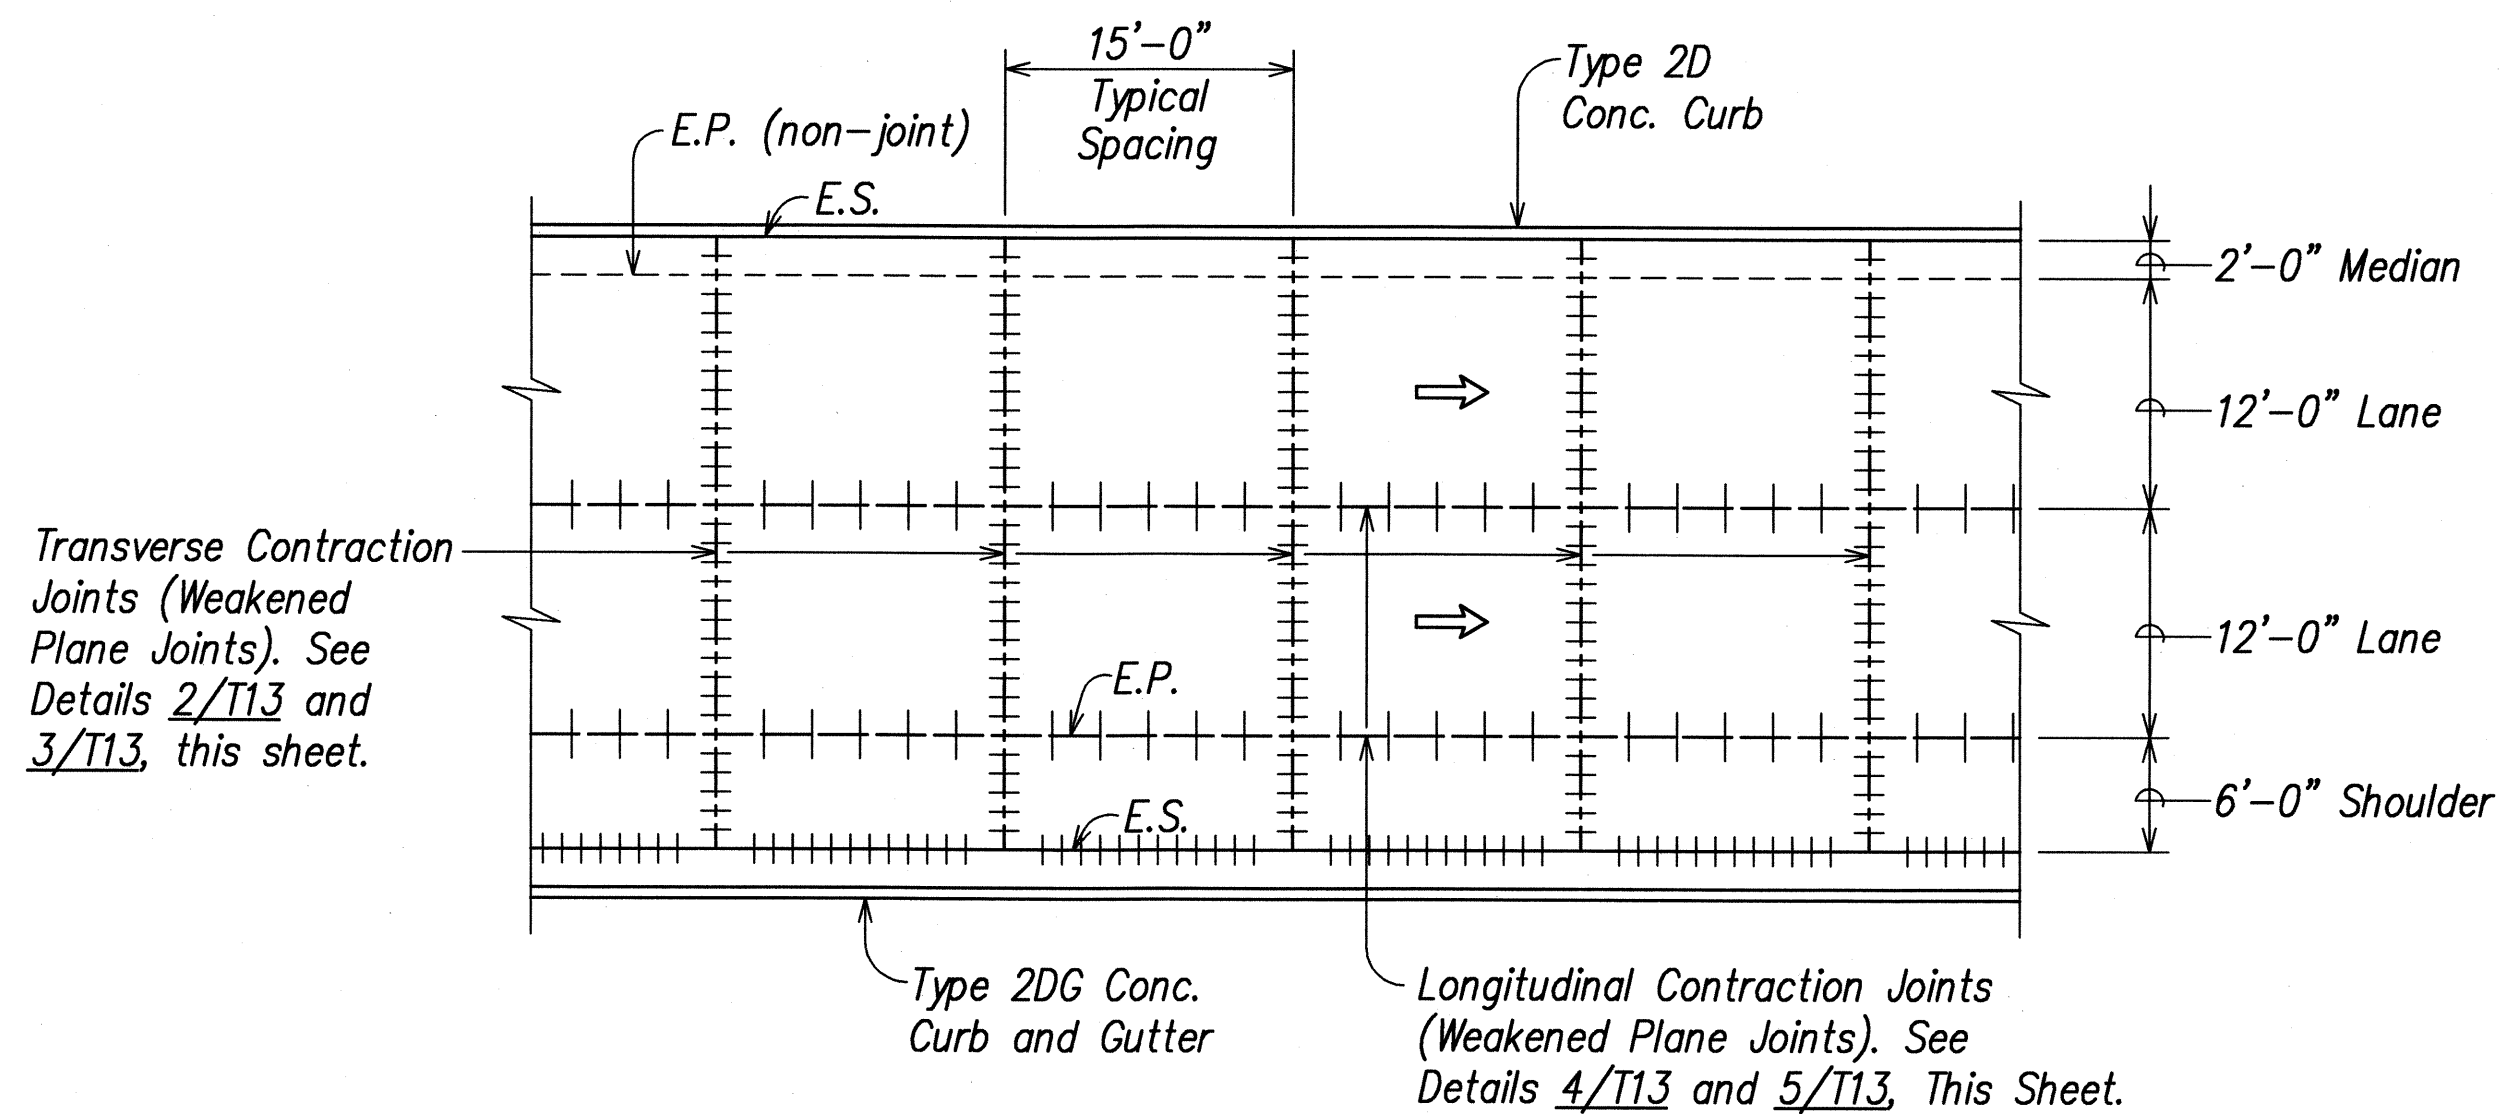


TYPICAL P.C.C. PAVEMENT  
JOINT LOCATION AND LAYOUT PLAN

Scale: 1" = 10'

1  
J1 to J11 T13

### NOTES FOR P.C.C. PAVEMENT:


- Epoxy-Coated Reinforcing shall conform to AASHTO M284 / M284M/ M95, Grade 60 (ASTM A 775).
- Dowels and deformed bars which are partially coated or which are damaged during shipment, handling, or placement shall be replaced at no additional cost to the State.
- The dowels shall be positioned parallel to centerline direction of traffic and parallel to the roadway surface. The ends of the dowels shall not deviate more than 0.01' from parallel in 9" length.
- Transverse Construction Joints shall be located a minimum distance of 10-feet from the nearest Transverse Joint. Joint shall be perpendicular to paving lane.
- Deformed bars shall be placed a minimum 15" from any transverse joint. Deformed bars closer to the Transverse Joint can interfere with joint movement.
- Odd shaped slabs and slabs with mismatched joints shall be reinforced. Odd shaped slabs are slabs with length to width ratios greater than 1.25, triangular shaped, or non-square shaped slabs. See Details on Sht. T14.
- Provide shop drawings of joint layout where obstructions such as manholes are encountered, for odd-shaped slabs and for slabs with mismatched joints.

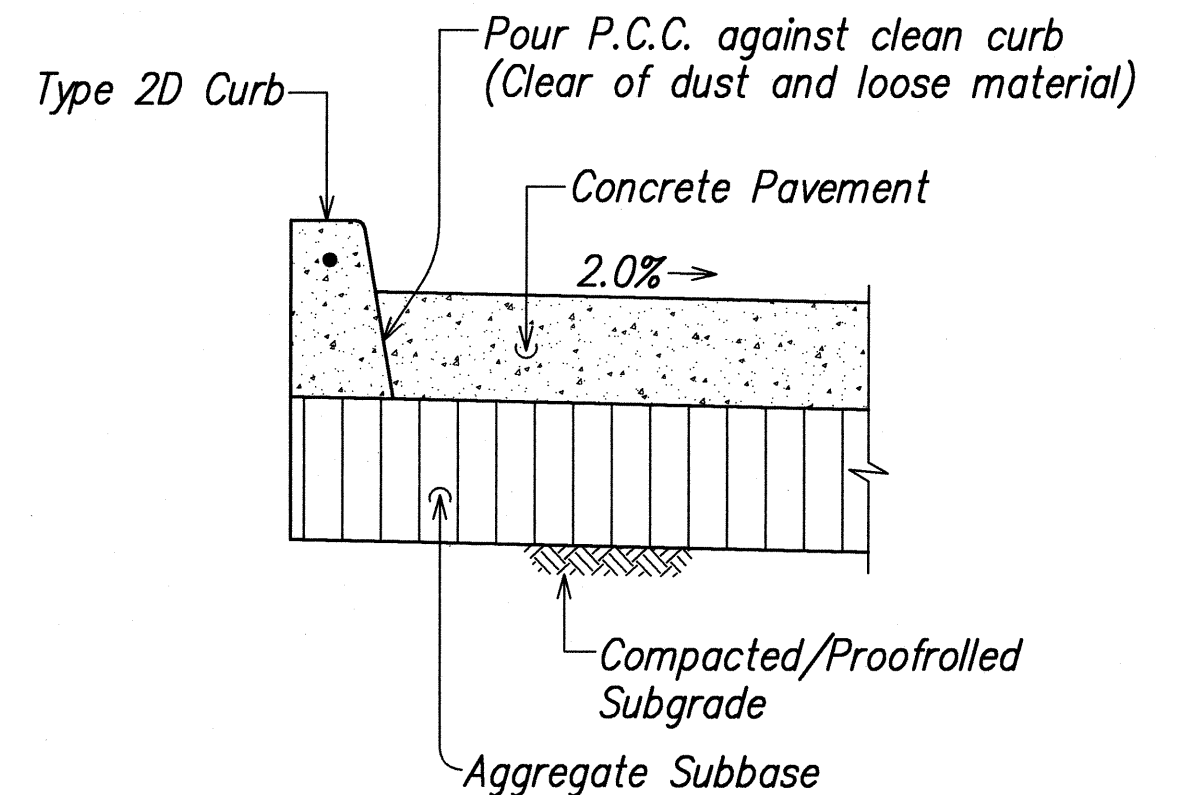

P.C.C. PAVEMENT AT CURB DETAIL

Scale: 3/4" = 1'-0"


6  
J2 to J10 T13

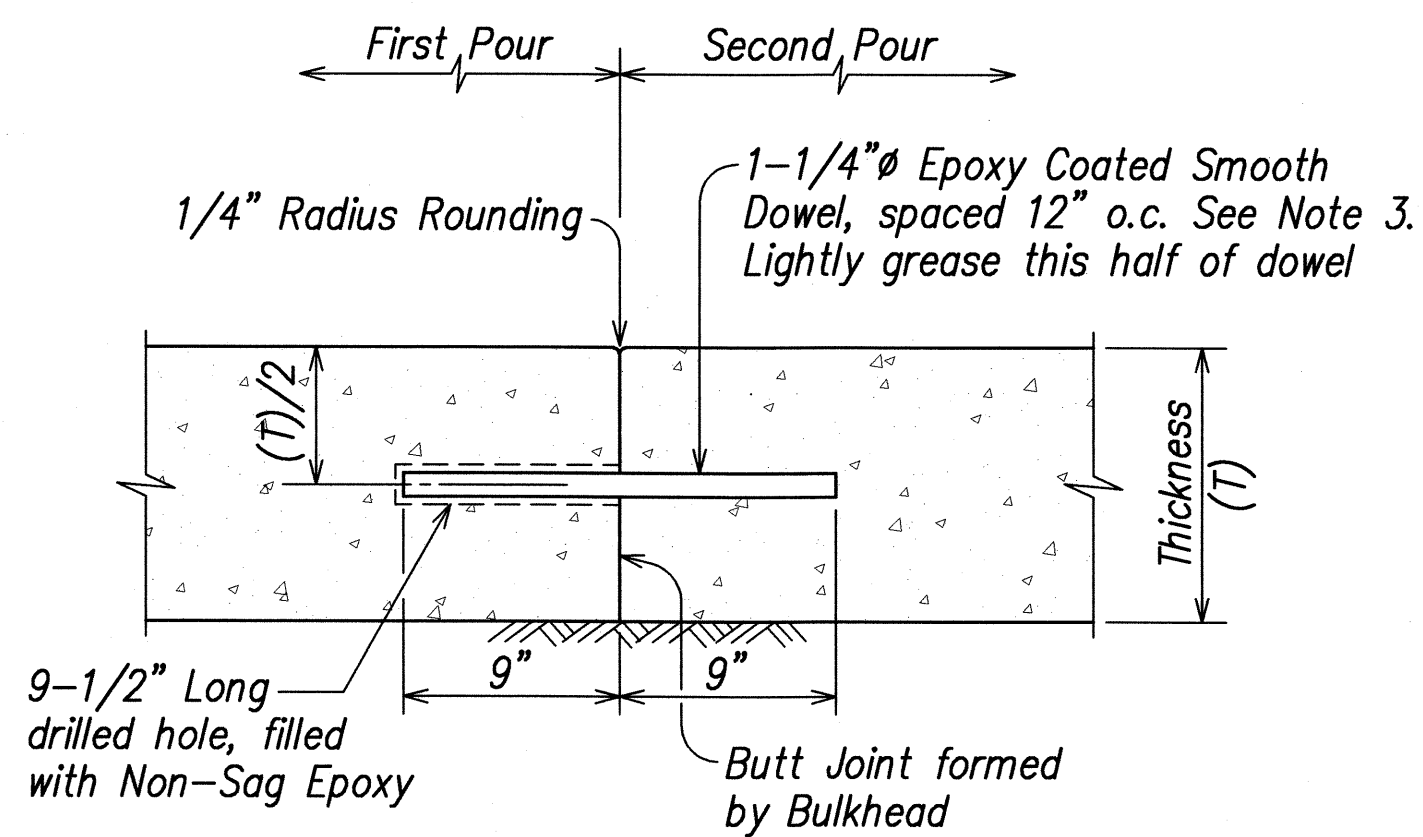

TRANSVERSE CONSTRUCTION JOINT  
(CONTACT JOINT)

Not to Scale


2  
T13 T13

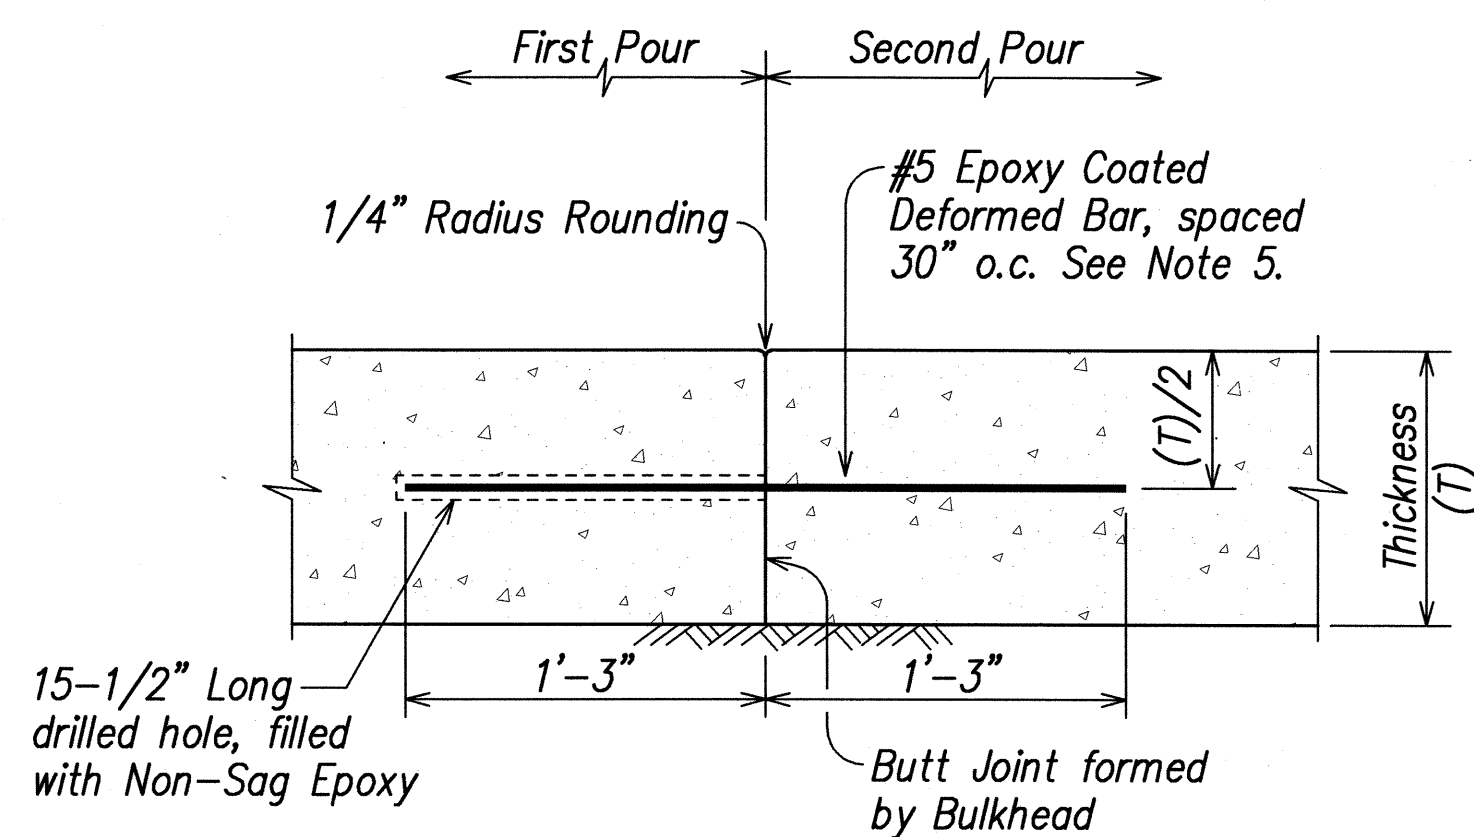

LONGITUDINAL CONSTRUCTION JOINT  
(CONTACT JOINT)

Not to Scale


4  
T13 T13

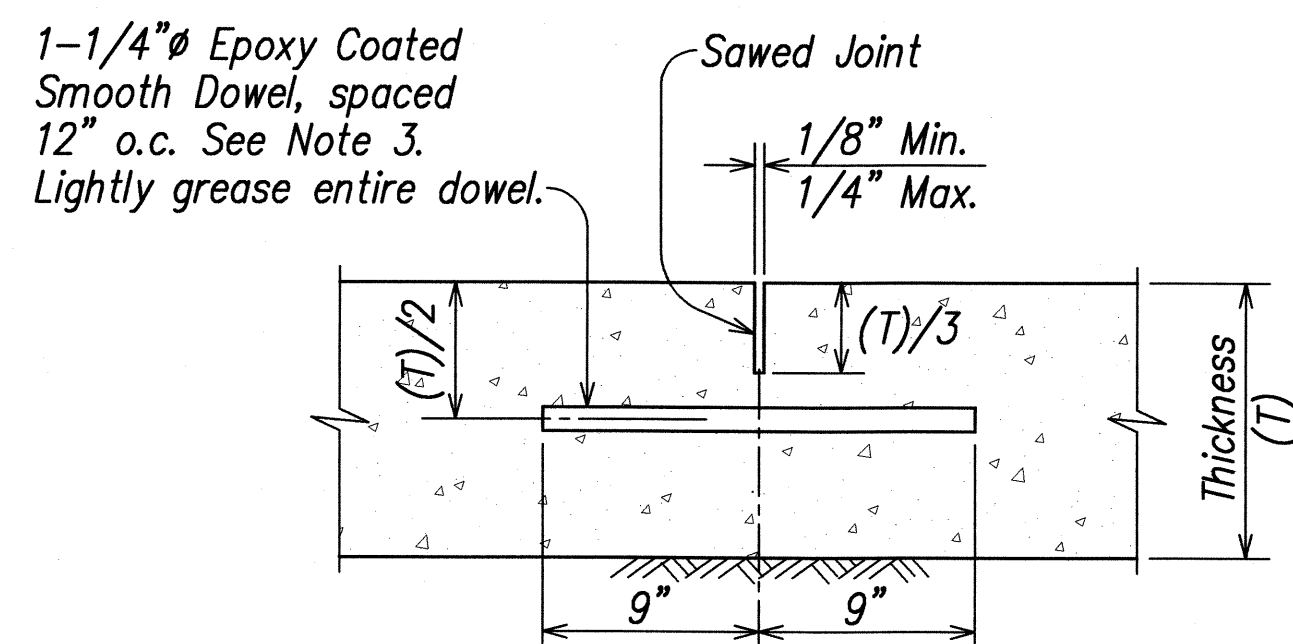

TRANSVERSE CONTRACTION JOINT  
(WEAKENED PLANE JOINT)

Not to Scale


3  
T13 T13

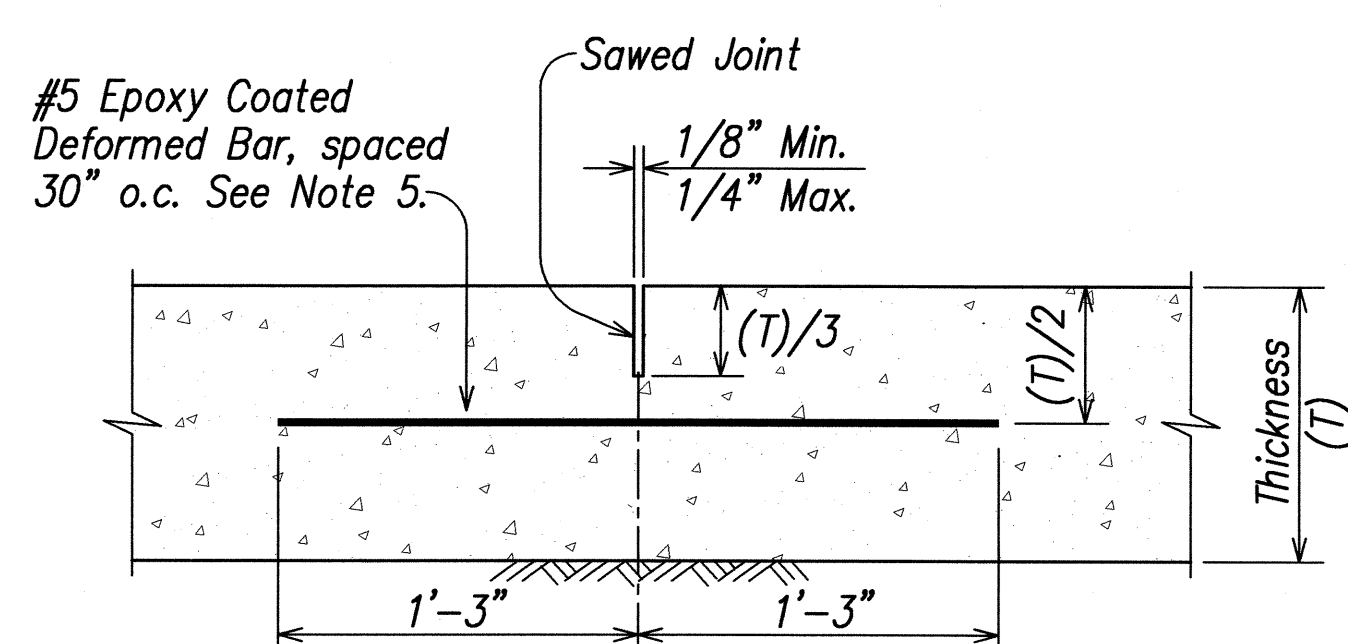

LONGITUDINAL CONTRACTION JOINT  
(WEAKENED PLANE JOINT)

Not to Scale

5  
T13 T13

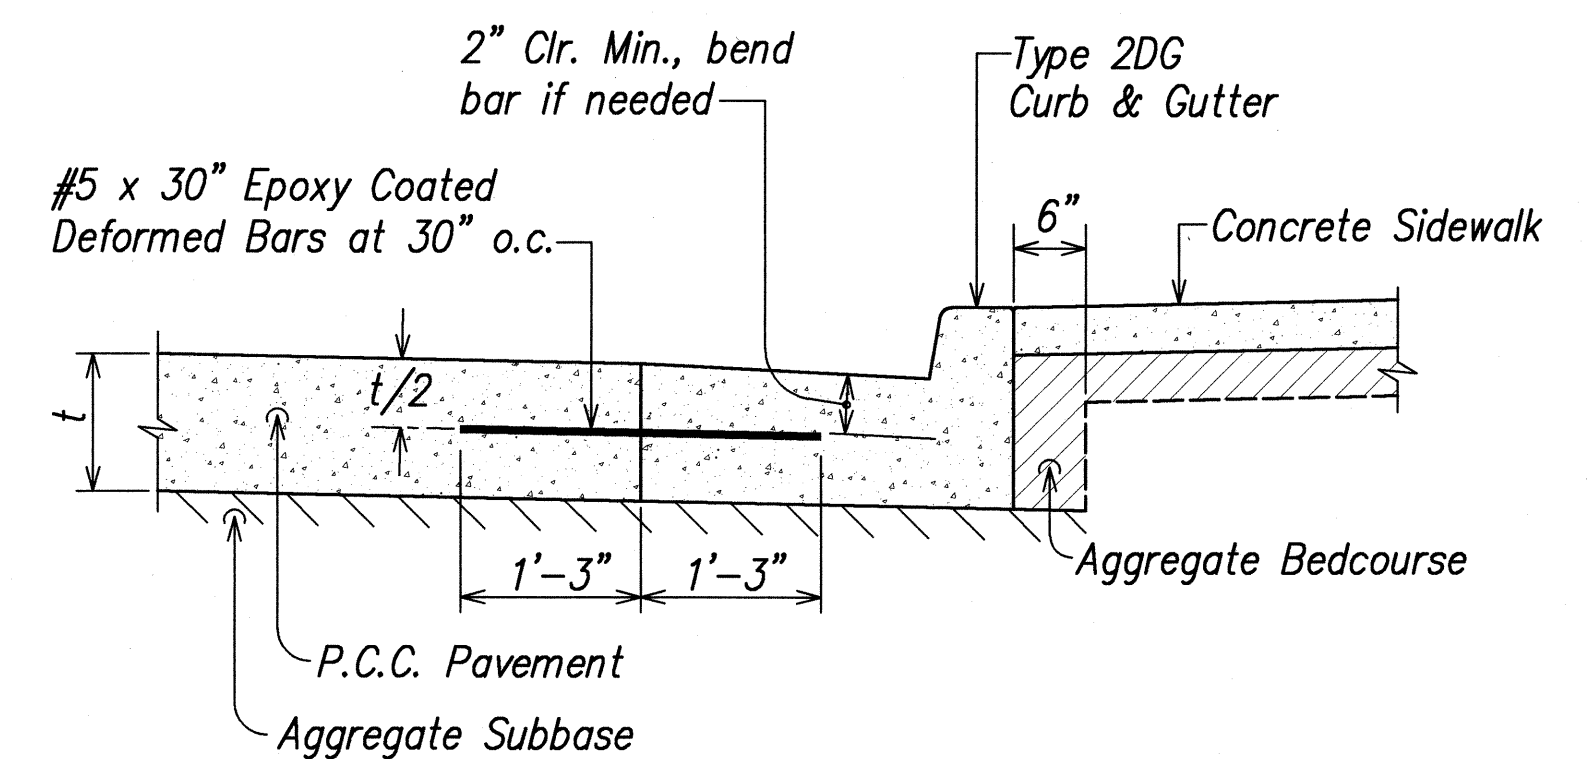

P.C.C. PAVEMENT AT CURB & GUTTER DETAIL

Scale: 3/4" = 1'-0"

7  
J1 T13

|                   |      |
|-------------------|------|
| SURVEY PLOTTED BY | DATE |
| DRAWN BY          |      |
| CHECKED BY        |      |
| NOTED BY          |      |
| QUANTITIES BY     |      |
| CHECKED BY        |      |
| ORIGINAL PLAN     |      |
| NOTE BOOK         |      |
| No.               |      |

LIB: STATE DOT\HAWAII\PROJECTS\REVISIONS\KAWA-113-PC0001.dwg 2/08/09



2-26-09  
THIS WORK WAS PREPARED BY  
ME OR UNDER MY SUPERVISION  
Glenn K. Ikeda  
P.E., Inc.  
480 PARK ENGINEERING  
LICENSE EXPIRES 4-30-10

STATE OF HAWAII  
DEPARTMENT OF TRANSPORTATION  
HIGHWAYS DIVISION






P.C.C. PAVEMENT DETAILS

KAUMUALII HIGHWAY WIDENING  
Vicinity of Anonui Street to Vicinity of Lihue Mill Bridge  
FEDERAL-AID PROJECT NO. NH-050-1(31)

Scale: As Noted Date: FEB. 2009


SHEET NO. T13 OF T18 SHEETS

| FED. ROAD DIST. NO. | STATE | FED. AID PROJ. NO. | FISCAL YEAR | SHEET NO. | TOTAL SHEETS |
|---------------------|-------|--------------------|-------------|-----------|--------------|
| HAWAII              | HAW.  | NH-050-1(31)       | 2009        | 24        | 452          |

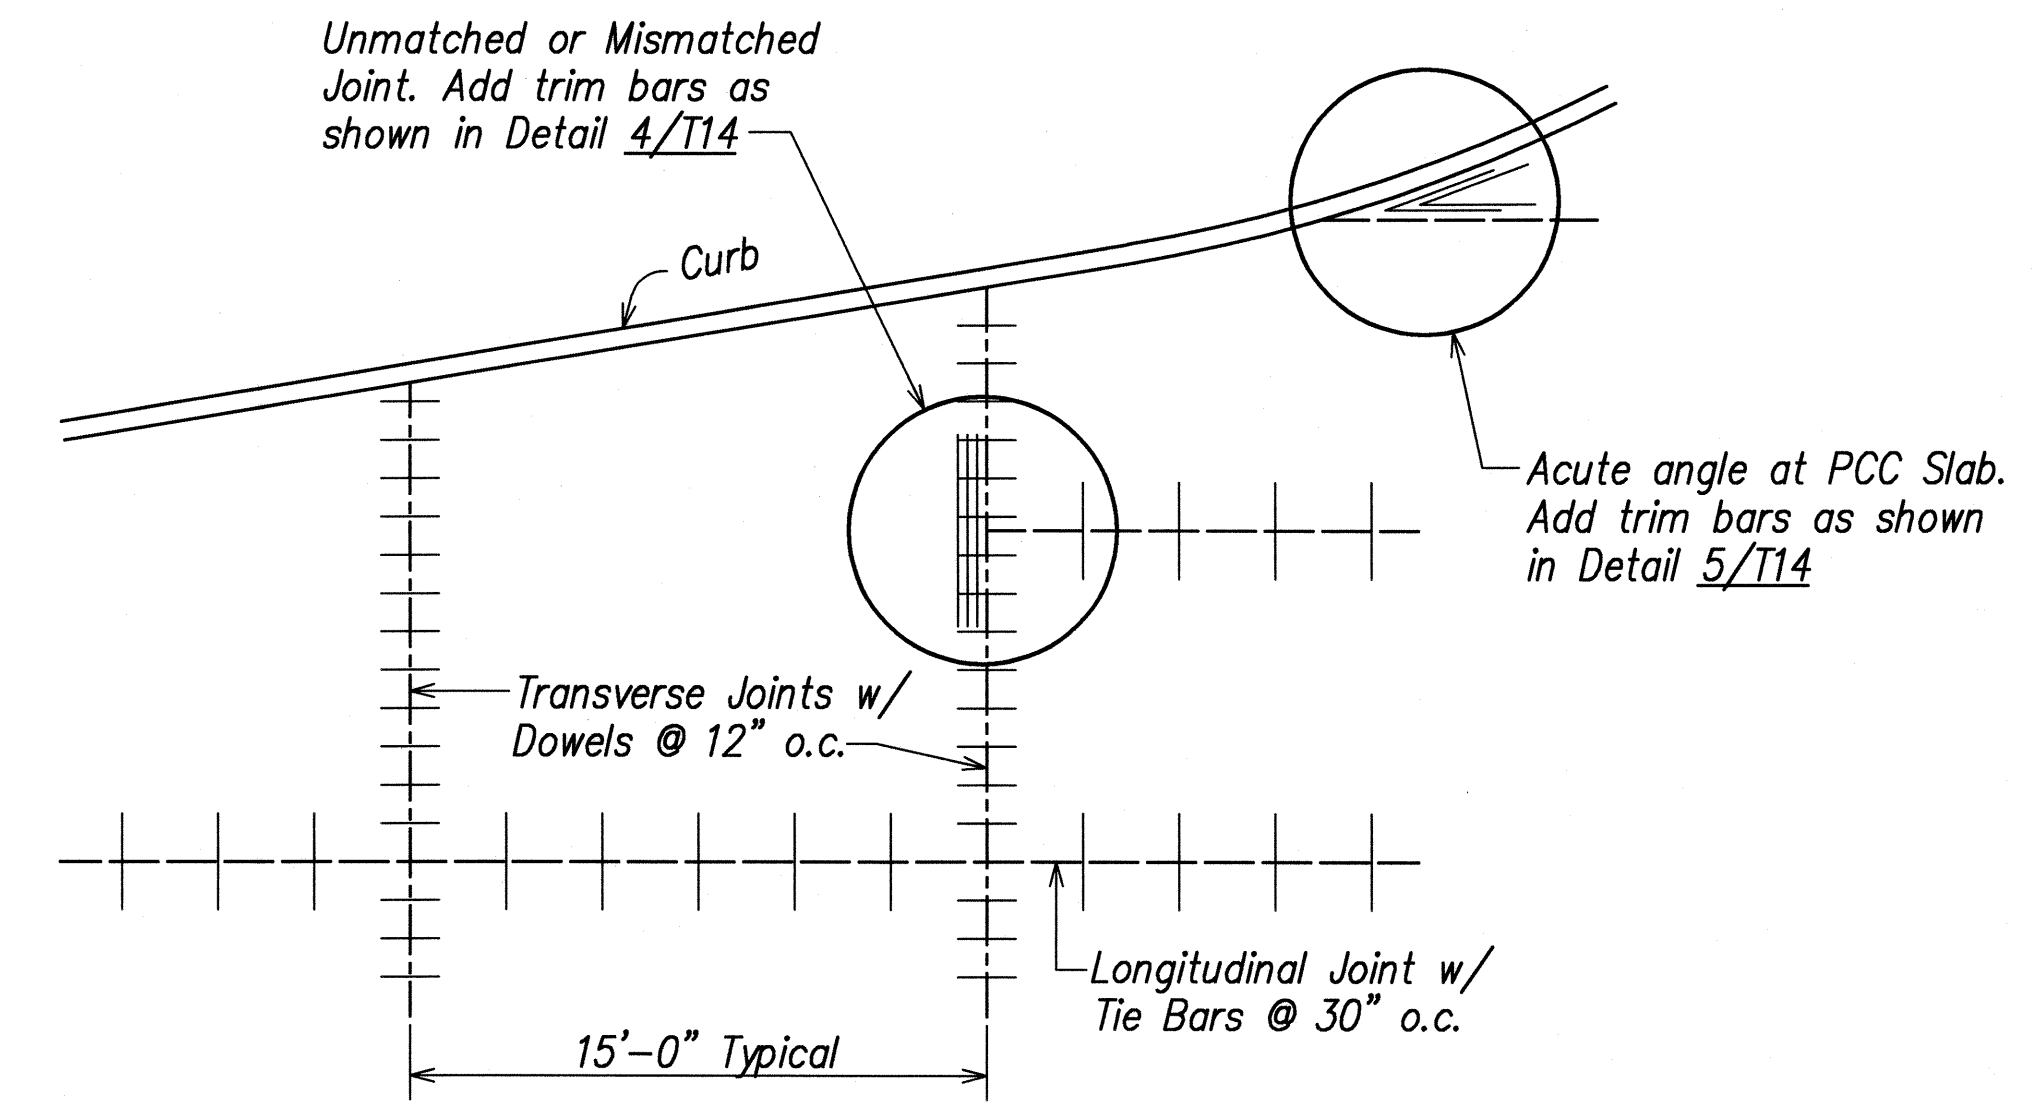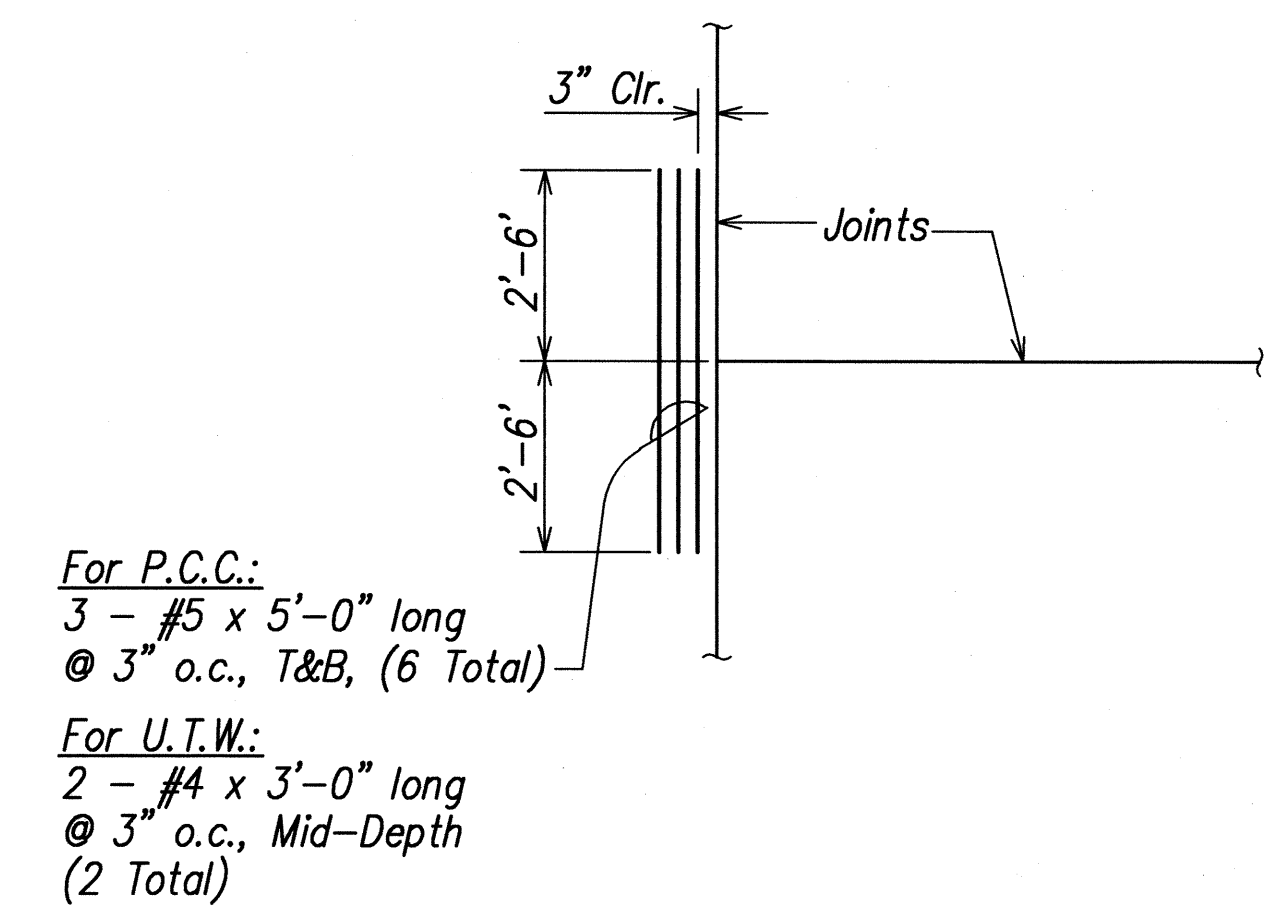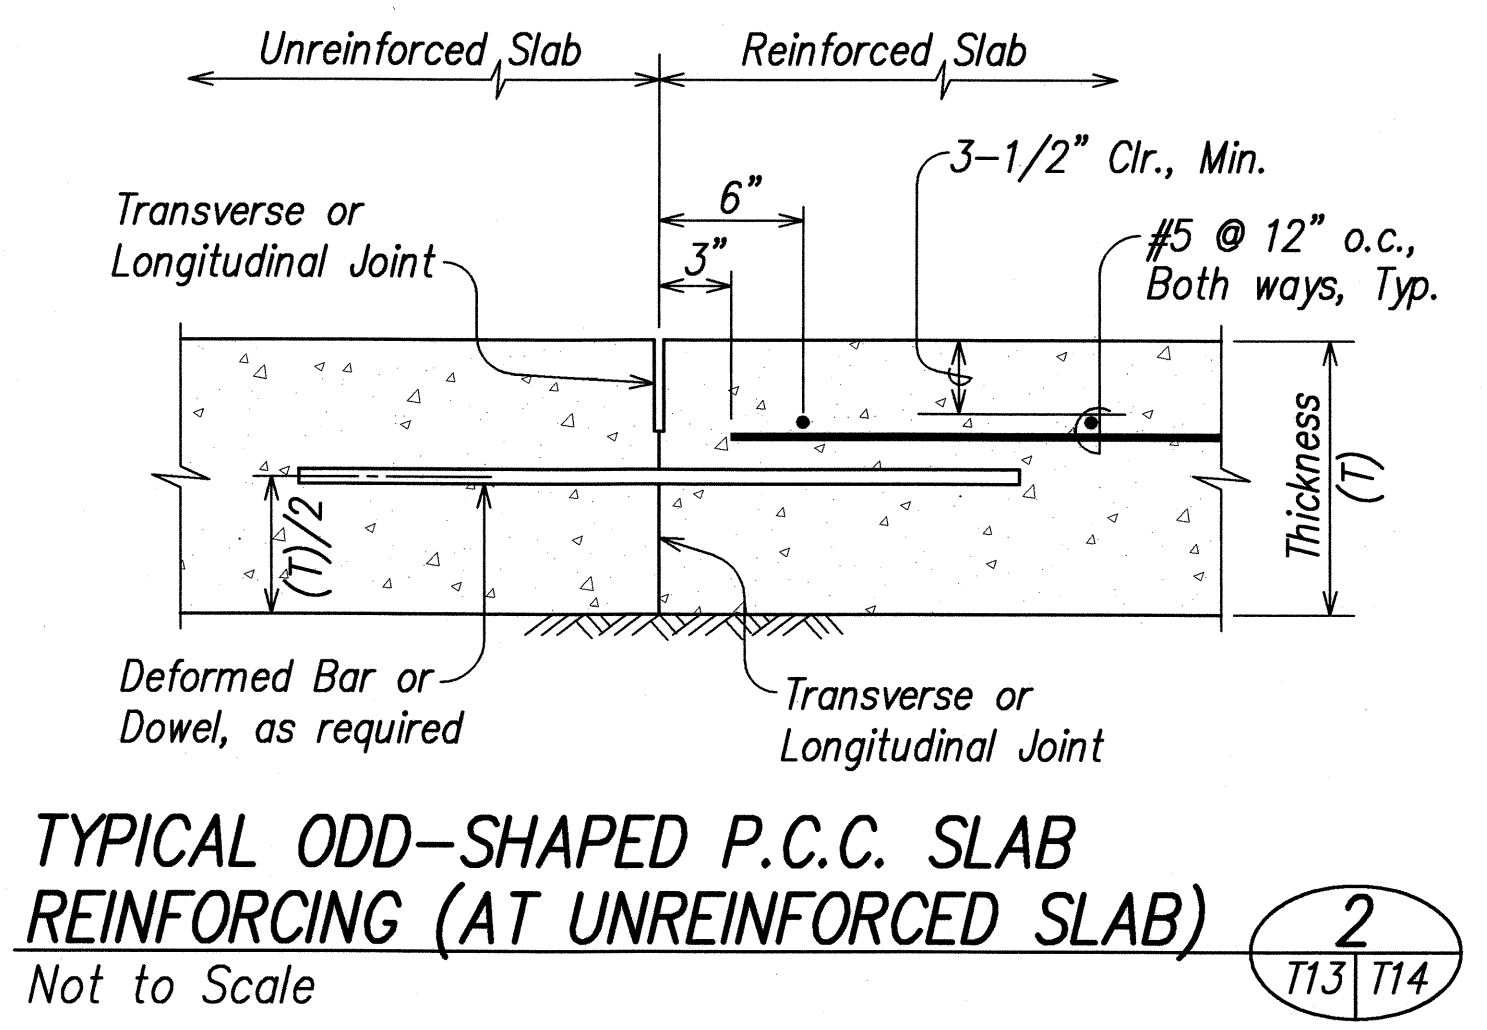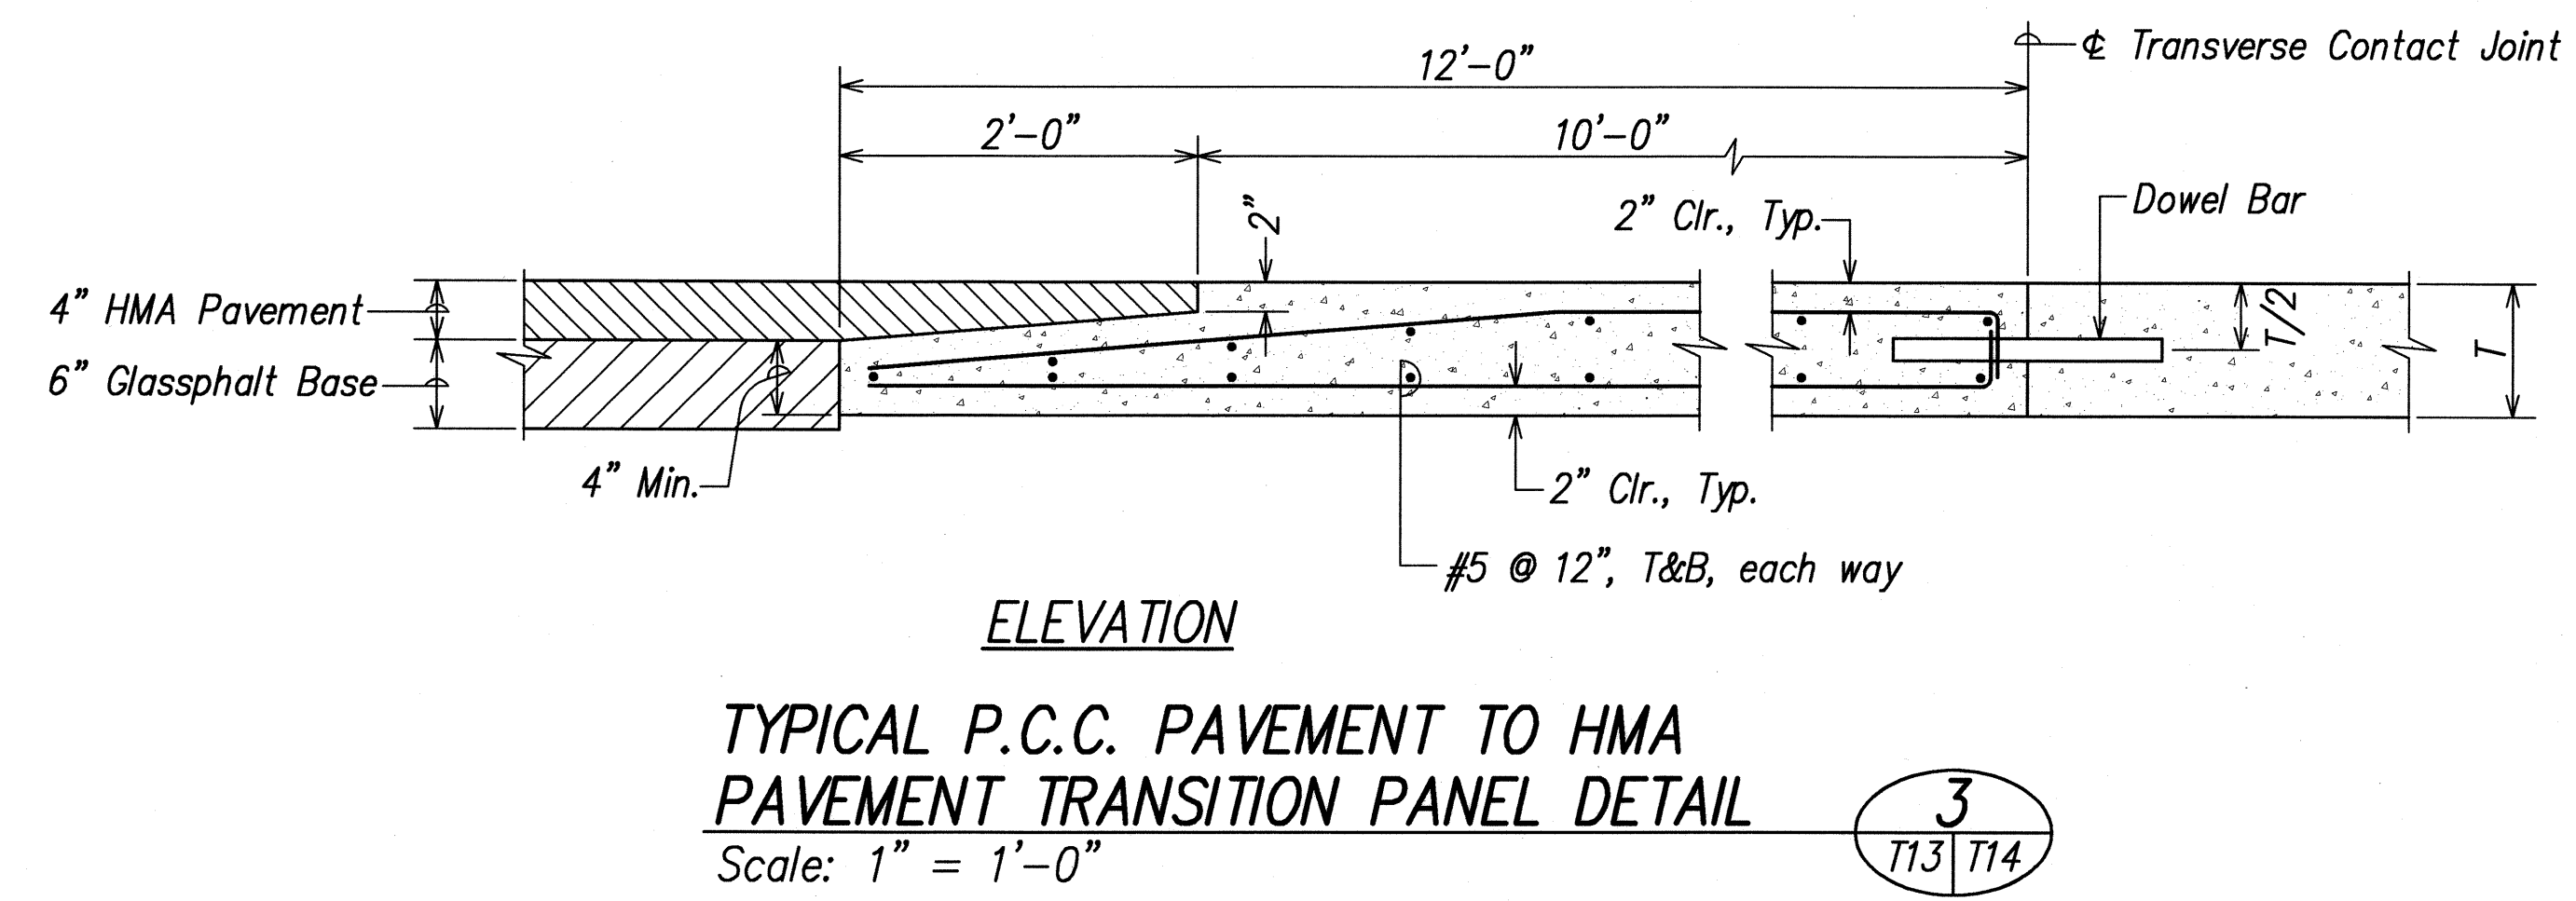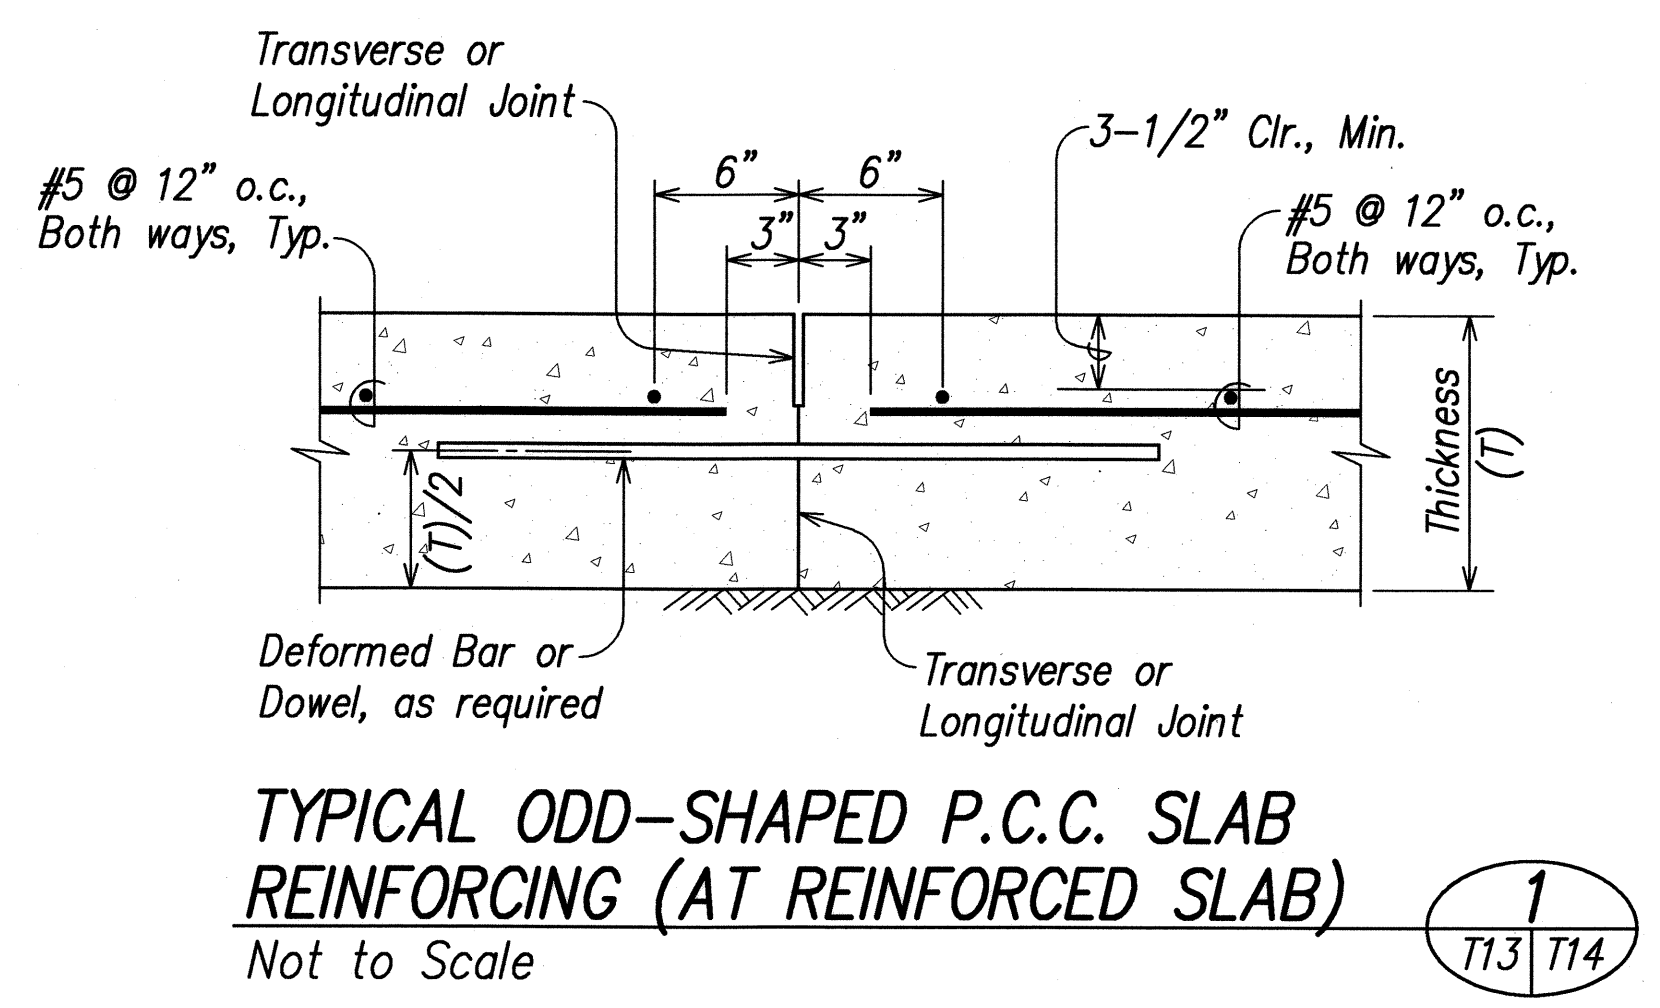

**ODD-SHAPED SLAB REINFORCING NOTES:**

- For dowel or deformed bar details and joint construction details, see applicable transverse or longitudinal joint details on Sht. T13.
- Reinforce odd shaped slabs: Slabs with ratio of length of one side to other side greater than 1.25 or less than 0.8; slabs with unmatched (or mismatched) joints; triangular shaped slabs; or slabs with at least one side larger than 15 feet.
- Slabs requiring reinforcing shall be reinforced with #5 deformed bars at 1'-0" o.c., each way (transversely and longitudinally) and with 7.5#/C.Y. of structural fibers.
- Structural fiber reinforcement shall consist of 7-1/2 pounds of "Forta Ferro", or accepted equal. Fiber shall be synthetic structural fiber made of 100% virgin copolymer/propylene consisting of a twisted bundle non-fibrillating monofilament and a fibrillating network fiber, and shall conform to ASTM C 1116 and ACI 544.
- Chairs and additional reinforcing required for support are not shown on the details, but shall be considered incidental to the Reinforcing.
- Contractor shall verify the dimensions of odd-shaped slabs prior to fabrication of reinforcing mats.

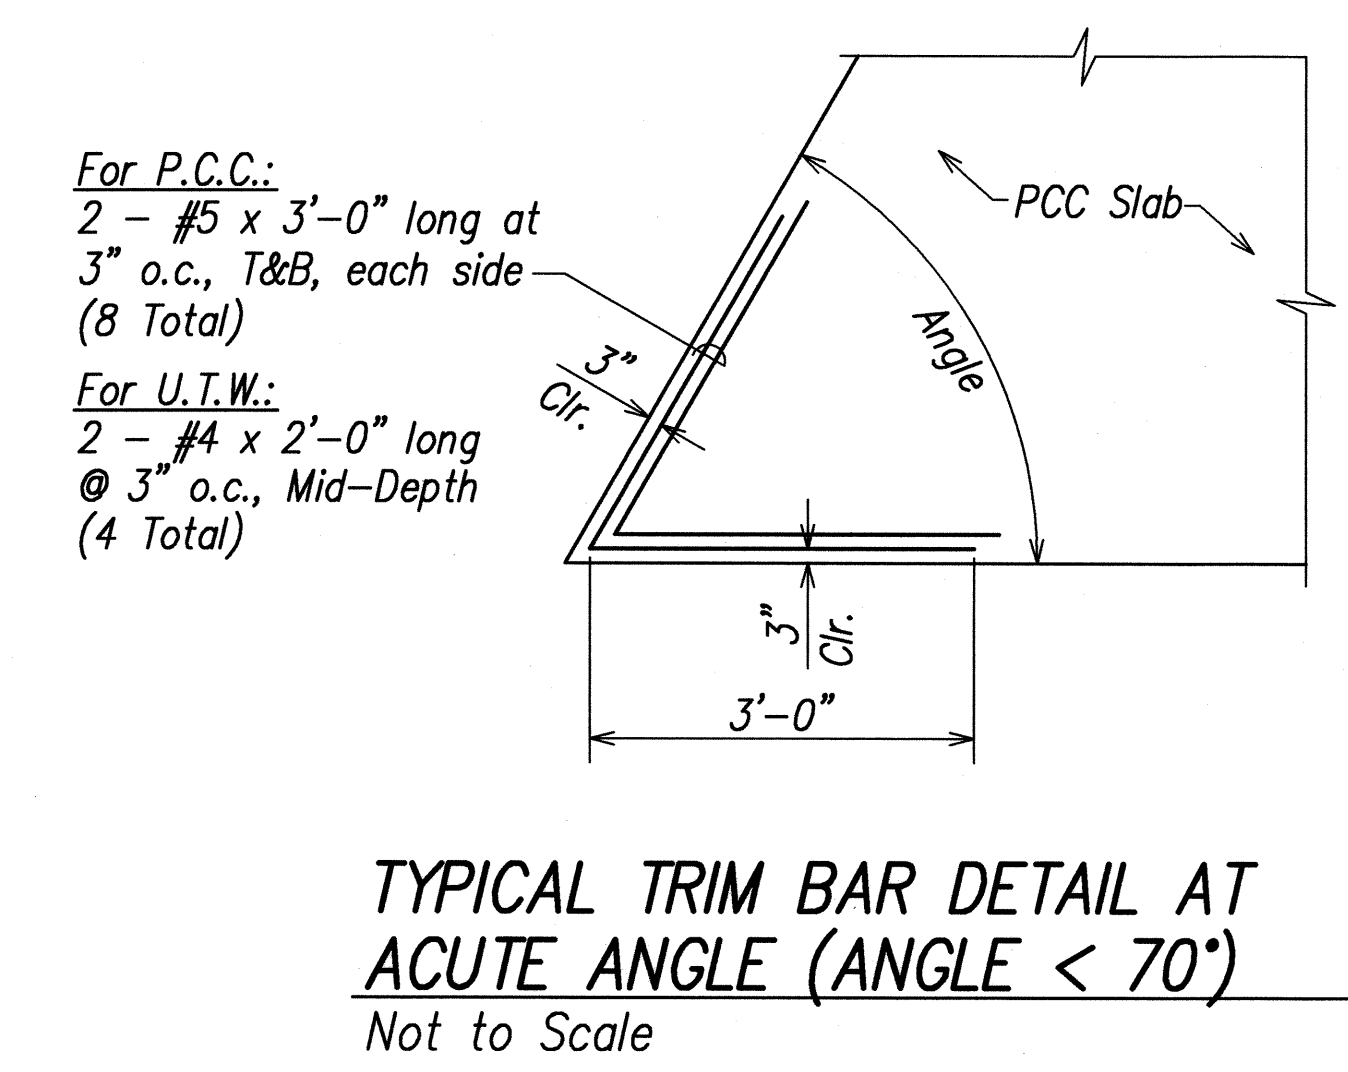

|                   |      |
|-------------------|------|
| SURVEY PLOTTED BY | DATE |
| DRAWN BY          |      |
| TRACED BY         |      |
| CHECKED BY        |      |
| QUANTITIES BY     |      |
| NO.               |      |


LIB2: STATE DOT KAUNALANI HIGHWAY REVISION PLAN: KAHW-114-PCDD-ETD.dwg 2/06/09



THIS WORK WAS PREPARED BY ME OR UNDER MY SUPERVISION  
 Glenn K. Ikeda  
 P.E., INC.  
 dba PARK ENGINEERING  
 LICENSE EXPIRES 4-30-10


STATE OF HAWAII  
 DEPARTMENT OF TRANSPORTATION  
 HIGHWAYS DIVISION  
  
**P.C.C. PAVEMENT DETAILS**  
  
 KAUNUALII HIGHWAY WIDENING  
 Vicinity of Anonui Street to Vicinity of Lihue Mill Bridge  
 FEDERAL-AID PROJECT NO. NH-050-1(31)  
 Scale: As Noted Date: FEB. 2009  
 SHEET No. T14 OF T18 SHEETS

| FED. ROAD DIST. NO. | STATE | FED. AID PROJ. NO. | FISCAL YEAR | SHEET NO. | TOTAL SHEETS |
|---------------------|-------|--------------------|-------------|-----------|--------------|
| HAWAII              | HAW.  | NH-050-1(31)       | 2009        | 25        | 452          |

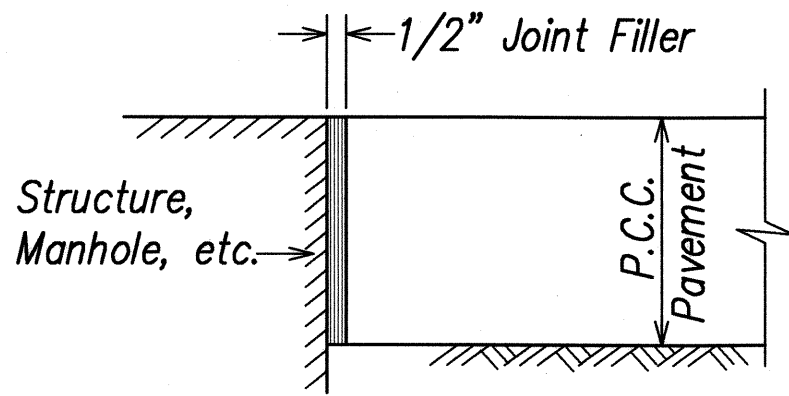


ISOLATION JOINT DETAIL  
Not to Scale


1  
T13 T15

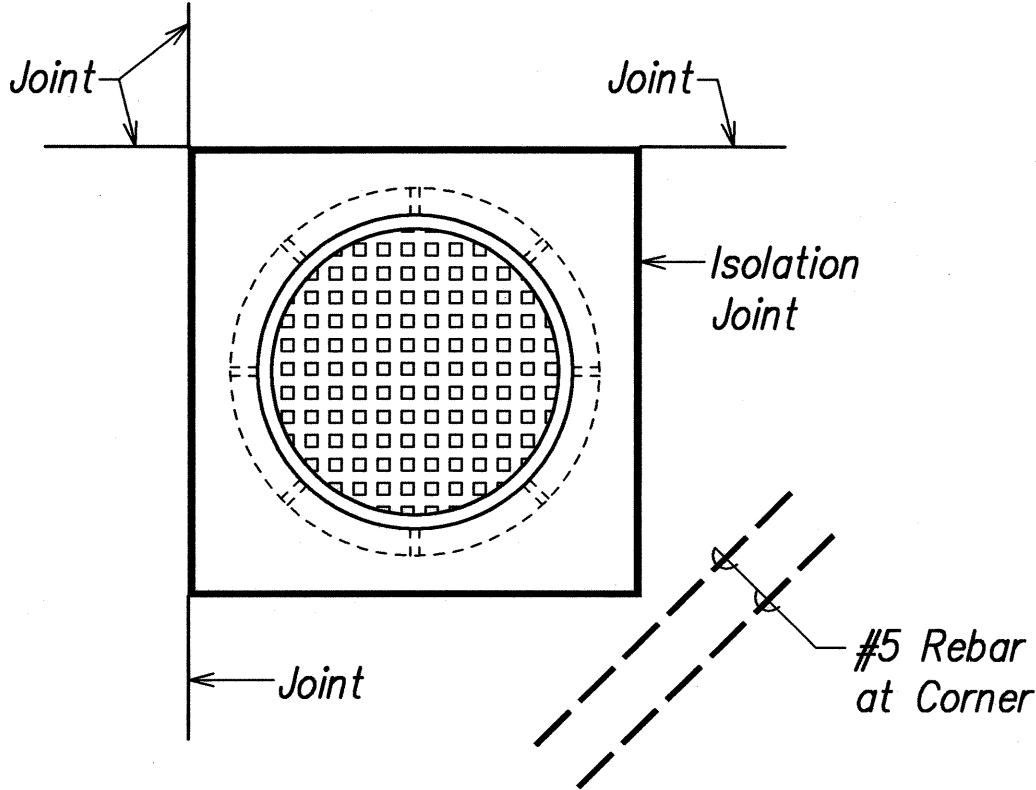


SQUARE BOXOUT

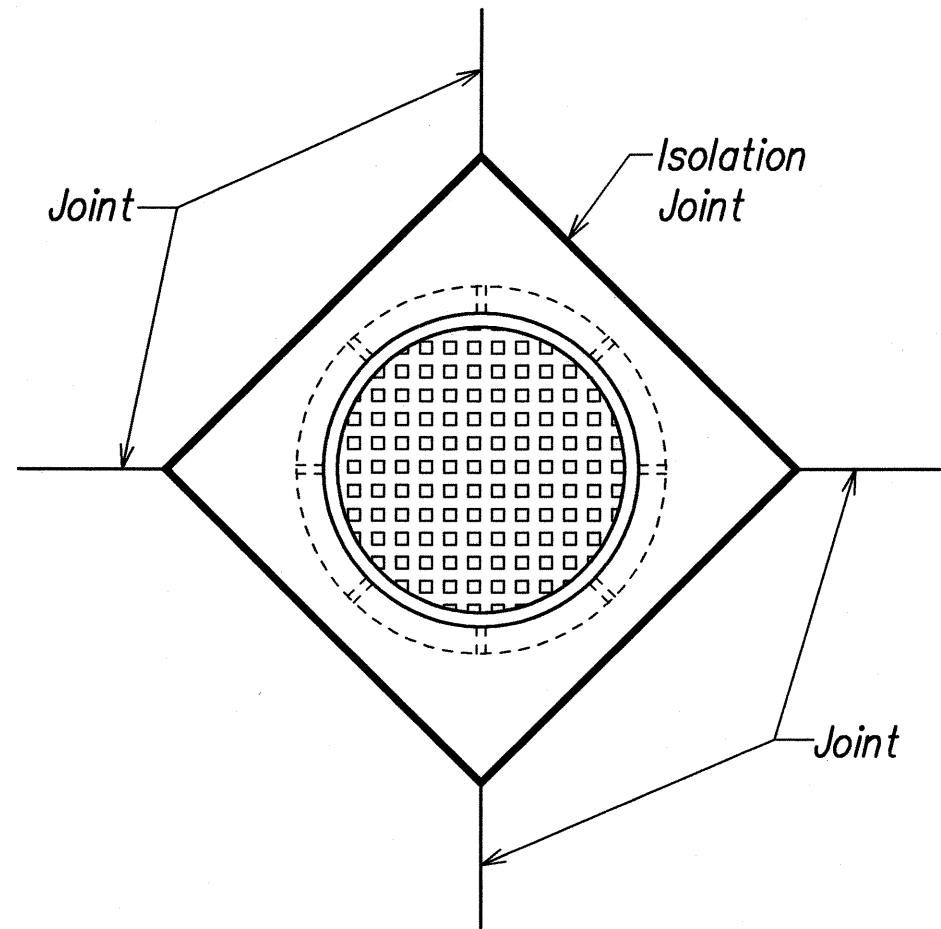

DIAMOND BOXOUT

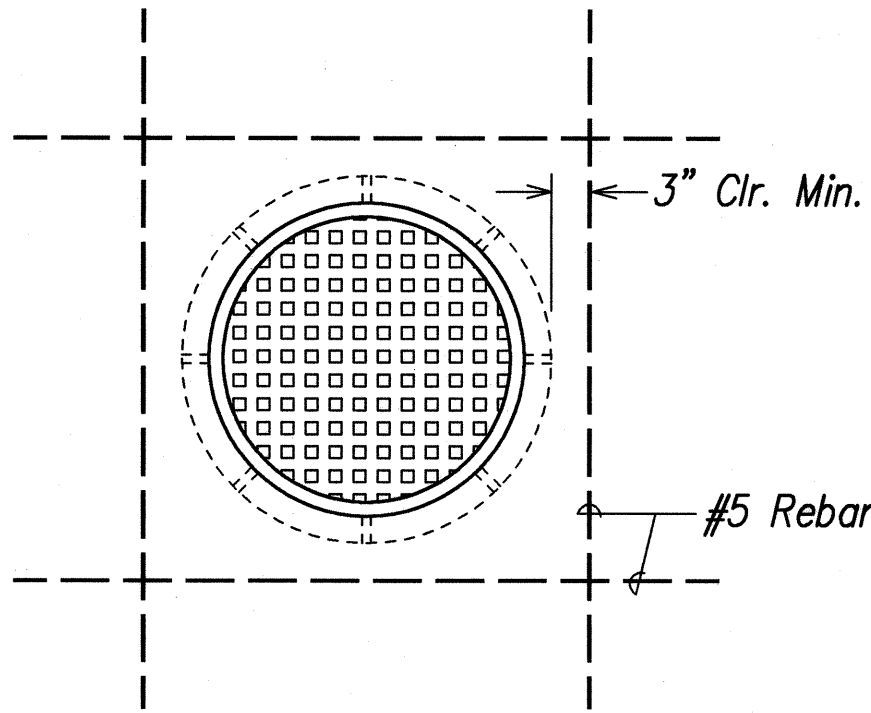


REINFORCED PANEL

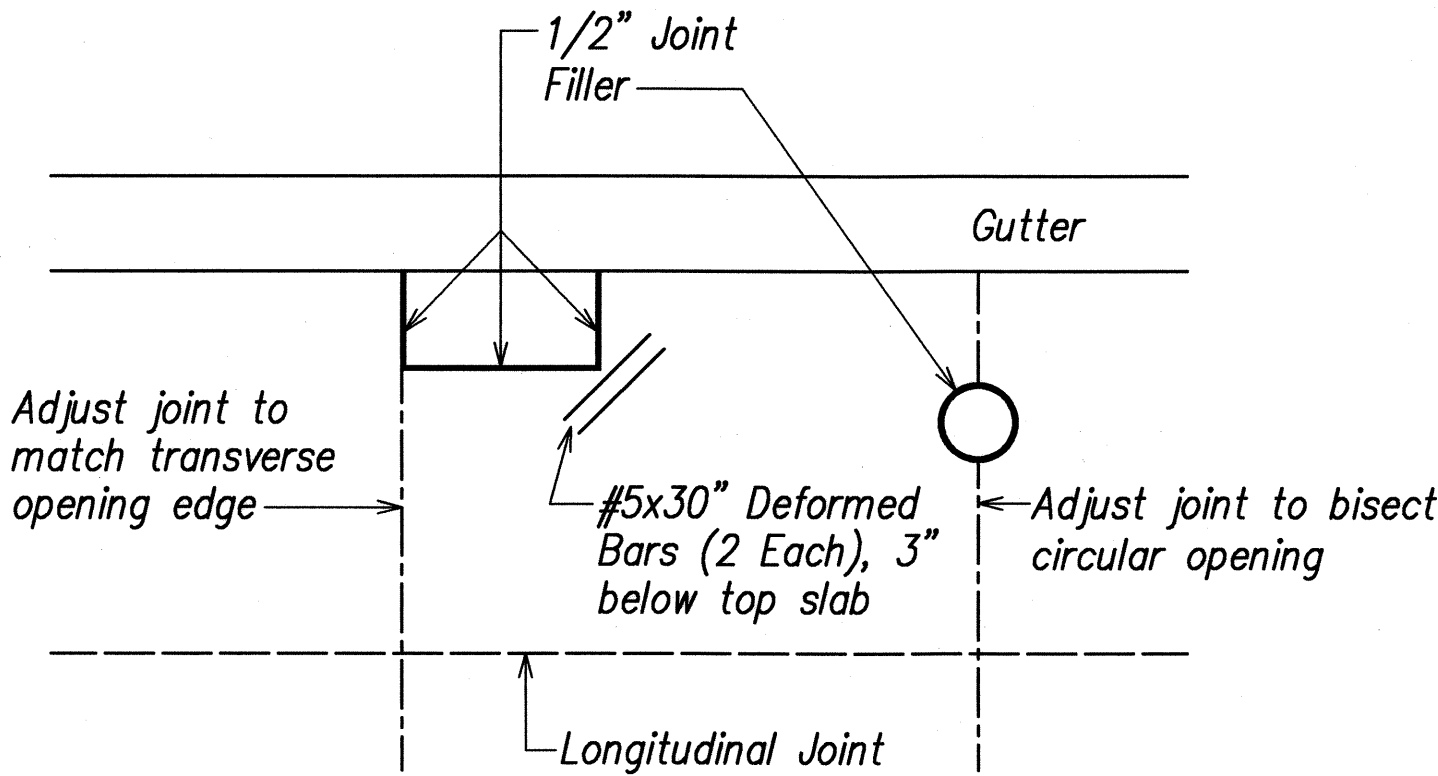


OPENINGS NEAR JOINTS DETAIL  
Not to Scale

2  
T13 T15

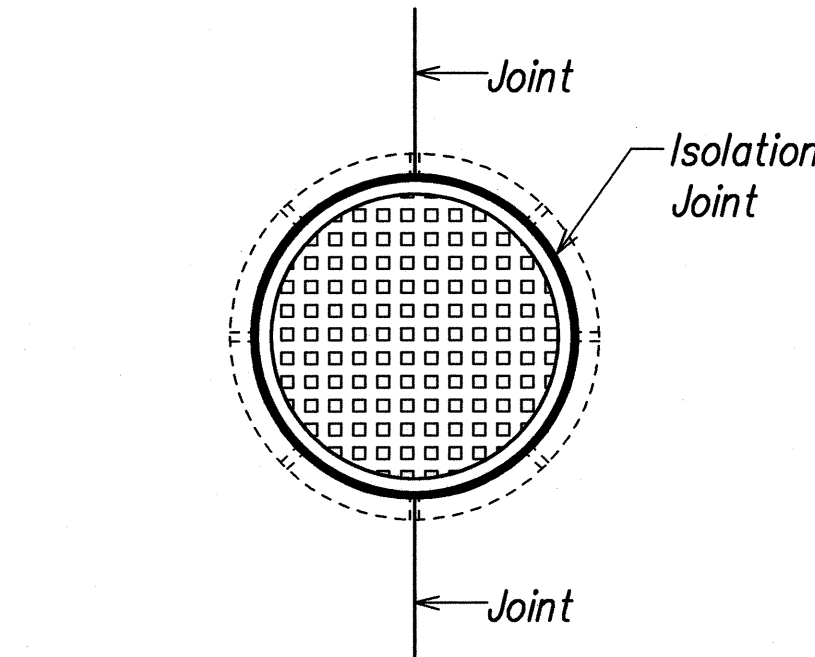

NO BOXOUT  
(Isolation Around Manhole)

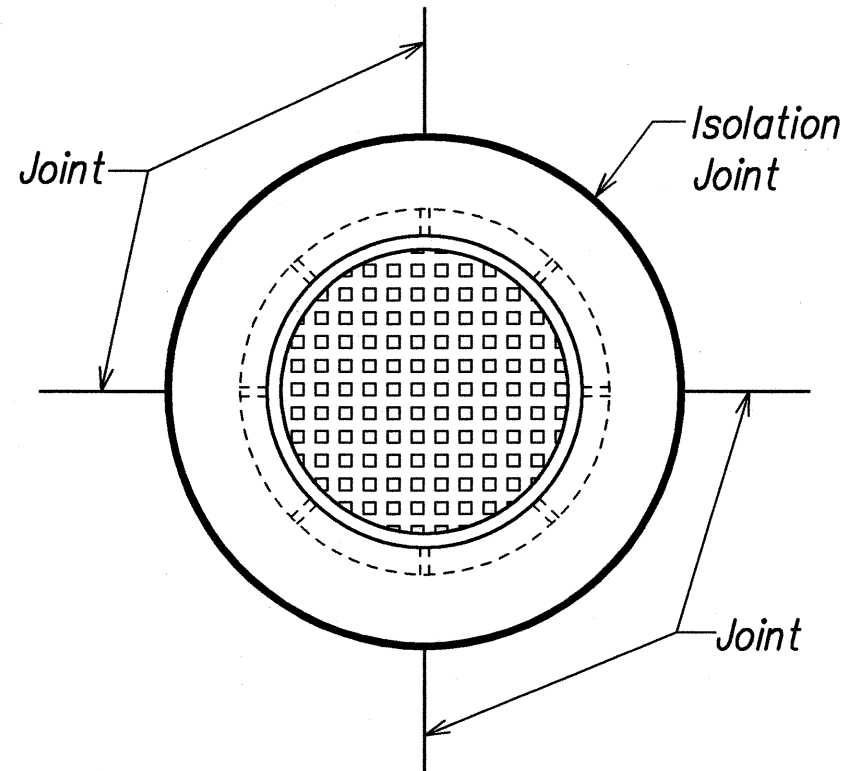


CIRCULAR BOXOUT

Notes:

1. Isolation joints shall be 1/2" wide, unless otherwise noted, and filled with joint filler.
2. Boxouts shall be large enough to provide 12" clearance between the structure and surrounding isolation joint.
3. Boxout details for rectangular inlets, pullboxes, or other structures shall be similar.
4. All boxout details are applicable to boxouts on both P.C.C. pavement and U.T.W. pavement.


MANHOLE COVER BOXOUT DETAILS  
Scale: 3/4" = 1'-0"

4  
T13 T15

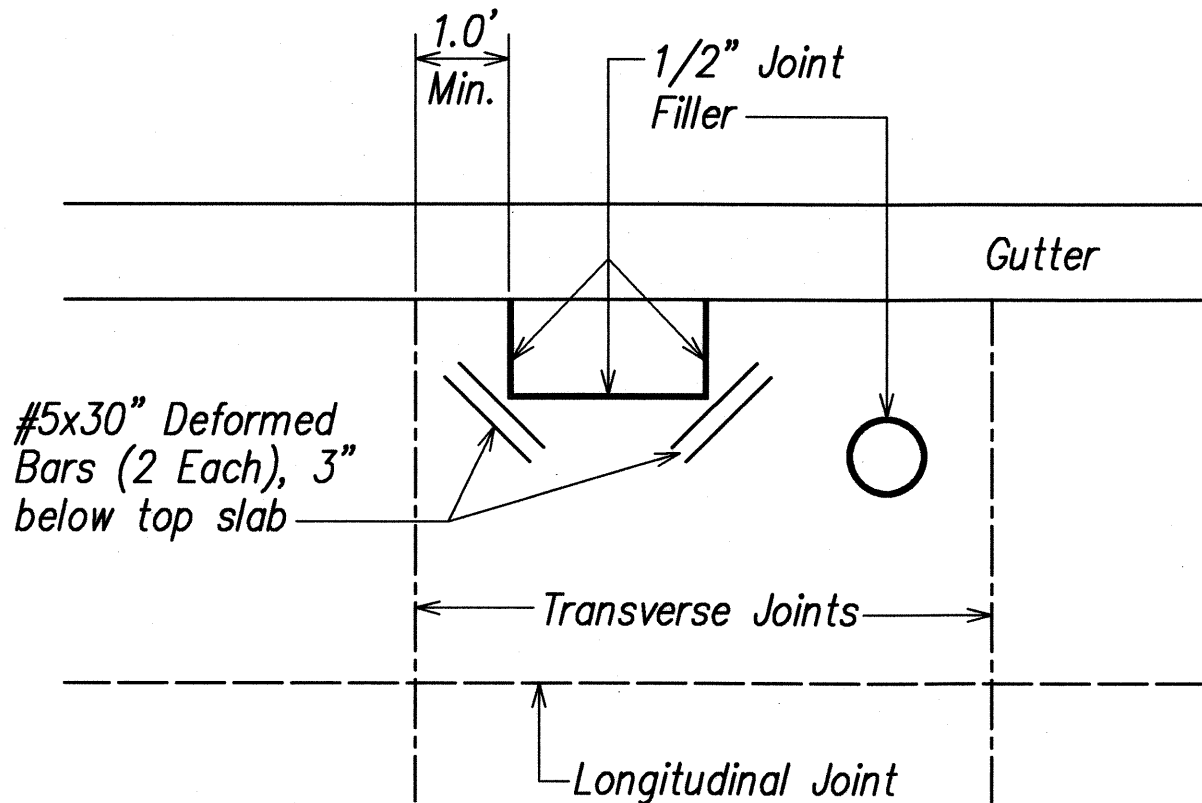

OPENINGS AWAY FROM JOINTS DETAIL  
Not to Scale

3  
T13 T15

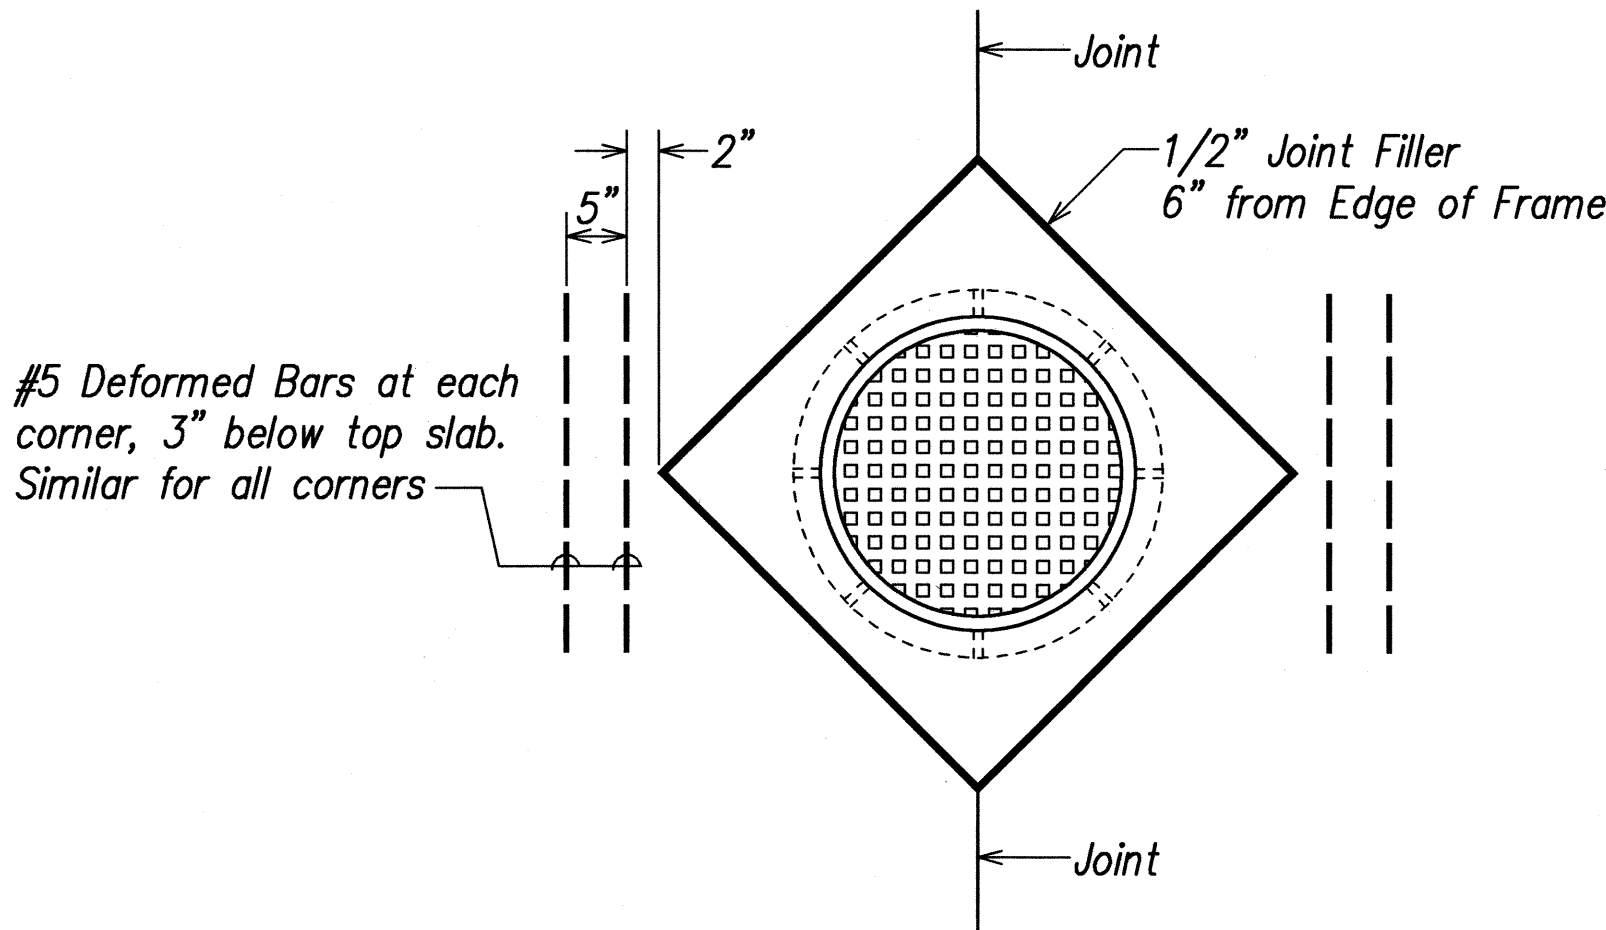

OPENINGS WITH CORNERS -  
CORNERS AT A JOINT DETAIL  
Not to Scale

5  
T13 T15

|                   |      |
|-------------------|------|
| SURVEY PLOTTED BY | DATE |
| DRAWN BY          |      |
| TRACED BY         |      |
| CHECKED BY        |      |
| NOTE BOOK         |      |
| NO.               |      |


LIB: STATE DOT/KAUAI-1/1/08/11/25/08



THIS WORK WAS PREPARED BY  
ME OR UNDER MY SUPERVISION  
Glenn K. Ikeda  
FEBRUARY, 2009  
dba PARK ENGINEERING  
LICENSE EXPIRES 4-30-10

STATE OF HAWAII  
DEPARTMENT OF TRANSPORTATION  
HIGHWAYS DIVISION  
  
ISOLATION JOINT DETAILS  
  
KAUAI HIGWAY WIDENING  
Vicinity of Anonui Street to Vicinity of Lihue Mill Bridge  
FEDERAL-AID PROJECT NO. NH-050-1(31)  
Scale: As Noted Date: FEB. 2009  
SHEET NO. T15 OF T18 SHEETS


| FED. ROAD DIST. NO. | STATE | FED. AID PROJ. NO. | FISCAL YEAR | SHEET NO. | TOTAL SHEETS |
|---------------------|-------|--------------------|-------------|-----------|--------------|
| HAWAII              | HAW.  | NH-050-1(31)       | 2009        | 26        | 452          |

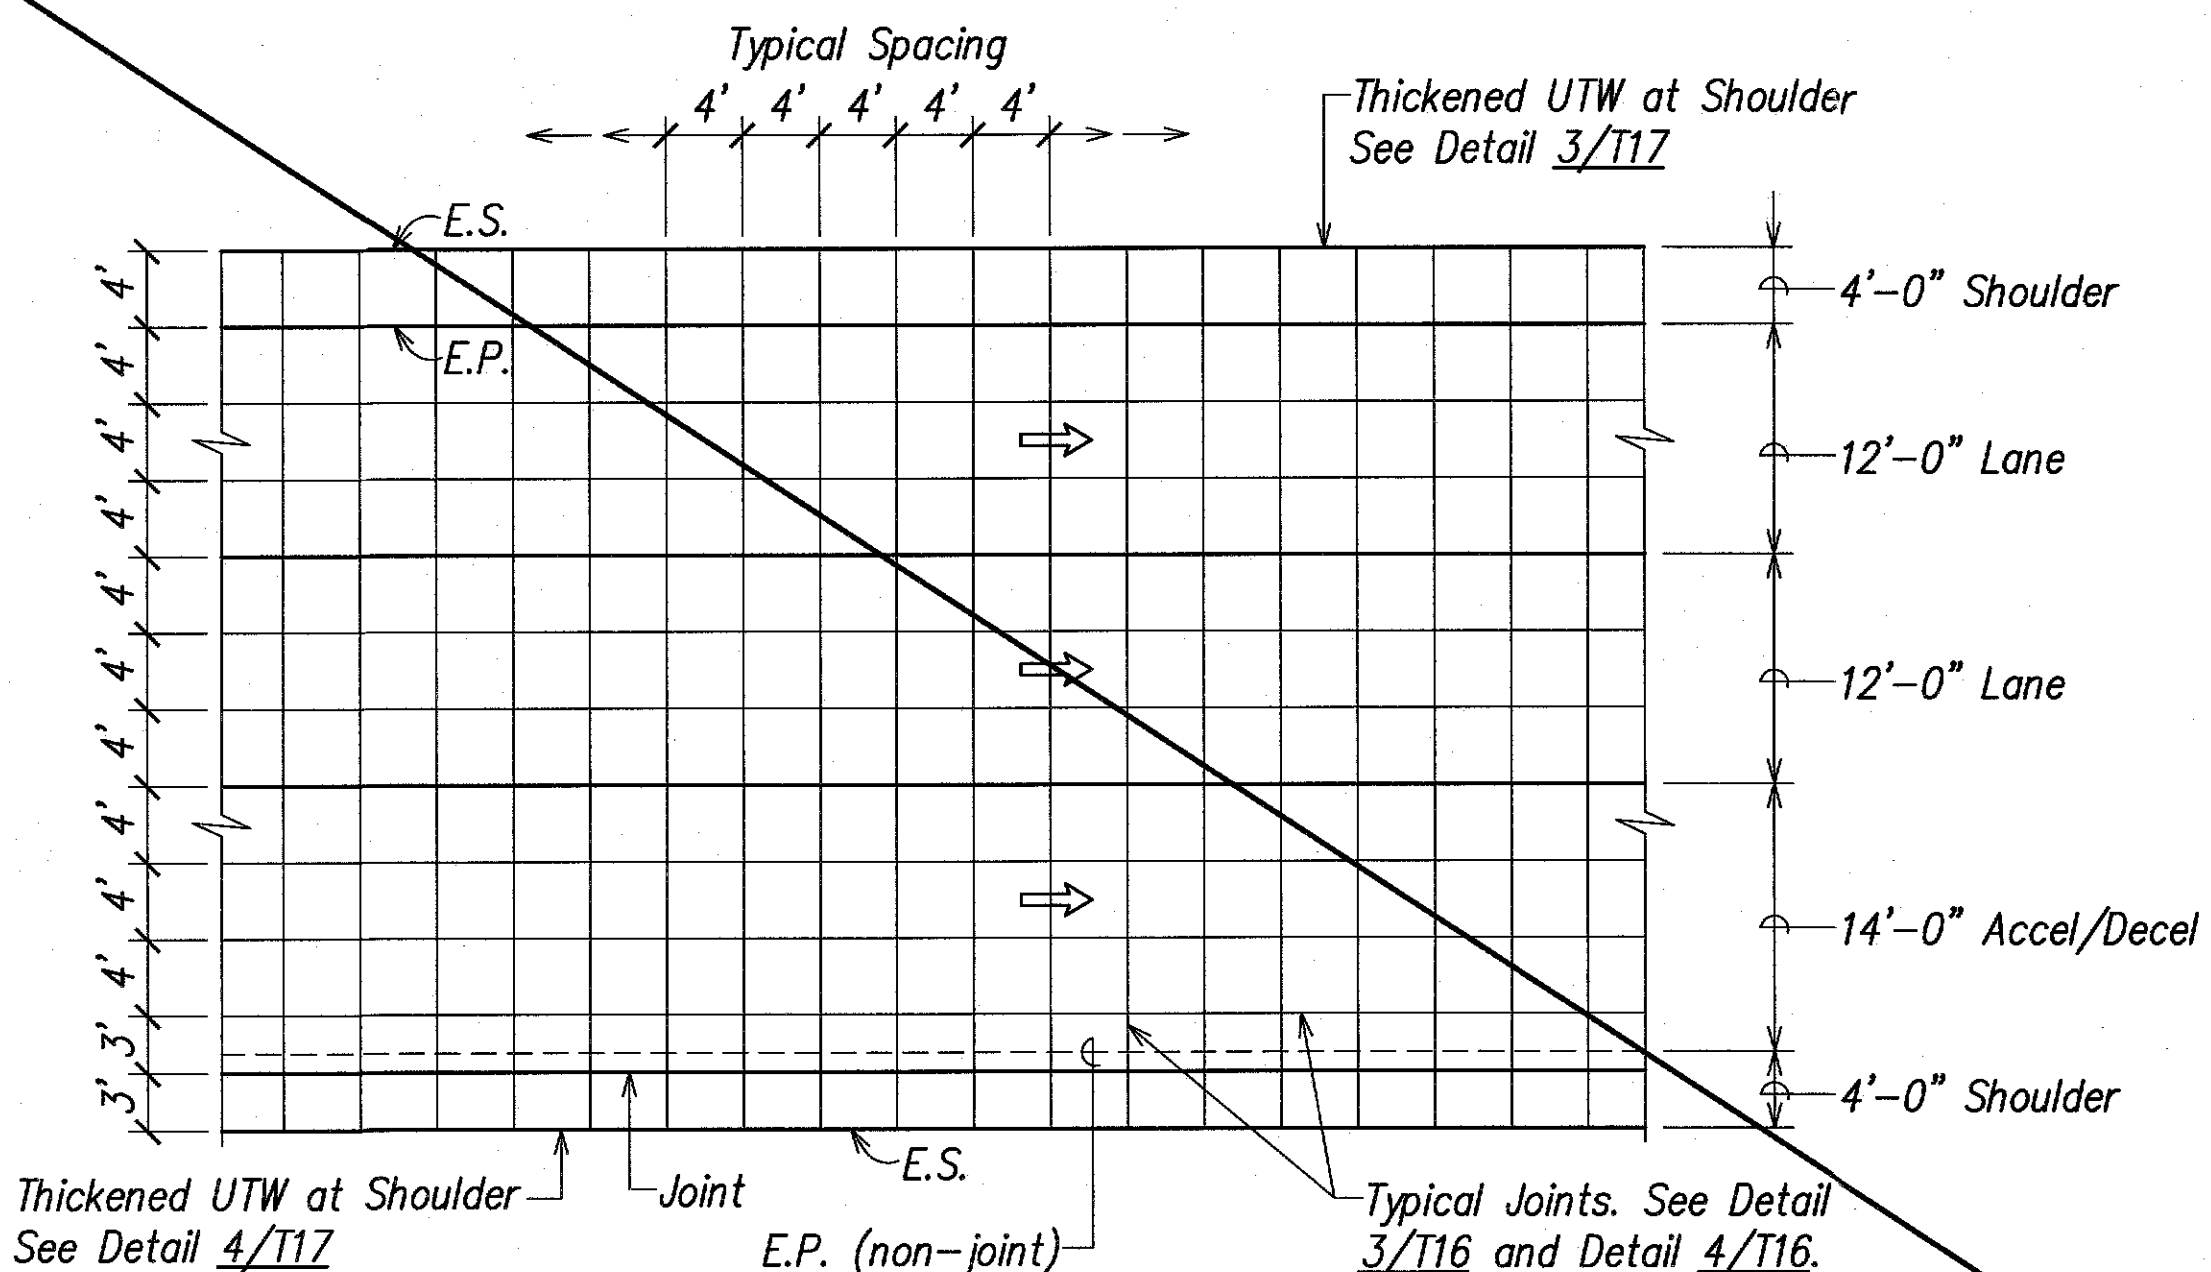

**TYPICAL U.T.W. PAVEMENT (NON-CURBED AREAS)  
JOINT LOCATION AND LAYOUT PLAN**

Scale: 1" = 10'


1  
T16

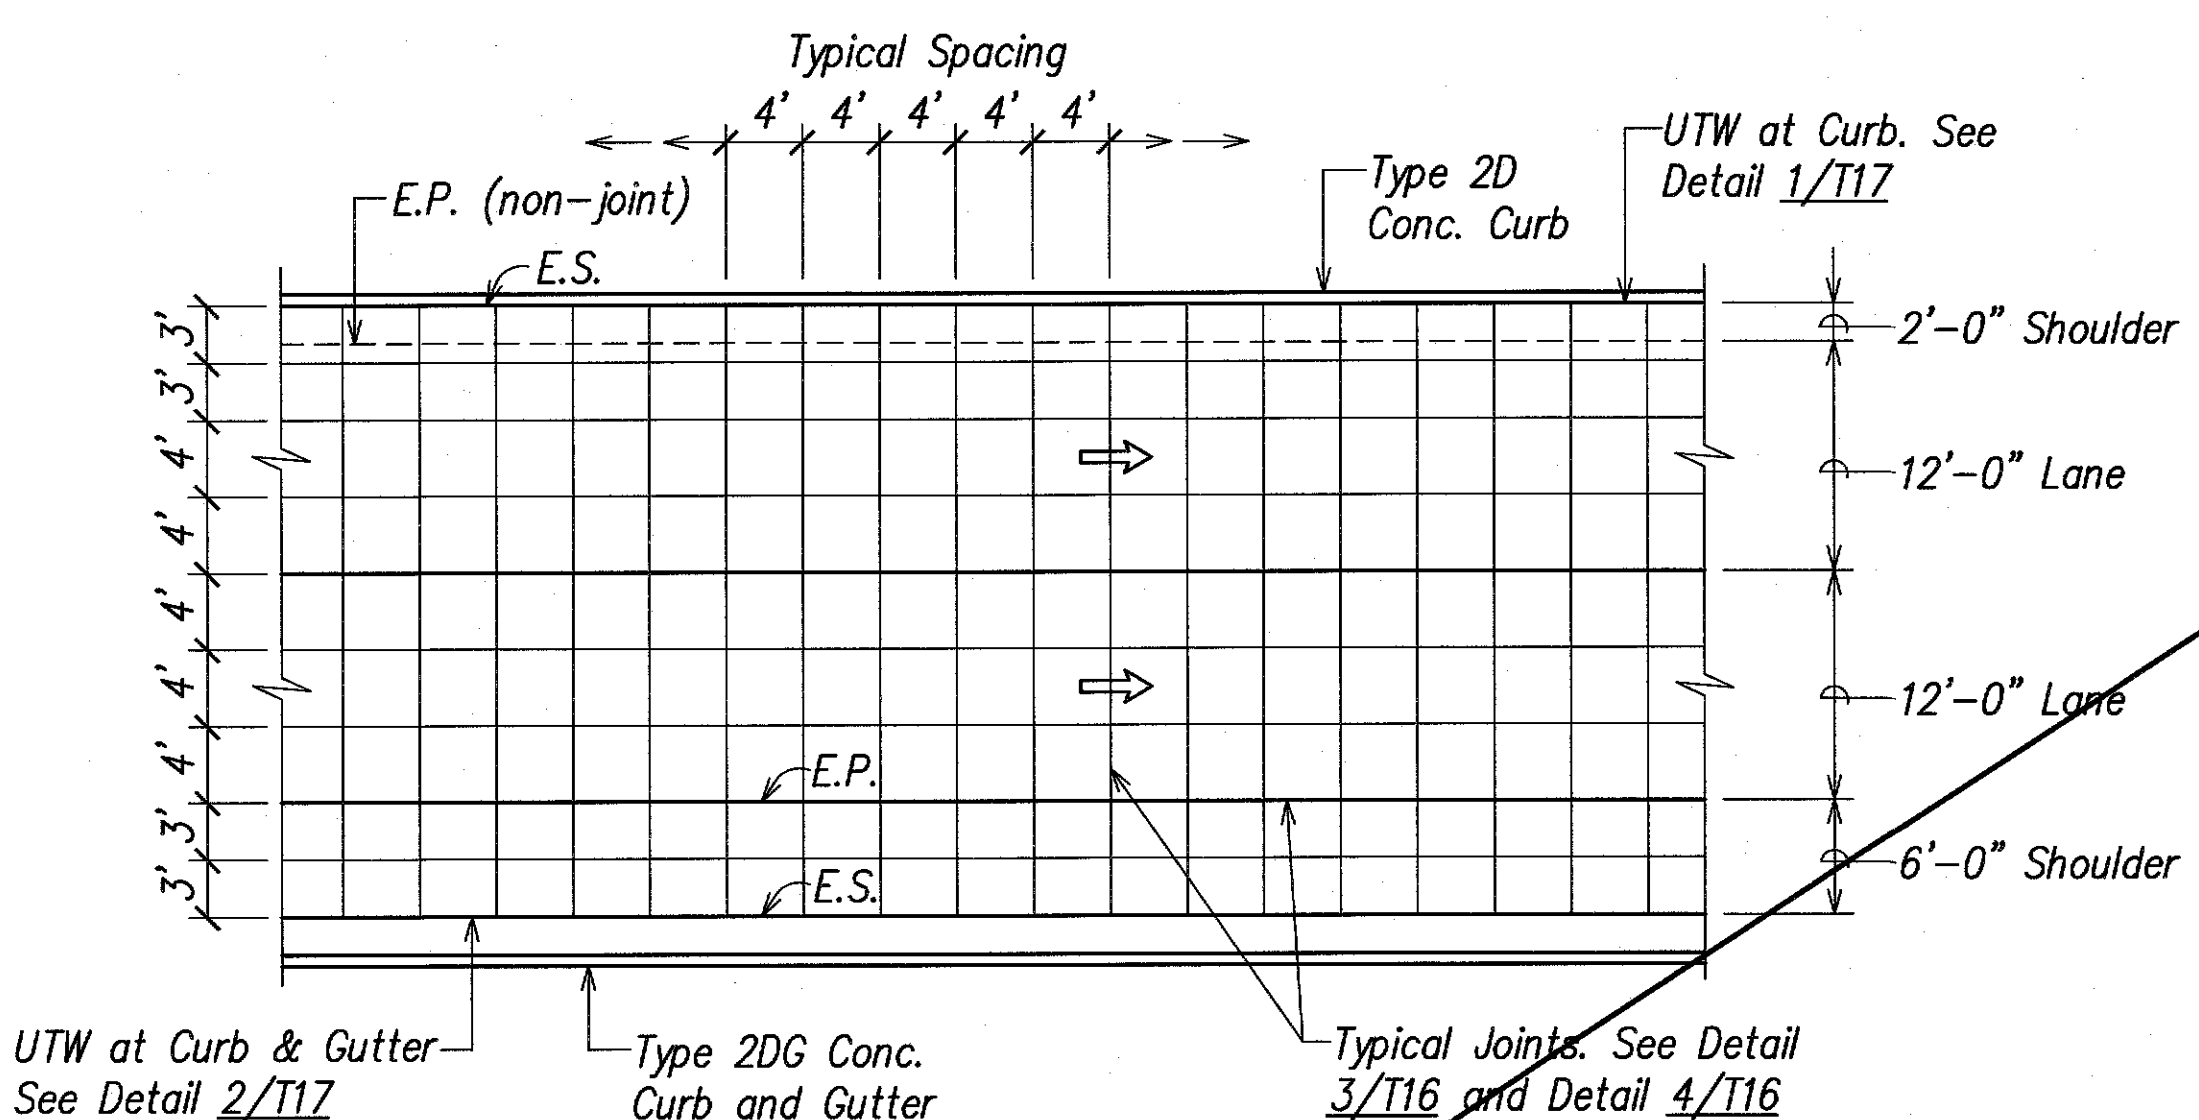

**TYPICAL U.T.W. PAVEMENT (CURBED AREAS)  
JOINT LOCATION AND LAYOUT PLAN**

Scale: 1" = 10'


2  
T16

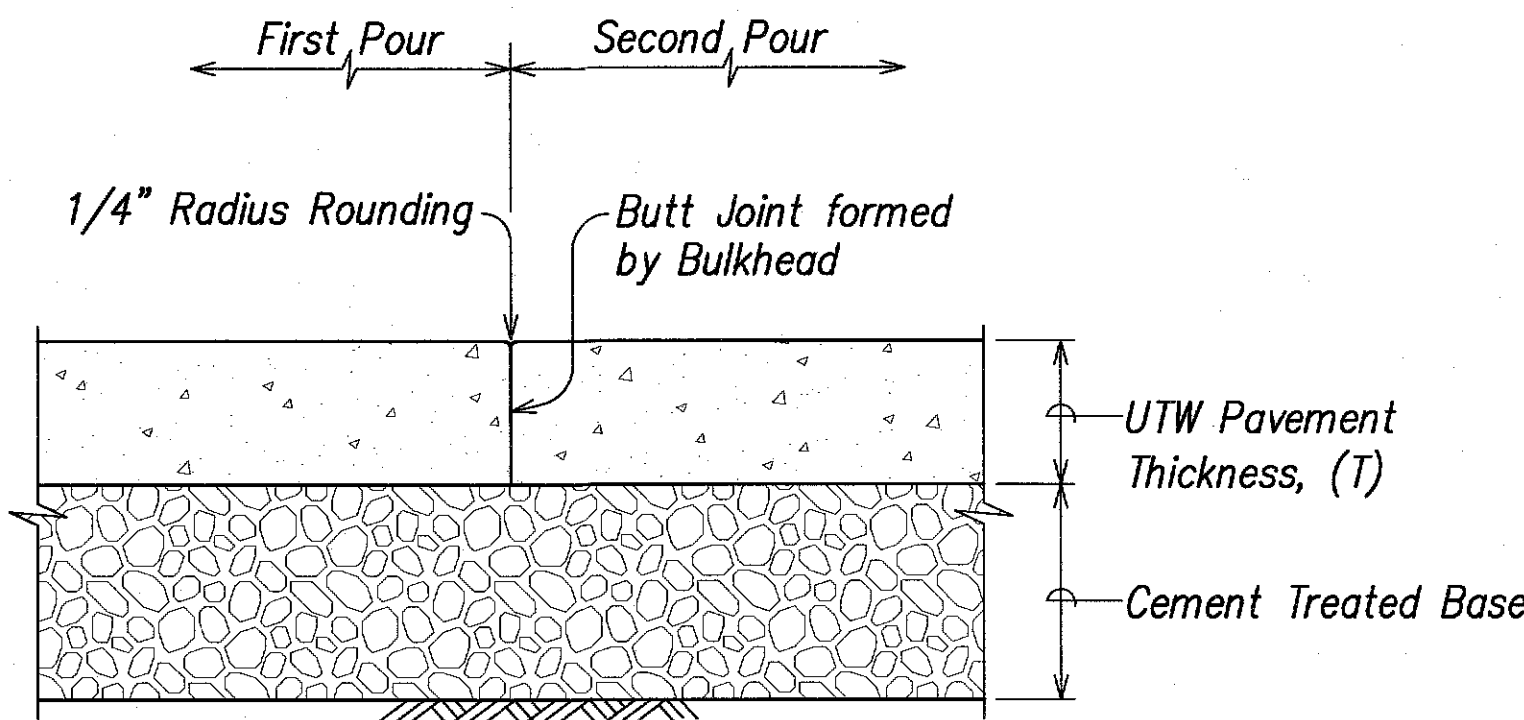

**TRANSVERSE OR LONGITUDINAL CONSTRUCTION  
JOINT (CONTACT JOINT)**

Not to Scale

3  
T16 T16

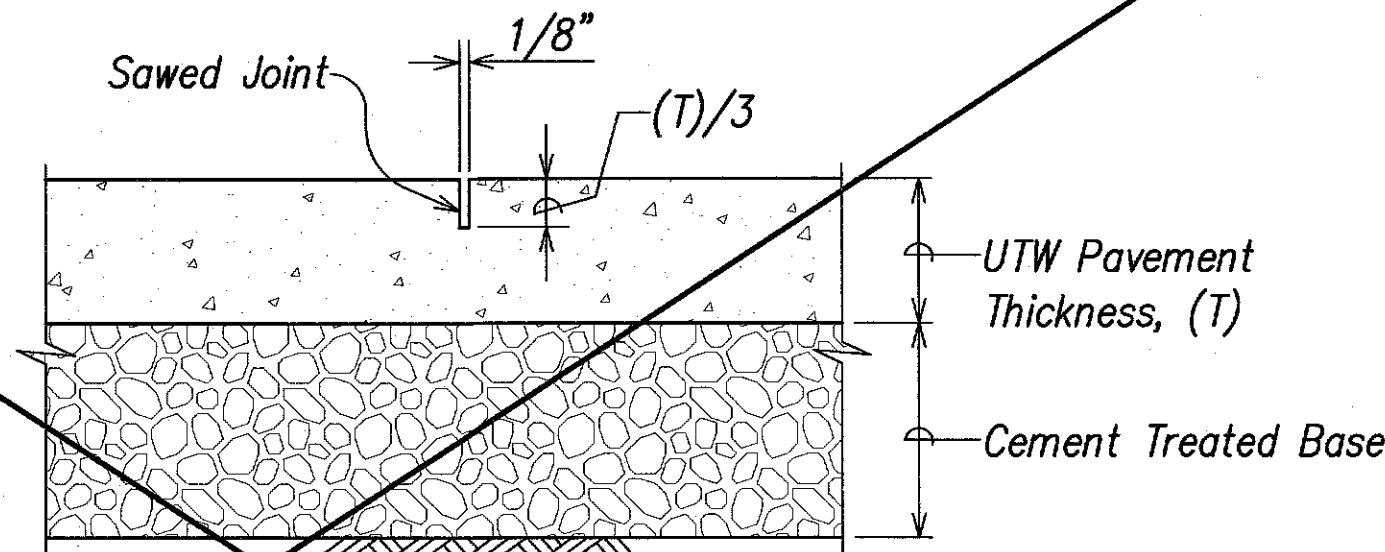

**TRANSVERSE OR LONGITUDINAL CONTRACTION  
JOINT (WEAKENED PLANE JOINT)**

Not to Scale

4  
T16 T16

N.I.C.

**NOTES FOR U.T.W. PAVEMENT:**

1. In general, longitudinal joints shall be at and parallel to lane lines, and transverse joints shall be perpendicular to the longitudinal joints.
2. Typical joint spacing shall be 4 feet, except where noted, and for areas where pavement width transitions occur.
3. Width to length ratio shall range between 0.80 to 1 and 1.25 to 1, unless otherwise specified, based on typical length of 4 feet (typical spacing). UTW slabs with dimensions outside this range are considered irregular shaped blocks or panels.
4. Triangular shaped blocks or panels are not allowed without acceptance by the Engineer.
5. Provide shop drawings of proposed joint layout to Engineer for review and acceptance. UTW construction shall not begin until shop drawings are accepted by Engineer. Shop drawings shall show proposed jointing layout at areas with penetrations and objects within the UTW (manhole covers, pullboxes, valves, etc.), and at areas with irregular shaped panels. Vary size of blocks/panels formed by joints shall when needed to minimize irregular shapes and eliminate longitudinal joints in wheel path. This work shall not be paid for separately, but shall be considered incidental to the various contract items.
6. Longitudinal joints shall not be placed at the location of vehicle wheelpath travel.
7. Sawcuts for joints shall be 1/8" wide and depth shall be 1/3 of slab thickness.

| LEGEND FOR<br>AS-BUILT POSTINGS |                                     |
|---------------------------------|-------------------------------------|
|                                 | Squiggly line for as-built deletion |
|                                 | Double line for as-built deletion   |
| Roadway                         | Text for as-built posting           |



THIS WORK WAS PREPARED BY  
ME OR UNDER MY SUPERVISION  
Parker, Inc.  
dba PARK ENGINEERING  
LICENSE EXPIRES 4-30-16

STATE OF HAWAII  
DEPARTMENT OF TRANSPORTATION  
HIGHWAYS DIVISION

**U.T.W. PAVEMENT DETAILS**

KAUMUALI HIGHWAY WIDENING  
Vicinity of Anonui Street to Vicinity of Lihue Mill Bridge  
FEDERAL-AID PROJECT NO. NH-050-1(31)


Scale: As Noted Date: JAN. 2010

SHEET NO. T16 OF T18 SHEETS

|                   |      |
|-------------------|------|
| SURVEY PLOTTED BY | DATE |
| DRAWN BY          |      |
| DESIGNED BY       |      |
| QUANTITIES BY     |      |
| CHECKED BY        |      |
| ORIGINAL PLAN     |      |
| NOTE BOOK         |      |
| No.               |      |

"AS-BUILT"

| FED. ROAD DIST. NO. | STATE | FED. AID PROJ. NO. | FISCAL YEAR | SHEET NO. | TOTAL SHEETS |
|---------------------|-------|--------------------|-------------|-----------|--------------|
| HAWAII              | HAW.  | NH-050-1(31)       | 2009        | 26        | 452          |

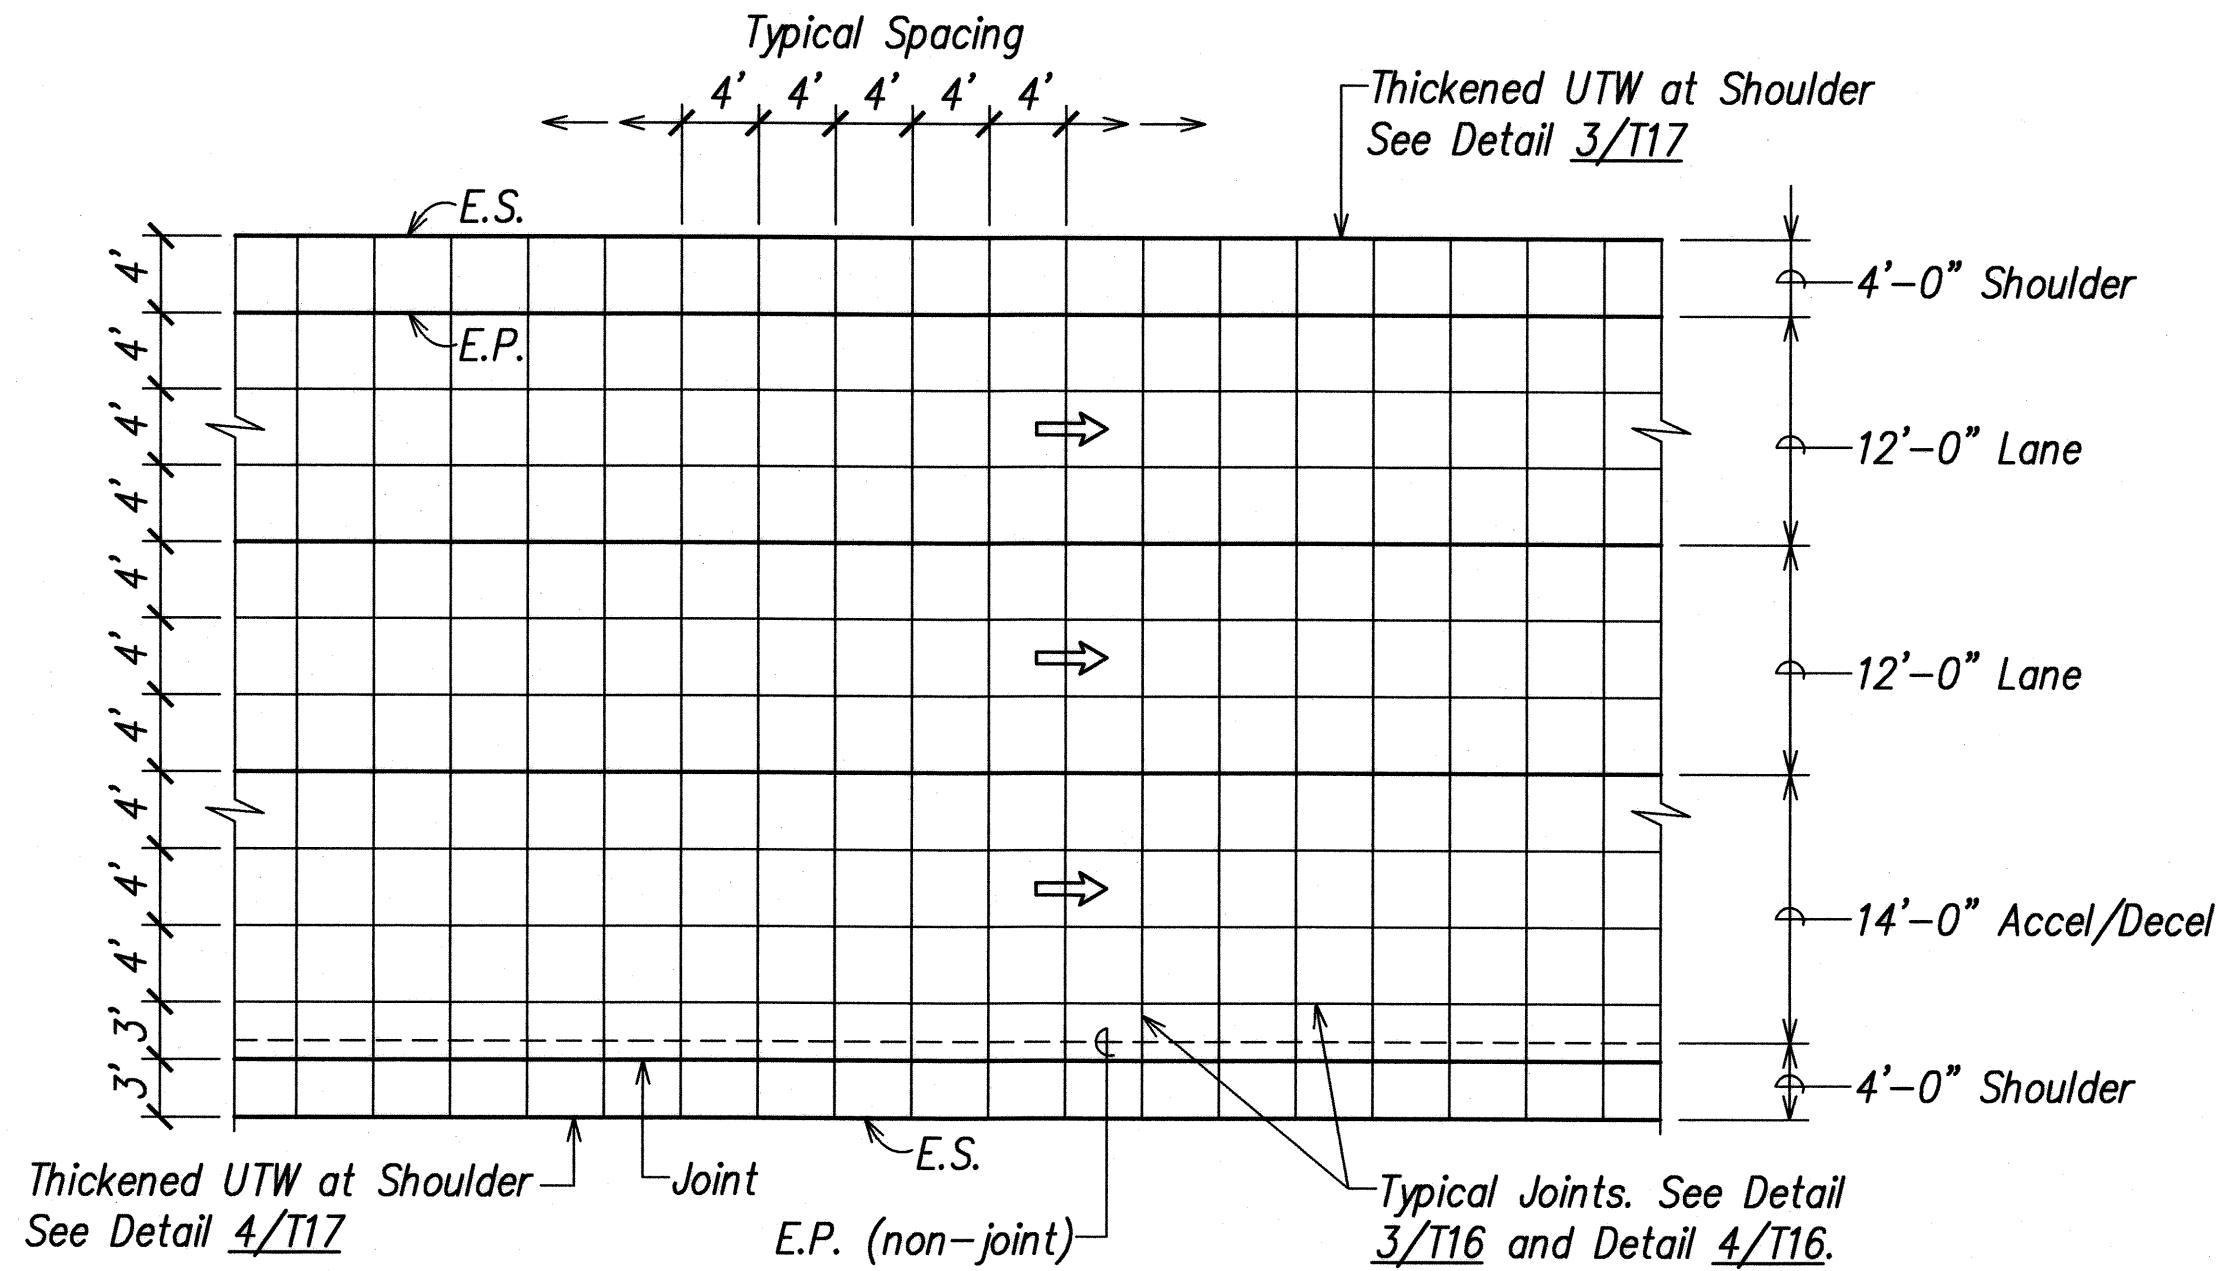


**TYPICAL U.T.W. PAVEMENT (NON-CURBED AREAS)**  
**JOINT LOCATION AND LAYOUT PLAN**

Scale: 1" = 10'

1  
T16

J1, J2

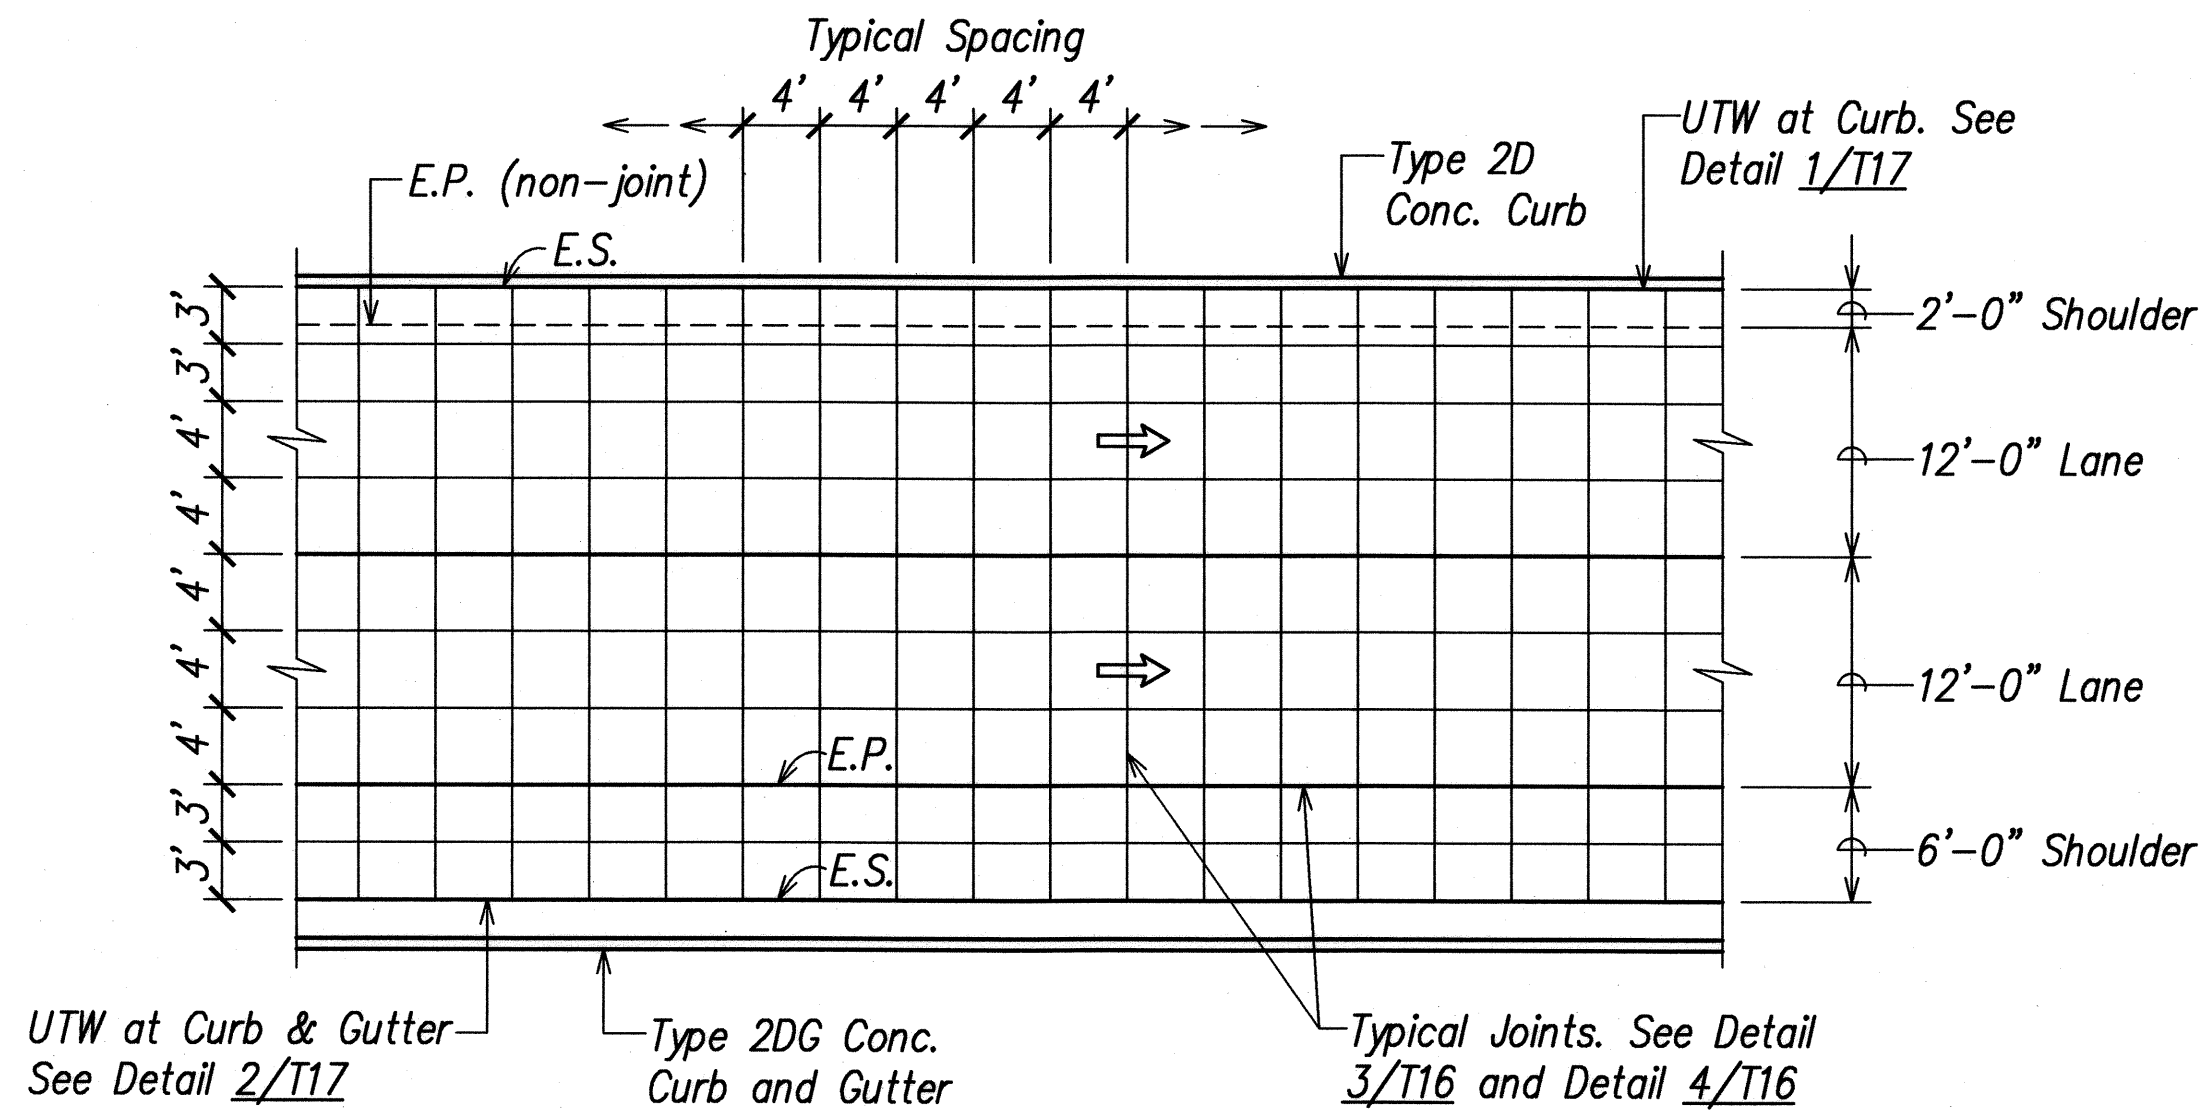


**TYPICAL U.T.W. PAVEMENT (CURBED AREAS)**  
**JOINT LOCATION AND LAYOUT PLAN**

Scale: 1" = 10'

2  
T16


J4, J5

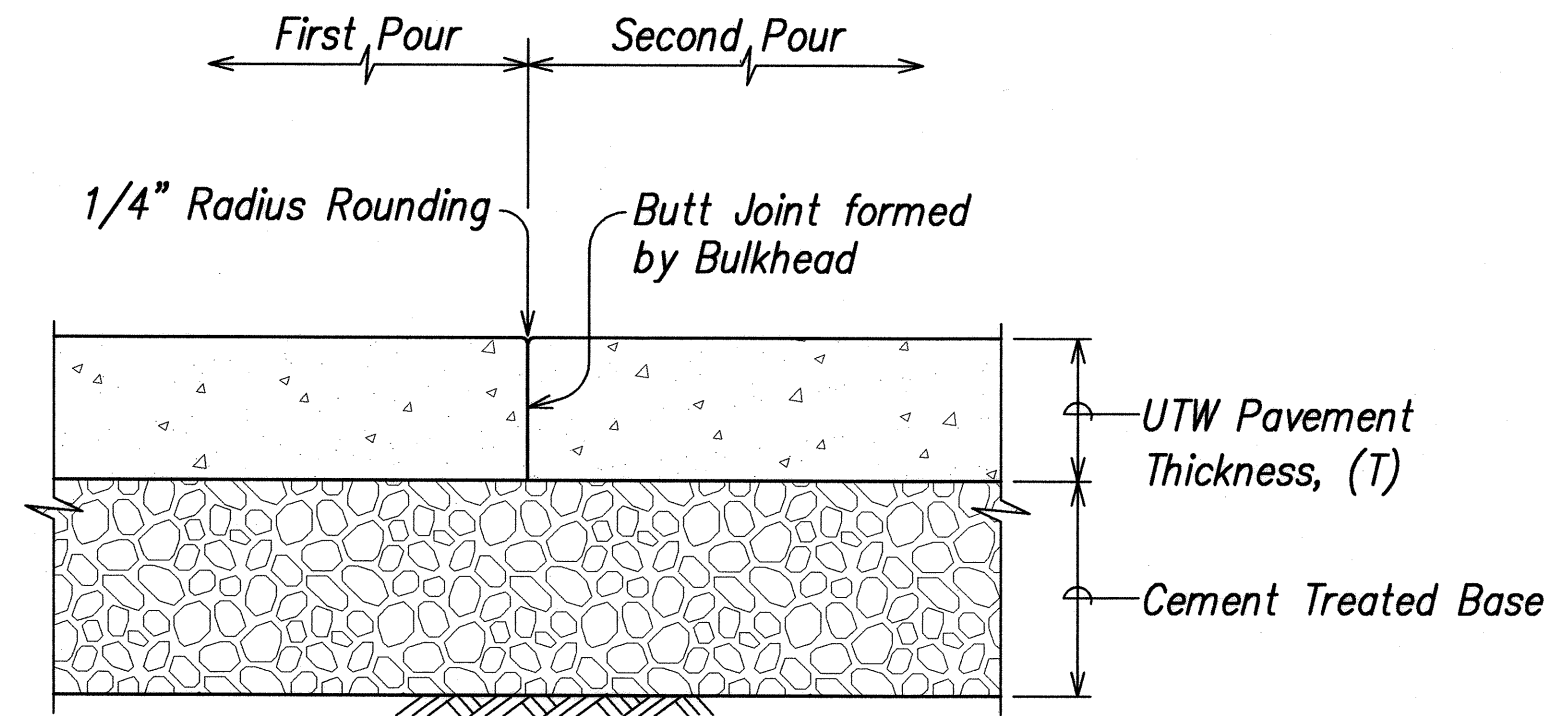

**TRANSVERSE OR LONGITUDINAL CONSTRUCTION JOINT (CONTACT JOINT)**

Not to Scale

3  
T16 T16

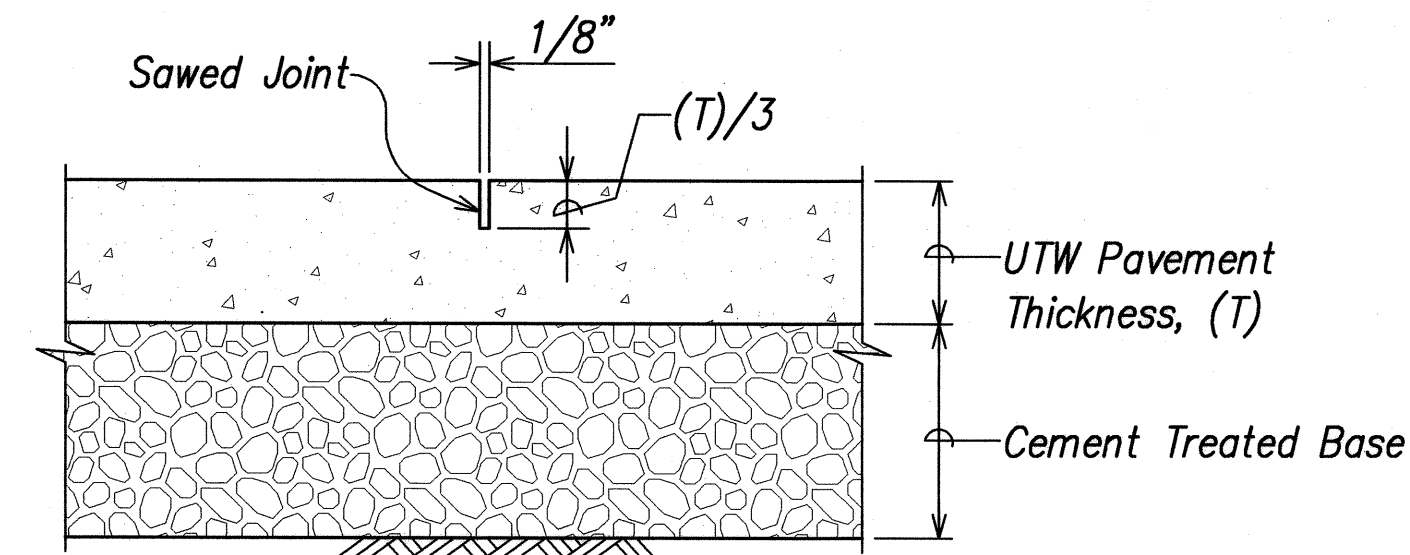

**TRANSVERSE OR LONGITUDINAL CONTRACTION JOINT (WEAKENED PLANE JOINT)**

Not to Scale

4  
T16 T16

**NOTES FOR U.T.W. PAVEMENT:**

1. In general, longitudinal joints shall be at and parallel to lane lines, and transverse joints shall be perpendicular to the longitudinal joints.
2. Typical joint spacing shall be 4 feet, except where noted, and for areas where pavement width transitions occur.
3. Width to length ratio shall range between 0.80 to 1 and 1.25 to 1, unless otherwise specified, based on typical length of 4 feet (typical spacing). UTW slabs with dimensions outside this range are considered irregular shaped blocks or panels.
4. Triangular shaped blocks or panels are not allowed without acceptance by the Engineer.
5. Provide shop drawings of proposed joint layout to Engineer for review and acceptance. UTW construction shall not begin until shop drawings are accepted by Engineer. Shop drawings shall show proposed jointing layout at areas with penetrations and objects within the UTW (manhole covers, pullboxes, valves, etc.), and at areas with irregular shaped panels. Vary size of blocks/panels formed by joints shall when needed to minimize irregular shapes and eliminate longitudinal joints in wheel path. This work shall not be paid for separately, but shall be considered incidental to the various contract items.
6. Longitudinal joints shall not be placed at the location of vehicle wheelpath travel.
7. Sawcuts for joints shall be 1/8" wide and depth shall be 1/3 of slab thickness.

|                   |      |
|-------------------|------|
| SURVEY PLOTTED BY | DATE |
| DRAWN BY          |      |
| DESIGNED BY       |      |
| QUANTITIES BY     |      |
| CHECKED BY        |      |

LIBS STATE DOT\HAWAII\PROJECTS\REVISIONS\KAWAII\T16-UTW\T16.dwg 2/06/09



THIS WORK WAS PREPARED BY  
ME OR UNDER MY SUPERVISION  
*Glenn K. Ikeda*  
P.E., Inc.  
dba PARK ENGINEERING  
LICENSE EXPIRES 4-30-10

STATE OF HAWAII  
DEPARTMENT OF TRANSPORTATION  
HIGHWAYS DIVISION


**U.T.W. PAVEMENT DETAILS**

KAUMUALII HIGHWAY WIDENING  
Vicinity of Anonui Street to Vicinity of Lihue Mill Bridge  
FEDERAL-AID PROJECT NO. NH-050-1(31)

Scale: As Noted Date: FEB. 2009


SHEET No. T16 OF T18 SHEETS

| FED. ROAD DIST. NO. | STATE | FED. AID PROJ. NO. | FISCAL YEAR | SHEET NO. | TOTAL SHEETS |
|---------------------|-------|--------------------|-------------|-----------|--------------|
| HAWAII              | HAW.  | NH-050-1(31)       | 2009        | 27        | 452          |

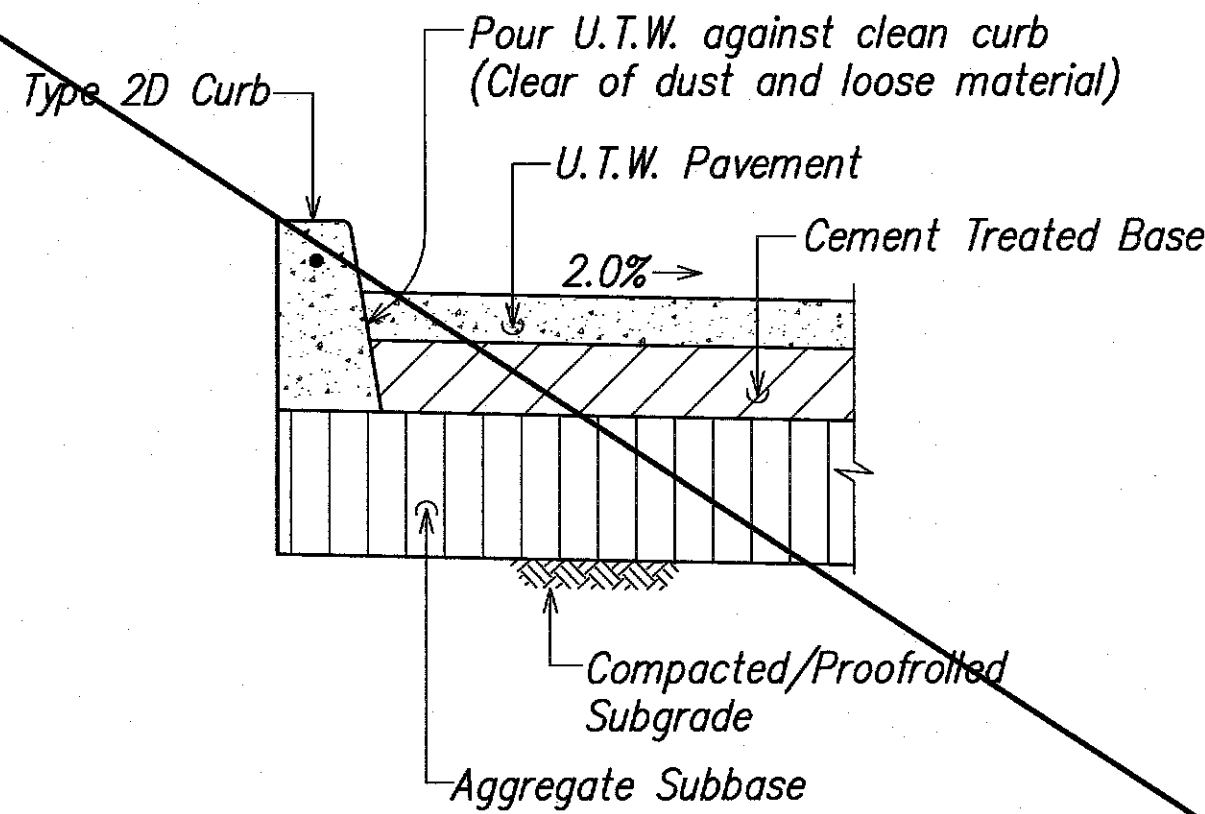


U.T.W. PAVEMENT AT CURB DETAIL  
Scale: 3/4" = 1'-0"

1  
T16 T17

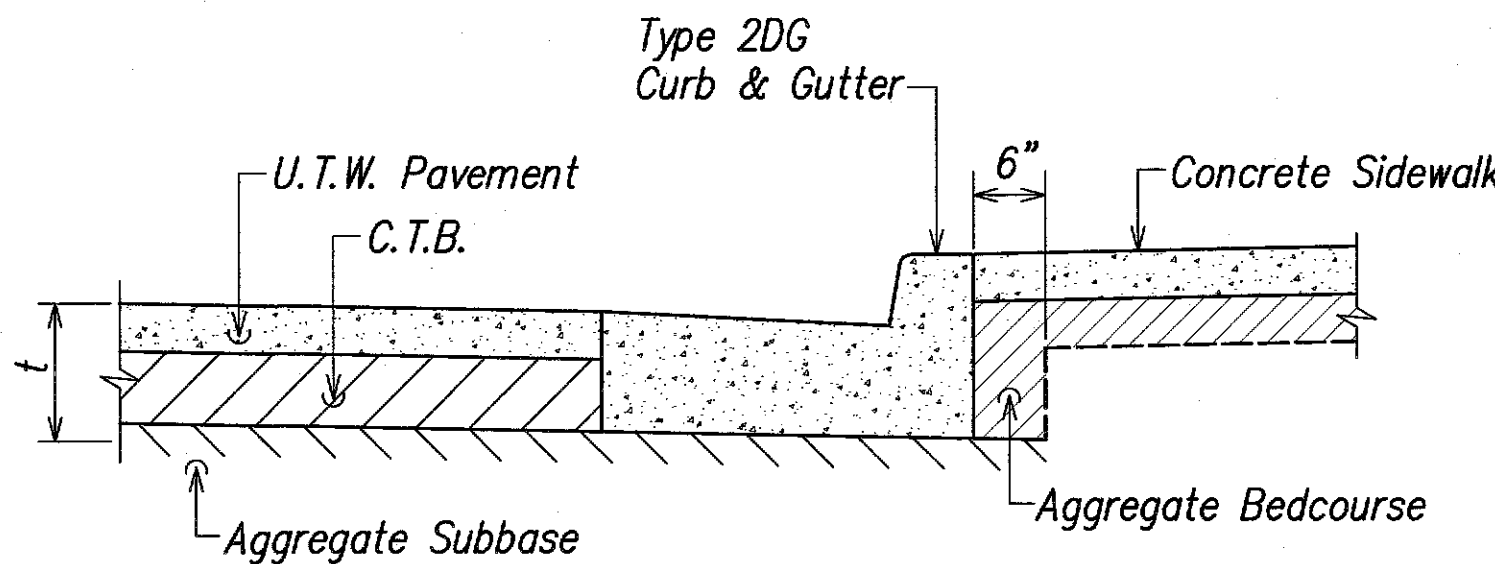


U.T.W. PAVEMENT AT CURB & GUTTER DETAIL  
Scale: 3/4" = 1'-0"

2  
T16 T17

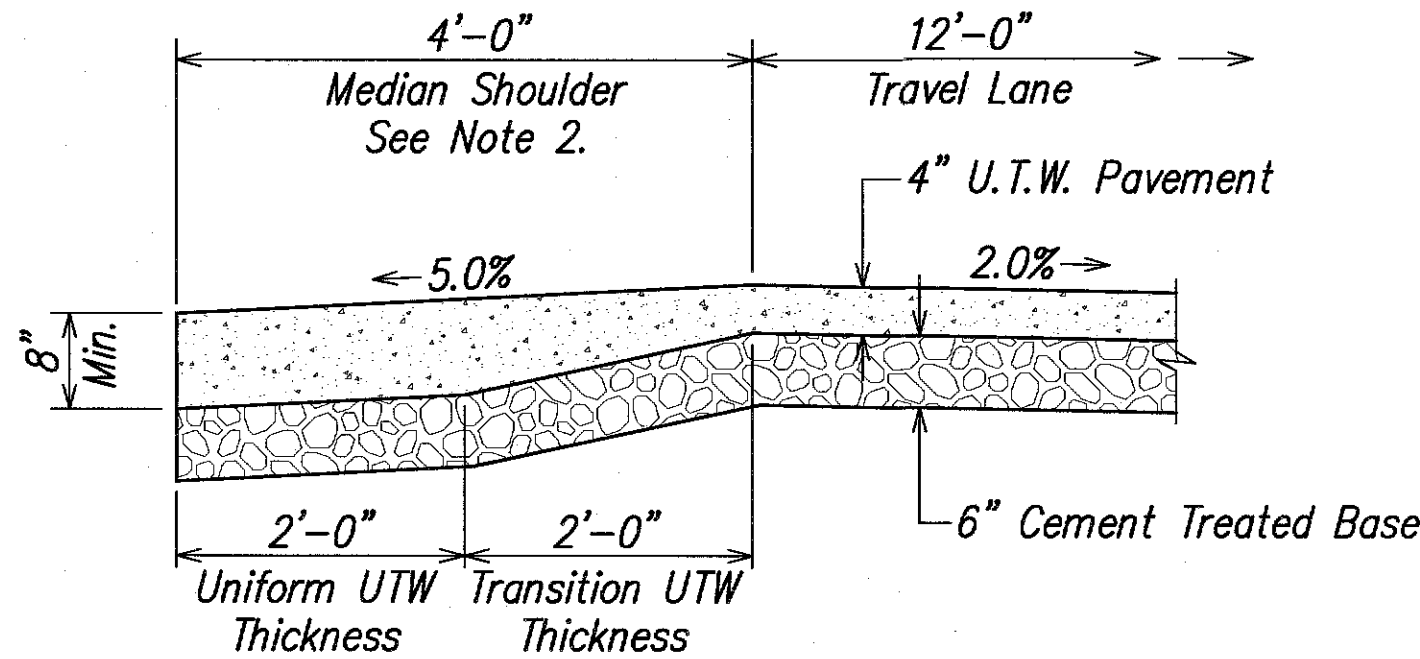


THICKENED U.T.W. AT EDGE OF MEDIAN SHOULDER  
Scale: 3/4" = 1'-0"

3  
T16 T17

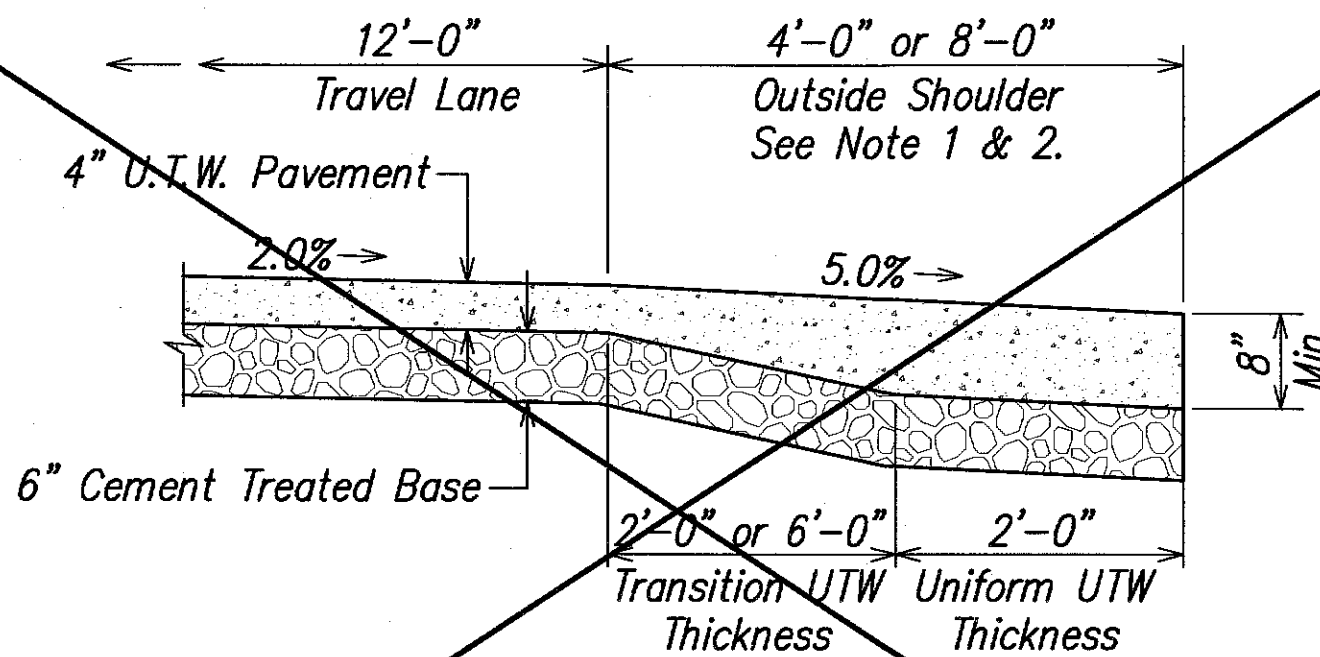

THICKENED U.T.W. AT EDGE OF OUTSIDE SHOULDER  
Scale: 3/4" = 1'-0"

4  
T16 T17

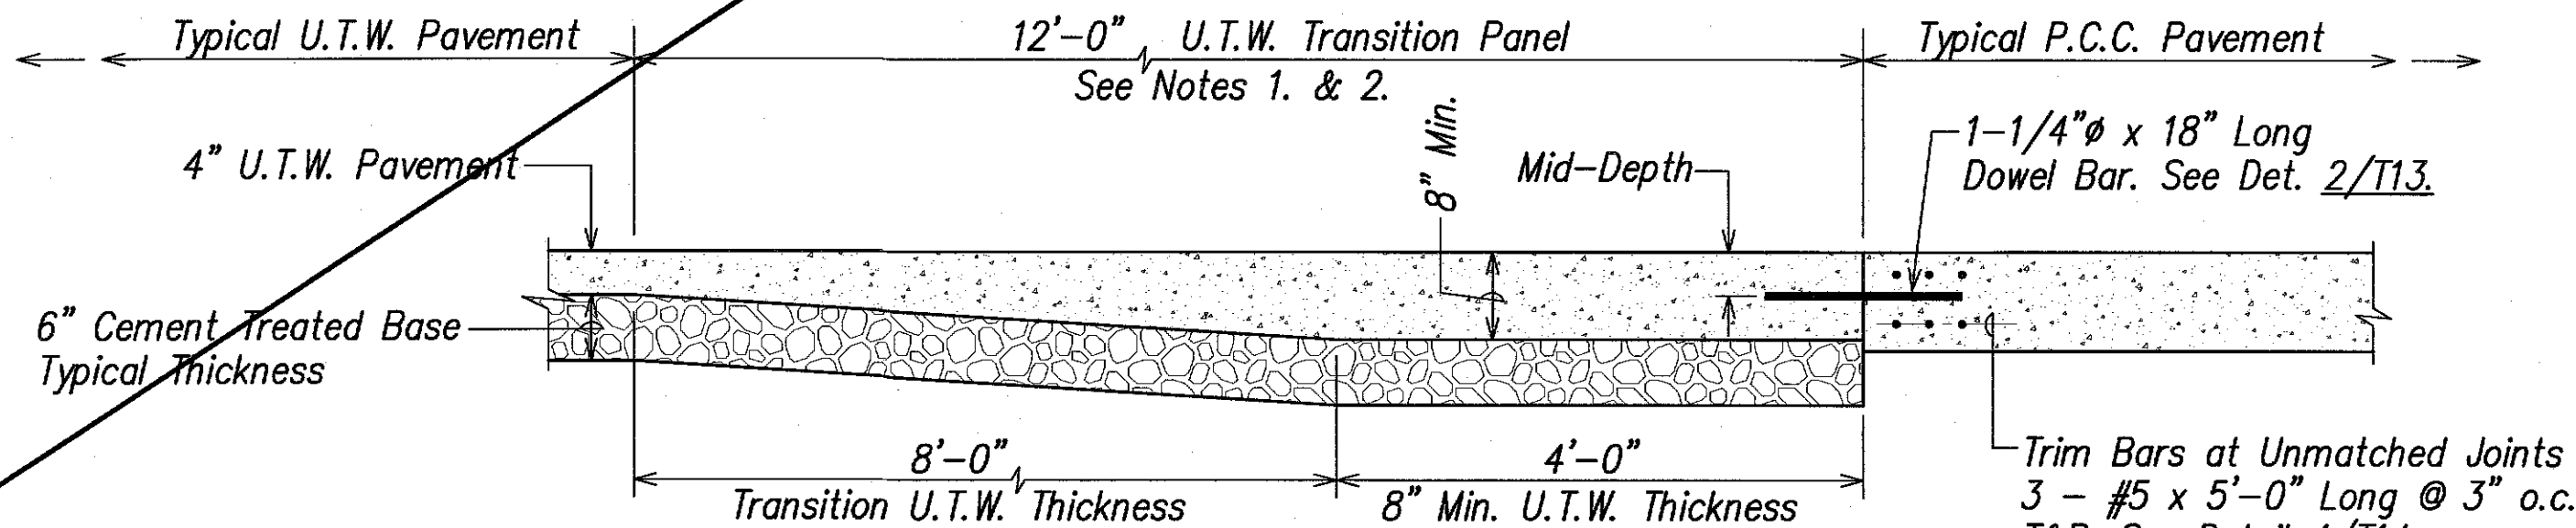

TYPICAL U.T.W. PAVEMENT TO P.C.C. PAVEMENT TRANSITION PANEL DETAIL  
Scale: 3/4" = 1'-0"

5  
T17

**Notes:**

1. Sawcut 1/8" wide joints at 4' interval, transversely and longitudinally, depth to 1/3 slab thickness.
2. Thickened edge at shoulders and thickening of UTW slab within transition panel shall be considered incidental to Item No. 418.0040 - Ultra-Thin Whitetopping.

|                   |      |
|-------------------|------|
| SURVEY PLOTTED BY | DATE |
| DRAWN BY          |      |
| DESIGNED BY       |      |
| QUANTITIES BY     |      |
| CHECKED BY        |      |
| ORIGINAL PLAN     |      |
| NOTE BOOK         |      |
| NO.               |      |

| LEGEND FOR AS-BUILT POSTINGS |                                     |
|------------------------------|-------------------------------------|
|                              | Squiggly line for as-built deletion |
|                              | Double line for as-built deletion   |
| Roadway                      | Text for as-built posting           |




THIS WORK WAS PREPARED BY ME OR UNDER MY SUPERVISION  
PARK, INC.  
dba PARK ENGINEERING  
LICENSE EXPIRES 4-30-16


|  |
|--|
| STATE OF HAWAII<br>DEPARTMENT OF TRANSPORTATION<br>HIGHWAYS DIVISION   |
| <b>U.T.W. PAVEMENT DETAILS</b>   |
| KAUMUALI HIGHWAY WIDENING<br>Vicinity of Anonui Street to Vicinity of Lihue Mill Bridge<br>FEDERAL-AID PROJECT NO. NH-050-1(31)<br>Scale: As Noted Date: JAN. 2010 |

"AS-BUILT"


| FED. ROAD DIST. NO. | STATE | FED. AID PROJ. NO. | FISCAL YEAR | SHEET NO. | TOTAL SHEETS |
|---------------------|-------|--------------------|-------------|-----------|--------------|
| HAWAII              | HAW.  | NH-050-1(31)       | 2009        | 27        | 452          |

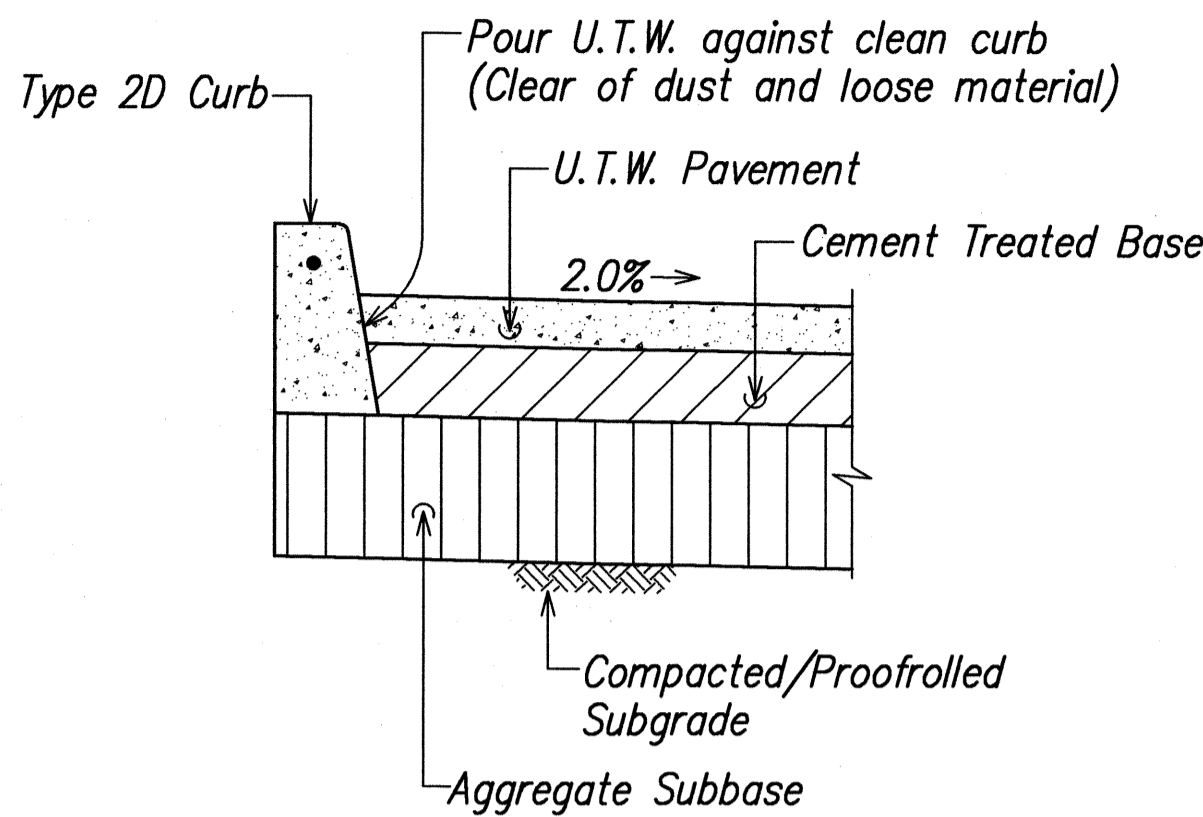


U.T.W. PAVEMENT AT CURB DETAIL  
Scale: 3/4" = 1'-0" 1  
T16 T17

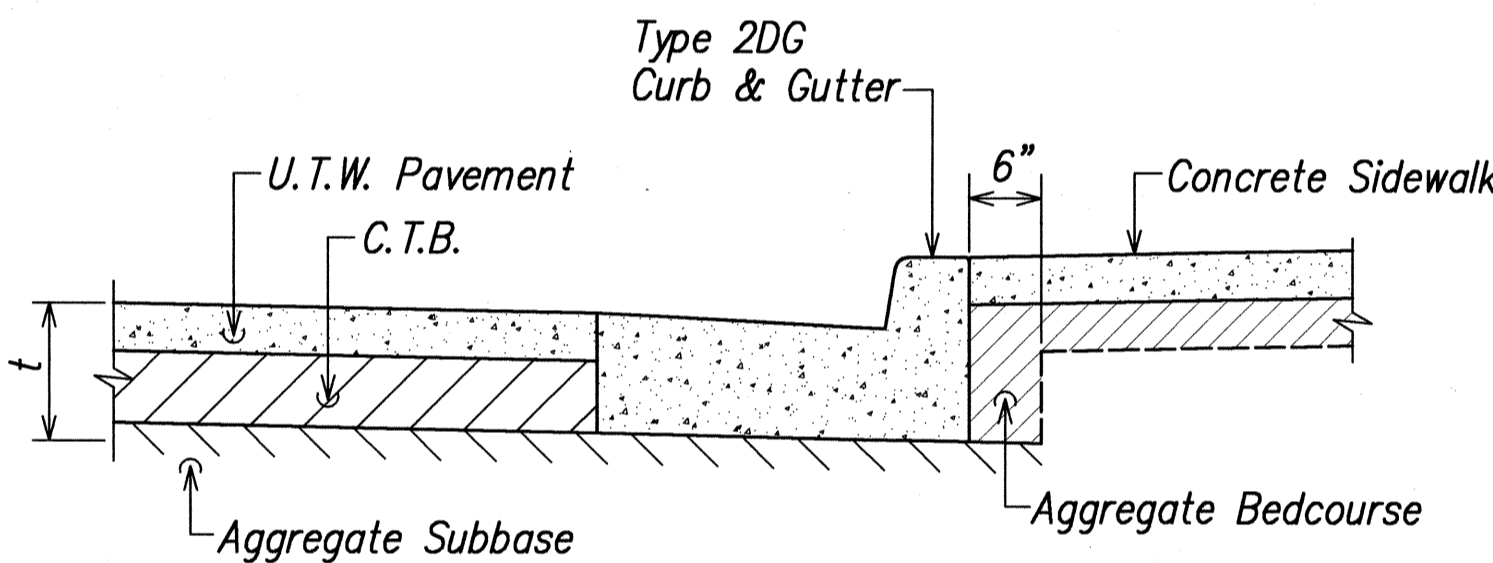


U.T.W. PAVEMENT AT CURB & GUTTER DETAIL  
Scale: 3/4" = 1'-0" 2  
T16 T17

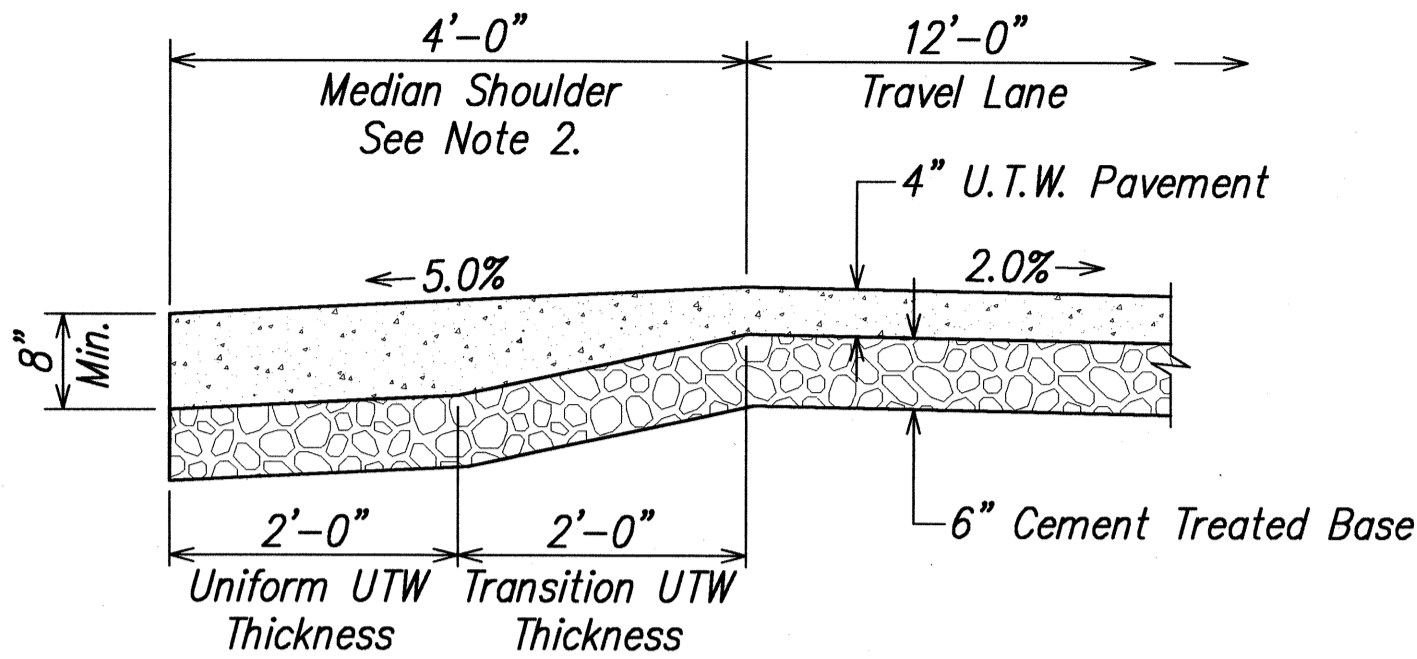

THICKENED U.T.W. AT EDGE OF MEDIAN SHOULDER  
Scale: 3/4" = 1'-0" 3  
T16 T17

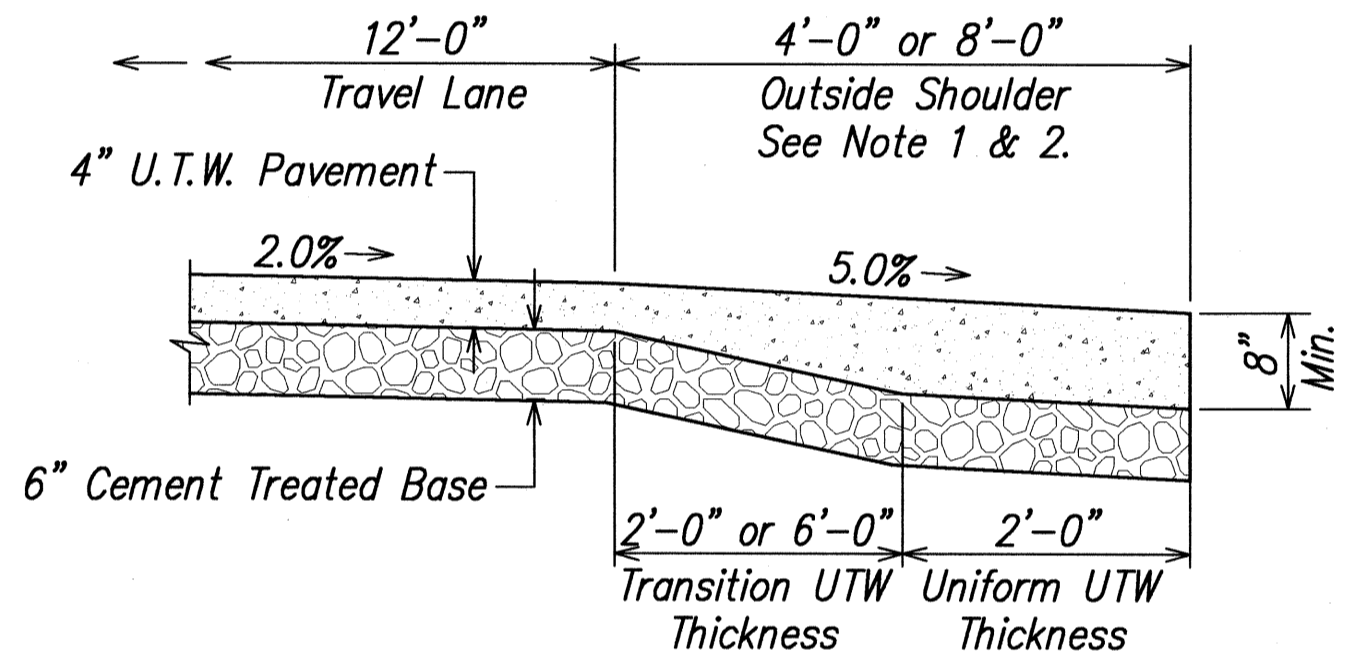

THICKENED U.T.W. AT EDGE OF OUTSIDE SHOULDER  
Scale: 3/4" = 1'-0" 4  
T16 T17

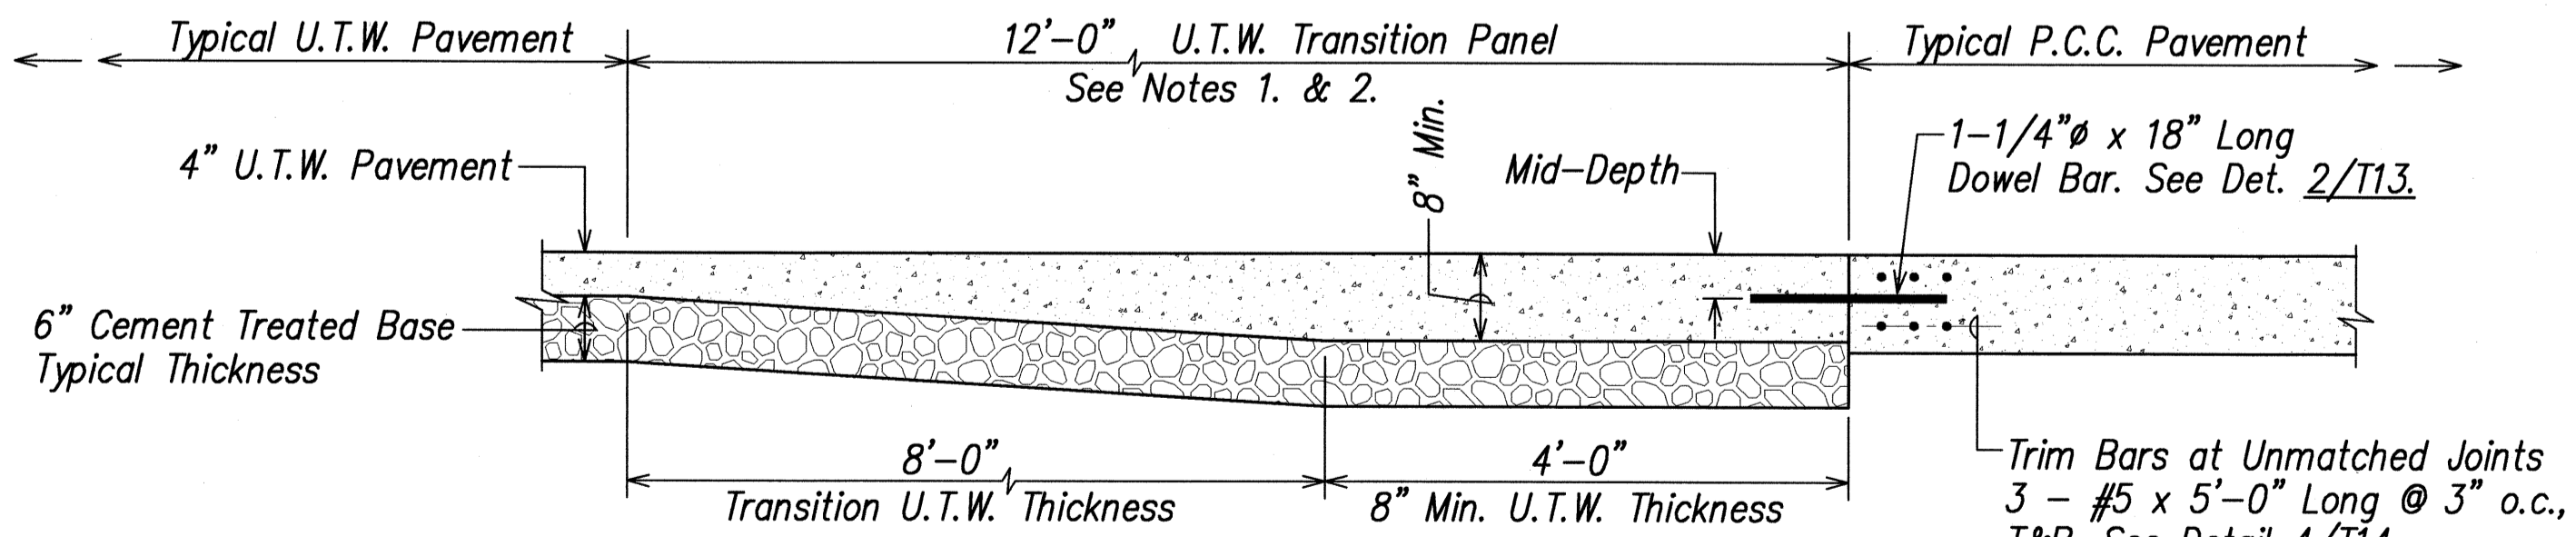

ELEVATION

TYPICAL U.T.W. PAVEMENT TO P.C.C. PAVEMENT TRANSITION PANEL DETAIL  
Scale: 3/4" = 1'-0" 5  
J1, J2, J4, J5 T17

Notes:

1. Sawcut 1/8" wide joints at 4' interval, transversely and longitudinally, depth to 1/3 slab thickness.
2. Thickened edge at shoulders and thickening of UTW slab within transition panel shall be considered incidental to Item No. 418.0040 - Ultra-Thin Whitetopping.



THIS WORK WAS PREPARED BY ME OR UNDER MY SUPERVISION  
Glenn K. Ikeda  
2-26-09  
P&E, Inc.  
dba PARK ENGINEERING  
LICENSE EXPIRES 4-30-10

STATE OF HAWAII  
DEPARTMENT OF TRANSPORTATION  
HIGHWAYS DIVISION

### U.T.W. PAVEMENT DETAILS

KAUMUALII HIGHWAY WIDENING  
Vicinity of Anonui Street to Vicinity of Lihue Mill Bridge  
FEDERAL-AID PROJECT NO. NH-050-1(31)


Scale: As Noted  
SHEET No. T17 OF T18 SHEETS

Date: FEB. 2009


|                   |      |
|-------------------|------|
| SURVEY PLOTTED BY | DATE |
| DRAWN BY          |      |
| DESIGNED BY       |      |
| QUANTITIES BY     |      |
| CHECKED BY        |      |
| ORIGINAL PLAN     |      |
| NOTE BOOK         |      |
| No.               |      |

LIB: STATE DOT\KAUMUALII HIGHWAY WIDENING\T17-UTWDETAIL.dwg 2/26/09


| FED. ROAD DIST. NO. | STATE | FED. AID PROJ. NO. | FISCAL YEAR | SHEET NO. | TOTAL SHEETS |
|---------------------|-------|--------------------|-------------|-----------|--------------|
| HAWAII              | HAW.  | NH-050-1(31)       | 2009        | 28        | 452          |

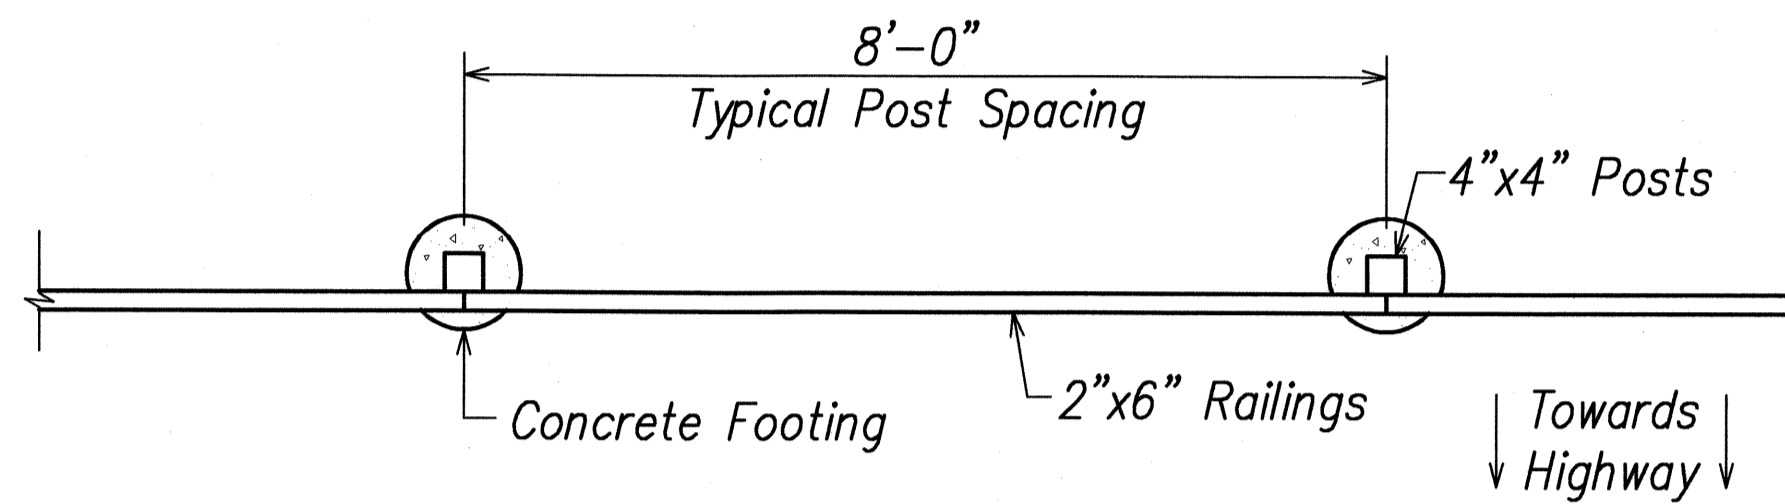


**PLAN**  
Scale: 1"=5'

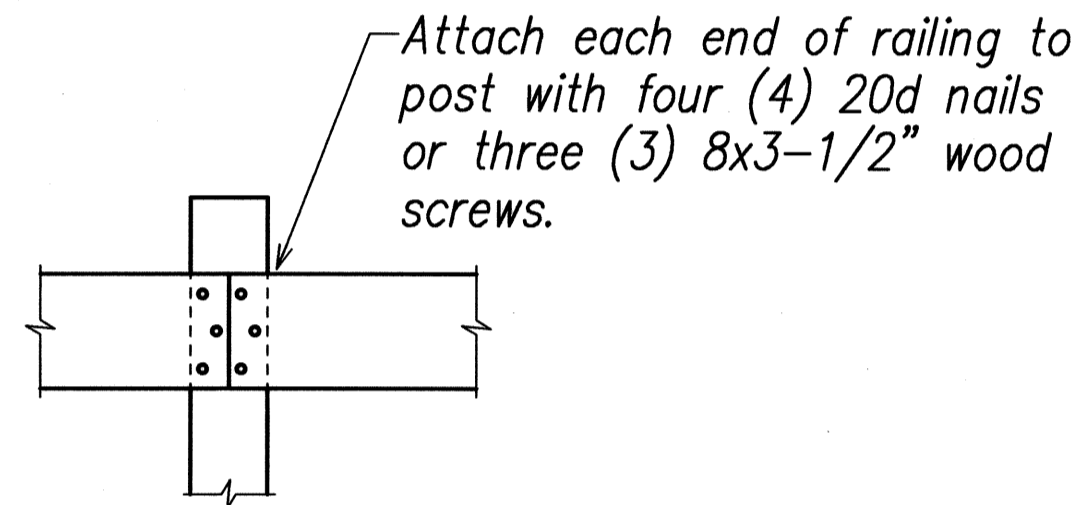

**CONNECTION DETAIL**

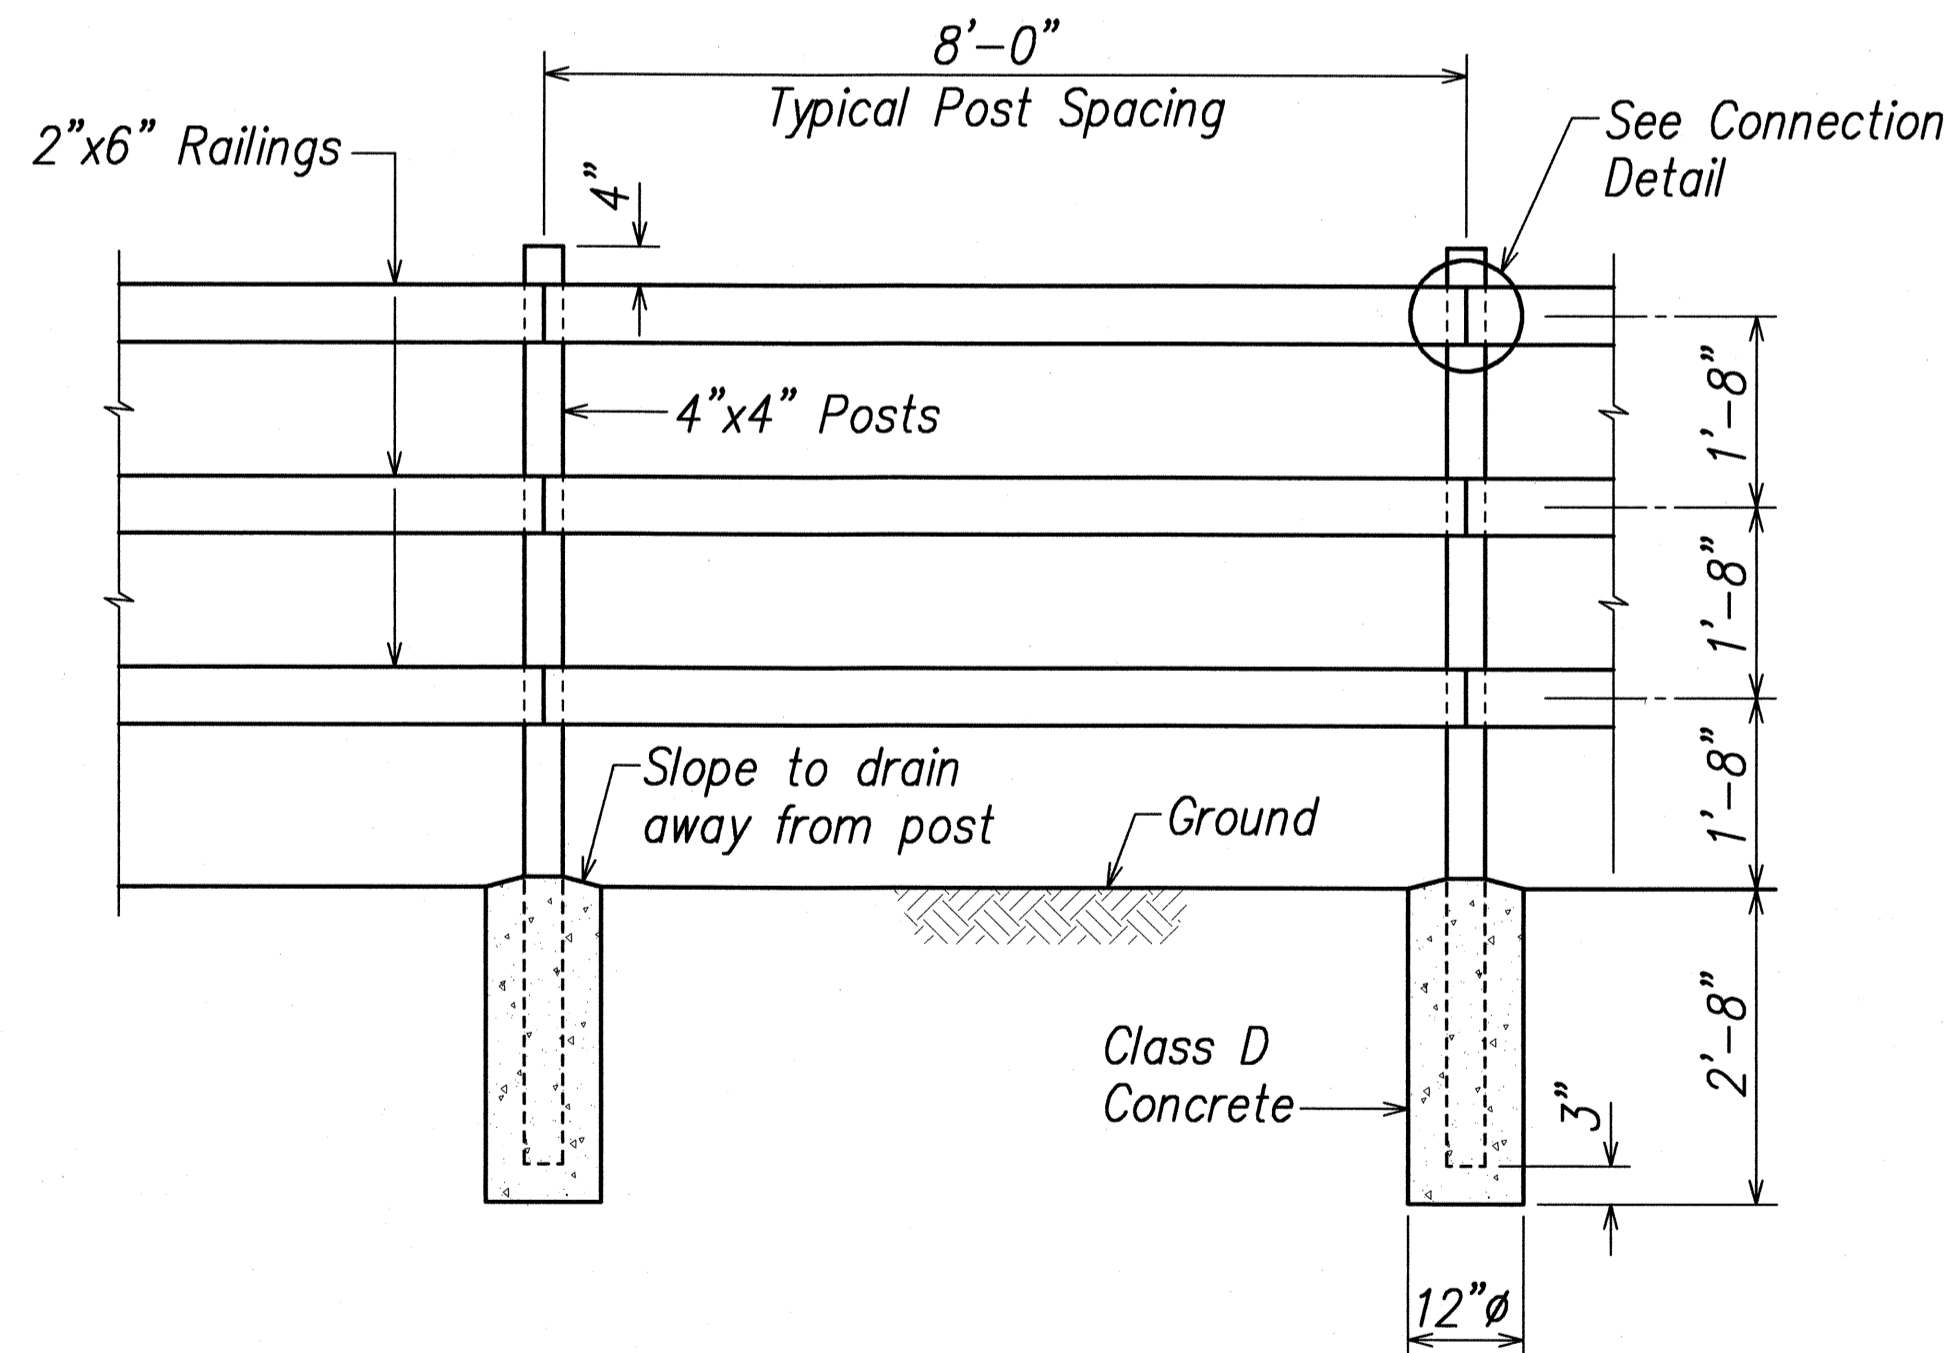

**ELEVATION**  
Scale: 1"=5'

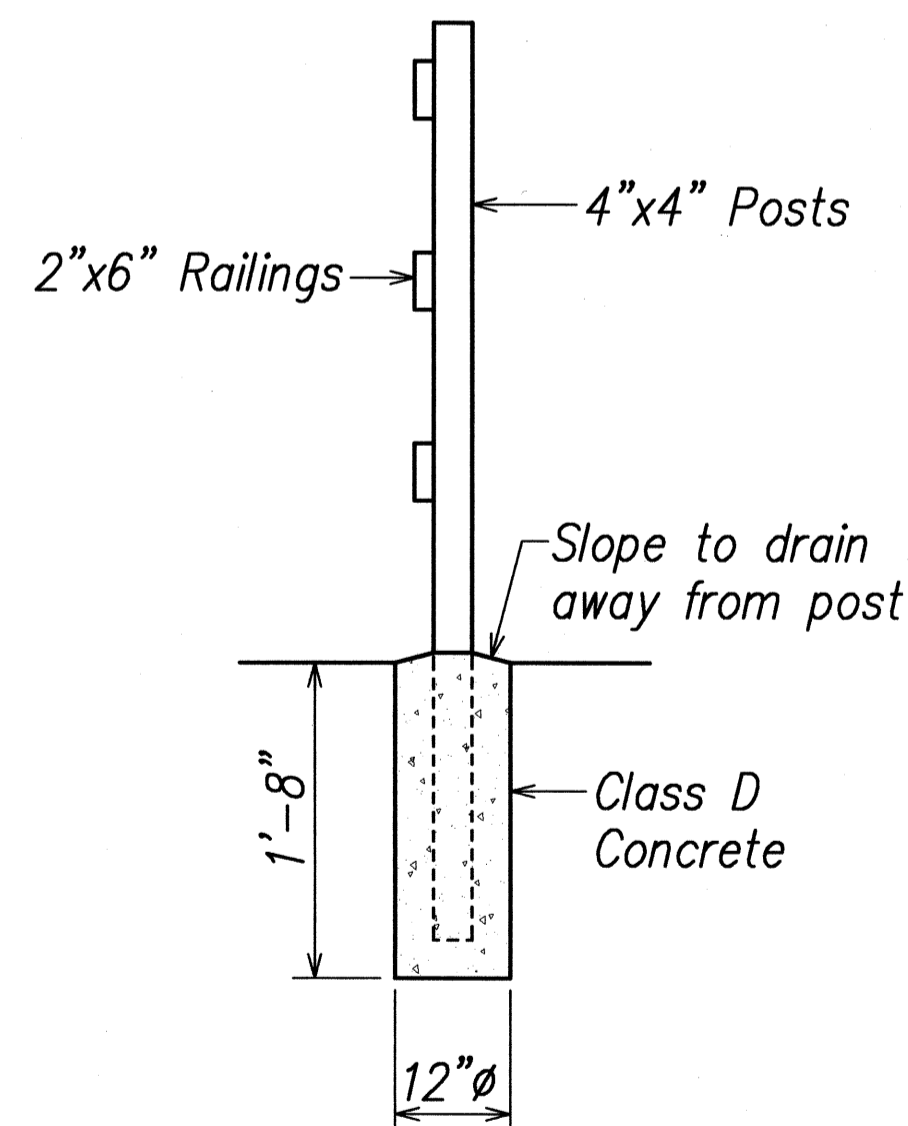

**SECTION**  
Scale: 1"=5'




**Wood Fence Notes:**

1. All nails and connectors shall be galvanized.
2. All wood posts and board railings shall be pressure-treated lumber.
3. After wood fence is erected, paint all exposed surfaces with exterior paint, white in color.

**WOOD POST & BOARD FENCE  
(VICINITY OF KILOHANA)**

Not to Scale

C1 to C4, C6, C9, C10

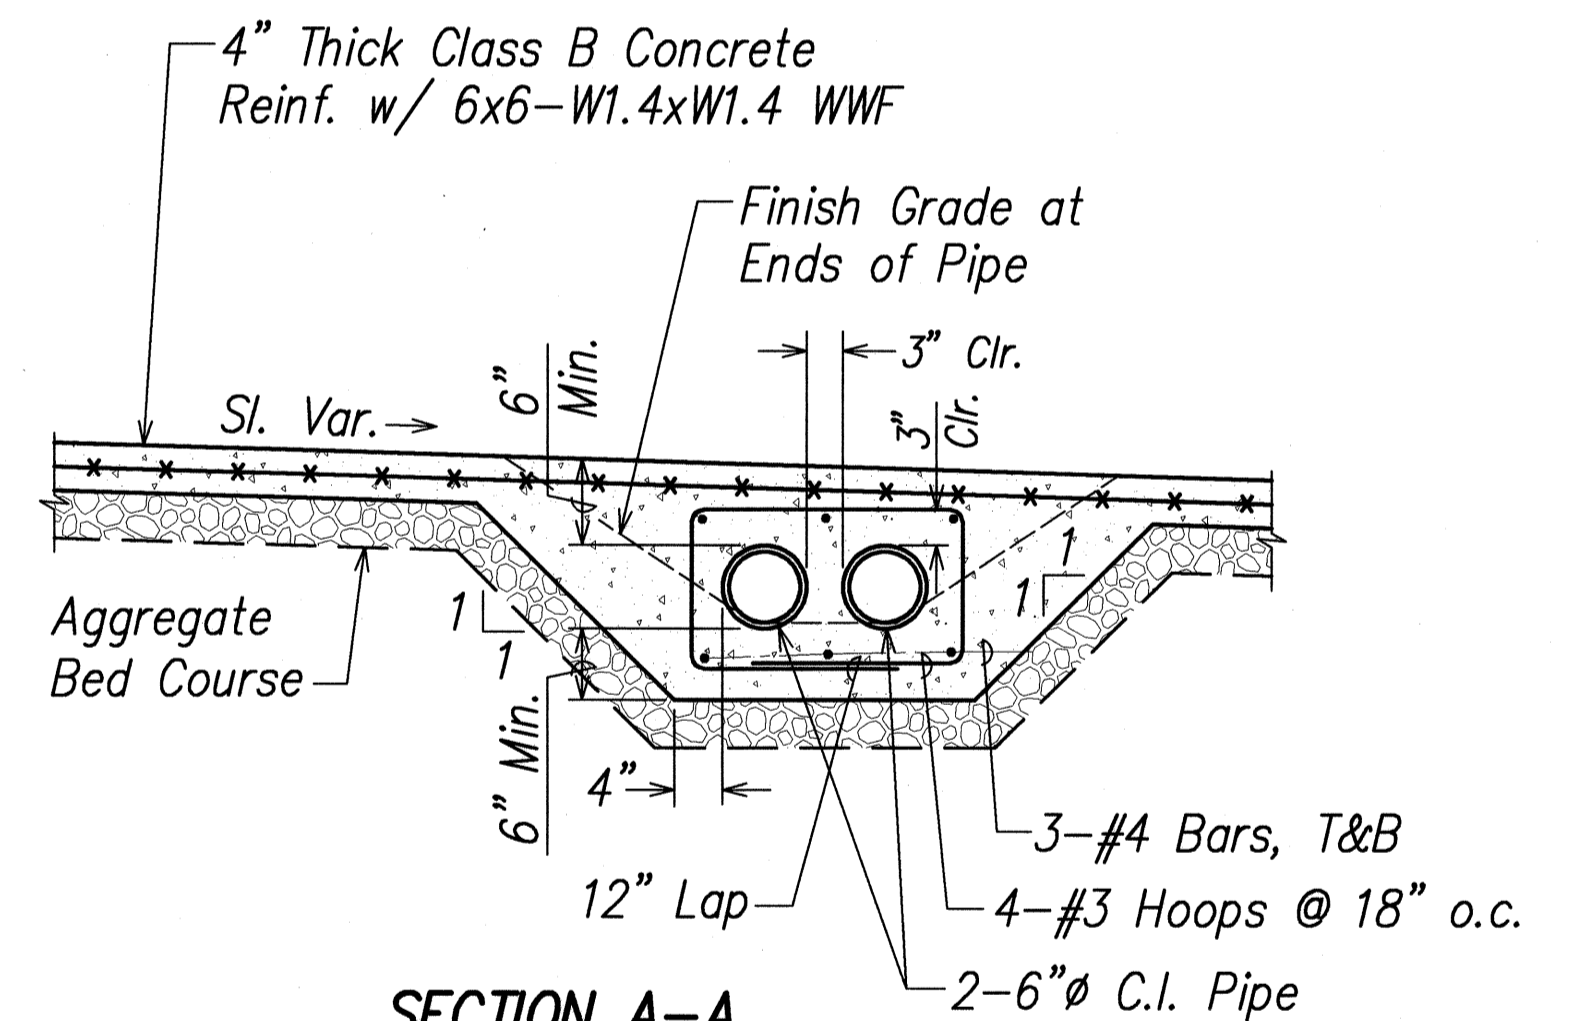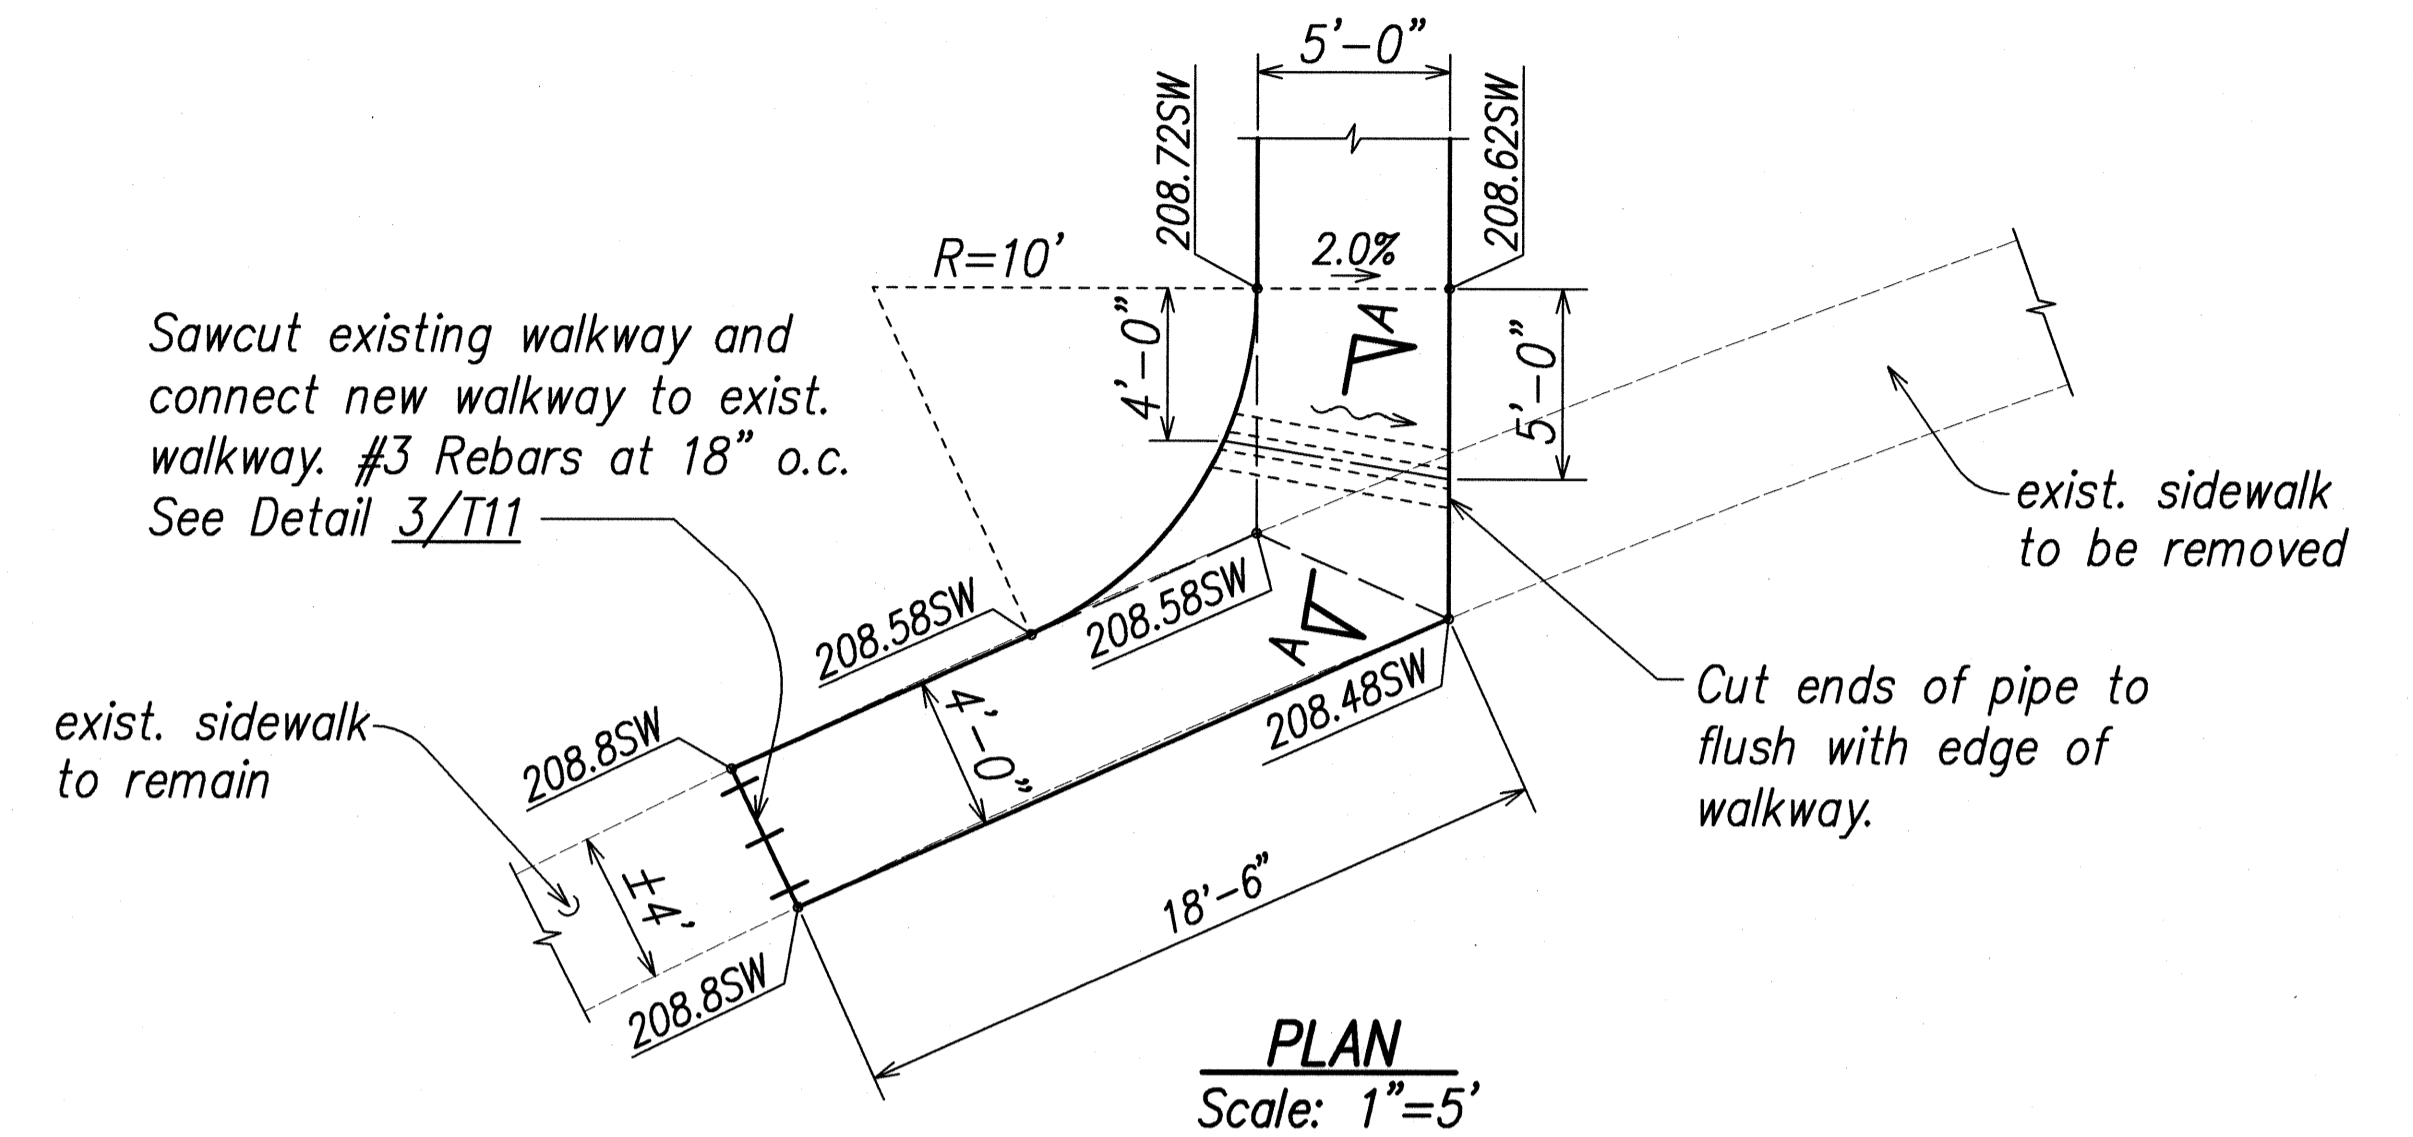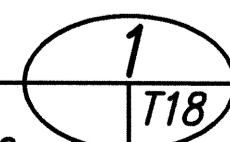

**SECTION A-A**  
Scale: 3/4"=1'-0"

**PIPES UNDER SIDEWALK  
(VICINITY OF HALA ROAD)**  
Scale As Noted



2-26-09  
THIS WORK WAS PREPARED BY  
ME OR UNDER MY SUPERVISION  
*Glenn K. Ikeda*  
PARE, INC.  
480 PARK ENGINEERING  
LICENSE EXPIRES 4-30-10

STATE OF HAWAII  
DEPARTMENT OF TRANSPORTATION  
HIGHWAYS DIVISION

**MISCELLANEOUS DETAILS**

KAUMUALII HIGHWAY WIDENING  
Vicinity of Anonui Street to Vicinity of Lihue Mill Bridge  
FEDERAL-AID PROJECT NO. NH-050-1(31)

Scale: As Noted

Date: FEB. 2009

SHEET NO. T18 OF T18 SHEETS