


FED. ROAD DIST. NO.	STATE	FED. AID PROJ. NO.	FISCAL YEAR	SHEET NO.	TOTAL SHEETS
HAWAII	HAW.	ARR-050-K036	FY13/14	50	50

Curve Data:

①	②	③
?=50°13'31"	?=31°29'38"	?=12°36'12"
?/2=25°06'45"	?/2=15°44'49"	?/2=06°18'06"
R=182.50'	R=137.50'	R=138.00'
T=85.54'	T=38.77'	T=15.24'
C=154.91'	C=74.63'	C=30.29'
Lc=159.98'	Lc=75.58'	Lc=30.29'

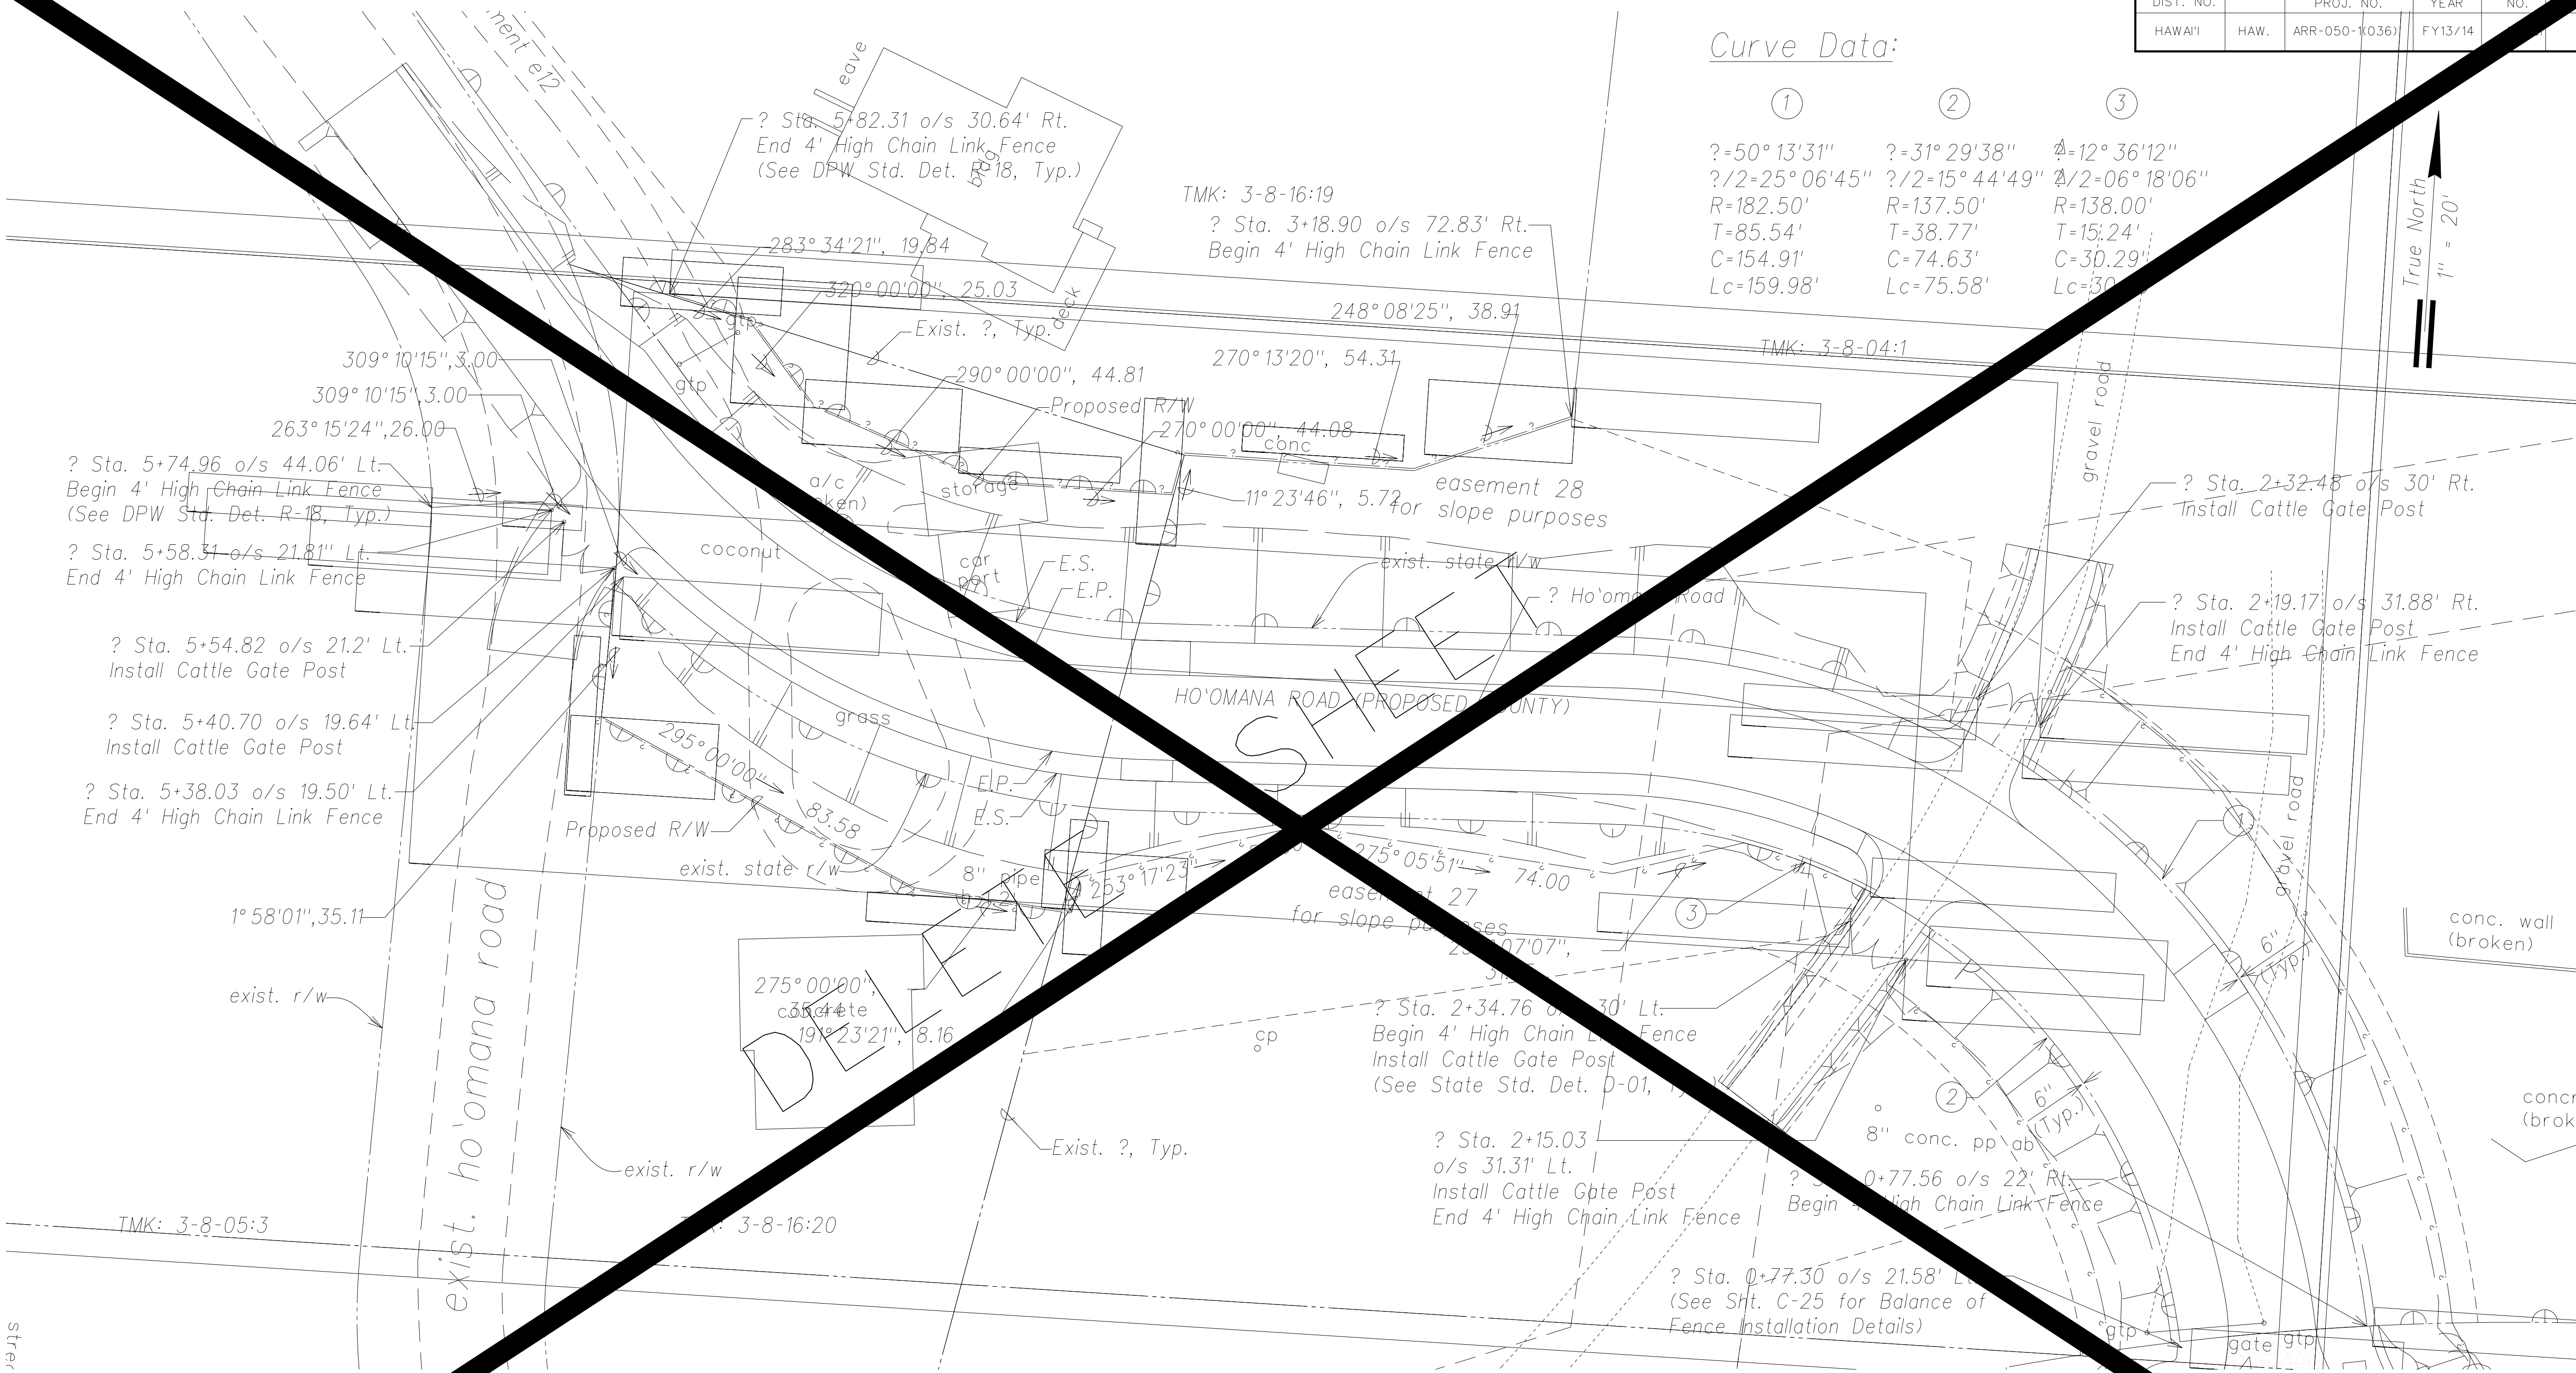


- Legend:
- Chain Link Fence (4' High)
 - Cattle Gate Post
 - Proposed R/W
 - Existing State R/W


Fence Plan
Scale: 1" = 20'

APPROVED BY:

COUNTY ENGINEER, DEPARTMENT OF PUBLIC WORKS

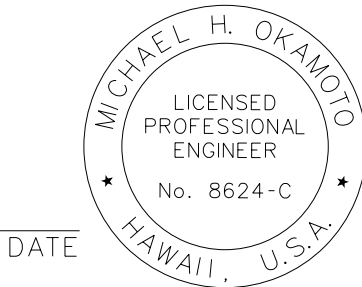

THIS WORK WAS PREPARED BY ME OR UNDER MY SUPERVISION AND CONSTRUCTION OF THIS PROJECT WILL BE UNDER MY OBSERVATION.

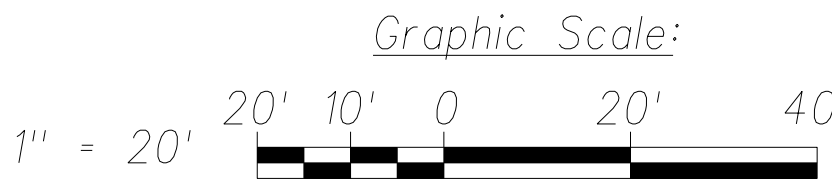

STATE OF HAWAII
DEPARTMENT OF TRANSPORTATION
HIGHWAYS DIVISION

FENCE PLAN

PHASE 1 - KAUMOA HIGHWAY
LIHU'E MILL BRIDGE TO THE STREET
PHASE 1 - HO'OMANA ROAD


Scale: As Shown Date: December 12, 2012
SHEET No. C-27 OF 50 SHEETS

SURVEY PLOTTED BY	DATE
DRAWN BY	
DESIGNED BY	
QUANTITIES BY	
CHECKED BY	
ORIGINAL PLAN	
NOTE BOOK	
No.	

"AS-BUILT"

Model

FED. ROAD DIST. NO.	STATE	FED. AID PROJ. NO.	FISCAL YEAR	SHEET NO.	TOTAL SHEETS
HAWAII	HAW.	ARR-050-K036	FY13/14	Model	50

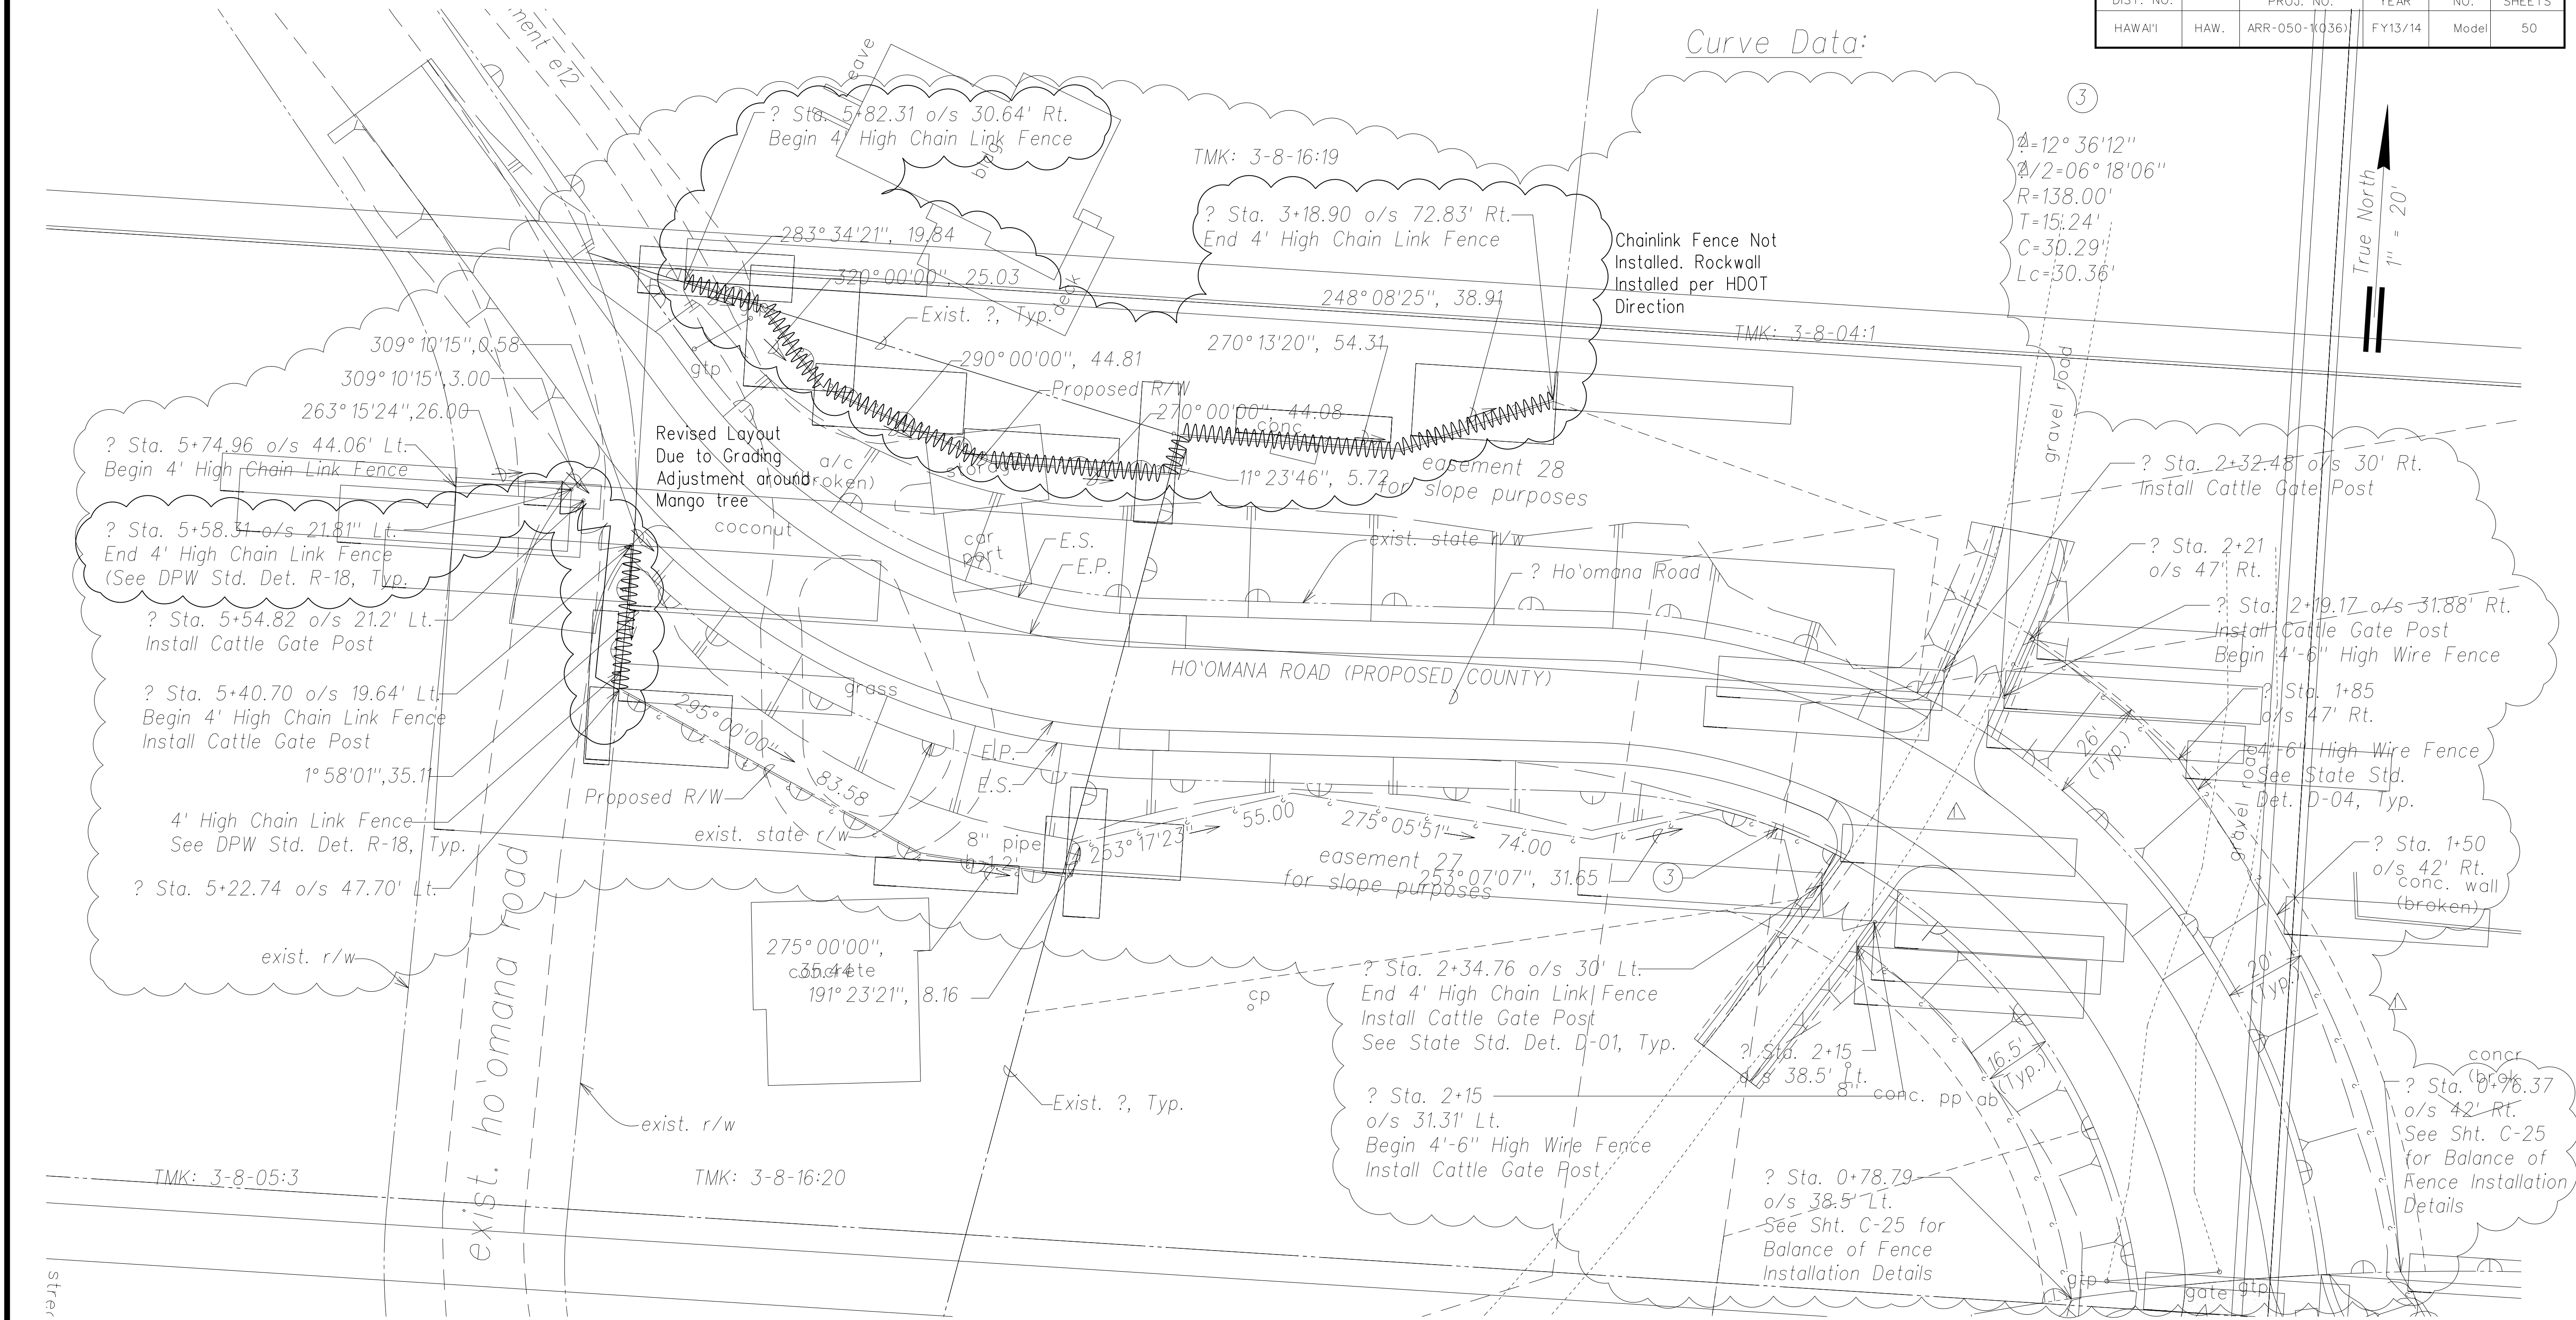

Curve Data:

③
Δ=12° 36' 12"
Δ/2=06° 18' 06"
R=138.00'
T=15.24'
C=30.29'
Lc=30.36'

True North
1" = 20'

Legend:

- 4' High Chain Link Fence or 4'-6" High Wire Fence
- Cattle Gate
- Proposed R/W
- Existing State R/W


LEGEND FOR AS-BUILT POSTINGS

- Squiggly line for as-built deletion
- Double line for as-built deletion
- Text for as-built posting


Fence Plan
Scale: 1" = 20'

APPROVED BY:

COUNTY ENGINEER, DEPARTMENT OF PUBLIC WORKS

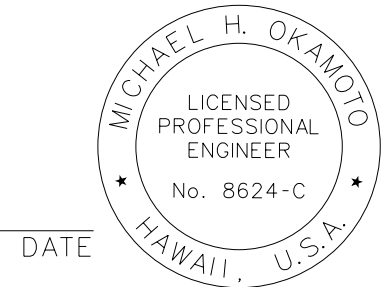

THIS WORK WAS PREPARED BY ME OR UNDER MY SUPERVISION AND CONSTRUCTION OF THIS PROJECT WILL BE UNDER MY OBSERVATION.

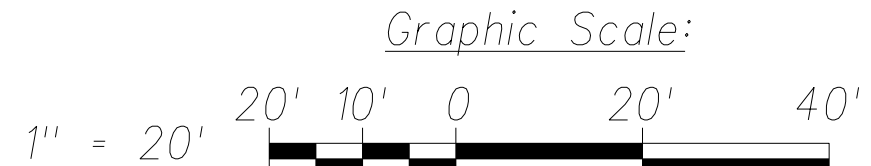

09/12/13
Date
Revise Fence.
Revision

STATE OF HAWAII
DEPARTMENT OF TRANSPORTATION
HIGHWAYS DIVISION

FENCE PLAN

PHASE 1 - KAUMUALI'I HIGHWAY
LIHU'E MILL BRIDGE TO RICE STREET
PHASE 1 - HO'OMANA ROAD

Scale: As Shown
Date: December 4, 2012

SHEET No. C-27 OF 50 SHEETS

SURVEY PLOTTED BY	DATE
DRAWN BY	
DESIGNED BY	
QUANTITIES BY	
CHECKED BY	
ORIGINAL PLAN	
NOTE BOOK	
No.	