


FED. ROAD DIST. NO.	STATE	FED. AID PROJ. NO.	FISCAL YEAR	SHEET NO.	TOTAL SHEETS
HAWAII	HAW.	ARR-050-1(036)	FY13/14	50	50

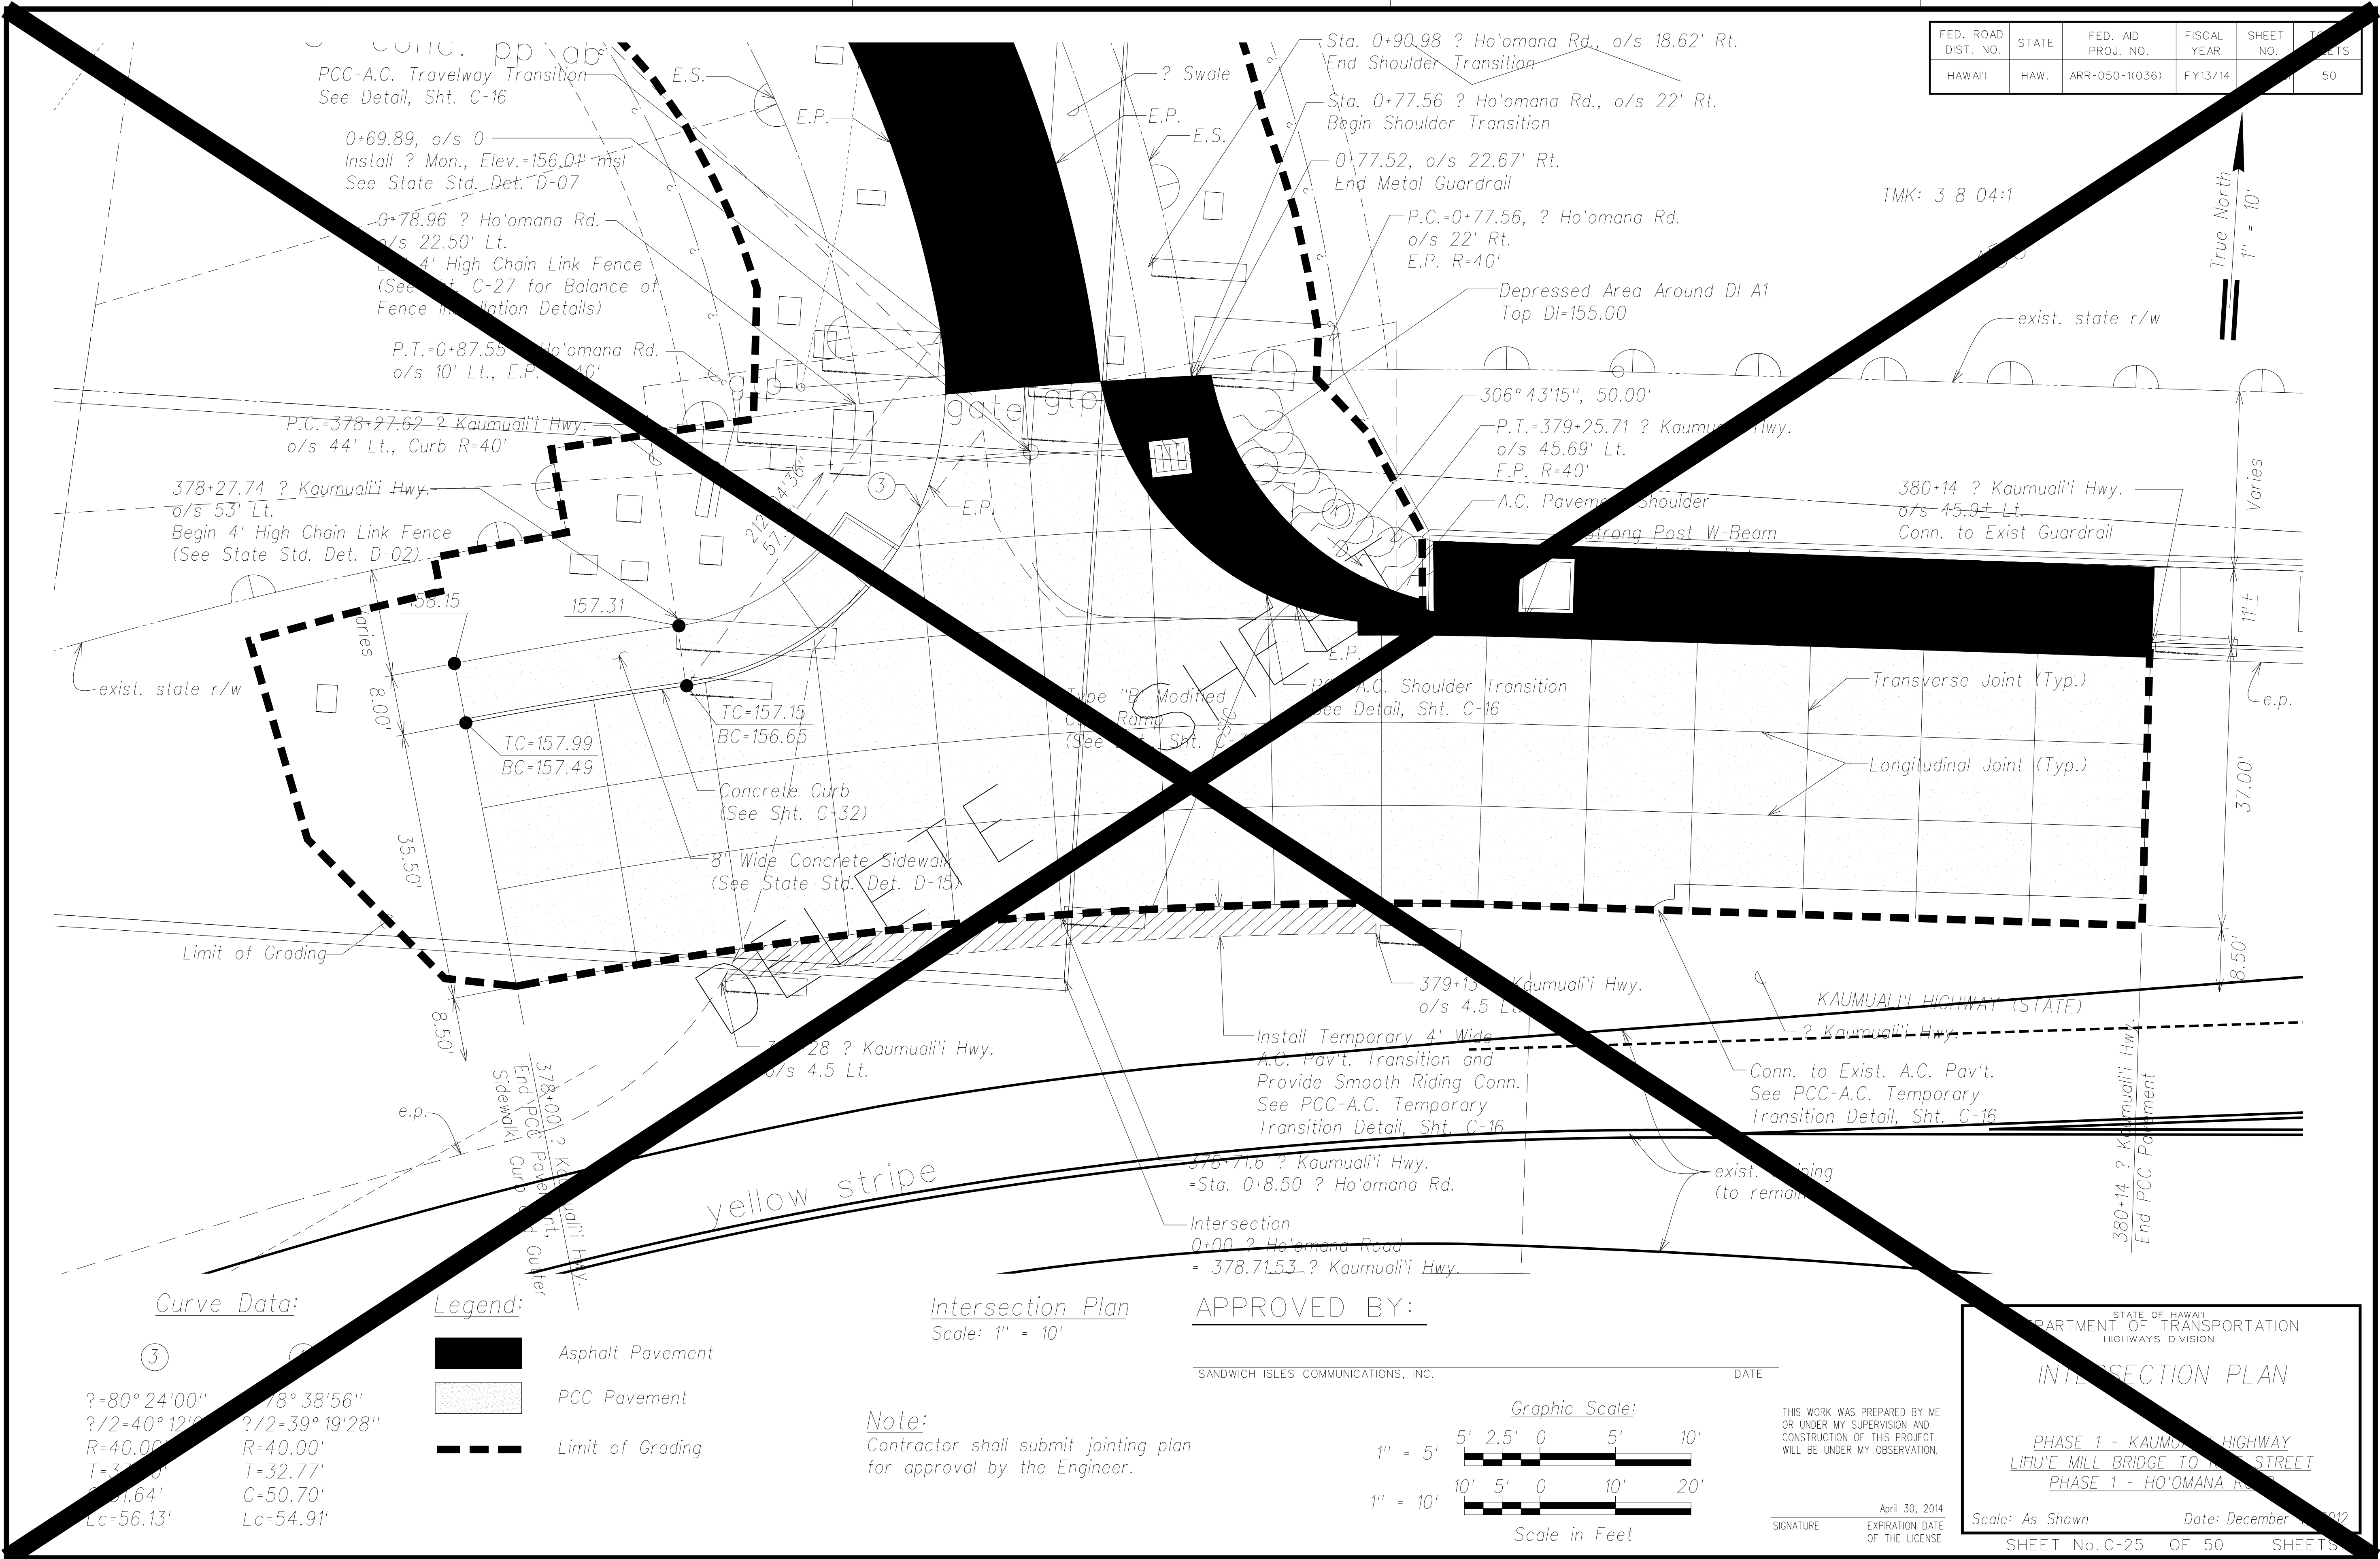

SURVEY PLOTTED BY: _____	DATE: _____	DRAWN BY: _____	DESIGNED BY: _____	QUANTITIES BY: _____	CHECKED BY: _____
ORIGINAL PLAN	NOTE BOOK	No. _____			

Curve Data:

③	④
?=80°24'00"	?=78°38'56"
?/2=40°12'00"	?/2=39°19'28"
R=40.00'	R=40.00'
T=32.77'	T=32.77'
E=51.64'	C=50.70'
Lc=56.13'	Lc=54.91'

Legend:

- Asphalt Pavement
- PCC Pavement
- Limit of Grading


Intersection Plan
Scale: 1" = 10'

Note:
Contractor shall submit jointing plan
for approval by the Engineer.

APPROVED BY:

SANDWICH ISLES COMMUNICATIONS, INC.

DATE

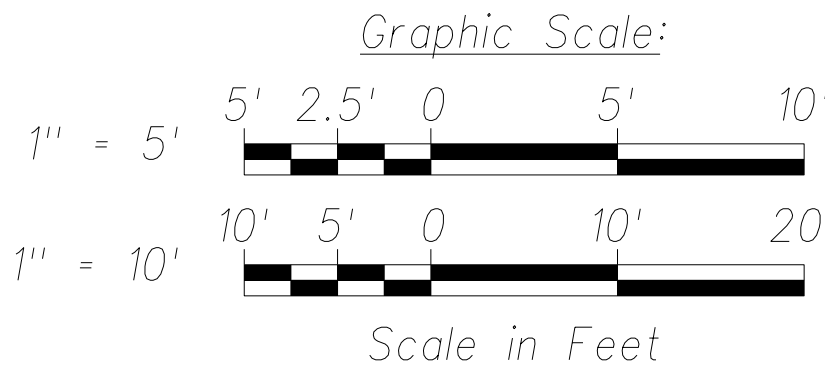

THIS WORK WAS PREPARED BY ME
OR UNDER MY SUPERVISION AND
CONSTRUCTION OF THIS PROJECT
WILL BE UNDER MY OBSERVATION.

SIGNATURE

April 30, 2014
EXPIRATION DATE
OF THE LICENSE

STATE OF HAWAII
DEPARTMENT OF TRANSPORTATION
HIGHWAYS DIVISION


INTERSECTION PLAN

PHASE 1 - KAUMUALI'I HIGHWAY
LIHU'E MILL BRIDGE TO THE STREET
PHASE 1 - HO'OMANA ROAD


Scale: As Shown Date: December 1, 2012

SHEET No. C-25 OF 50 SHEETS

FED. ROAD DIST. NO.	STATE	FED. AID PROJ. NO.	FISCAL YEAR	SHEET NO.	TOTAL SHEETS
HAWAII	HAW.	ARR-050-1(036)	FY13/14	Model	50

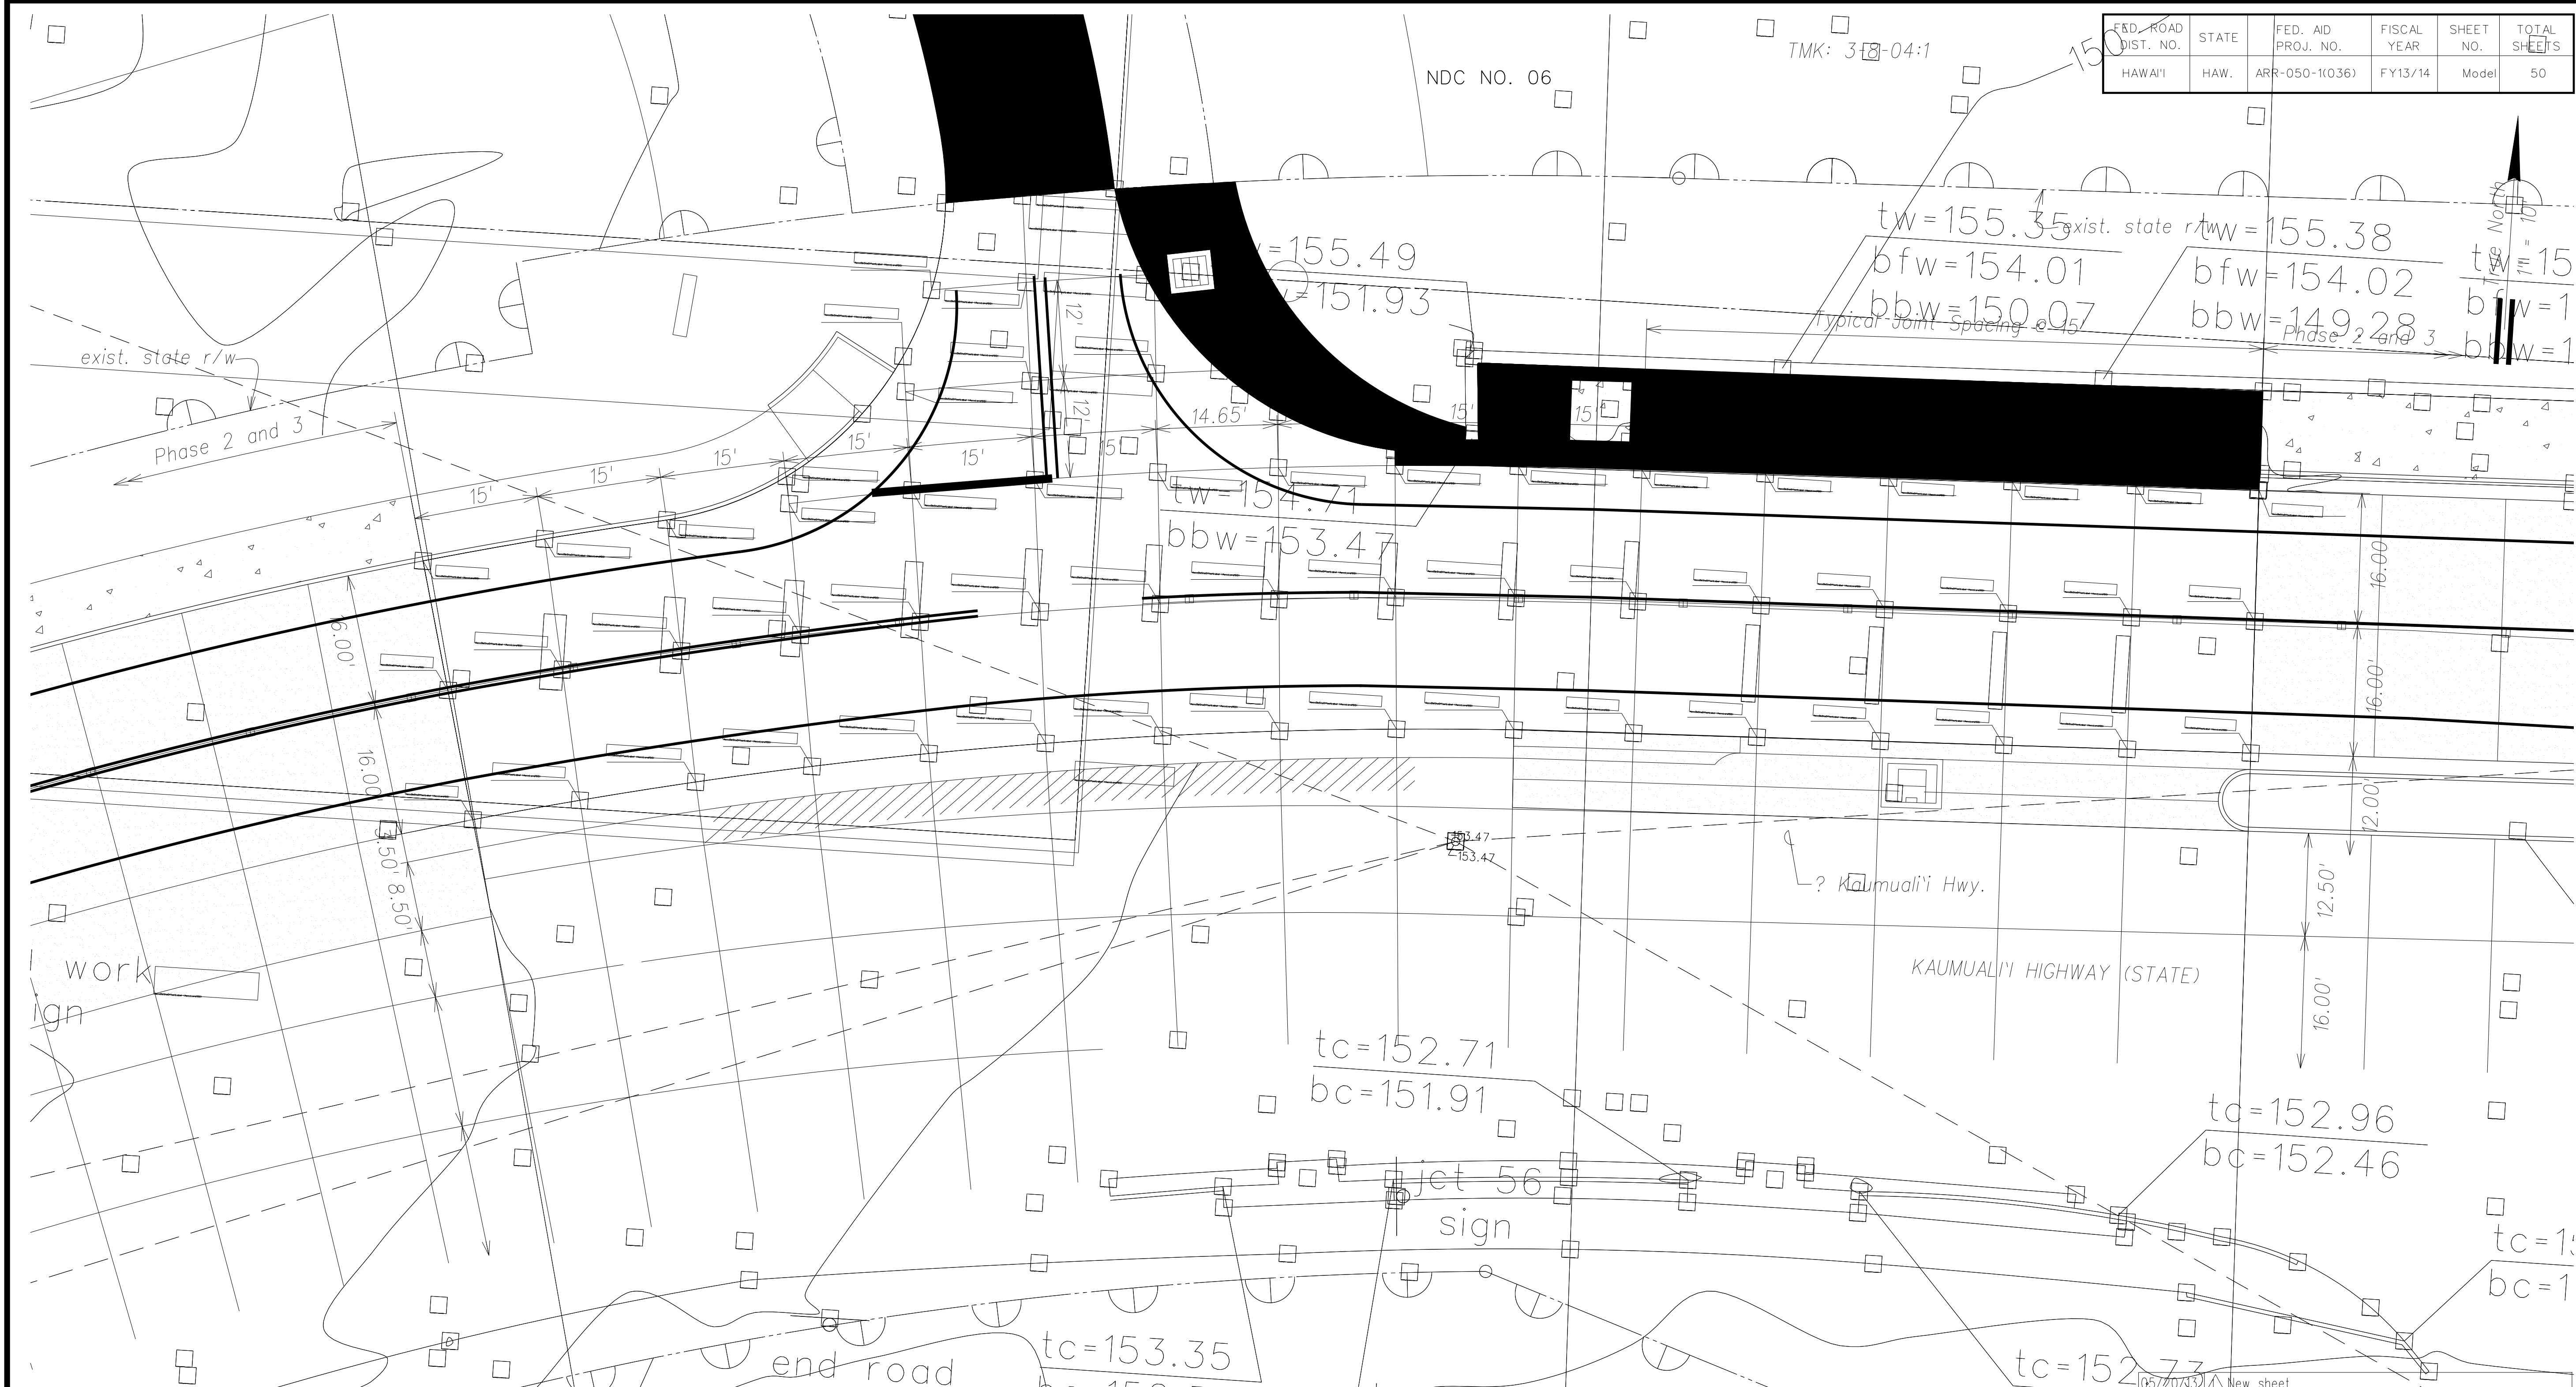

- Legend:
- Asphalt Pavement
 - PCC Pavement
 - Typical Transverse Joint
 - Typical Longitudinal Joint

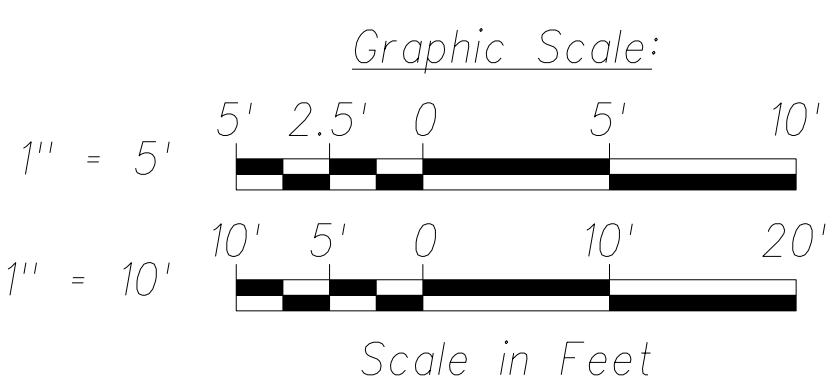

THIS WORK WAS PREPARED BY ME OR UNDER MY SUPERVISION AND CONSTRUCTION OF THIS PROJECT WILL BE UNDER MY OBSERVATION.

SIGNATURE _____

April 30, 2014

EXPIRATION DATE OF THE LICENSE

Date	Revision
STATE OF HAWAII DEPARTMENT OF TRANSPORTATION HIGHWAYS DIVISION	
PAVING PLAN	
PHASE 1 - KAUMUALI'I HIGHWAY LIHU'E MILL BRIDGE TO RICE STREET PHASE 1 - HO'OMANA ROAD	
Scale: As Shown	Date: December 4, 2012
SHEET No. C-25 OF 50 SHEETS	


SURVEY PLOTTED BY	DATE
DRAWN BY	
DESIGNED BY	
QUANTITIES BY	
CHECKED BY	
ORIGINAL PLAN	
NOTE BOOK	
No.	

"AS-BUILT"

C. Model S1

DECEMBER 18, 2015

FED. ROAD DIST. NO.	STATE	FED. AID PROJ. NO.	FISCAL YEAR	SHEET NO.	TOTAL SHEETS
HAWAII	HAW.	ARR-050-1(036)	FY13/14	Model	50

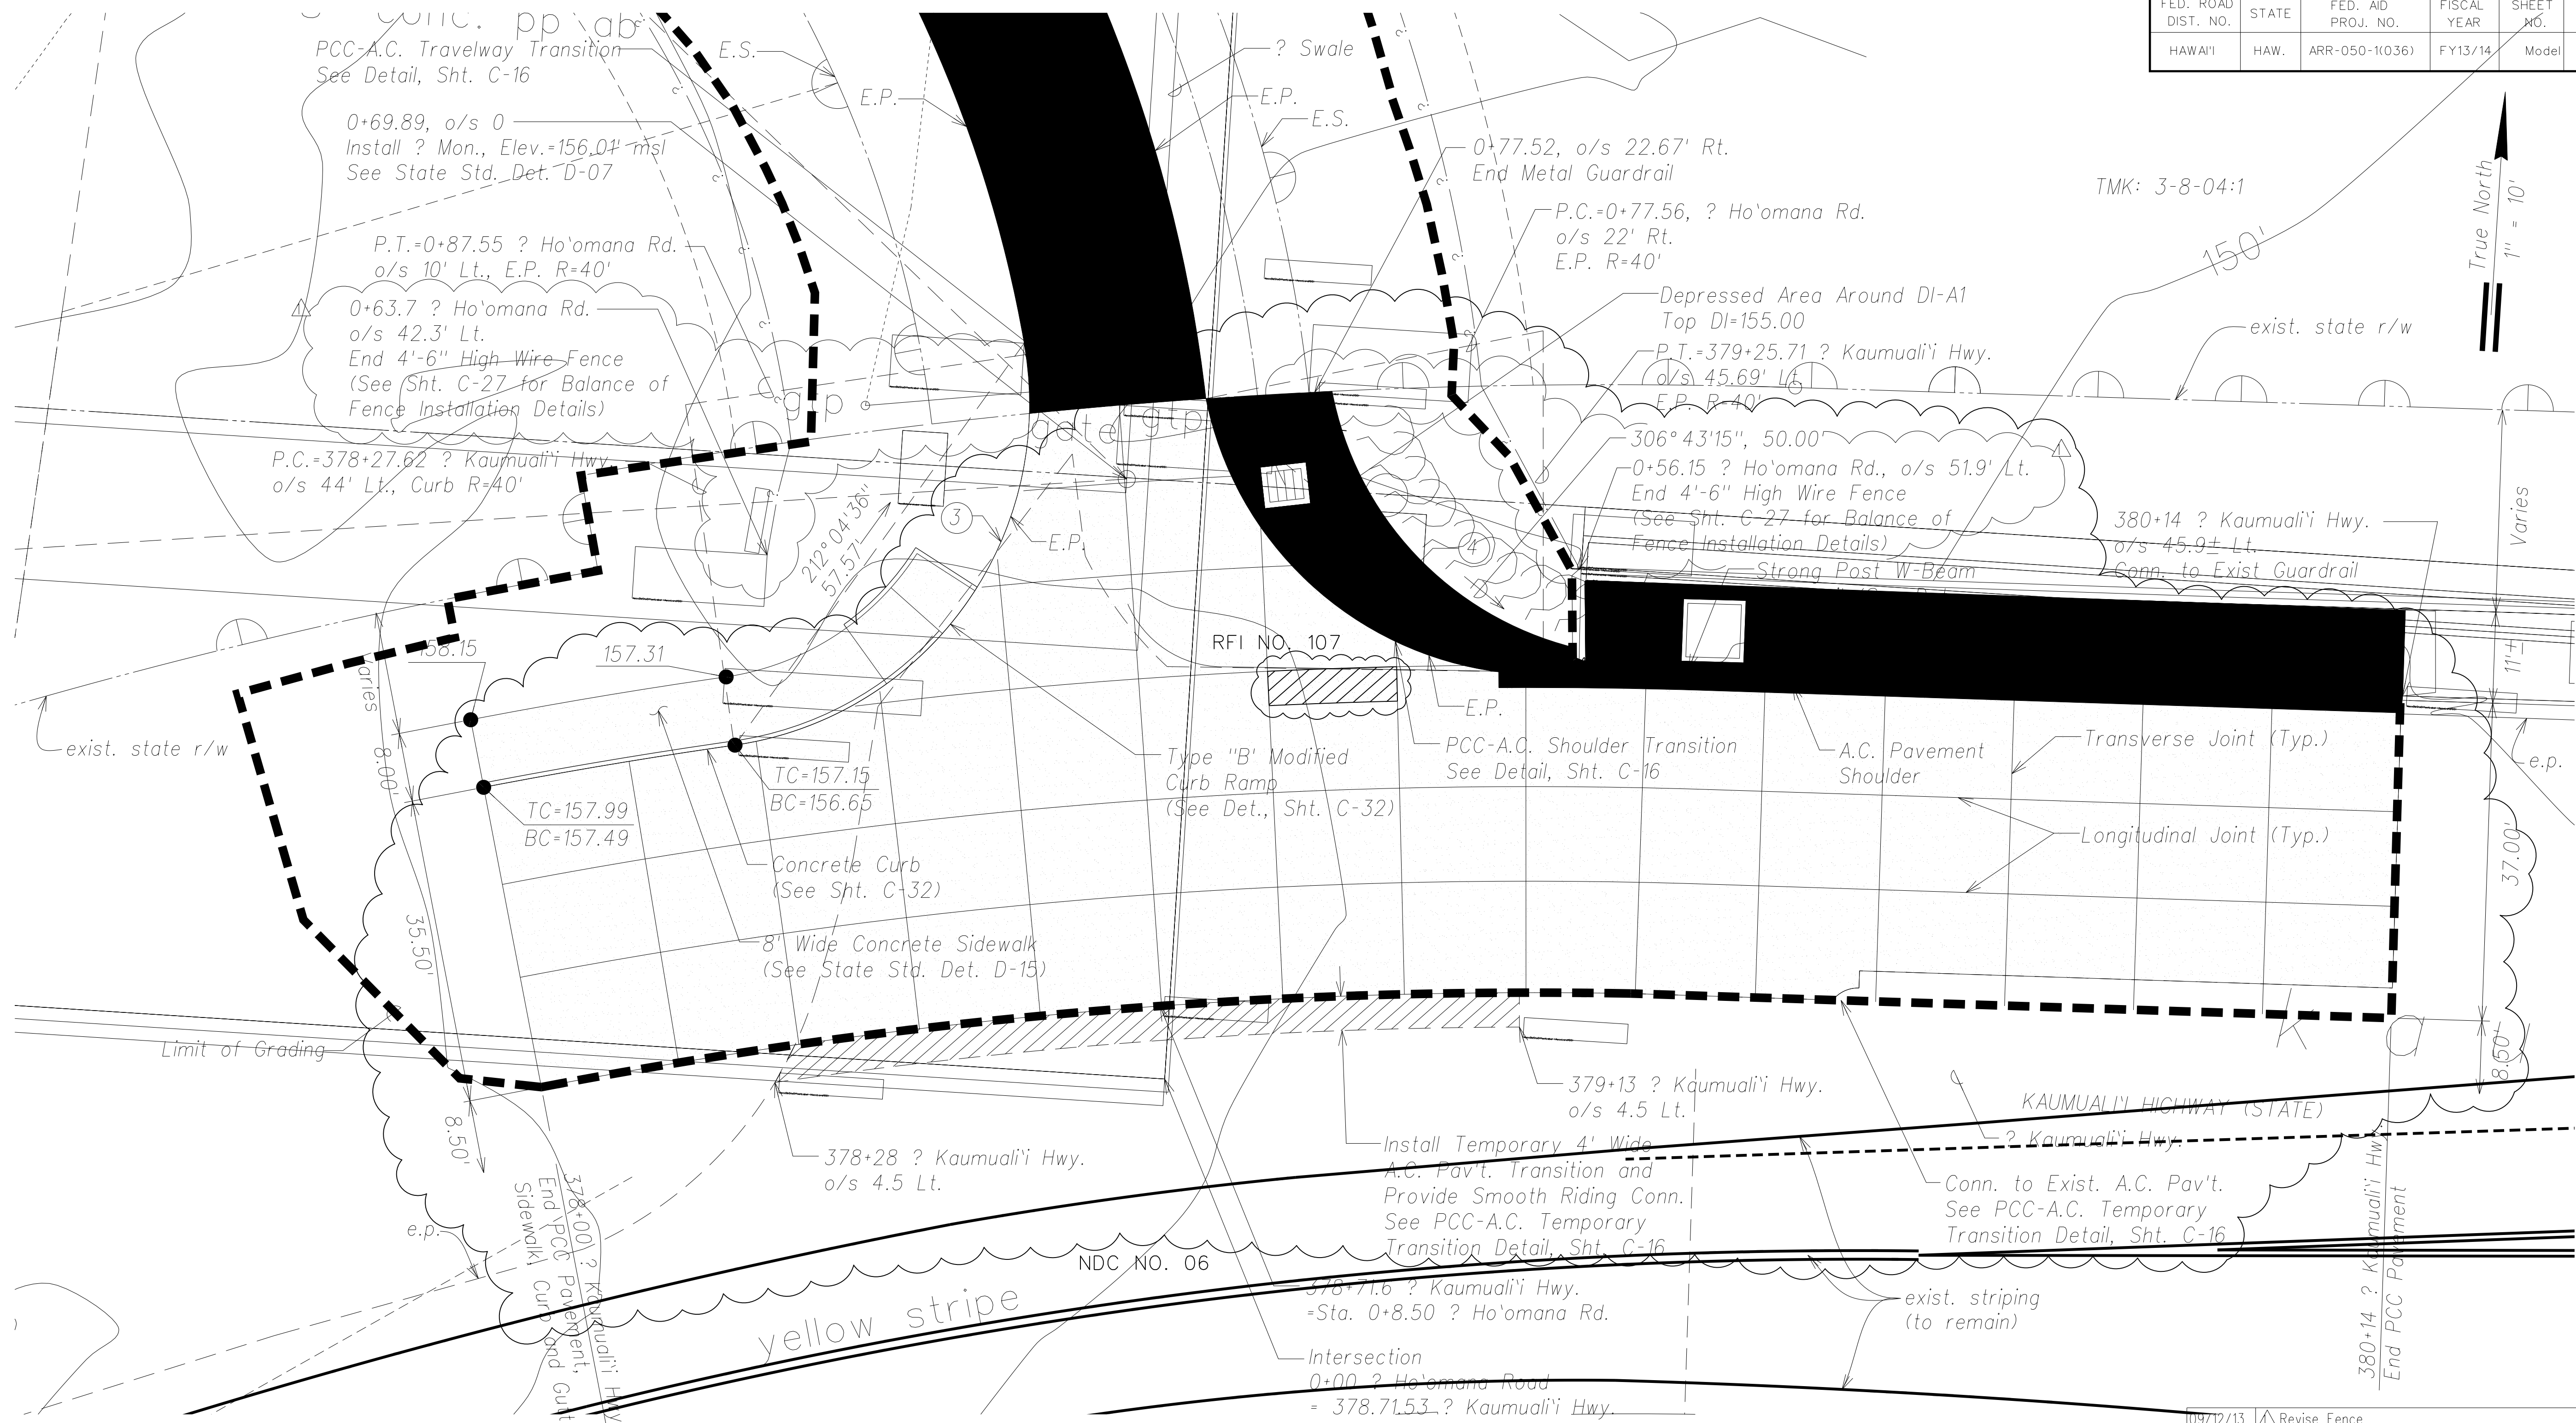

Curve Data:

③	④
?=80°24'00"	?=78°38'56"
?/2=40°12'00"	?/2=39°19'28"
R=40.00'	R=40.00'
T=33.80'	T=32.77'
C=51.64'	C=50.70'
Lc=56.13'	Lc=54.91'


Legend:

- Asphalt Pavement
- PCC Pavement
- Limit of Grading

Intersection Plan
Scale: 1" = 10'

APPROVED BY:

Note:
Contractor shall submit
jointing plan for approval by
the Engineer.

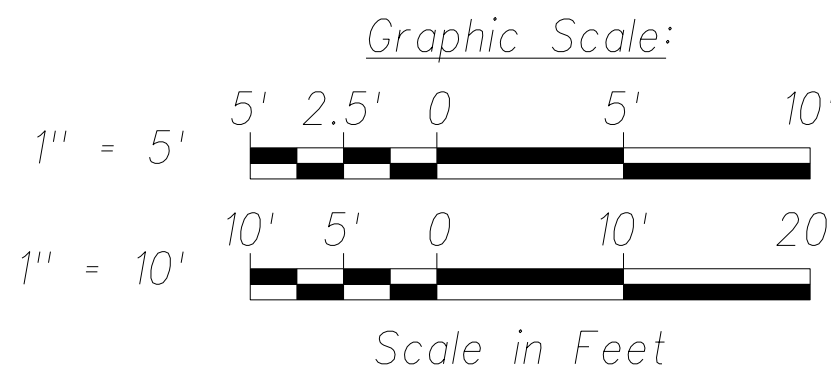

THIS WORK WAS PREPARED BY ME
OR UNDER MY SUPERVISION AND
CONSTRUCTION OF THIS PROJECT
WILL BE UNDER MY OBSERVATION.

Signature: _____
Date: April 30, 2014
Expiration Date of License: _____

09/12/13
Date

△ Revise Fence.
Revision

STATE OF HAWAII
DEPARTMENT OF TRANSPORTATION
HIGHWAYS DIVISION

INTERSECTION PLAN

PHASE 1 - KAUMUALI'I HIGHWAY
LIHU'E MILL BRIDGE TO RICE STREET
PHASE 1 - HO'OMANA ROAD

Scale: As Shown
Date: December 4, 2012

SHEET No. C-25 OF 50 SHEETS

SURVEY PLOTTED BY: _____	DATE: _____
DRAWN BY: _____	DESIGNED BY: _____
NOTE BOOK: _____	QUANTITIES BY: _____
ORIGINAL PLAN: _____	CHECKED BY: _____

"AS-BUILT"

C. Model S2