




INDEX TO DRAWINGS		REF.	SHTS.
SHEET NO.	DESCRIPTION	FROM	TO
1	TITLE SHEET	T-1	T-1
2-45	CIVIL DRAWINGS	C-1	C-44
46-49	ELECTRICAL DRAWINGS	E-1	E-4
50	LANDSCAPING DRAWINGS	L-1	L-1

Plan Sht. Nos. CO 17 S1, CO 20 S1, CO 26 S1 & S2, CO 27 S1, CO 28 S1, CO 30 S1, CO 31 SW, and CO 33 S1 & S2 are supplementary sheets to this project, added during Addendum & "AS BUILT" postings.

LEGEND FOR AS-BUILT POSTINGS	
	Squiggly line for as-built deletion
	Double line for as-built deletion
Roadway	Text for as-built posting

TOTAL SHEET COUNT after Addendum & "AS BUILT" postings is 60 sheets.

CHANGES MADE DURING CONSTRUCTION HAVE BEEN INCORPORATED ON THESE PLANS EXCEPT CHANGES IN THE ORIGINAL THEORETICAL QUANTITIES. FOR ACTUAL QUANTITIES, REFER TO PROJECT LEDGER AND/OR COMPUTATION BOOK.

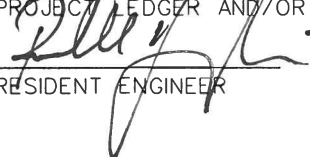
RESIDENT ENGINEER
12/28/21
DATE

12/11/12
DATE

692-7570
PHONE

HWY-DD
MANAGED BY

R.M. TOWILL CORPORATION
DESIGNED BY



STATE OF HAWAI'I DEPARTMENT OF TRANSPORTATION

HIGHWAYS DIVISION
HONOLULU, HAWAI'I
"AS BUILT"
PLANS FOR

PHASE 1 - KAUMUALI'I HIGHWAY LTHU'E MILL BRIDGE TO RICE STREET PHASE 1 - HO'OMANA ROAD

DISTRICT OF LTHU'E
PROJECT NO. ARR-050-1(036)
DISTRICT OF LTHU'E
ISLAND OF KAUAI


FED. ROAD DIST. NO.	STATE	FED. AID PROJ. NO.	FISCAL YEAR	SHEET NO.	TOTAL SHEETS
HAWAI'I	HAW.	ARR-050-1(036)	FY13/14	Model	50

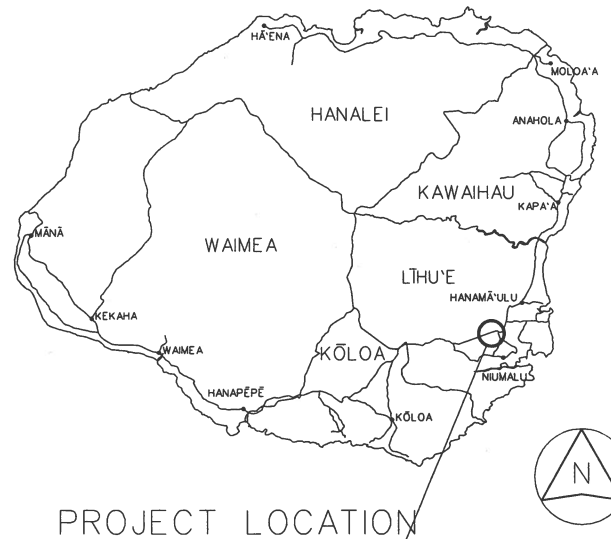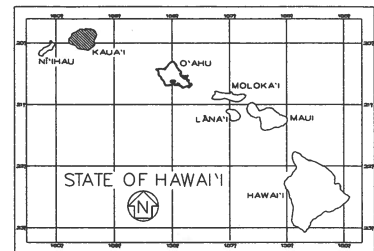

4 0 4 8
SCALE IN MILES

APPROVED BY:

COUNTY ENGINEER, DEPARTMENT OF PUBLIC WORKS, COUNTY OF KAUAI (WORK WITHIN COUNTY RIGHT-OF-WAY)	DATE
STATE DEPARTMENT OF TRANSPORTATION, HIGHWAYS DIVISION - KAUAI BRANCH	DATE
DIRECTOR, DEPARTMENT OF PLANNING, COUNTY OF KAUAI	DATE
MANAGER AND CHIEF ENGINEER, DEPARTMENT OF WATER, COUNTY OF KAUAI	DATE
KAUAI ISLAND UTILITY COOPERATIVE	DATE
HAWAIIAN TELCOM	DATE
OCEANIC TIME WARNER CABLE	DATE
SANDWICH ISLES COMMUNICATIONS, INC.	DATE

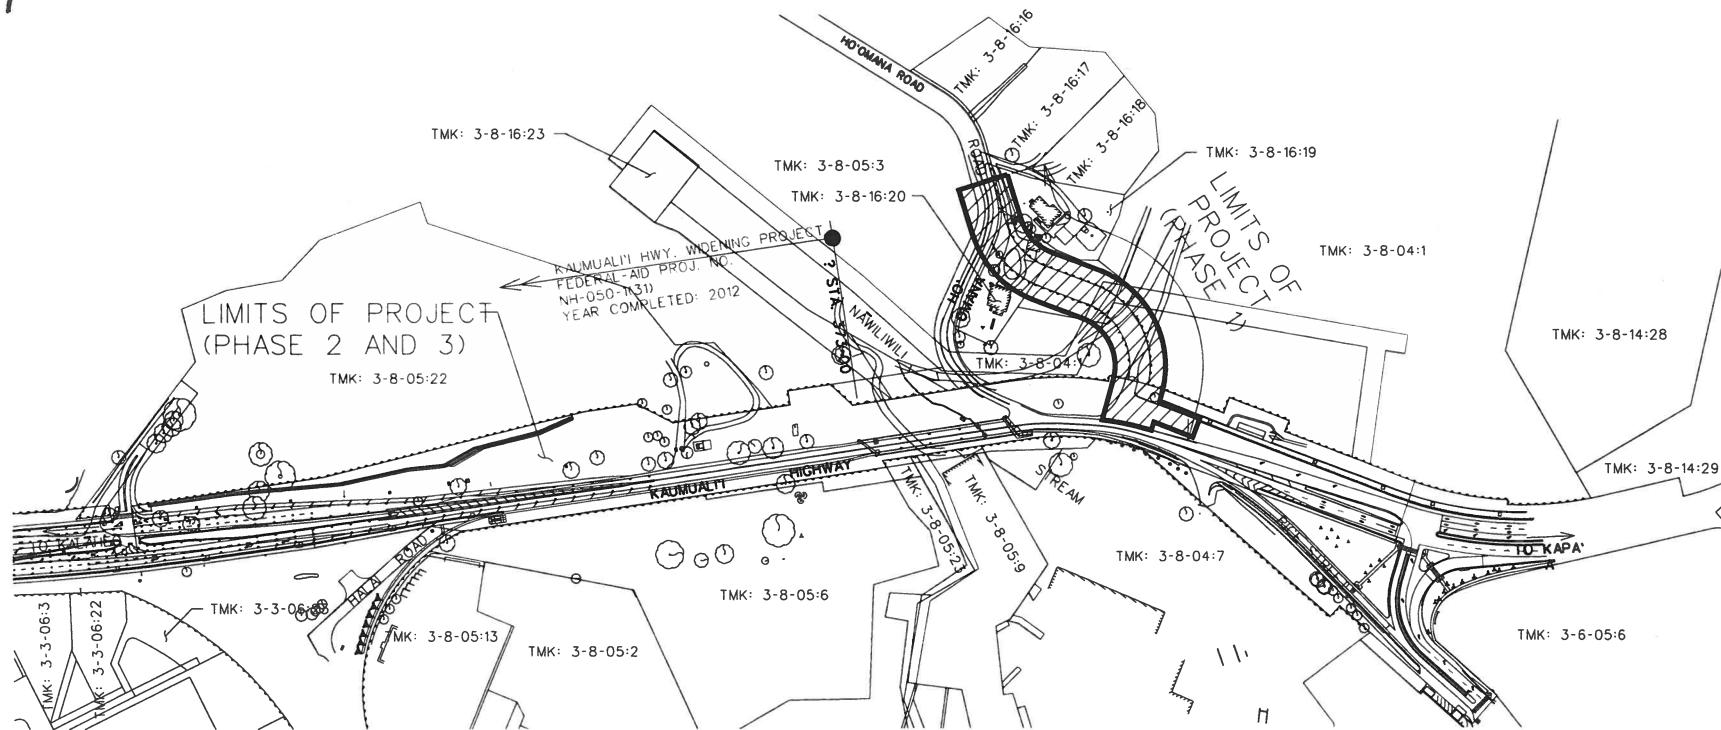

GRAPHIC SCALE
200' 100' 0 200' 400'
SCALE IN HUNDRED FEET

LAYOUT PLAN
NET LENGTH OF PROJECT (PH. 1) = 0.08 MILES
GROSS LENGTH OF PROJECT (PH. 1) = 0.08 MILES

DEPARTMENT OF TRANSPORTATION
STATE OF HAWAI'I
APPROVED:
DIVISION ADMINISTRATOR DATE

DEPARTMENT OF TRANSPORTATION
STATE OF HAWAI'I
APPROVED:
DIR. OF TRANSPORTATION DATE