


FED. ROAD DIST. NO.	STATE	FED. AID PROJ. NO.	FISCAL YEAR	SHEET NO.	TOTAL SHEETS
HAWAII	HAW.	ARR-050-1(036)	FY13/14	Model	50

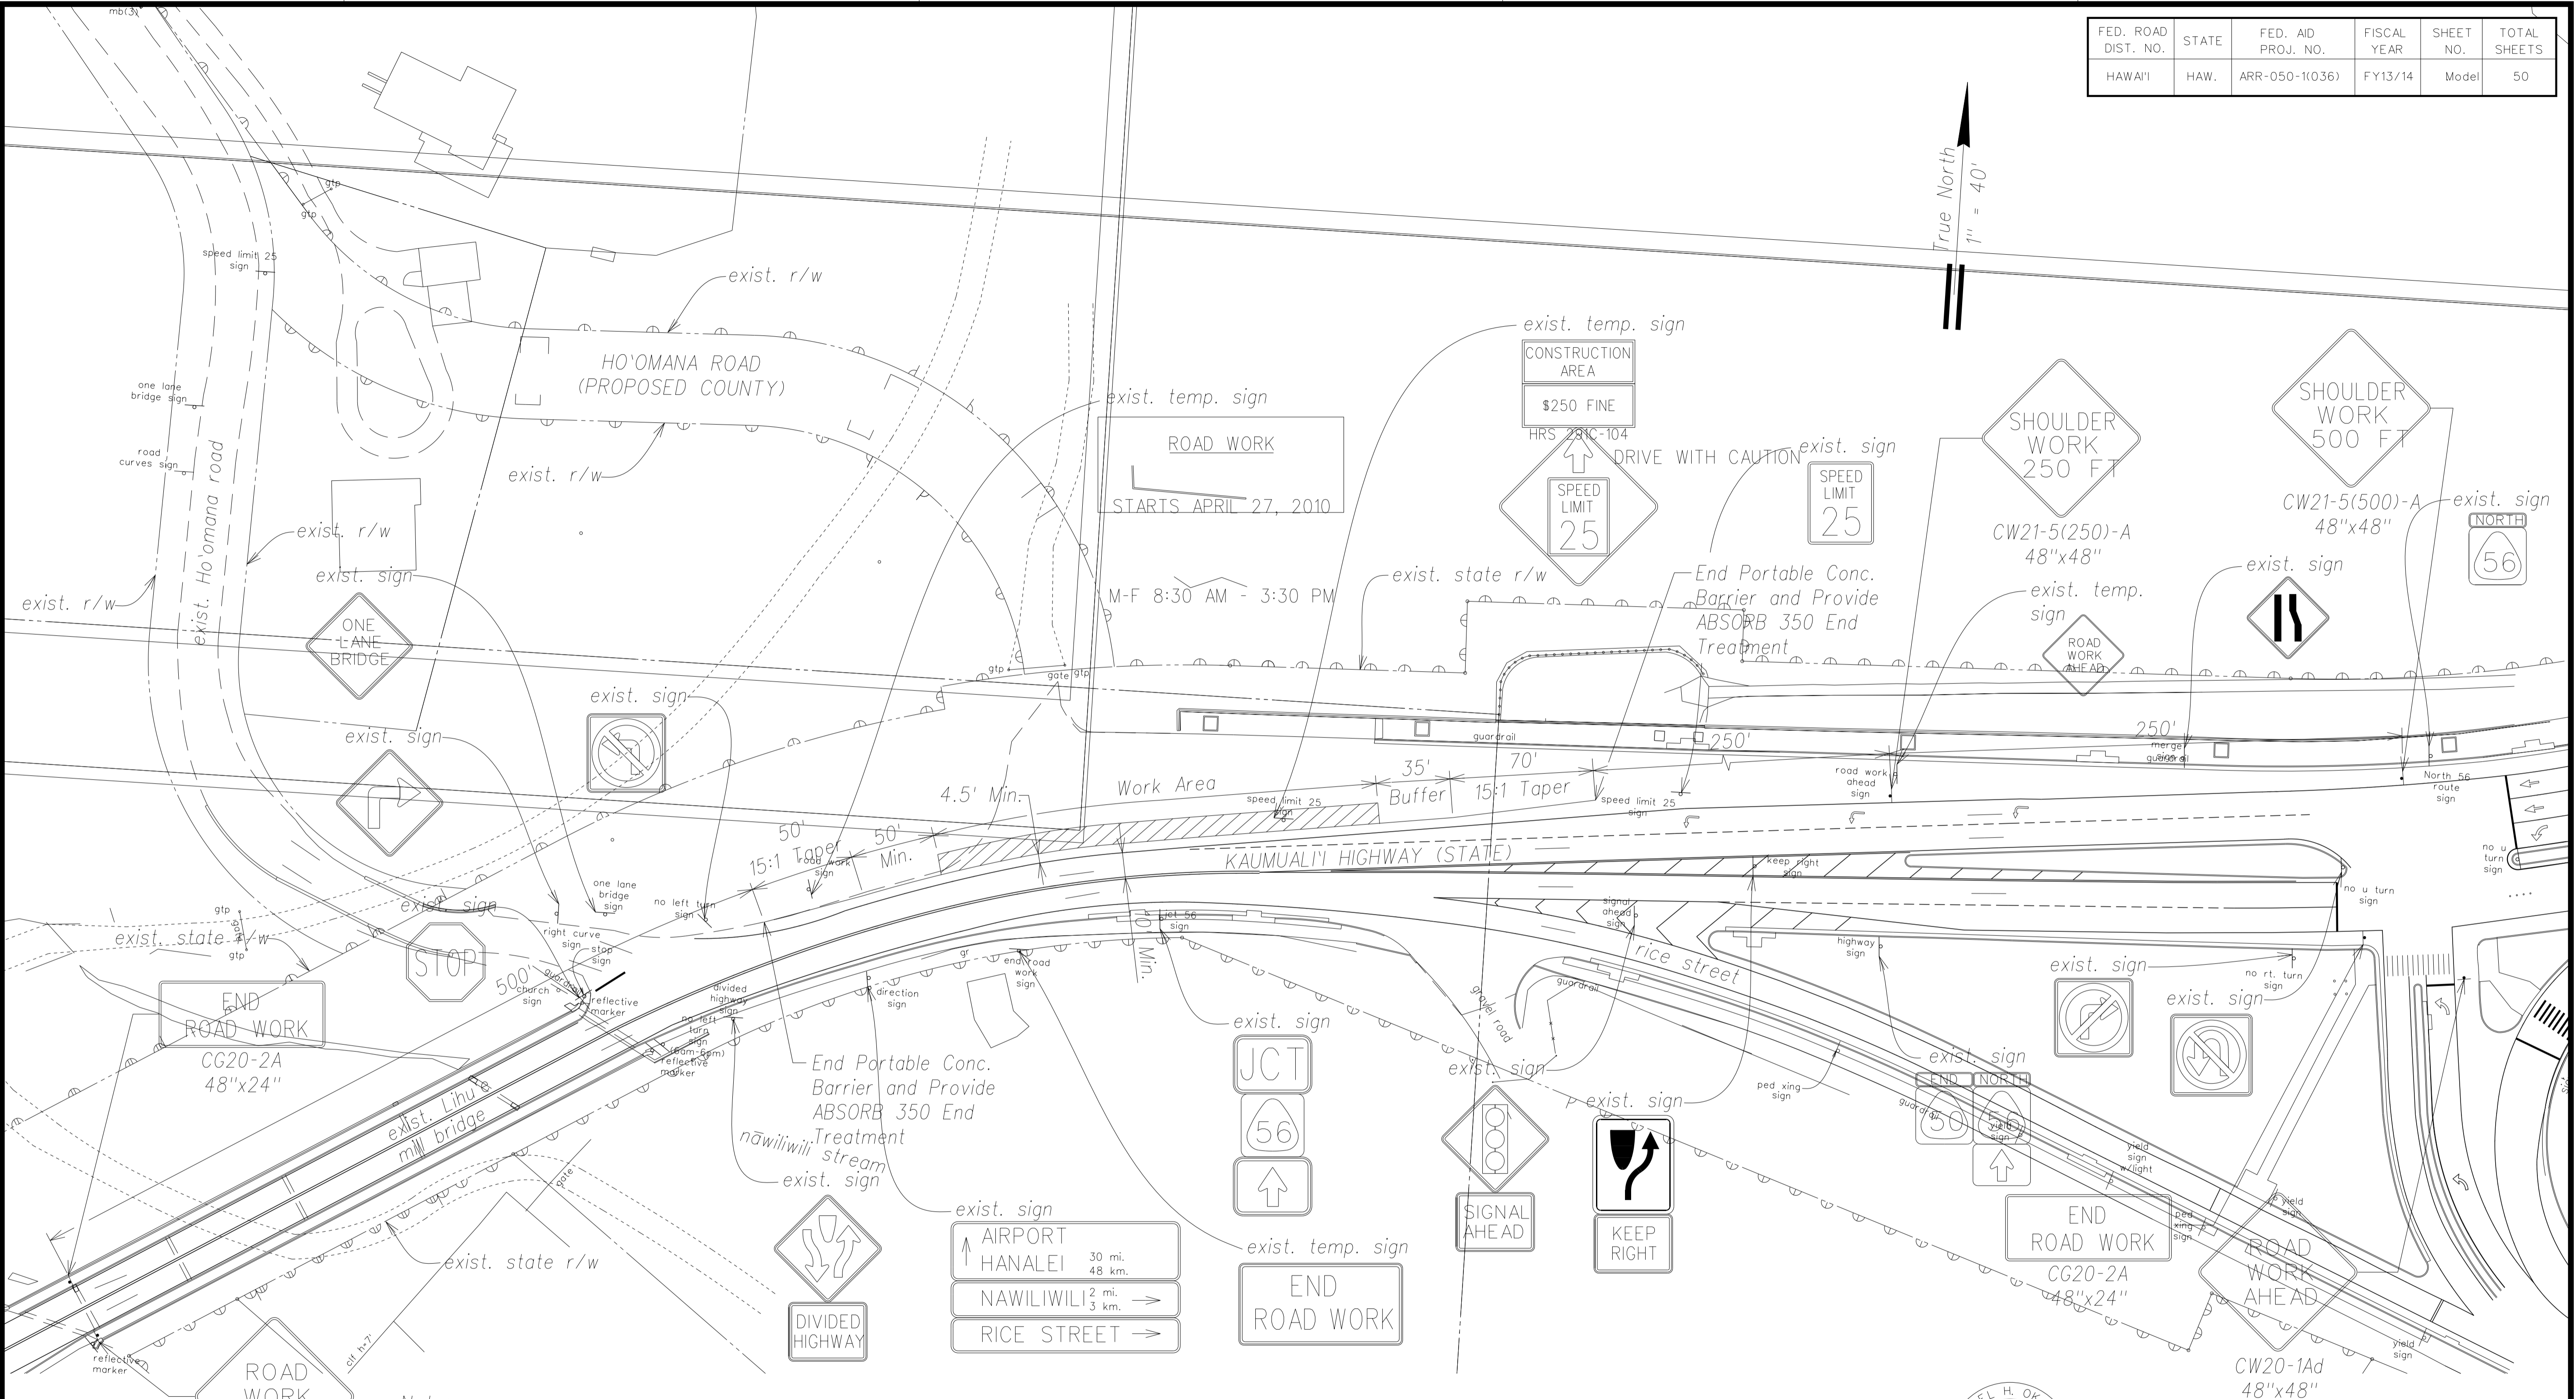

SURVEY PLOTTED BY	DATE
DRAWN BY	
DESIGNED BY	
QUANTITIES BY	
CHECKED BY	
ORIGINAL PLAN	
NOTE BOOK	
No.	


Note:  
See Sht. C-4 for General Notes for  
Traffic Control Plan.

- Legend
- Sign
  - Portable Concrete Barrier
  - Direction of Traffic
  - Police Officer/Flagger
  - Work Area


Traffic Control Plan-Kaumuali'i Highway  
Scale: 1" = 40'

APPROVED BY:

COUNTY ENGINEER, DEPARTMENT OF PUBLIC WORKS  
(FOR WORK IN THE COUNTY RIGHT-OF-WAY)

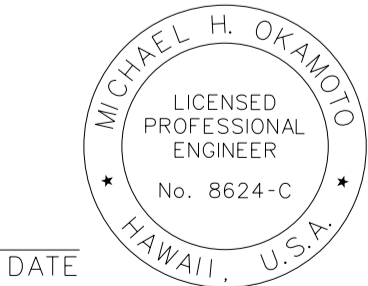

THIS WORK WAS PREPARED BY ME  
OR UNDER MY SUPERVISION AND  
CONSTRUCTION OF THIS PROJECT  
WILL BE UNDER MY OBSERVATION.

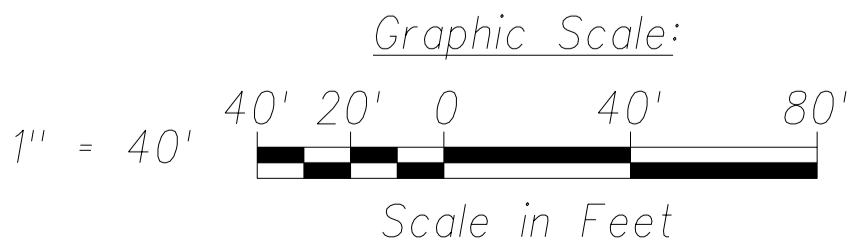

SIGNATURE  
April 30, 2014  
EXPIRATION DATE  
OF THE LICENSE

STATE OF HAWAII  
DEPARTMENT OF TRANSPORTATION  
HIGHWAYS DIVISION

TRAFFIC CONTROL  
PLAN - 1


PHASE 1 - KAUMUALI'I HIGHWAY  
LIHU'E MILL BRIDGE TO RICE STREET  
PHASE 1 - HO'OMANA ROAD

Scale: As Shown Date: December 4, 2012  
SHEET No. C-40 OF 50 SHEETS

"AS-BUILT"

Model


FED. ROAD DIST. NO.	STATE	FED. AID PROJ. NO.	FISCAL YEAR	SHEET NO.	TOTAL SHEETS
HAWAII	HAW.	ARR-050-1(036)	FY13/14	Model	50

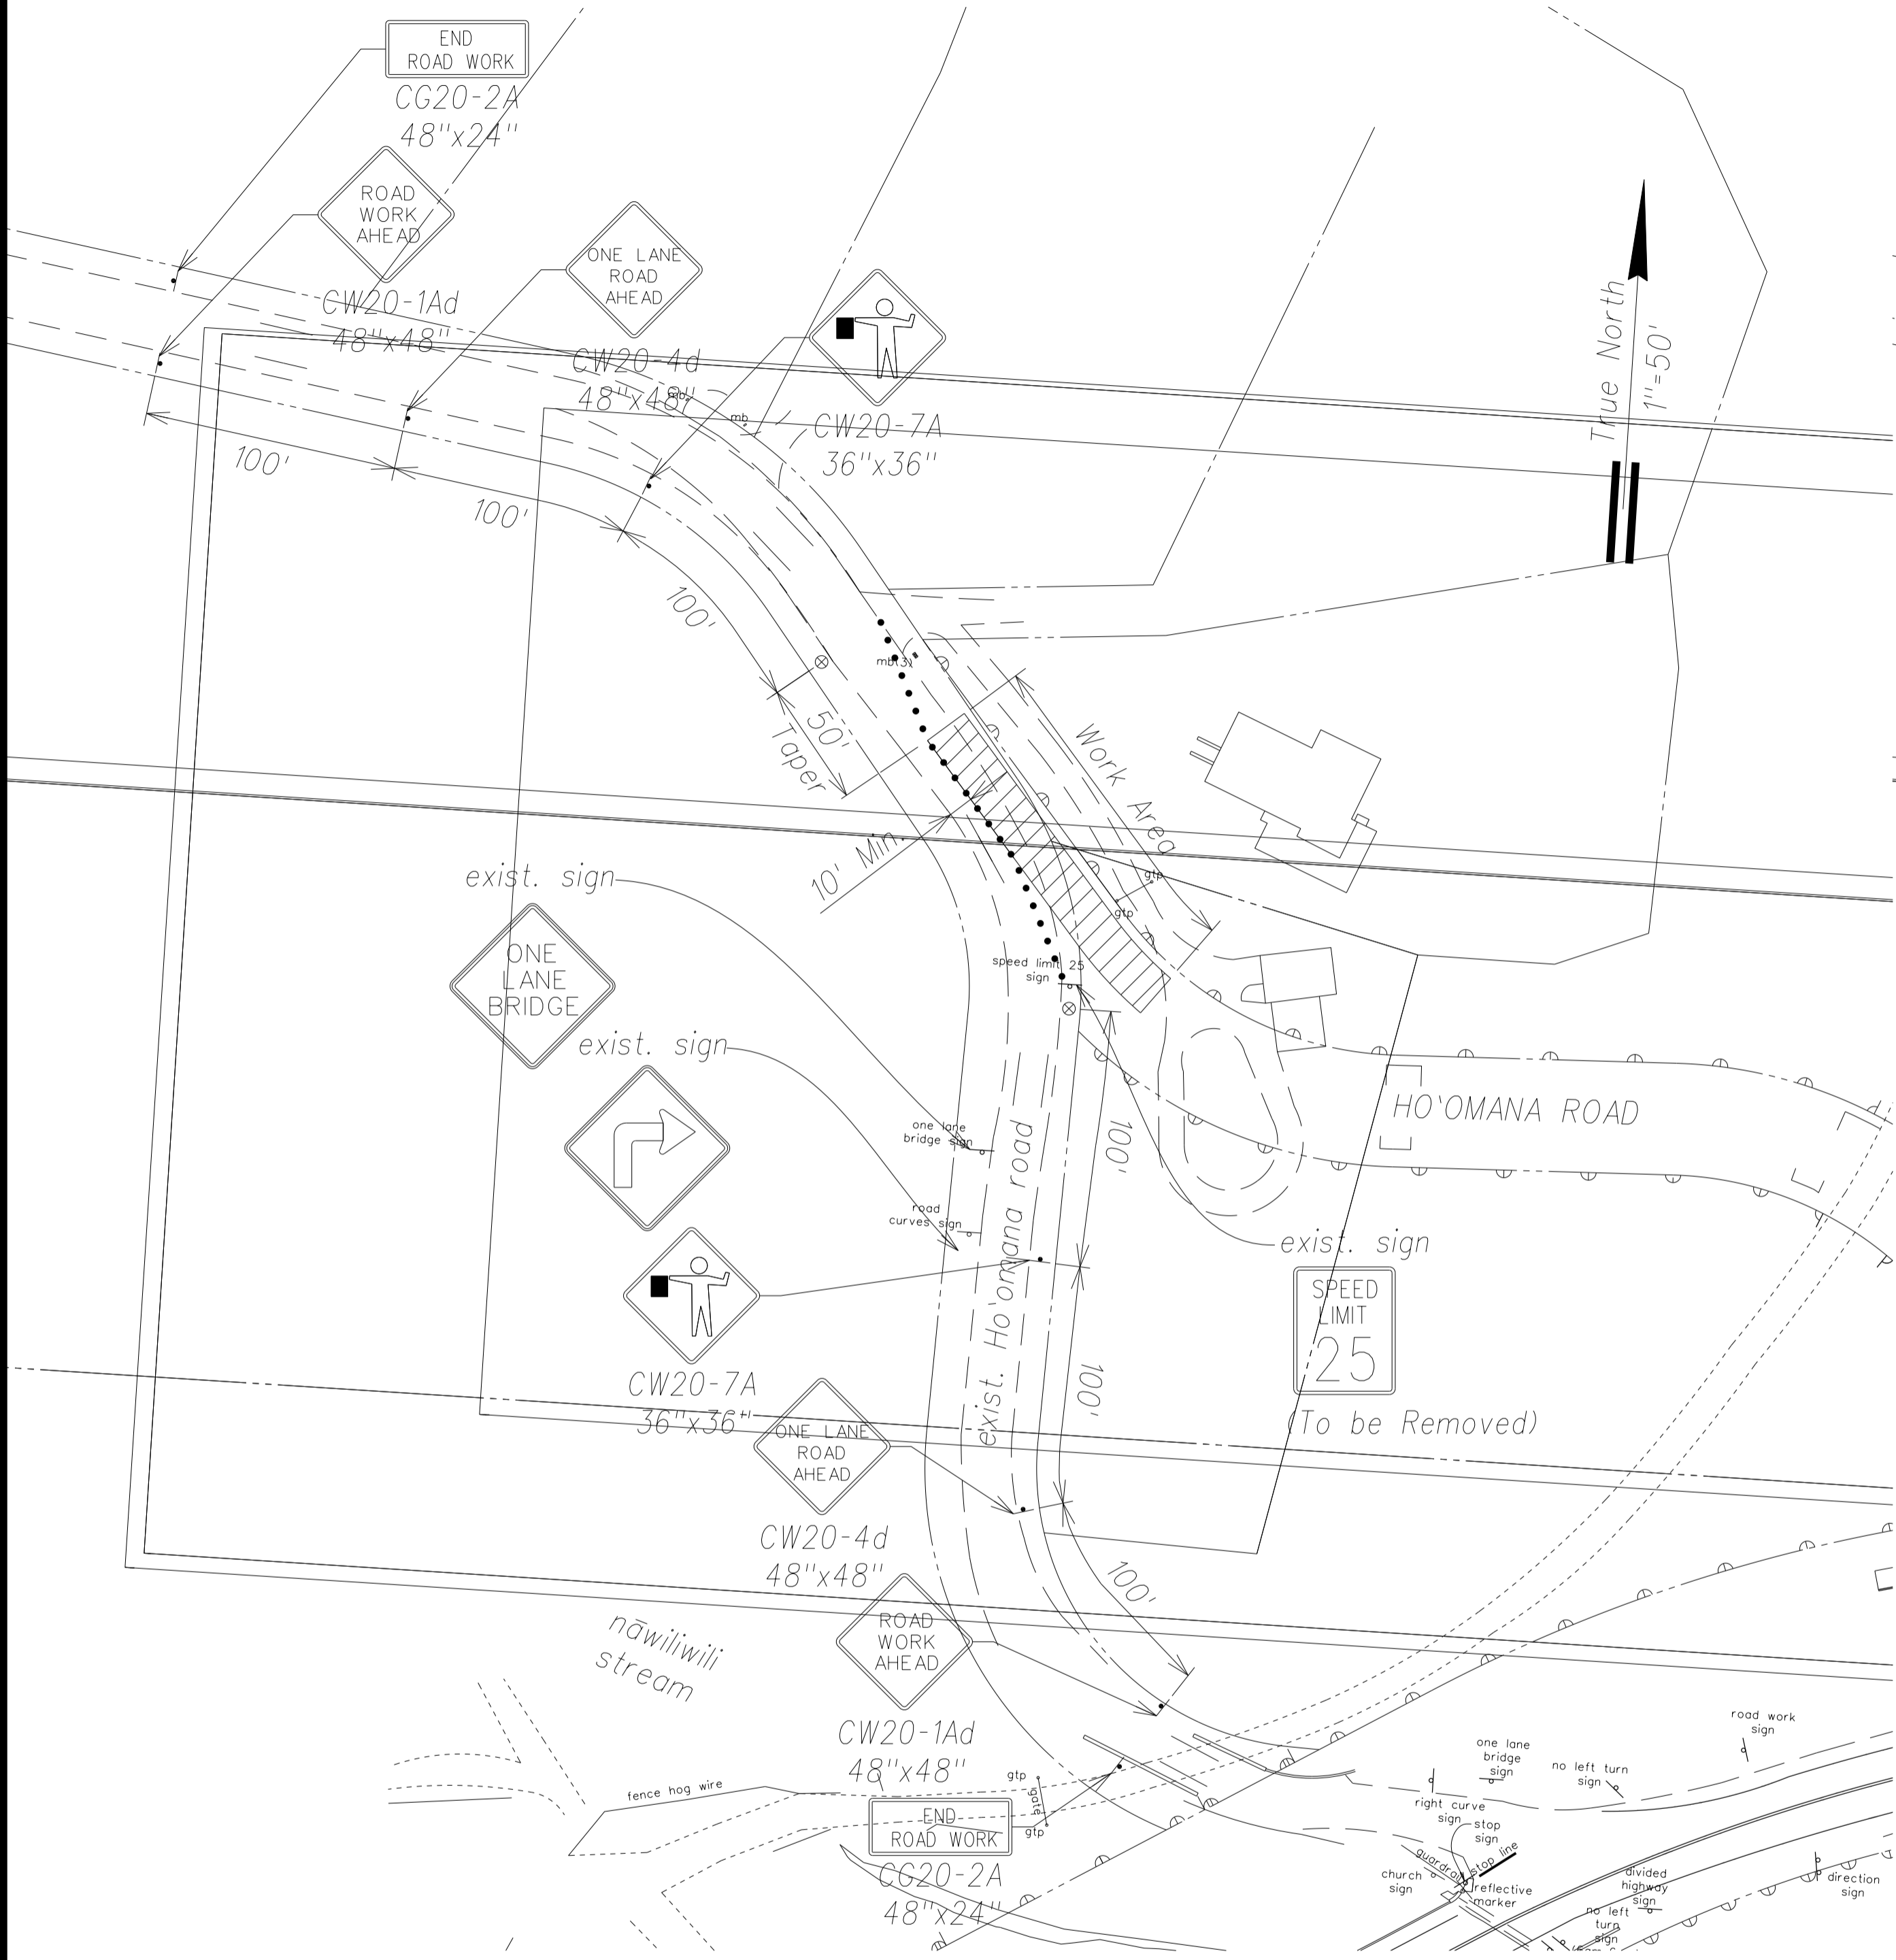

Traffic Control Plan-Ho'omana Road (Phase 1)  
Scale: 1" = 50'

Note:  
See Sht. C-4 for General Notes for  
Traffic Control Plan.

- Legend
- Sign
  - Cone or Delineator
  - Direction of Traffic
  - Police Officer/Flagger
  - Work Area

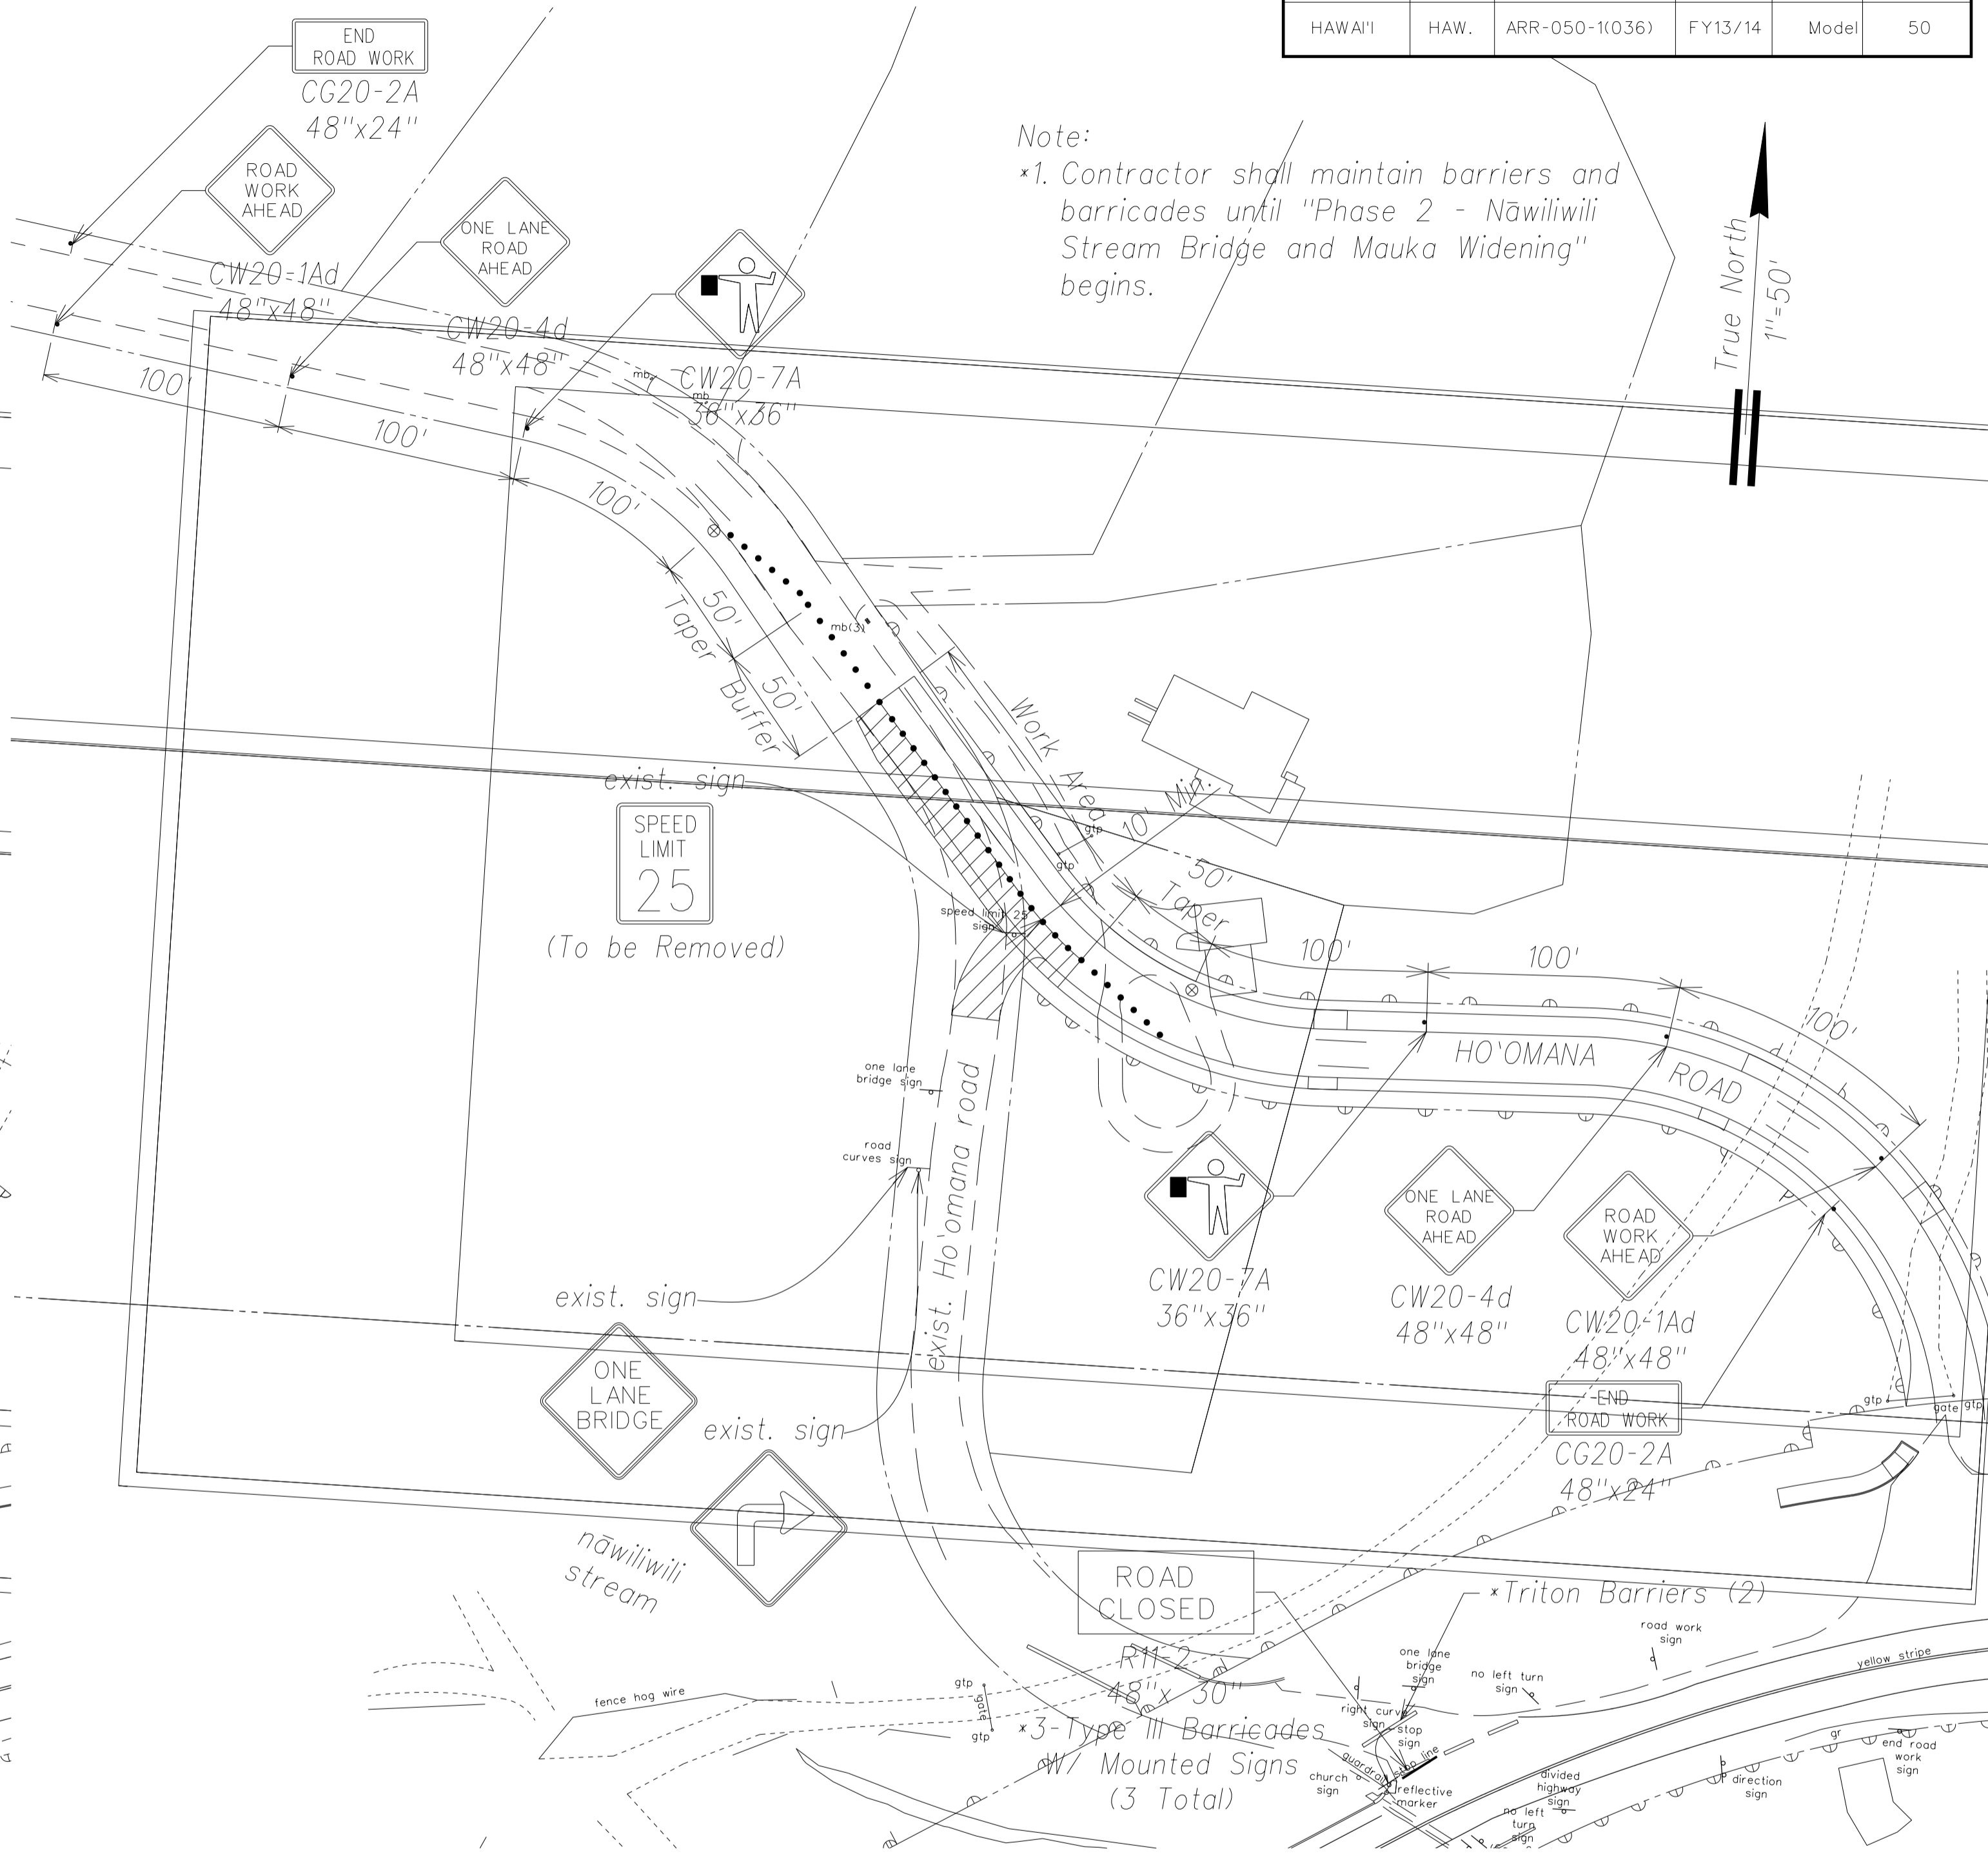

Traffic Control Plan-Ho'omana Road (Phase 2)  
Scale: 1" = 50'


Note:  
\*1. Contractor shall maintain barriers and  
barricades until "Phase 2 - Nāwiliwili  
Stream Bridge and Mauka Widening"  
begins.

APPROVED BY:

COUNTY ENGINEER, DEPARTMENT OF PUBLIC WORKS  
(FOR WORK IN THE COUNTY RIGHT-OF-WAY)



THIS WORK WAS PREPARED BY ME  
OR UNDER MY SUPERVISION AND  
CONSTRUCTION OF THIS PROJECT  
WILL BE UNDER MY OBSERVATION.

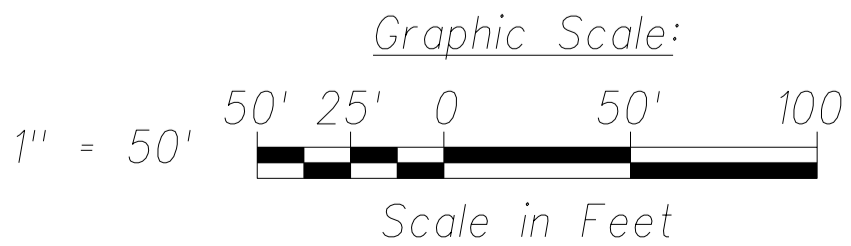

Signature: \_\_\_\_\_  
April 30, 2014  
EXPIRATION DATE  
OF THE LICENSE

STATE OF HAWAII  
DEPARTMENT OF TRANSPORTATION  
HIGHWAYS DIVISION

TRAFFIC CONTROL  
PLAN - 2

PHASE 1 - KAUMUALI'I HIGHWAY  
LIHU'E MILL BRIDGE TO RICE STREET  
PHASE 1 - HO'OMANA ROAD

Scale: As Shown Date: December 4, 2012  
SHEET No. C-41 OF 50 SHEETS

SURVEY PLOTTED BY	DATE
DRAWN BY	
DESIGNED BY	
QUANTITIES BY	
CHECKED BY	
ORIGINAL PLAN	
NOTE BOOK	
No.	