



FED. ROAD DIST. NO.	STATE	FED. AID PROJ. NO.	FISCAL YEAR	SHEET NO.	TOTAL SHEETS
HAWAII	HAW.	ARR-050-1(036)	FY13/14	Model	50

Note:  
1. See Landscape Drawing L-1 for Groundcover Requirements.

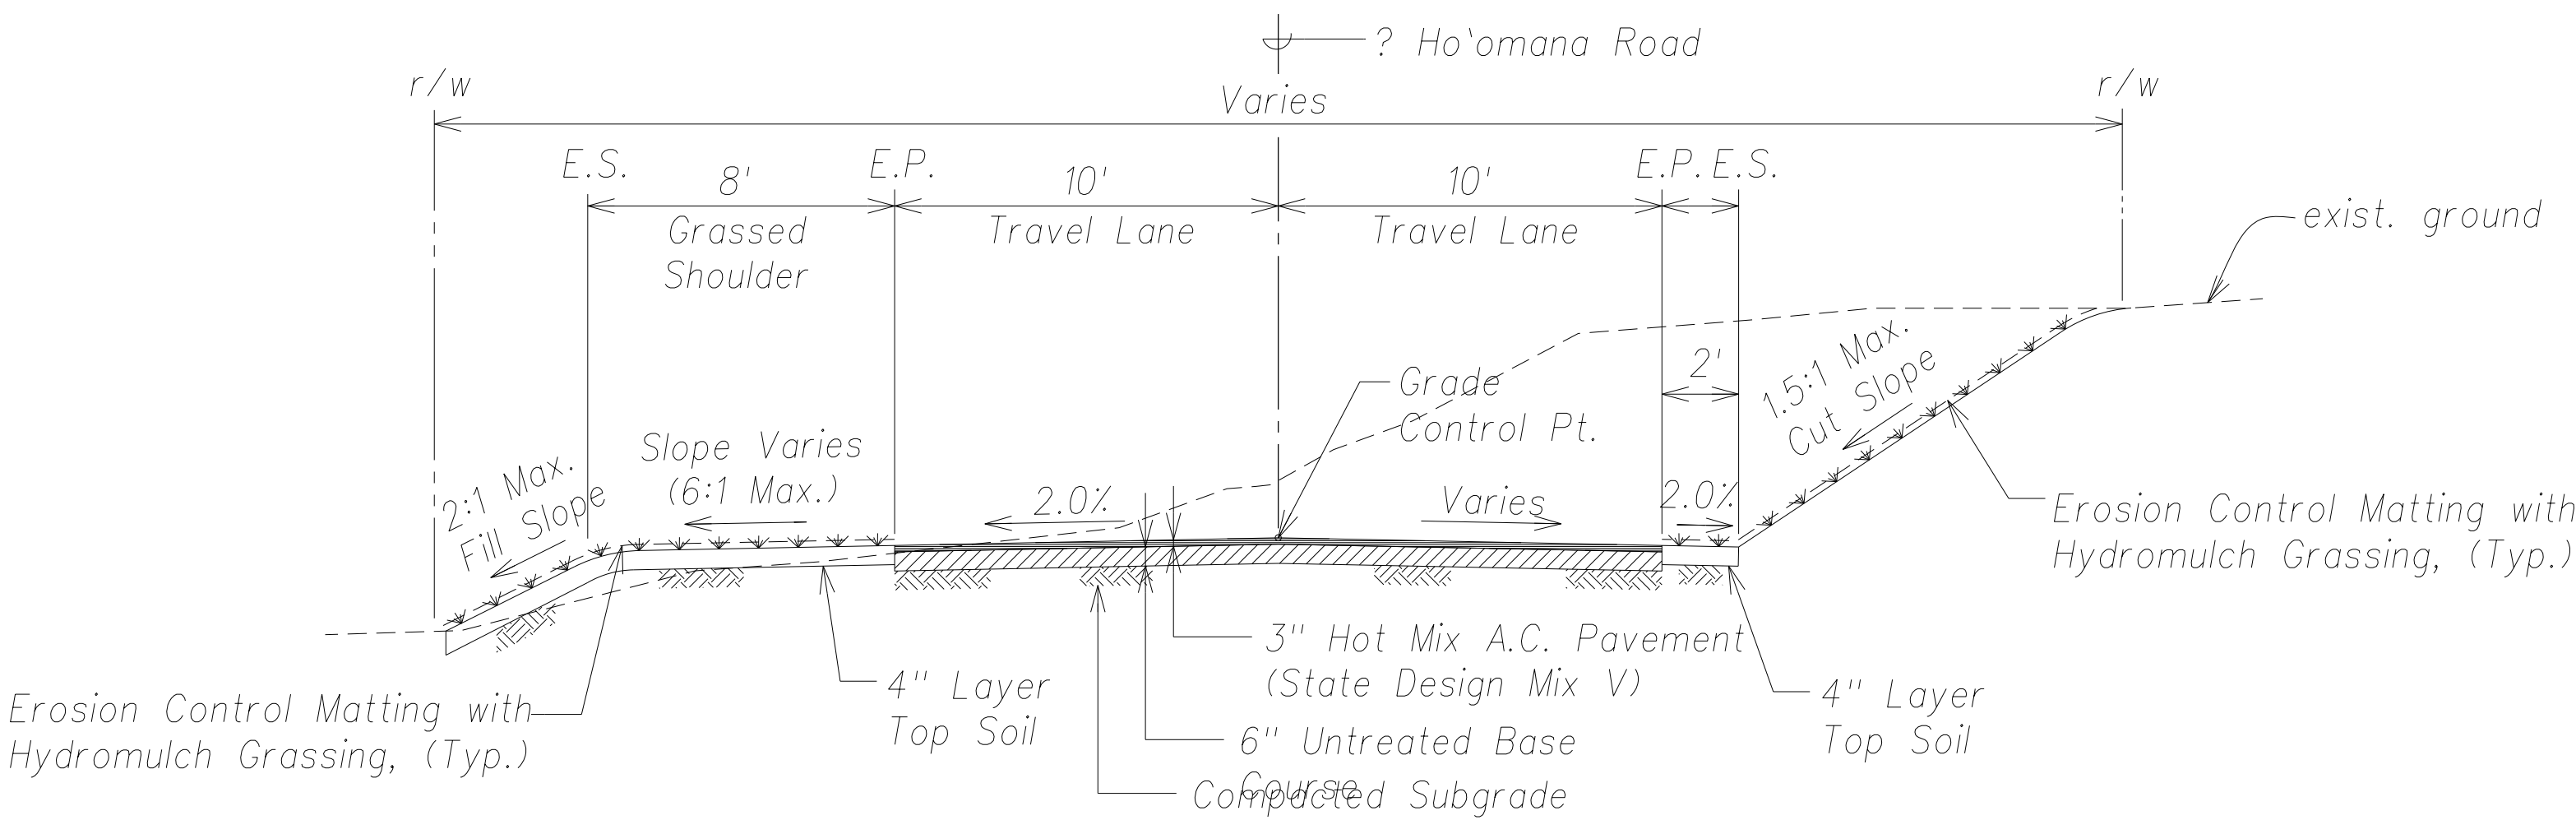


Typical Section - Ho'omana Road  
Sta. 6+00 To Sta. 6+62.61

Scale: 1" = 4'

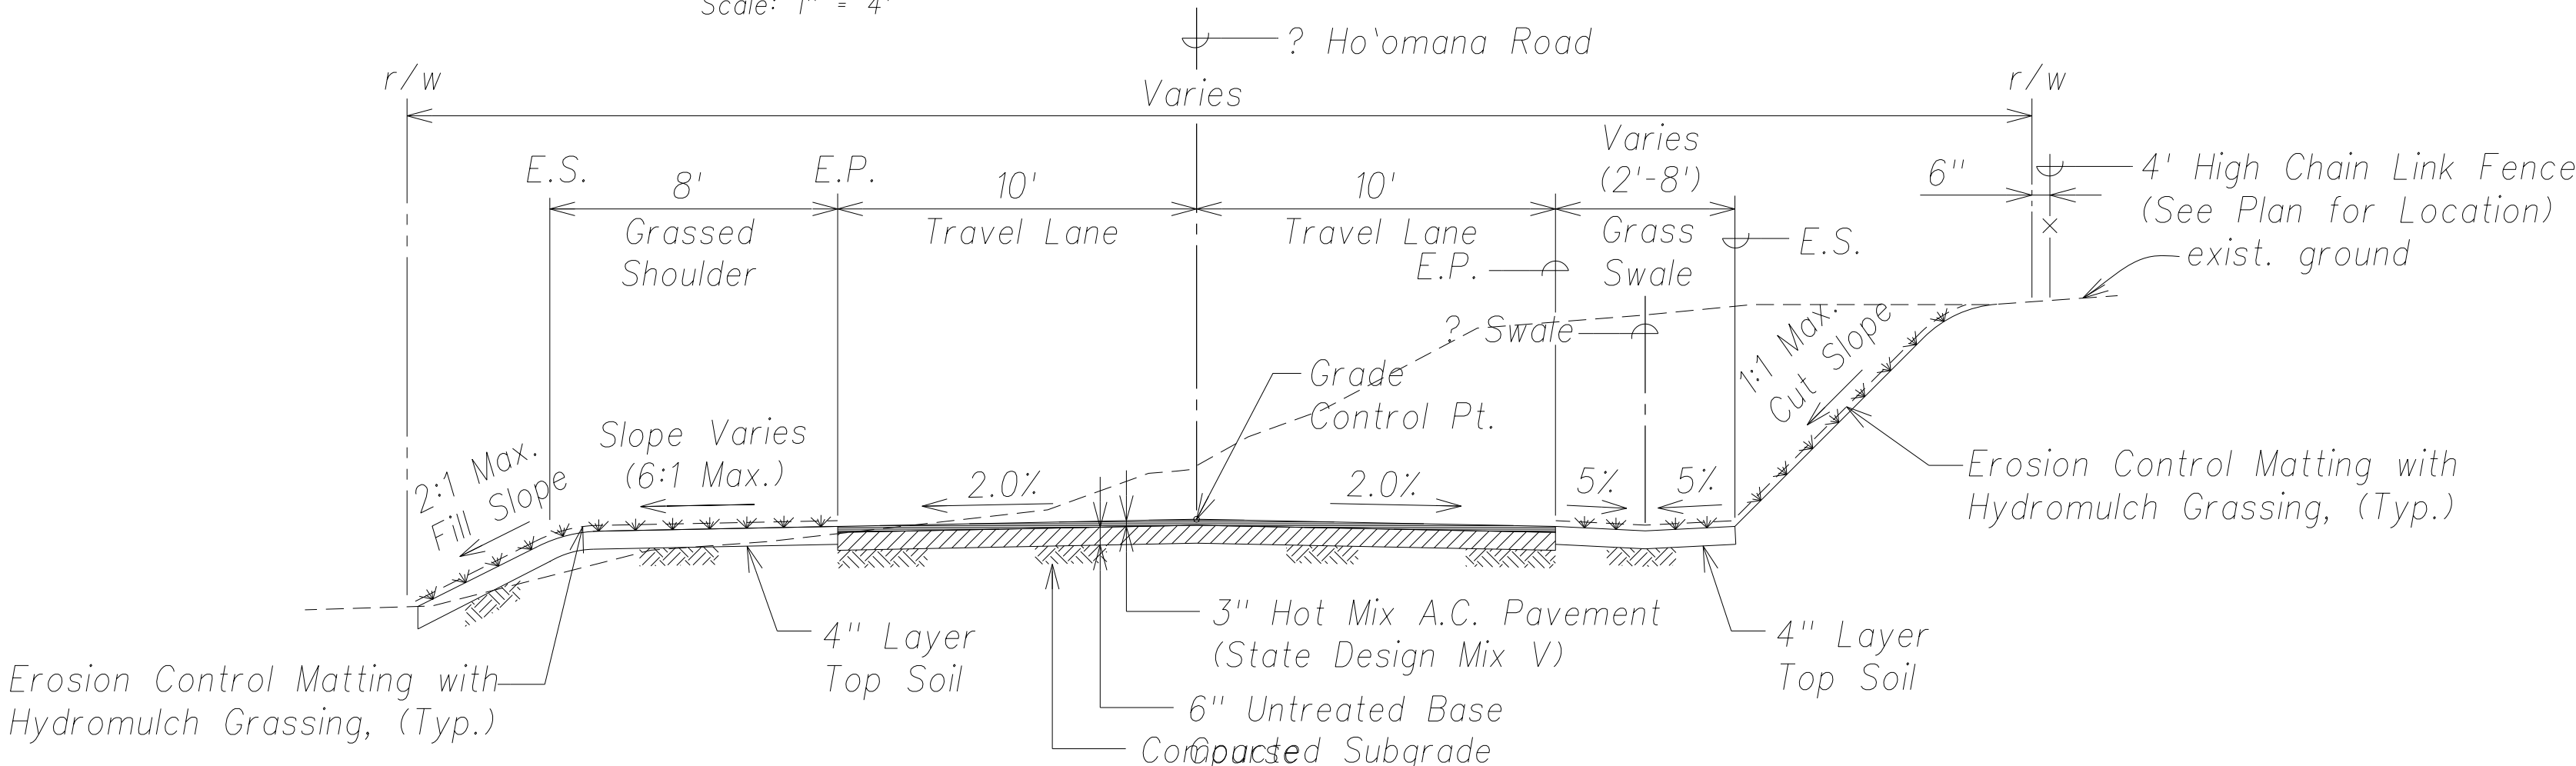


Typical Section - Ho'omana Road  
Sta. 5+59.14 To Sta. 6+00

Scale: 1" = 4'

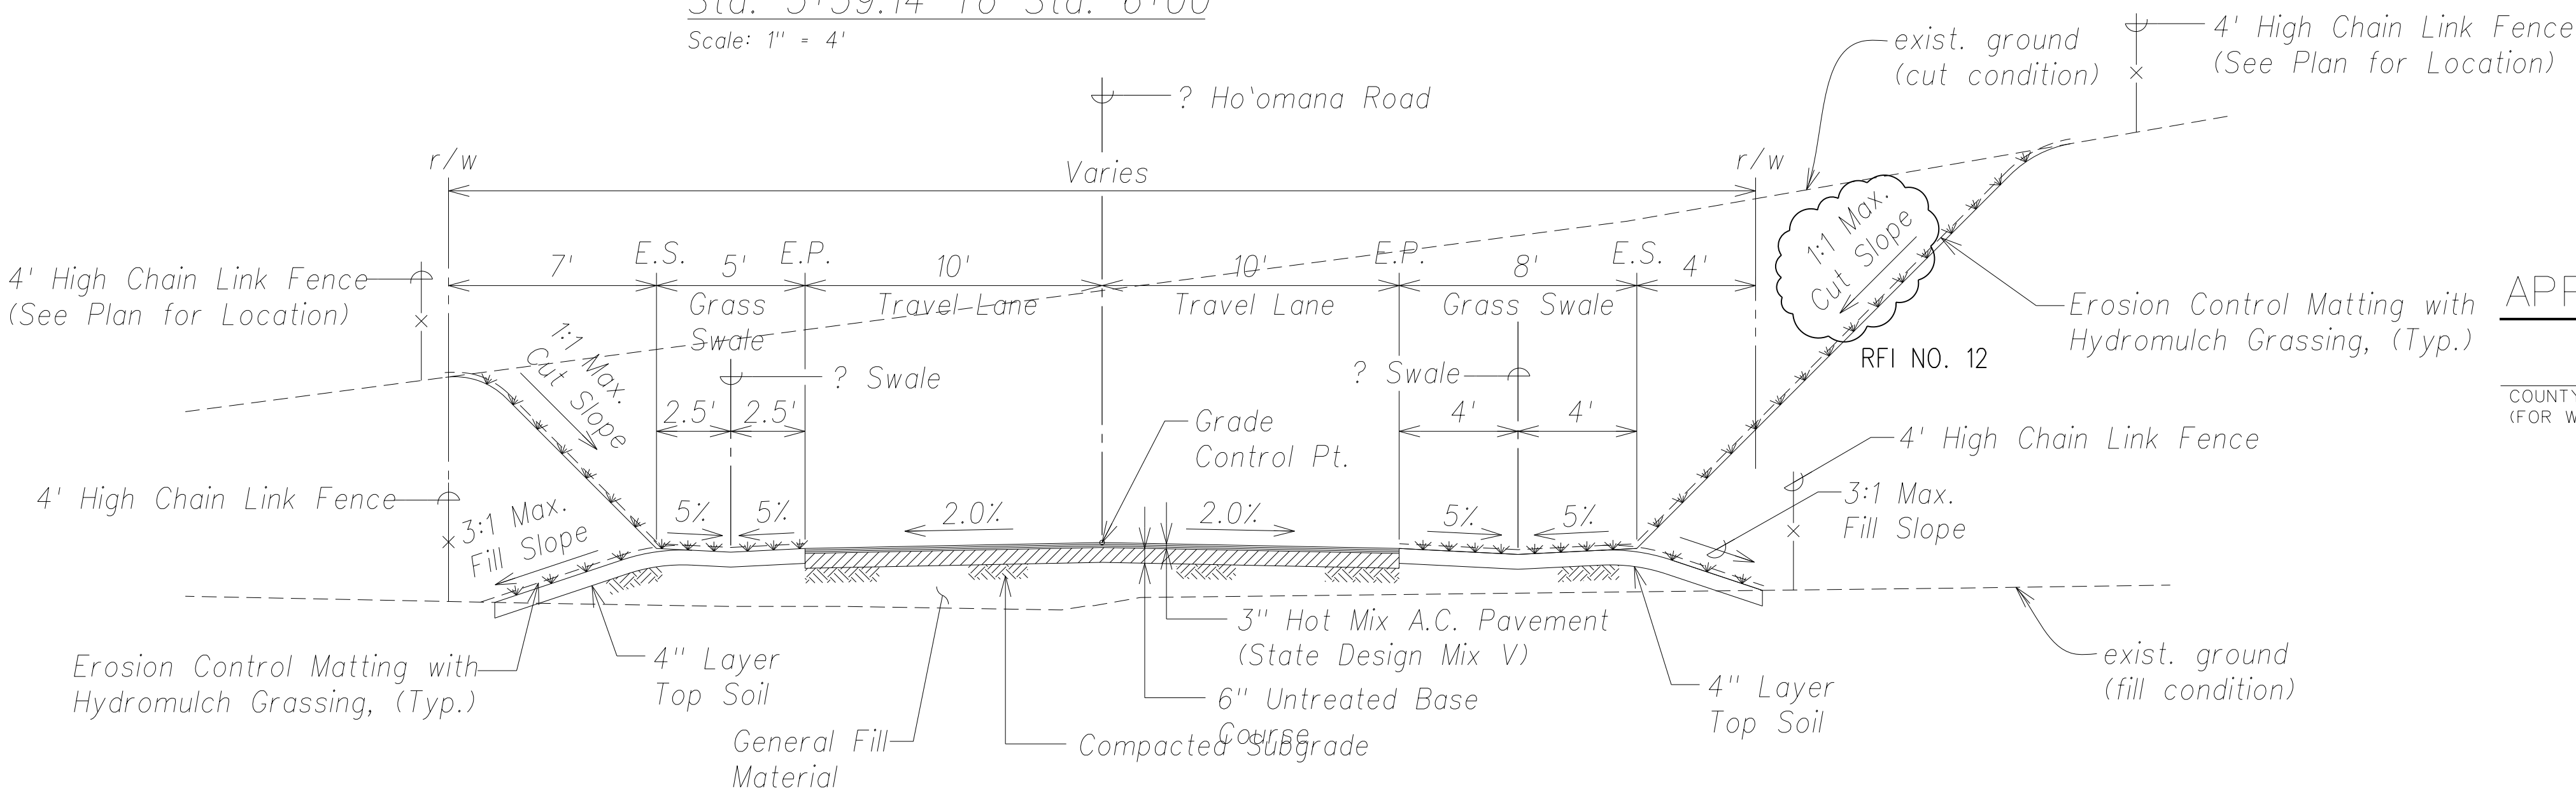


Typical Section - Ho'omana Road  
Sta. 2+18 To Sta. 5+59.14

Scale: 1" = 4'

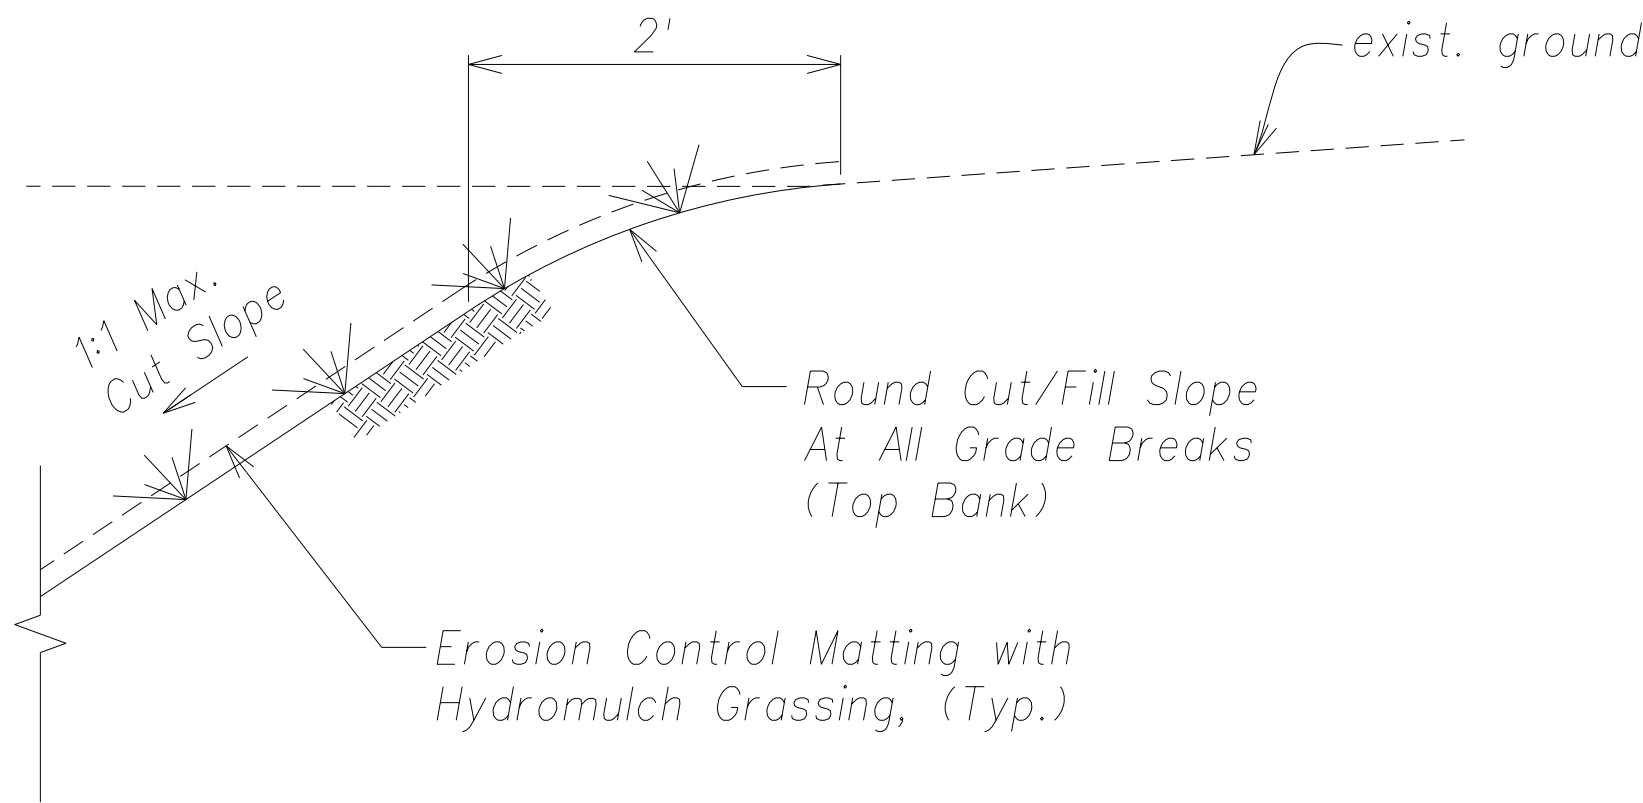

Typical Top Bank Rounding

Scale 1" = 1'

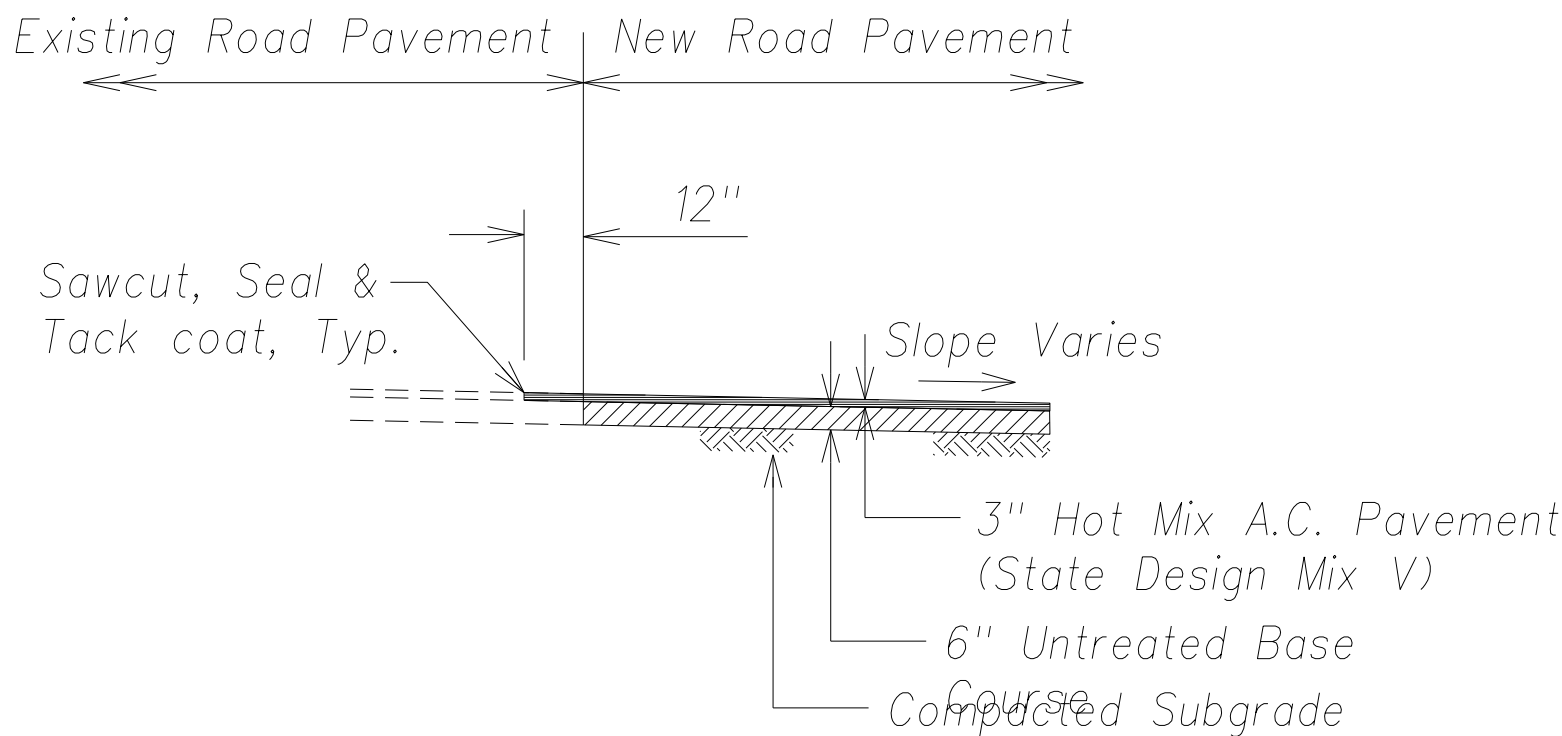

A.C. to A.C. Pavement Connection Detail

Not to Scale

LEGEND FOR  
AS-BUILT POSTINGS

- Squiggly line for as-built deletion
- Double line for as-built deletion
- Text for as-built posting

APPROVED BY:

COUNTY ENGINEER, DEPARTMENT OF PUBLIC WORKS  
(FOR WORK WITHIN THE COUNTY RIGHT-OF-WAY)

DATE



THIS WORK WAS PREPARED BY ME  
OR UNDER MY SUPERVISION AND  
CONSTRUCTION OF THIS PROJECT  
WILL BE UNDER MY OBSERVATION.

SIGNATURE  
April 30, 2014  
EXPIRATION DATE  
OF THE LICENSE

STATE OF HAWAII  
DEPARTMENT OF TRANSPORTATION  
HIGHWAYS DIVISION


TYPICAL SECTIONS - 1  
(HO'OMANA ROAD)

PHASE 1 - KAUMUALI'I HIGHWAY  
LIHU'E MILL BRIDGE TO RICE STREET  
PHASE 1 - HO'OMANA ROAD

Scale: As Shown Date: December 4, 2012

SHEET No. C-14 OF 50 SHEETS

Graphic Scale:

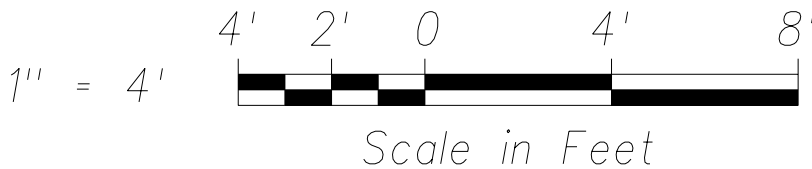


Scale in Feet


"AS-BUILT"

Model


FED. ROAD DIST. NO.	STATE	FED. AID PROJ. NO.	FISCAL YEAR	SHEET NO.	TOTAL SHEETS
HAWAII	HAW.	ARR-050-1(036)	FY13/14	Model	50

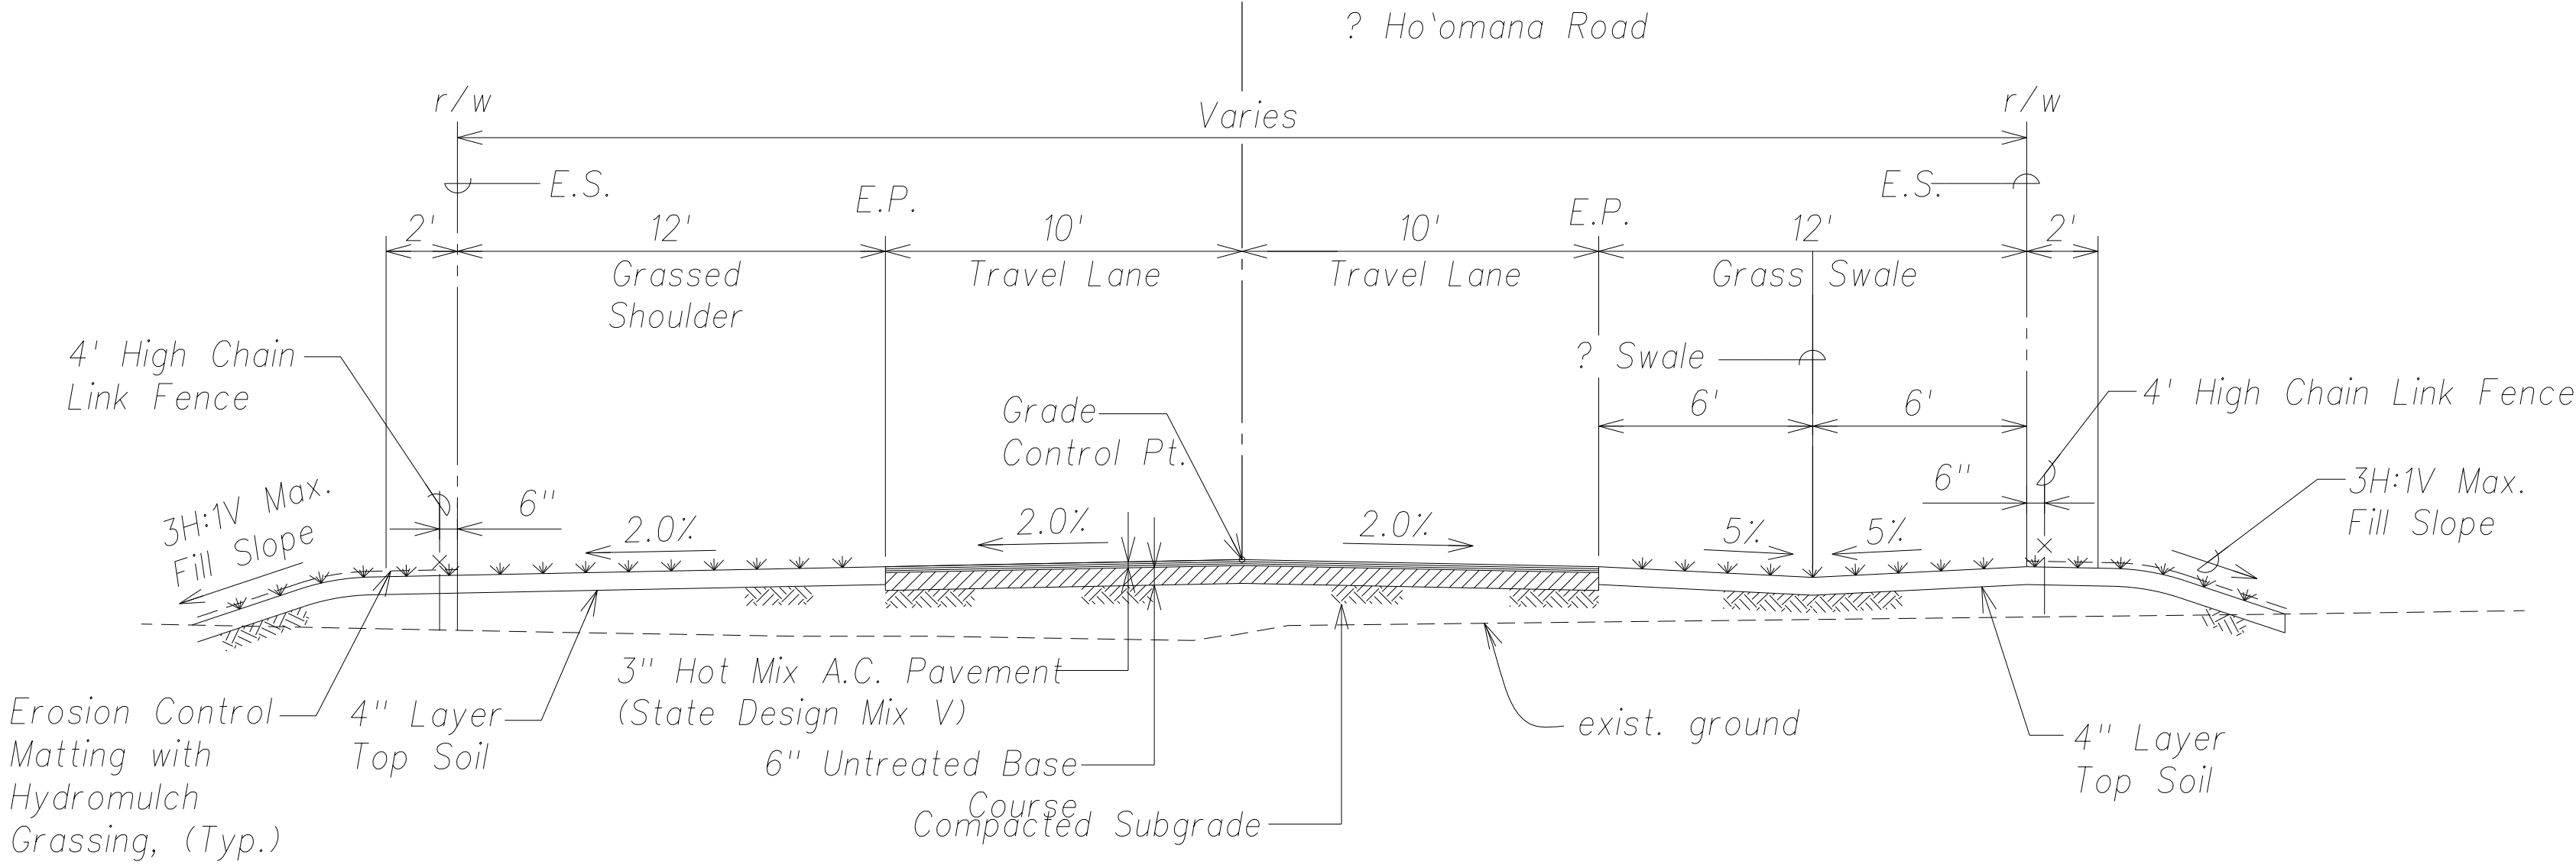

Typical Section - Ho'omana Road  
Left Shoulder Section Sta. 0+78.52 To Sta. 2+18  
Scale: 1" = 4'

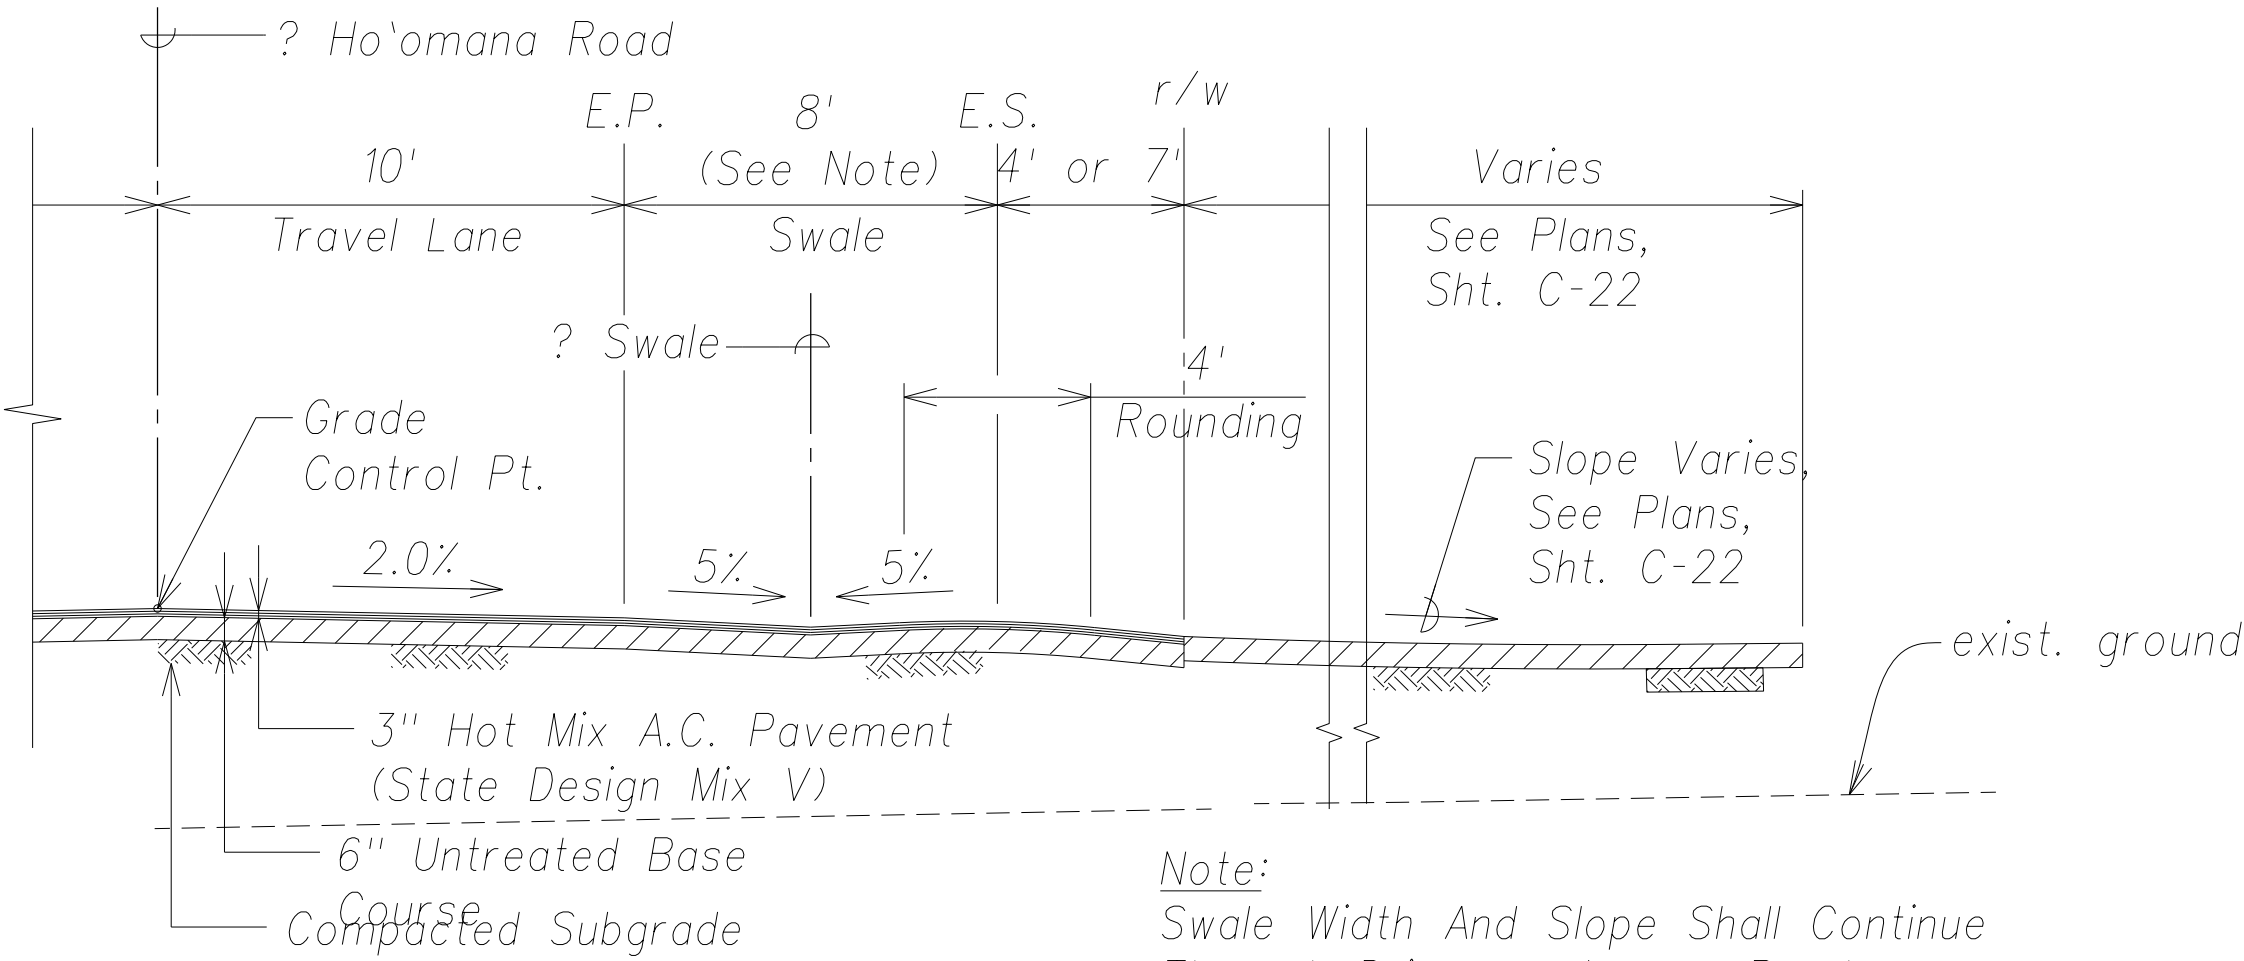


Typical Section - Ho'omana Road  
(Sta. 2+23.14 North Driveway Access Road)  
Scale: 1" = 4'

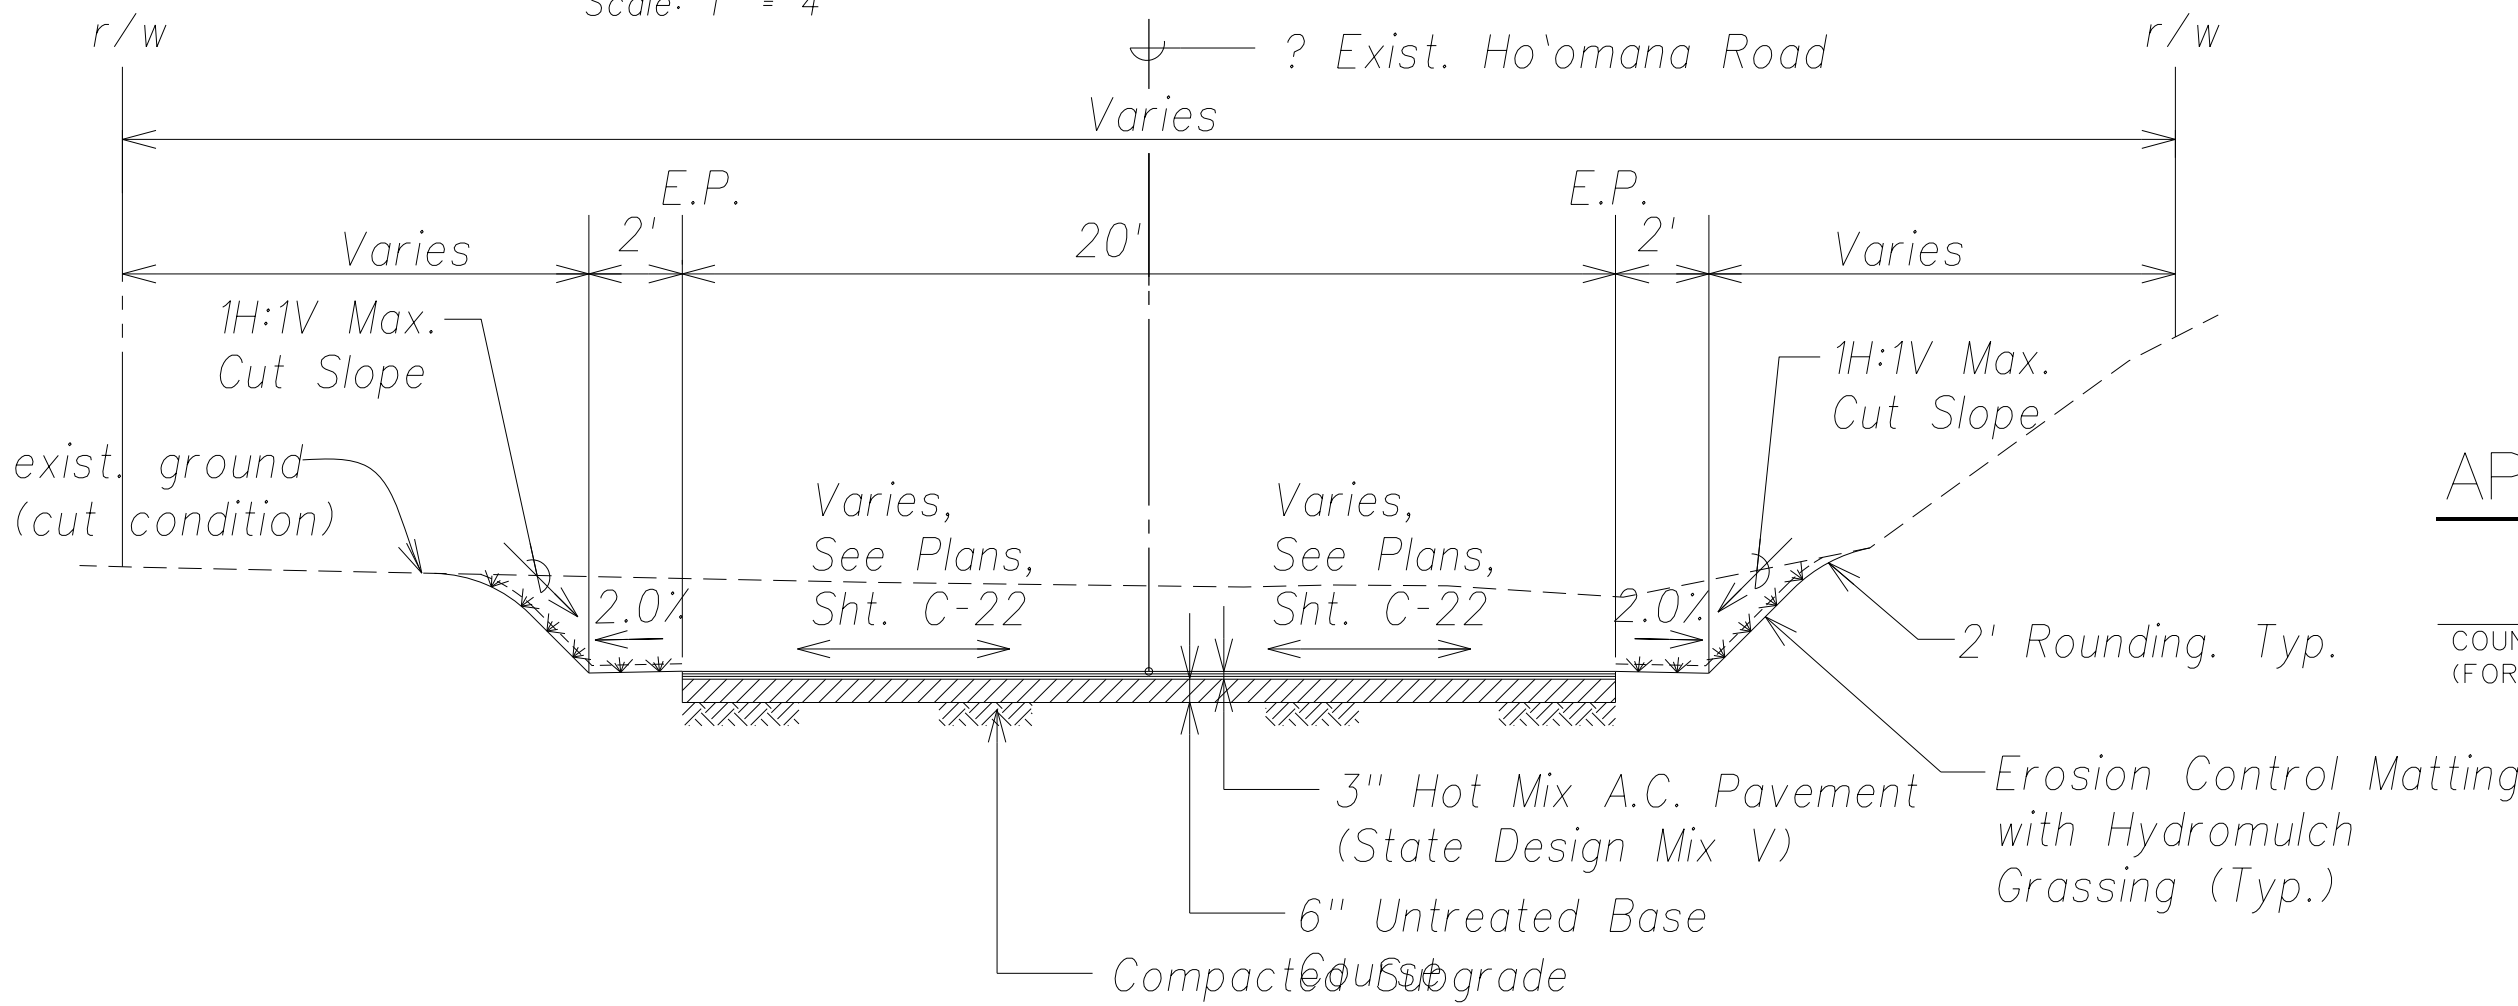


Typical Section - Exist. Ho'omana Road Access Road  
Scale: 1" = 4'

Note:  
1. See Landscape Drawing L-1  
for Groundcover Requirements.

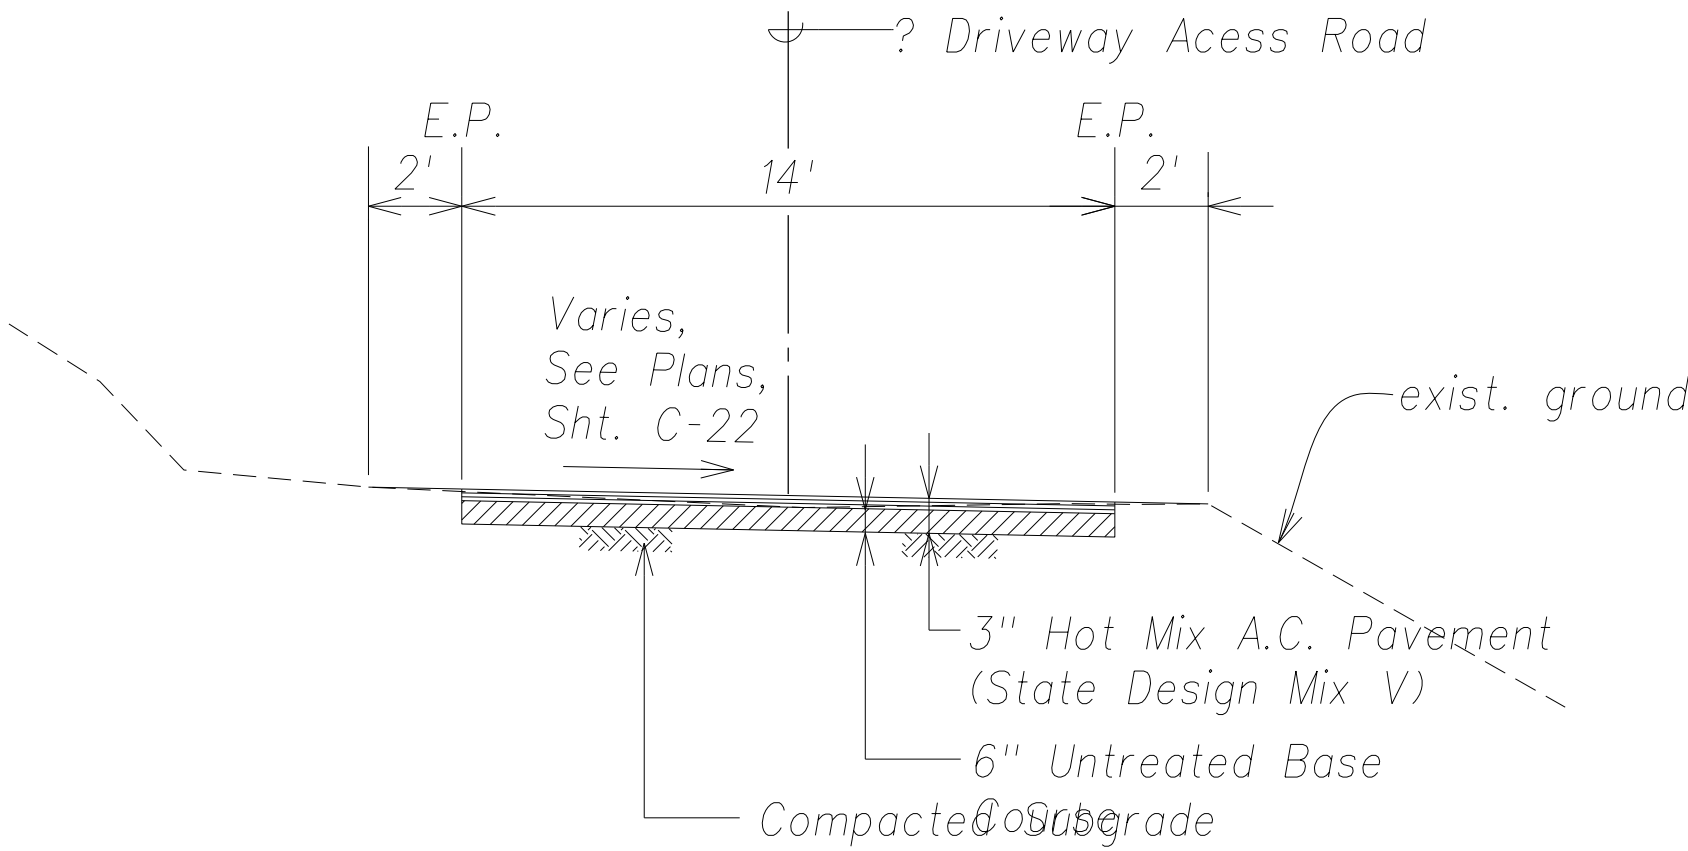

Typical Section - Driveway Access Road  
Scale: 1" = 4'

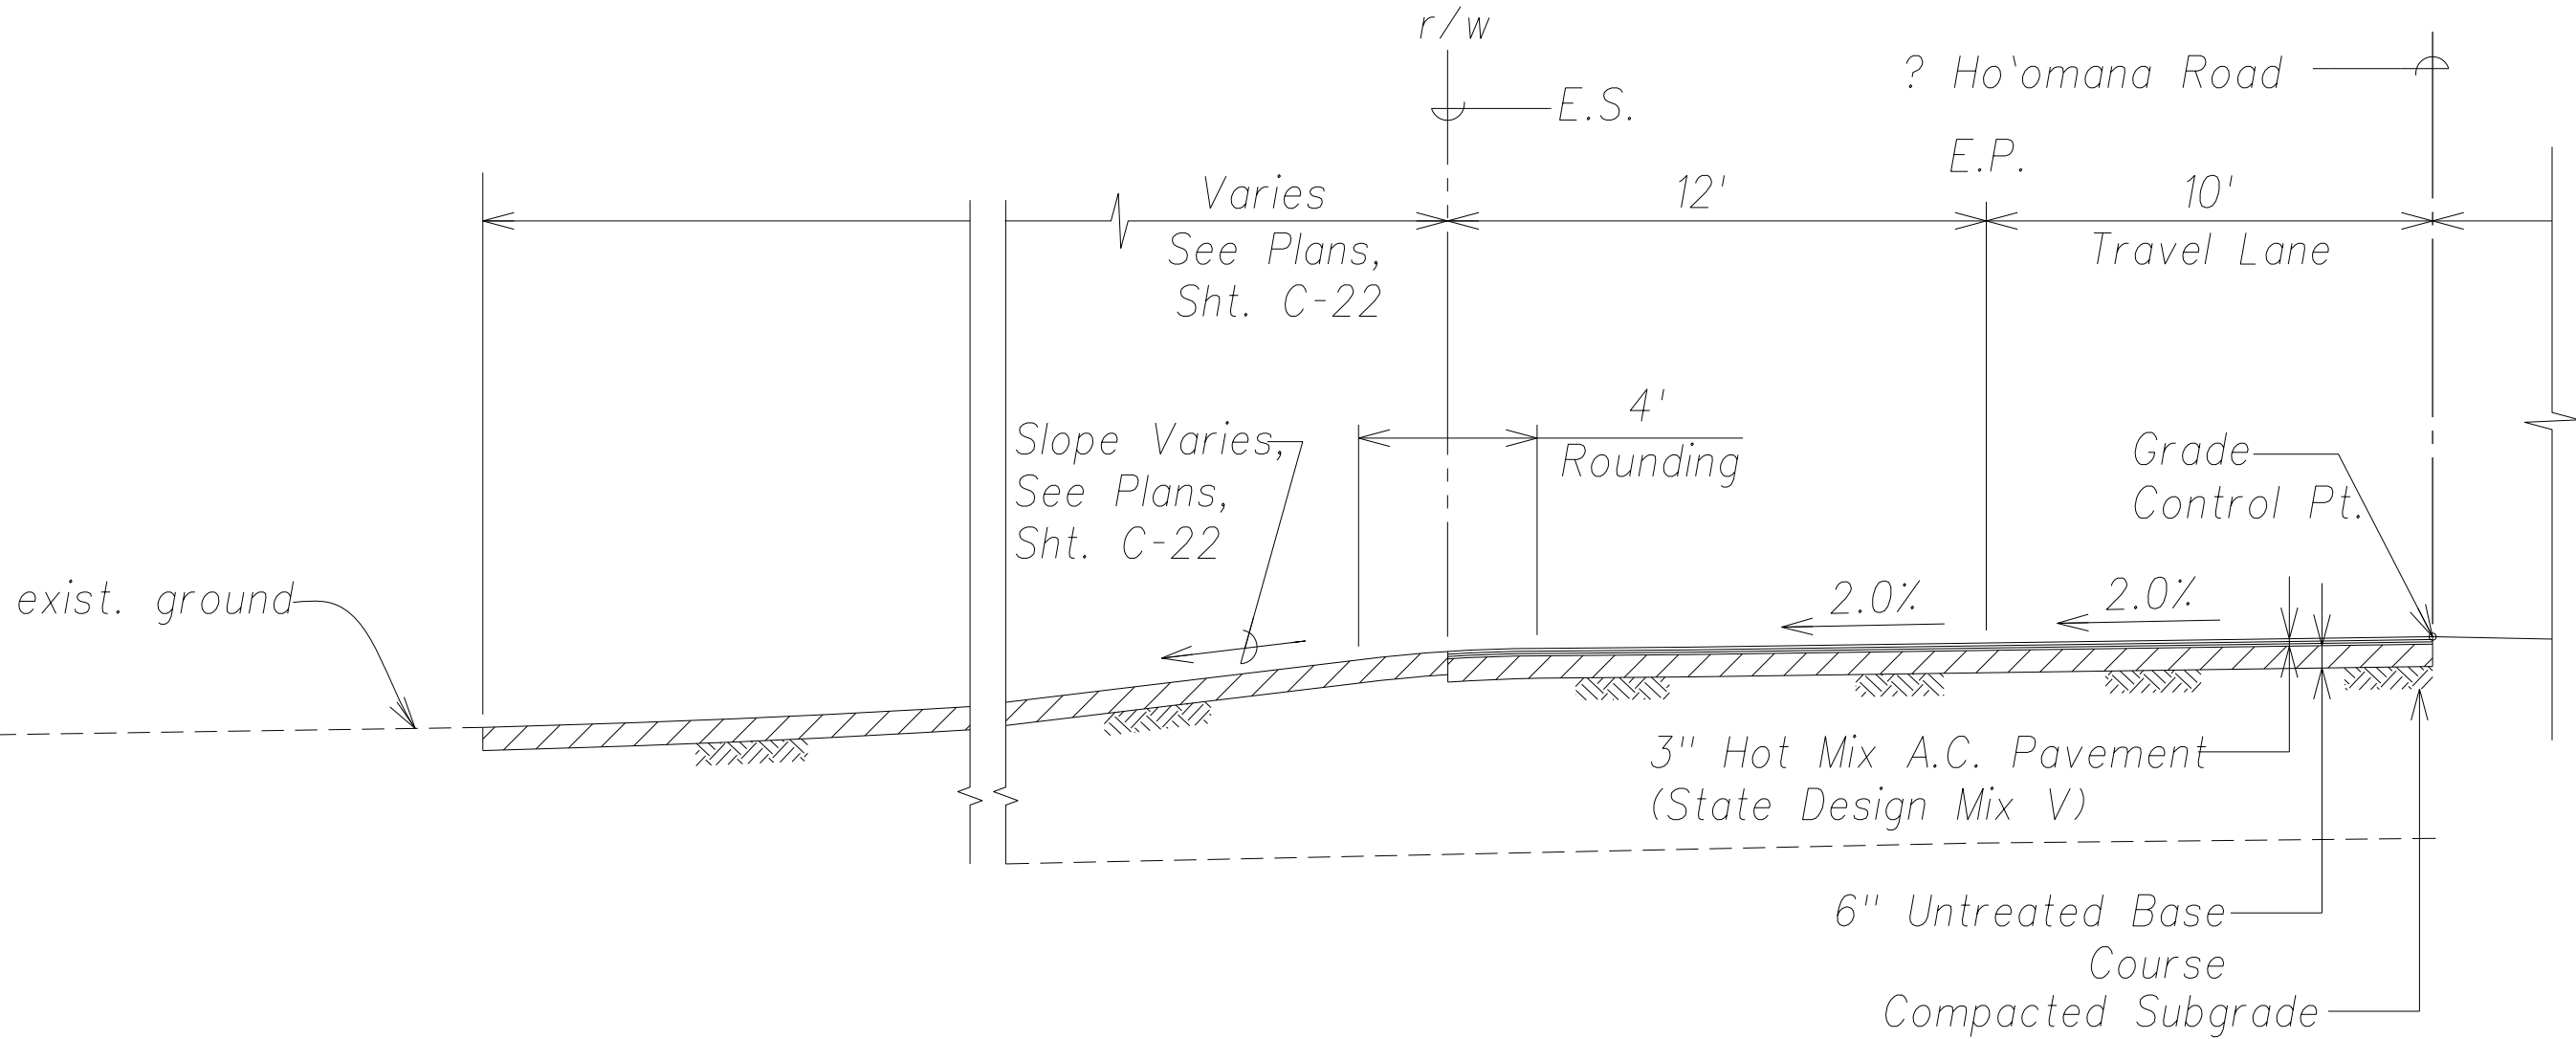

Typical Section - Ho'omana Road  
(Sta. 5+50.19 Exist. Ho'omana Access Road  
and Sta. 2+23.41 South Driveway Access Road)  
Scale: 1" = 4'

APPROVED BY:

COUNTY ENGINEER, DEPARTMENT OF PUBLIC WORKS  
(FOR WORK IN THE COUNTY RIGHT-OF-WAY)

DATE




THIS WORK WAS PREPARED BY ME  
OR UNDER MY SUPERVISION AND  
CONSTRUCTION OF THIS PROJECT  
WILL BE UNDER MY OBSERVATION.

SIGNATURE

April 30, 2014  
EXPIRATION DATE  
OF THE LICENSE

Graphic Scales:

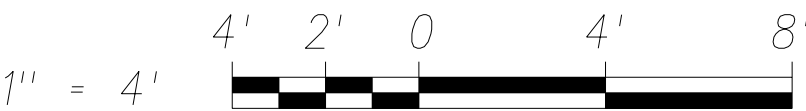

Scale in Feet

STATE OF HAWAII  
DEPARTMENT OF TRANSPORTATION  
HIGHWAYS DIVISION

TYPICAL SECTIONS - 2  
(HO'OMANA ROAD)

PHASE 1 - KAUMUALI'I HIGHWAY  
LIHU'E MILL BRIDGE TO RICE STREET  
PHASE 1 - HO'OMANA ROAD

Scale: As Shown

Date: December 4, 2012

SHEET No. C-15 OF 50 SHEETS

"AS-BUILT"

Model