


FED. ROAD DIST. NO.	STATE	FED. AID PROJ. NO.	FISCAL YEAR	SHEET NO.	TOTAL SHEETS
HAWAII	HAW.	ARR-050-11036)	FY13/14	MODEL	131

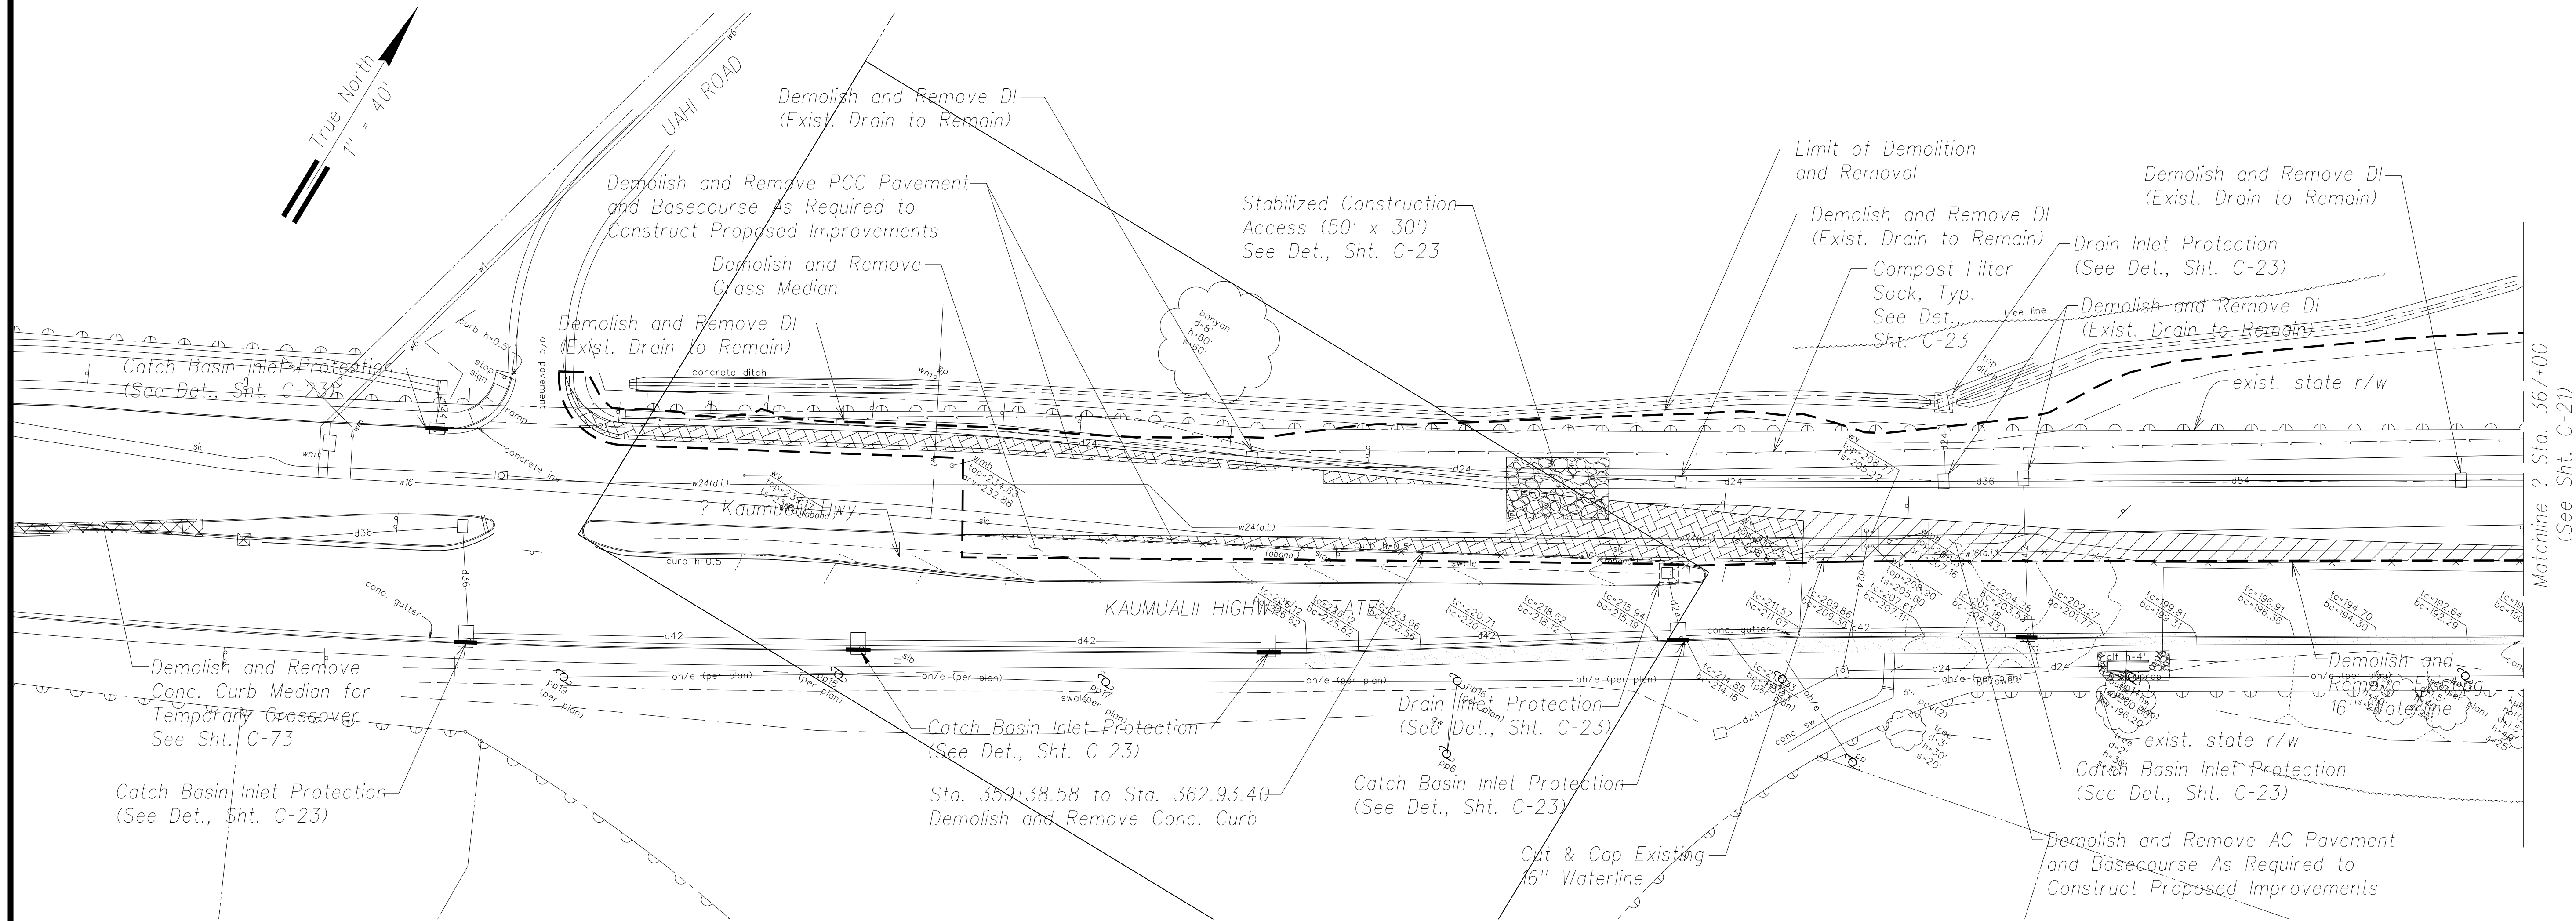

Demolition and Erosion Control Plan - (Begin Project to Sta. 367+00)
Scale: 1" = 40'

Legend:

- Limits of Demolition and Removal
- ☒ Drain Inlet Protection
- Compost Filter Sock (or Approved Equal)
- ☐ Catch Basin Inlet Protection
- ▨ Demolish and Remove
- ▧ Demolish and Remove PCC Pavement
- ▩ Demolish and Remove AC Pavement
- x— Demolish and Remove Exist. Curb or Utility

Notes:

- See Electrical Dwg. for demolition and relocation of electrical improvements.
- Vehicles are allowed to drive over compost filter sock.
- See Sht. C-23 for Erosion Control Details.
- Contractor shall sawcut all curbs, gutters and pavements prior to removal.
- See Signing and Pavement Marking Plans for sign removal or relocation.
- Remove Pavement Striping As Required to Construct Temporary Improvements. See Sht. C-73.


APPROVED BY:

MANAGER AND CHIEF ENGINEER, DEPARTMENT OF WATER, COUNTY OF KAUAI DATE



THIS WORK WAS PREPARED BY ME OR UNDER MY SUPERVISION AND CONSTRUCTION OF THIS PROJECT WILL BE UNDER MY OBSERVATION.

SIGNATURE EXPIRATION DATE OF THE LICENSE

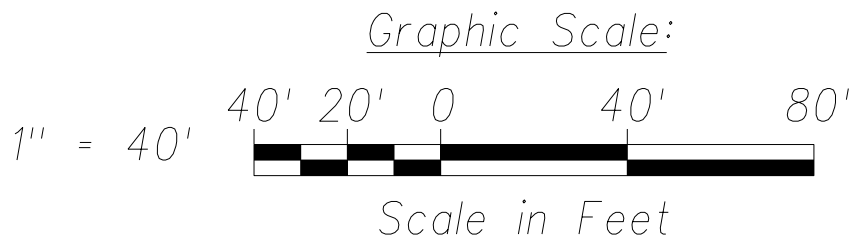

STATE OF HAWAII
DEPARTMENT OF TRANSPORTATION
HIGHWAYS DIVISION

DEMOLITION AND EROSION CONTROL PLAN

PHASE 1 - KAUMUALII HIGHWAY
LIHUE MILL BRIDGE TO RICE STREET
PHASE 2 - NAWILIWILI STREAM BRIDGE
AND MAUKA WIDENING


Scale: As Shown Date: March 25, 2013
SHEET No. C-20 OF 84 SHEETS

ORIGINAL PLAN	SURVEY PLOTTED BY	DATE
	DRAWN BY	
	DESIGNED BY	
	CHECKED BY	
NOTE BOOK	No.	

"AS-BUILT"

MODEL

FED. ROAD DIST. NO.	STATE	FED. AID PROJ. NO.	FISCAL YEAR	SHEET NO.	TOTAL SHEETS
HAWAII	HAW.	ARR-050-1(036)	FY13/14	Model	131

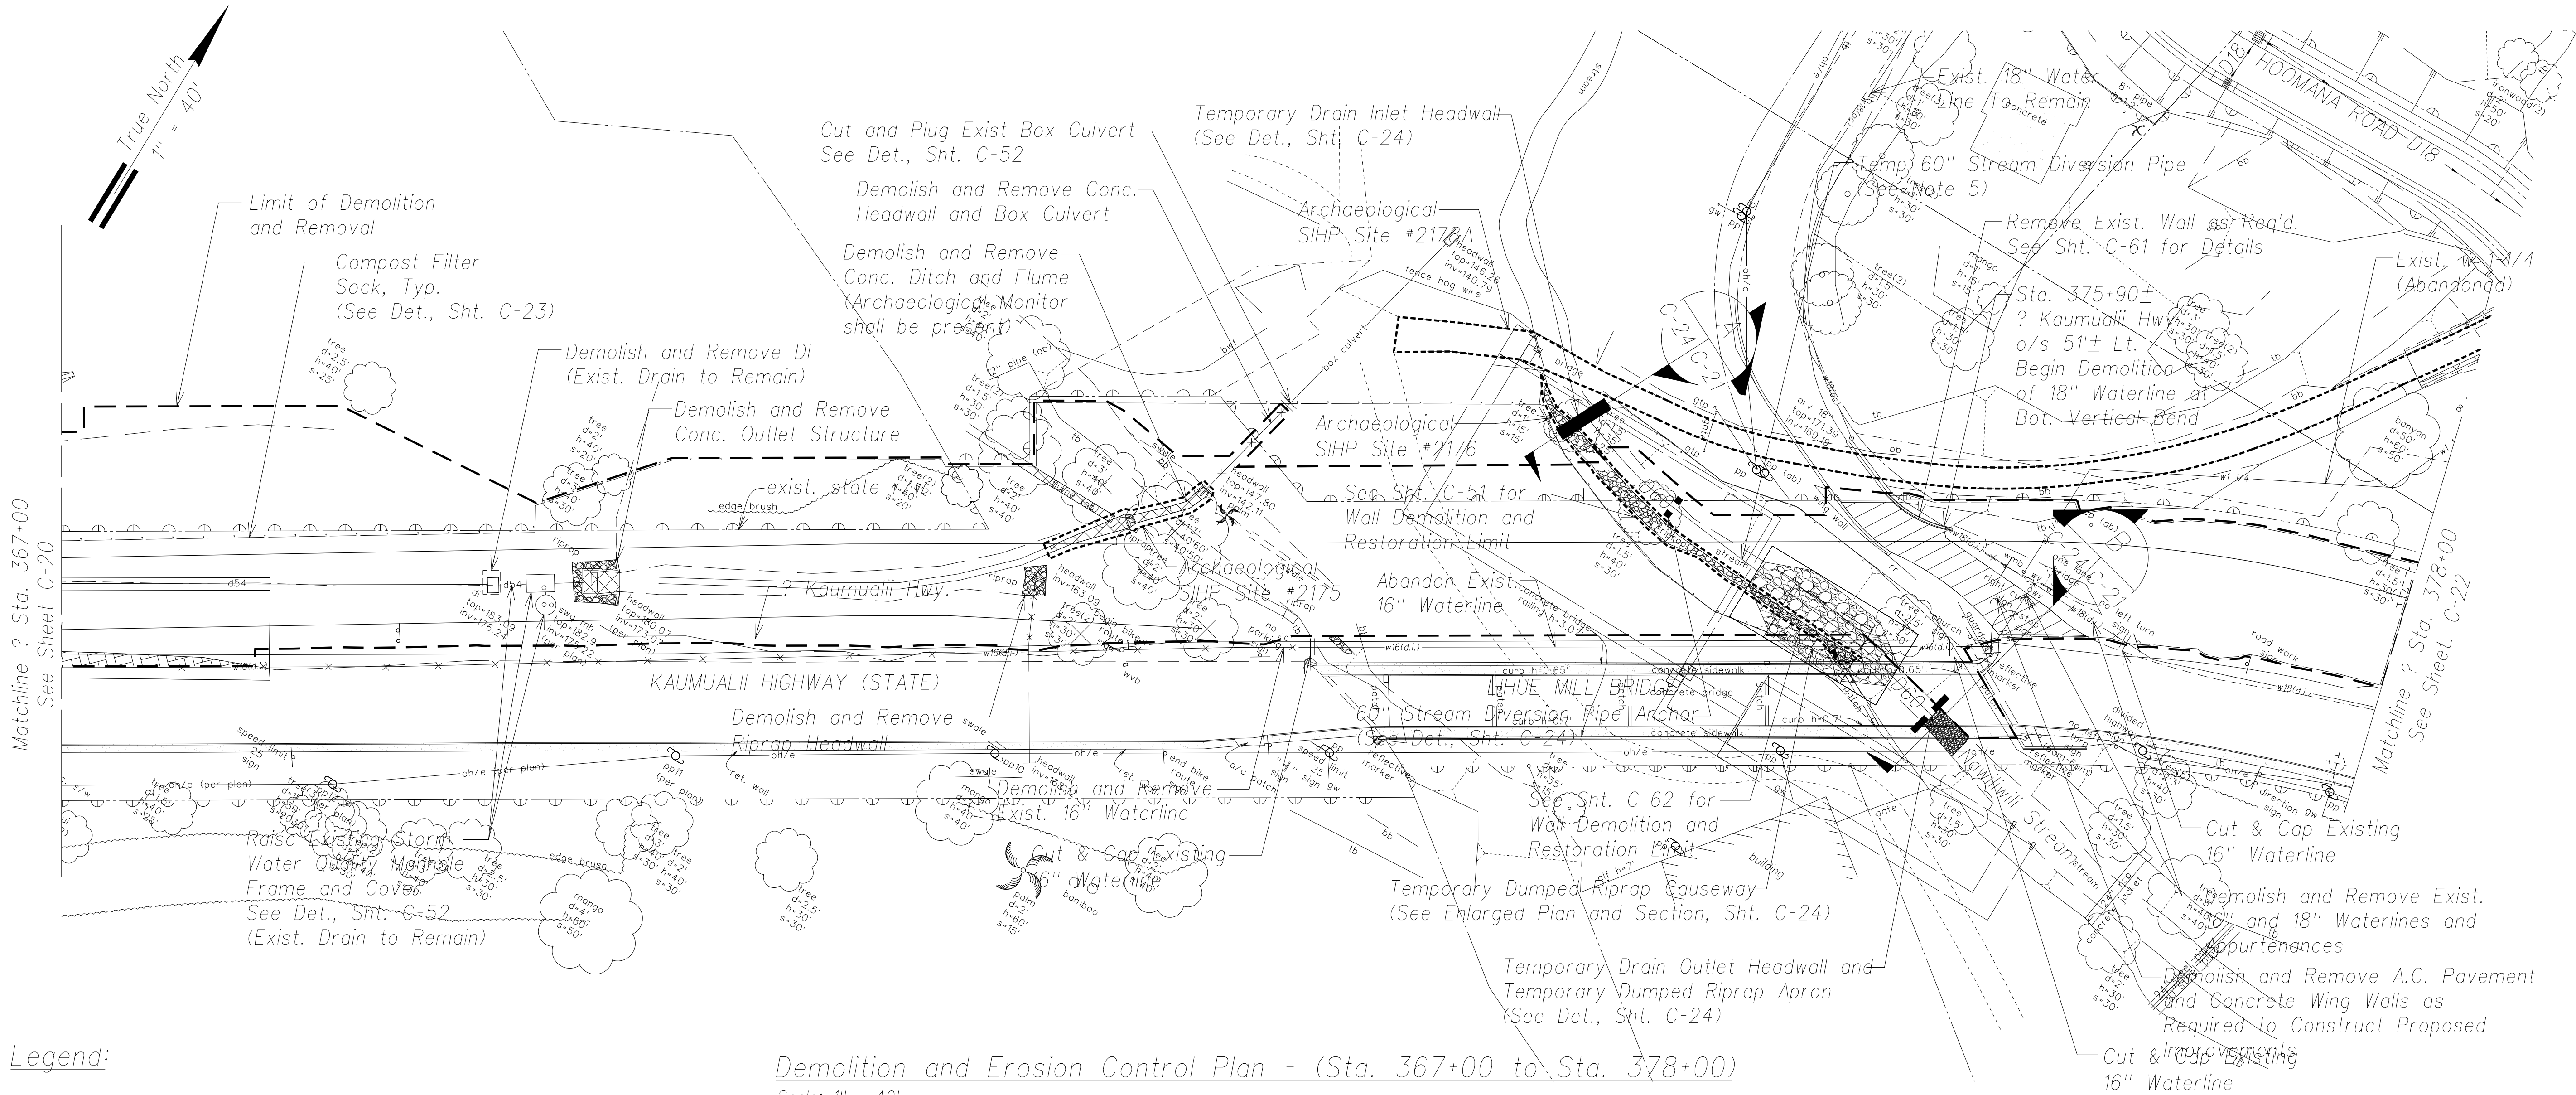

Legend:

- Limits of Demolition and Removal
- Limits of State Inventory of Historic Places (SIHP) Site
- ☐ Drain Inlet Protection
- Compost Filter Sock (or Approved Equal)
- ☐ Catch Basin Inlet Protection
- ☐ Demolish and Remove
- ☐ Demolish and Remove PCC Pavement
- ☐ Demolish and Remove AC Pavement
- Demolish and Remove Exist. Curb or Utility
- × Demolish and Remove Exist. Tree or Obstruction

Demolition and Erosion Control Plan - (Sta. 367+00 to Sta. 378+00)

Scale: 1" = 40'

Notes:

- See Electrical Dwg. for demolition and relocation of electrical improvements.
- Vehicles are allowed to drive over compost filter sock.
- See Sht. C-23 for Erosion Control Details.
- Contractor shall sawcut all curbs, gutters and pavements prior to removal.
- Contractor shall install temporary 60" HDPE drain for stream diversion in the general vicinity shown. Field adjustments shall be made as necessary.
- See Signing and Pavement Marking Plans for sign removal or relocation.
- Remove Pavement Striping As Required to Construct Temporary Improvements. See Sht. C-74.
- SIHP site subject to monitoring, data recovery, preservation and/or demolition in accordance with an approved Archaeological Monitoring Plan and Archaeological Preservation Plan.

APPROVED BY:

MANAGER AND CHIEF ENGINEER, DEPARTMENT OF WATER, COUNTY OF KAUAI DATE




THIS WORK WAS PREPARED BY ME OR UNDER MY SUPERVISION AND CONSTRUCTION OF THIS PROJECT WILL BE UNDER MY OBSERVATION.

SIGNATURE April 30, 2016 EXPIRATION DATE OF THE LICENSE

STATE OF HAWAII
DEPARTMENT OF TRANSPORTATION
HIGHWAYS DIVISION
DEMOLITION AND EROSION CONTROL PLAN
PHASE 1 - KAUMUALII HIGHWAY
LIHUE MILL BRIDGE TO RICE STREET
PHASE 2 - NAWILIILI STREAM BRIDGE
AND MAUKA WIDENING


Scale: As Shown Date: March 25, 2013
SHEET No. C-21 OF 84 SHEETS

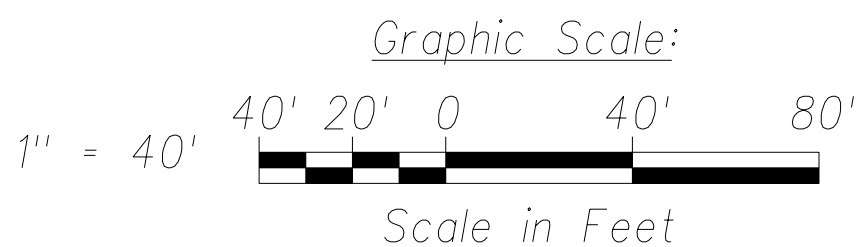

"AS-BUILT"

MODEL

FED. ROAD DIST. NO.	STATE	FED. AID PROJ. NO.	FISCAL YEAR	SHEET NO.	TOTAL SHEETS
HAWAII	HAW.	ARR-050-1(036)	FY13/14	MODEL	131

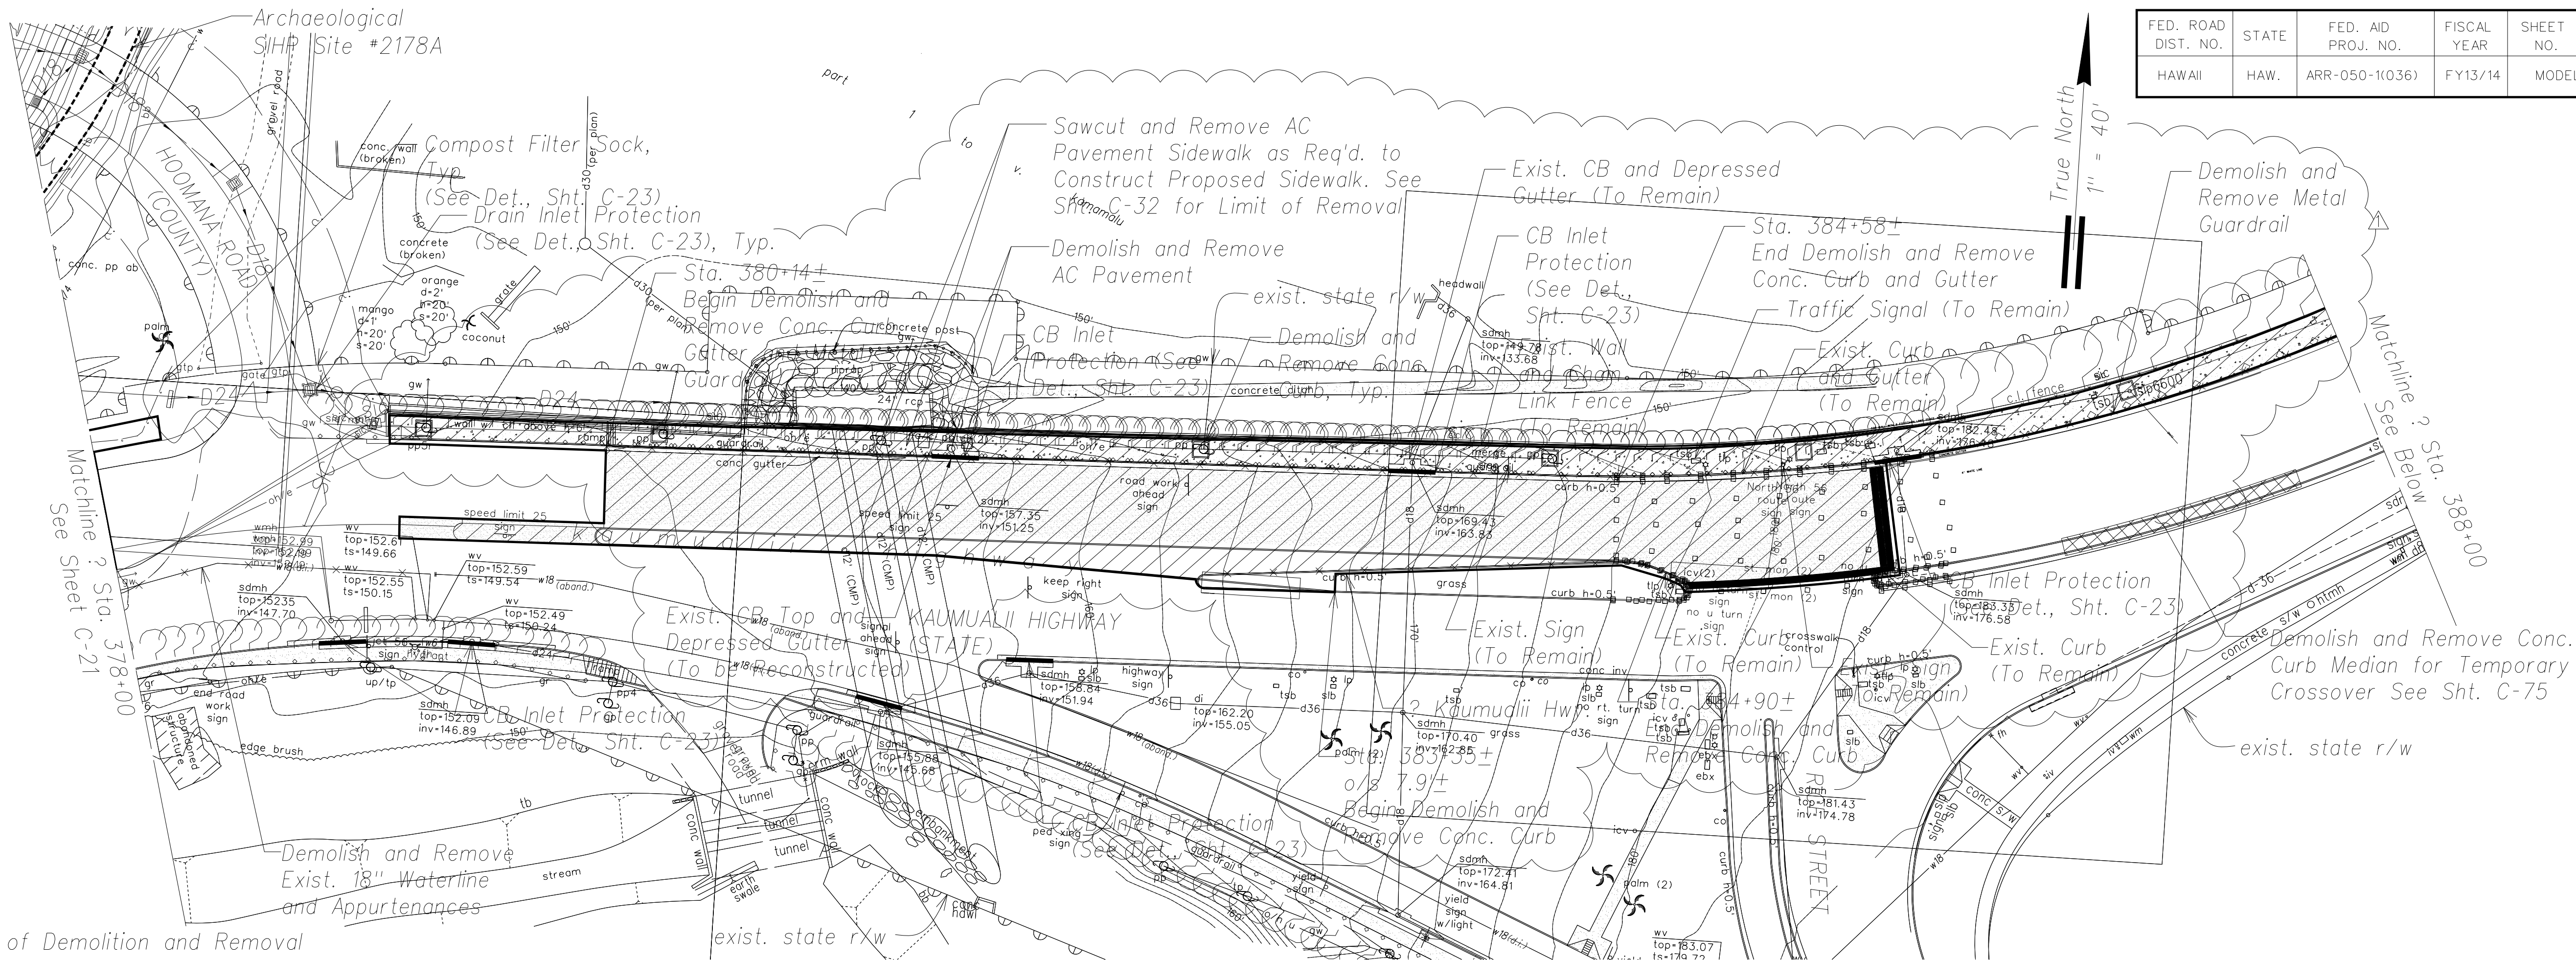


Legend:

- Limits of Demolition and Removal
- - - Limits of State Inventory of Historic Places (SIHP) Site
- Drain Inlet Protection
- ▣ Compost Filter Sock (or Approved Equal)
- Catch Basin Inlet Protection
- Demolish and Remove
- Demolish and Remove PCC Pavement
- Demolish and Remove AC Pavement
- Demolish and Remove Exist. Curb or Utility
-
-


Notes:

- Excess cold planed material not being reused on site to be property of HDOT and shall be stockpiled at the Lihue Airport stockpile area.
- See Electrical Dwg's. for demolition and relocation of electrical improvements.
- Vehicles are allowed to drive over compost filter sock.
- See Sht. C-23 for Erosion Control Details.
- Contractor shall sawcut all curbs, gutters and pavements prior to removal.
- See Signing and Pavement Marking Plans for sign removal or relocation.
- Remove Pavement Striping As Required to Construct Temporary Improvements. See Sht. C-74 and C-75.
- SIHP site subject to monitoring, data recovery, preservation and/or demolition in accordance with an approved Archaeological Monitoring Plan and Archaeological Preservation Plan.

Demolition and Erosion Control Plan - (Sta. 378+00 to Sta. 388+00)
Scale: 1" = 40'

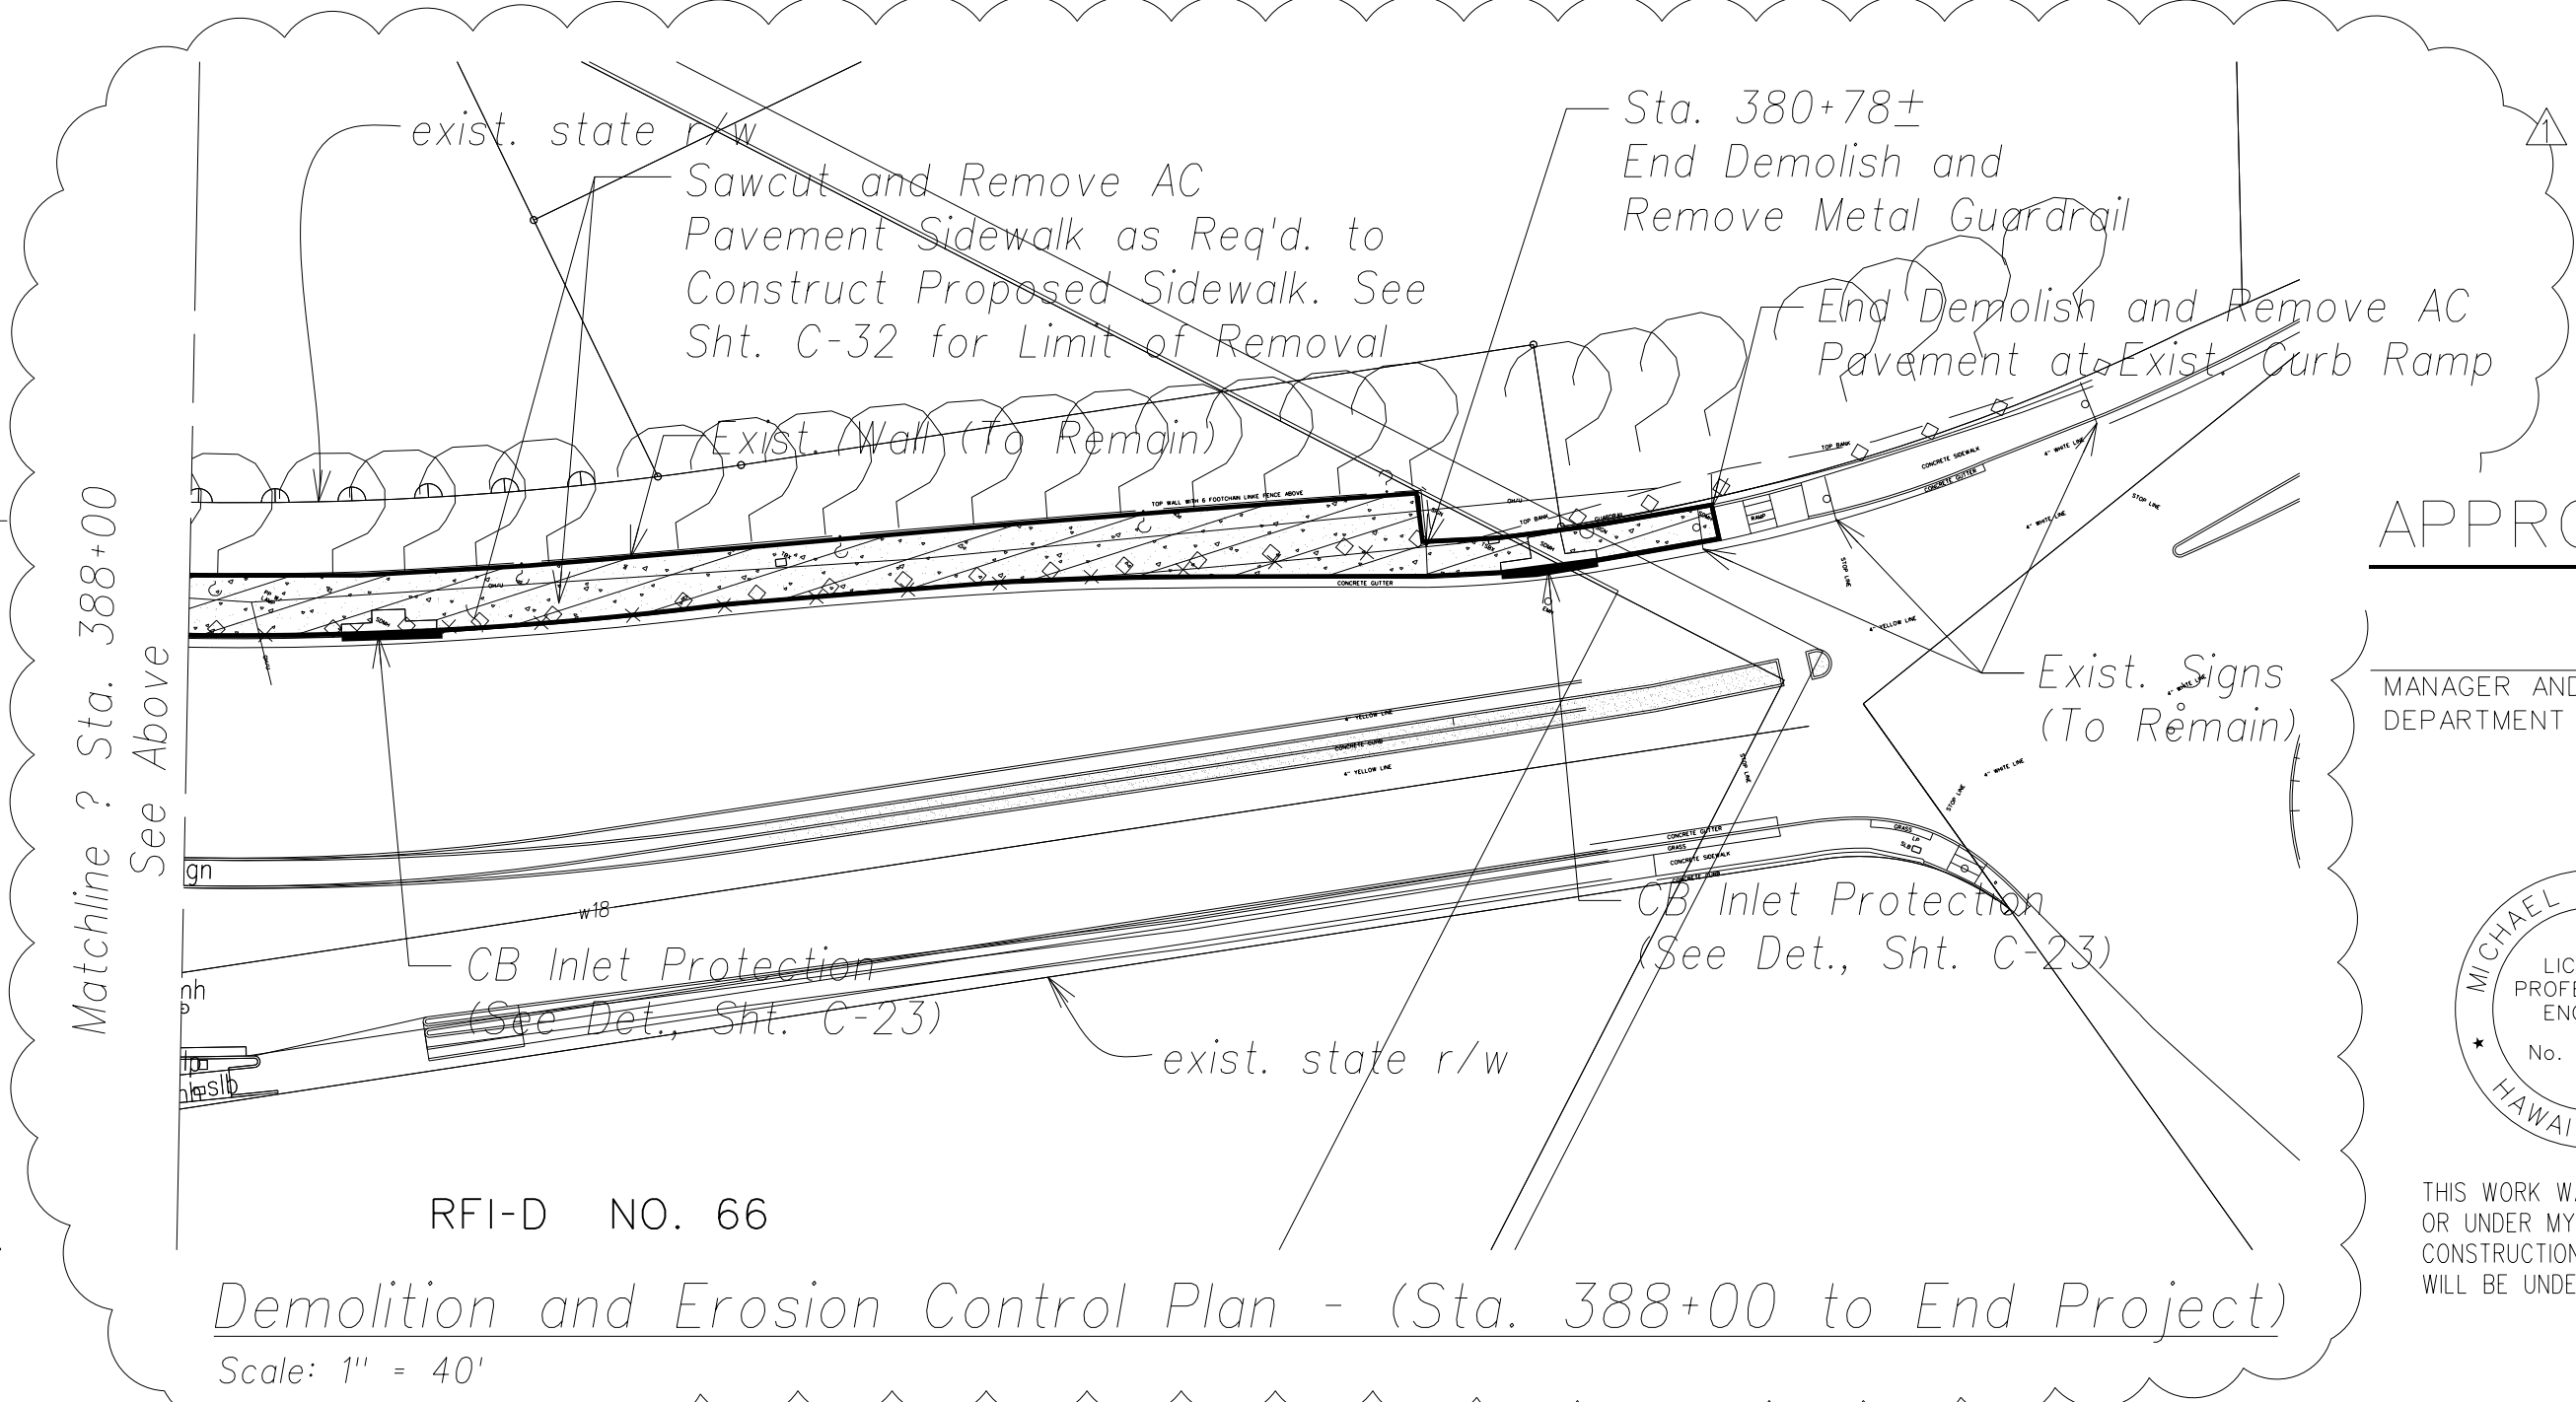

Demolition and Erosion Control Plan - (Sta. 388+00 to End Project)
Scale: 1" = 40'

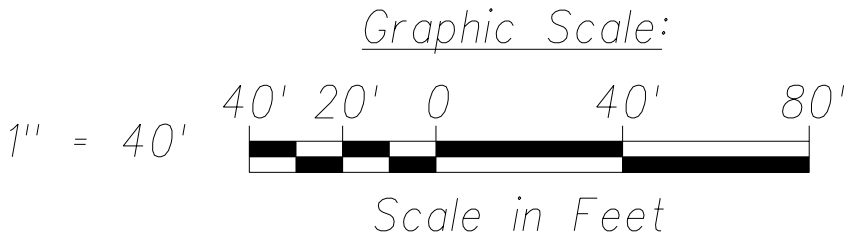

APPROVED BY:

MANAGER AND CHIEF ENGINEER, DEPARTMENT OF WATER, COUNTY OF KAUAI DATE



THIS WORK WAS PREPARED BY ME OR UNDER MY SUPERVISION AND CONSTRUCTION OF THIS PROJECT WILL BE UNDER MY OBSERVATION.

SIGNATURE April 30, 2016 EXPIRATION DATE OF THE LICENSE

07/30/14	Add pavement, curb, gutter and sidewalk demolition.
Date	Revision
STATE OF HAWAII DEPARTMENT OF TRANSPORTATION HIGHWAYS DIVISION	
DEMOLITION AND EROSION CONTROL PLAN	
PHASE 1 - KAUMUALII HIGHWAY LIHUE MILL BRIDGE TO RICE STREET	
PHASE 2 - NAWILIWILI STREAM BRIDGE AND MAUKA WIDENING	
Scale: As Shown	Date: March 25, 2013
SHEET No. C-22 OF 84 SHEETS	

SURVEY PLOTTED BY	DATE
DRAWN BY	
DESIGNED BY	
QUANTITIES BY	
CHECKED BY	
ORIGINAL PLAN	
NOTE BOOK	
No.	

"AS-BUILT"

MODEL S1