

FED. ROAD DIST. NO.	STATE	FED. AID PROJ. NO.	FISCAL YEAR	SHEET NO.	TOTAL SHEETS
HAWAII	HAW.	ARR-050-1(036)	FY13/14	Model	131


Compost Filter Sock Notes:

1. Compost filter sock shall utilize an outer layer of filtration mesh, and an inner


layer of containment netting. All layers shall collectively enclose the compost

filtration media. Compost filter sock shall be installed as 12-inch nominal

diameters as indicated on the project drawings, or as specified by the

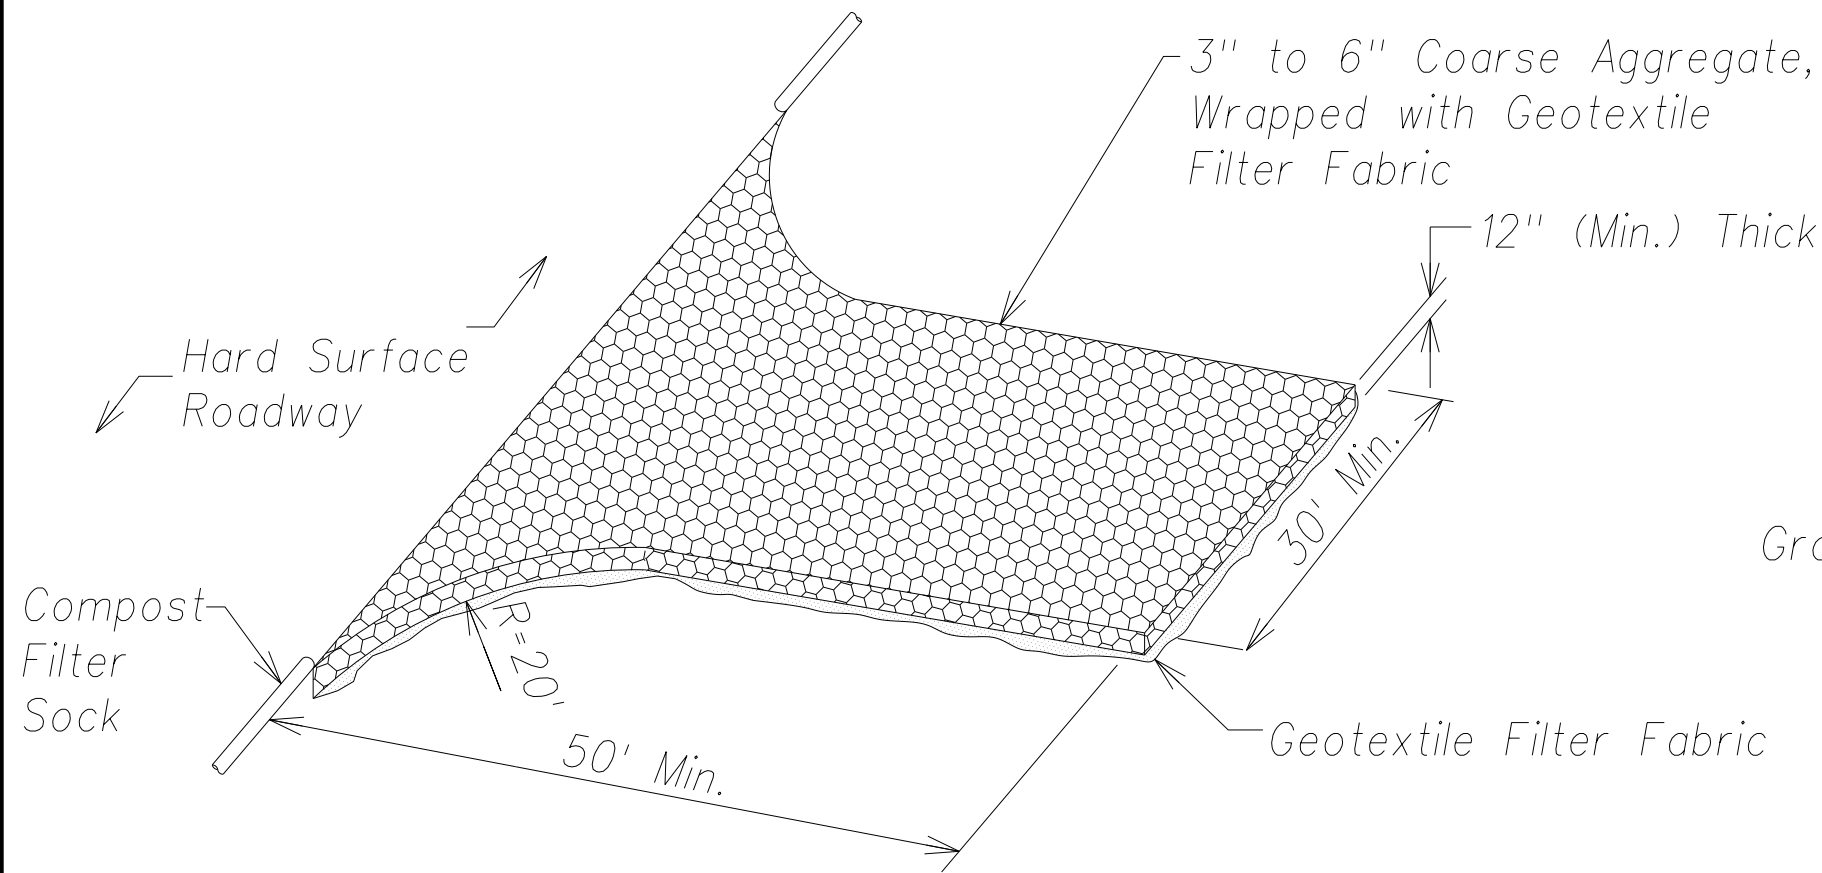


Stabilized Construction Access
Not To Scale

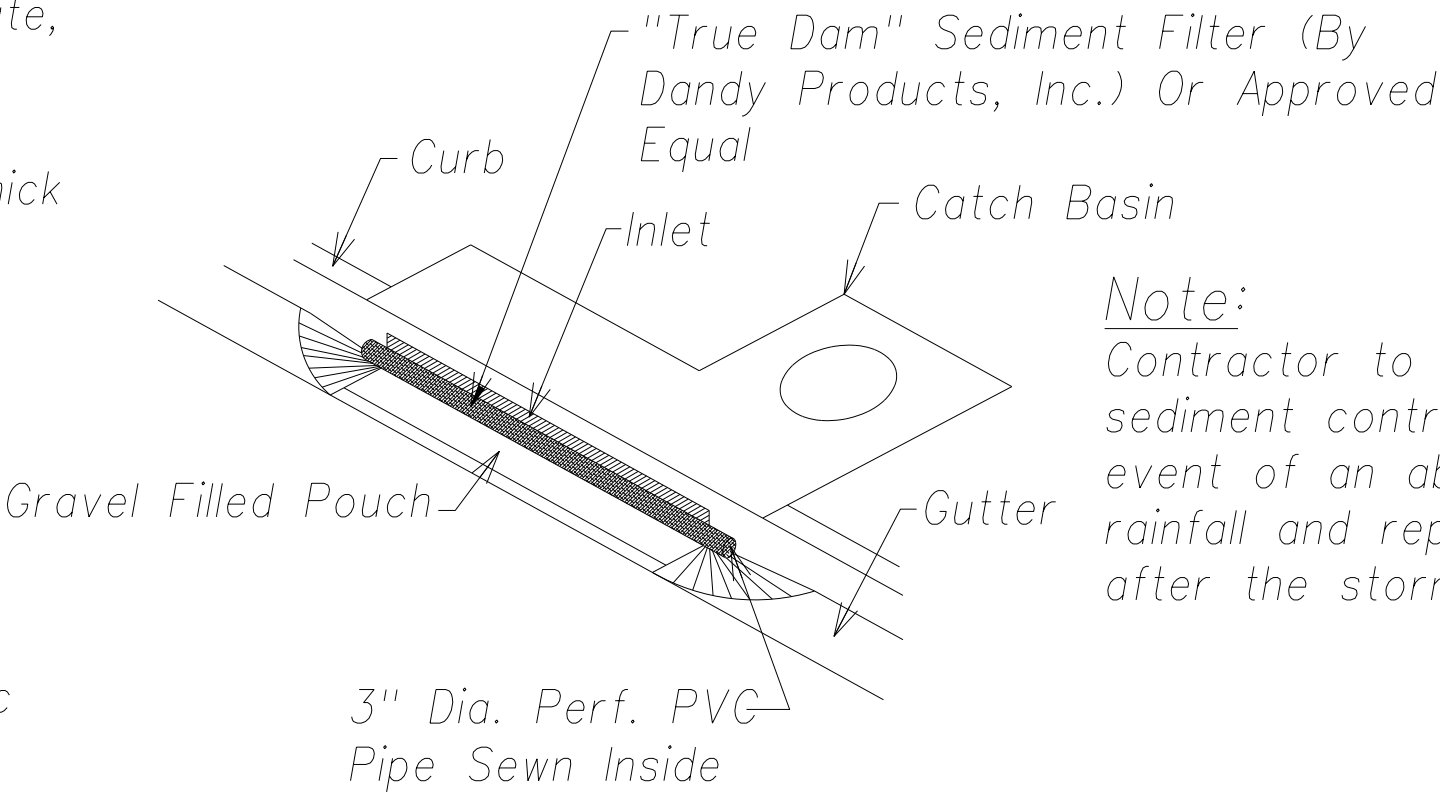


Catch Basin Inlet Protection
Not To Scale

Note:
Contractor to remove sediment control filter in the event of an above average rainfall and replace the filter after the storm has passed.

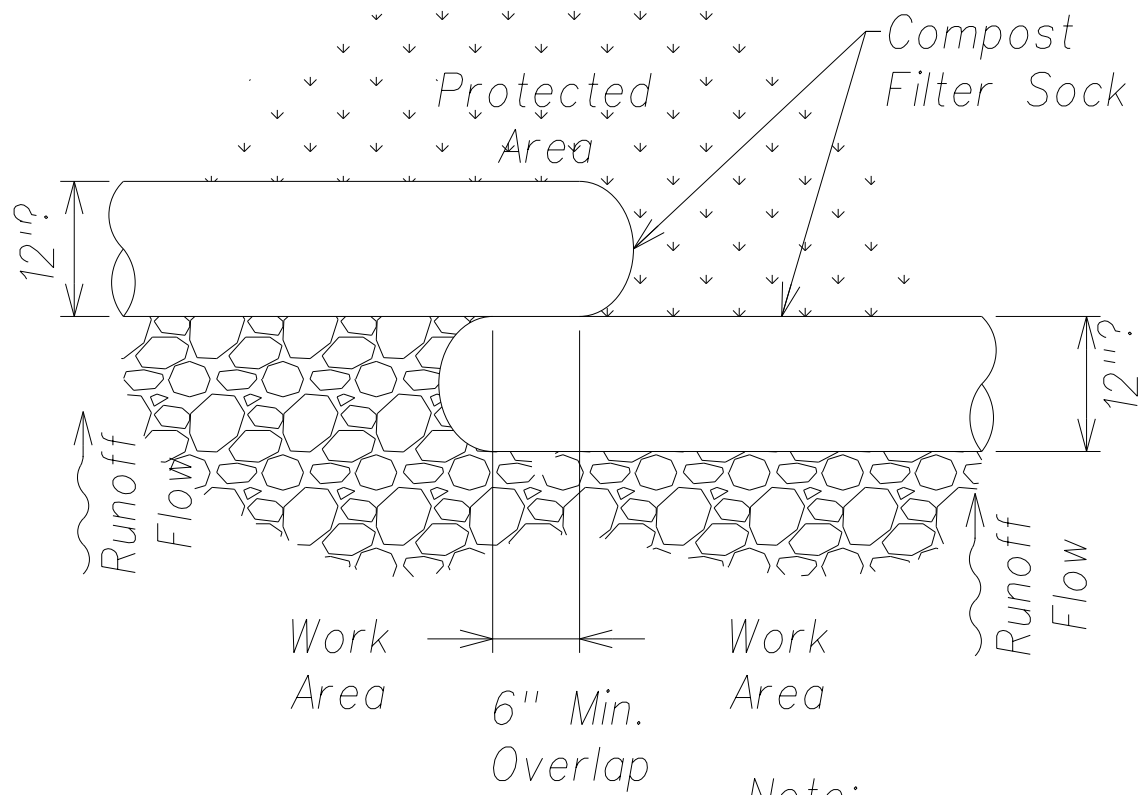



Note:
Install Per Anchor Method A, B, C
Or Per Spec.

Compost Filter Sock
Not To Scale

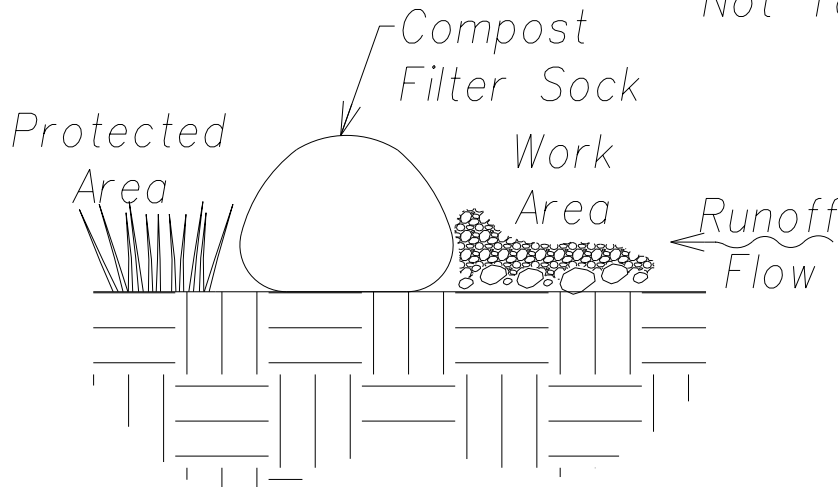


Elevation

Slope Gradient	Anchor Method	Anchor Spacing
< 4:1	Not Required	Not Required
4:1 TO 3:1	'A' OR 'B'	10'
3:1 TO 2:1	'A'	5' TO 10'
> 2:1	'C'	5'

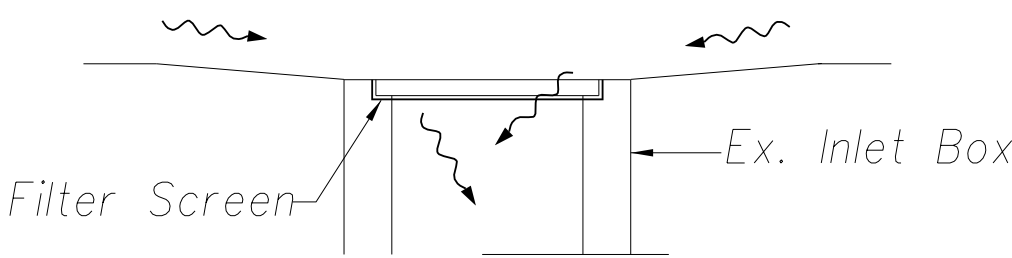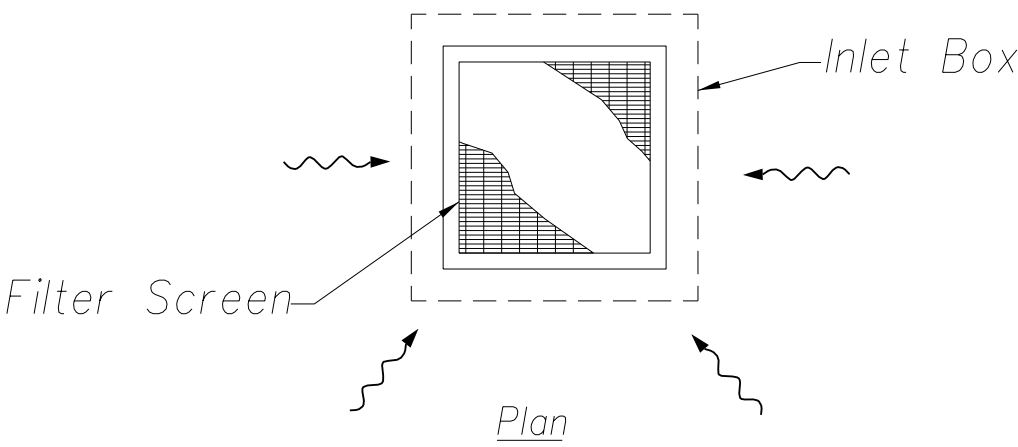



Section

Drain Inlet Protection
Not To Scale

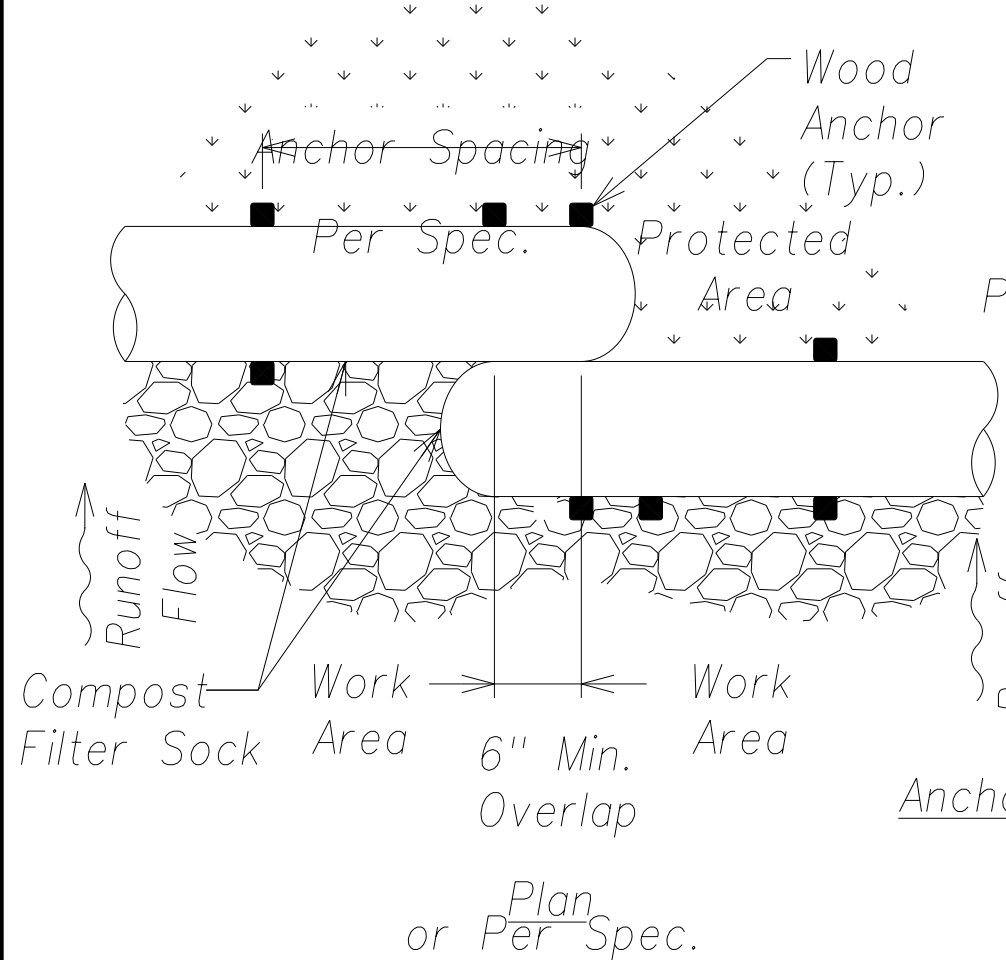



Anchor 'A'

Elevation

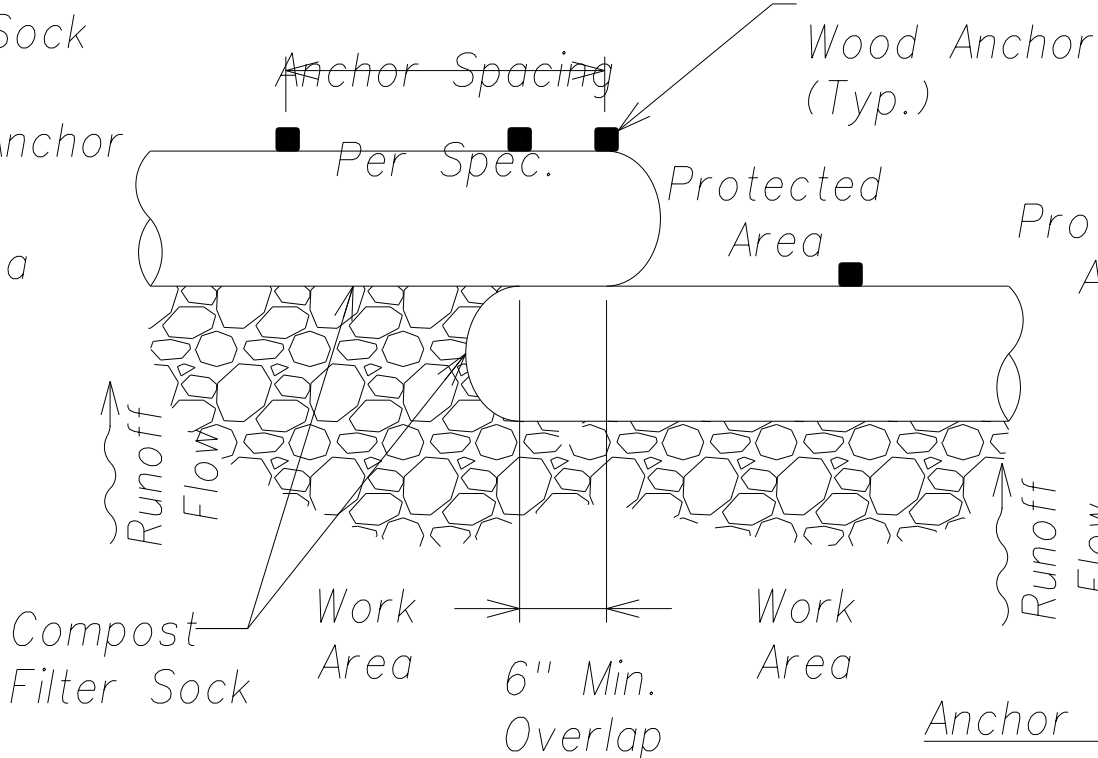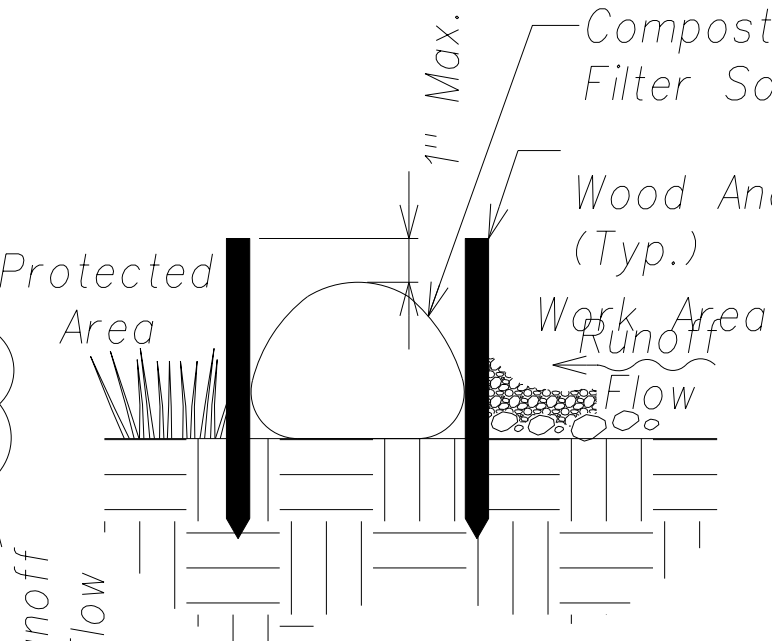

Anchor 'B'

Elevation

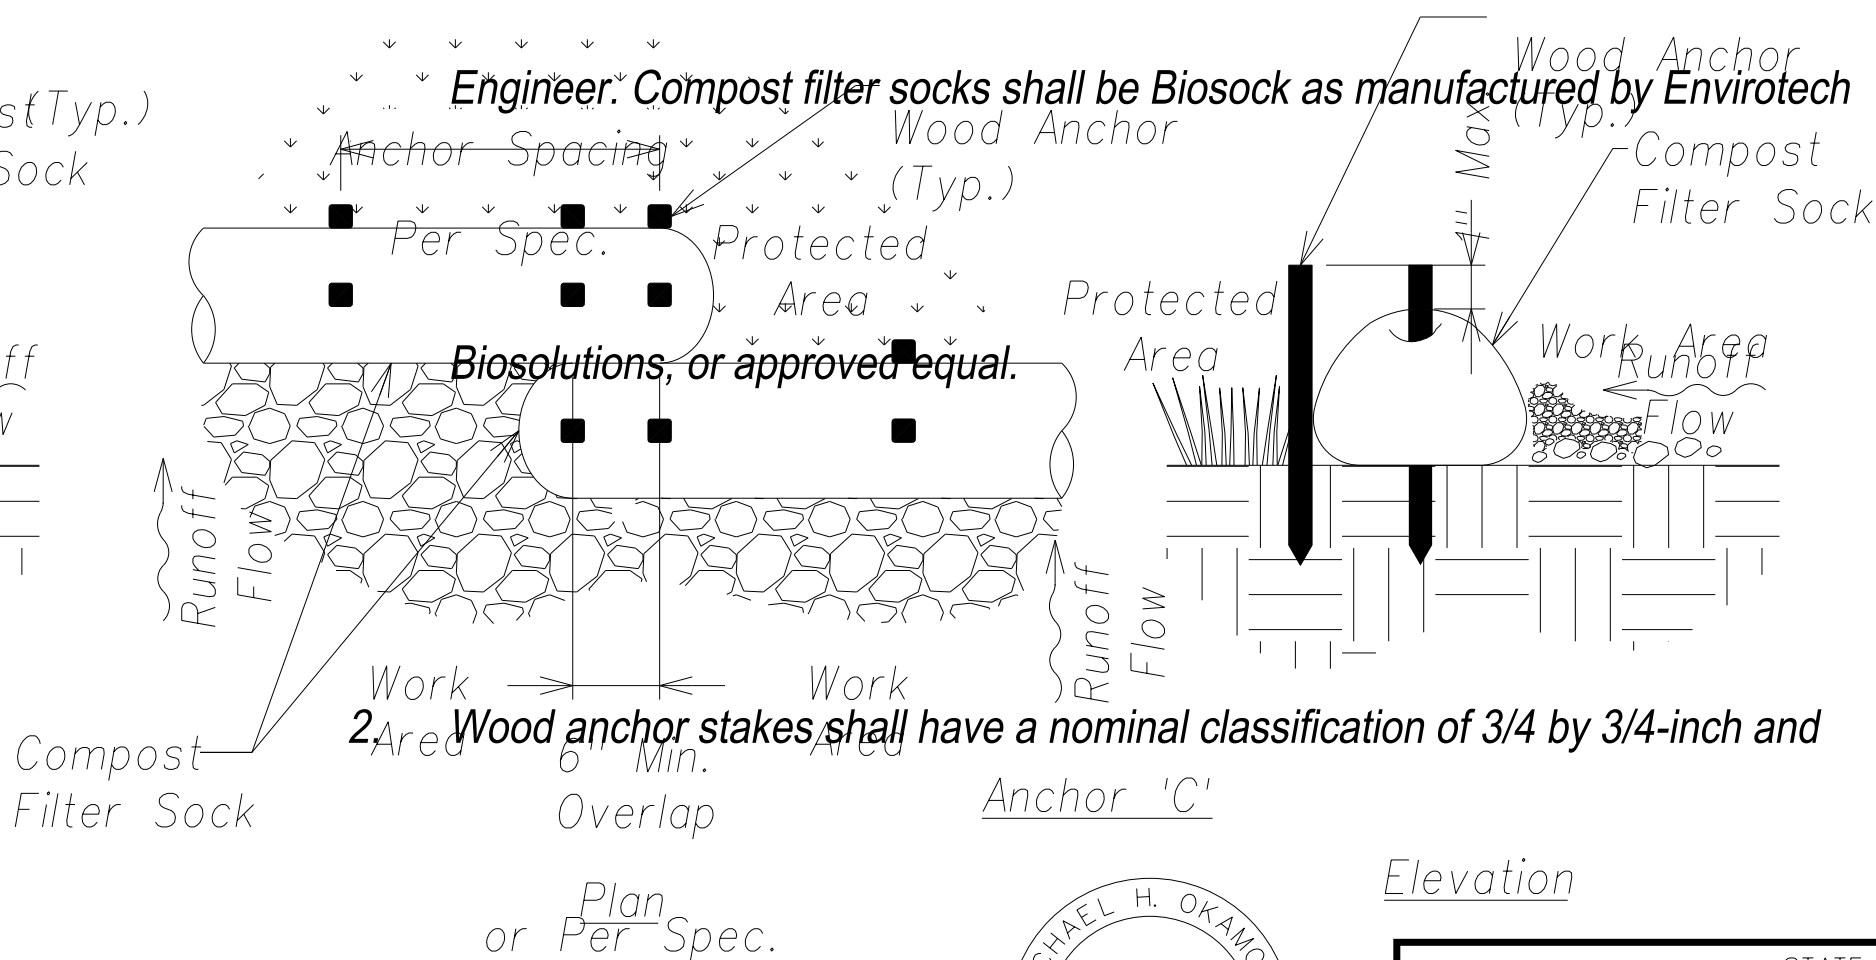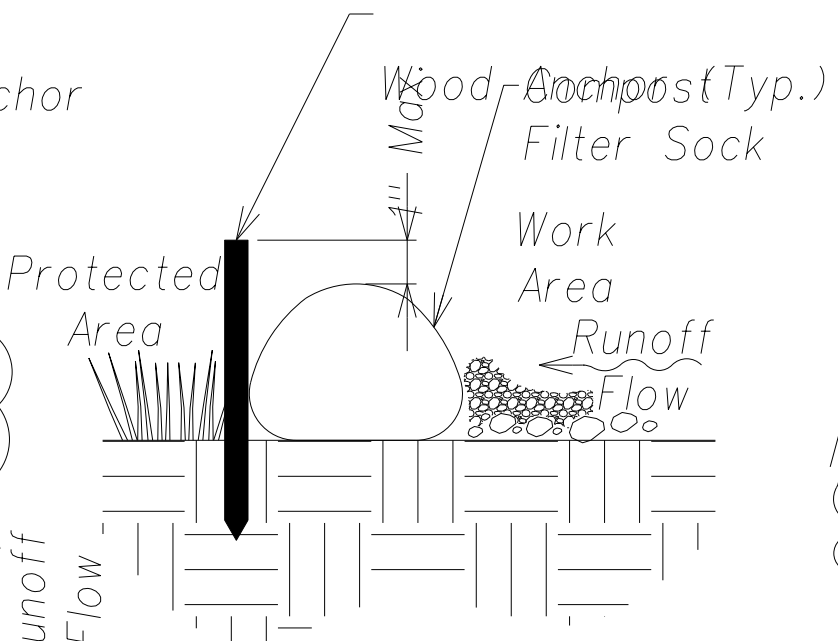

THIS WORK WAS PREPARED BY ME OR UNDER MY SUPERVISION AND CONSTRUCTION OF THIS PROJECT WILL BE UNDER MY OBSERVATION.

SIGNATURE
EXPIRATION DATE OF THE LICENSE

STATE OF HAWAII
DEPARTMENT OF TRANSPORTATION
HIGHWAYS DIVISION

EROSION CONTROL DETAILS

PHASE 1 - KAUMUALII HIGHWAY
LIHUE MILL BRIDGE TO RICE STREET
PHASE 2 - NAWILIWILI STREAM BRIDGE
AND MAUKA WIDENING

Scale: As Shown
Date: March 25, 2013
SHEET No. C-23 OF 84 SHEETS


ORIGINAL PLAN	SURVEY PLOTTED BY	DATE
	DRAWN BY	
	DESIGNED BY	
	CHECKED BY	
NOTE BOOK	No.	

"AS-BUILT"


installed at the discretion of the installer, or as specified by the Engineer. Do

Model


FED. ROAD DIST. NO.	STATE	FED. AID PROJ. NO.	FISCAL YEAR	SHEET NO.	TOTAL SHEETS
HAWAII	HAW.	ARR-050-1(036)	FY13/14	Model	131

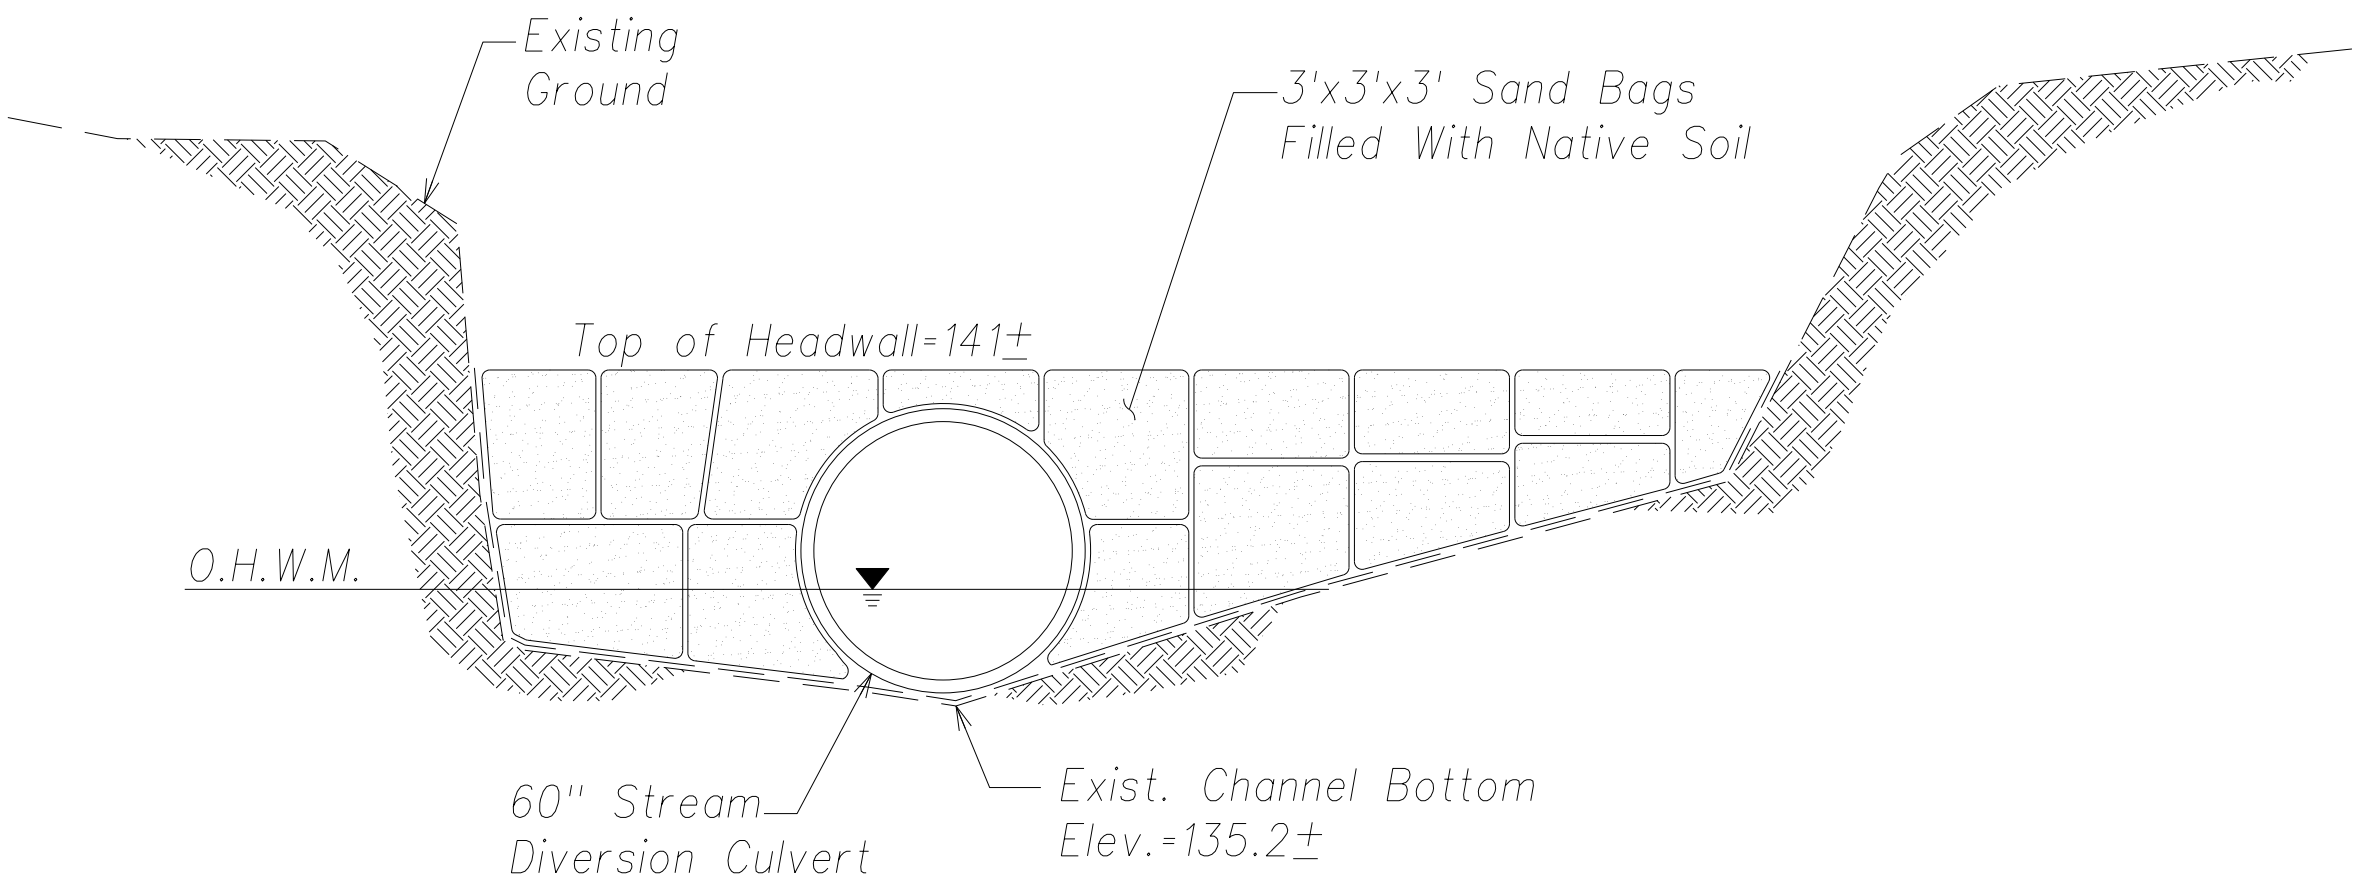


A
C-21 | C-24
Temporary Drain Inlet Headwall
Not to Scale

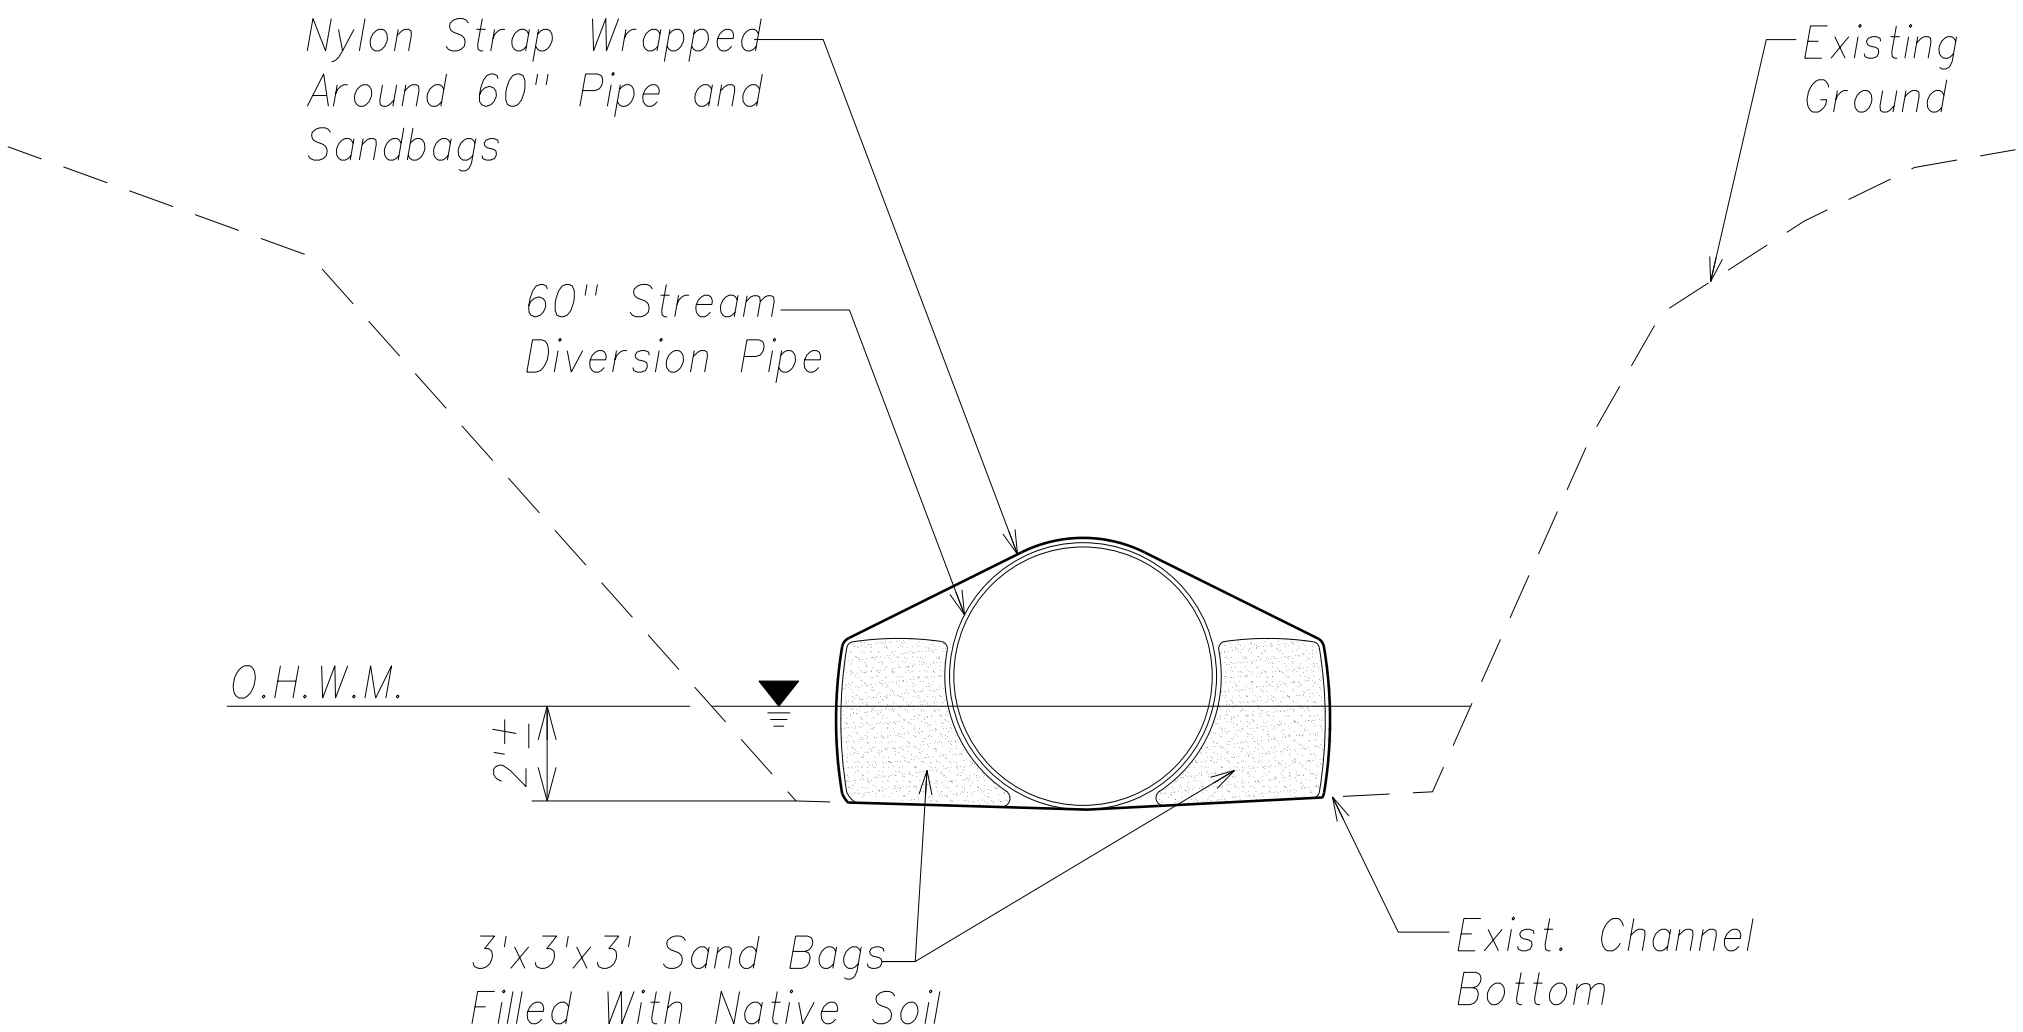


Typical 60" Stream Diversion Pipe Anchor
Not to Scale

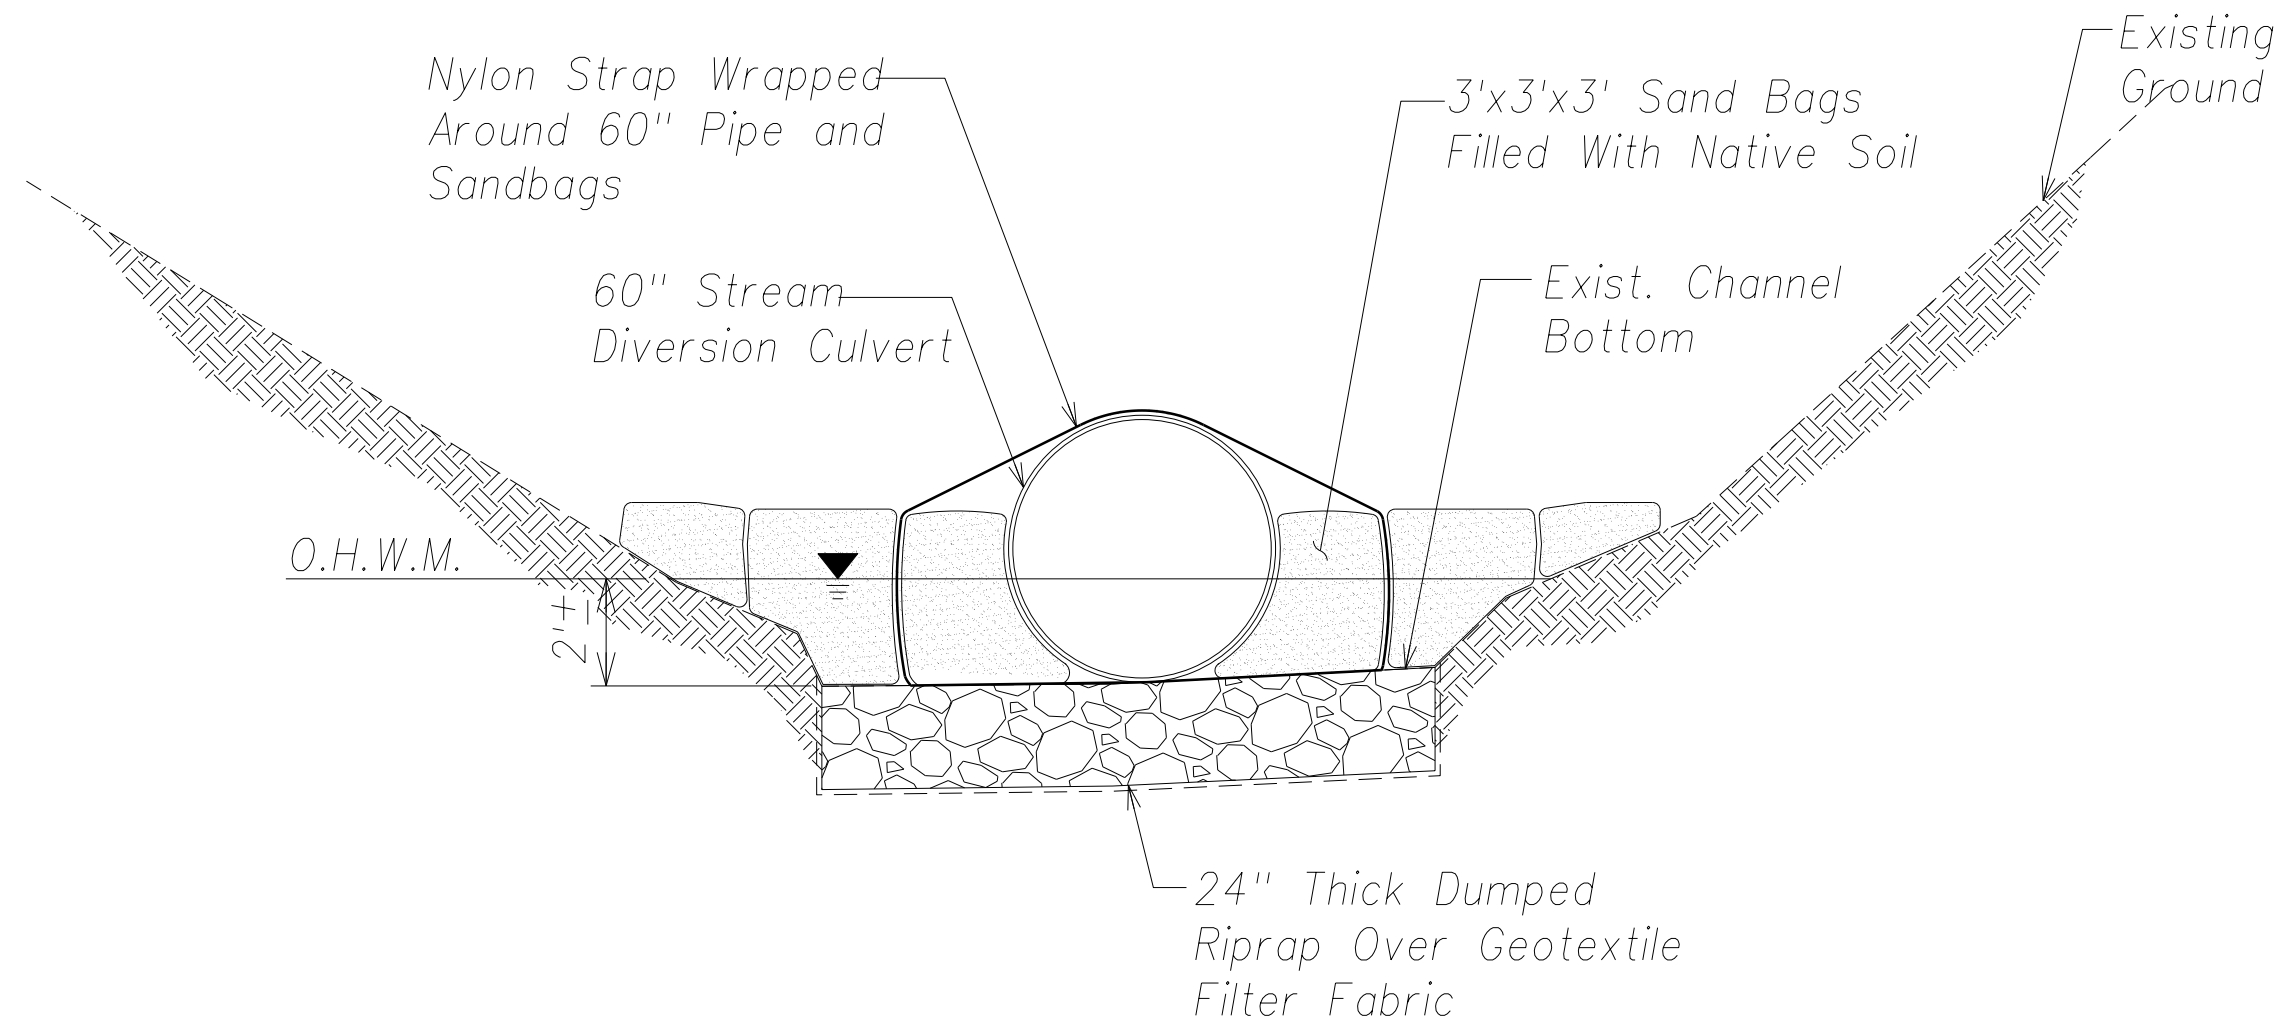

B
C-21 | C-24
Temporary Drain Outlet Headwall
Not to Scale


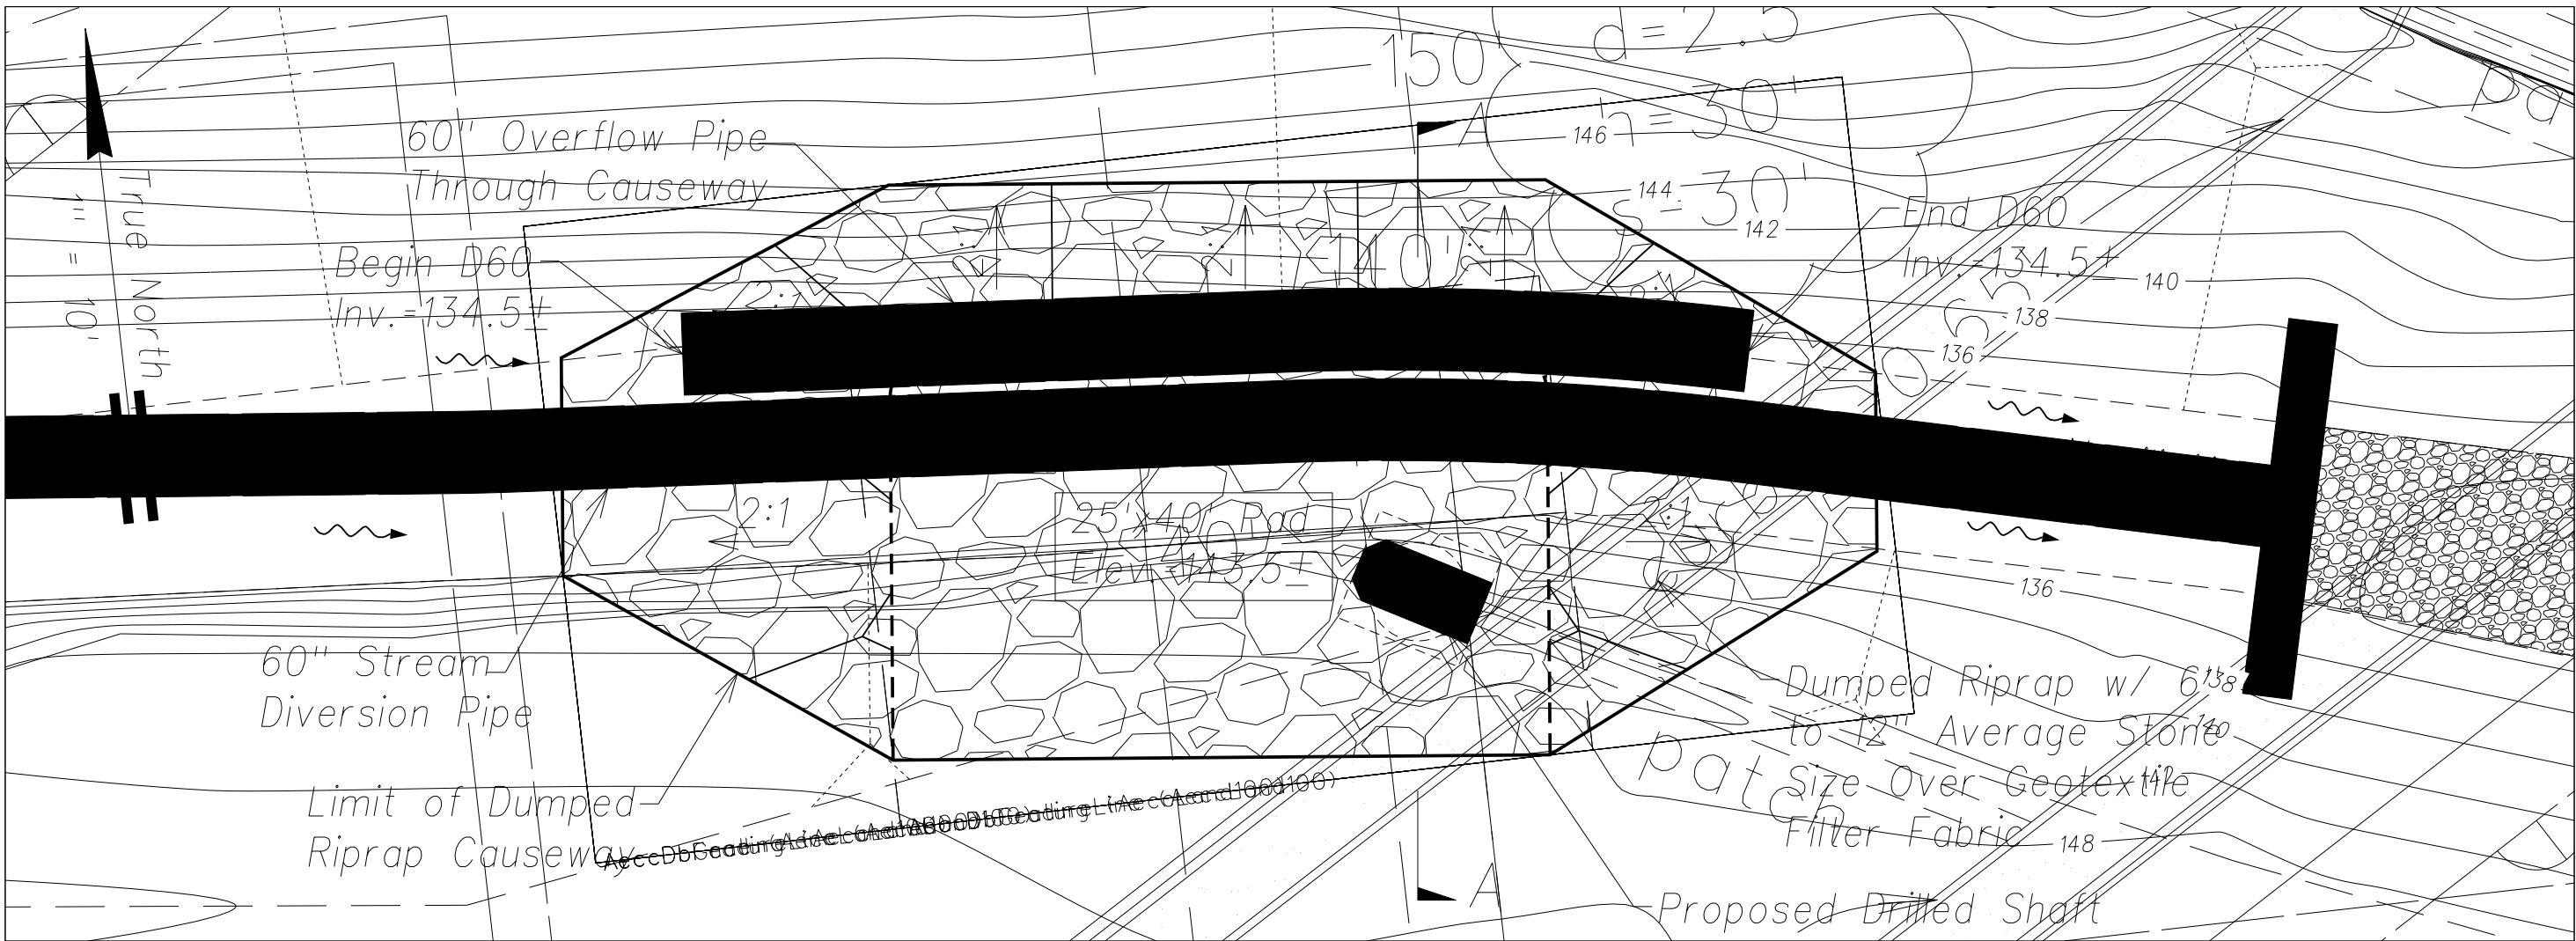


Enlarged Plan
Scale: 1"=10'

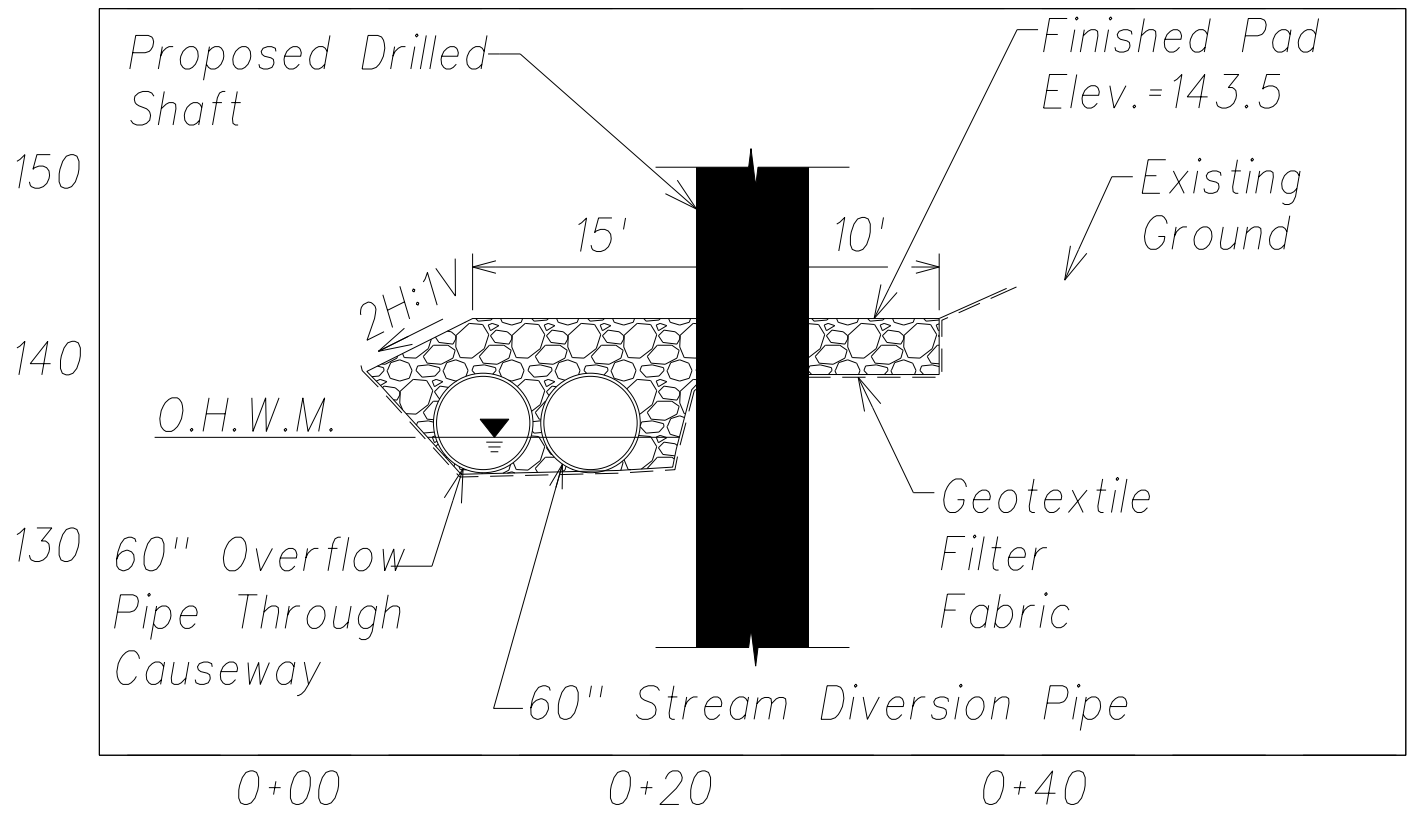

Section A-A
Scales: Vert.: 1"=10'
Hor.: 1"=10'

Temporary Causeway
Scale: 1" = 10'

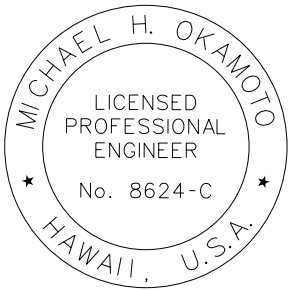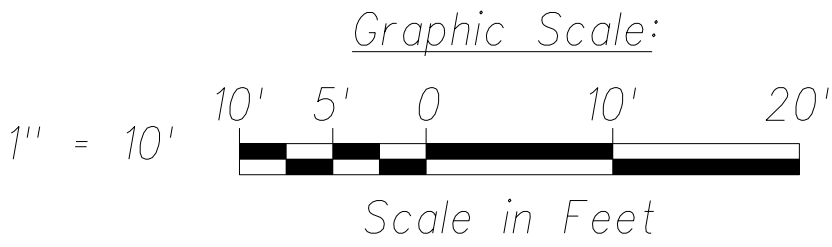

THIS WORK WAS PREPARED BY ME
OR UNDER MY SUPERVISION AND
CONSTRUCTION OF THIS PROJECT
WILL BE UNDER MY OBSERVATION.

SIGNATURE
EXPIRATION DATE
OF THE LICENSE

STATE OF HAWAII
DEPARTMENT OF TRANSPORTATION
HIGHWAYS DIVISION
EROSION CONTROL DETAILS
PHASE 1 - KAUMUALII HIGHWAY
LIHUE MILL BRIDGE TO RICE STREET
PHASE 2 - NAWILIWILI STREAM BRIDGE
AND MAUKA WIDENING

Scale: As Shown
Date: March 25, 2013
SHEET No. C-24 OF 84 SHEETS

Notes: Using Native Soil Filled Bags for Dam

1. Bag Material: Bags shall be either polypropylene, polyethylene or polymide woven fabric, minimum unit weight 4oz per sq. yd. mullen burst strength exceeding 300 psi in conformance with the requirements in ASTM D3786, and ultraviolet stability exceeding 70% in conformance with the requirements in ASTM D4355.
2. Bag Size: Each native soil filled bag shall have be 3'x3'x3' (LxWxT). Bag size are nominal, and may vary based on locally available materials.
3. Fill Material: Fill material shall be native soil and be free of organic matter and other deleterious materials. Secure bags such that native soil will not escape.

Maintenance Notes:

1. Check for sediment at damn after significant rainfall. Sediment shall be removed when it reaches one third of the original height.
2. Check for damage to sand bags and replace if necessary.

ORIGINAL PLAN	NO. _____	DATE _____	SURVEY PLOTTED BY _____
			DRAWN BY _____
			DESIGNED BY _____
			CHECKED BY _____

"AS-BUILT"

Model