
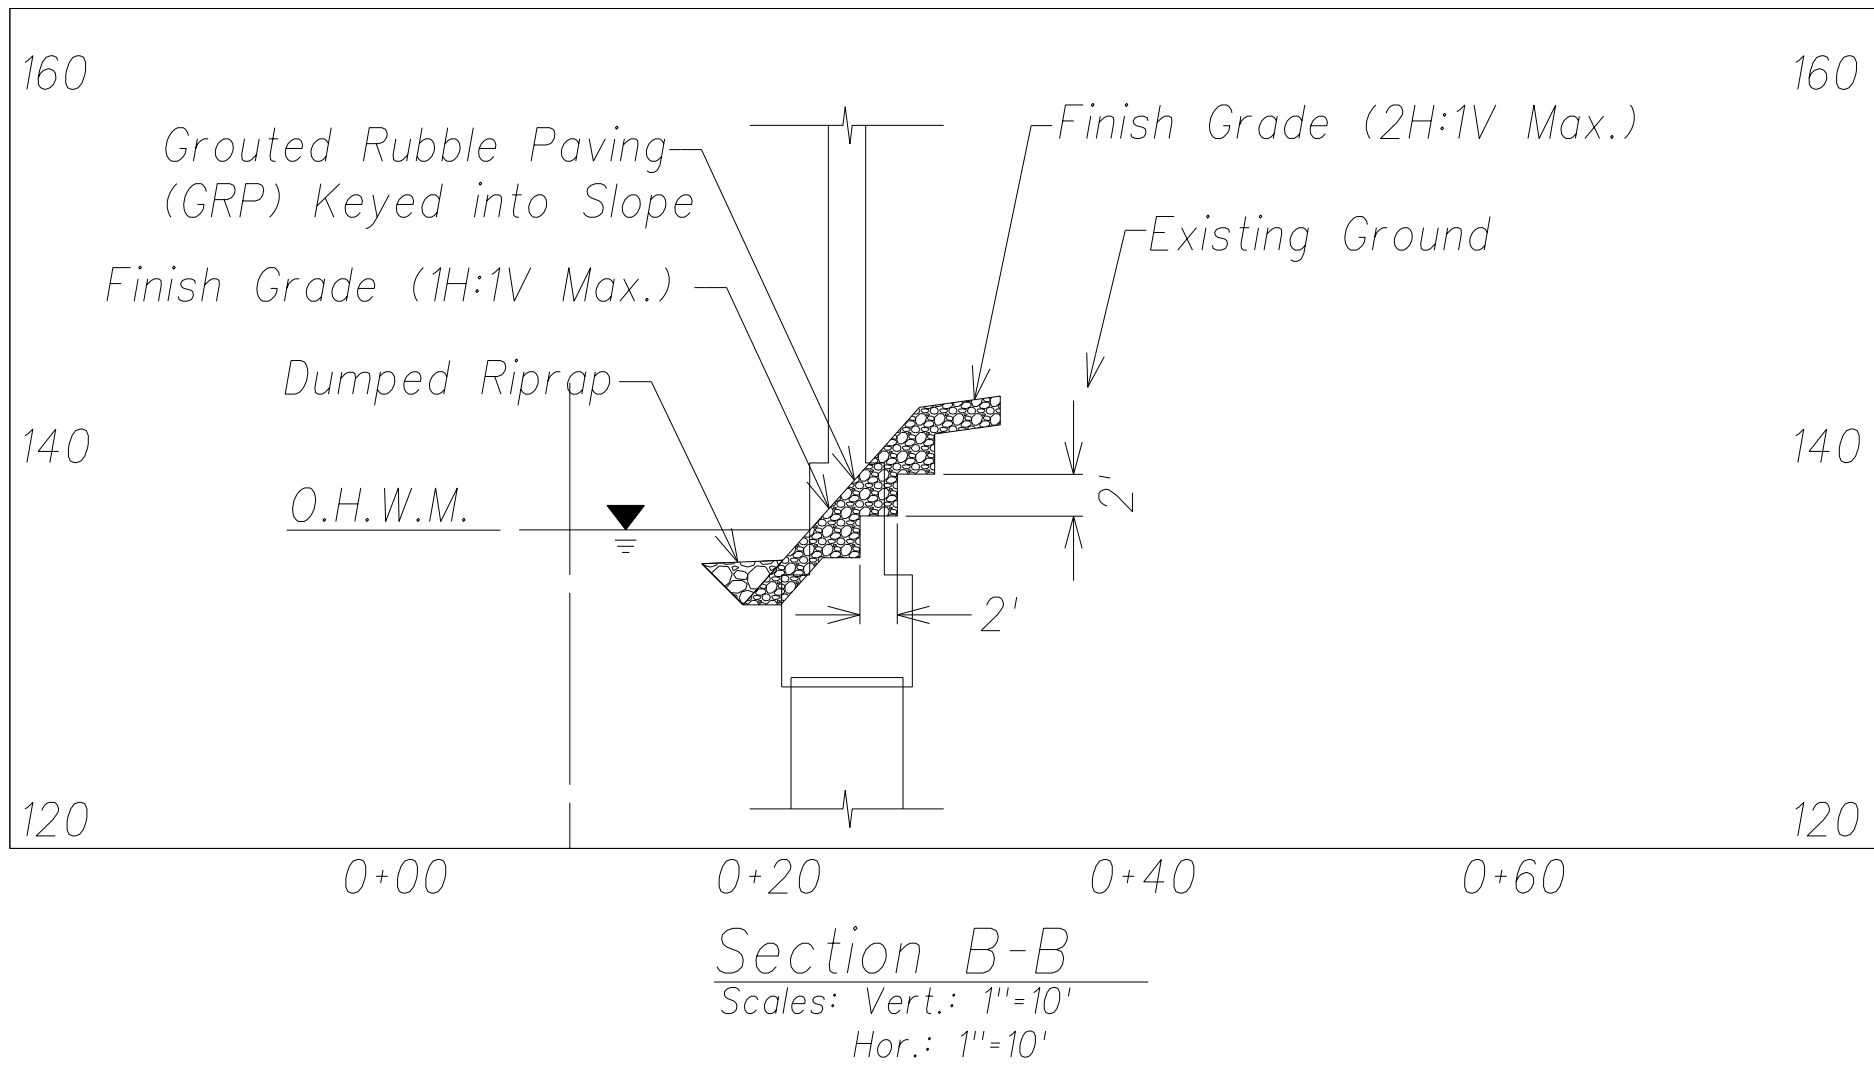
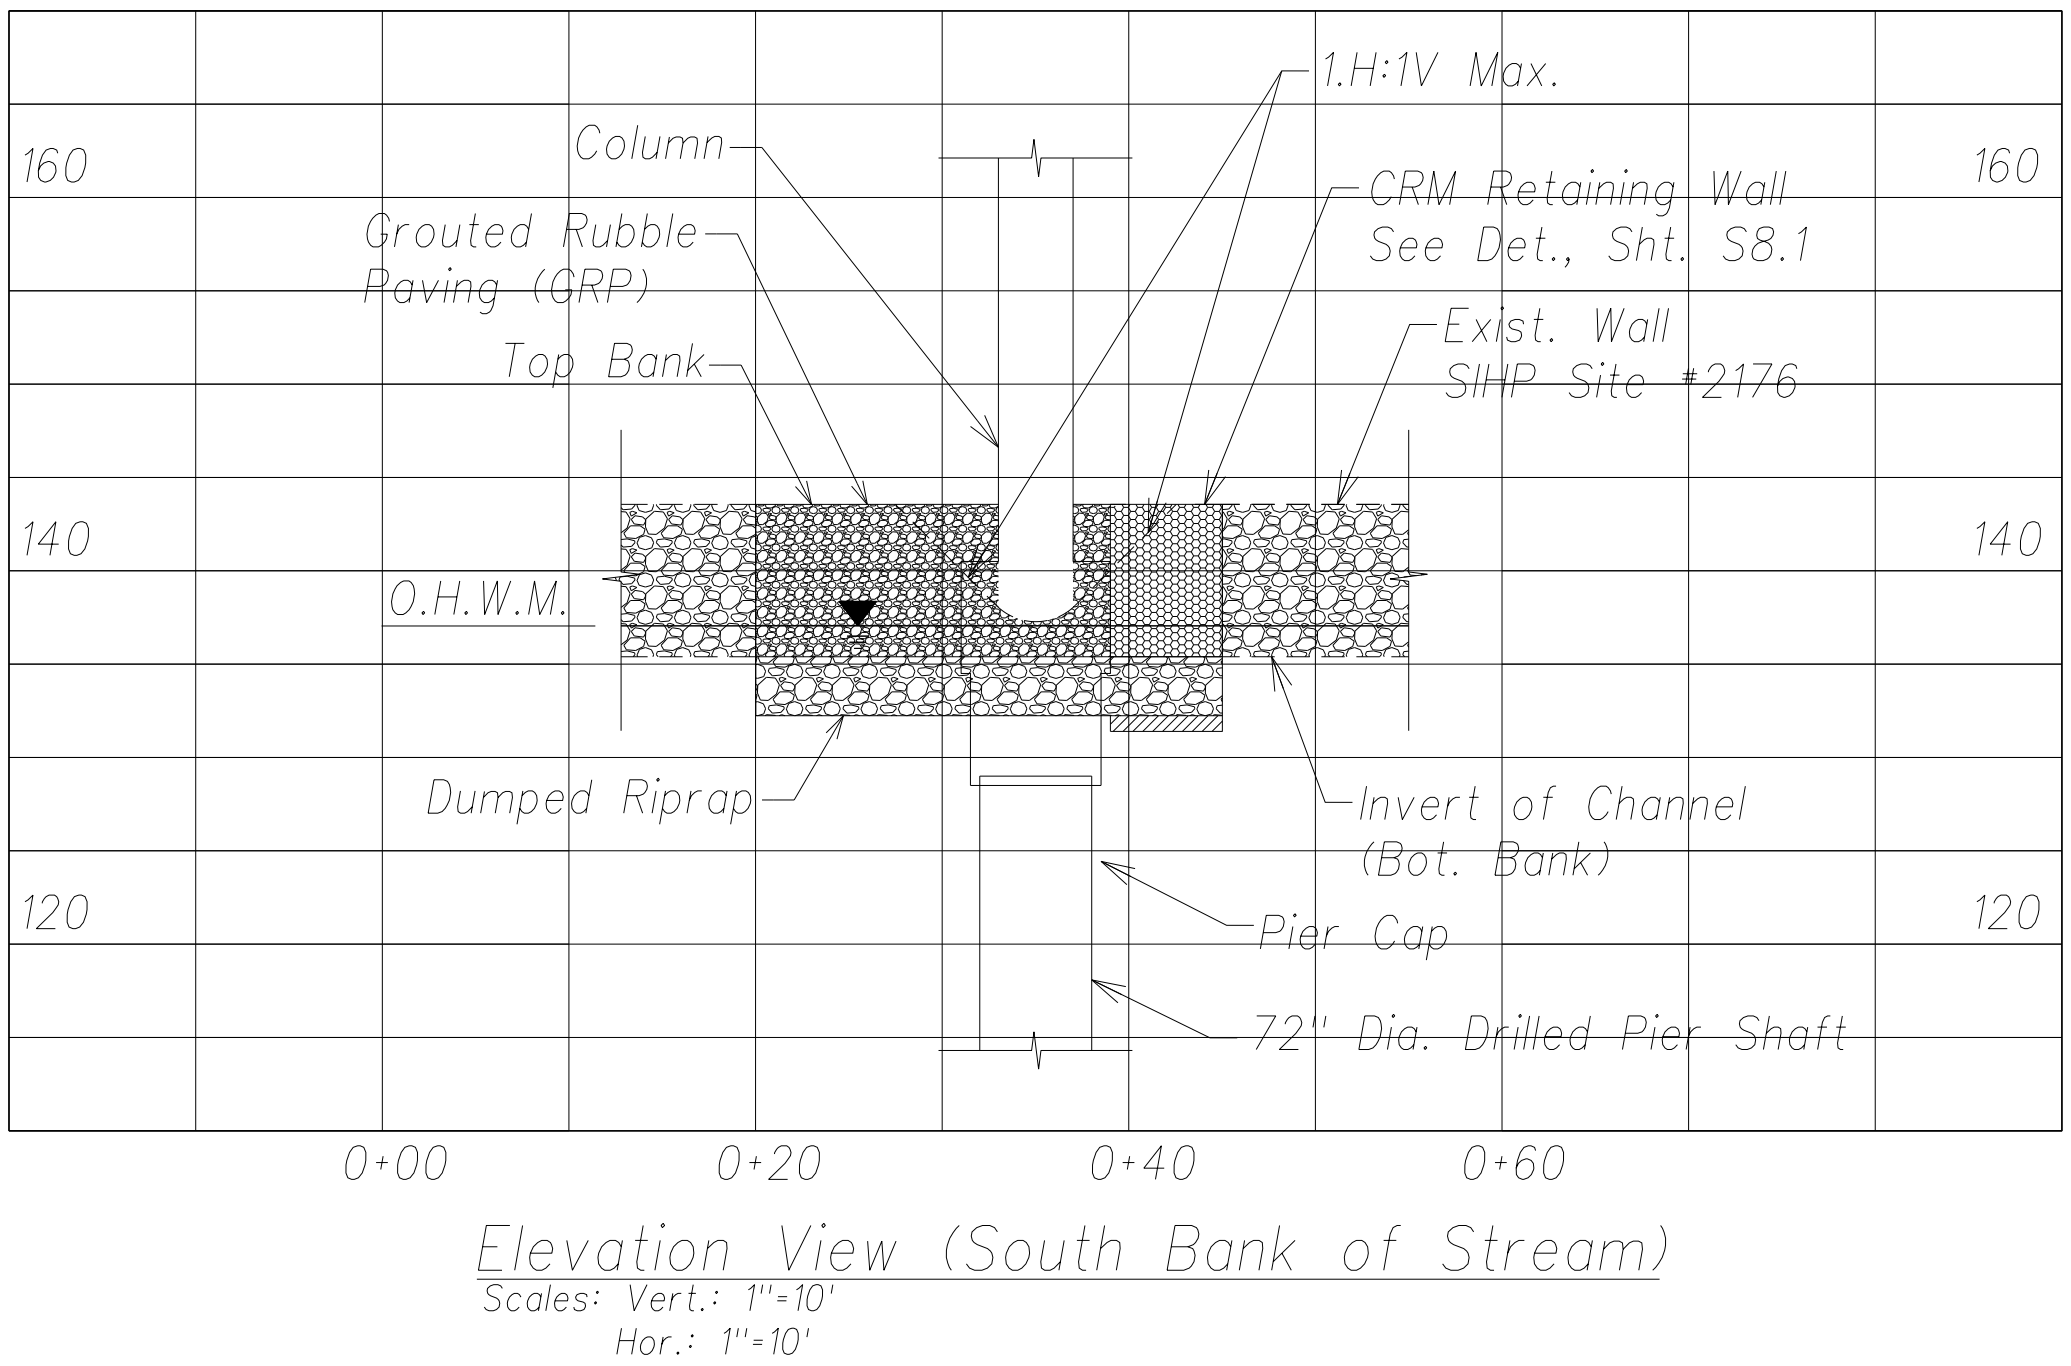
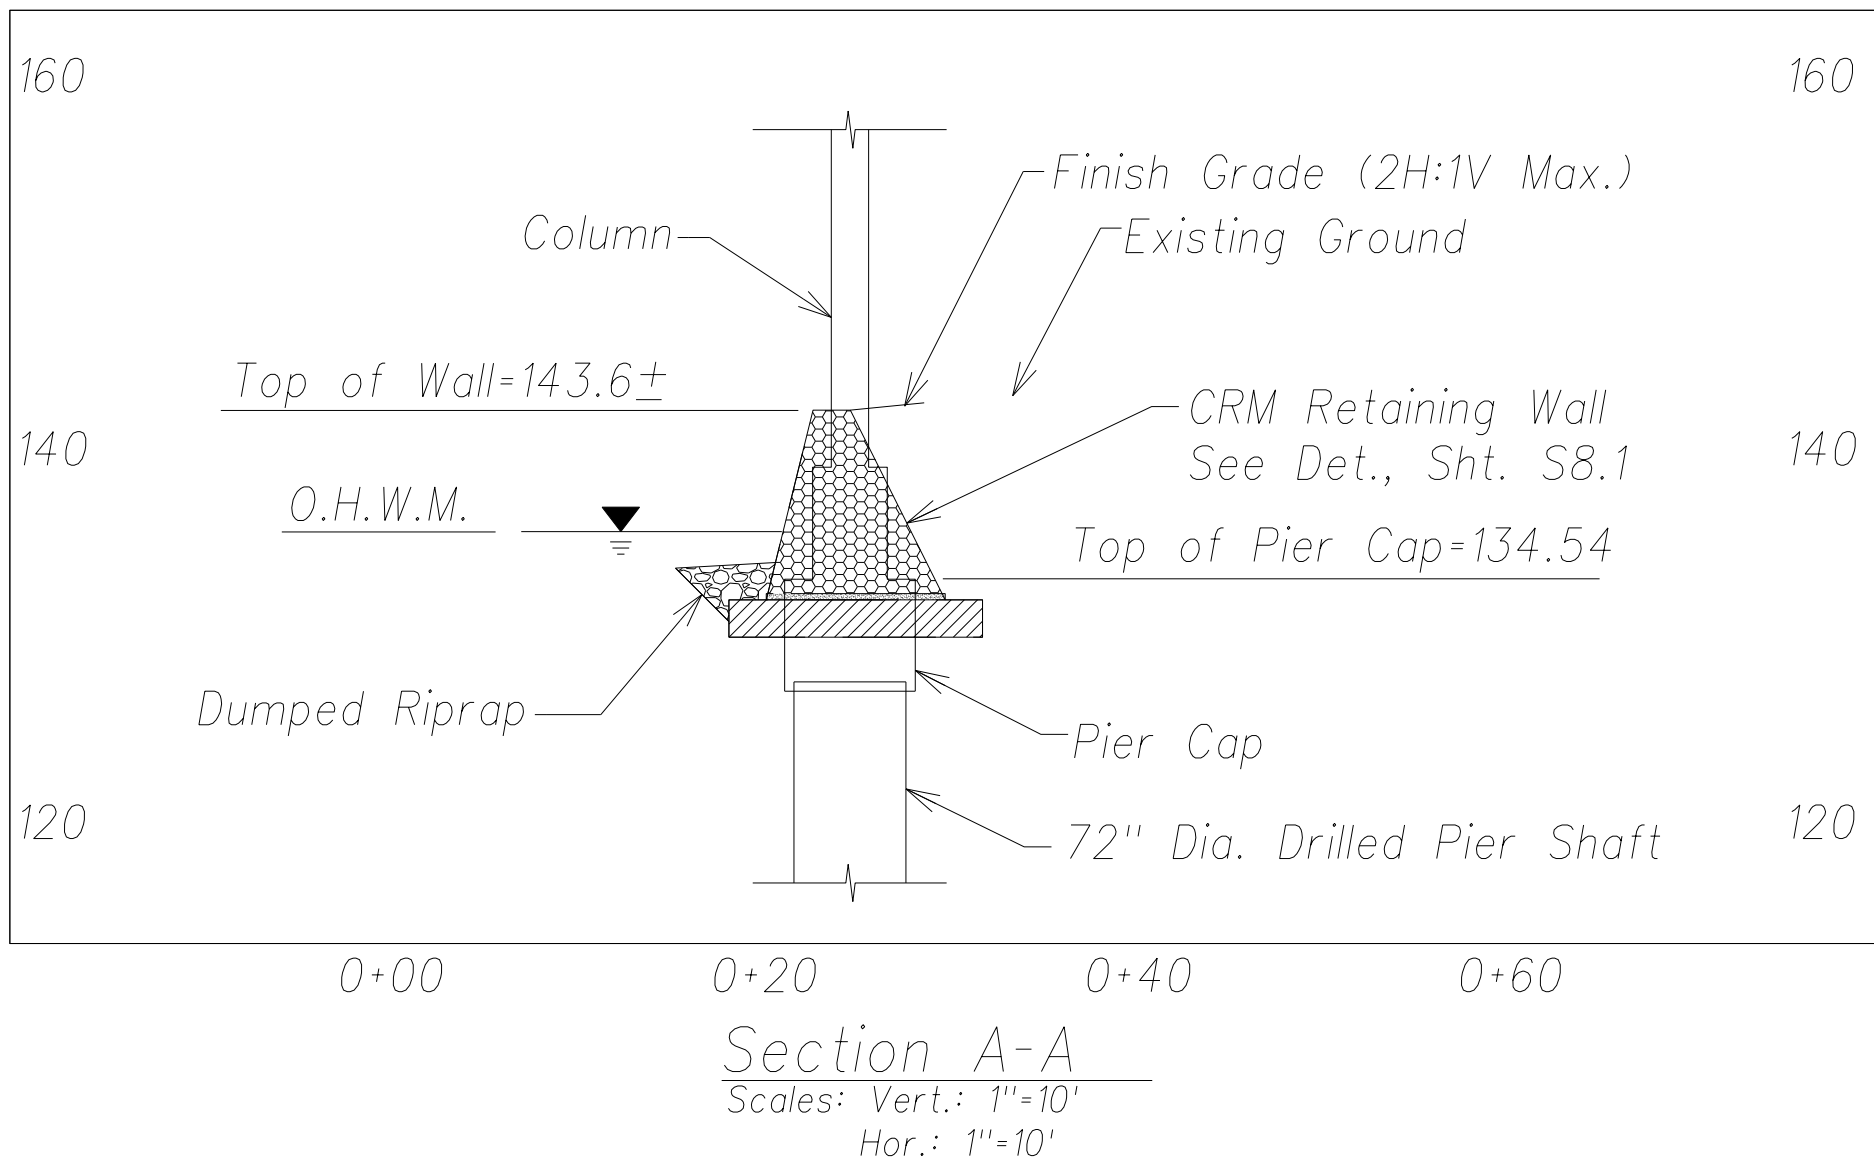
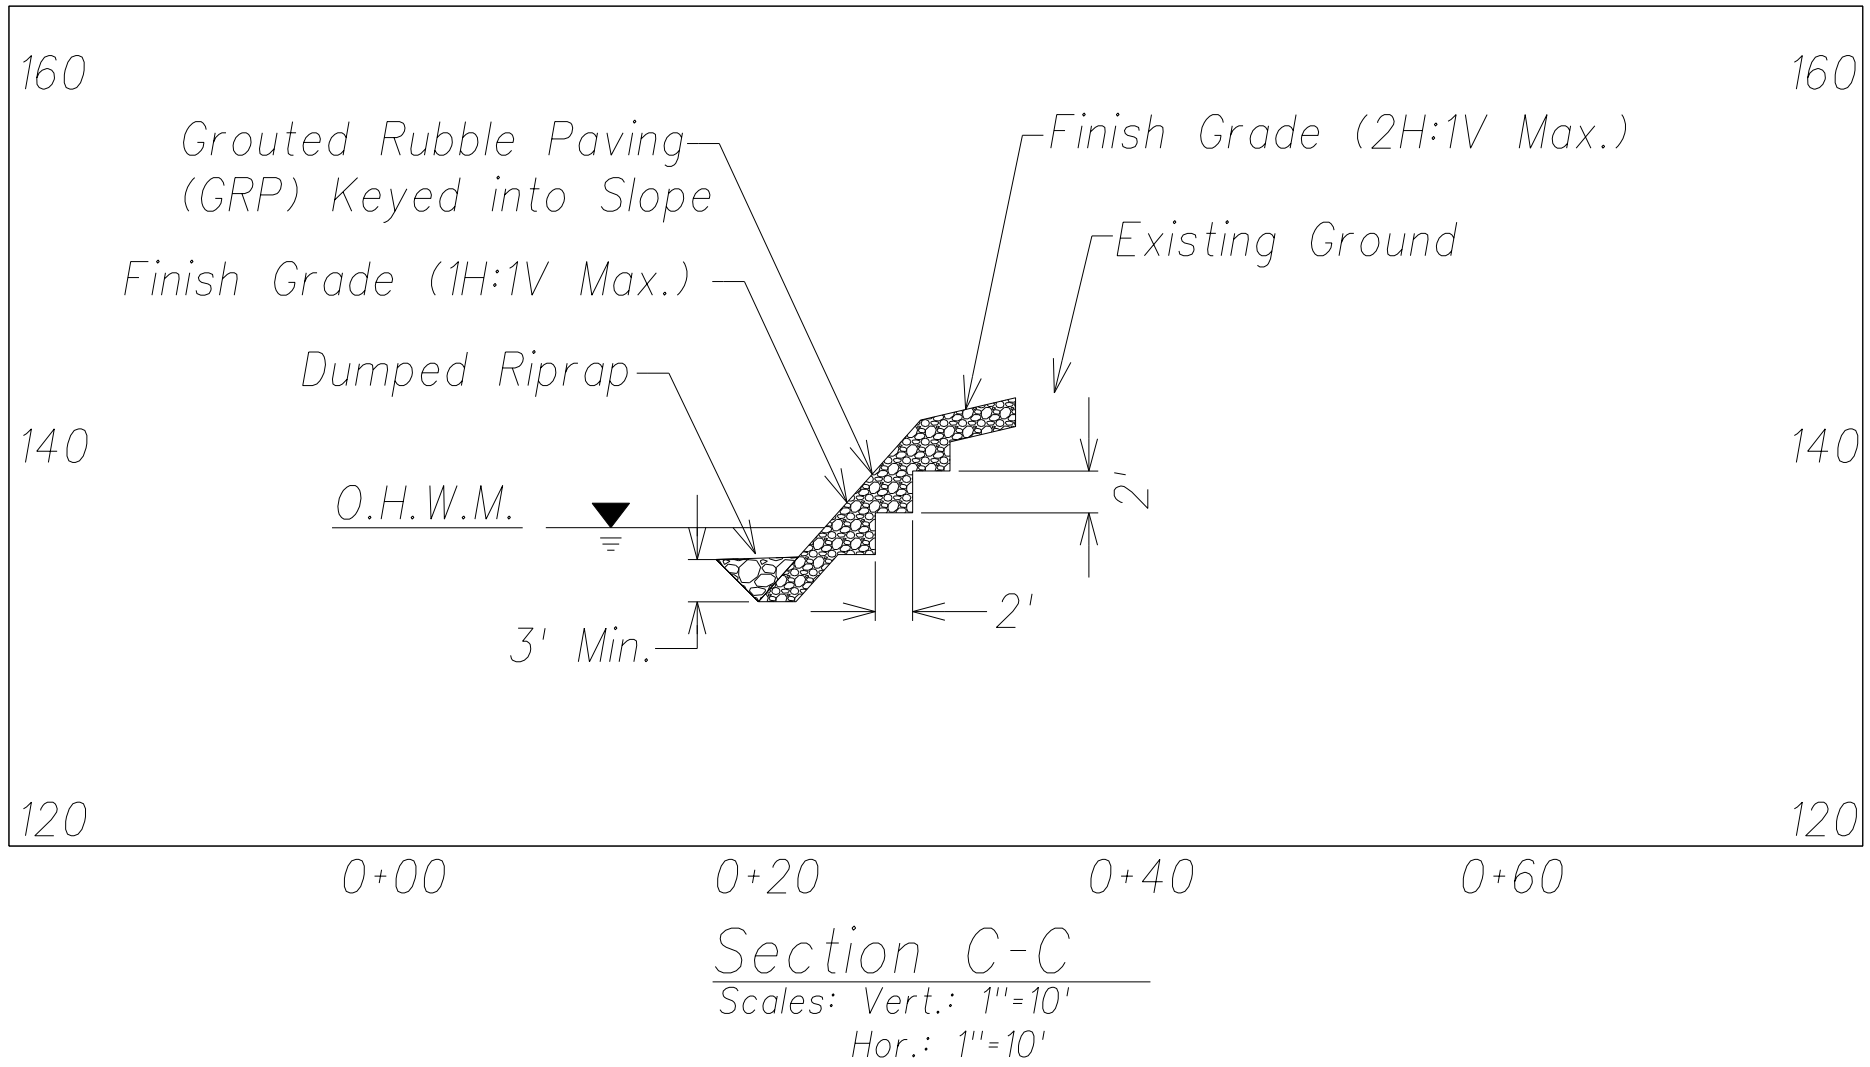



FED. ROAD DIST. NO.	STATE	FED. AID PROJ. NO.	FISCAL YEAR	SHEET NO.	TOTAL SHEETS
HAWAII	HAW.	ARR-050-1(036)	FY13/14	Model	131

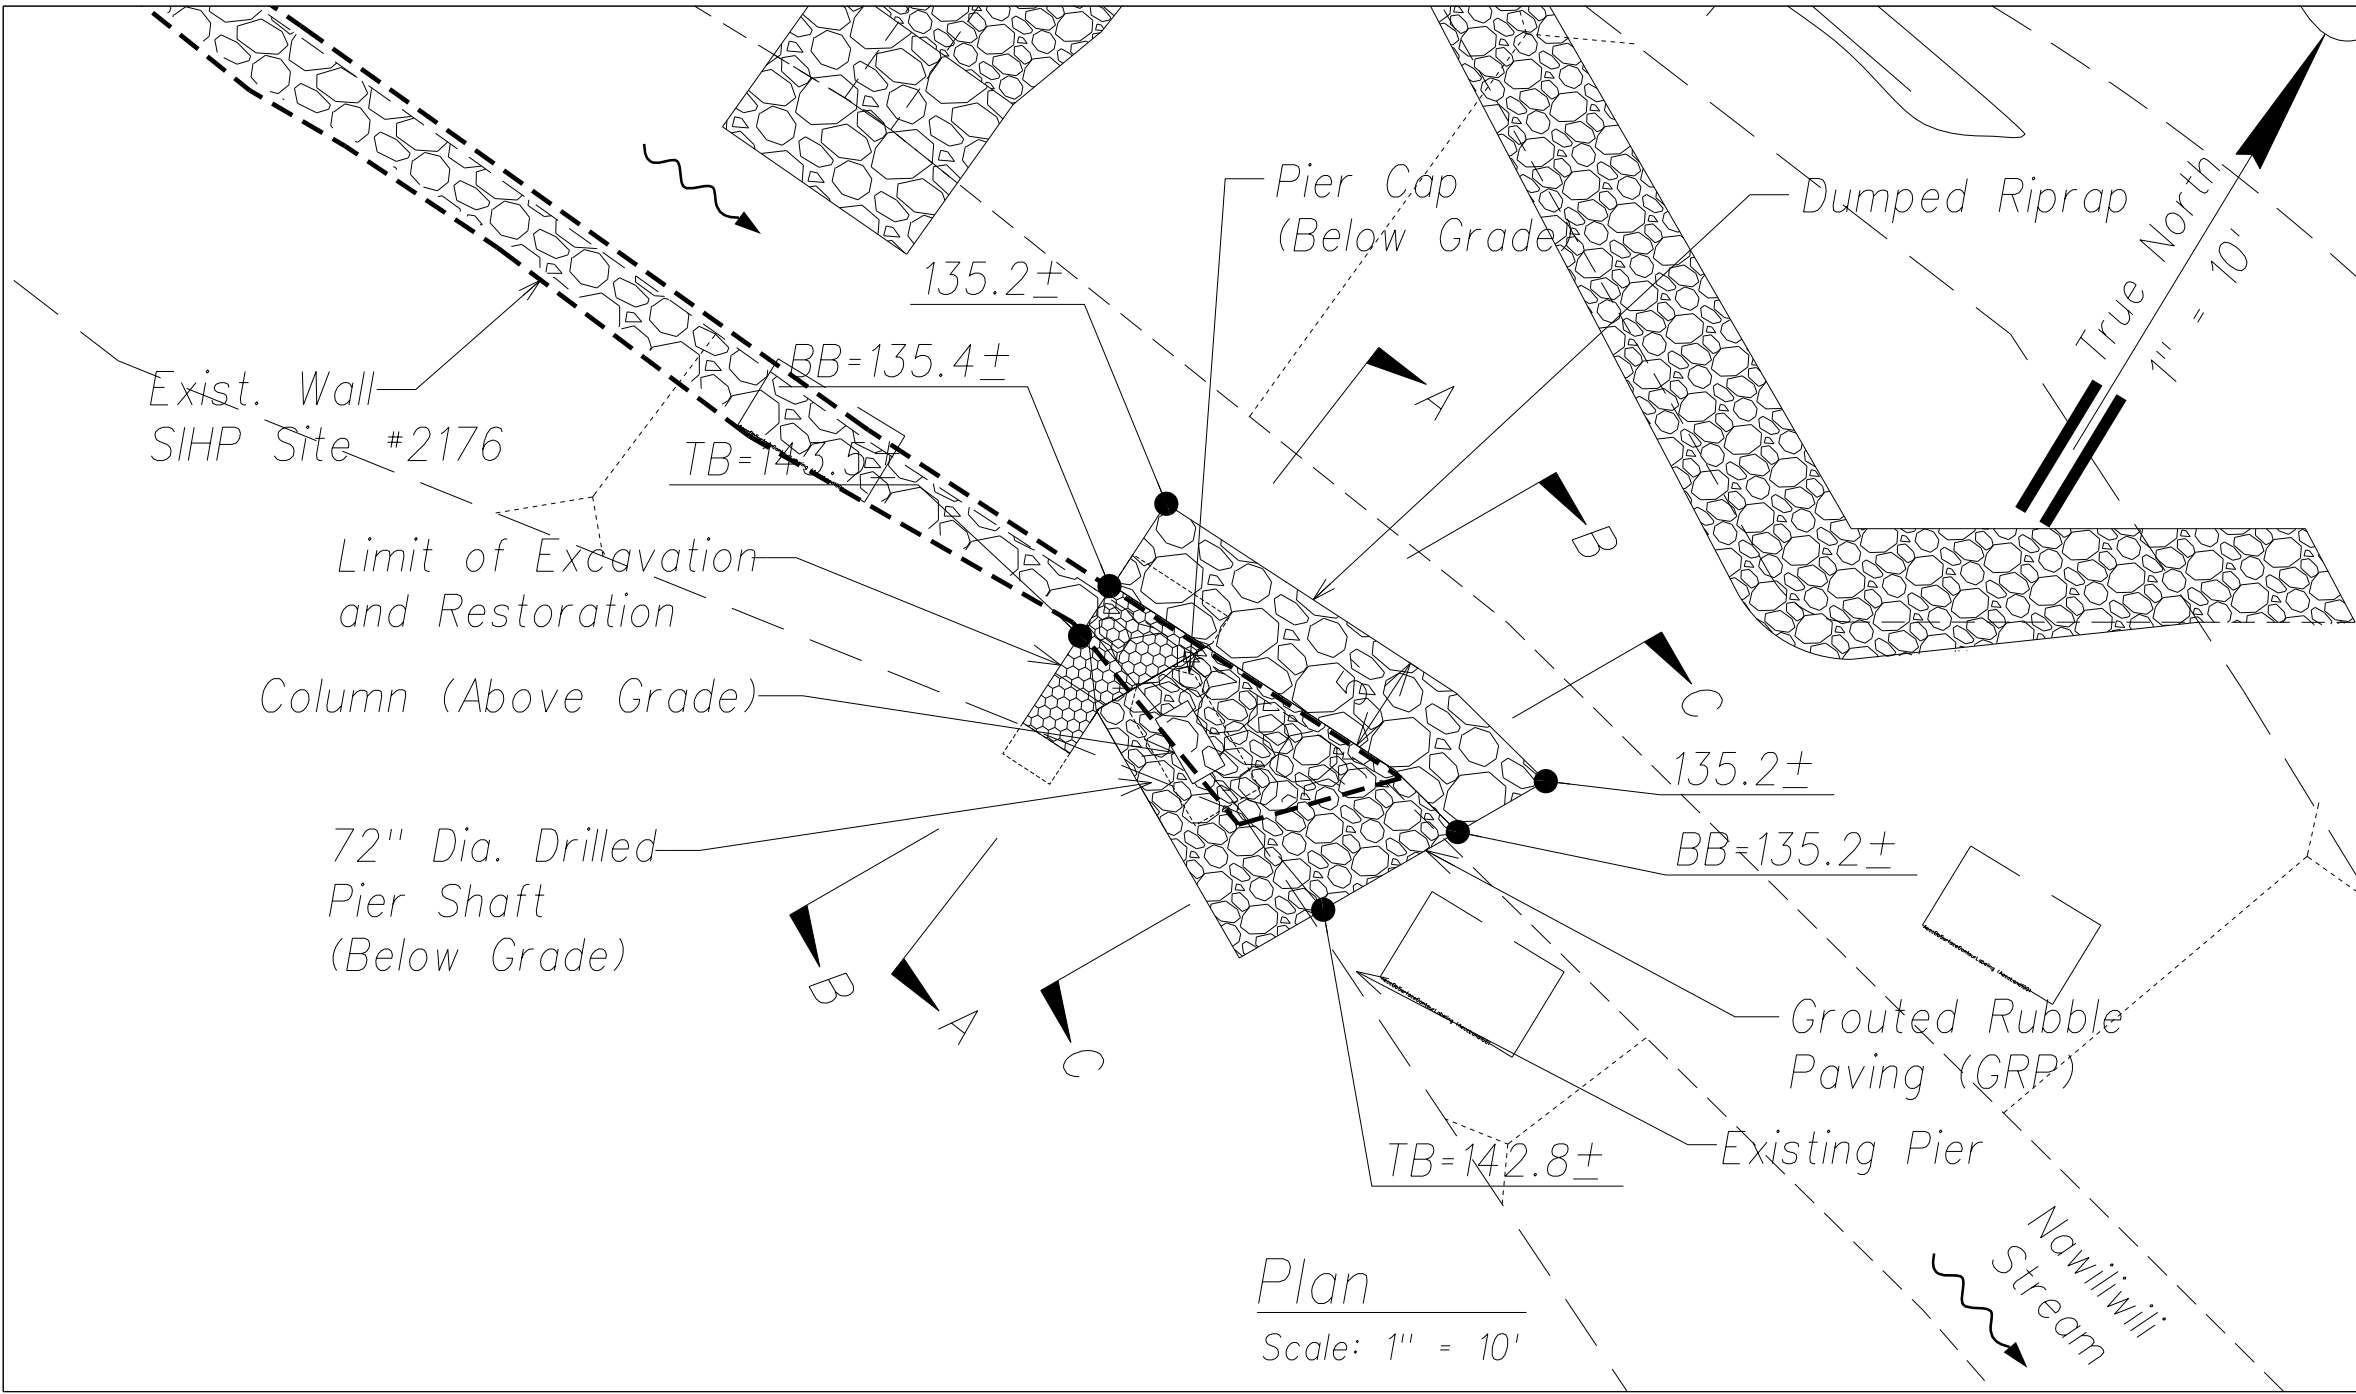


Legend:

- 168.90 Finished Grade Elevation
- TB=168.90 Top of Bank Elevation
- BB=168.90 Bottom of Bank Elevation

Graphic Scales:

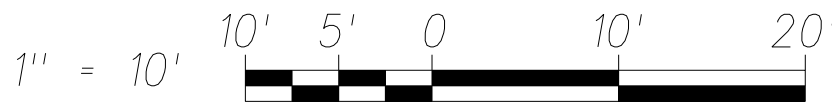

Scale in Feet

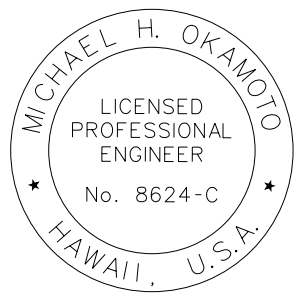

THIS WORK WAS PREPARED BY ME OR UNDER MY SUPERVISION AND CONSTRUCTION OF THIS PROJECT WILL BE UNDER MY OBSERVATION.

SIGNATURE April 30, 2016 EXPIRATION DATE OF THE LICENSE

STATE OF HAWAII
DEPARTMENT OF TRANSPORTATION
HIGHWAYS DIVISION
**BANK RECONSTRUCTION AT
72-INCH DRILLED SHAFT**
PHASE 1 - KAUMUALII HIGHWAY
LIHUE MILL BRIDGE TO RICE STREET
PHASE 2 - NAWILIILI STREAM BRIDGE
AND MAUKA WIDENING
Scale: As Shown Date: March 25, 2013
SHEET No. C-62 OF 84 SHEETS

SURVEY PLOTTED BY	DATE
DRAWN BY	
TRACED BY	
DESIGNED BY	
QUANTITIES BY	
CHECKED BY	
ORIGINAL PLAN	
NOTE BOOK	
No.	

"AS-BUILT"

MODEL