


FED. ROAD DIST. NO.	STATE	FED. AID PROJ. NO.	FISCAL YEAR	SHEET NO.	TOTAL SHEETS
HAWAII	HAW.	ARR-050-1(036)	FY13/14	41	131

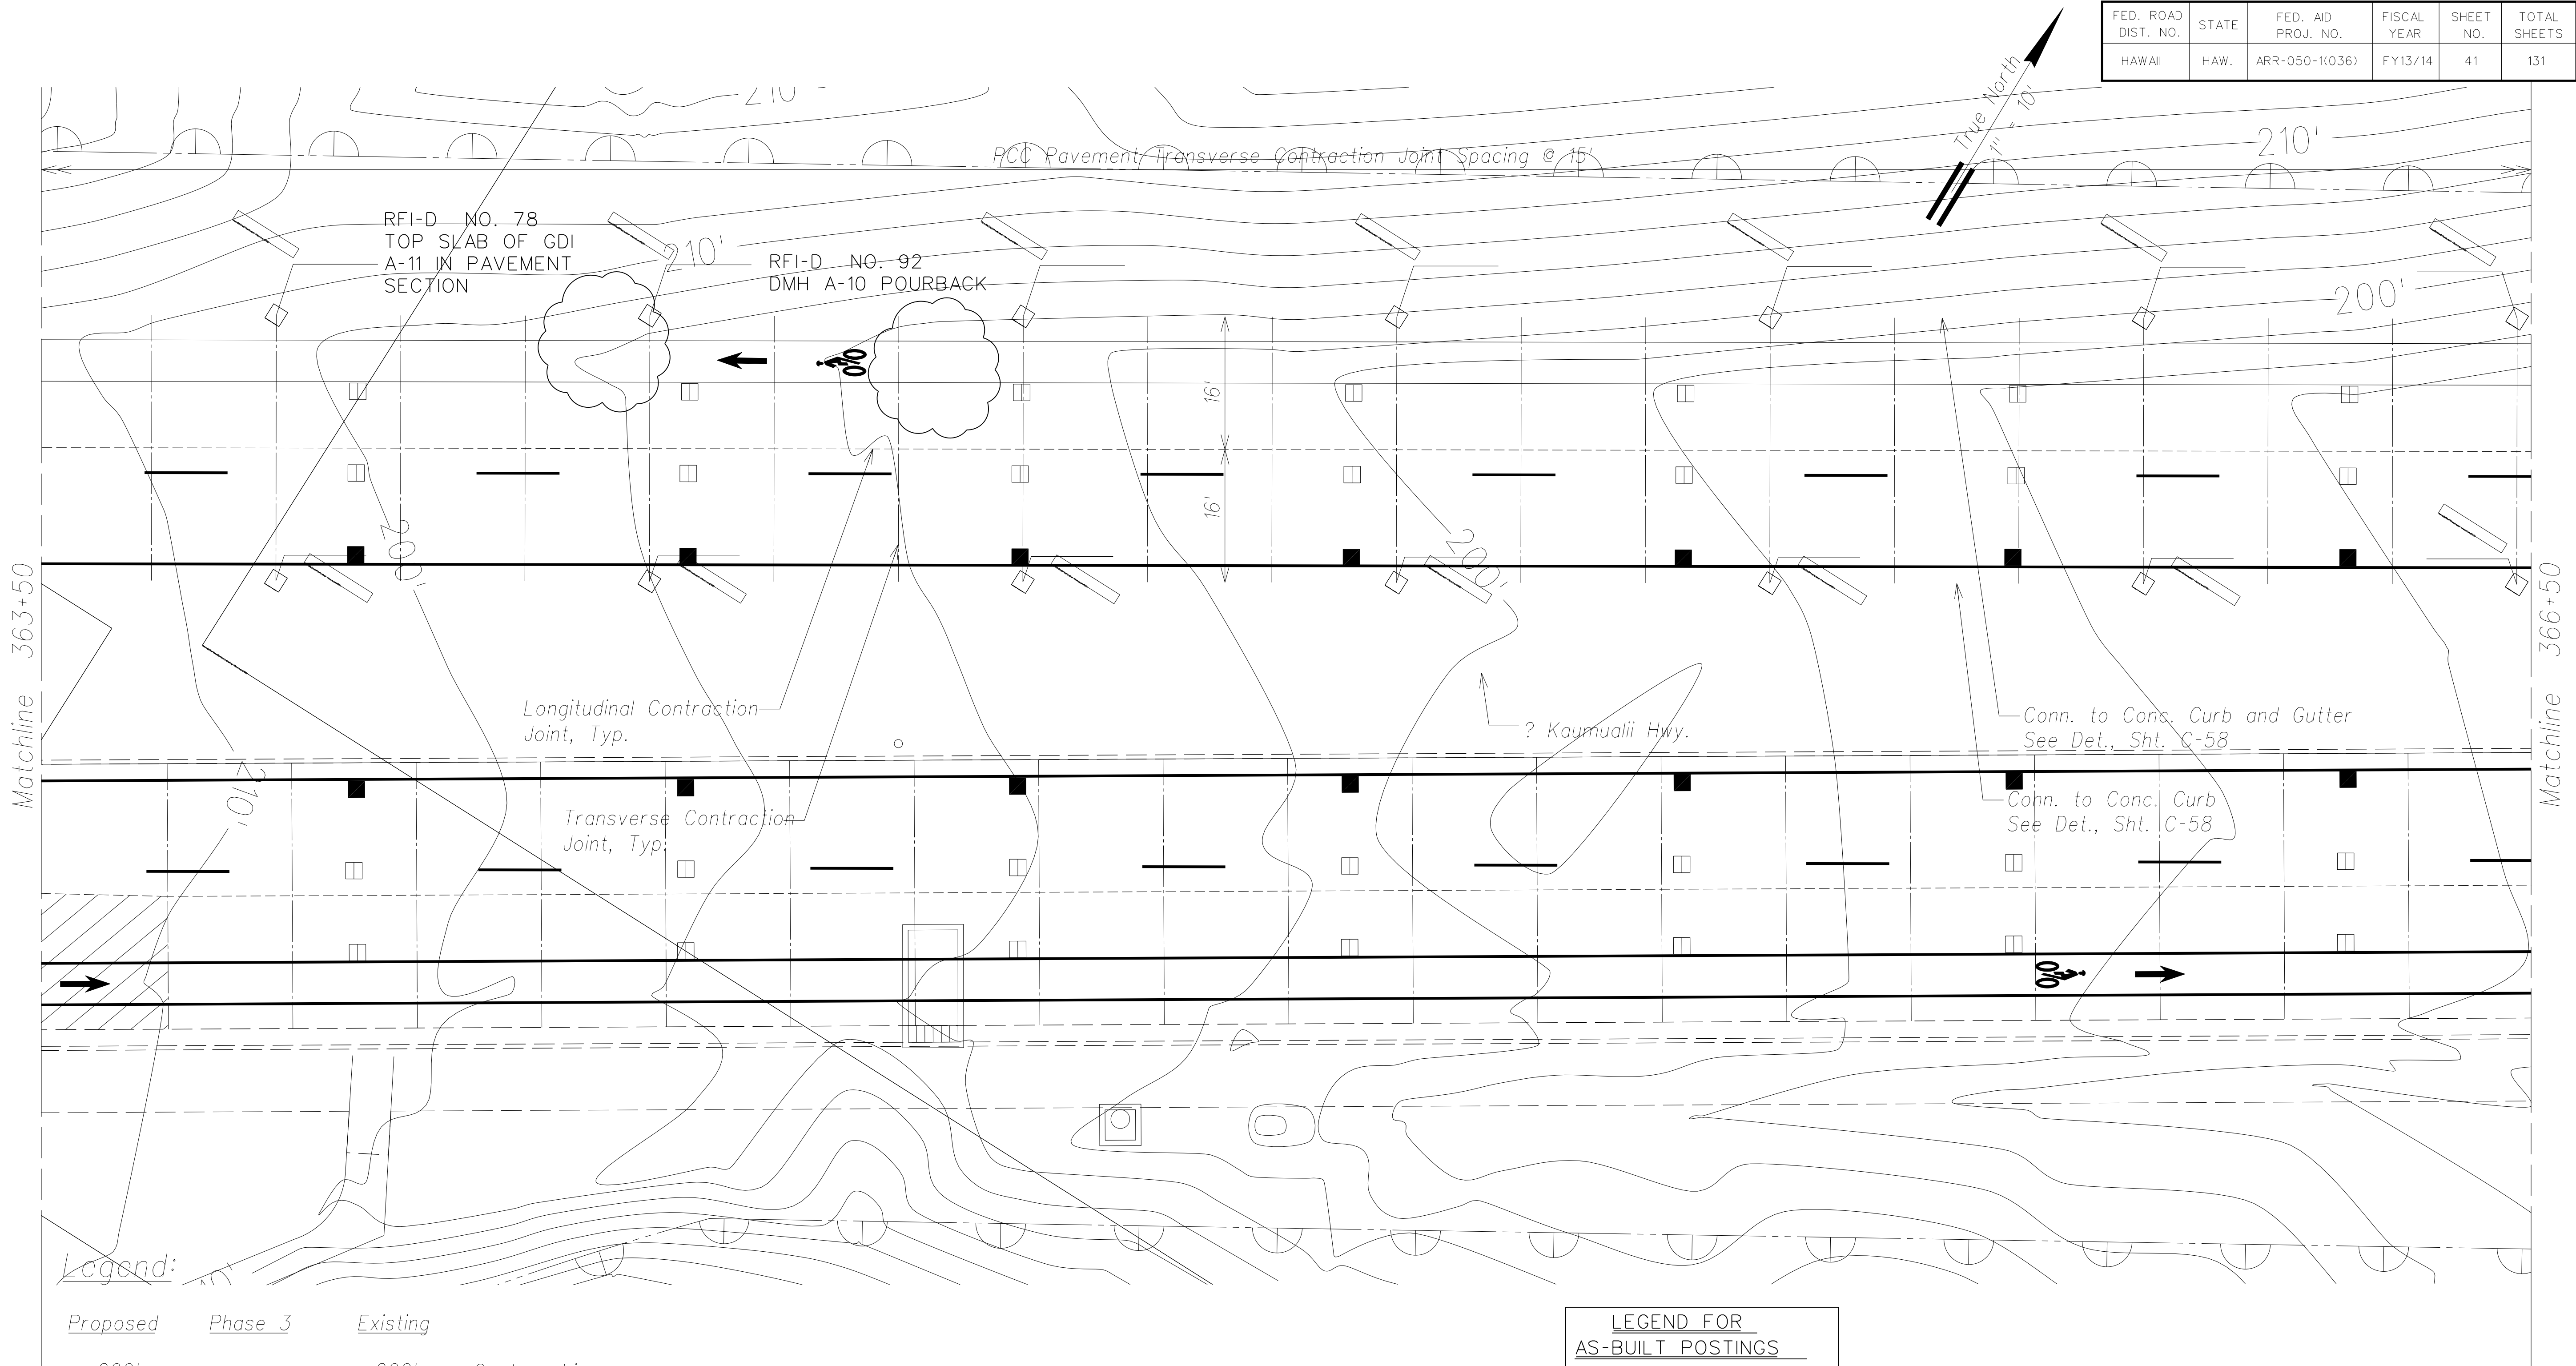


Legend:


Proposed	Phase 3	Existing	
—200'—	—200'—	—200'—	Contour Line
— — — —	— — — —	— — — —	Typical Transverse Joint
- - - - -	- - - - -	- - - - -	Typical Longitudinal Joint
			Odd Shaped Slabs
370+00.00			? Sta. of Finished Pavement Spot Elevation
250.00			Finished Pavement Spot Elevation

Paving Plan (Sta. 363+50 to Sta. 366+50)
Scale: 1" = 10'

LEGEND FOR AS-BUILT POSTINGS	
	Squiggly line for as-built deletion
	Double line for as-built deletion
Roadway	Text for as-built posting

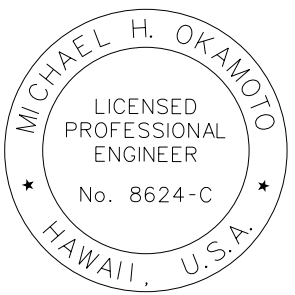

THIS WORK WAS PREPARED BY ME OR UNDER MY SUPERVISION AND CONSTRUCTION OF THIS PROJECT WILL BE UNDER MY OBSERVATION.

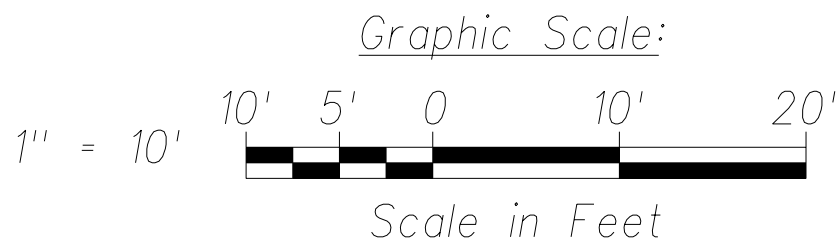


07/30/14	Δ	New sheet. Replace Roadway Elevations Plan.
Date	Revision	
STATE OF HAWAII DEPARTMENT OF TRANSPORTATION HIGHWAYS DIVISION		
PAVING PLAN (Sta. 363+50 to Sta. 366+50) PHASE 1 - KAUMUALII HIGHWAY LIHUE MILL BRIDGE TO RICE STREET PHASE 2 - NAWILIWILI STREAM BRIDGE AND MAUKA WIDENING		
Scale: As Shown		Date: March 25, 2013
SHEET No. C-40 OF 84 SHEETS		

SURVEY PLOTTED BY	DATE
DRAWN BY	
TRACED BY	
DESIGNED BY	
QUANTITIES BY	
CHECKED BY	
ORIGINAL PLAN	
NOTE BOOK	
No.	

"AS-BUILT"

FED. ROAD DIST. NO.	STATE	FED. AID PROJ. NO.	FISCAL YEAR	SHEET NO.	TOTAL SHEETS
HAWAII	HAW.	ARR-050-1(036)	FY13/14	41	131

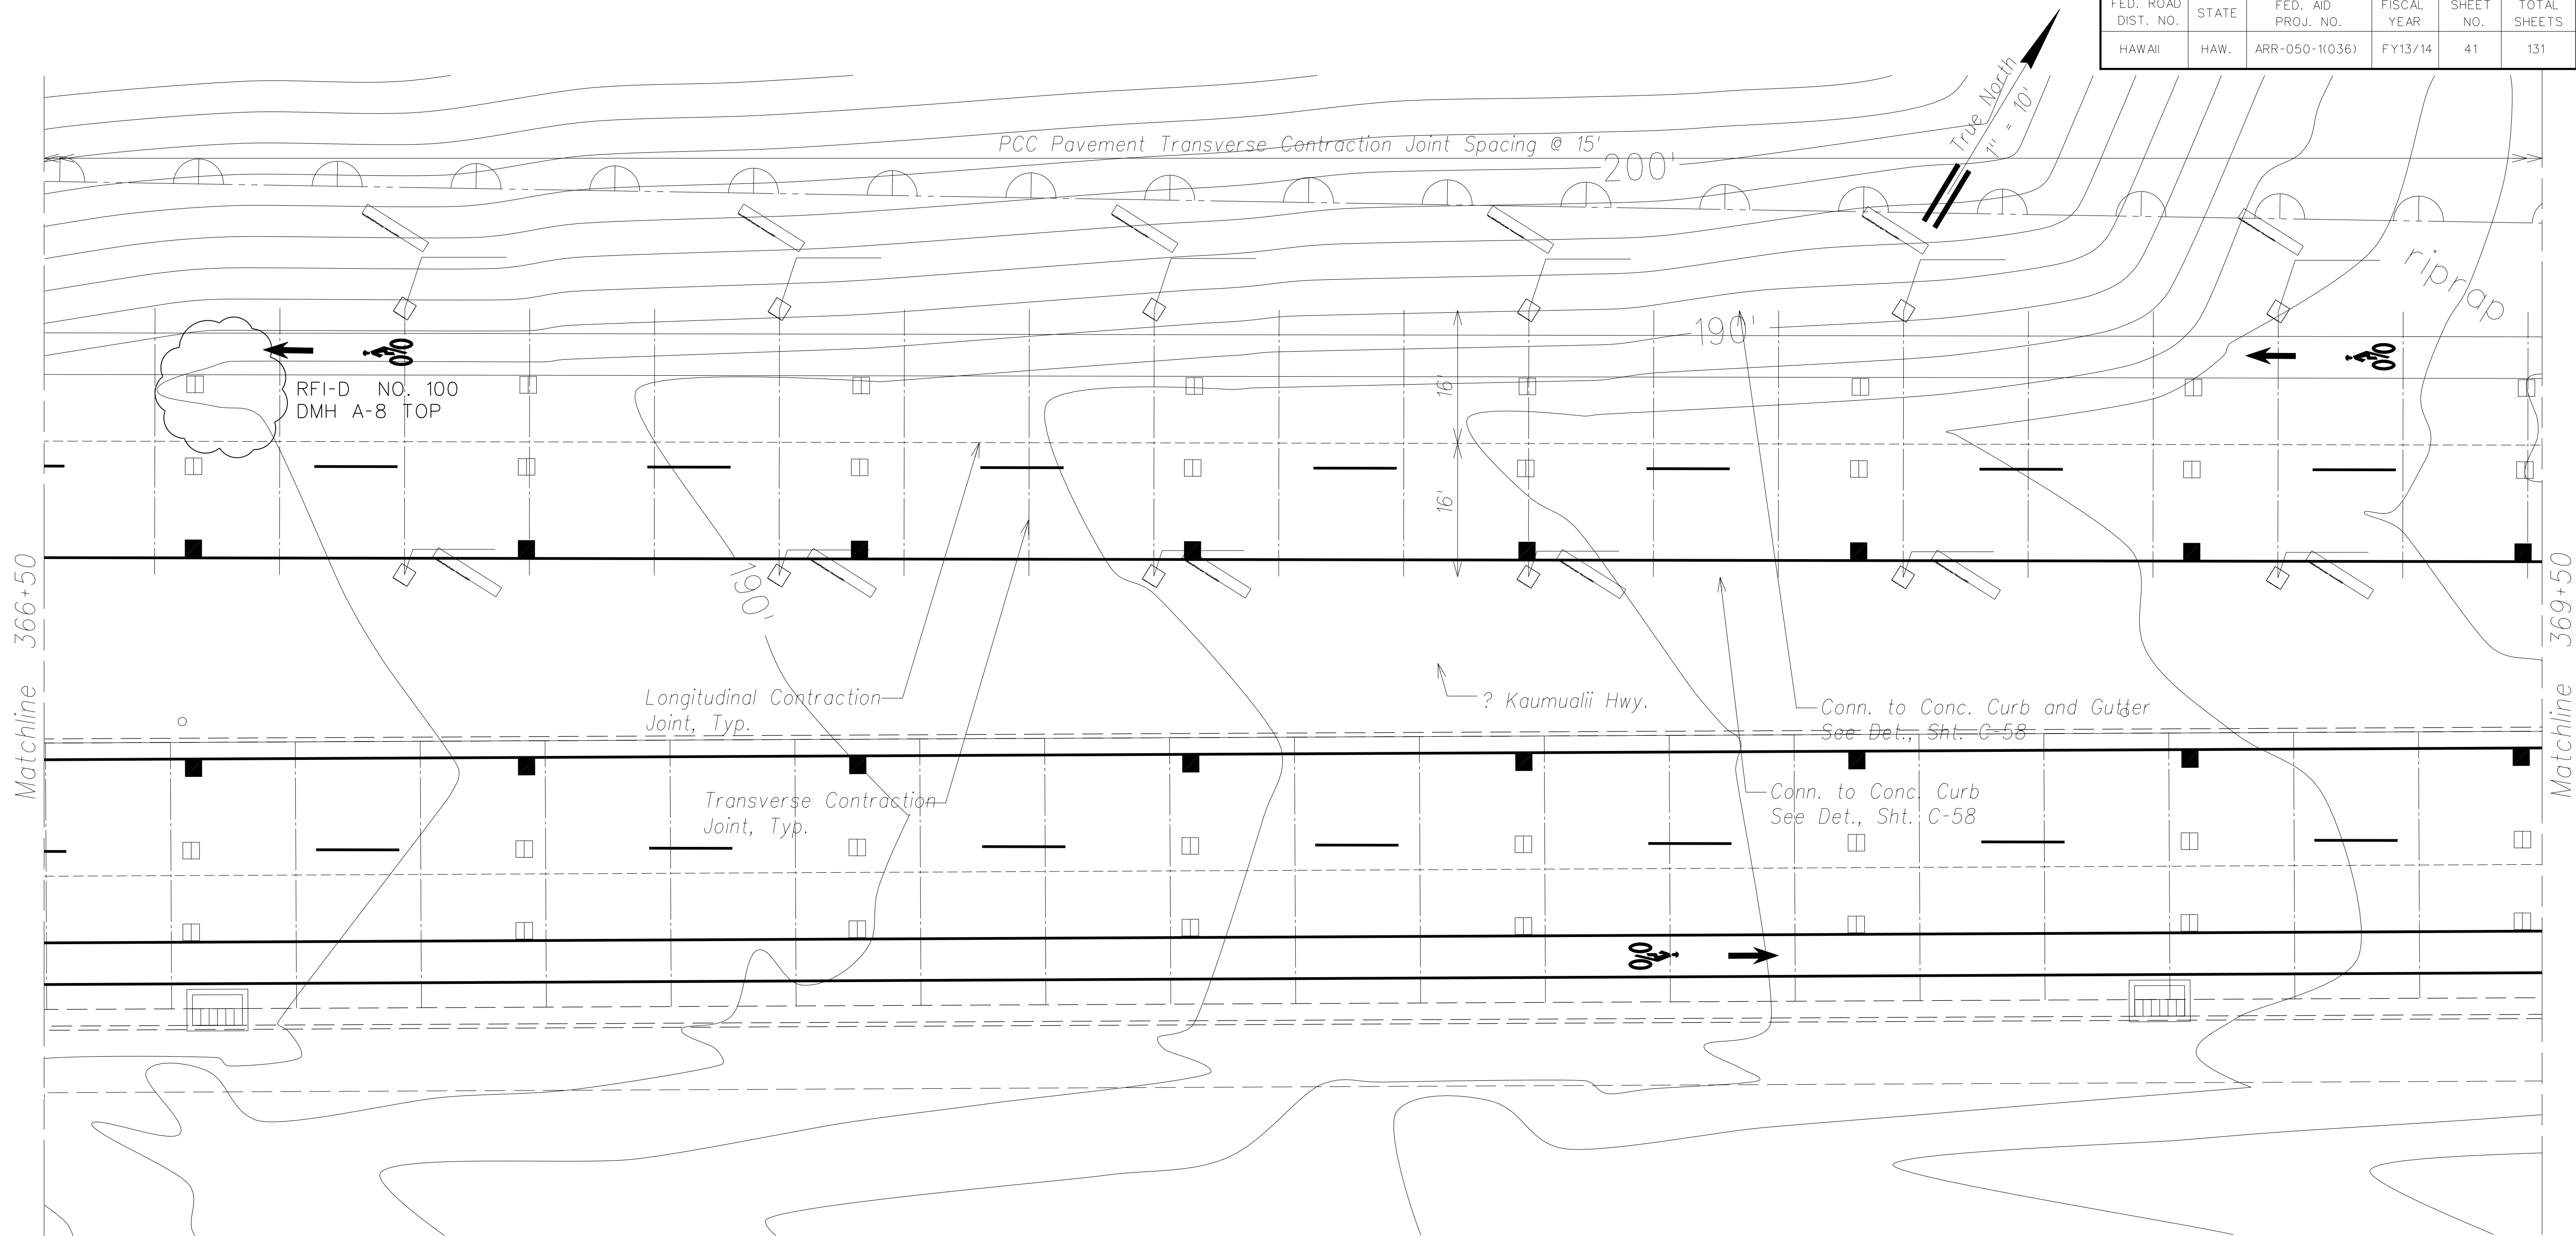


Legend:


Proposed	Phase 3	Existing	
—200'—		—200'—	Contour Line
— — — —		— — — —	Typical Transverse Joint
- - - - -		- - - - -	Typical Longitudinal Joint
▨ ▨ ▨ ▨	▨ ▨ ▨ ▨		Odd Shaped Slabs
370+00.00		•	? Sta. of Finished Pavement Spot Elevation
250.00		•	Finished Pavement Spot Elevation

Paving Plan (Sta. 366+50 to Sta. 369+50)
Scale: 1" = 10'

LEGEND FOR AS-BUILT POSTINGS	
	Squiggly line for as-built deletion
	Double line for as-built deletion
	Text for as-built posting

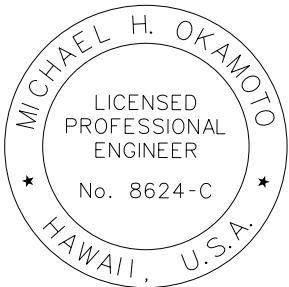

THIS WORK WAS PREPARED BY ME OR UNDER MY SUPERVISION AND CONSTRUCTION OF THIS PROJECT WILL BE UNDER MY OBSERVATION.

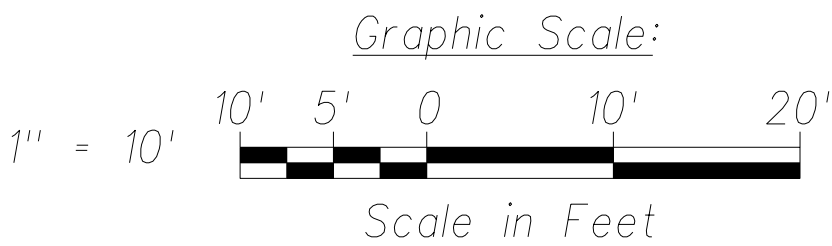


07/30/14	△ New sheet. Replace Roadway Elevations Plan.
Date	Revision
STATE OF HAWAII DEPARTMENT OF TRANSPORTATION HIGHWAYS DIVISION	
PAVING PLAN (Sta. 366+50 to Sta. 369+50) PHASE 1 - KAUMUALII HIGHWAY LIHUE MILL BRIDGE TO RICE STREET PHASE 2 - NAWILIWILI STREAM BRIDGE AND MAUKA WIDENING	
Scale: As Shown	Date: March 25, 2013
SHEET No. C-40 OF 84 SHEETS	

SIGNATURE _____
EXPIRATION DATE OF THE LICENSE

SURVEY PLOTTED BY _____	DATE _____
DRAWN BY _____	DESIGNED BY _____
NOTE BOOK _____	CHECKED BY _____
ORIGINAL PLAN _____	No. _____

"AS-BUILT"

FED. ROAD DIST. NO.	STATE	FED. AID PROJ. NO.	FISCAL YEAR	SHEET NO.	TOTAL SHEETS
HAWAII	HAW.	ARR-050-1(036)	FY13/14	41	131


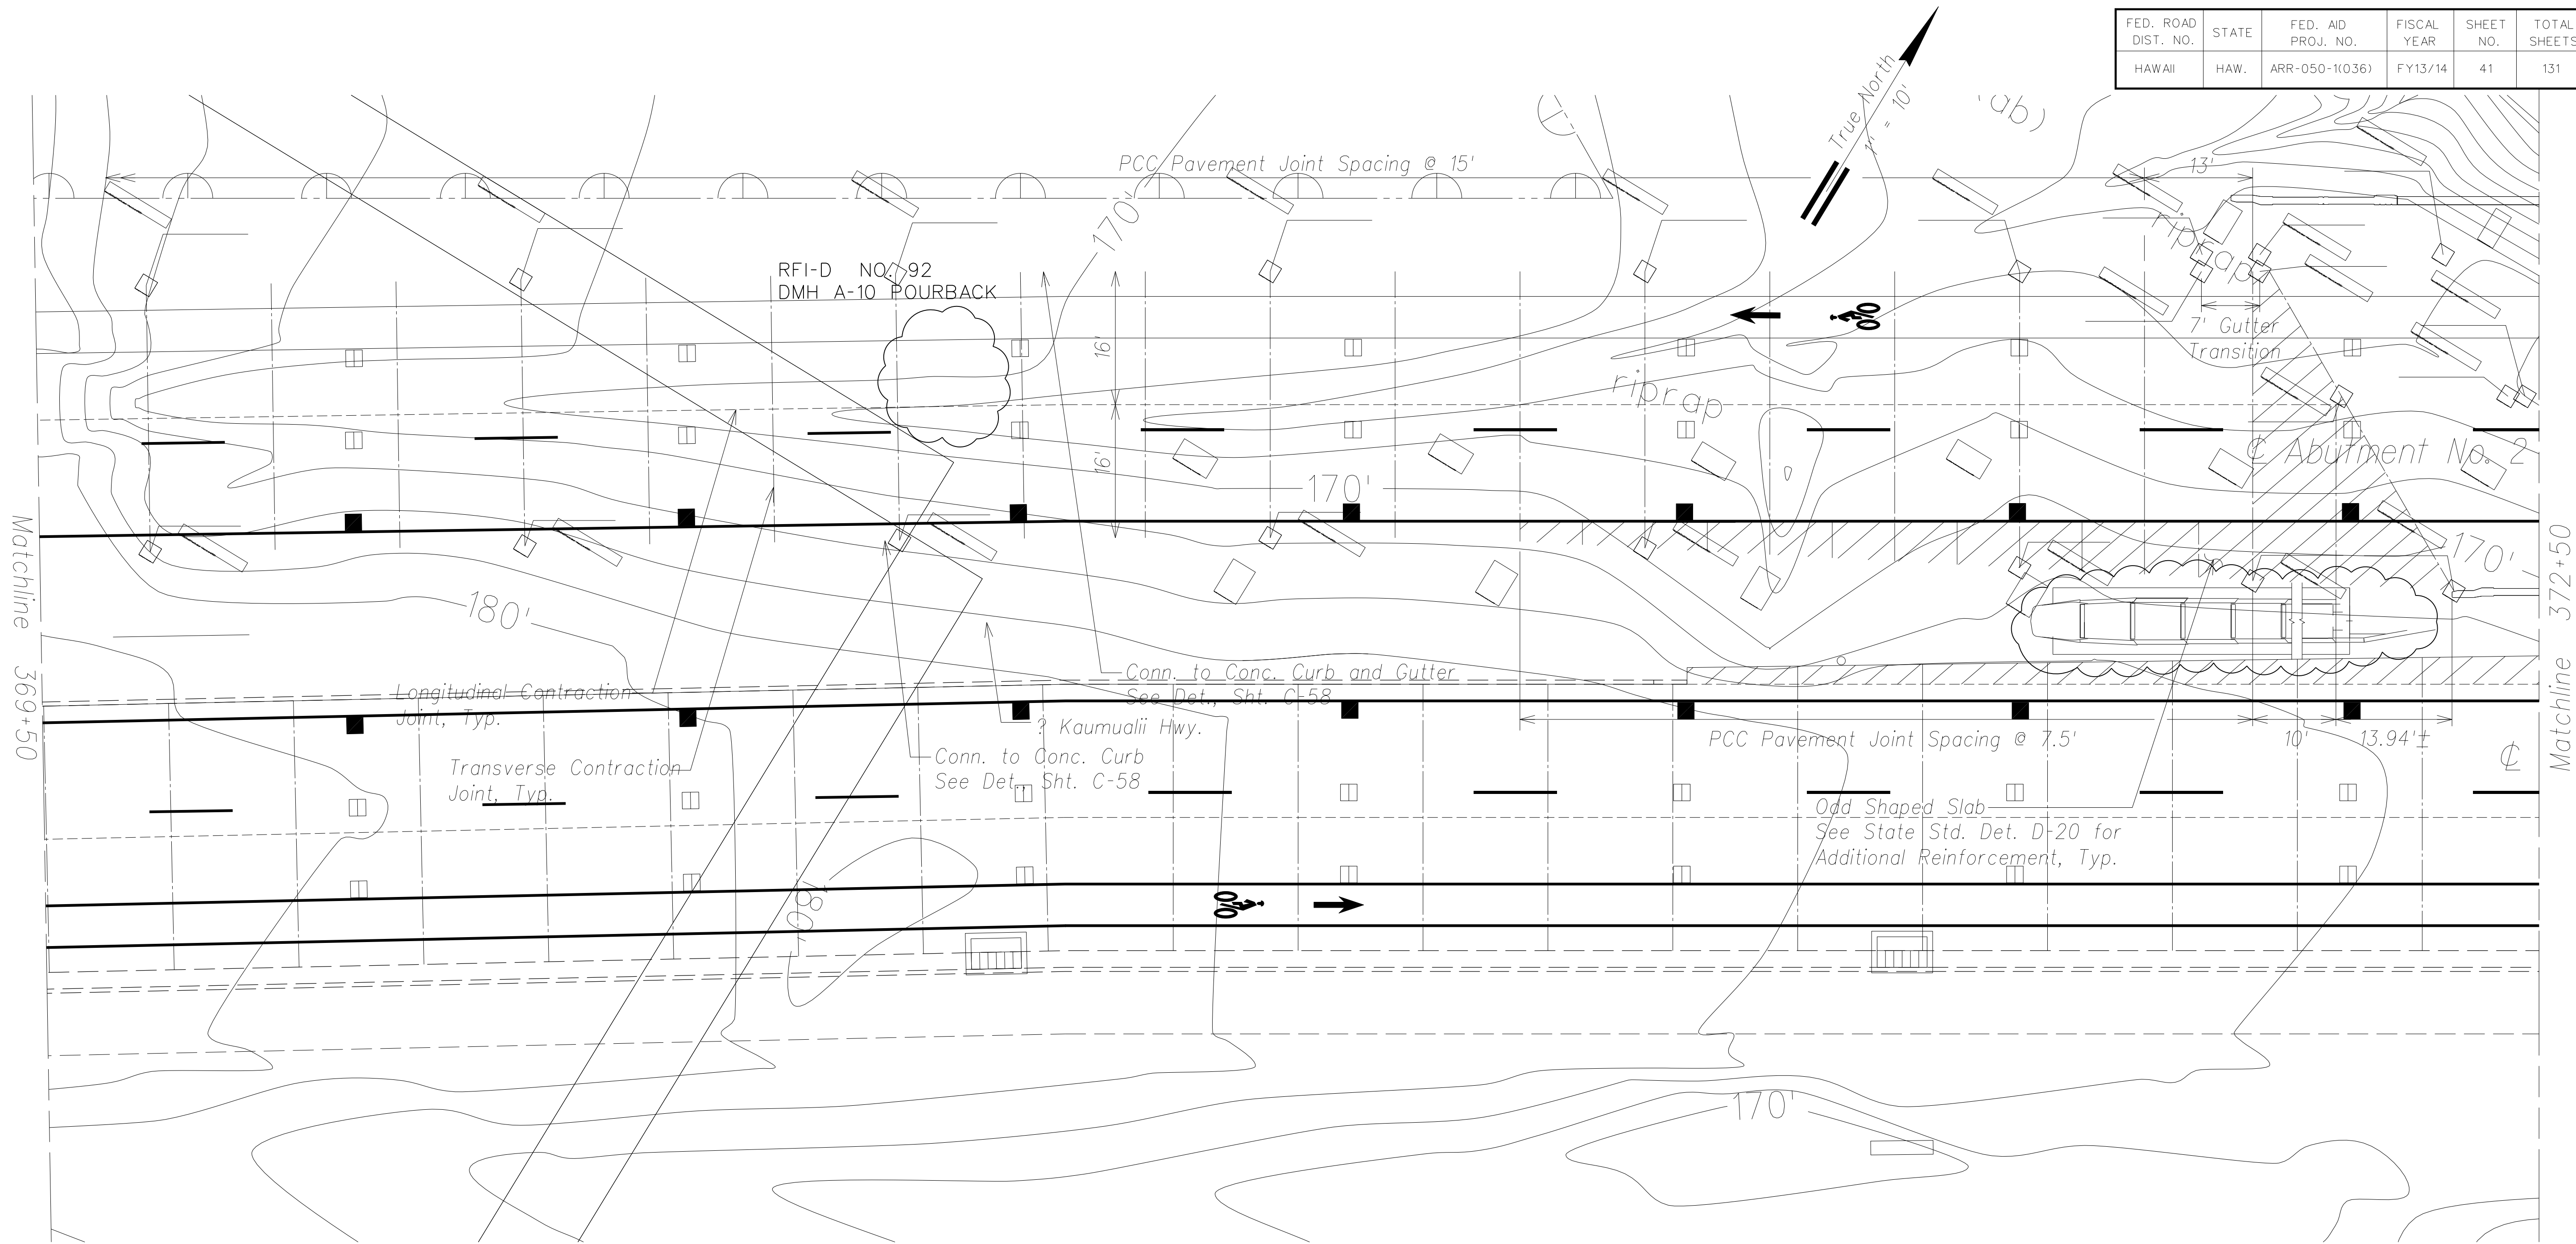


Legend:

<u>Proposed</u>	<u>Phase 3</u>	<u>Existing</u>	
—200'—	—200'—	—200'—	Contour Line
----	----	----	Typical Transverse Joint
-----	-----	-----	Typical Longitudinal Joint
			Odd Shaped Slabs
370+00.00			? Sta. of Finished Pavement Spot Elevation
250.00			Finished Pavement Spot Elevation

Paving Plan (Sta. 369+50 to Sta. 372+50)
Scale: 1" = 10'

LEGEND FOR AS-BUILT POSTINGS	
	Squiggly line for as-built deletion
	Double line for as-built deletion
	Text for as-built posting

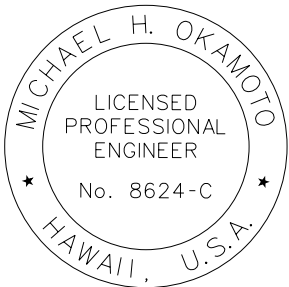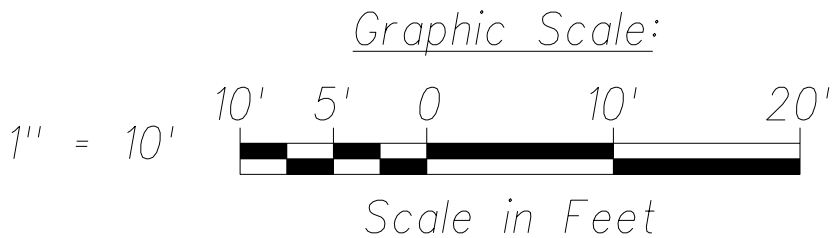

THIS WORK WAS PREPARED BY ME OR UNDER MY SUPERVISION AND CONSTRUCTION OF THIS PROJECT WILL BE UNDER MY OBSERVATION.


SIGNATURE
April 30, 2016
EXPIRATION DATE OF THE LICENSE

07/30/14	Δ New sheet. Replace Roadway Elevations Plan.
Date	Revision
STATE OF HAWAII DEPARTMENT OF TRANSPORTATION HIGHWAYS DIVISION	
PAVING PLAN (Sta. 369+50 to Sta. 372+50) PHASE 1 - KAUMUALII HIGHWAY LIHUE MILL BRIDGE TO RICE STREET PHASE 2 - NAWILIWILI STREAM BRIDGE AND MAUKA WIDENING	
Scale: As Shown	Date: March 25, 2013
SHEET No. C-40 OF 84 SHEETS	

SURVEY PLOTTED BY	DATE
DRAWN BY	
TRACED BY	
DESIGNED BY	
QUANTITIES BY	
CHECKED BY	
ORIGINAL PLAN	
NOTE BOOK	
No.	

"AS-BUILT"



FED. ROAD DIST. NO.	STATE	FED. AID PROJ. NO.	FISCAL YEAR	SHEET NO.	TOTAL SHEETS
HAWAII	HAW.	ARR-050-1(036)	FY13/14	41	131

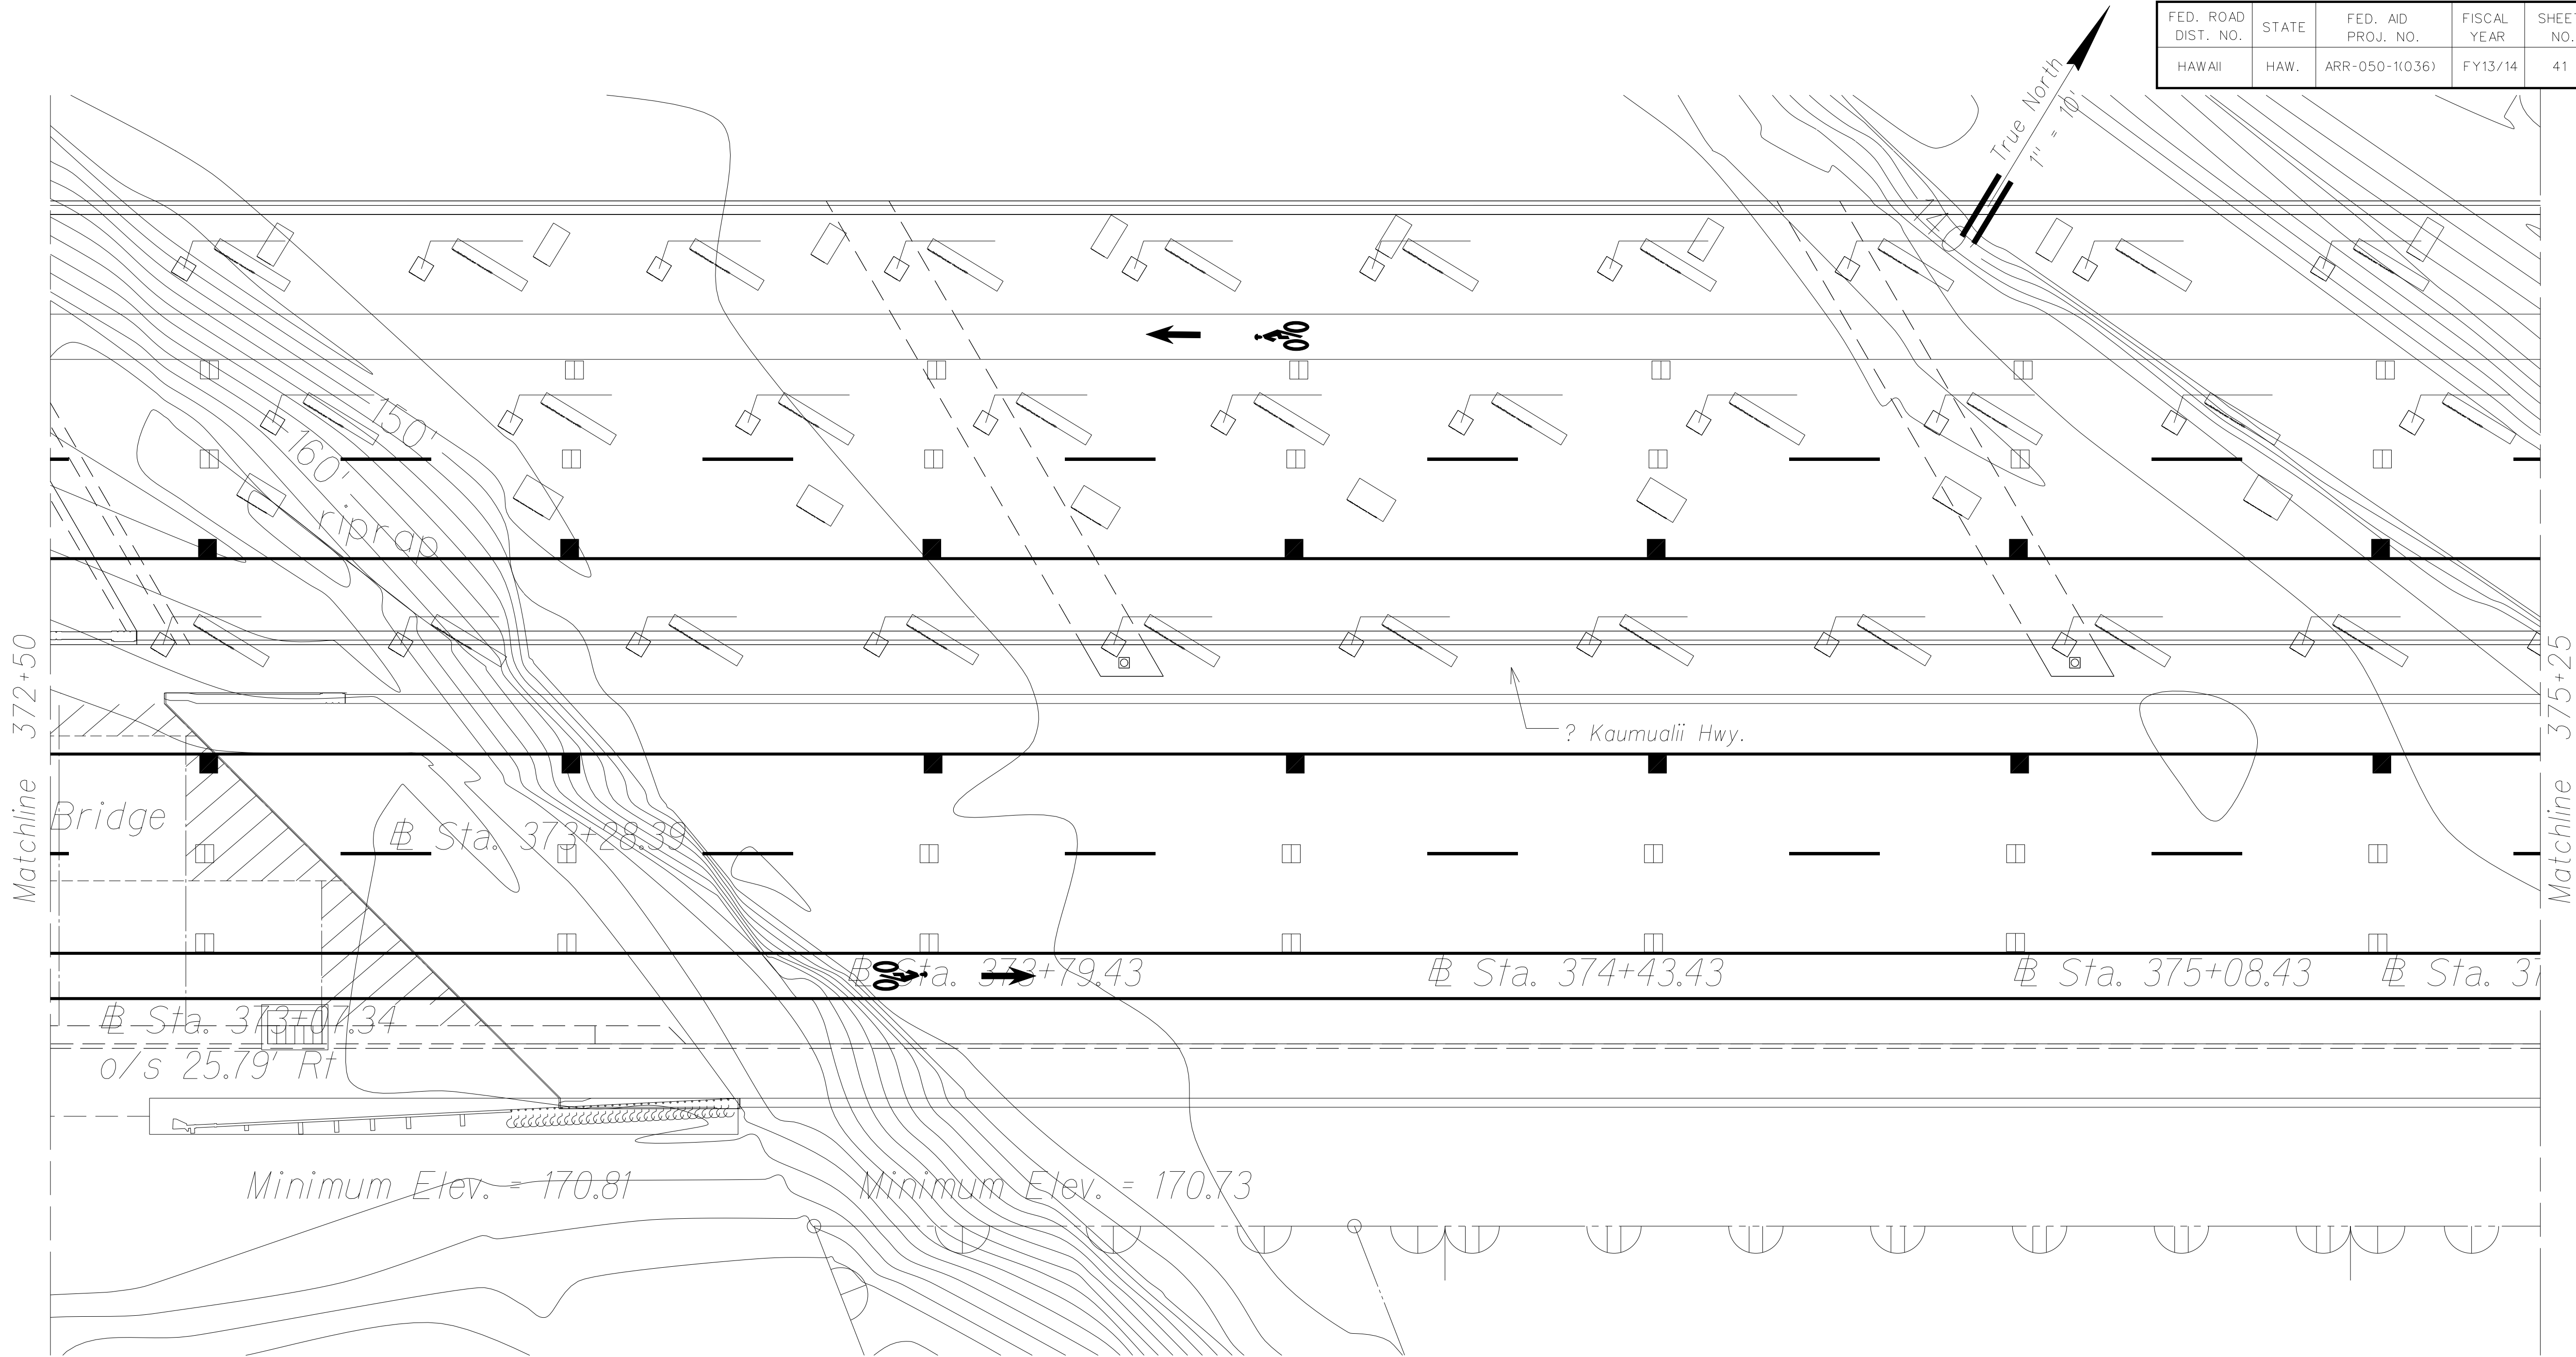

Legend:

- | | | |
|-----------|-----------|--|
| Proposed | Phase 3 | Existing |
| —200'— | —200'— | Contour Line |
| — | — | Typical Transverse Joint |
| - - - - - | - - - - - | Typical Longitudinal Joint |
| ▨ | ▨ | Odd Shaped Slabs |
| 370+00.00 | 250.00 | ? Sta. of Finished Pavement Spot Elevation |
| | | Finished Pavement Spot Elevation |

Paving Plan (Sta. 372+50 to Sta. 375+25)
Scale: 1" = 10'

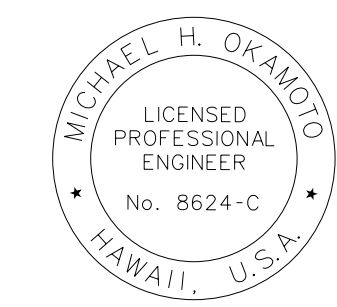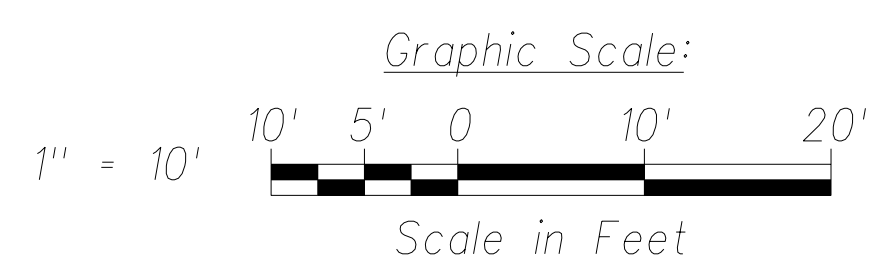

THIS WORK WAS PREPARED BY ME OR UNDER MY SUPERVISION AND CONSTRUCTION OF THIS PROJECT WILL BE UNDER MY OBSERVATION.


Signature: _____
Date: April 30, 2016
Expiration Date of the License: _____

07/30/14	Δ	New sheet. Replace Roadway Elevations Plan.
Date	Revision	
STATE OF HAWAII DEPARTMENT OF TRANSPORTATION HIGHWAYS DIVISION		
PAVING PLAN		
(Sta. 372+50 to Sta. 375+25)		
PHASE 1 - KAUMUALII HIGHWAY		
LIHUE MILL BRIDGE TO RICE STREET		
PHASE 2 - NAWILIWILI STREAM BRIDGE		
AND MAUKA WIDENING		
Scale: As Shown		Date: March 25, 2013
SHEET No. C-40 OF 84 SHEETS		

SURVEY PLOTTED BY: _____	DATE: _____
DRAWN BY: _____	DESIGNED BY: _____
TRACED BY: _____	QUANTITIES BY: _____
CHECKED BY: _____	
ORIGINAL PLAN BOOK No. _____	

"AS-BUILT"



FED. ROAD DIST. NO.	STATE	FED. AID PROJ. NO.	FISCAL YEAR	SHEET NO.	TOTAL SHEETS
HAWAII	HAW.	ARR-050-1(036)	FY13/14	41	131

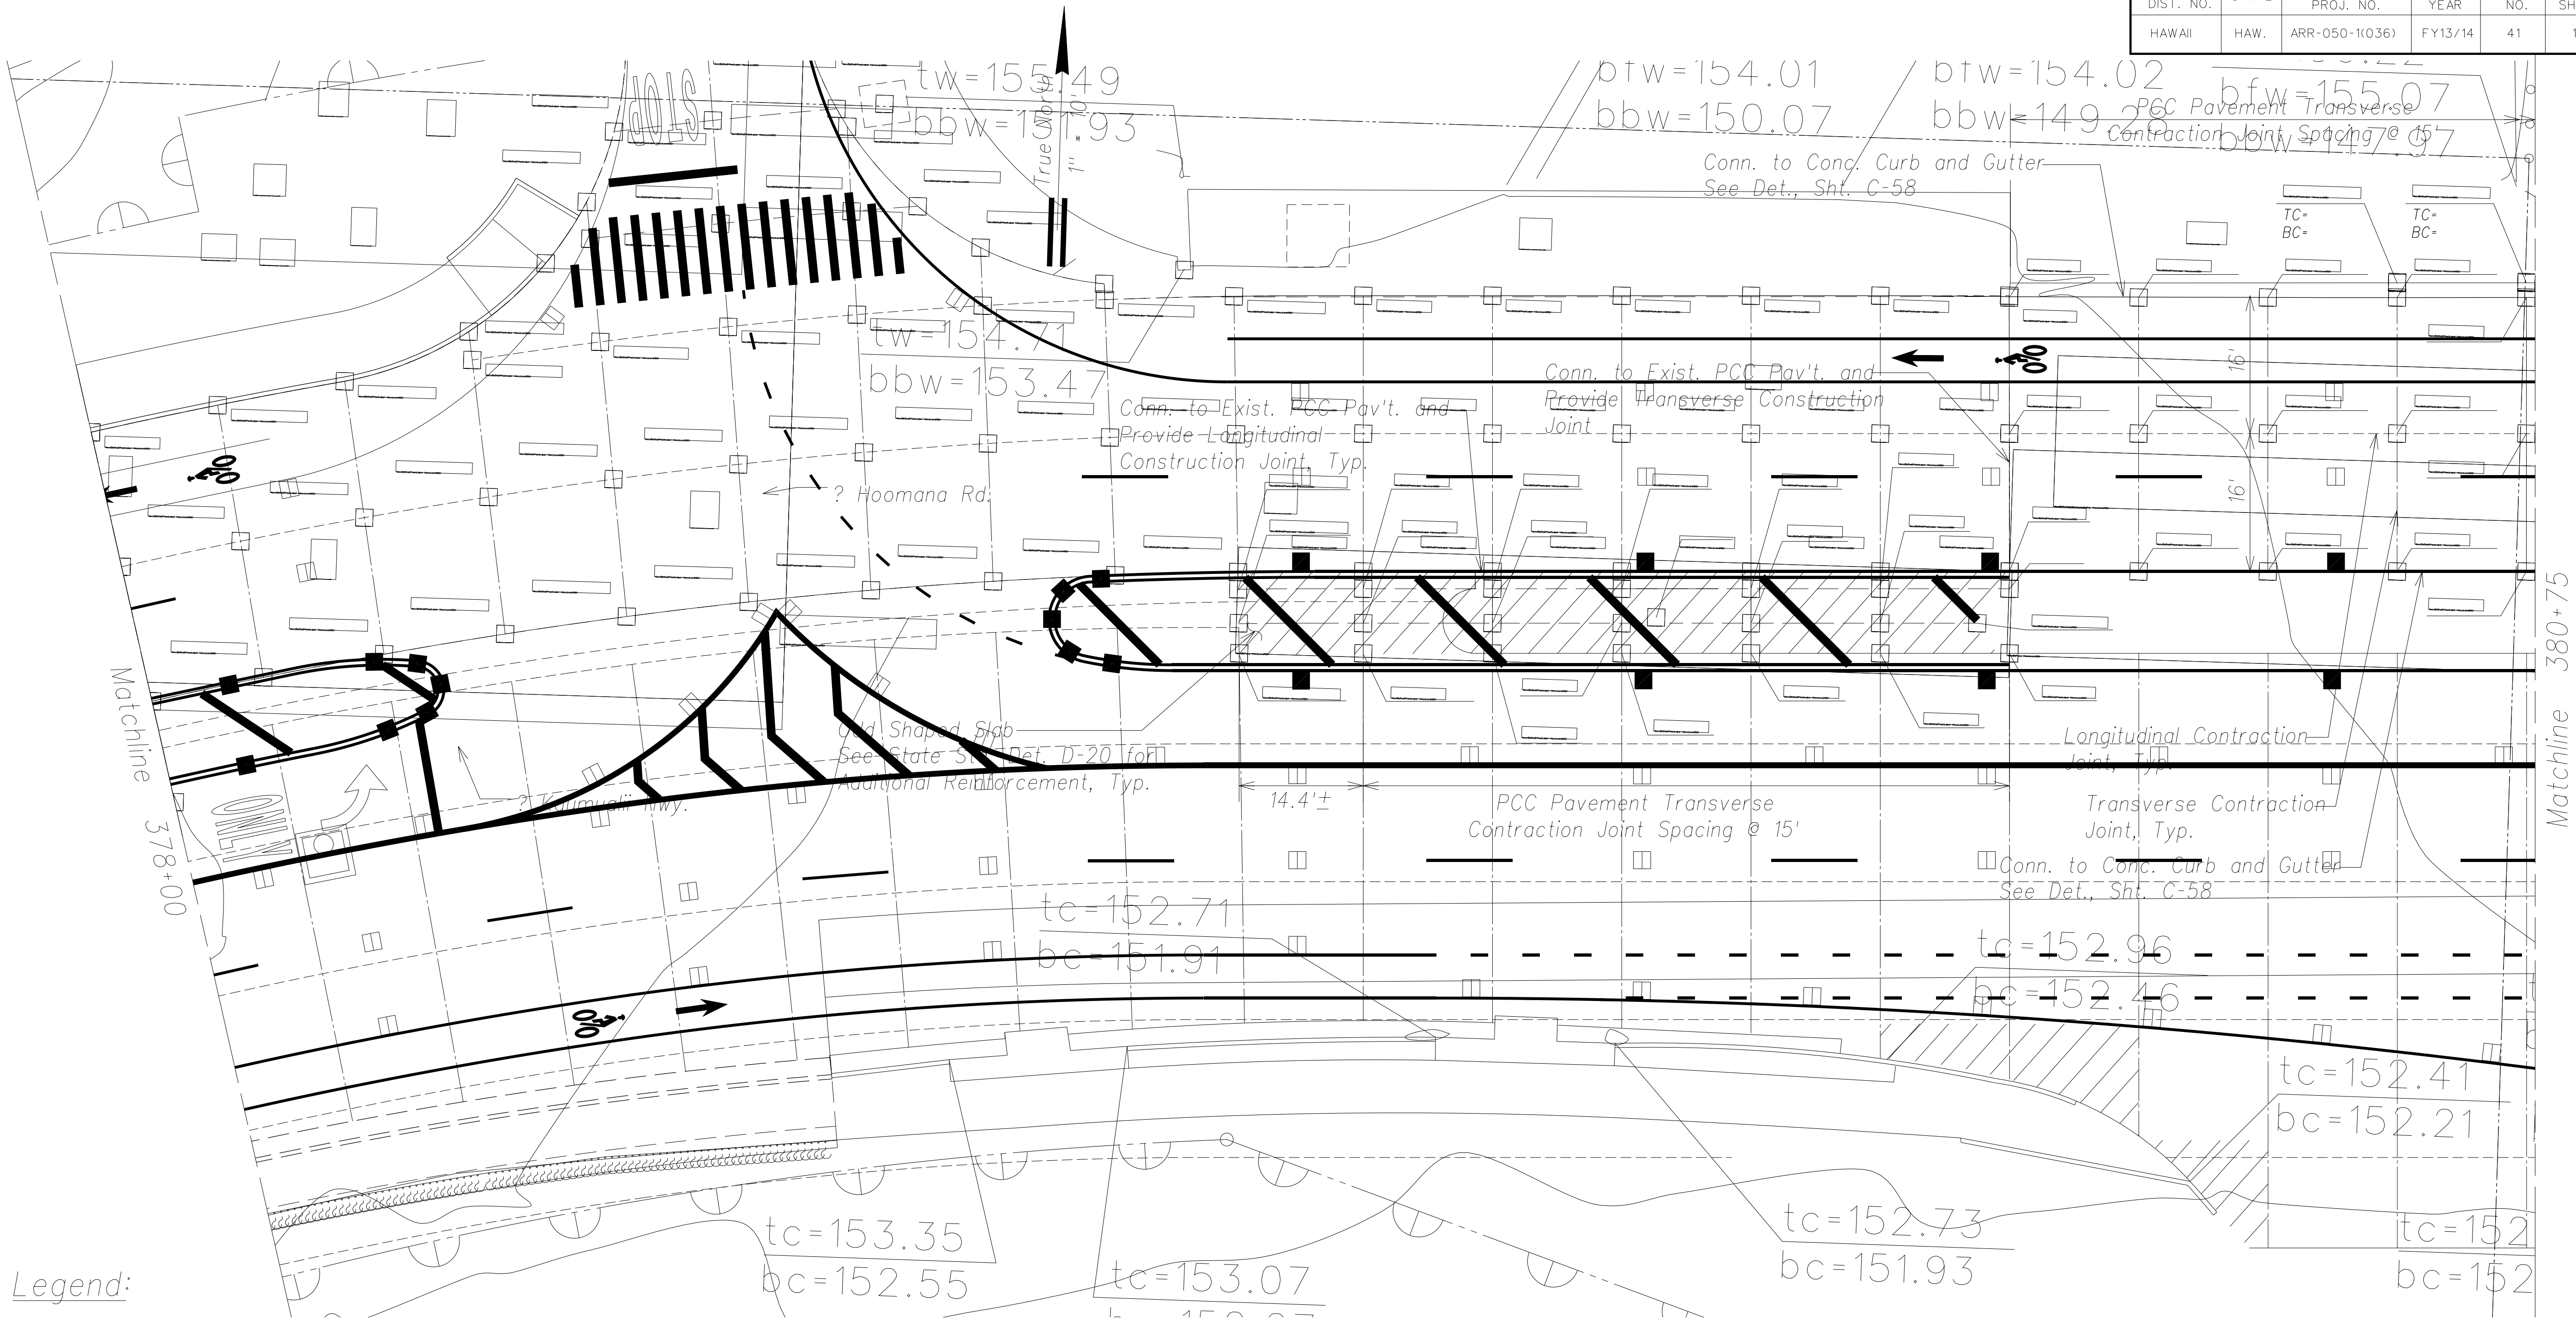

Legend:

- | | | |
|----------|---------|--|
| Proposed | Phase 3 | Existing |
| —200'— | —200'— | Contour Line |
| ---- | ---- | Typical Transverse Joint |
| ---- | ---- | Typical Longitudinal Joint |
| | | Odd Shaped Slabs |
| | | ? Sta. of Finished Pavement Spot Elevation |
| | | Finished Pavement Spot Elevation |
- 370+00.00
250.00

Paving Plan
Scale: 1" = 10'

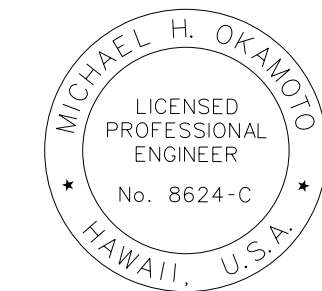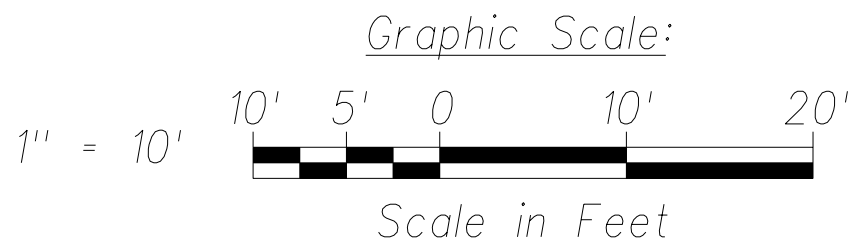


THIS WORK WAS PREPARED BY ME
OR UNDER MY SUPERVISION AND
CONSTRUCTION OF THIS PROJECT
WILL BE UNDER MY OBSERVATION.

SIGNATURE
April 30, 2016
EXPIRATION DATE
OF THE LICENSE

07/30/14	Δ New sheet. Replace Roadway Elevations Plan.
Date	Revision
STATE OF HAWAII DEPARTMENT OF TRANSPORTATION HIGHWAYS DIVISION	
PAVING PLAN	
(Sta. 378+00 to Sta. 380+75)	
PHASE 1 - KAUMUALII HIGHWAY	
LIHUE MILL BRIDGE TO RICE STREET	
PHASE 2 - NAWILIWILI STREAM BRIDGE	
AND MAUKA WIDENING	
Scale: As Shown	Date: March 25, 2013
SHEET No. C-40 OF 84 SHEETS	

"AS-BUILT"

FED. ROAD DIST. NO.	STATE	FED. AID PROJ. NO.	FISCAL YEAR	SHEET NO.	TOTAL SHEETS
HAWAII	HAW.	ARR-050-1(036)	FY13/14	41	131

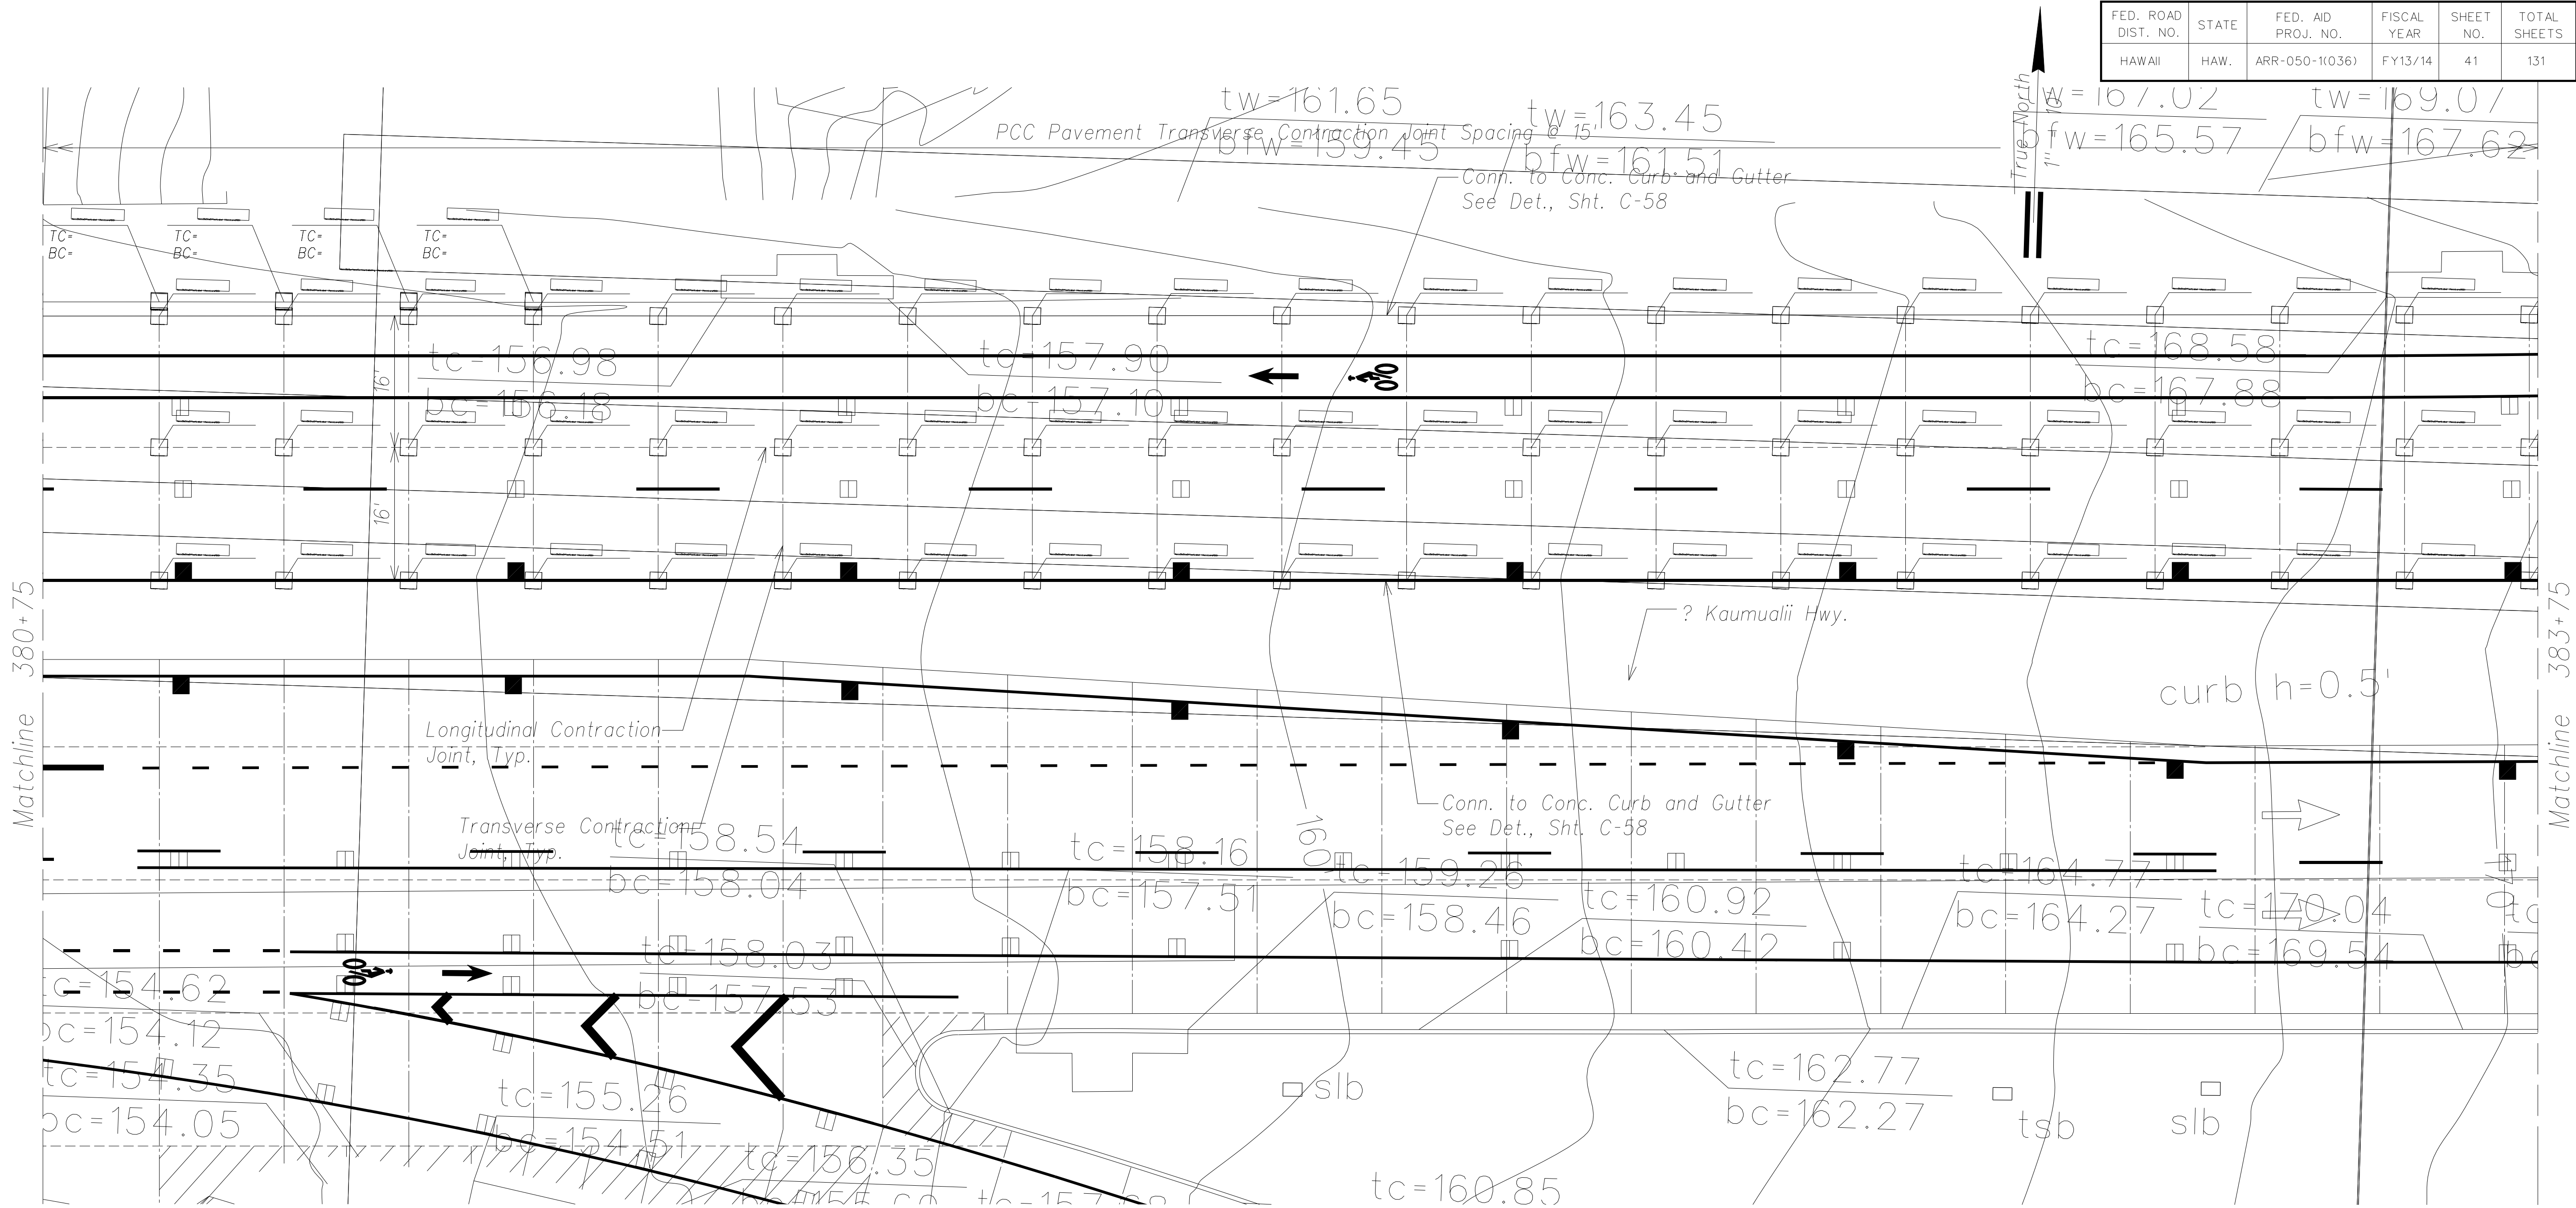

Legend:

- Proposed

Phase 3

Existing
- 200'—

—200'—


—200'—

Contour Line
- -----

Typical Transverse Joint
- -----

Typical Longitudinal Joint
- Odd Shaped Slabs
- ? Sta. of Finished Pavement Spot Elevation
- Finished Pavement Spot Elevation

Paving Plan (Sta. 380+75 to Sta. 383+75)
Scale: 1" = 10'

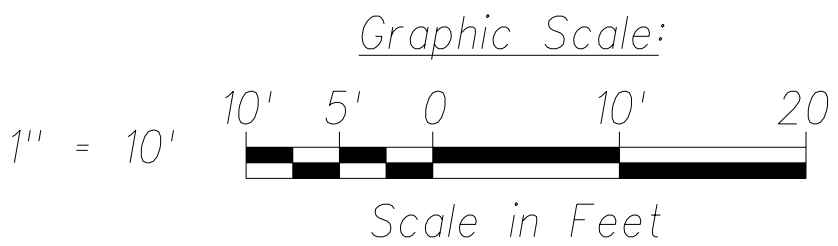


THIS WORK WAS PREPARED BY ME OR UNDER MY SUPERVISION AND CONSTRUCTION OF THIS PROJECT WILL BE UNDER MY OBSERVATION.

SIGNATURE
April 30, 2016
EXPIRATION DATE OF THE LICENSE

07/30/14	Δ New sheet. Replace Roadway Elevations Plan.
Date	Revision
STATE OF HAWAII DEPARTMENT OF TRANSPORTATION HIGHWAYS DIVISION	
PAVING PLAN	
(Sta. 380+75 to Sta. 383+75)	
PHASE 1 - KAUMUALII HIGHWAY	
LIHUE MILL BRIDGE TO RICE STREET	
PHASE 2 - NAWILIWILI STREAM BRIDGE	
AND MAUKA WIDENING	
Scale: As Shown	Date: March 25, 2013
SHEET No. C-40 OF 84 SHEETS	

"AS-BUILT"

FED. ROAD DIST. NO.	STATE	FED. AID PROJ. NO.	FISCAL YEAR	SHEET NO.	TOTAL SHEETS
HAWAII	HAW.	ARR-050-1(036)	FY13/14	41	131

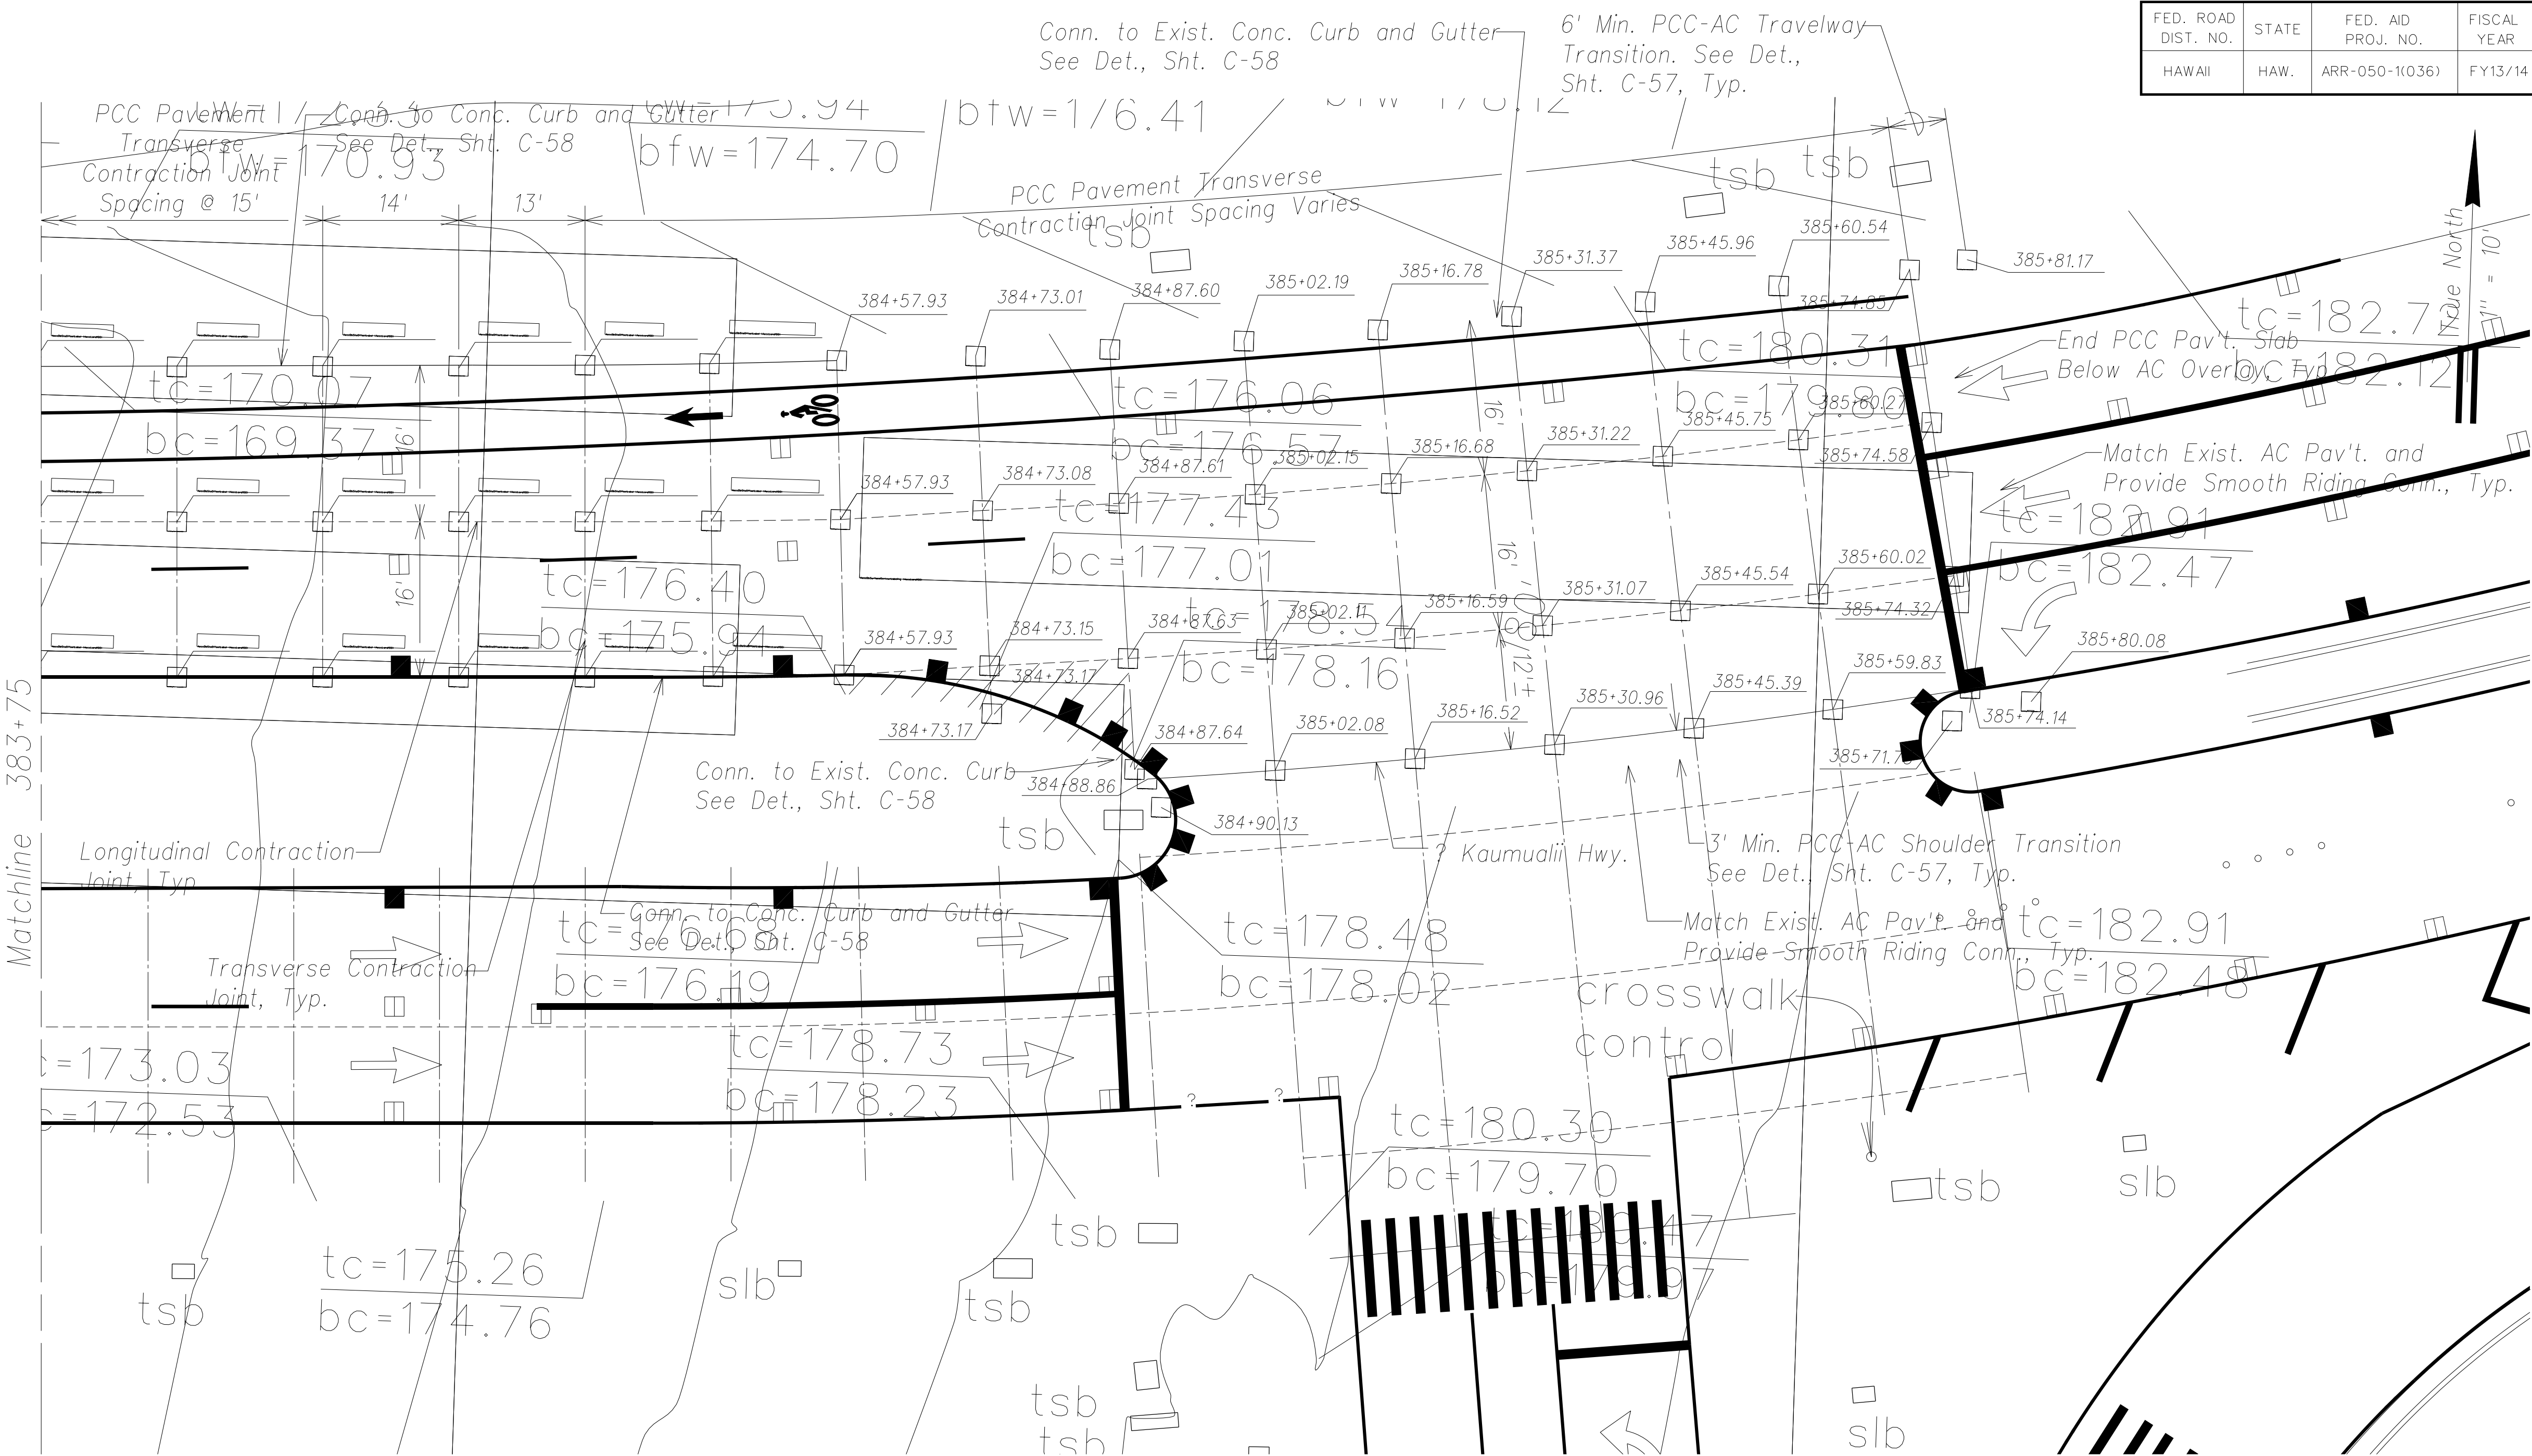

Legend:

Proposed	Phase 3	Existing
—200'—	—200'—	Contour Line
— · — · —	— · — · —	Typical Transverse Joint
— · — — · —	— · — — · —	Typical Longitudinal Joint
		Odd Shaped Slabs
		? Sta. of Finished Pavement Spot Elevation
		Finished Pavement Spot Elevation


Paving Plan (Sta. 383+75 to Sta. 385+81.17)
Scale: 1" = 10'

ORIGINAL PLAN	SURVEY PLOTTED BY _____ DATE _____	
	DRAWN BY _____	
	TRACED BY _____	
	DESIGNED BY _____	
NOTE BOOK	QUANTITIES BY _____	
	CHECKED BY _____	
	No. _____	



THIS WORK WAS PREPARED BY ME OR UNDER MY SUPERVISION AND CONSTRUCTION OF THIS PROJECT WILL BE UNDER MY OBSERVATION.

SIGNATURE
April 30, 2016
EXPIRATION DATE OF THE LICENSE

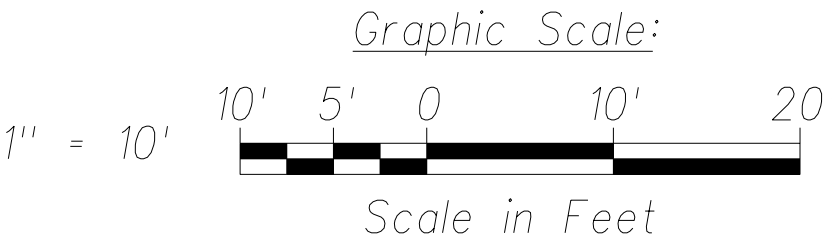

07/30/14	Δ New sheet. Replace Roadway Elevations Plan.
Date	Revision
STATE OF HAWAII DEPARTMENT OF TRANSPORTATION HIGHWAYS DIVISION	
PAVING PLAN (Sta. 383+75 to Sta. 385+81.17) PHASE 1 - KAUMUALII HIGHWAY LIHUE MILL BRIDGE TO RICE STREET PHASE 2 - NAWILIWILI STREAM BRIDGE AND MAUKA WIDENING	
Scale: As Shown	Date: March 25, 2013
SHEET No. C-40 OF 84 SHEETS	

"AS-BUILT"