


FED. ROAD DIST. NO.	STATE	FED. AID PROJ. NO.	FISCAL YEAR	SHEET NO.	TOTAL SHEETS
HAWAII	HAW.	ARR-050-1(036)	FY13/14	Model	131

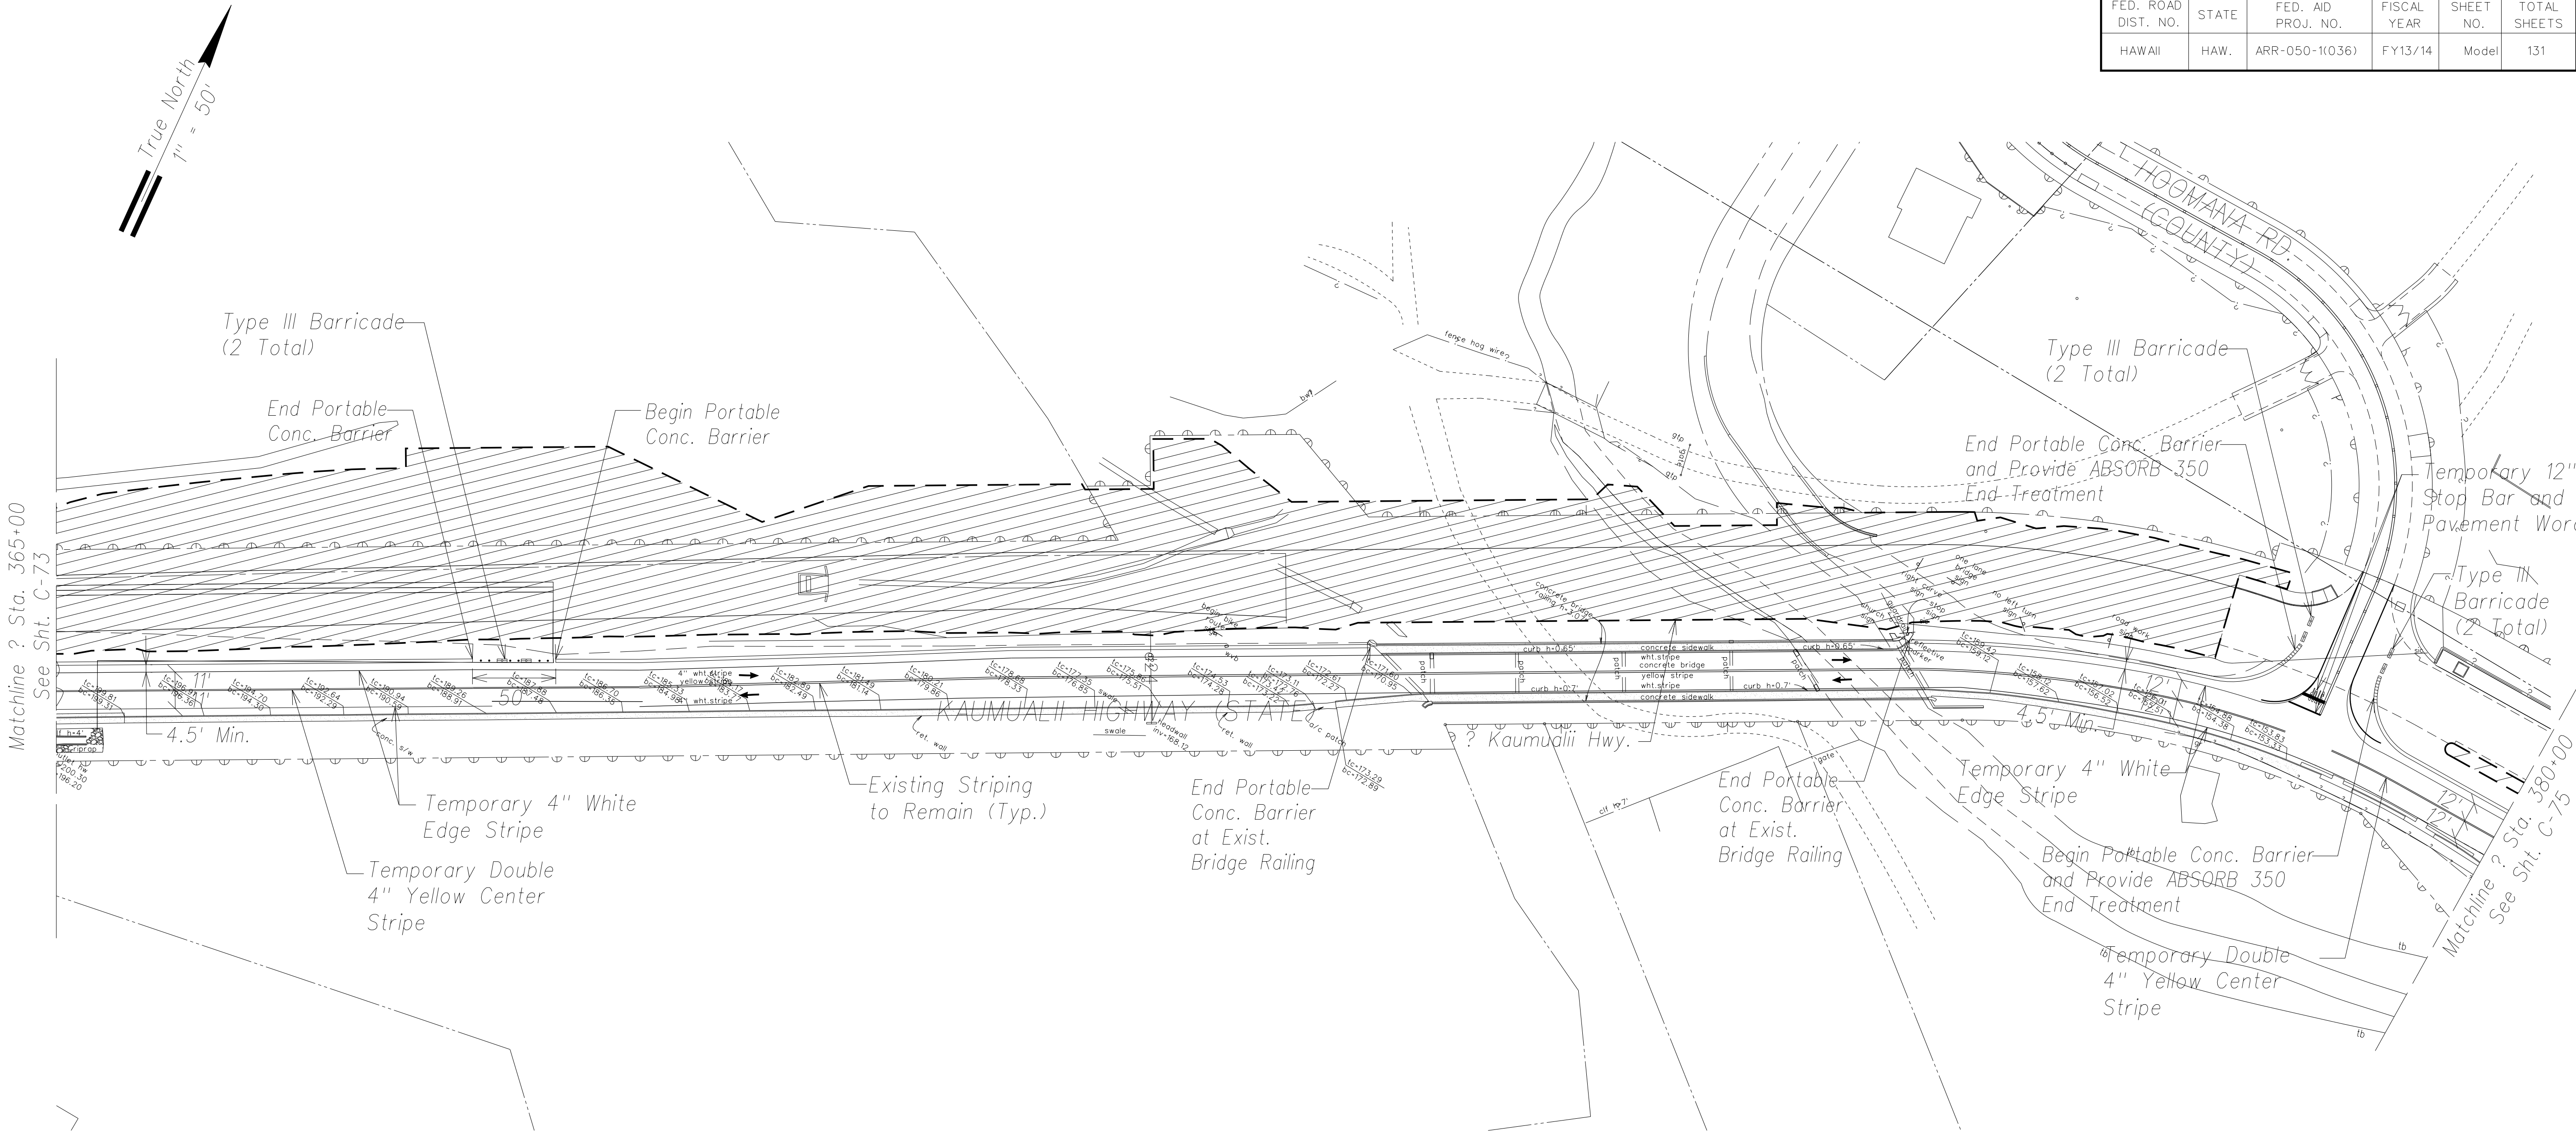

Temporary Work Plan
Scale: 1" = 50'

ORIGINAL PLAN	SURVEY PLOTTED BY	DATE
	DRAWN BY	"
	DESIGNED BY	"
	CHECKED BY	"
NOTE BOOK	QUANTITIES BY	
	CHECKED BY	
No.		

Legend:


- ➔ Direction of Traffic Flow
- Portable Concrete Barrier
- Work Area

Note:
See Demolition Plans for existing
striping to be removed.



THIS WORK WAS PREPARED BY ME
OR UNDER MY SUPERVISION AND
CONSTRUCTION OF THIS PROJECT
WILL BE UNDER MY OBSERVATION.

SIGNATURE
April 30, 2016
EXPIRATION DATE
OF THE LICENSE

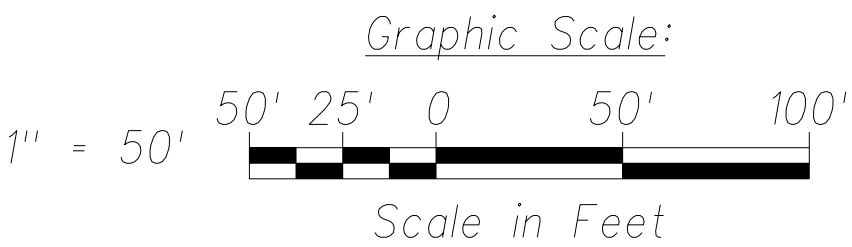

STATE OF HAWAII
DEPARTMENT OF TRANSPORTATION
HIGHWAYS DIVISION

TEMPORARY WORK PLAN

PHASE 1 - KAUMUALII HIGHWAY
LIHUE MILL BRIDGE TO RICE STREET
PHASE 2 - NAWILIWILI STREAM BRIDGE
AND MAUKA WIDENING

Scale: As Shown
Date: March 25, 2013

SHEET No. C-74 OF 84 SHEETS

"AS-BUILT"

MODEL

