


FED. ROAD DIST. NO.	STATE	FED. AID PROJ. NO.	FISCAL YEAR	SHEET NO.	TOTAL SHEETS
HAWAII	HAW.	ARR-050-1(036)	FY13/14	Model	131


(*)Note:

Phase 2 work installed during Phase 1 of the project.

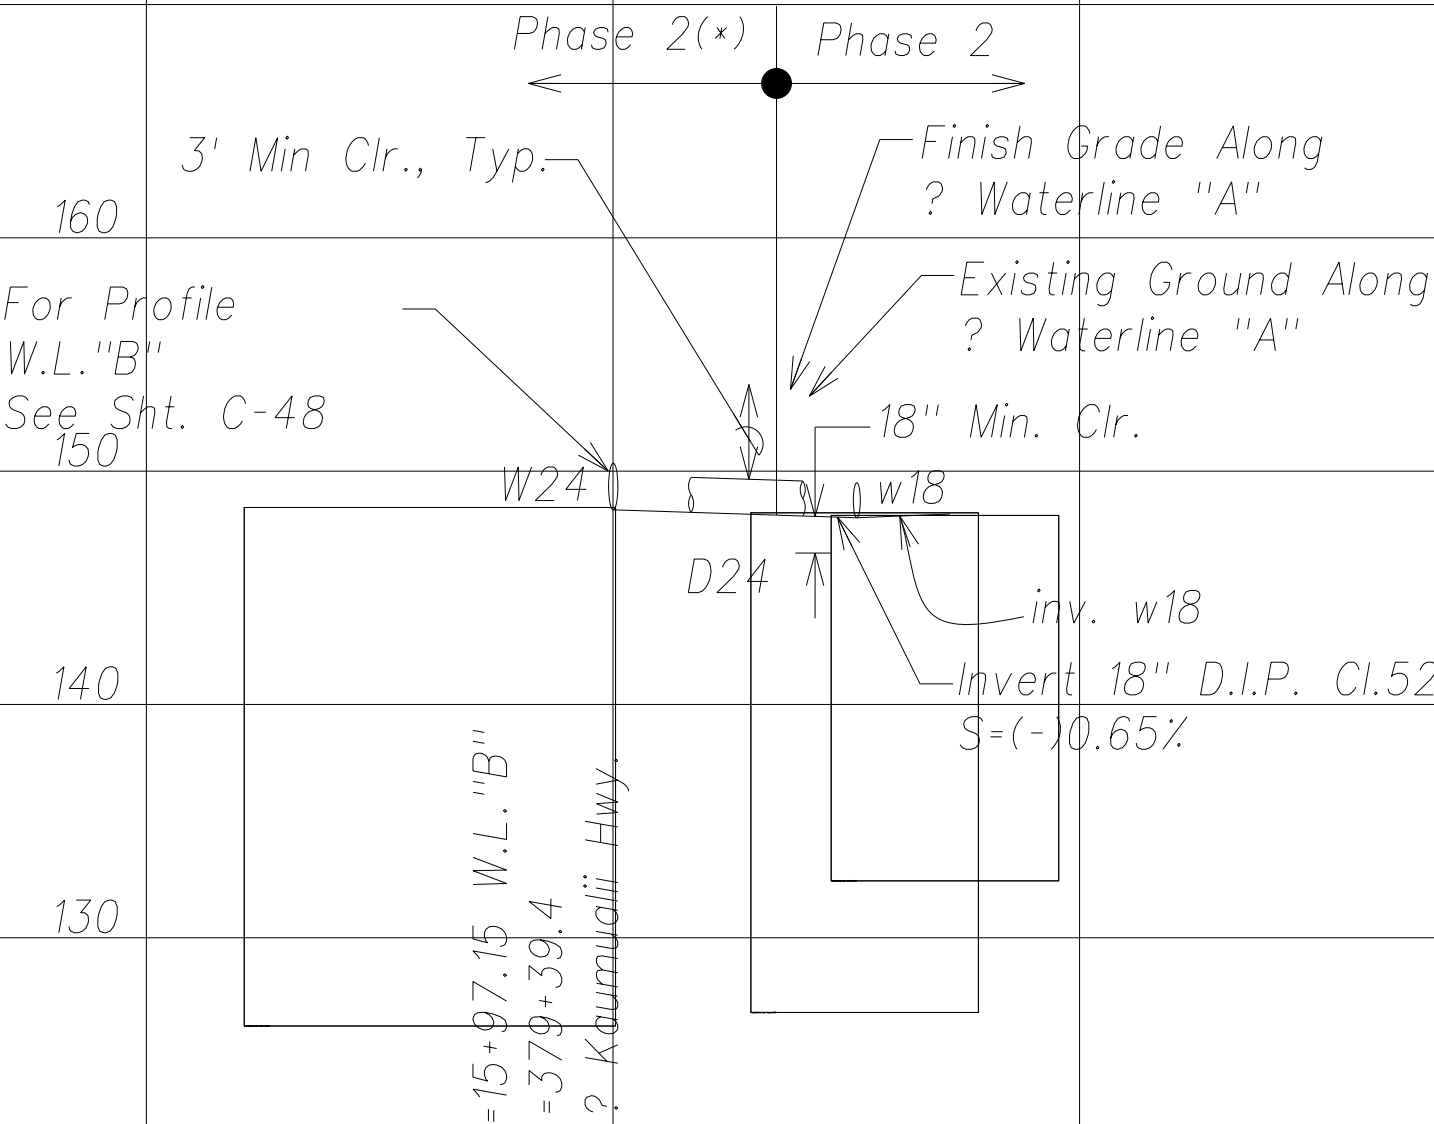

Profile: Waterline "A"

Scales: Hor.: 1" = 40'
Vert.: 1" = 8'

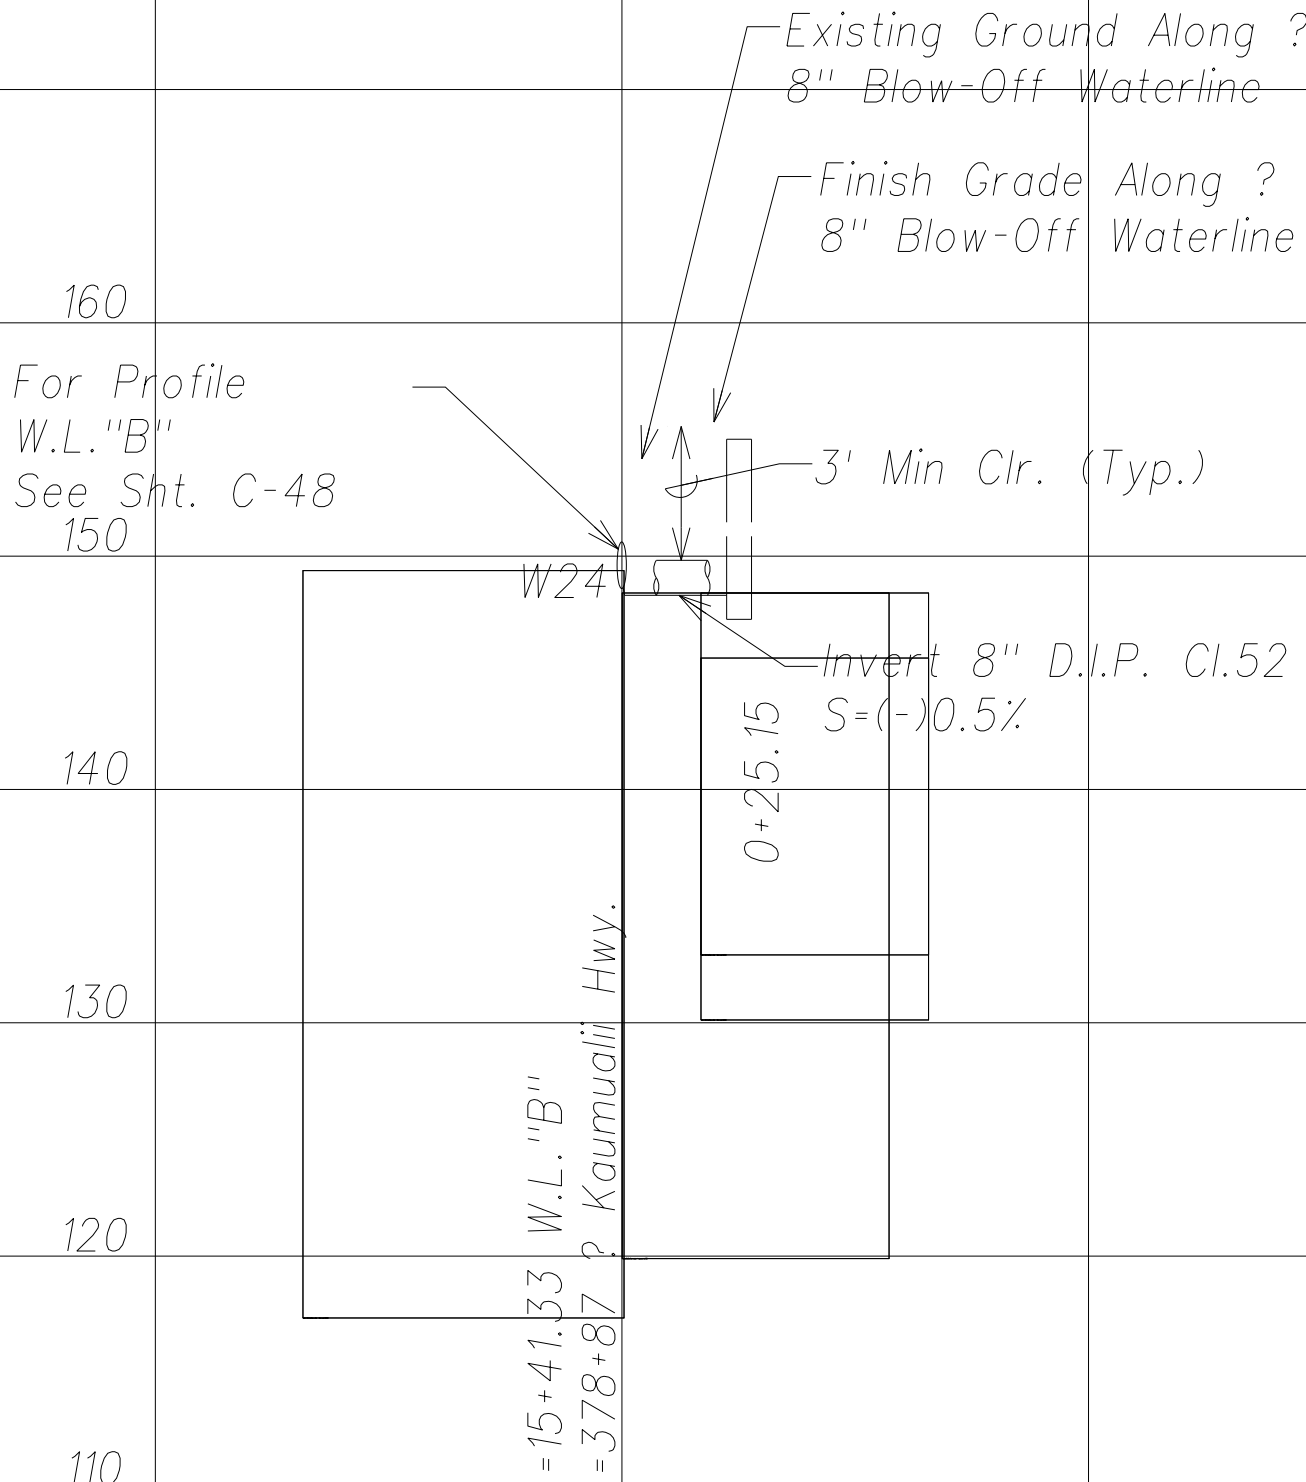

Profile: 8" Blow-Off Waterline

Scales: Hor.: 1" = 40'
Vert.: 1" = 8'

(*)Note:

Blow-off Waterline shall be considered Phase 2 work installed during Phase 1 of the project.

APPROVED BY:

MANAGER AND CHIEF ENGINEER,
DEPARTMENT OF WATER, COUNTY OF KAUAI

DATE

THIS WORK WAS PREPARED BY ME
OR UNDER MY SUPERVISION AND
CONSTRUCTION OF THIS PROJECT
WILL BE UNDER MY OBSERVATION.

SIGNATURE
EXPIRATION DATE
OF THE LICENSE

April 30, 2016

STATE OF HAWAII
DEPARTMENT OF TRANSPORTATION
HIGHWAYS DIVISION


WATERLINE PROFILES

PHASE 1 - KAUMUALII HIGHWAY
LIHUE MILL BRIDGE TO RICE STREET
PHASE 2 - NAWILIWILI STREAM BRIDGE
AND MAUKA WIDENING

Scale: As Shown Date: March 25, 2013

SHEET No. C-47 OF 84 SHEETS



ORIGINAL PLAN	SURVEY PLOTTED BY	DATE
	DRAWN BY	" "
	TRACED BY	" "
	DESIGNED BY	" "
NOTE BOOK	QUANTITIES BY	" "
	CHECKED BY	" "
No.		

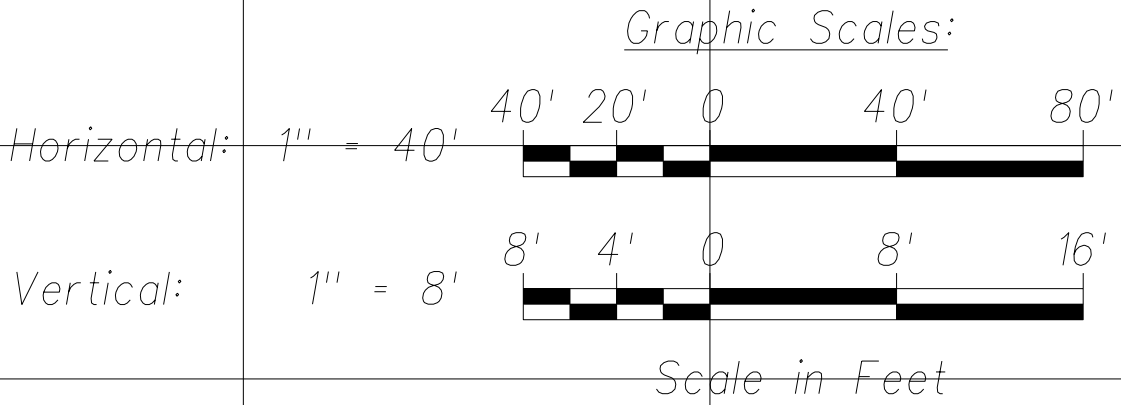

"AS-BUILT"


MODEL

FED. ROAD DIST. NO.	STATE	FED. AID PROJ. NO.	FISCAL YEAR	SHEET NO.	TOTAL SHEETS
HAWAII	HAW.	ARR-050-1(036)	FY13/14	Model	131

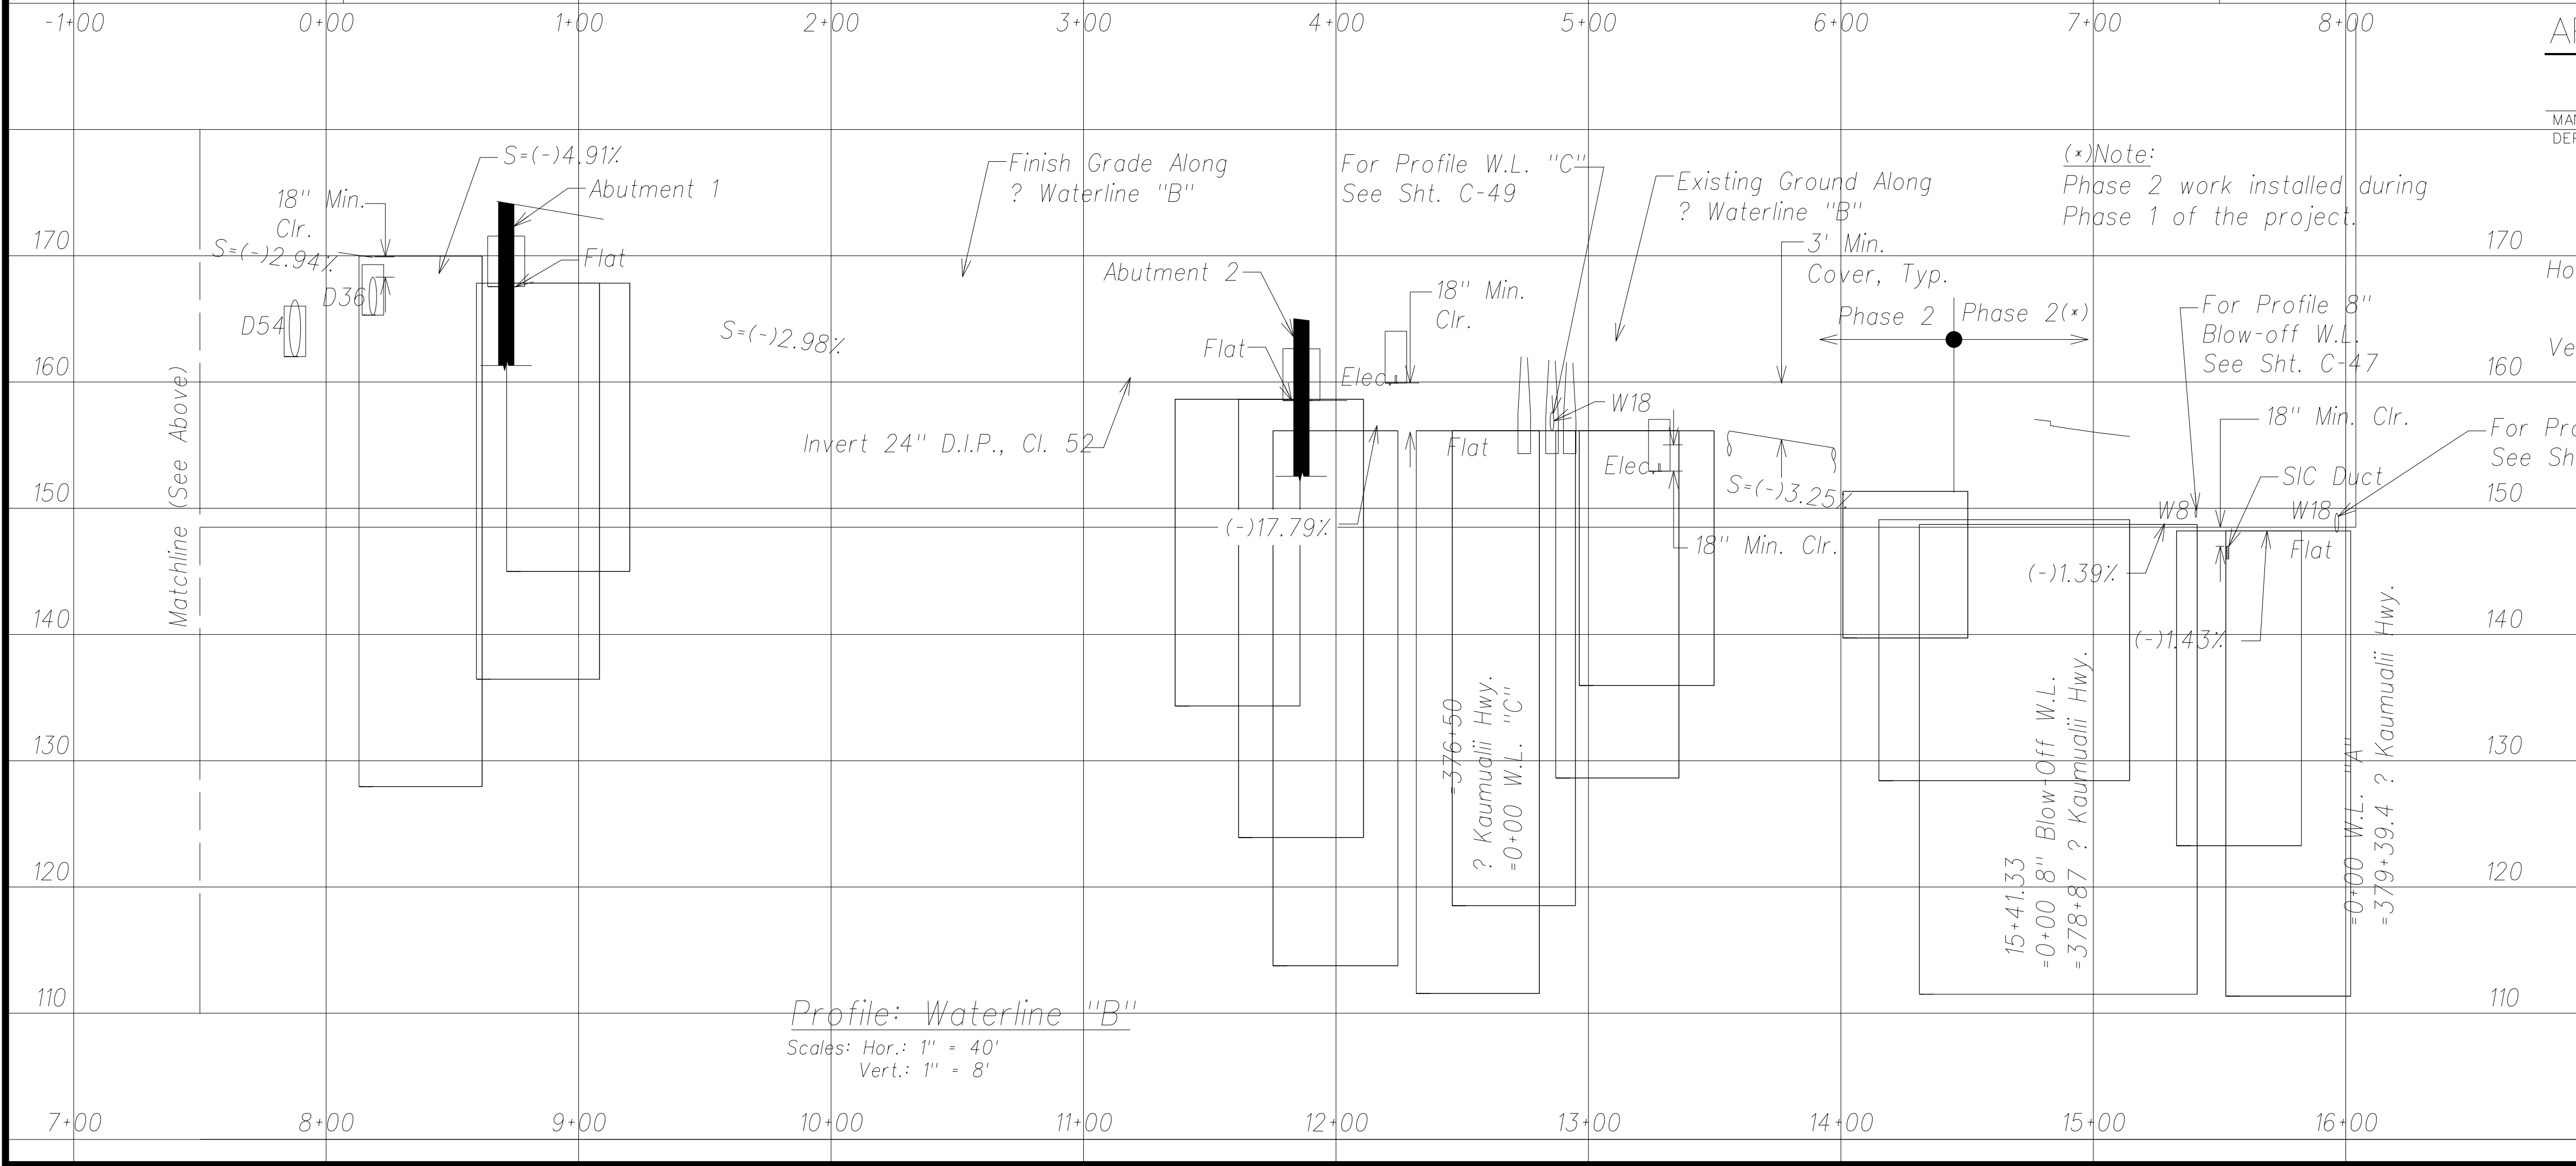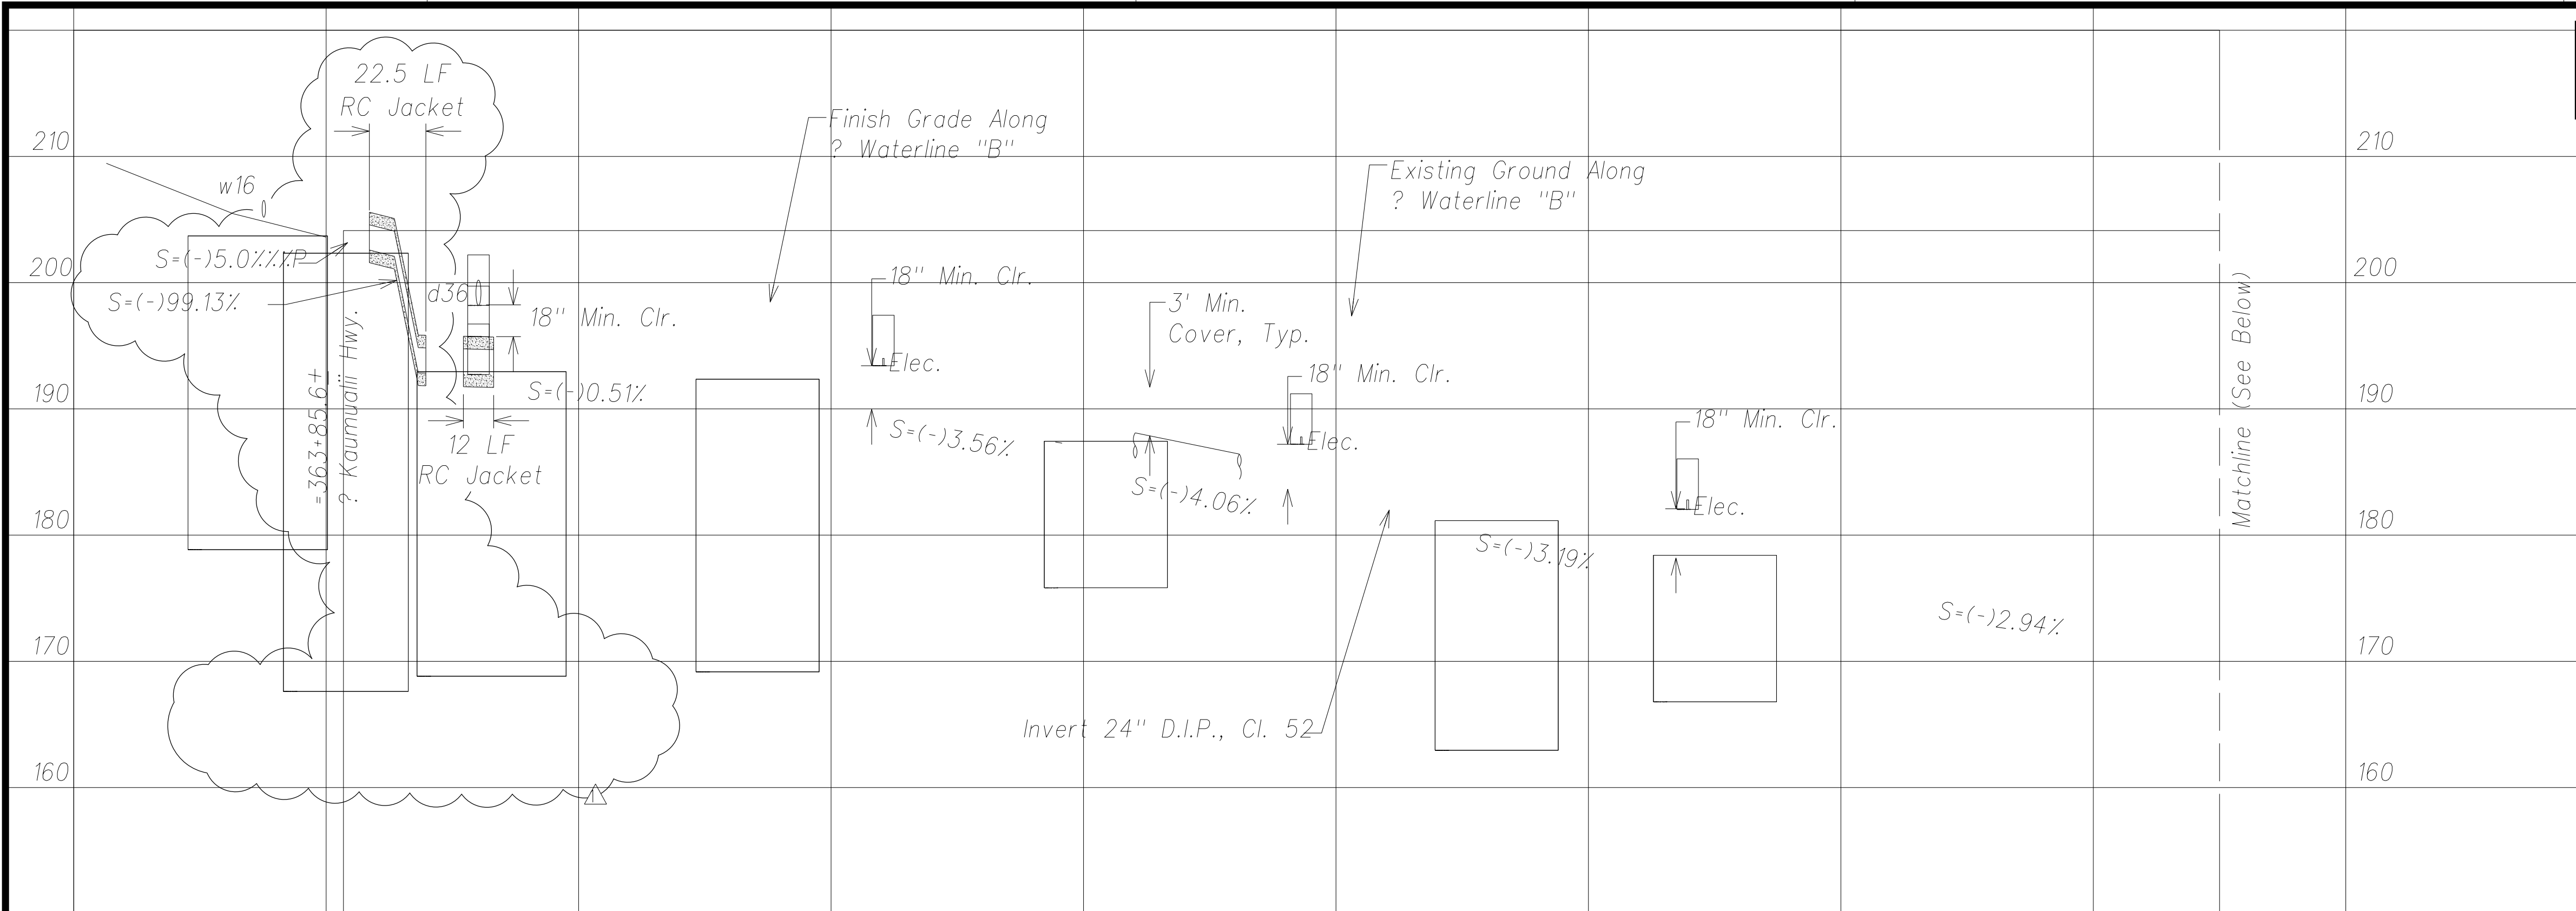

APPROVED BY:

MANAGER AND CHIEF ENGINEER,
DEPARTMENT OF WATER, COUNTY OF KAUAI

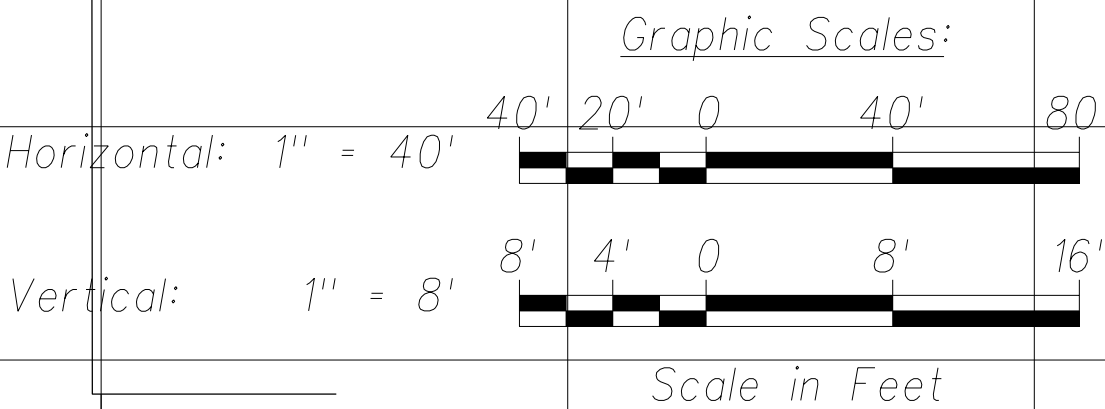

THIS WORK WAS PREPARED BY ME
OR UNDER MY SUPERVISION AND
CONSTRUCTION OF THIS PROJECT
WILL BE UNDER MY OBSERVATION.

07/30/14
Date

Revise water profile.
Revision

SIGNATURE

EXPIRATION DATE
OF THE LICENSE

STATE OF HAWAII
DEPARTMENT OF TRANSPORTATION
HIGHWAYS DIVISION

WATERLINE PROFILES

PHASE 1 - KAUMUALII HIGHWAY
LIHUE MILL BRIDGE TO RICE STREET
PHASE 2 - NAWILIWILI STREAM BRIDGE
AND MAUKA WIDENING

Scale: As Shown

Date: March 25, 2013

SHEET No. C-48 OF 84 SHEETS


SURVEY PLOTTED BY	DATE
DRAWN BY	
DESIGNED BY	
QUANTITIES BY	
CHECKED BY	

ORIGINAL PLAN	NOTE BOOK
No.	No.


"AS-BUILT"

MODEL S1

FED. ROAD DIST. NO.	STATE	FED. AID PROJ. NO.	FISCAL YEAR	SHEET NO.	TOTAL SHEETS
HAWAII	HAW.	ARR-050-1(036)	FY13/14	Model	131

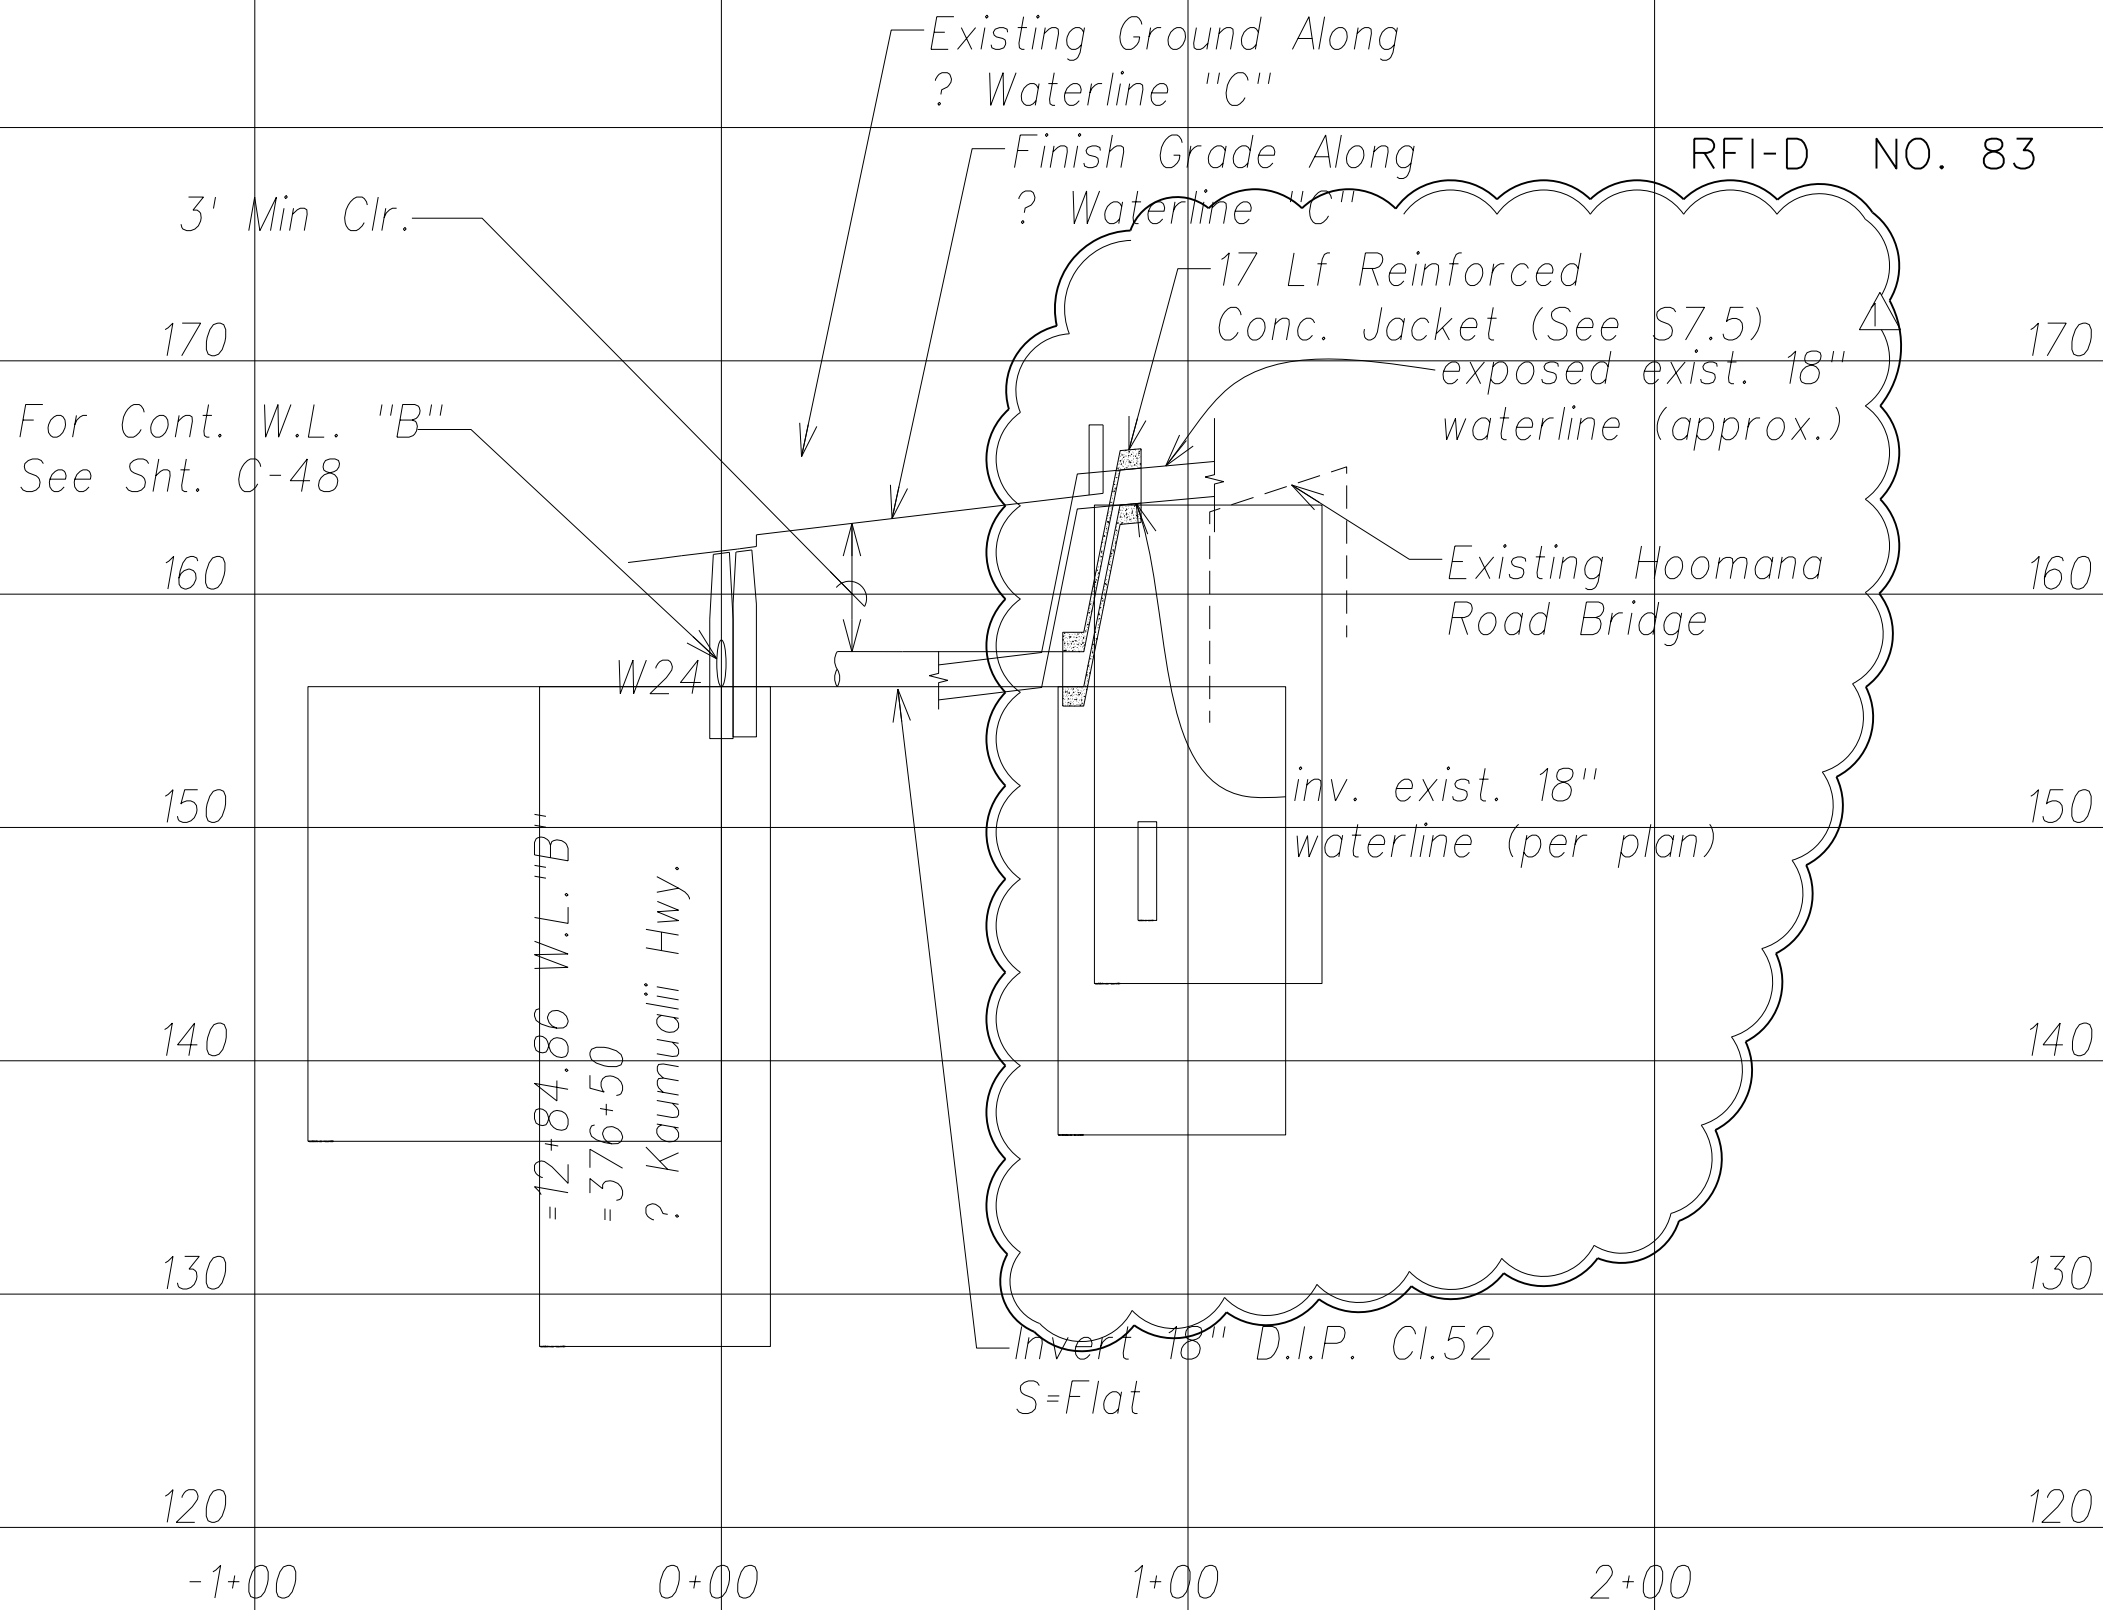

Profile: Waterline "C"
Scales: Hor.: 1" = 40'
Vert.: 1" = 8'

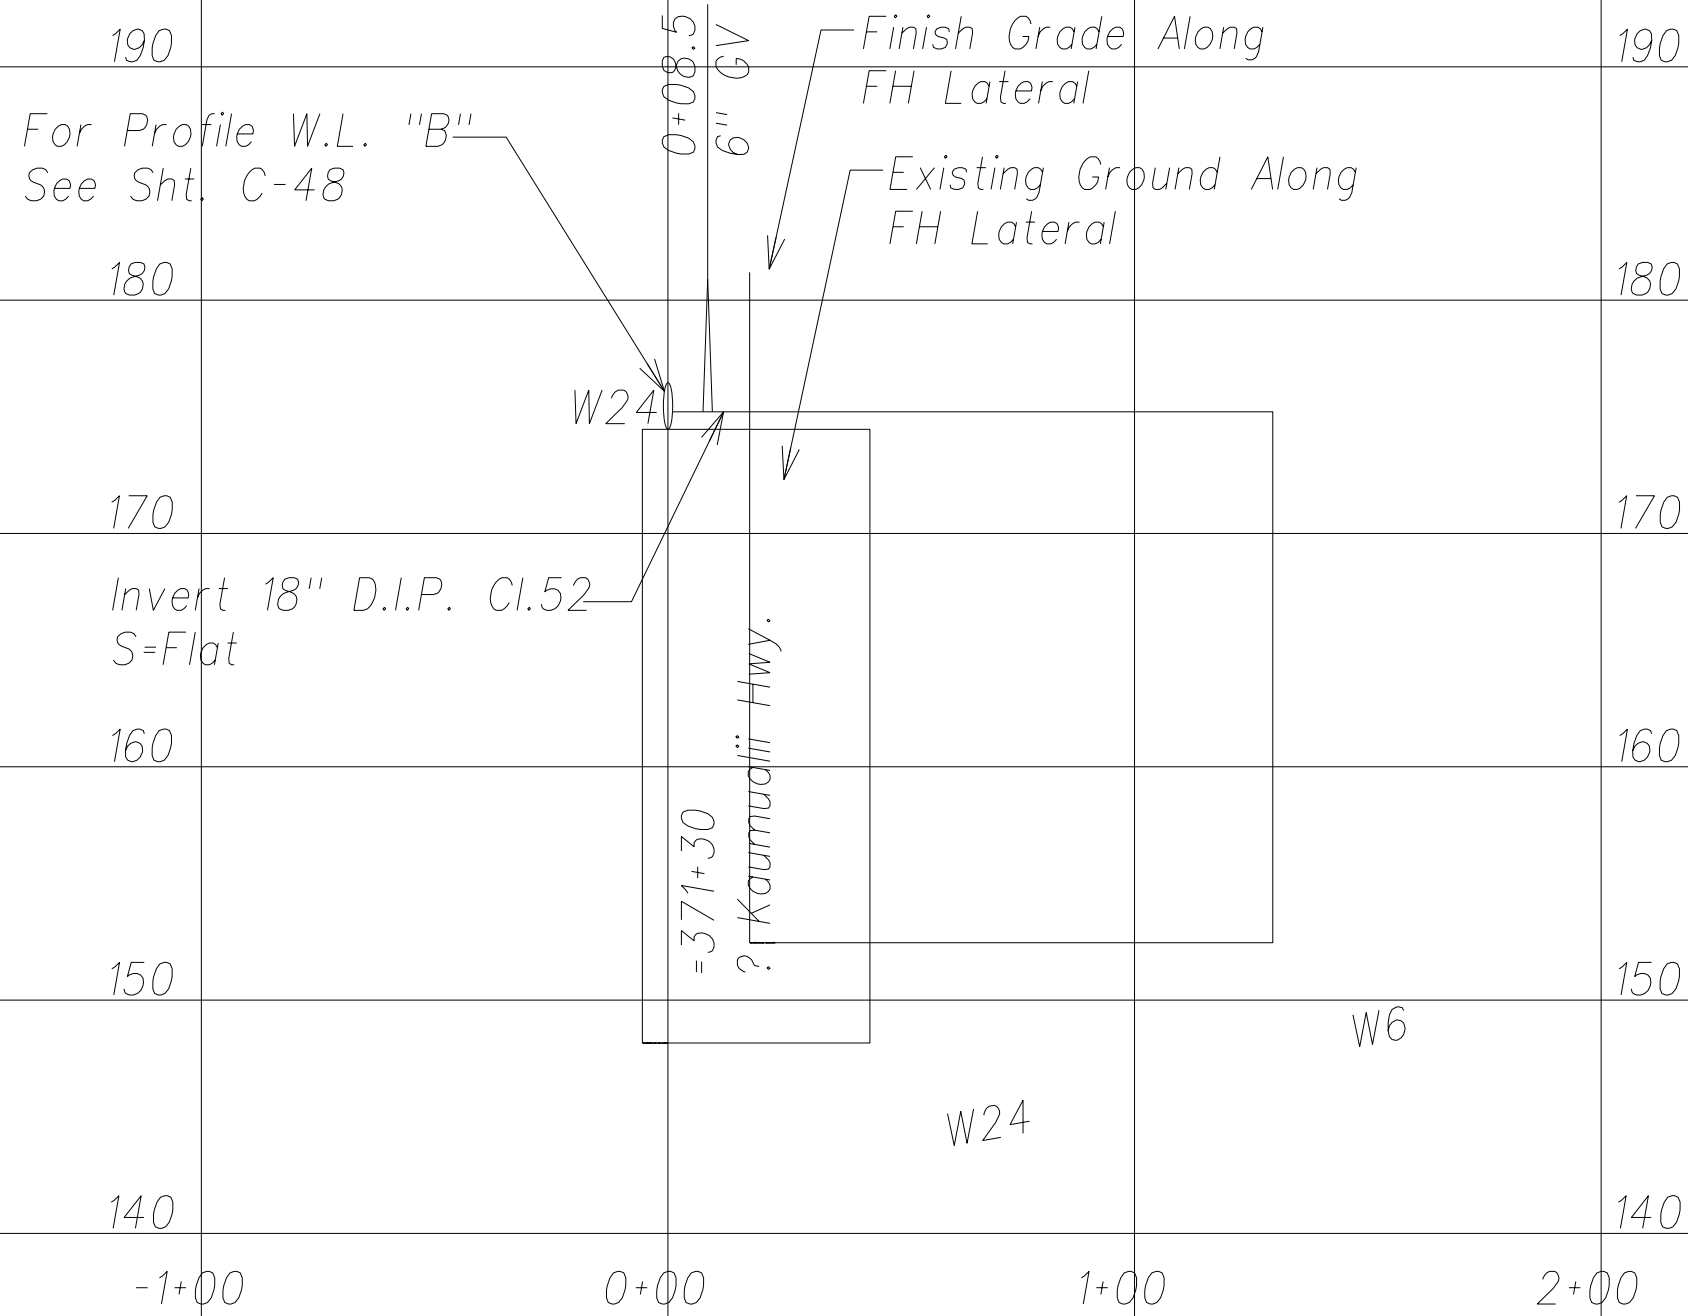


Profile: FH Lateral at Sta. 370+30
Scales: Hor.: 1" = 40'
Vert.: 1" = 8'

LEGEND FOR AS-BUILT POSTINGS	
	Squiggly line for as-built deletion
	Double line for as-built deletion
Roadway	Text for as-built posting

ORIGINAL PLAN	SURVEY PLOTTED BY	DATE
	DRAWN BY	"
	TRACED BY	"
	DESIGNED BY	"
NOTE BOOK	QUANTITIES BY	"
	CHECKED BY	"
No.		

APPROVED BY:

MANAGER AND CHIEF ENGINEER, DEPARTMENT OF WATER, COUNTY OF KAUAI DATE

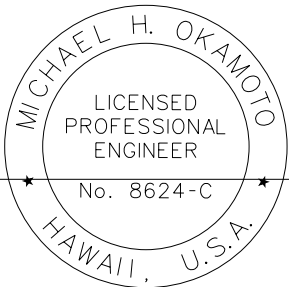

THIS WORK WAS PREPARED BY ME OR UNDER MY SUPERVISION AND CONSTRUCTION OF THIS PROJECT WILL BE UNDER MY OBSERVATION.

SIGNATURE EXPIRATION DATE OF THE LICENSE

07/30/14	△ Revise water profile.
Date	Revision
STATE OF HAWAII DEPARTMENT OF TRANSPORTATION HIGHWAYS DIVISION	
WATERLINE PROFILES	
PHASE 1 - KAUMUALII HIGHWAY LIHUE MILL BRIDGE TO RICE STREET	
PHASE 2 - NAWILIWILI STREAM BRIDGE AND MAUKA WIDENING	
Scale: As Shown	Date: March 25, 2013
SHEET No. C-49 OF 84 SHEETS	

"AS-BUILT"

MODEL S1