

SHEET NO.	INDEX TO DRAWINGS	REF. SHTS.	
	DESCRIPTION	FROM	TO
1	TITLE SHEET	T-1	T-1
2-84	CIVIL DRAWINGS	C-1	C-84
85-115	STRUCTURAL DRAWINGS	S0.1	S8.1
116-127	ELECTRICAL DRAWINGS	E-1	E-12
128-129	TEMPORARY TRAFFIC SIGNAL PLANS	TS-1	TS-2
130-131	LANDSCAPING DRAWINGS	L-1	L-3

Plan Sht. Nos. CO 14 S1, CO 15 S1, CO 19 S1-S2, CO 20 S1, CO 20A S1, CO 22 S1, CO 23 S1, CO 26-30 S1, CO 32-39 S1, CO 40 S2, CO 41 S1-S9, CO 43-47 S1, CO 43-47 S1, CO 49 S1, CO 51 S1, CO 52 S1, CO 54 S1, CO 55 S1, CO 56 S1, CO 58 S1, CO 59 S1, CO 64 S1, CO 66 S1, CO 67 S1-S2, CO 84 S1-S2, CO 114 S1-S7 are supplementary sheets to this project, added during Addendum & "AS BUILT" postings.

TOTAL SHEET COUNT after Addendum & "AS BUILT" postings is 164 sheets.

DESIGN DESIGNATION

ADT (2012)27,400 VPD
DESIGN ADT (2035)37,800 VPD
DHV3,080
D (DESIGN)55/45
T (DESIGN)3.0%
V35 MPH



STATE OF HAWAII
DEPARTMENT OF TRANSPORTATION

HIGHWAYS DIVISION
HONOLULU, HAWAII
"AS BUILT"
PLANS FOR

PHASE 1 - KAUMUALII HIGHWAY
LIHUE MILL BRIDGE TO RICE STREET
PHASE 2 - NAWILIWILI STREAM BRIDGE
AND MAUKA HIGHWAY WIDENING
PROJECT NO. ARR-050-1(036)

DISTRICT OF LIHUE
ISLAND OF KAUAI

FED. ROAD DIST. NO.	STATE	FED. AID PROJ. NO.	FISCAL YEAR	SHEET NO.	TOTAL SHEETS
HAWAII	HAW.	ARR-050-1(036)	FY13/14	1	131

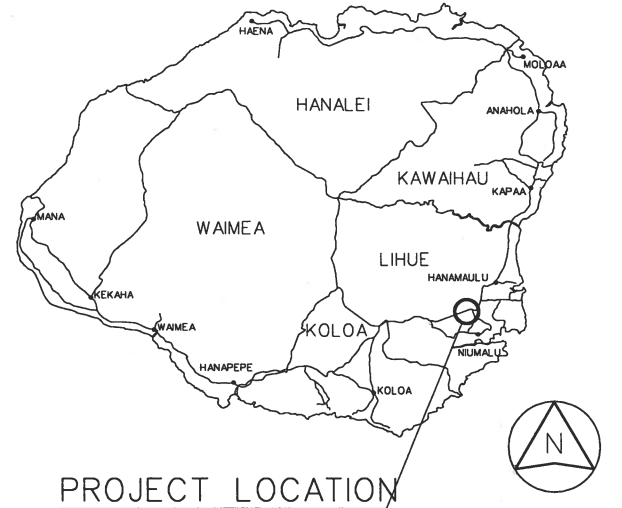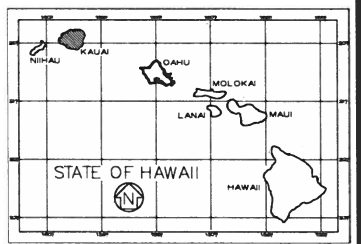

PROJECT LOCATION



APPROVED BY:

STATE DEPARTMENT OF TRANSPORTATION, HIGHWAYS DIVISION - KAUAI BRANCH


MANAGER AND CHIEF ENGINEER,
DEPARTMENT OF WATER, COUNTY OF KAUAI

CHANGES MADE DURING CONSTRUCTION HAVE BEEN INCORPORATED ON THESE PLANS EXCEPT CHANGES IN THE ORIGINAL THEORETICAL QUANTITIES. FOR ACTUAL QUANTITIES, REFER TO PROJECT LEDGER AND/OR COMPUTATION BOOK.

[Signature]
RESIDENT ENGINEER
2/8/22
DATE


DEPARTMENT OF TRANSPORTATION
STATE OF HAWAII
APPROVED:
DIVISION ADMINISTRATOR DATE

DEPARTMENT OF TRANSPORTATION
STATE OF HAWAII
APPROVED:
DIR. OF TRANSPORTATION DATE

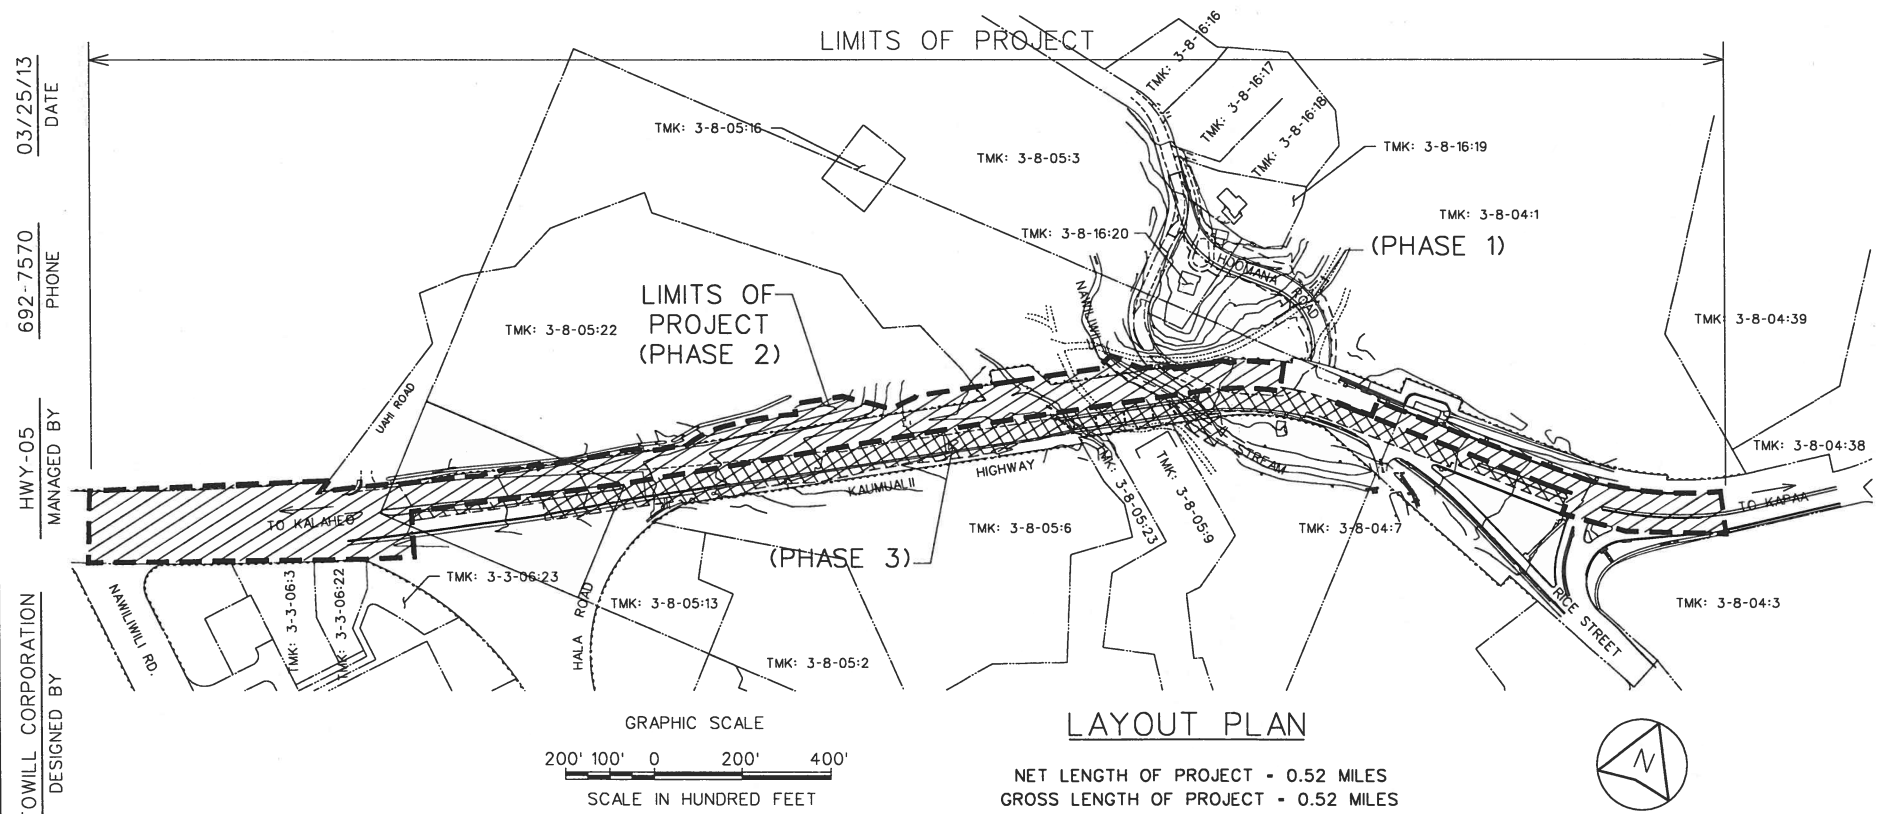

LAYOUT PLAN

NET LENGTH OF PROJECT - 0.52 MILES
GROSS LENGTH OF PROJECT - 0.52 MILES

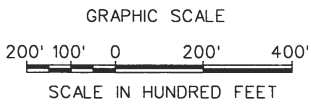

03/25/13 DATE
692-7570 PHONE
HWY-05
MANAGED BY
DESIGNED BY
R.M. TOWILL CORPORATION

"AS-BUILT"