
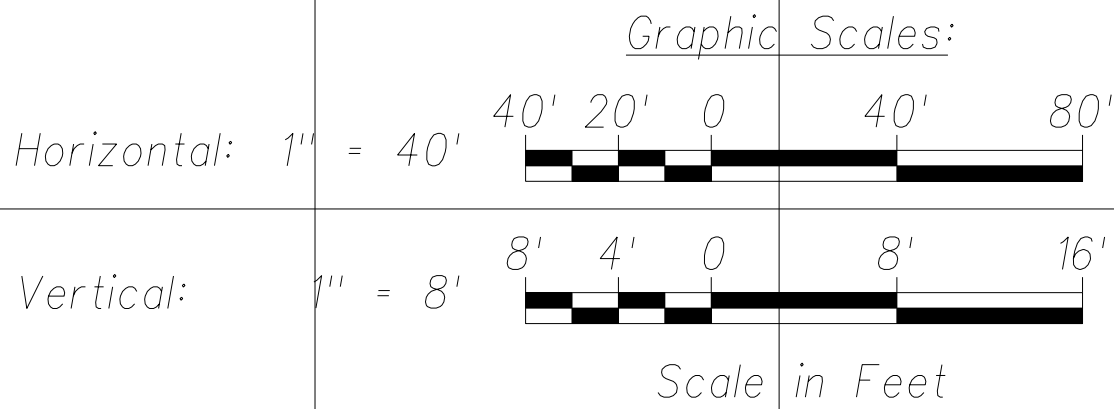


FILE: C:\Users\Nashin\Desktop\Drawing\ang saved April 7, 2016

ORIGINAL PLAN	SURVEY PLOTTED BY	DATE
	DRAWN BY	
	DESIGNED BY	
	QUANTITIES BY	
	CHECKED BY	
NOTE BOOK	No.	

FED. ROAD DIST. NO.	STATE	FED. AID PROJ. NO.	FISCAL YEAR	SHEET NO.	TOTAL SHEETS
HAWAII	HAW.	ARR-050-1(036)	FY13/14	Model	141

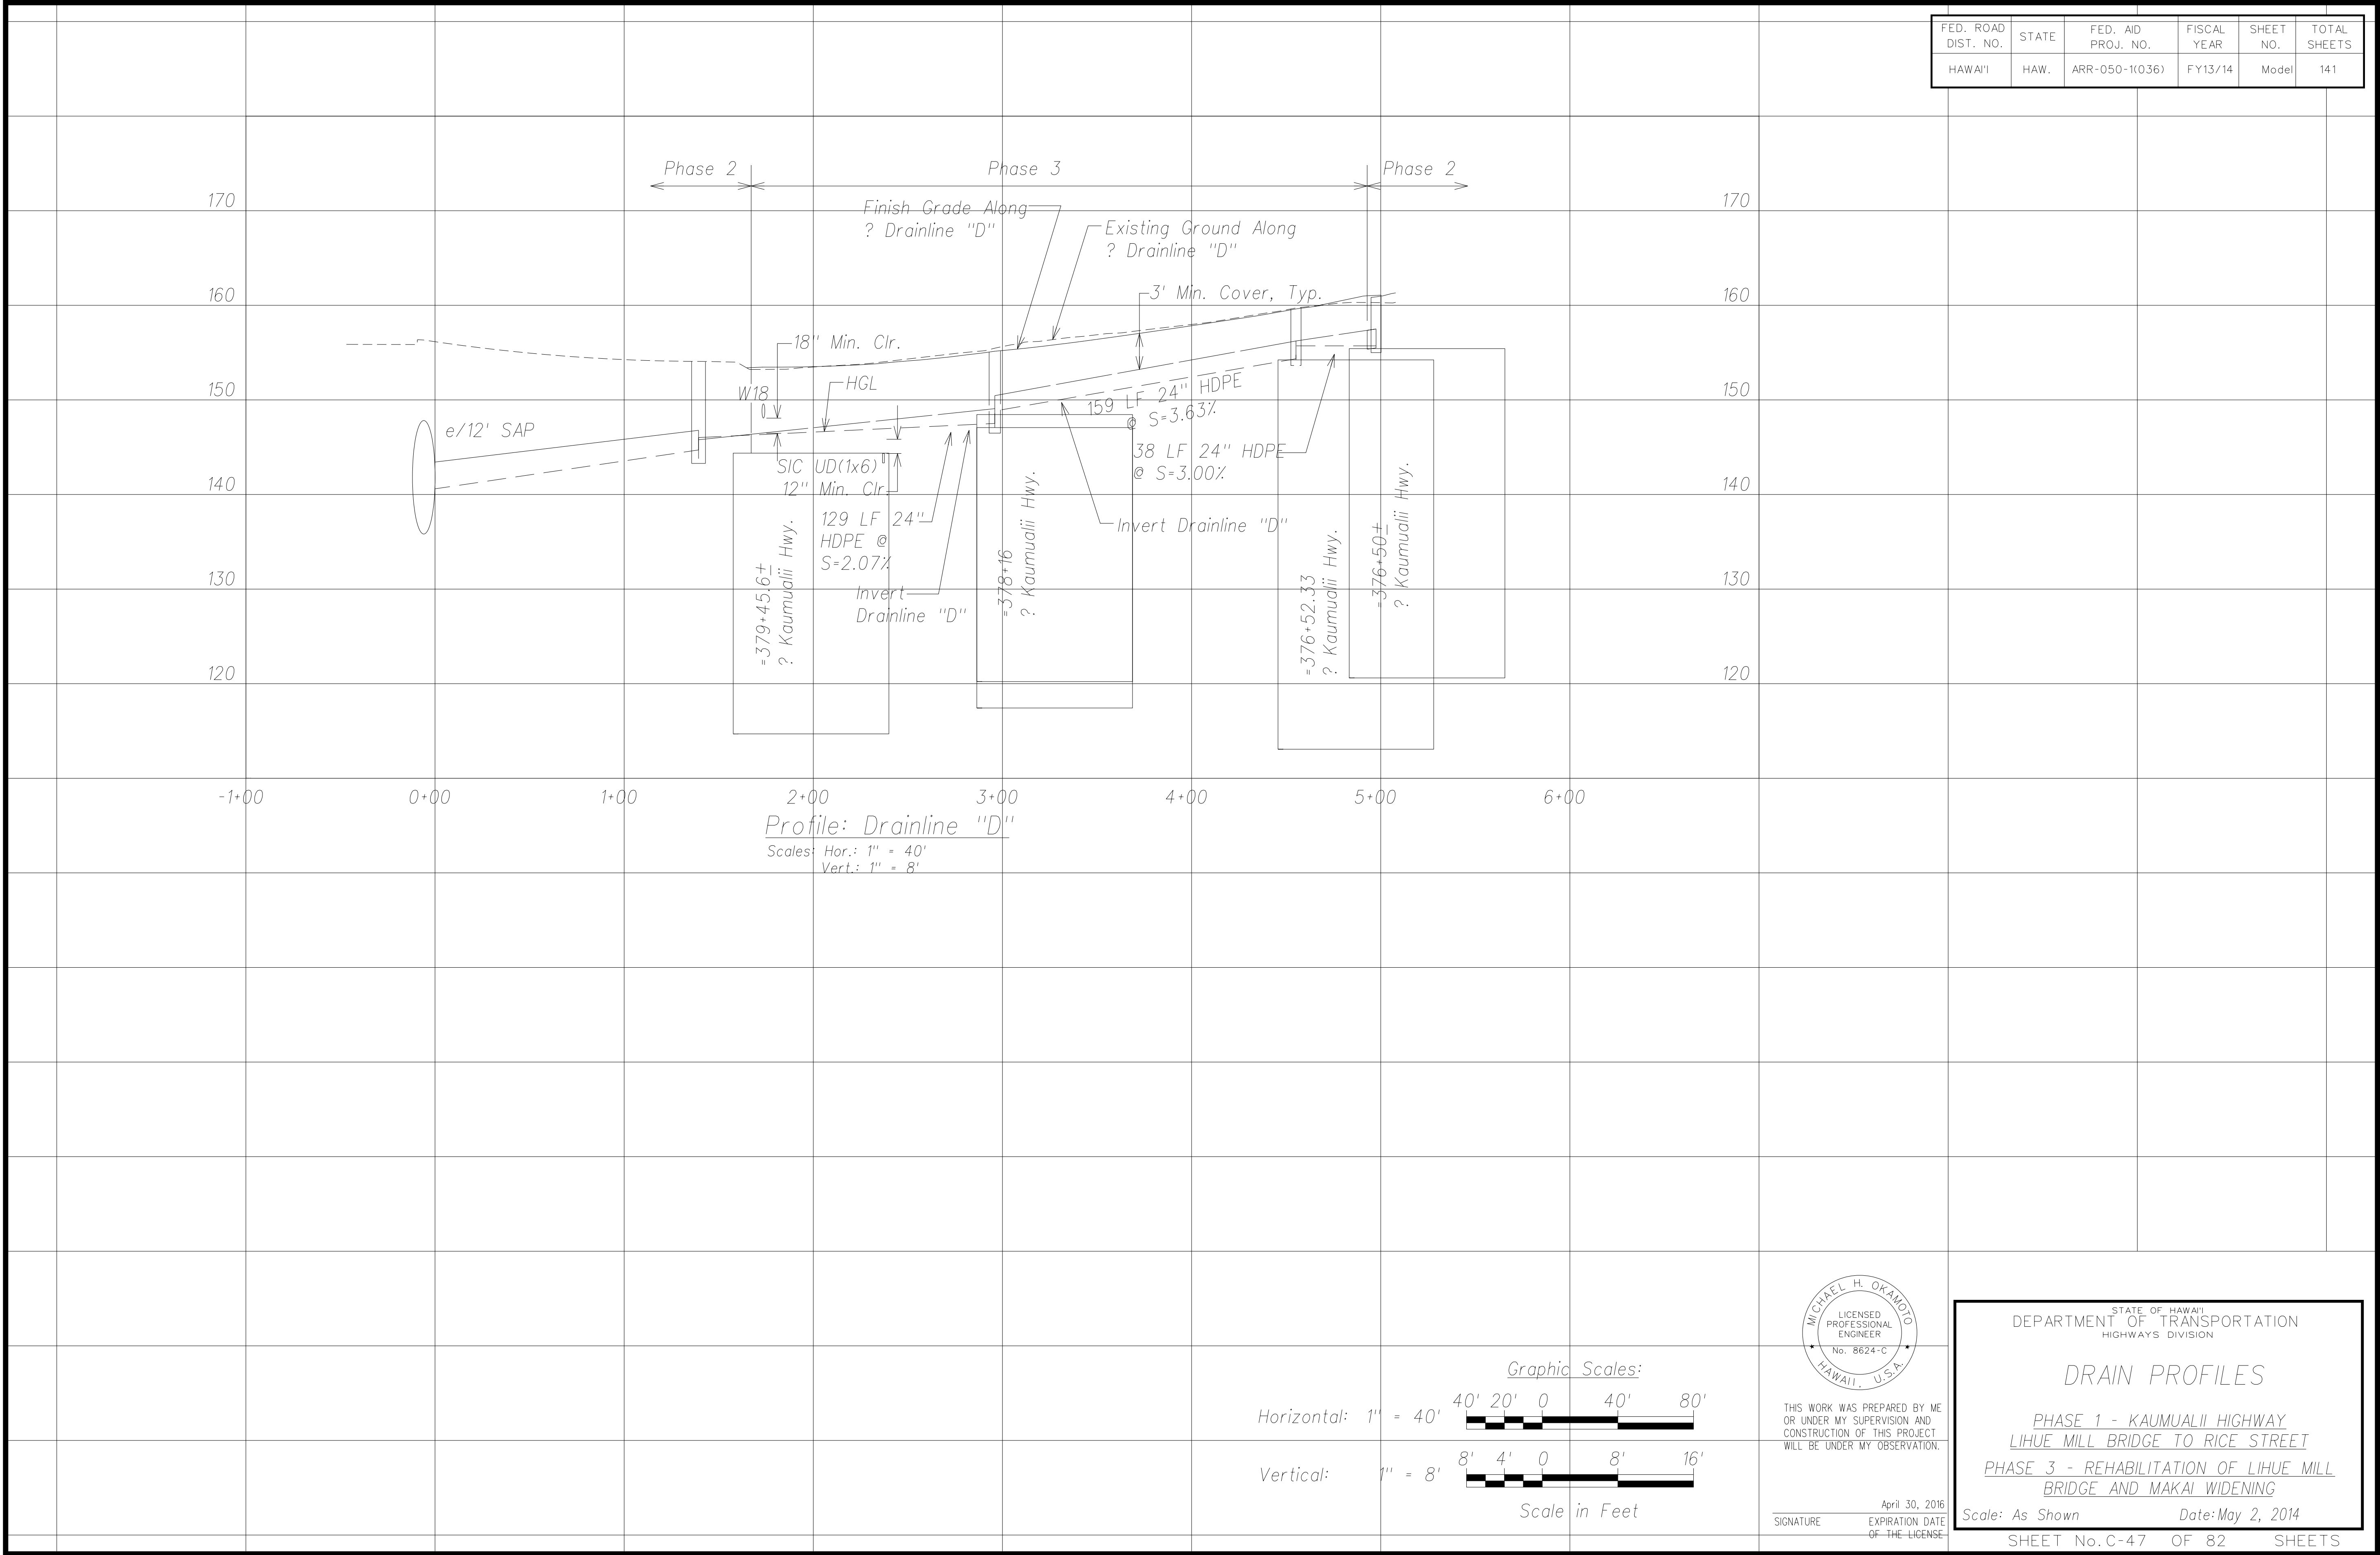

THIS WORK WAS PREPARED BY ME
OR UNDER MY SUPERVISION AND
CONSTRUCTION OF THIS PROJECT
WILL BE UNDER MY OBSERVATION.

April 30, 2016
SIGNATURE EXPIRATION DATE
OF THE LICENSE

STATE OF HAWAII
DEPARTMENT OF TRANSPORTATION
HIGHWAYS DIVISION

DRAIN PROFILES

PHASE 1 - KAUMUALII HIGHWAY
LIHUE MILL BRIDGE TO RICE STREET

PHASE 3 - REHABILITATION OF LIHUE MILL
BRIDGE AND MAKAI WIDENING

Scale: As Shown Date: May 2, 2014


SHEET No. C-47 OF 82 SHEETS

"AS-BUILT"

MODEL

FILE: C:\Users\lspahs\Desktop\Drawings\Drawg.dwg saved April 7, 2016

ORIGINAL PLAN	SURVEY PLOTTED BY	DATE
	DRAWN BY	
	DESIGNED BY	
	QUANTITIES BY	
	CHECKED BY	
NOTE BOOK	No.	

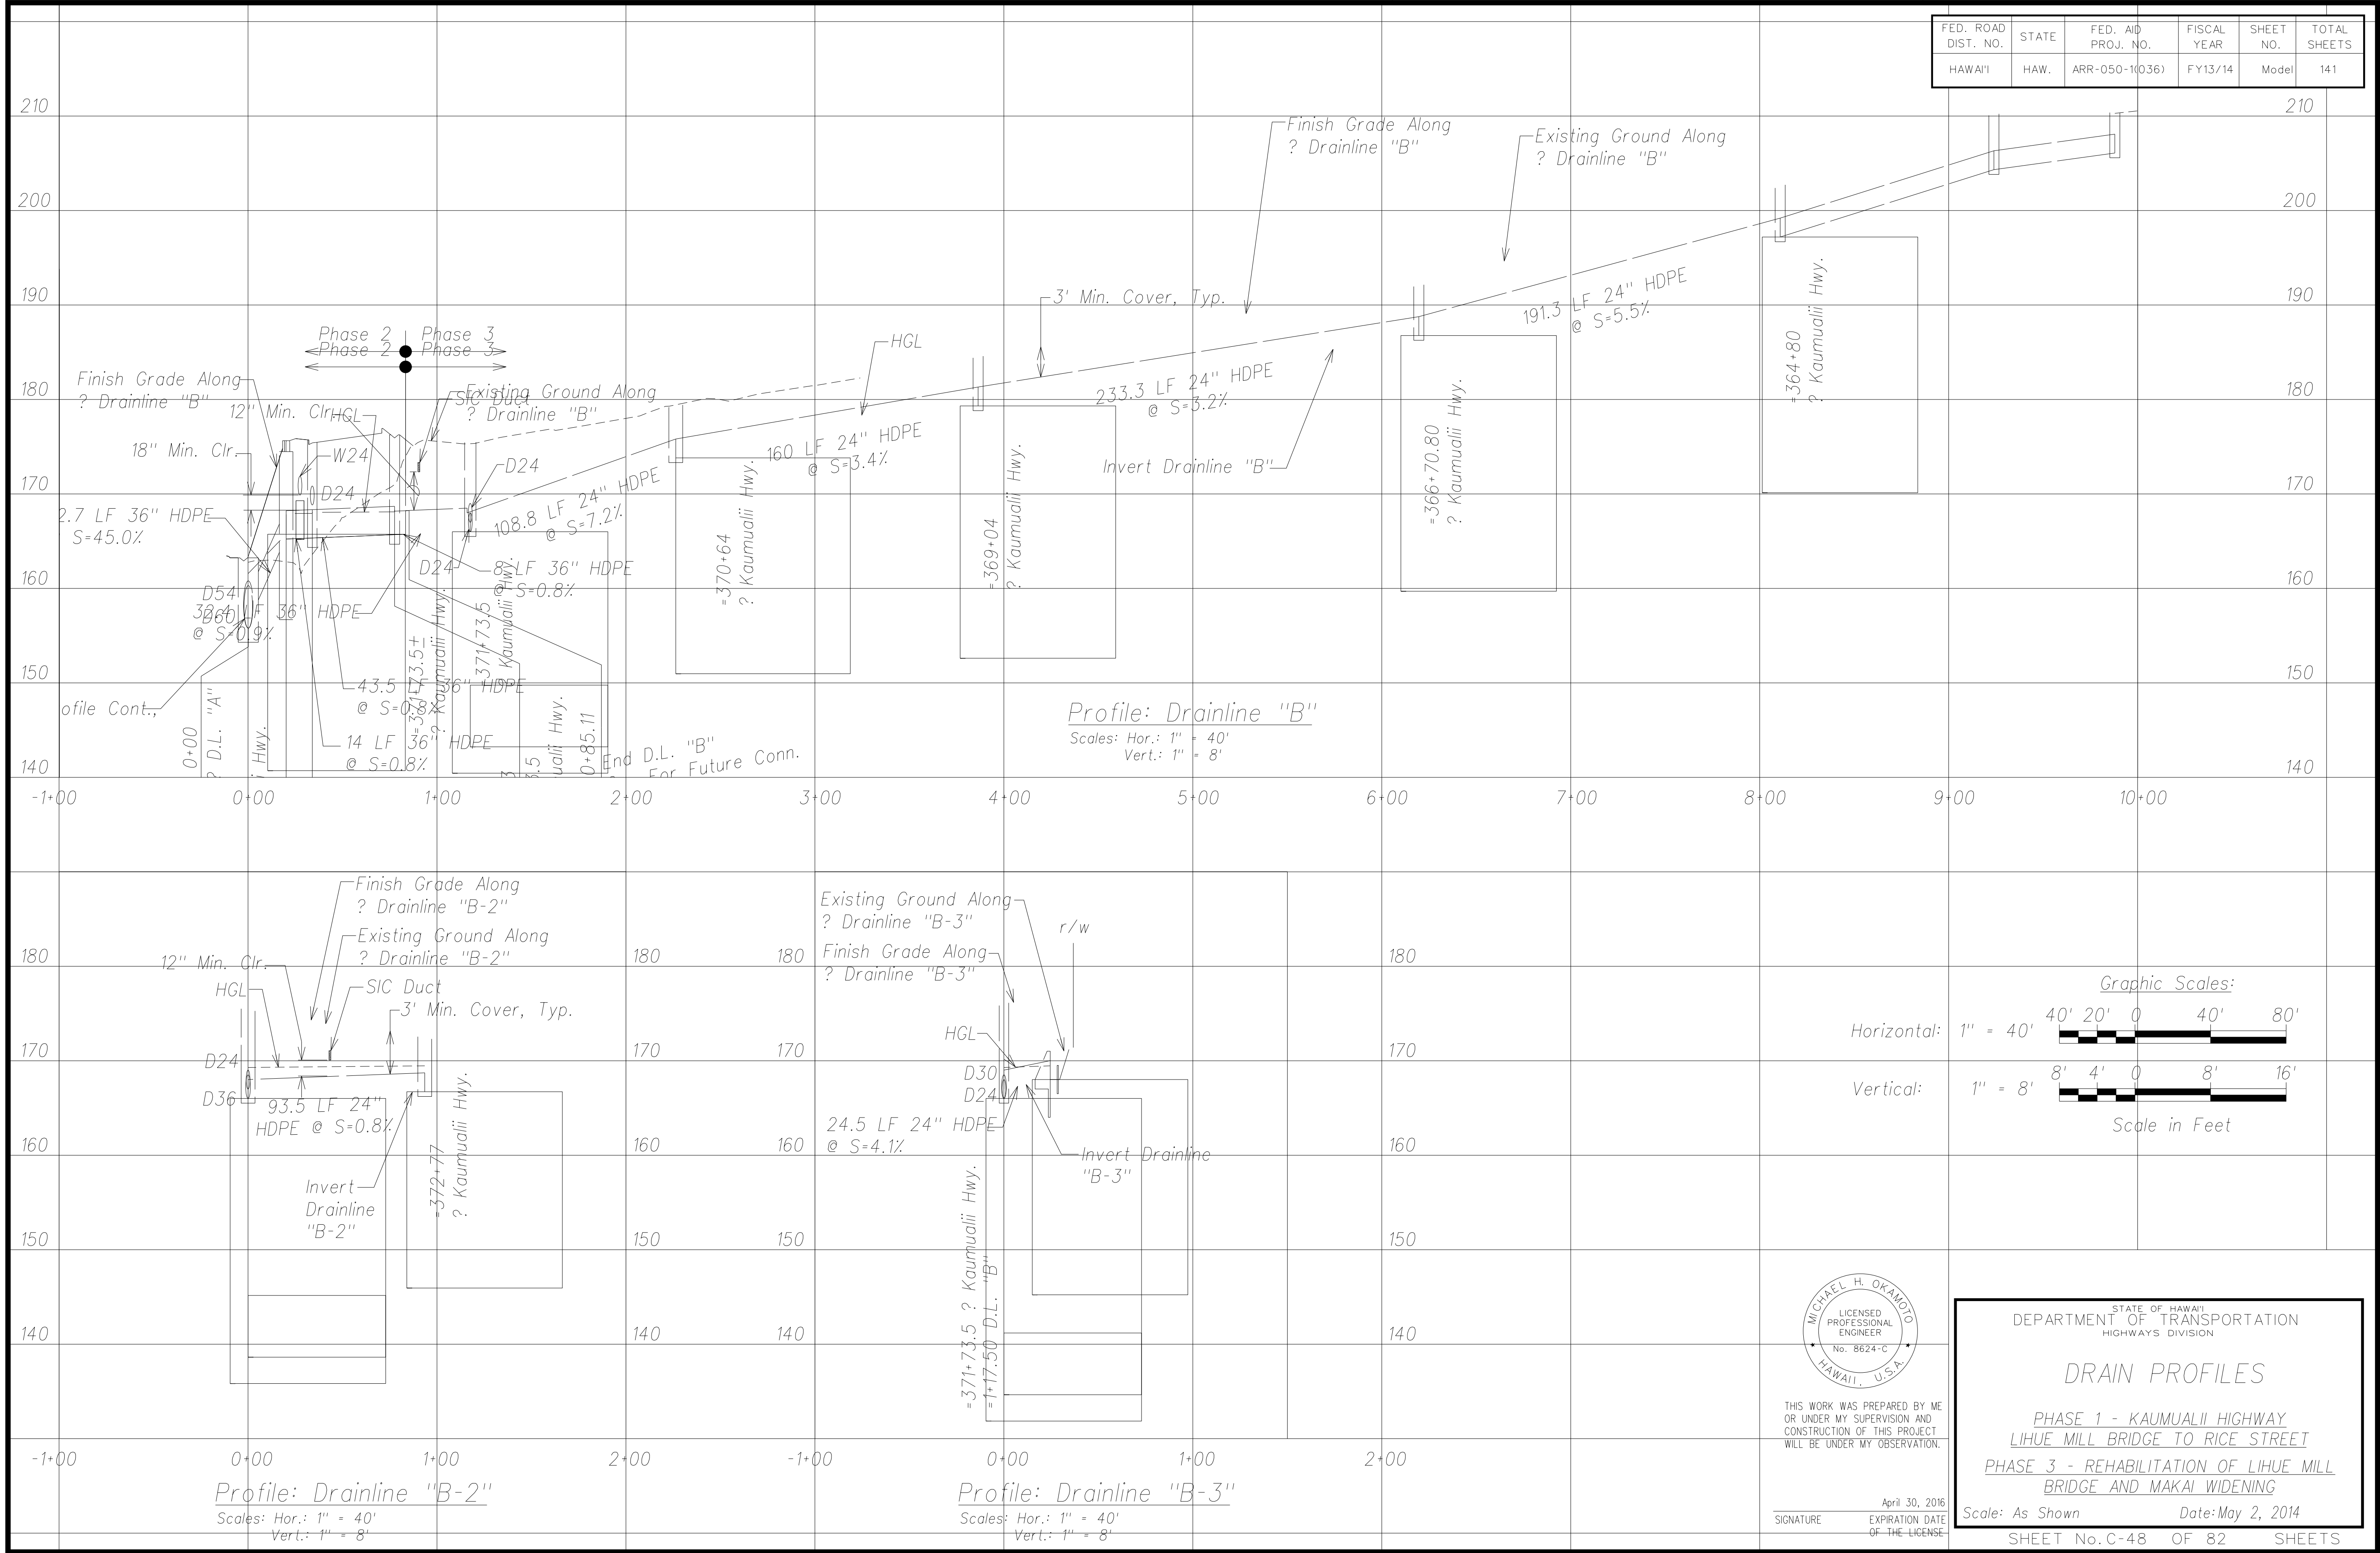

"AS-BUILT"

MODEL