




FED. ROAD DIST. NO.	STATE	FED. AID PROJ. NO.	FISCAL YEAR	SHEET NO.	TOTAL SHEETS
HAWAII	HAW.	ARR-050-1(036)	FY13/14	Model	141

LEGEND FOR AS-BUILT POSTINGS


~~~~~ Squiggly line for as-built deletion

== Double line for as-built deletion

Roadway Text for as-built posting

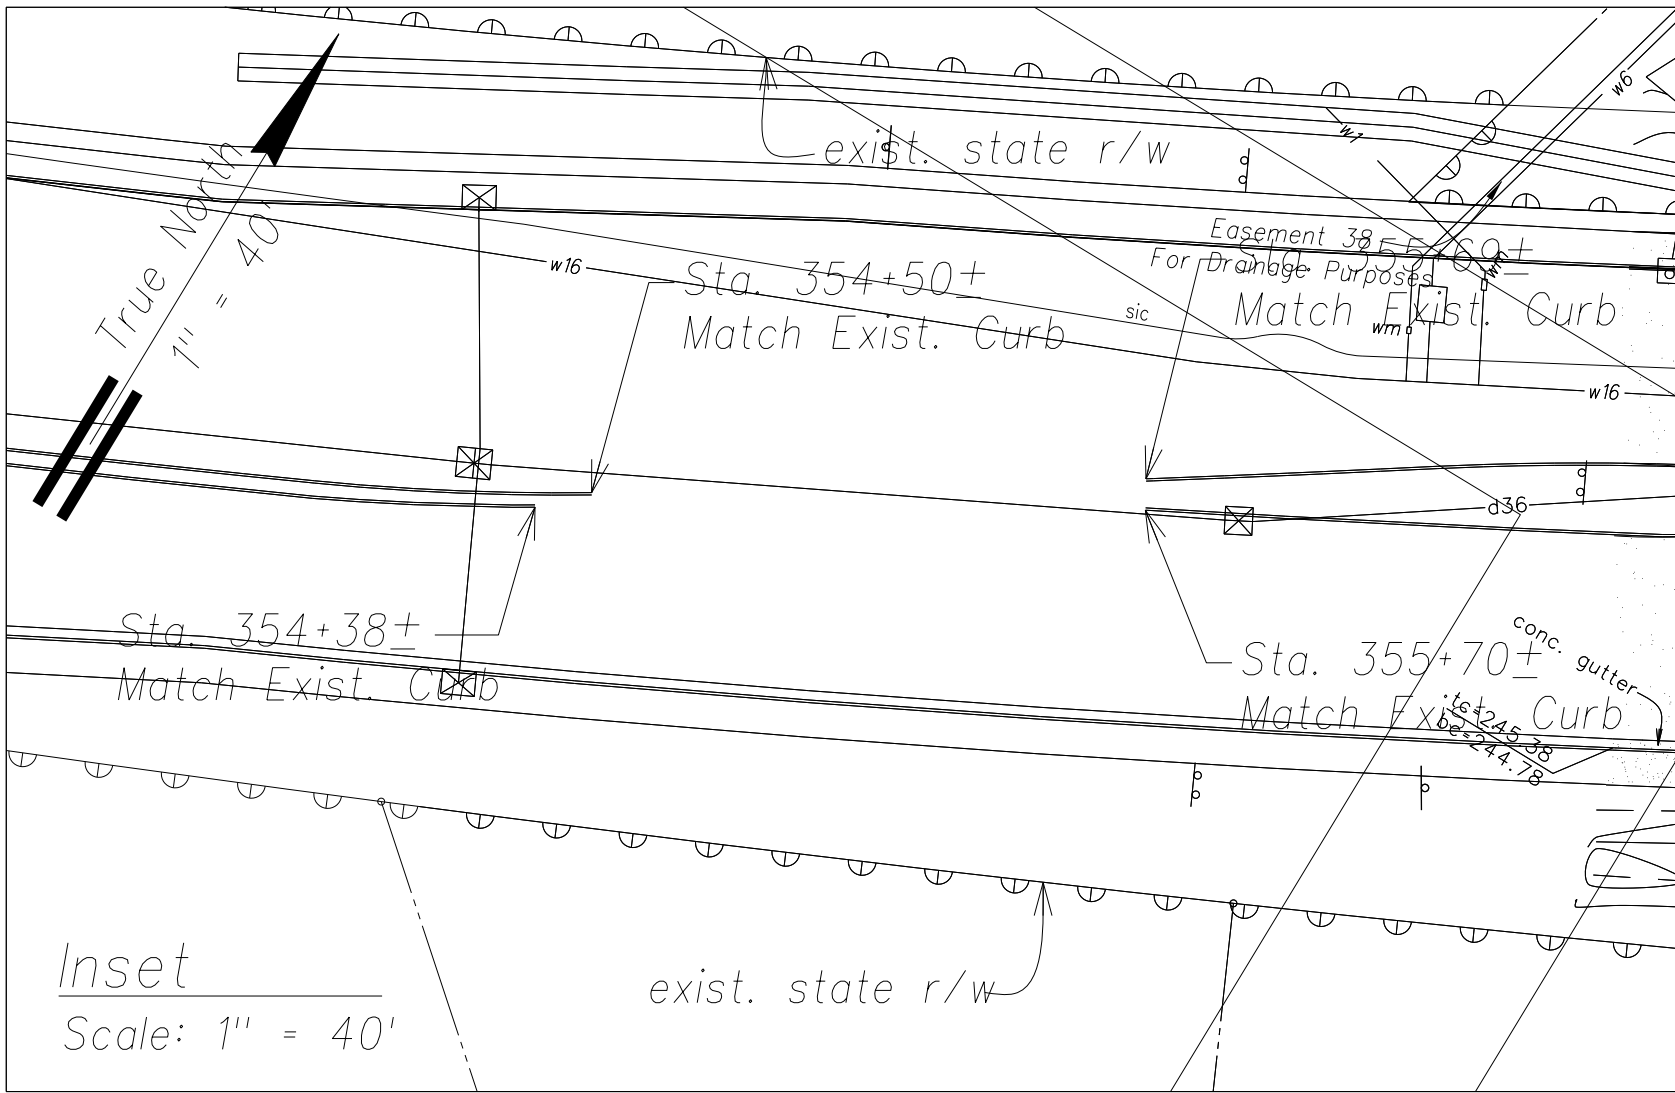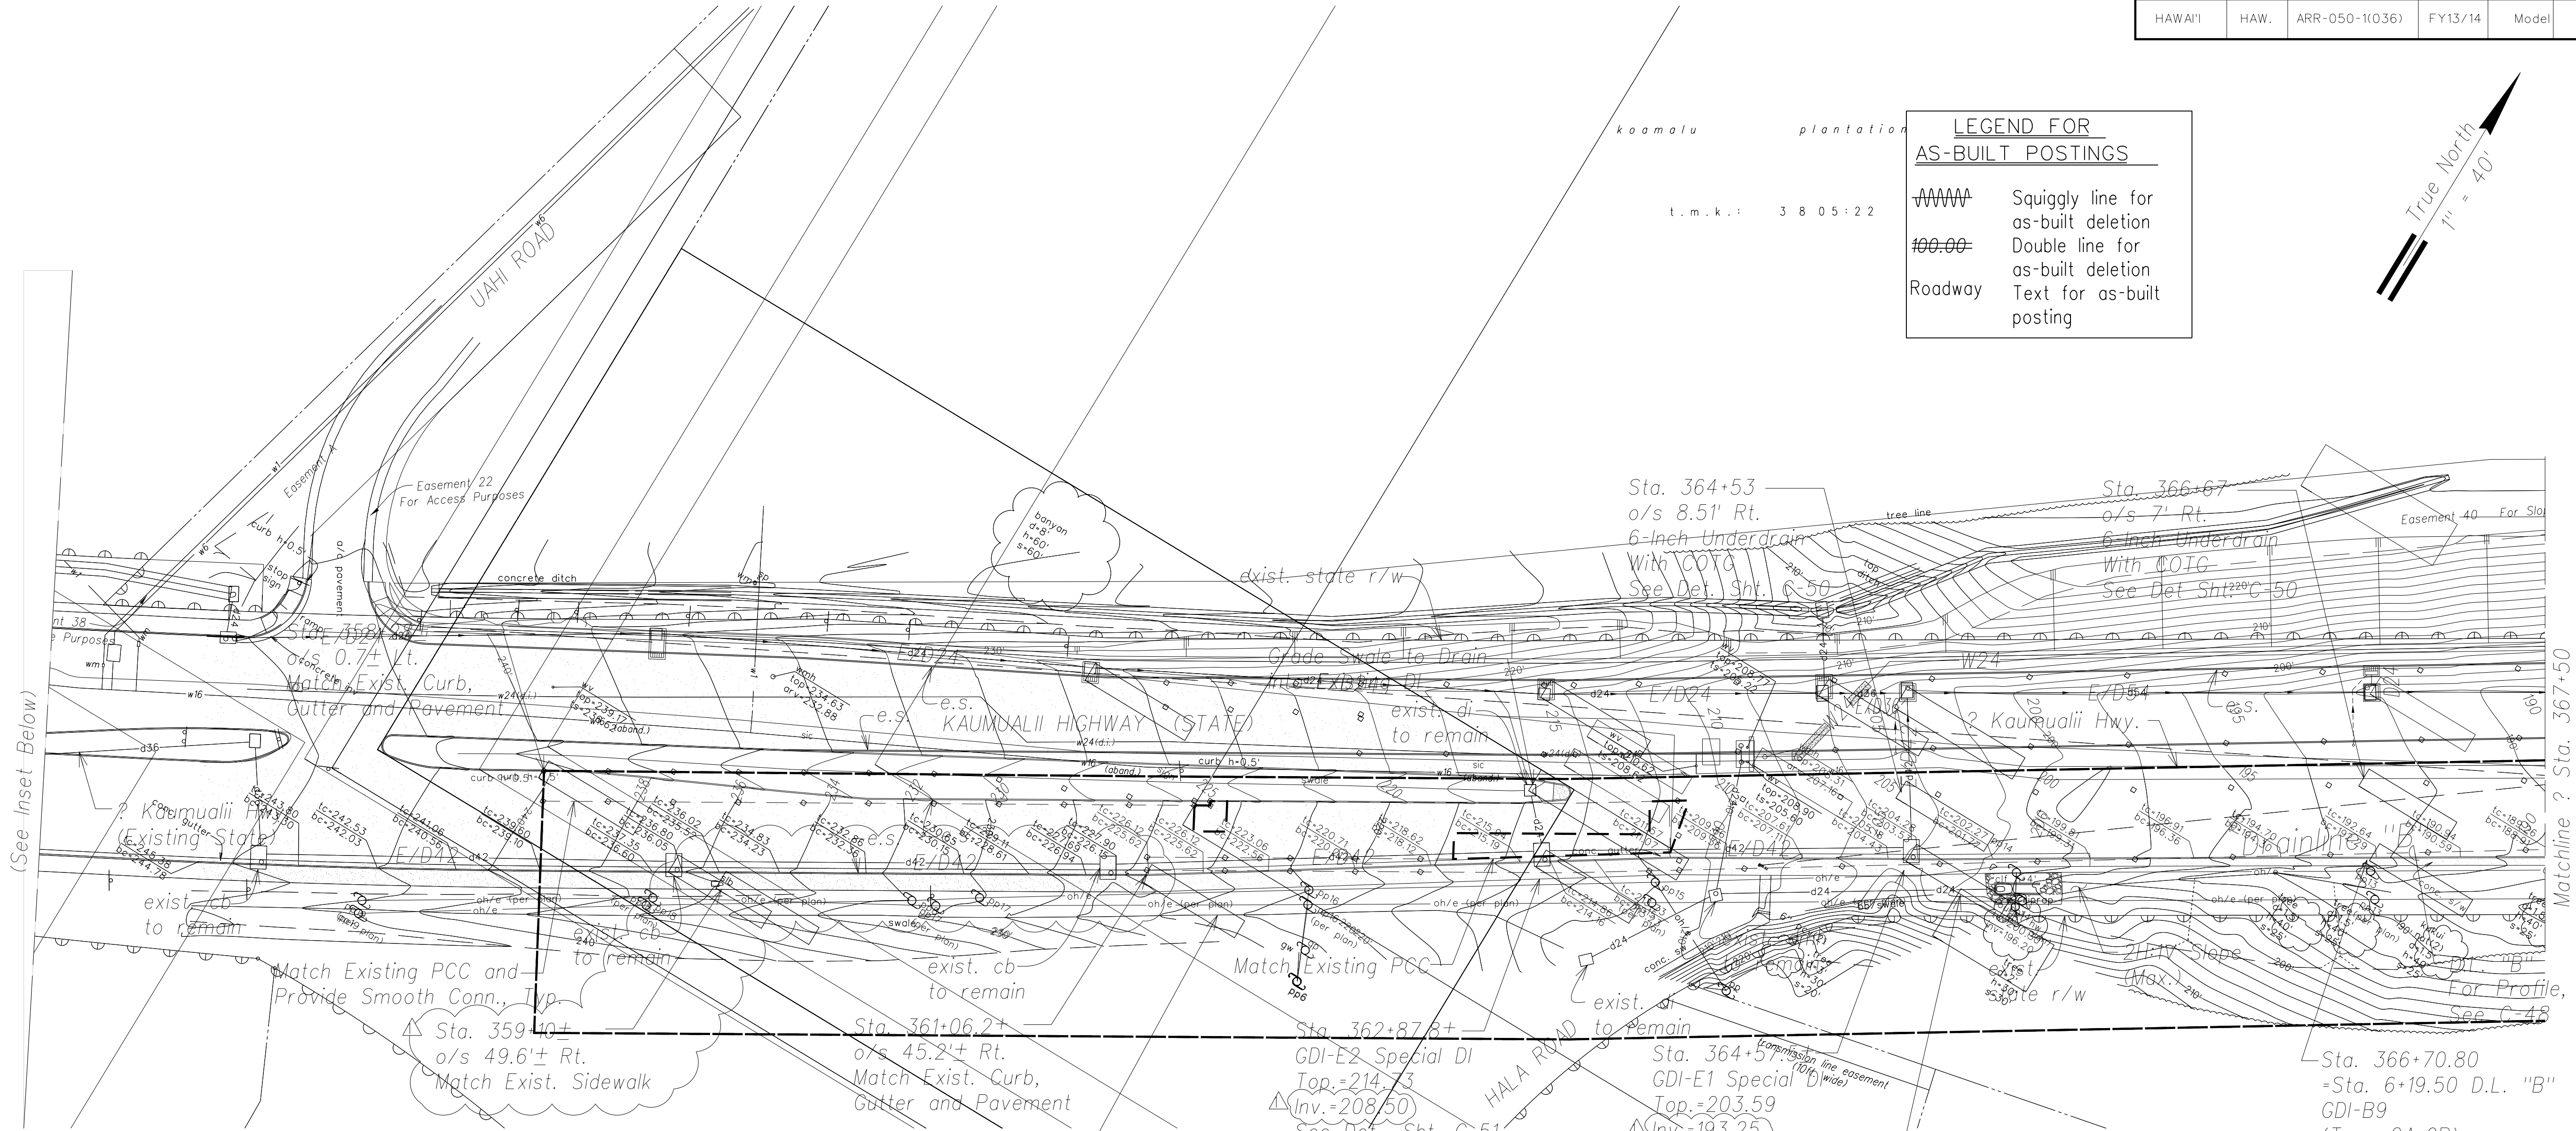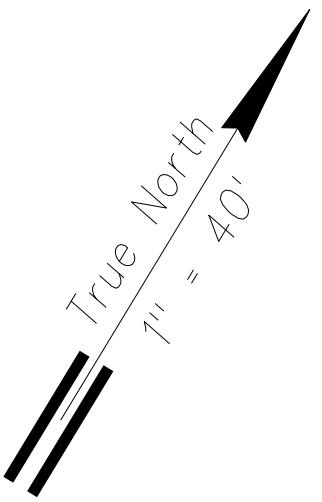

- Legend:**
- 200— Existing Contour
  - 200— Finished Grade Contour

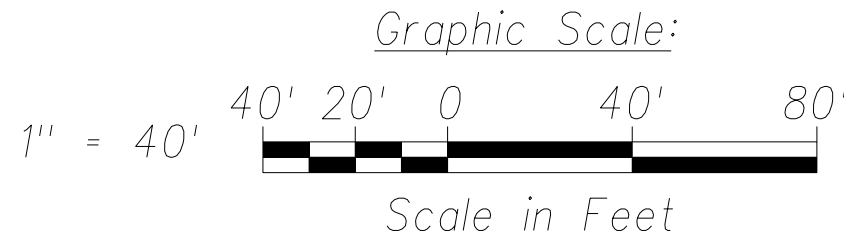

**Note:**  
For Special Grated Drop Inlet (GDI) Details, See Sheet C-51.



THIS WORK WAS PREPARED BY ME OR UNDER MY SUPERVISION AND CONSTRUCTION OF THIS PROJECT WILL BE UNDER MY OBSERVATION.

SIGNATURE \_\_\_\_\_  
April 30, 2016  
EXPIRATION DATE OF THE LICENSE

**NCR NO. 31 - HDPE PIPE CRACKING**

| Date   | Revision                                               |
|--------|--------------------------------------------------------|
| 4/6/15 | Revise for additional PCC pav't. and interconnect work |

STATE OF HAWAII  
DEPARTMENT OF TRANSPORTATION  
HIGHWAYS DIVISION


**GRADING AND DRAINAGE PLAN**  
(Sta. 354+38± to Sta. 367+50)

PHASE 1 - KAUMUALII HIGHWAY  
LIHUE MILL BRIDGE TO RICE STREET

PHASE 3 - REHABILITATION OF LIHUE MILL  
BRIDGE AND MAKAI WIDENING

Scale: As Shown Date: May 2, 2014

| FED. ROAD DIST. NO. | STATE | FED. AID PROJ. NO. | FISCAL YEAR | SHEET NO. | TOTAL SHEETS |
|---------------------|-------|--------------------|-------------|-----------|--------------|
| HAWAII              | HAW.  | ARR-050-110363     | FY13/14     | Model     | 141          |

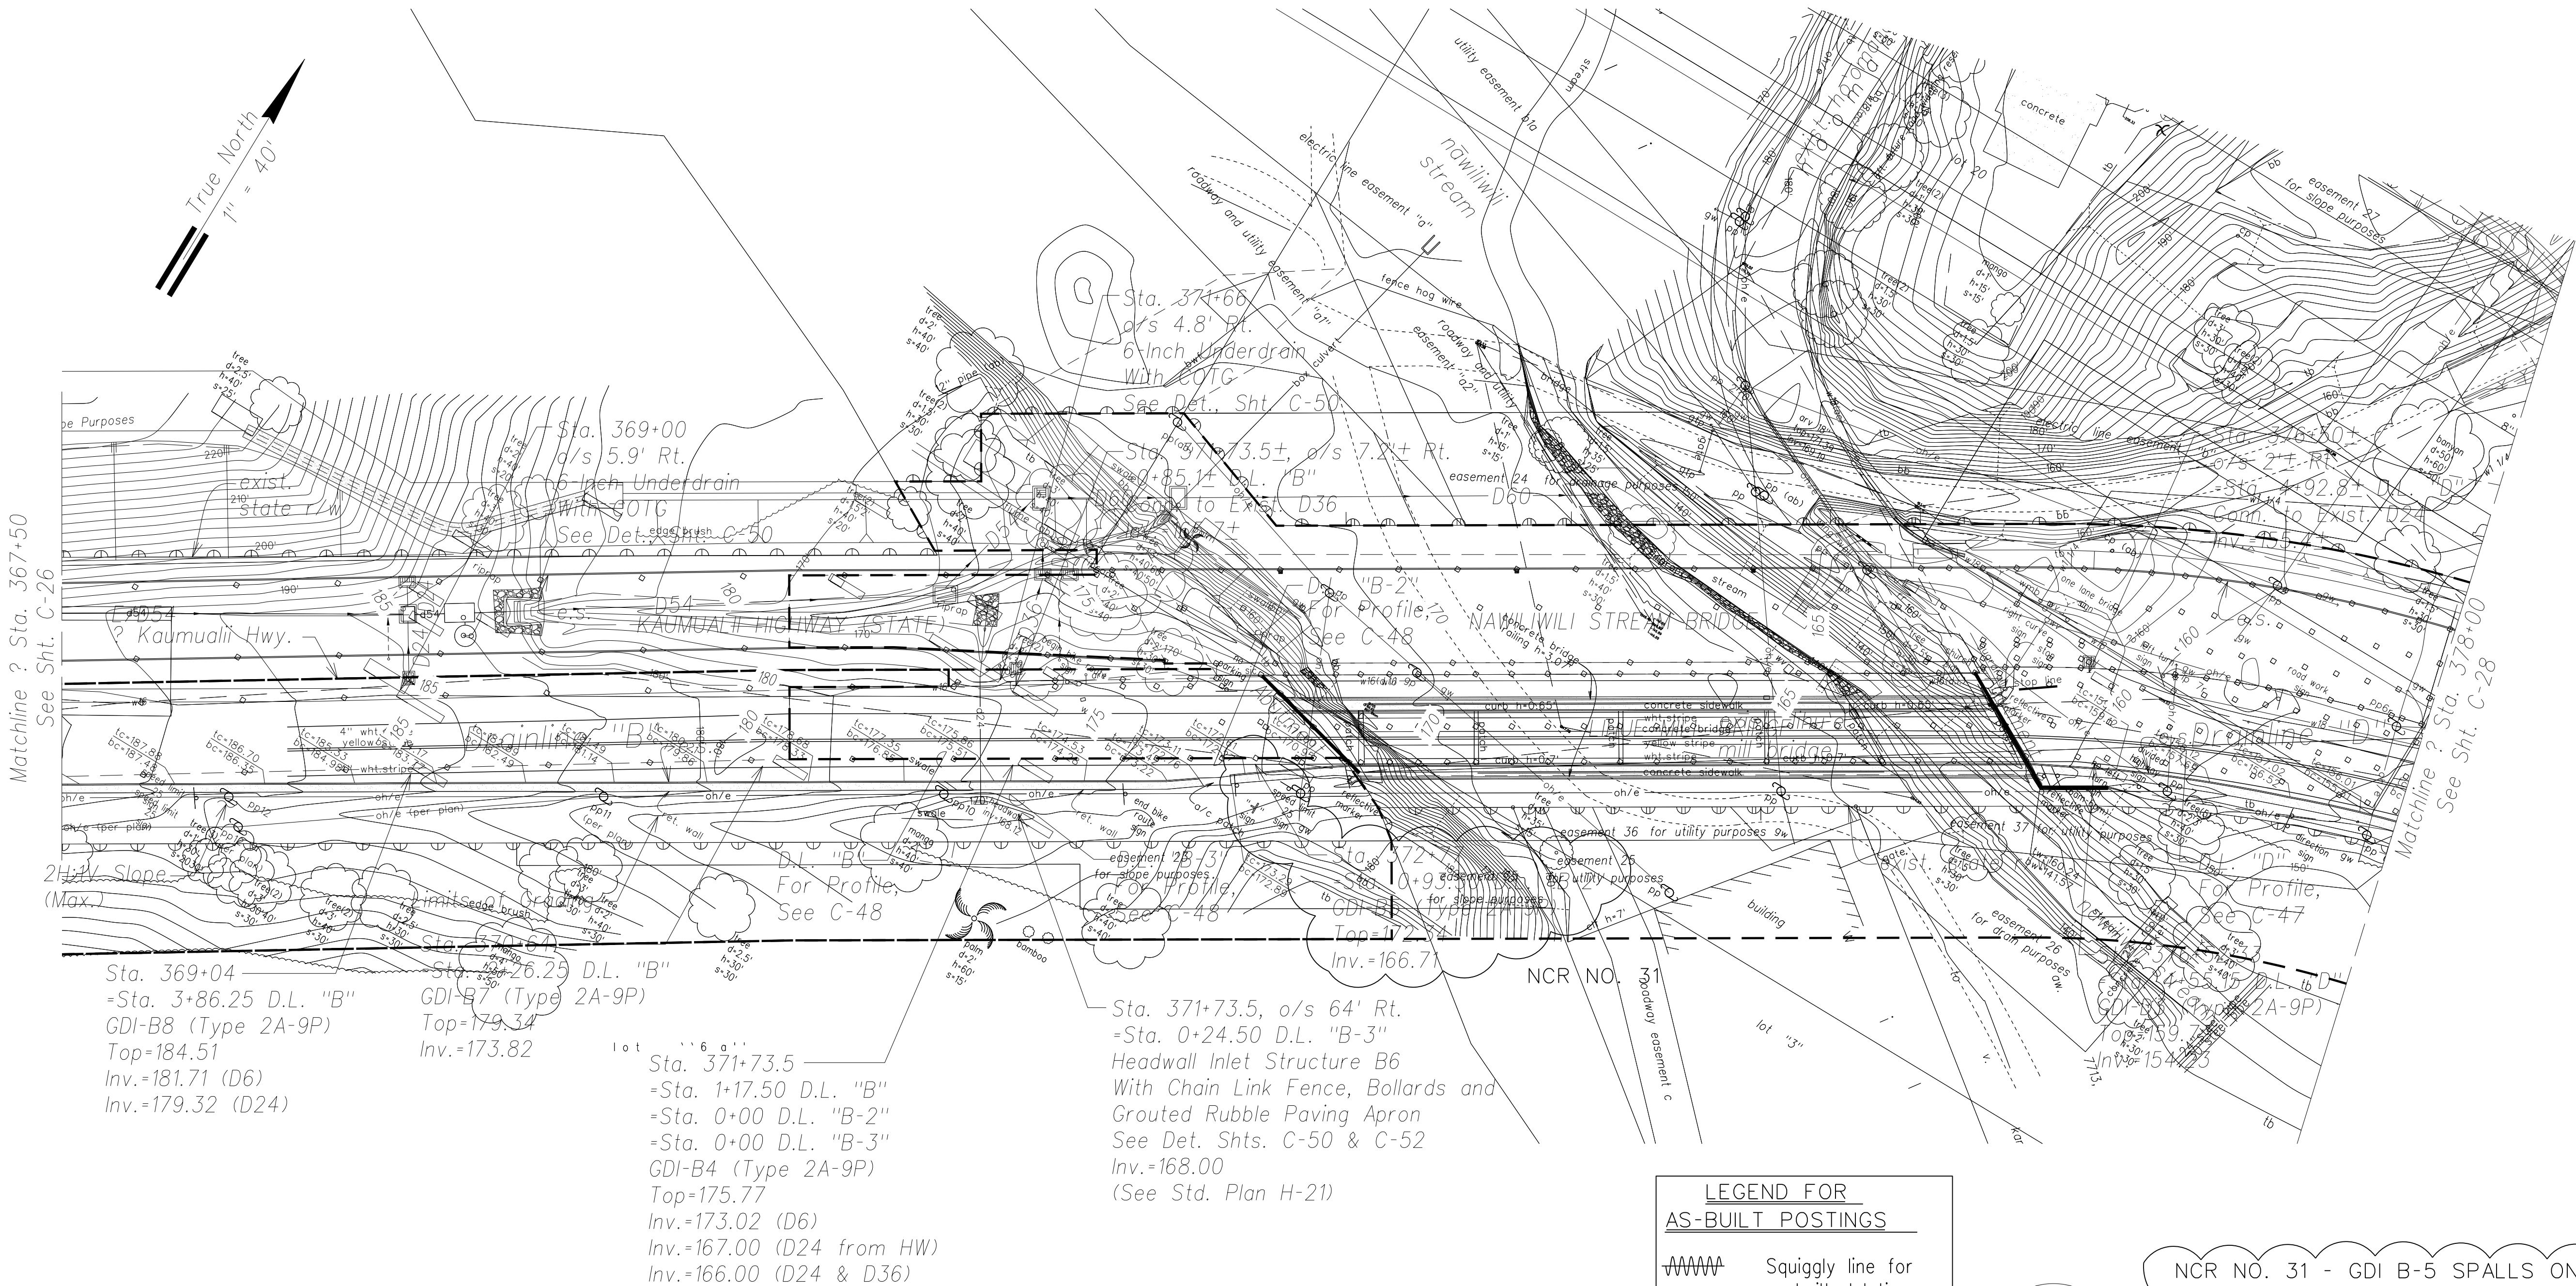

|                   |      |
|-------------------|------|
| SURVEY PLOTTED BY | DATE |
| DRAWN BY          |      |
| DESIGNED BY       |      |
| QUANTITIES BY     |      |
| CHECKED BY        |      |
| ORIGINAL PLAN     |      |
| NOTE BOOK         |      |
| No.               |      |

Grading & Drainage Plan - (Sta. 367+50 to Sta. 378+00)  
Scale: 1" = 40'

- Legend:
- 200— Existing Contour
  - 200— Finished Grade Contour

LEGEND FOR  
AS-BUILT POSTINGS

~~~~~ Squiggly line for  
as-built deletion


== Double line for
as-built deletion

Roadway Text for as-built
posting



THIS WORK WAS PREPARED BY ME
OR UNDER MY SUPERVISION AND
CONSTRUCTION OF THIS PROJECT
WILL BE UNDER MY OBSERVATION.

SIGNATURE
EXPIRATION DATE
OF THE LICENSE

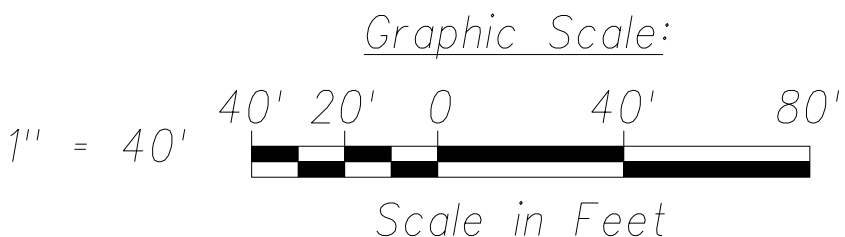

NCR NO. 31 - GDI B-5 SPALLS ON
STRUCTURE

STATE OF HAWAII
DEPARTMENT OF TRANSPORTATION
HIGHWAYS DIVISION
GRADING AND DRAINAGE PLAN
(Sta. 367+50 to Sta. 378+00)
PHASE 1 - KAUMUALII HIGHWAY
LIHUE MILL BRIDGE TO RICE STREET
PHASE 3 - REHABILITATION OF LIHUE MILL
BRIDGE AND MAKAI WIDENING
Scale: As Shown Date: May 2, 2014
SHEET No. C-27 OF 82 SHEETS

