


FED. ROAD DIST. NO.	STATE	FED. AID PROJ. NO.	FISCAL YEAR	SHEET NO.	TOTAL SHEETS
HAWAII	HAW.	ARR-050-1(036)	FY13/14	Model	141

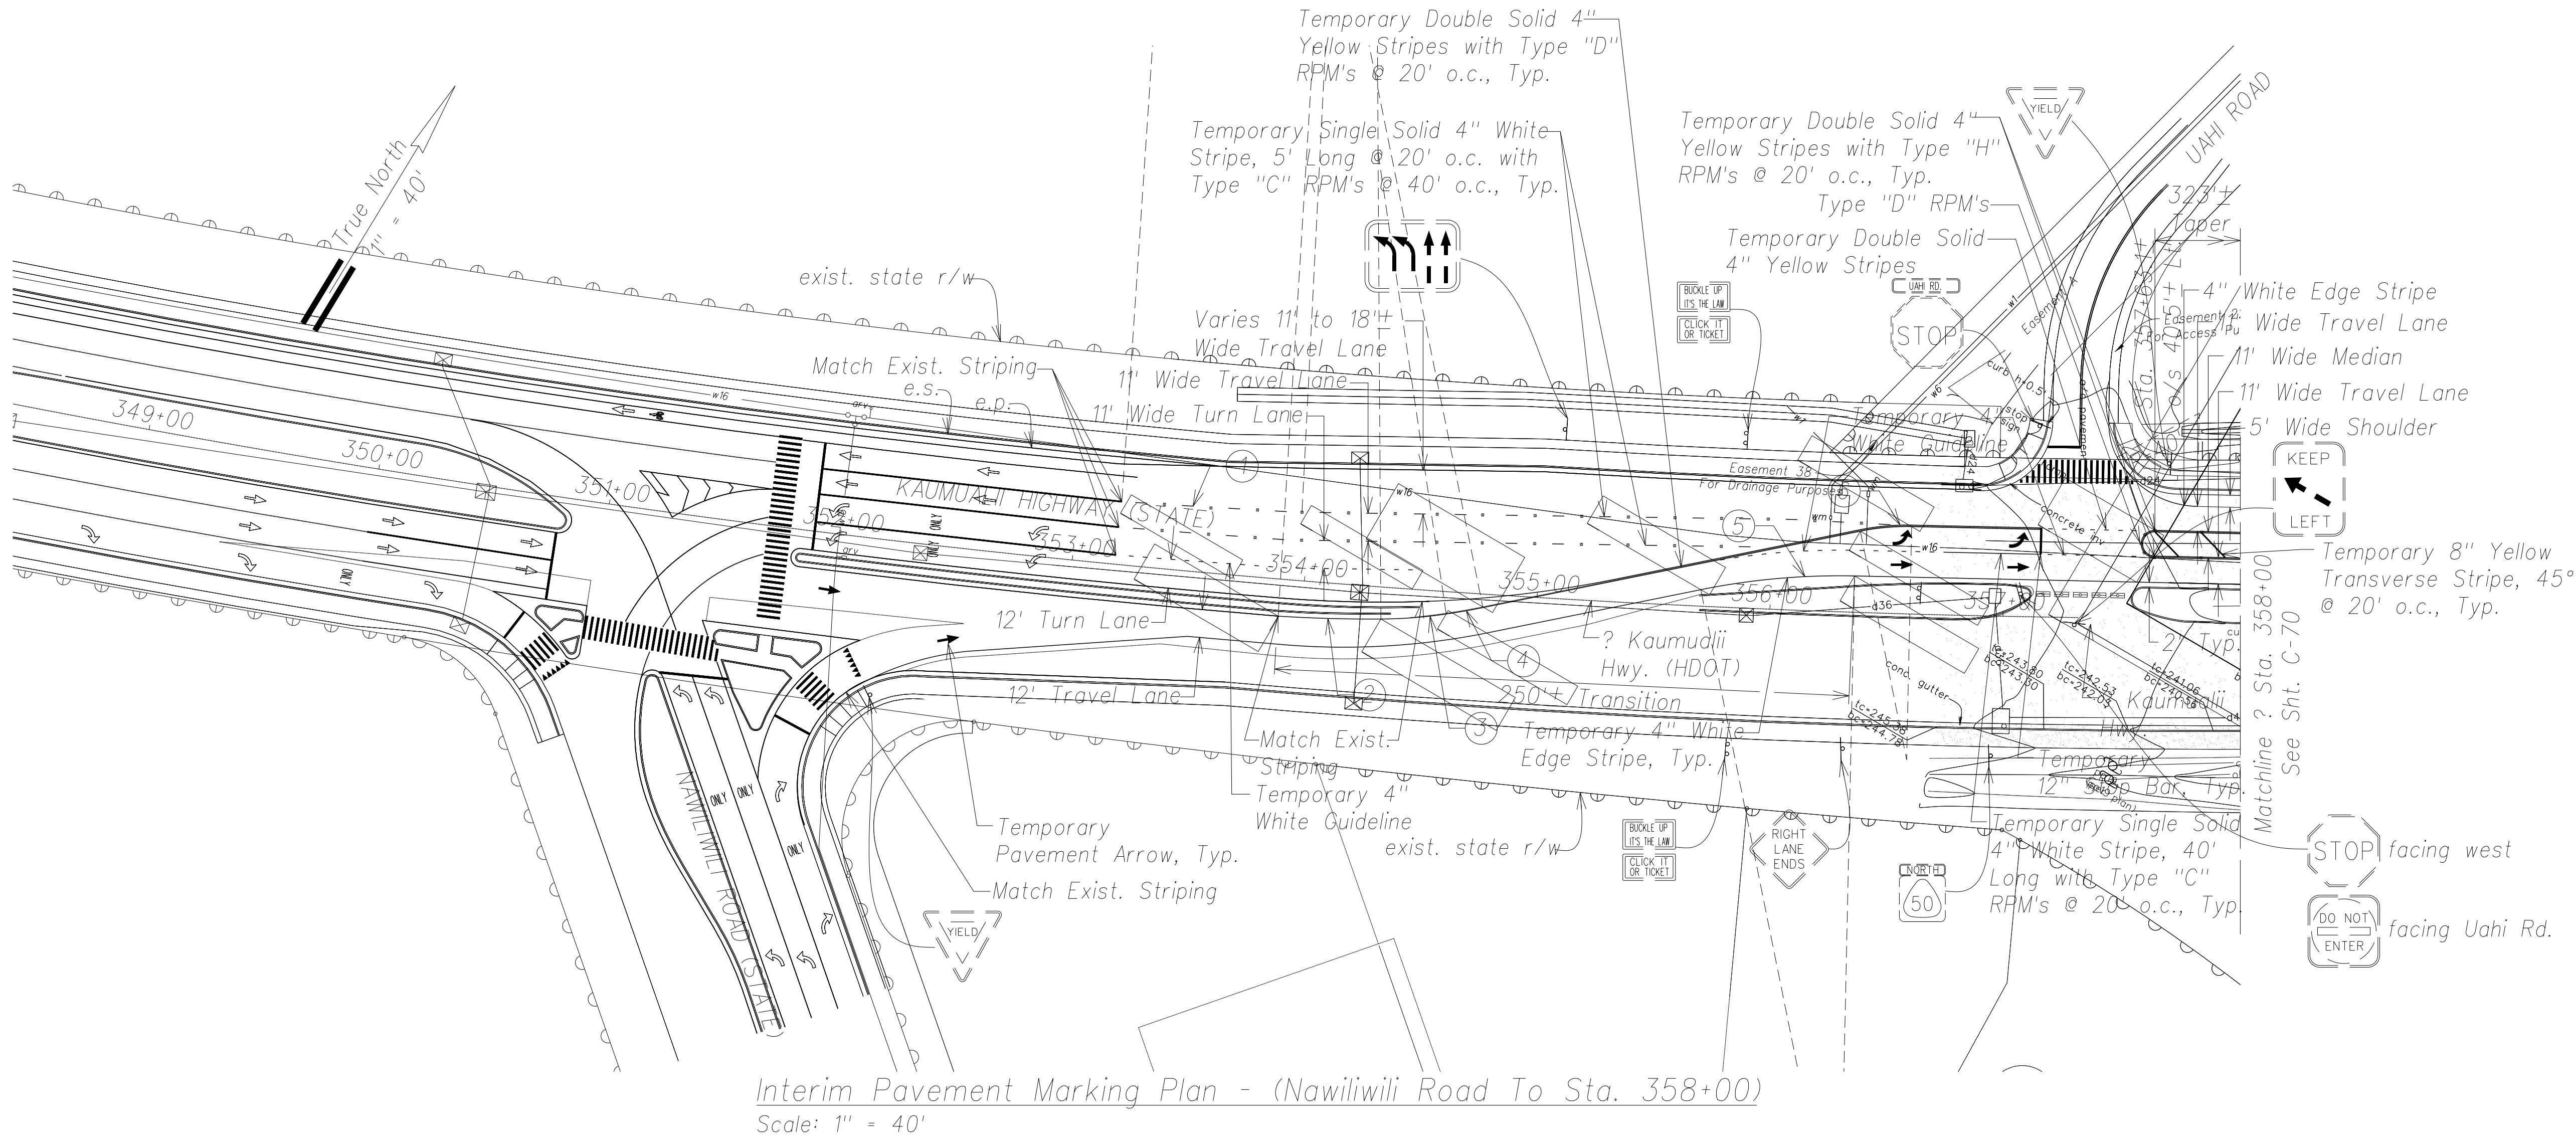


STRIPING CURVE DATA						
CURVE	1	2	3	4	5	6
P.C. Sta.	353+18.8±	353+90±	354+33.9±	354+61.6±	355+70±	356+37.7± o/s
o/s	o/s 27' Lt.	o/s 15.9'± Rt.	o/s 13.7'± Rt.	o/s 9.6'± Rt.	o/s 7.1'± Lt.	34.8'± Lt.
P.T. Sta.	353+96.6±	354+33.9±	354+61.6±	354+77.0±	356+35.8± o/s	356+59.8± o/s
o/s	o/s 29.3'± Lt.	o/s 13.7'± Rt.	o/s 9.6'± Rt.	o/s 5.5'± Rt.	15.6'± Lt.	37.5'± Lt.
Δ	0° 54' 15"	3° 52' 24"	8° 03' 00"	3° 02' 43"	12° 40' 33"	12° 40' 33"
Δ/2	0° 27' 08"	1° 56' 12"	4° 01' 30"	1° 31' 22"	6° 20' 17"	6° 20' 17"
R	4900'	652'	200'	301'	300'	100.33'
T	38.70'	22.04'	14.07'	8.00'	33.32'	11.14'
C	77.40'	44.06'	28.08'	16.00'	66.24'	22.15'
Lc	77.40'	44.07'	28.10'	16.00'	66.37'	22.20'

SURVEY PLOTTED BY	DATE
DRAWN BY	
DESIGNED BY	
CHECKED BY	
ORIGINAL PLAN	
NOTE BOOK	
No.	



THIS WORK WAS PREPARED BY ME OR UNDER MY SUPERVISION AND CONSTRUCTION OF THIS PROJECT WILL BE UNDER MY OBSERVATION.

SIGNATURE
April 30, 2016
EXPIRATION DATE OF THE LICENSE

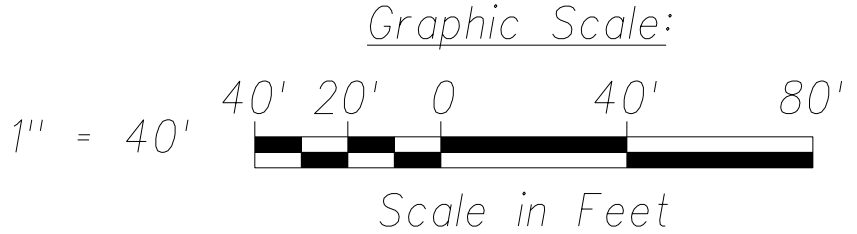

STATE OF HAWAII
DEPARTMENT OF TRANSPORTATION
HIGHWAYS DIVISION


INTERIM PAVEMENT MARKING PLAN
PHASE 1 - KAUMUALII HIGHWAY
LIHUE MILL BRIDGE TO RICE STREET
PHASE 3 - REHABILITATION OF LIHUE MILL BRIDGE AND MAKAI WIDENING

Scale: As Shown Date: May 2, 2014
SHEET No. C-71 OF 82 SHEETS

"AS-BUILT"



MODEL

FED. ROAD DIST. NO.	STATE	FED. AID PROJ. NO.	FISCAL YEAR	SHEET NO.	TOTAL SHEETS
HAWAII	HAW.	ARR-050-1(036)	FY13/14	Model	141

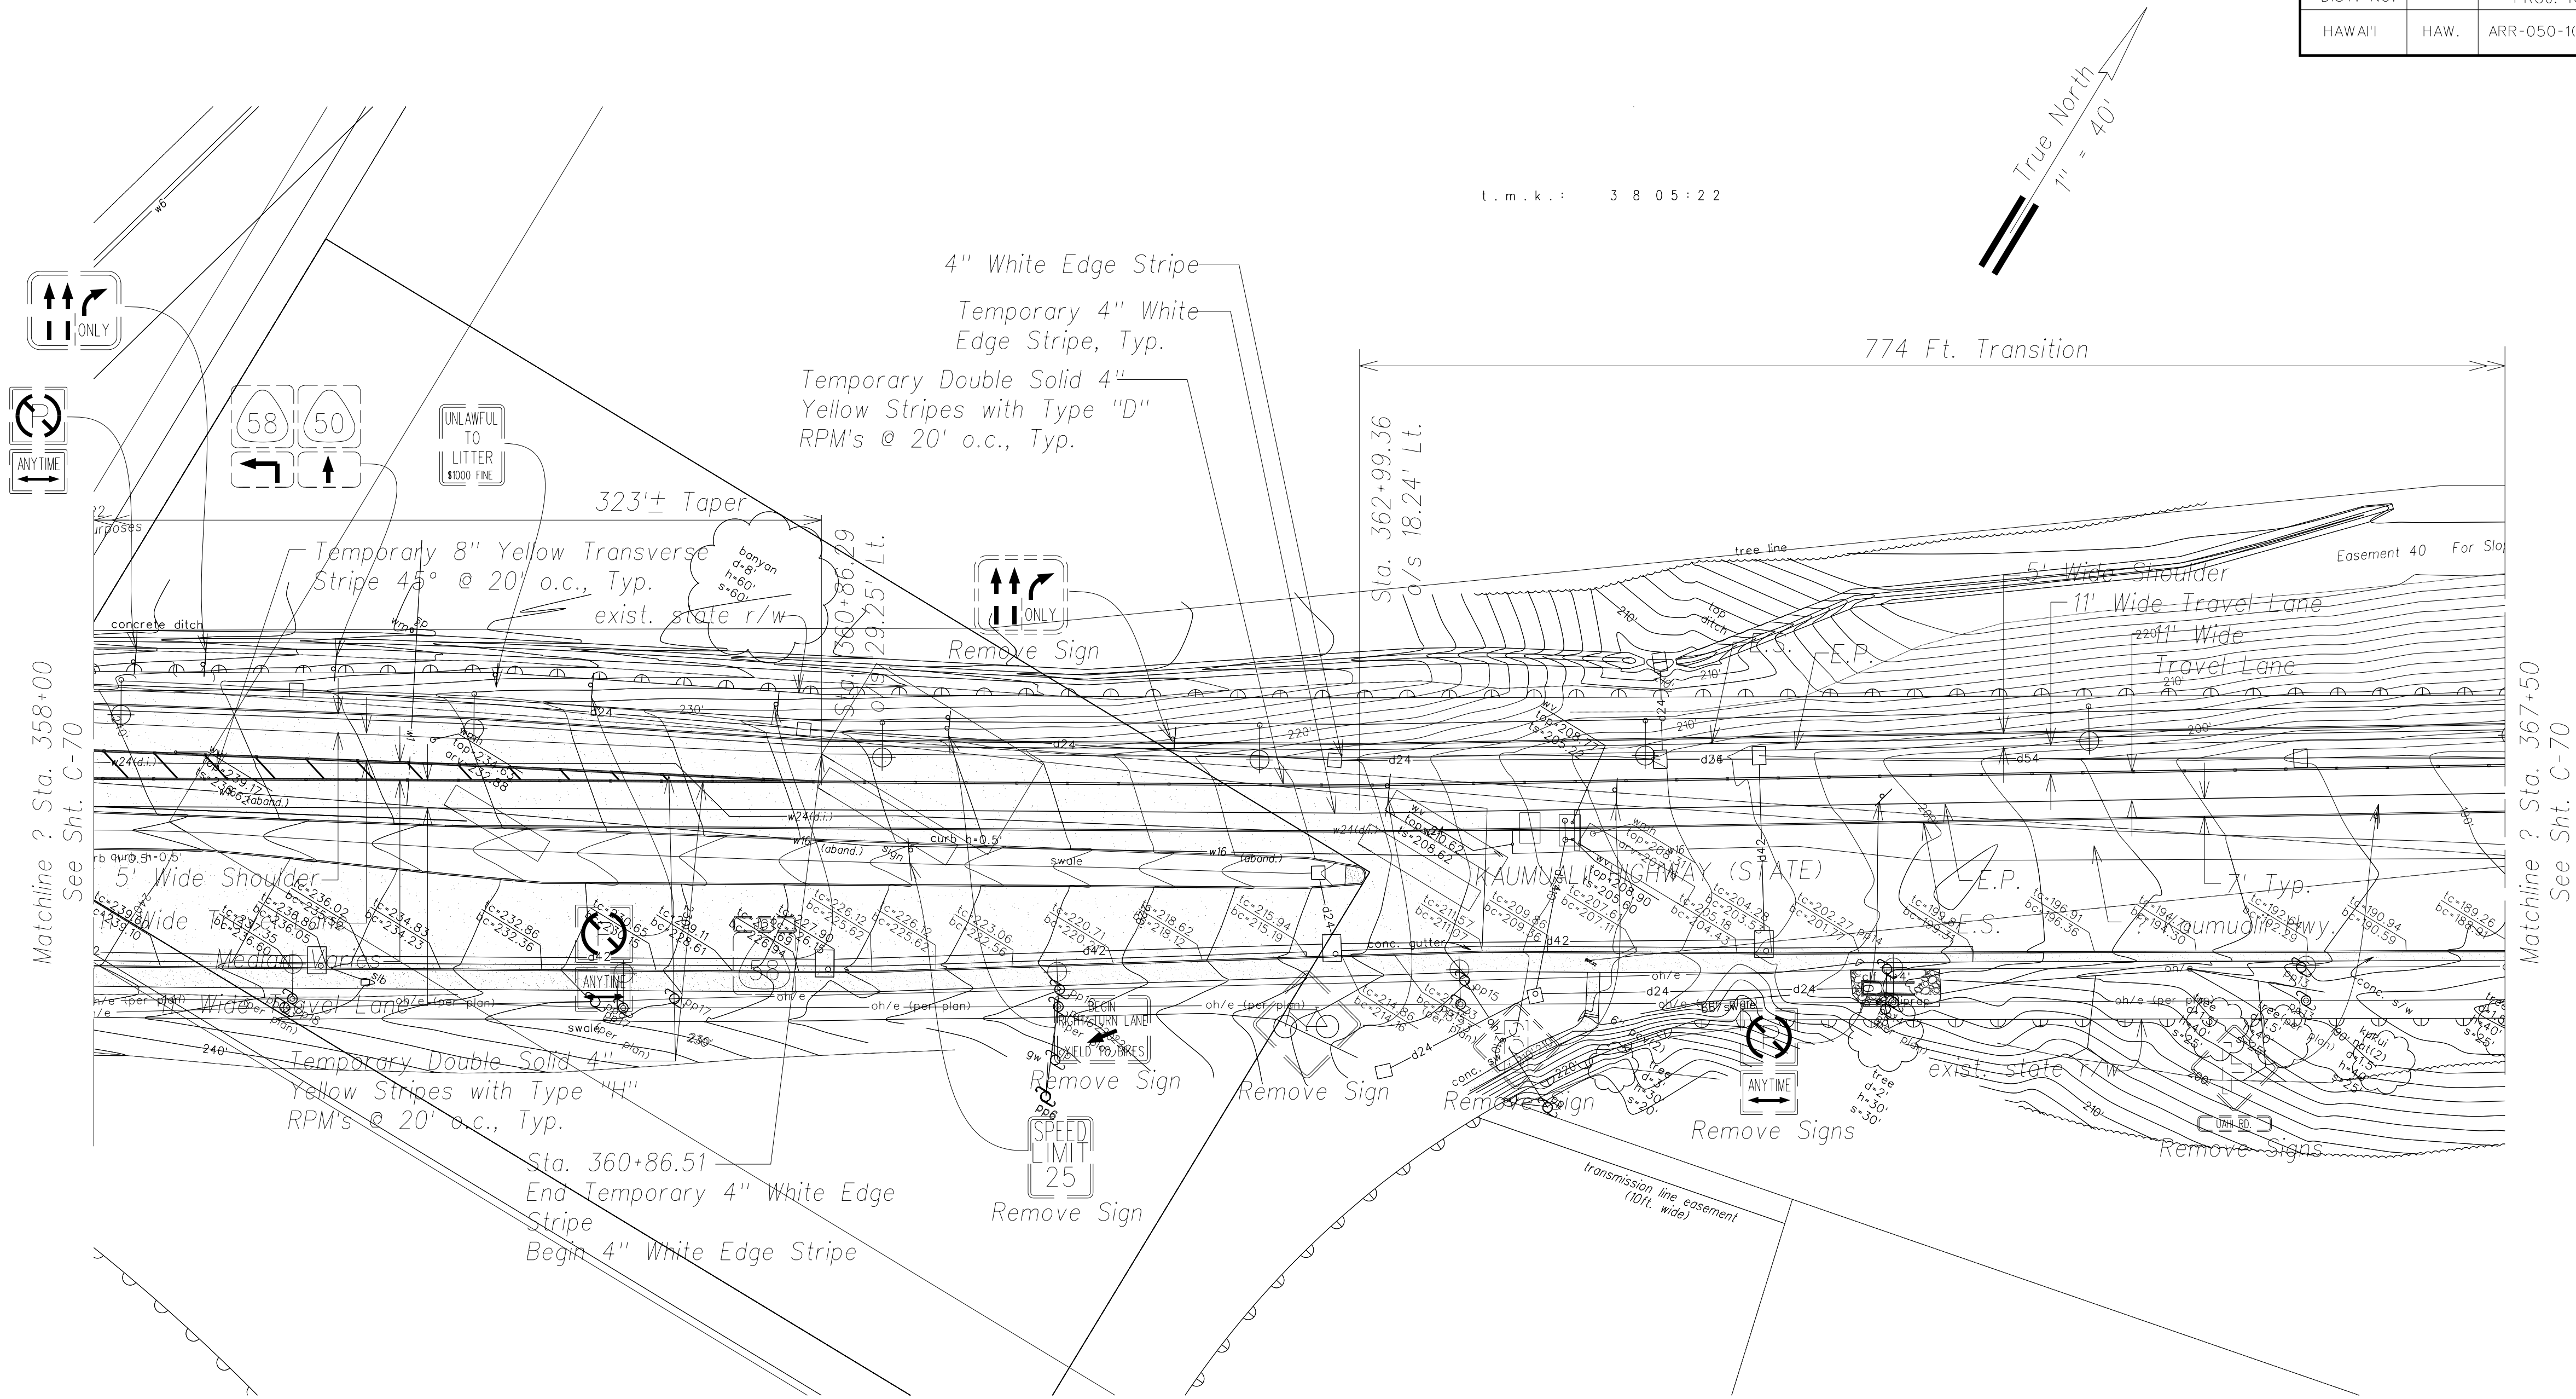

Interim Pavement Marking Plan - (Sta. 358+00 To Sta. 367+50)
Scale: 1" = 40'

ORIGINAL PLAN	SURVEY PLOTTED BY	DATE
NOTE BOOK	DESIGNED BY	
	QUANTITIES BY	
	CHECKED BY	

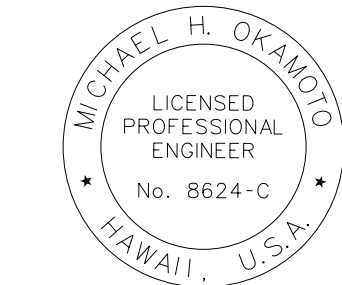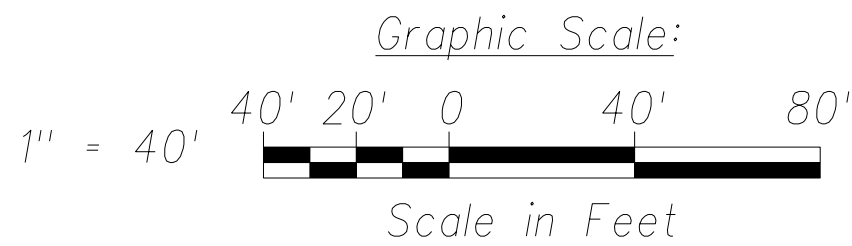

THIS WORK WAS PREPARED BY ME
OR UNDER MY SUPERVISION AND
CONSTRUCTION OF THIS PROJECT
WILL BE UNDER MY OBSERVATION.

SIGNATURE
APR 30, 2016
EXPIRATION DATE
OF THE LICENSE

STATE OF HAWAII
DEPARTMENT OF TRANSPORTATION
HIGHWAYS DIVISION

INTERIM PAVEMENT
MARKING PLAN

PHASE 1 - KAUMUALII HIGHWAY
LIHUE MILL BRIDGE TO RICE STREET

PHASE 3 - REHABILITATION OF LIHUE MILL
BRIDGE AND MAKAI WIDENING


Scale: As Shown Date: May 2, 2014

SHEET No. C-72 OF 82 SHEETS

"AS-BUILT"

MODEL

FED. ROAD DIST. NO.	STATE	FED. AID PROJ. NO.	FISCAL YEAR	SHEET NO.	TOTAL SHEETS
HAWAII	HAW.	ARR-050-1(036)	FY13/14	Model	141


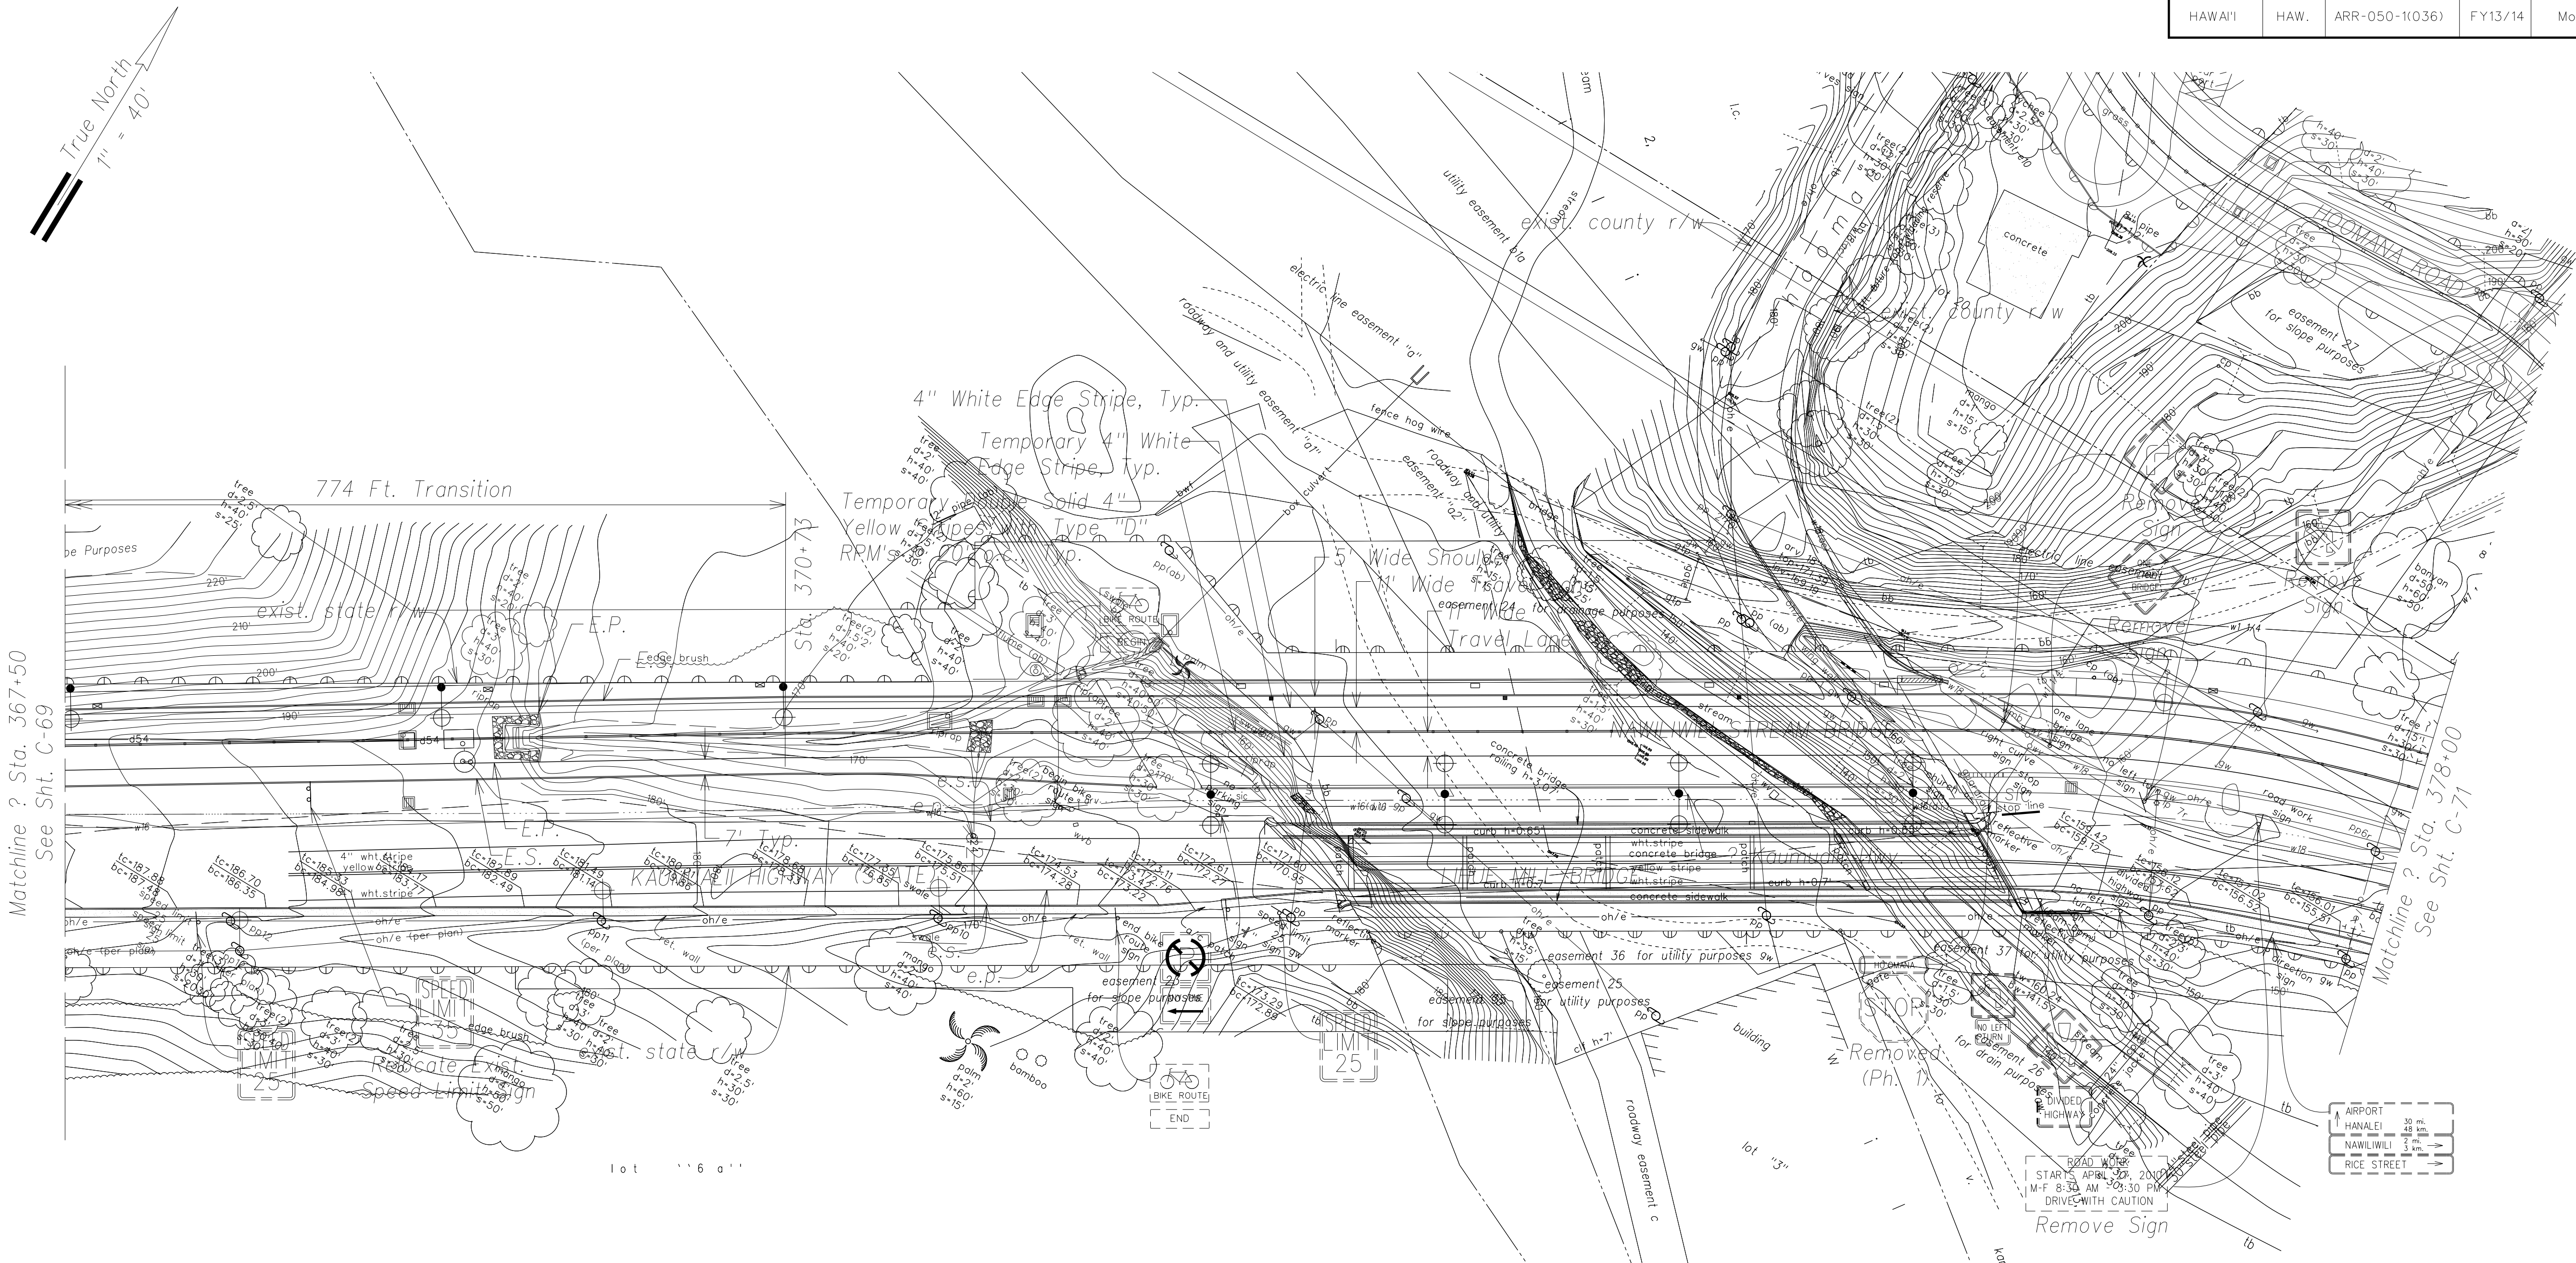


Matchline ? Sta. 367+50
See Sht. C-69

Matchline ? Sta. 378+00
See Sht. C-71

Interim Paving Marking Plan - (Sta. 367+50 To Sta. 378+00)
Scale: 1" = 40'

ORIGINAL PLAN	SURVEY PLOTTED BY	DATE
NOTE BOOK	DRAWN BY	
	DESIGNED BY	
	QUANTITIES BY	
	CHECKED BY	

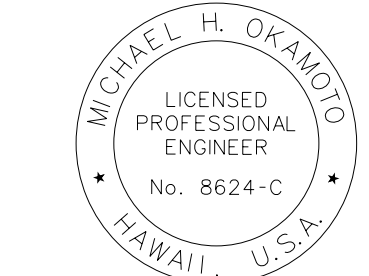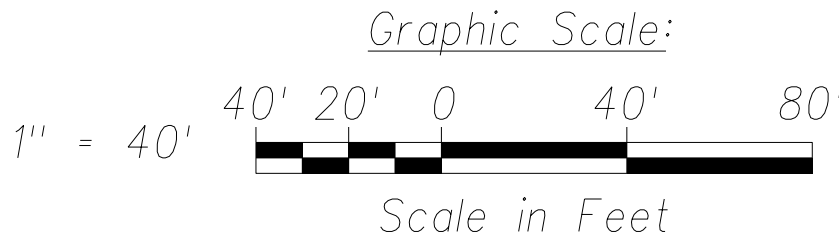

THIS WORK WAS PREPARED BY ME OR UNDER MY SUPERVISION AND CONSTRUCTION OF THIS PROJECT WILL BE UNDER MY OBSERVATION.

SIGNATURE
EXPIRATION DATE OF THE LICENSE

STATE OF HAWAII
DEPARTMENT OF TRANSPORTATION
HIGHWAYS DIVISION



INTERIM PAVEMENT
MARKING PLAN
PHASE 1 - KAUMUALII HIGHWAY
LIHUE MILL BRIDGE TO RICE STREET
PHASE 3 - REHABILITATION OF LIHUE MILL
BRIDGE AND MAKAI WIDENING

Scale: As Shown Date: May 2, 2014
SHEET No. C-73 OF 82 SHEETS

"AS-BUILT"


MODEL

FED. ROAD DIST. NO.	STATE	FED. AID PROJ. NO.	FISCAL YEAR	SHEET NO.	TOTAL SHEETS
HAWAII	HAW.	ARR-050-1(036)	FY13/14	Model	141

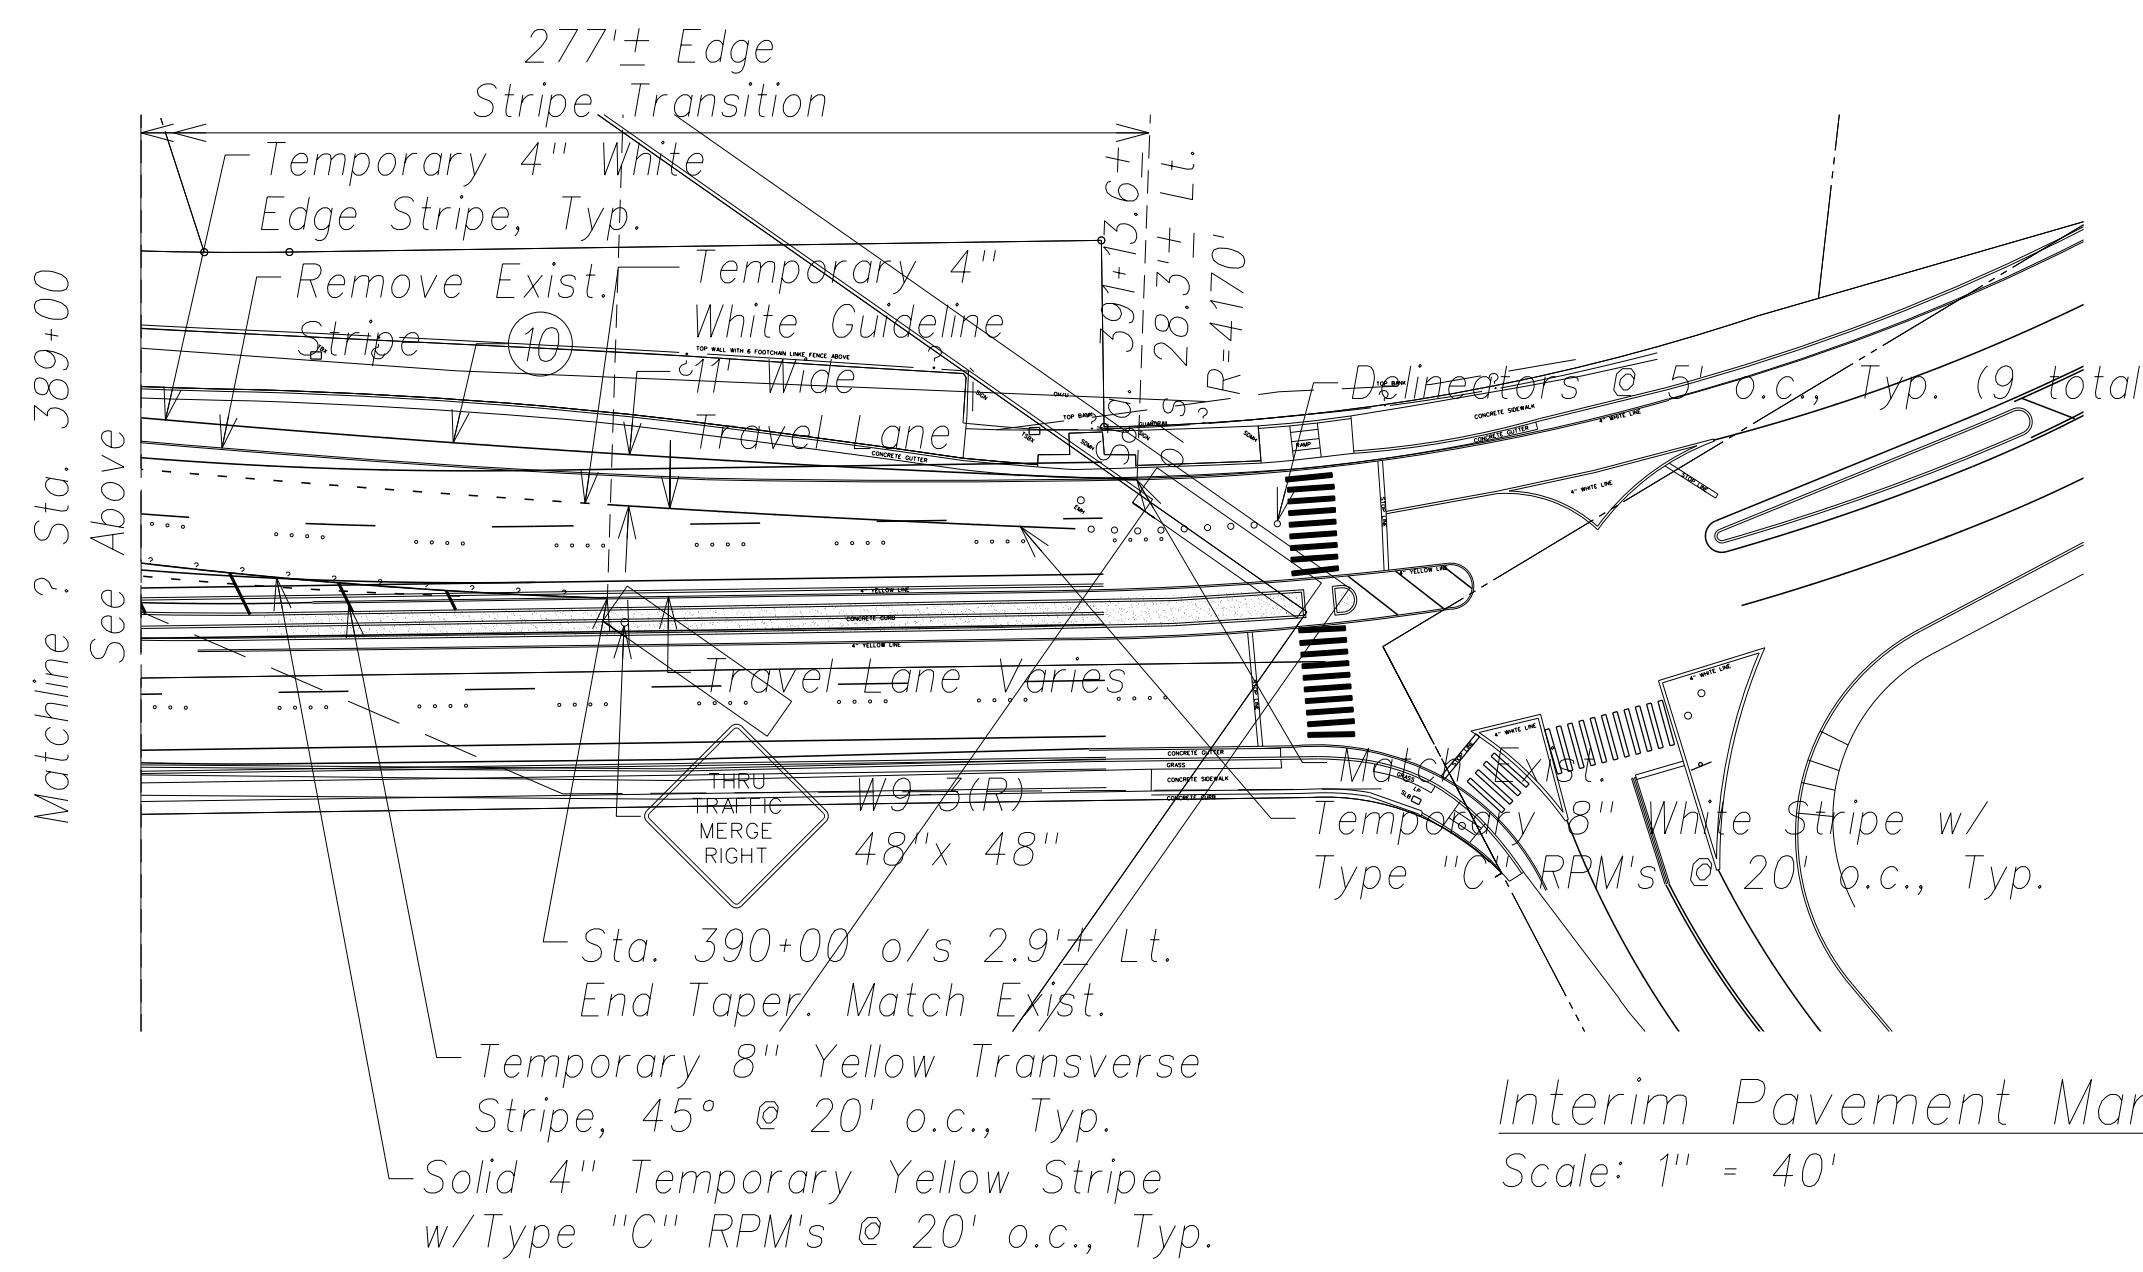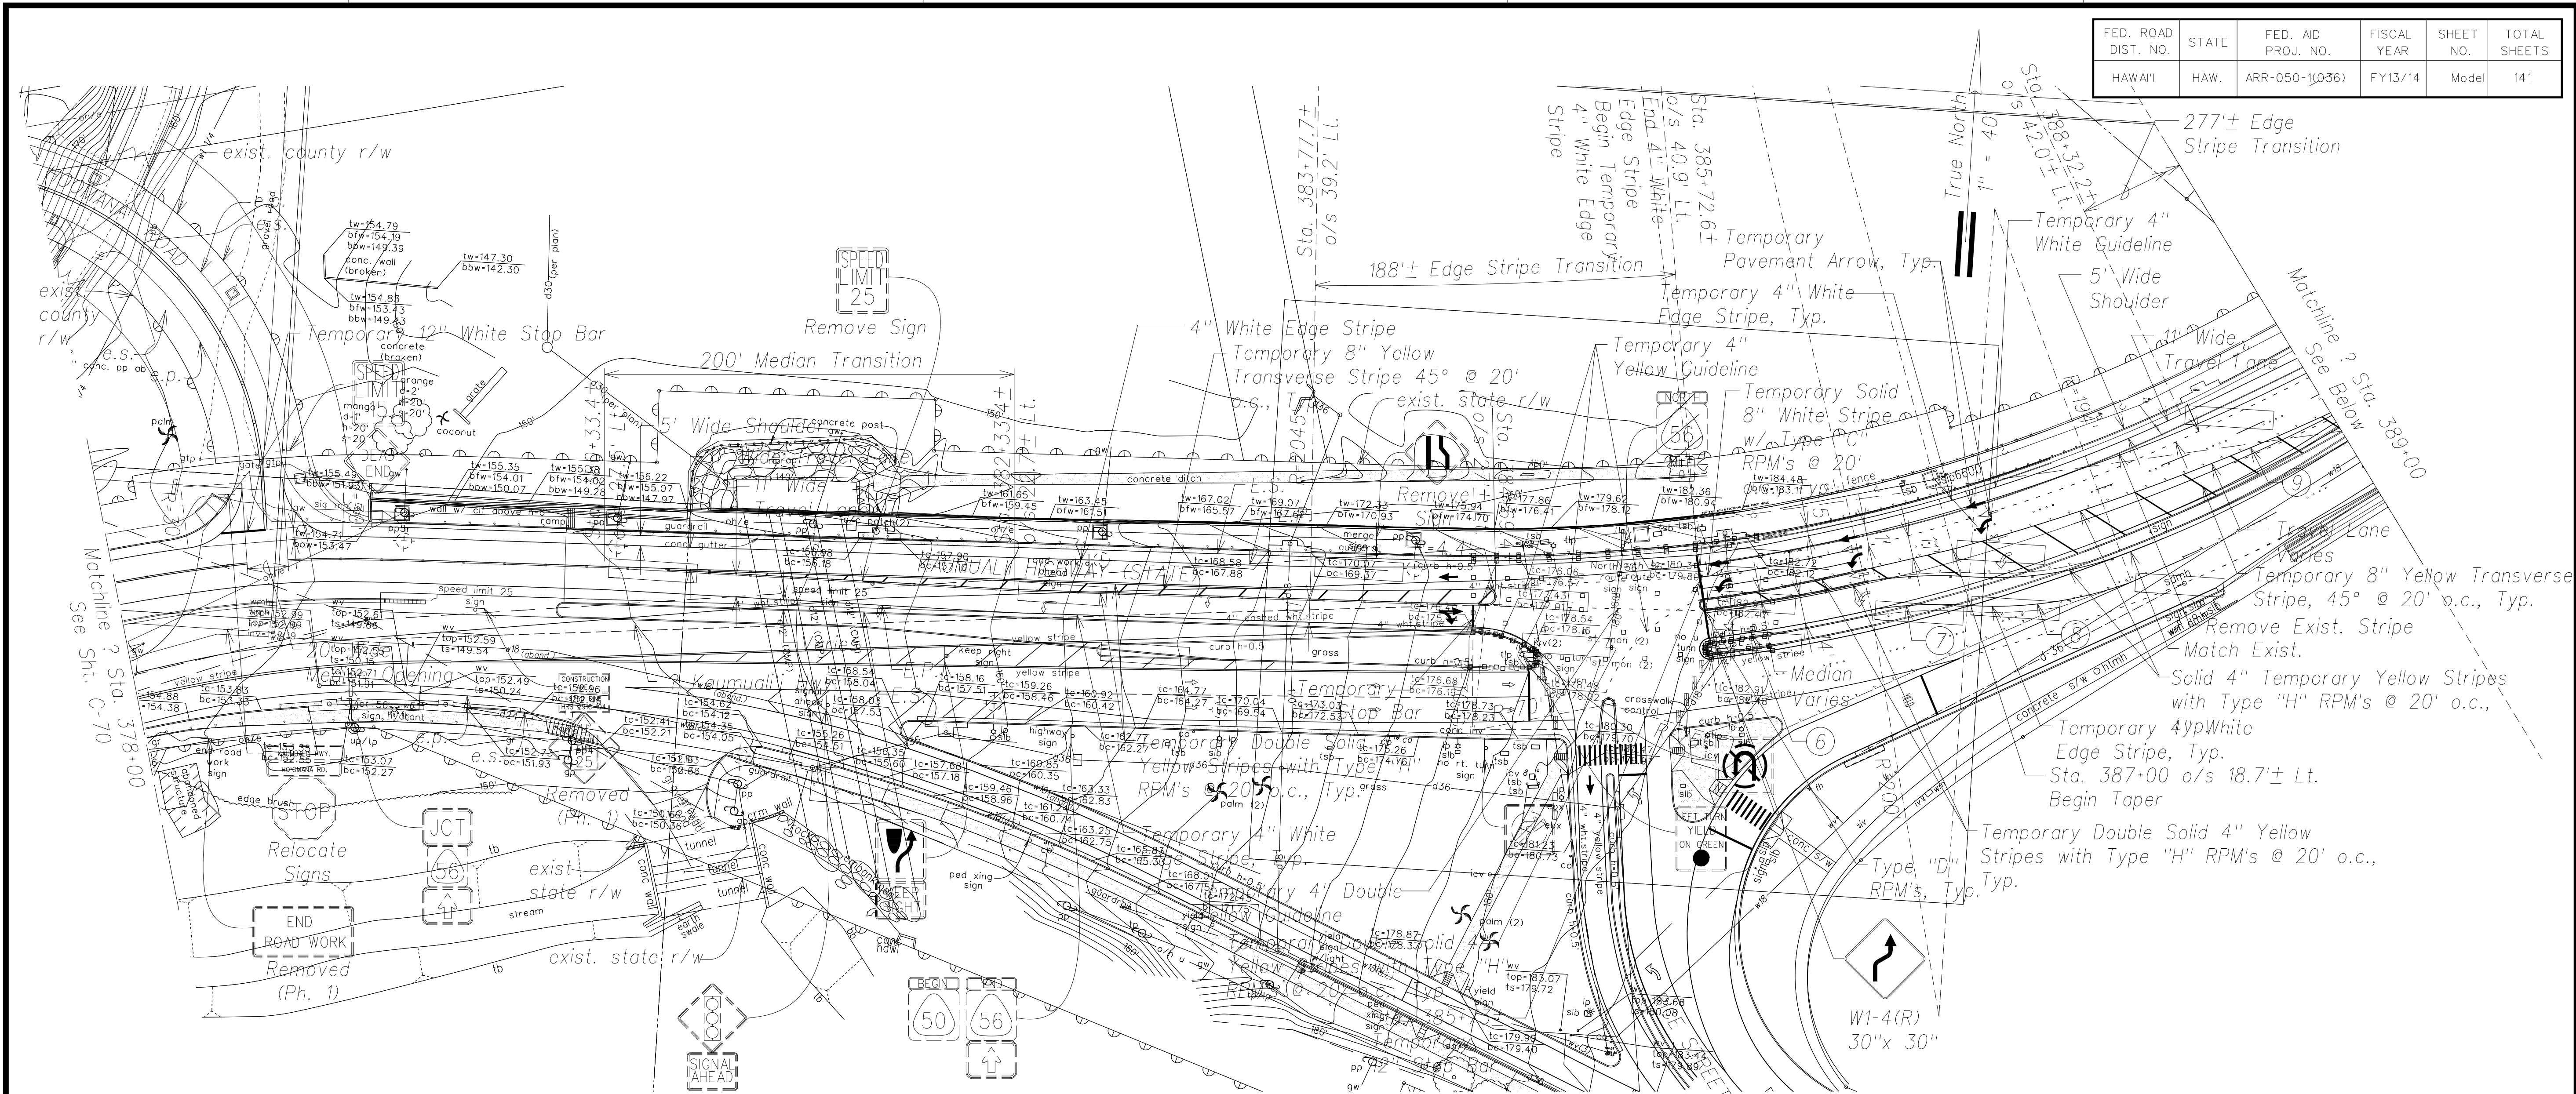


STRIPING CURVE DATA					
CURVE	6	7	8	9	10
P.C. Sta.	385+73.5±	386+53.8±	386+99.5±	387+00	388+32.2±
o/s	o/s 0.25' Rt.	o/s 0.3'± Rt.	o/s 9.6'± Rt.	o/s 18.7'± Lt.	o/s 42.0'± Lt.
P.T. Sta.	386+53.8±	386+99.5±	387+77.5±	390+00	391+13.6±
o/s	o/s 0.3'± Rt.	o/s 24.0'± Rt.	o/s 13.7'± Rt.	o/s 2.9'± Lt.	o/s 28.3'± Lt.
Δ	5°45'40"	13°24'05"	24°03'07"	14°25'28"	3°48'22"
Δ/2	2°52'50"	6°42'03"	12°01'34"	7°12'44"	1°54'11"
R	800'	201'	194'	1178'	4170'
T	40.25'	23.61'	41.33'	149.07'	138.56'
C	80.41'	46.91'	80.84'	295.78'	276.96'
Lc	80.44'	47.01'	81.44'	296.57'	277.01'

Interim Pavement Marking Plan - (Sta. 378+00 To 390+00)
Scale: 1" = 40'

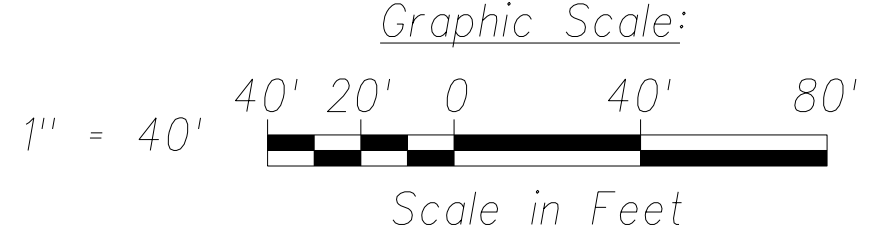

SURVEY PLOTTED BY	DATE
DRAWN BY	
DESIGNED BY	
CHECKED BY	
NOTE BOOK	
No.	

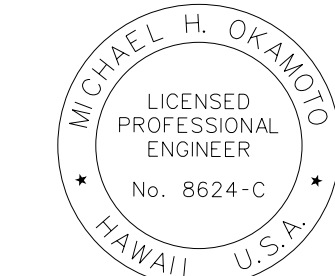

THIS WORK WAS PREPARED BY ME OR UNDER MY SUPERVISION AND CONSTRUCTION OF THIS PROJECT WILL BE UNDER MY OBSERVATION.

SIGNATURE
April 30, 2016
EXPIRATION DATE OF THE LICENSE

STATE OF HAWAII
DEPARTMENT OF TRANSPORTATION
HIGHWAYS DIVISION

INTERIM PAVEMENT MARKING PLAN

PHASE 1 - KAUMUALII HIGHWAY
LIHUE MILL BRIDGE TO RICE STREET

PHASE 3 - REHABILITATION OF LIHUE MILL BRIDGE AND MAKAI WIDENING

Scale: As Shown Date: May 2, 2014

SHEET No. C-74 OF 82 SHEETS

"AS-BUILT"

MODEL