


FED. ROAD DIST. NO.	STATE	FED. AID PROJ. NO.	FISCAL YEAR	SHEET NO.	TOTAL SHEETS
HAWAII	HAW.	ARR-050-1(036)	FY13/14	Model	141

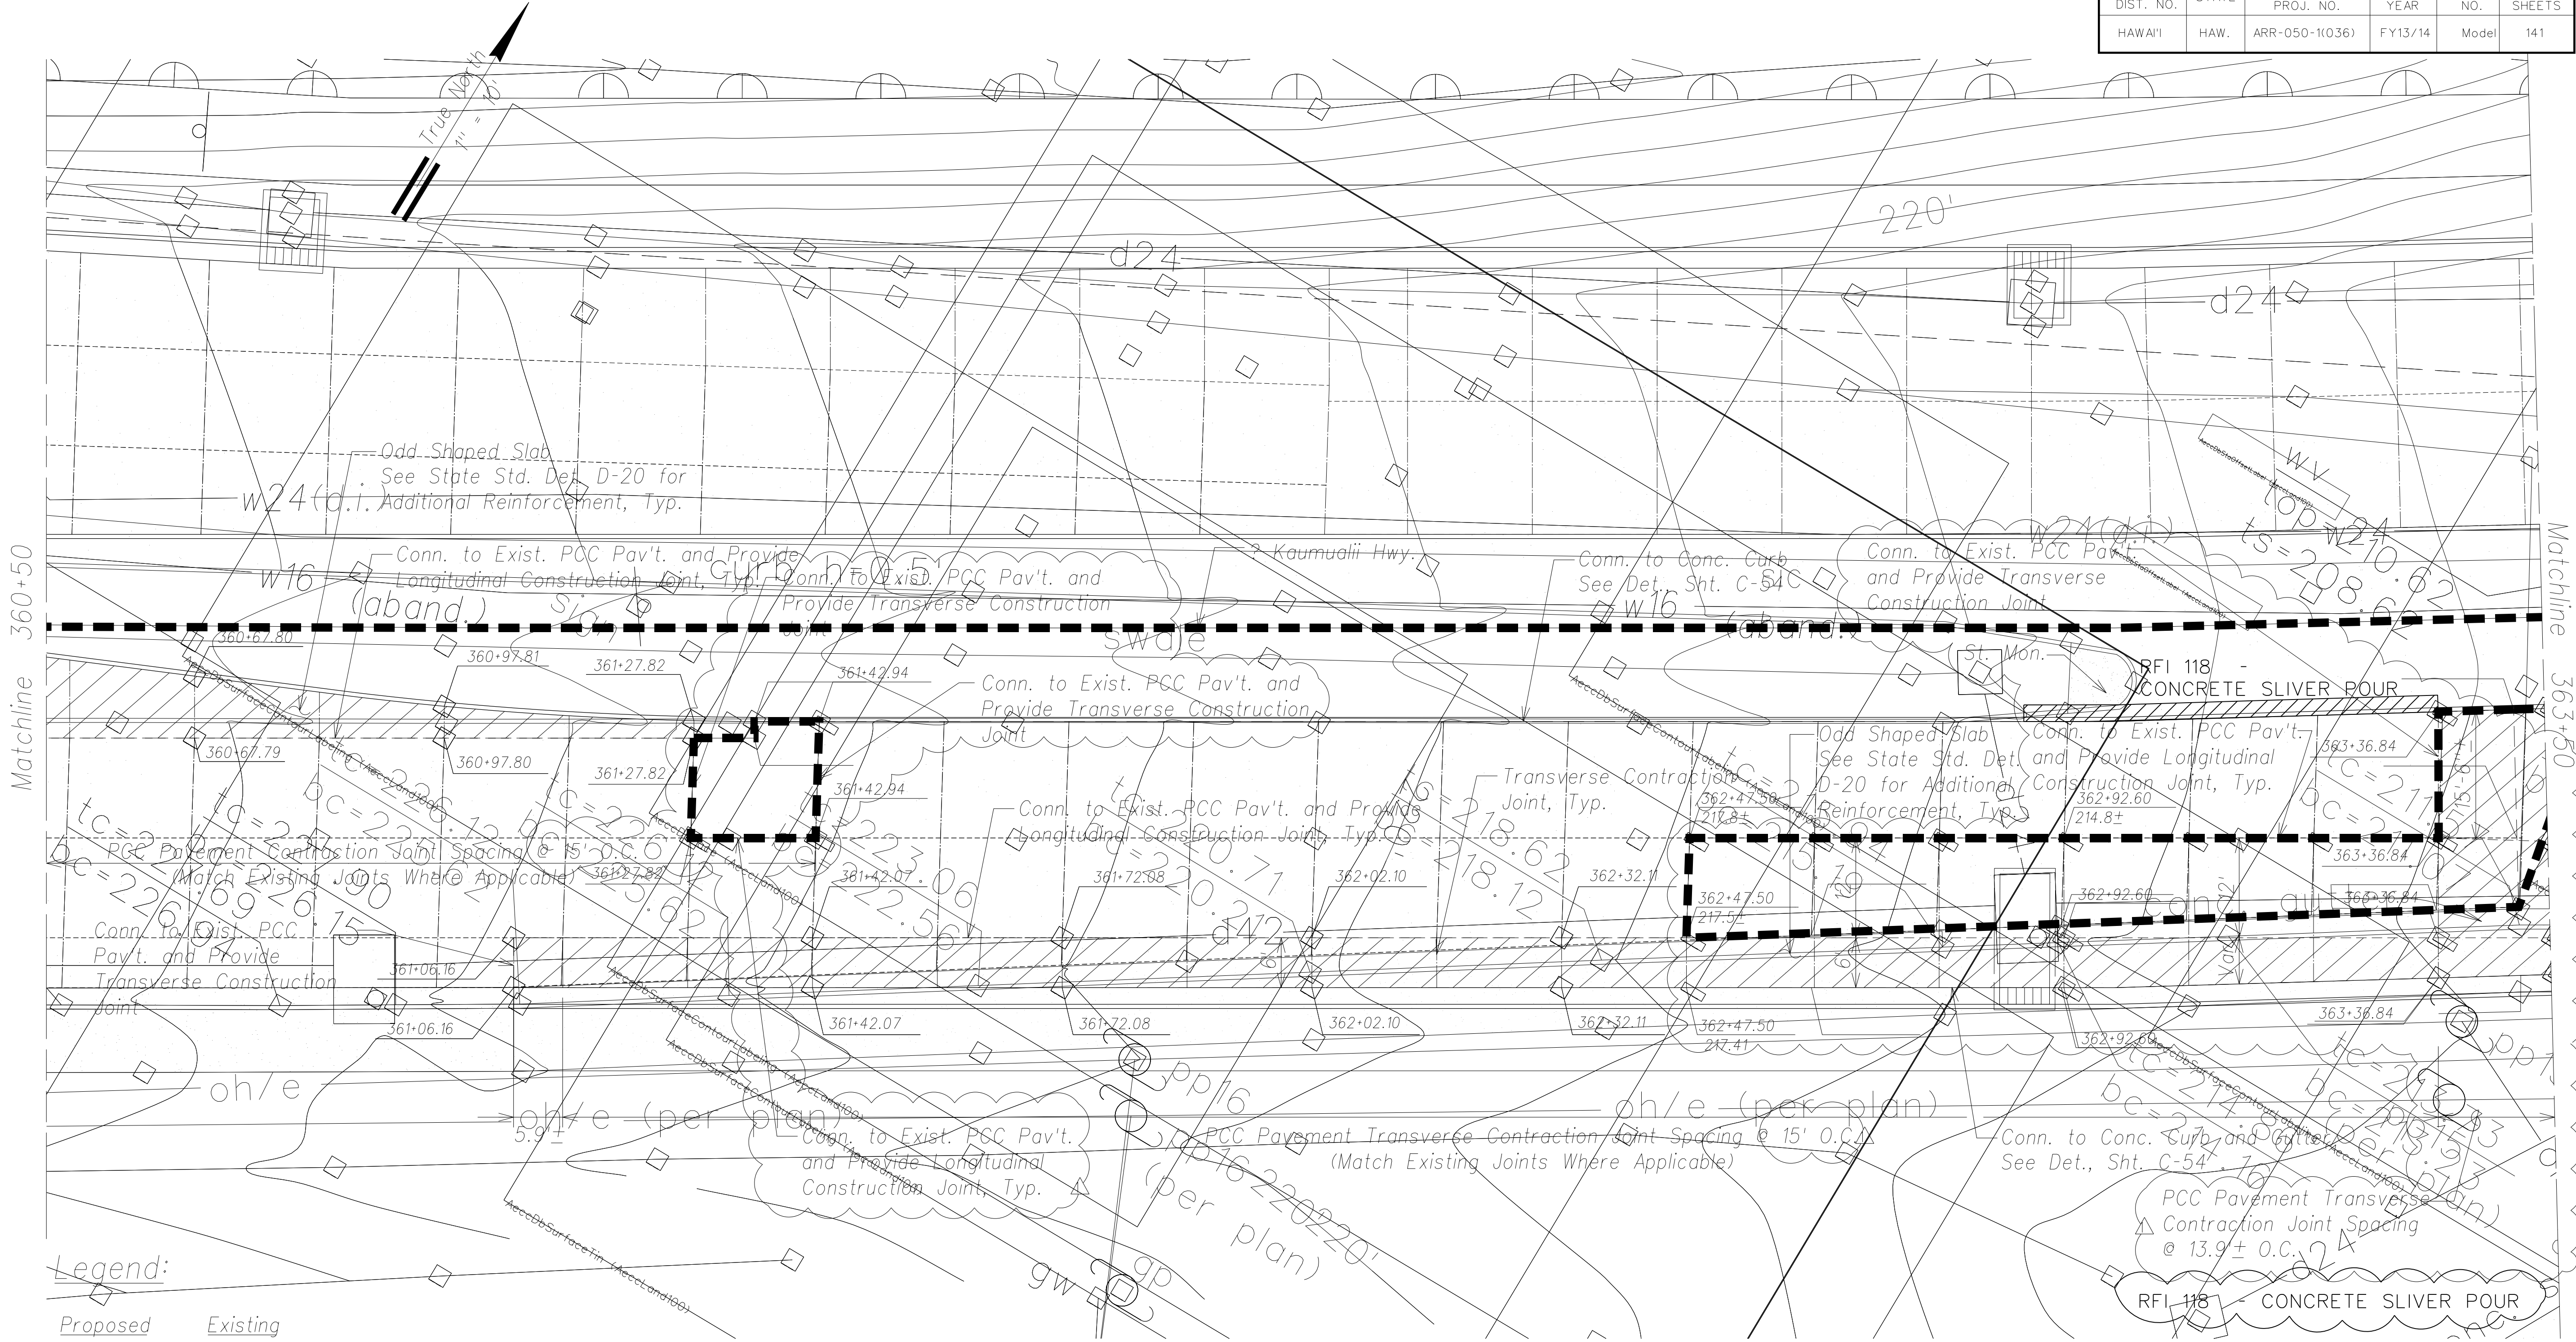


Legend:

- | | |
|--|----------|
| Proposed | Existing |
| —200'— | —200'— |
| Contour Line | |
| Typical Transverse Joint | |
| Typical Longitudinal Joint | |
| Odd Shaped Slabs | |
| ? Sta. of Finished Pavement Spot Elevation | |
| Finished Pavement Spot Elevation | |

Paving Plan (Sta. 360+50 to Sta. 363+50)
Scale: 1" = 10'

LEGEND FOR AS-BUILT POSTINGS

Squiggly line for as-built deletion
Double line for as-built deletion
Text for as-built posting

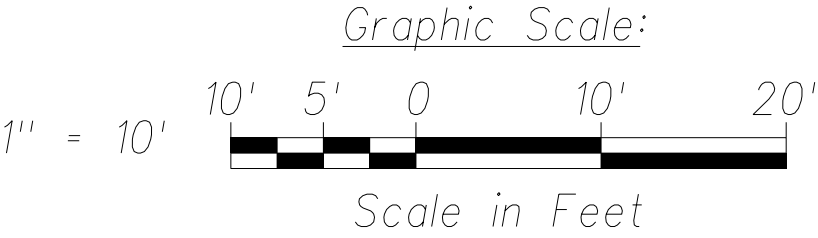

THIS WORK WAS PREPARED BY ME OR UNDER MY SUPERVISION AND CONSTRUCTION OF THIS PROJECT WILL BE UNDER MY OBSERVATION.

APRIL 30, 2016
EXPIRATION DATE OF THE LICENSE

4/6/15
Date
Revision
Revise jointing. Add st. mon.

STATE OF HAWAII
DEPARTMENT OF TRANSPORTATION
HIGHWAYS DIVISION

PAVING PLAN

PHASE 1 - KAUMUALII HIGHWAY
LIHUE MILL BRIDGE TO RICE STREET

PHASE 3 - REHABILITATION OF LIHUE MILL
BRIDGE AND MAKAI WIDENING

Scale: As Shown Date: May 2, 2014


SHEET No. C-33 OF 82 SHEETS

SURVEY PLOTTED BY	DATE
DRAWN BY	
DESIGNED BY	
CHECKED BY	
ORIGINAL PLAN	
NOTE BOOK	
No.	

AS-BUILT

MODEL S1

FED. ROAD DIST. NO.	STATE	FED. AID PROJ. NO.	FISCAL YEAR	SHEET NO.	TOTAL SHEETS
HAWAII	HAW.	ARR-050-1(036)	FY13/14	Model	141

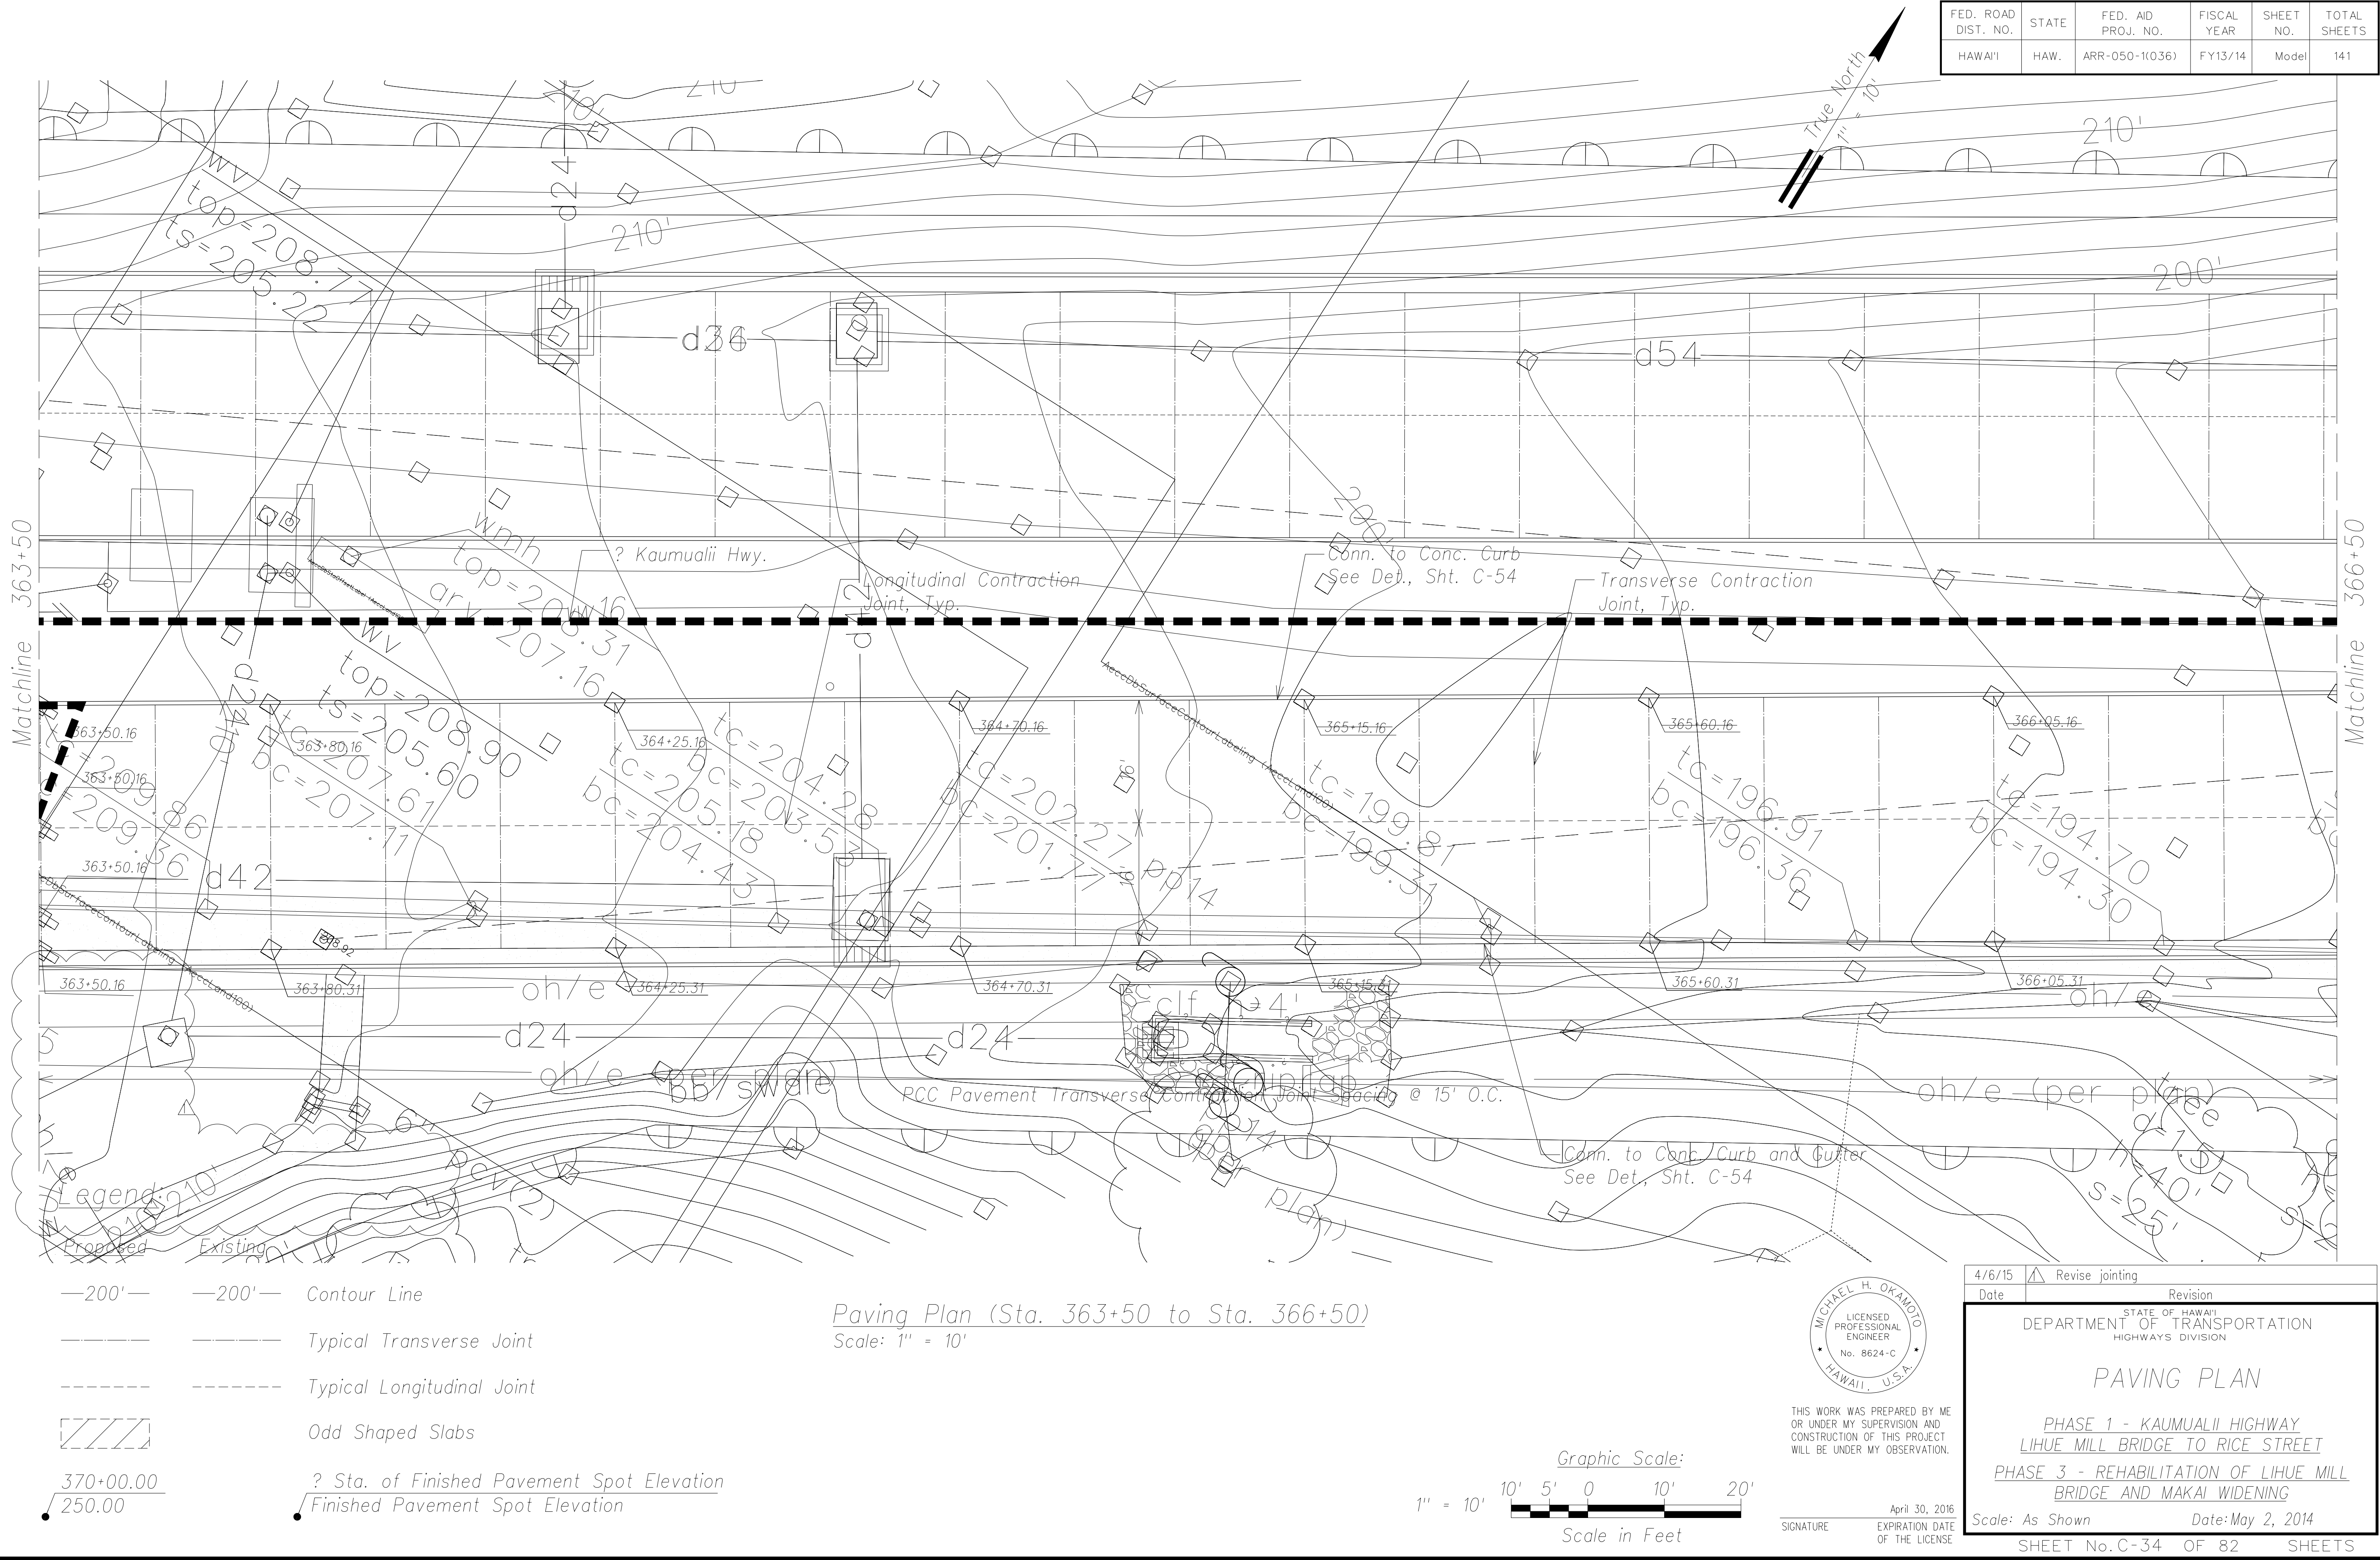


"AS-BUILT"


CMODEL S1

FILE: C:\Users\Nisaa\Desktop\Drawing\ang saved April 7, 2016

ORIGINAL PLAN	SURVEY PLOTTED BY _____	DATE _____
	DESIGNED BY _____	DATE _____
	QUANTITIES BY _____	DATE _____
	CHECKED BY _____	DATE _____
NOTE BOOK	No. _____	

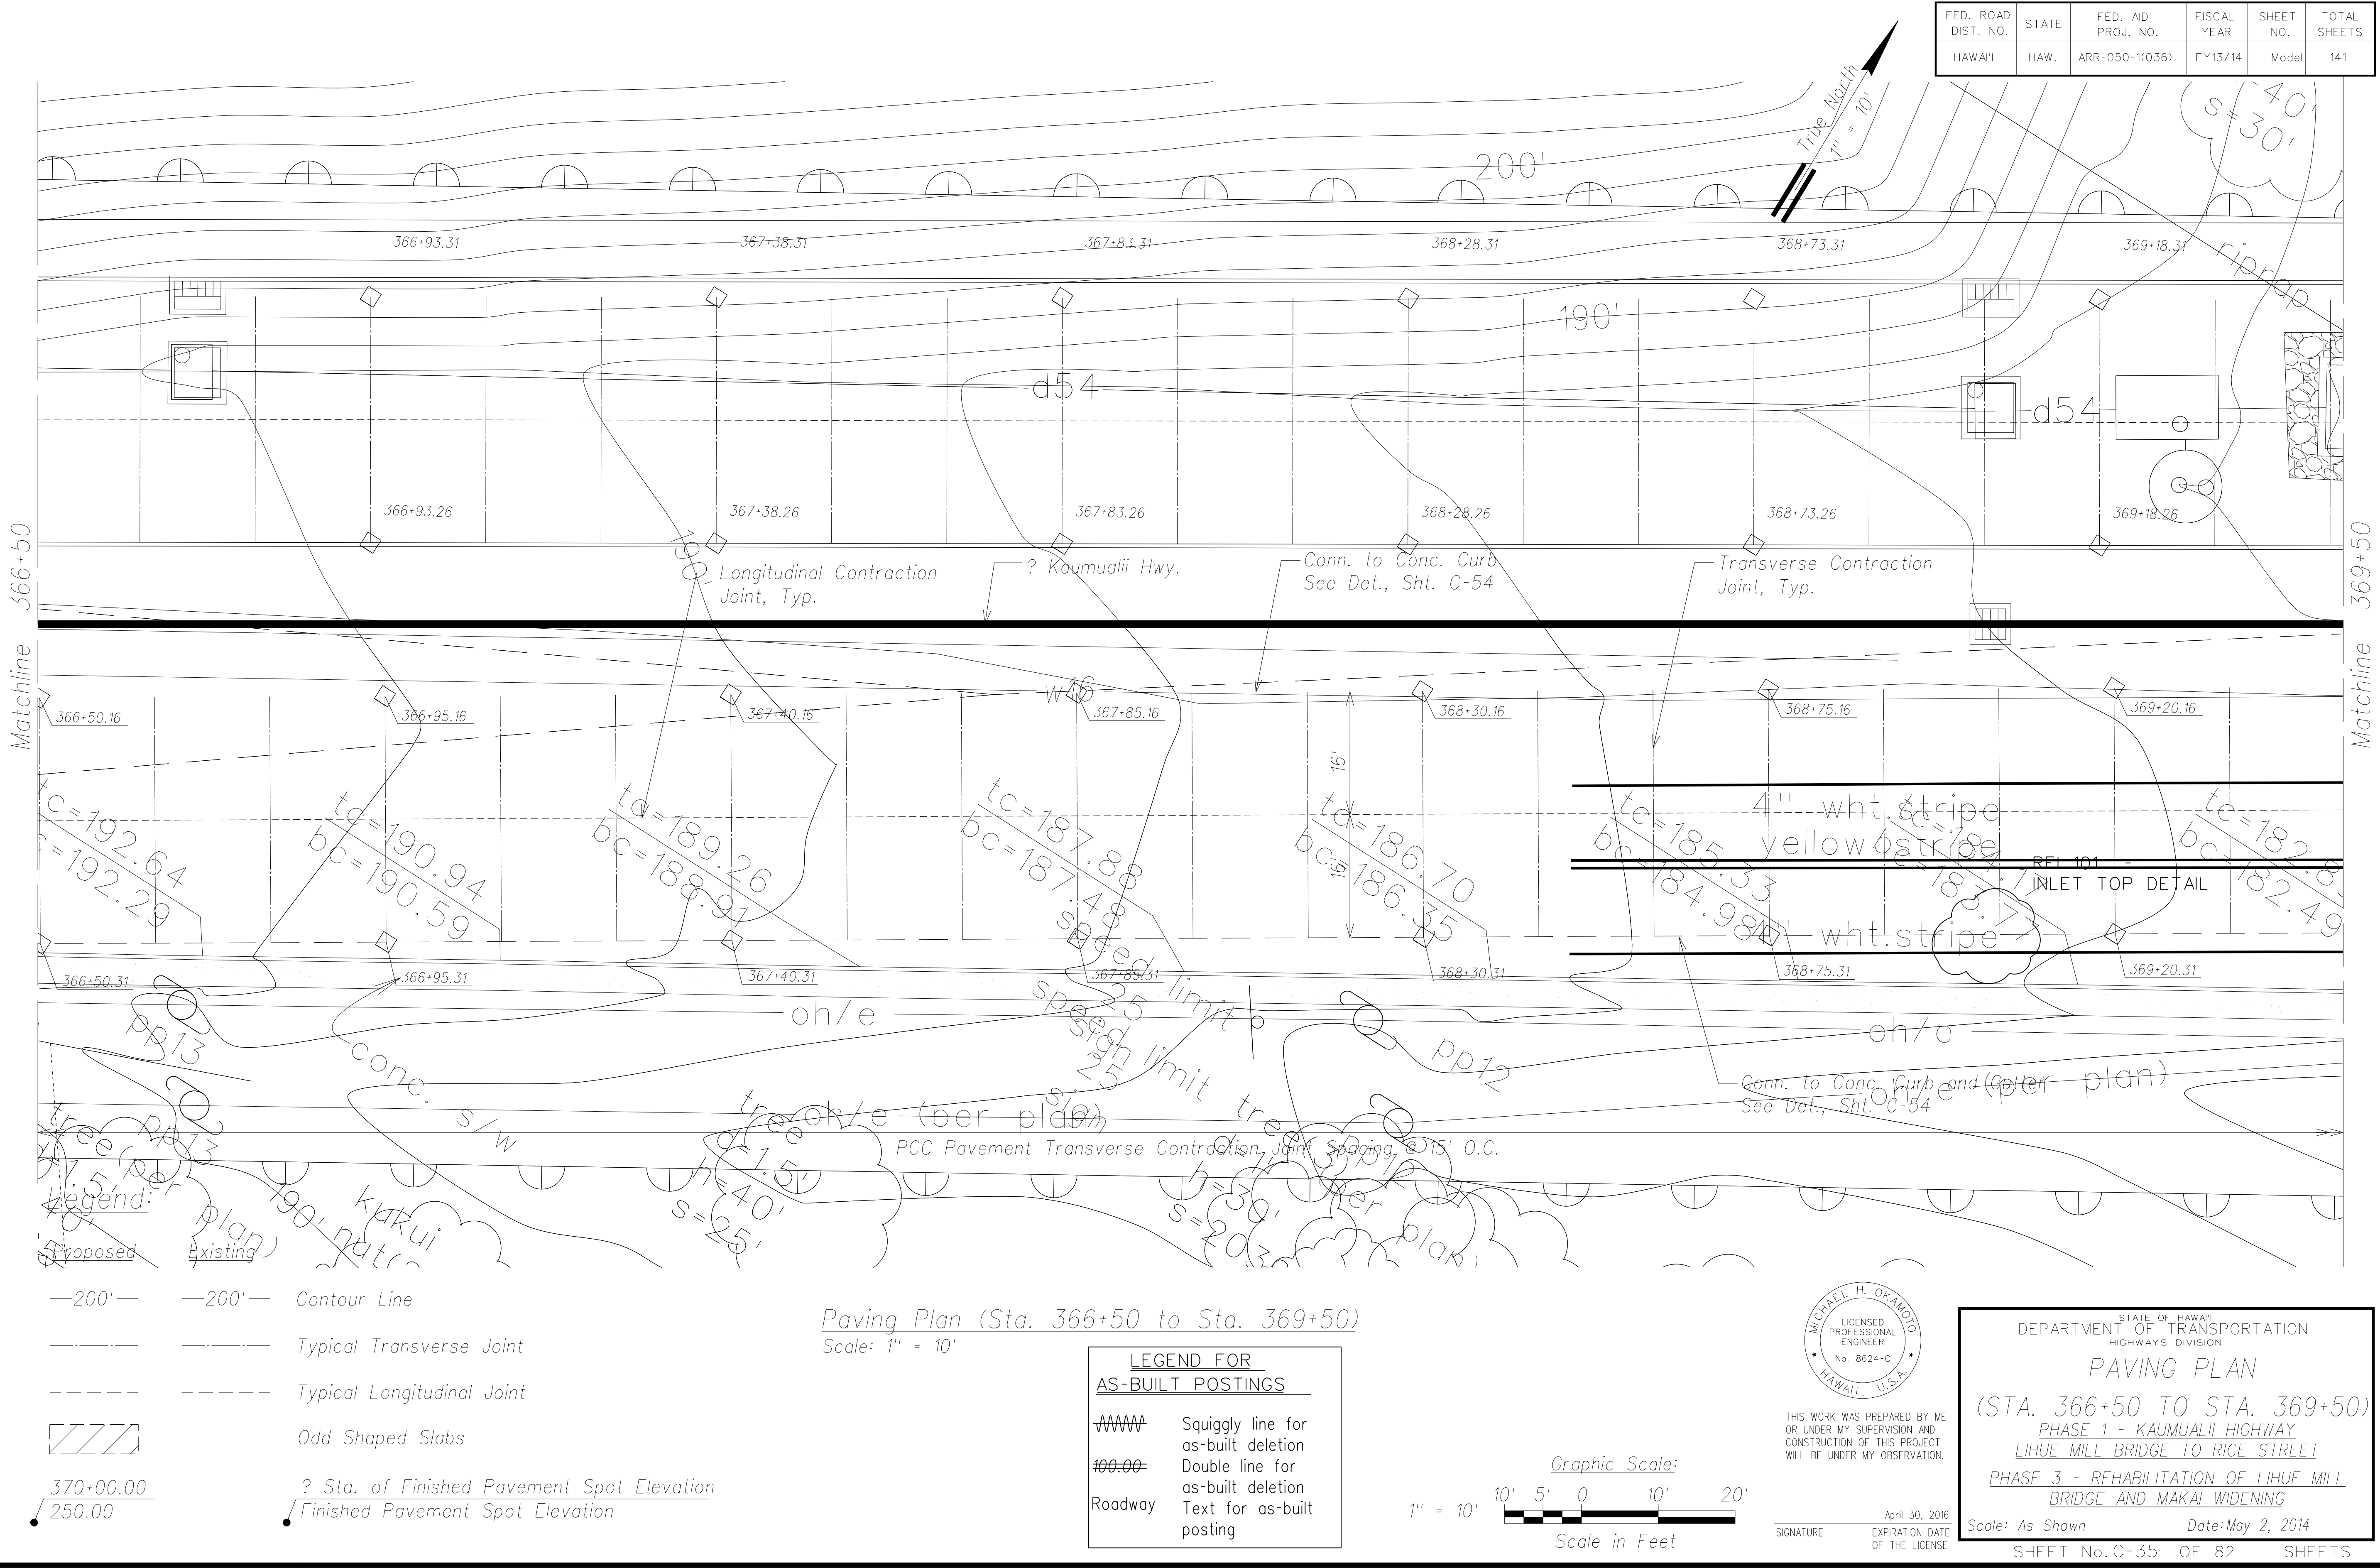

FED. ROAD DIST. NO.	STATE	FED. AID PROJ. NO.	FISCAL YEAR	SHEET NO.	TOTAL SHEETS
HAWAII	HAW.	ARR-050-1(Q36)	FY13/14	Model	141

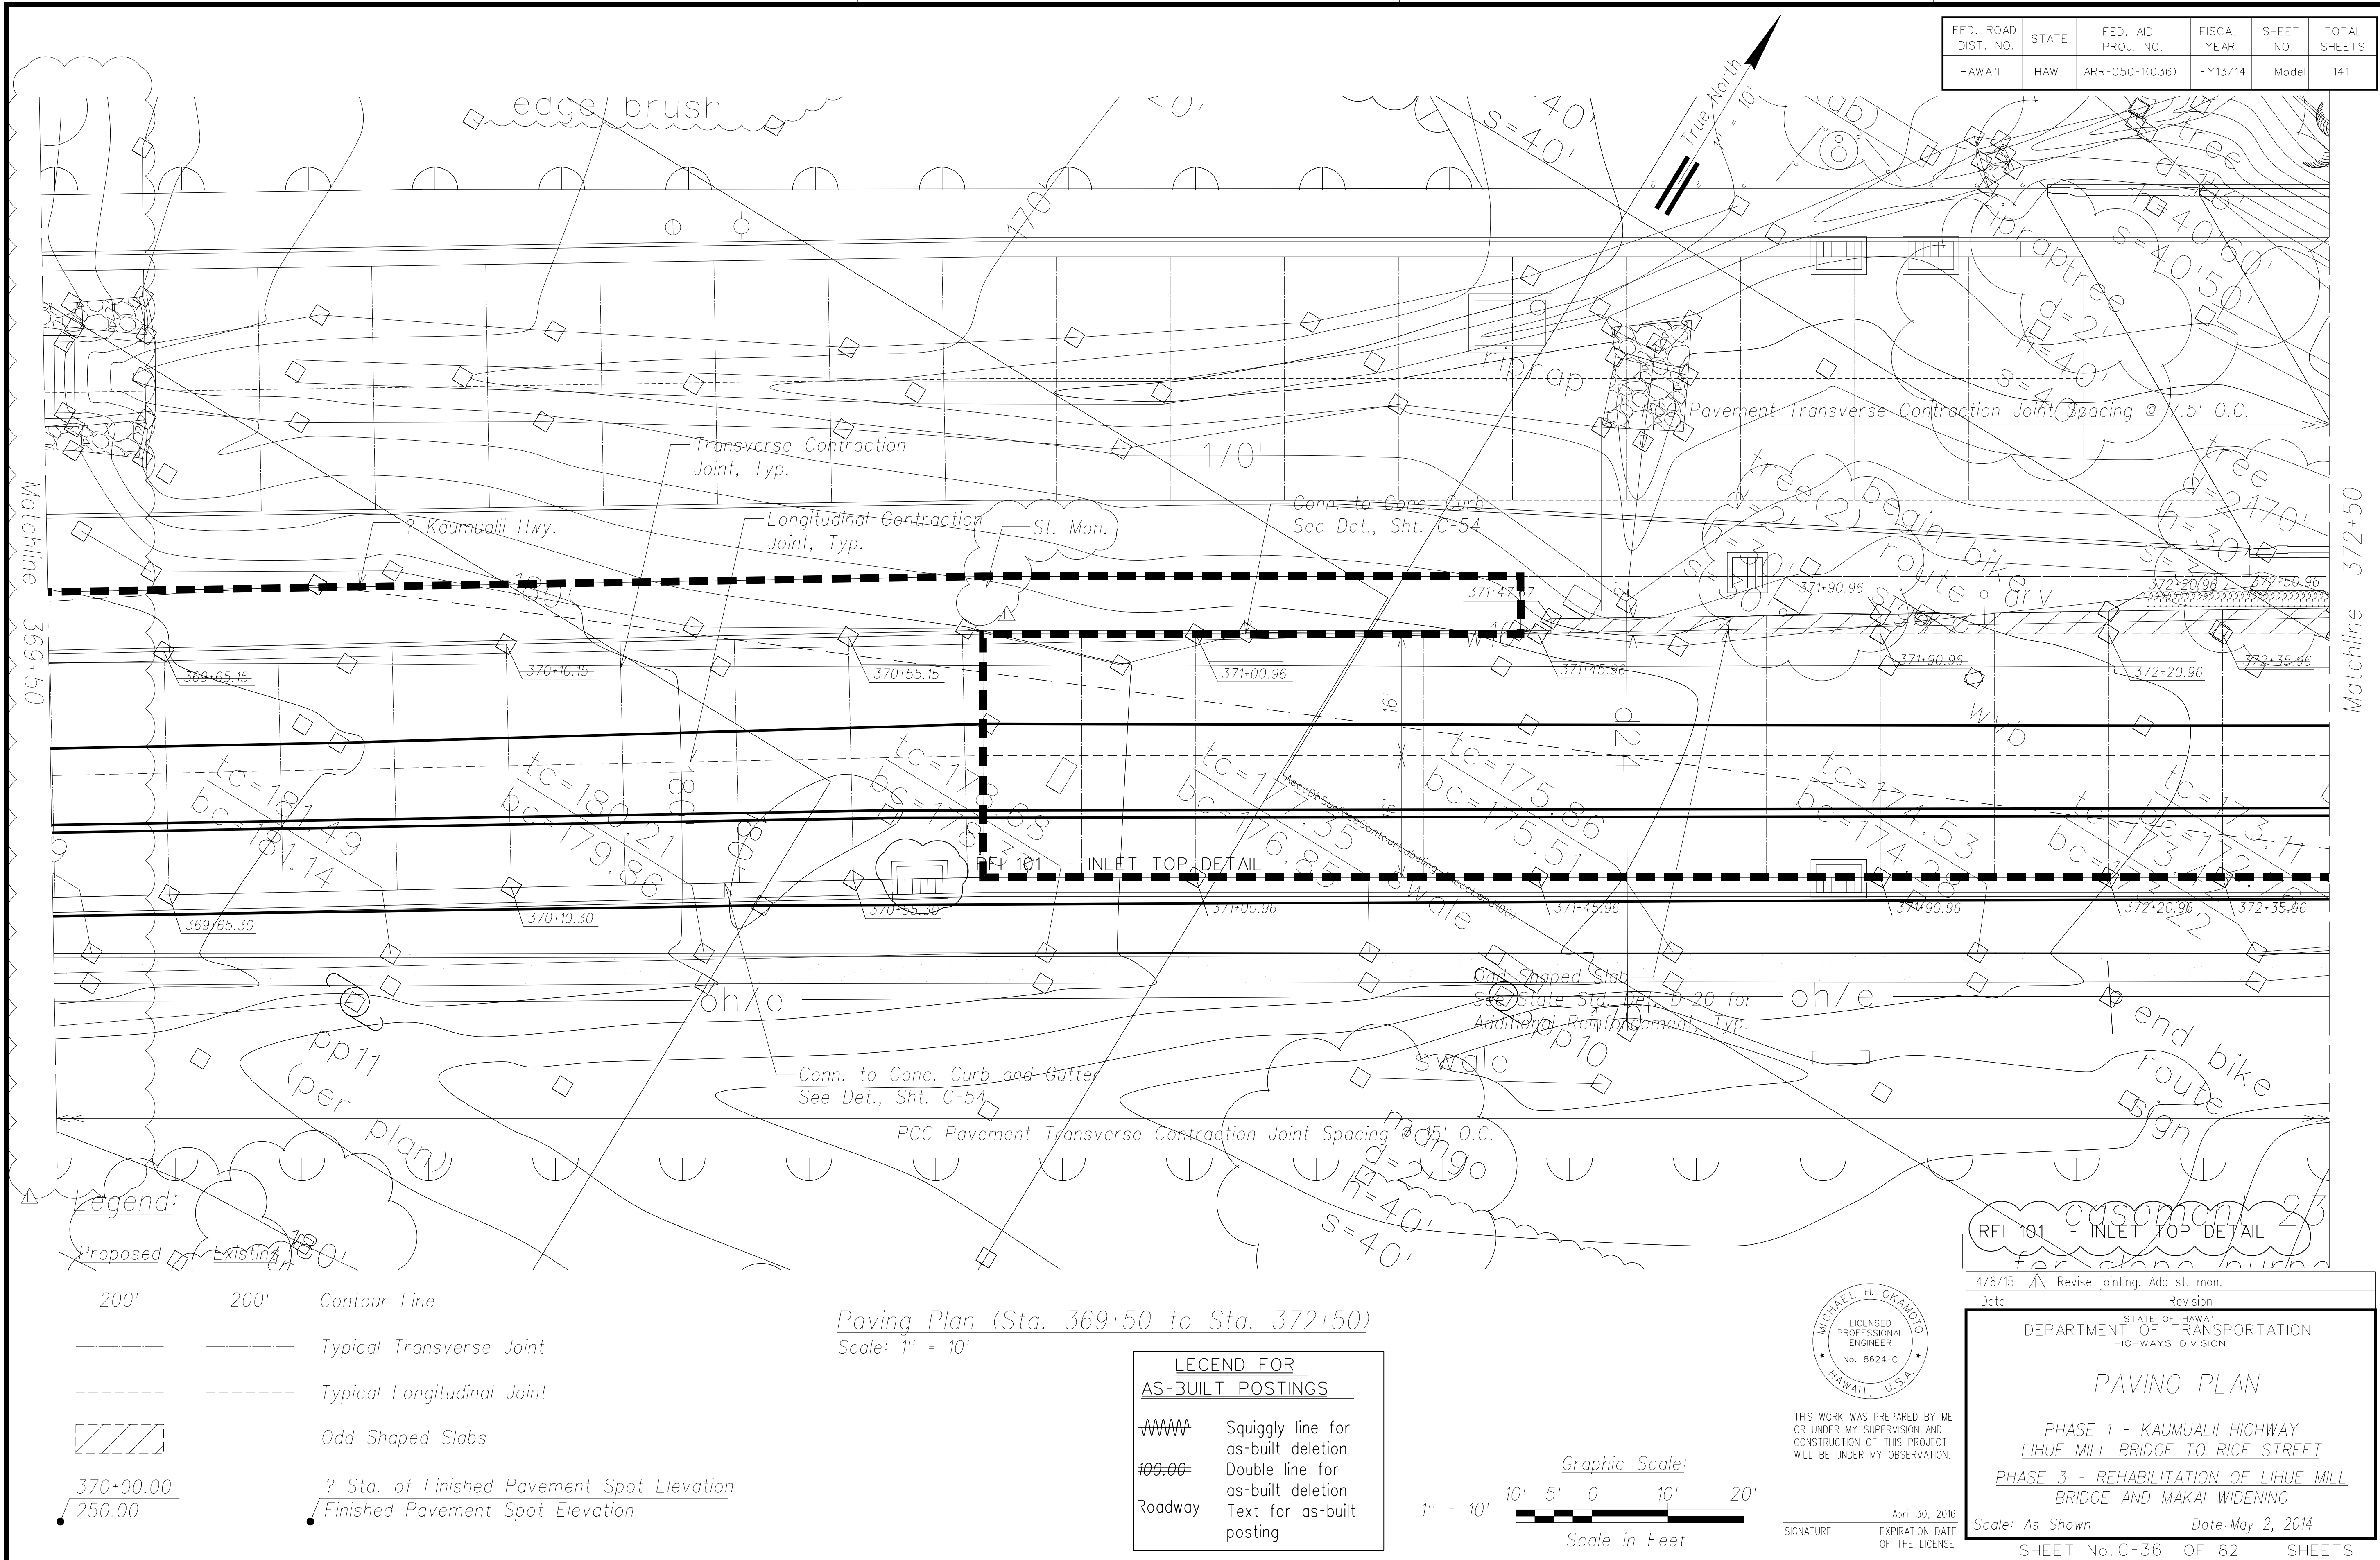

ORIGINAL PLAN	SURVEY PLOTTED BY _____		DATE _____
	DRAWN BY _____		“ _____
	TRACED BY _____		“ _____
	DESIGNED BY _____		“ _____
NOTE BOOK	QUANTITIES BY _____		“ _____
	CHECKED BY _____		“ _____
No. _____			


Legend:

- Proposed
- Existing
- 200' Contour Line
- Typical Transverse Joint
- Typical Longitudinal Joint
- Odd Shaped Slabs
- 370+00.00
- 250.00
- ? Sta. of Finished Pavement Spot Elevation
- Finished Pavement Spot Elevation

Paving Plan (Sta. 369+50 to Sta. 372+50)
Scale: 1" = 10'

LEGEND FOR AS-BUILT POSTINGS

- Squiggly line for as-built deletion
- Double line for as-built deletion
- Roadway Text for as-built posting

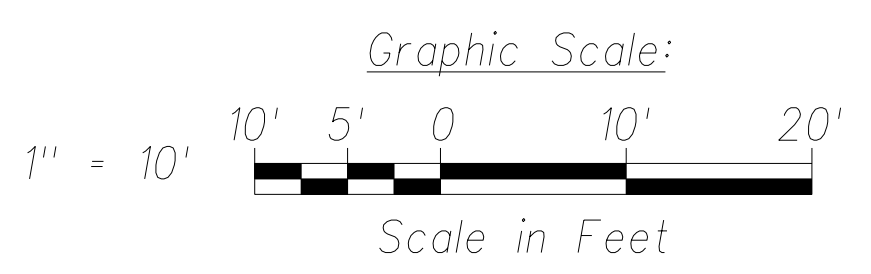

MICHAEL H. OKAMOTO
LICENSED PROFESSIONAL ENGINEER
No. 8624-C
HAWAII, U.S.A.

THIS WORK WAS PREPARED BY ME OR UNDER MY SUPERVISION AND CONSTRUCTION OF THIS PROJECT WILL BE UNDER MY OBSERVATION.

Signature: _____
Date: April 30, 2016
EXPIRATION DATE OF THE LICENSE

RFI 101 - INLET TOP DETAIL

4/6/15

Date Revision

DEPARTMENT OF TRANSPORTATION
HIGHWAYS DIVISION

PAVING PLAN

PHASE 1 - KAUMUALII HIGHWAY
LIHUE MILL BRIDGE TO RICE STREET

PHASE 3 - REHABILITATION OF LIHUE MILL
BRIDGE AND MAKAI WIDENING

Scale: As Shown Date: May 2, 2014

SHEET No. C-36 OF 82 SHEETS

Legend:
 Proposed —200'— Existing —200'— Contour Line
 Typical Transverse Joint
 Typical Longitudinal Joint
 Odd Shaped Slabs
 ? Sta. of Finished Pavement Spot Elevation
 Finished Pavement Spot Elevation

LEGEND FOR AS-BUILT POSTINGS
 Squiggly line for as-built deletion
 Double line for as-built deletion
 Text for as-built posting

Note:
 See sheet S1.4 for remainder of Lihue Mill Bridge Deck spot elevations.


Graphic Scale:
 1" = 10'
 Scale in Feet

MICHAEL H. OKAMOTO
 LICENSED PROFESSIONAL ENGINEER
 No. 8624-C
 HAWAII, U.S.A.
 THIS WORK WAS PREPARED BY ME OR UNDER MY SUPERVISION AND CONSTRUCTION OF THIS PROJECT WILL BE UNDER MY OBSERVATION.
 EXPIRATION DATE OF THE LICENSE: April 30, 2016
 SIGNATURE: _____

NCR NO. 30 - GDI B-5 CRACK RFI-101-INLET TOP DETAIL
 DEPARTMENT OF TRANSPORTATION HIGHWAYS DIVISION
 PAVING PLAN (STA. 372+50 TO STA. 375+25)
 PHASE 1 - KAUMUALII HIGHWAY LIHUE MILL BRIDGE TO RICE STREET
 PHASE 3 - REHABILITATION OF LIHUE MILL BRIDGE AND MAKAI WIDENING
 Scale: As Shown Date: May 2, 2014
 SHEET No. C-37 OF 82 SHEETS

MODEL

FED. ROAD DIST. NO.	STATE	FED. AID PROJ. NO.	FISCAL YEAR	SHEET NO.	TOTAL SHEETS
HAWAII	HAW.	ARR-050-1(036)	FY13/14	Model	141

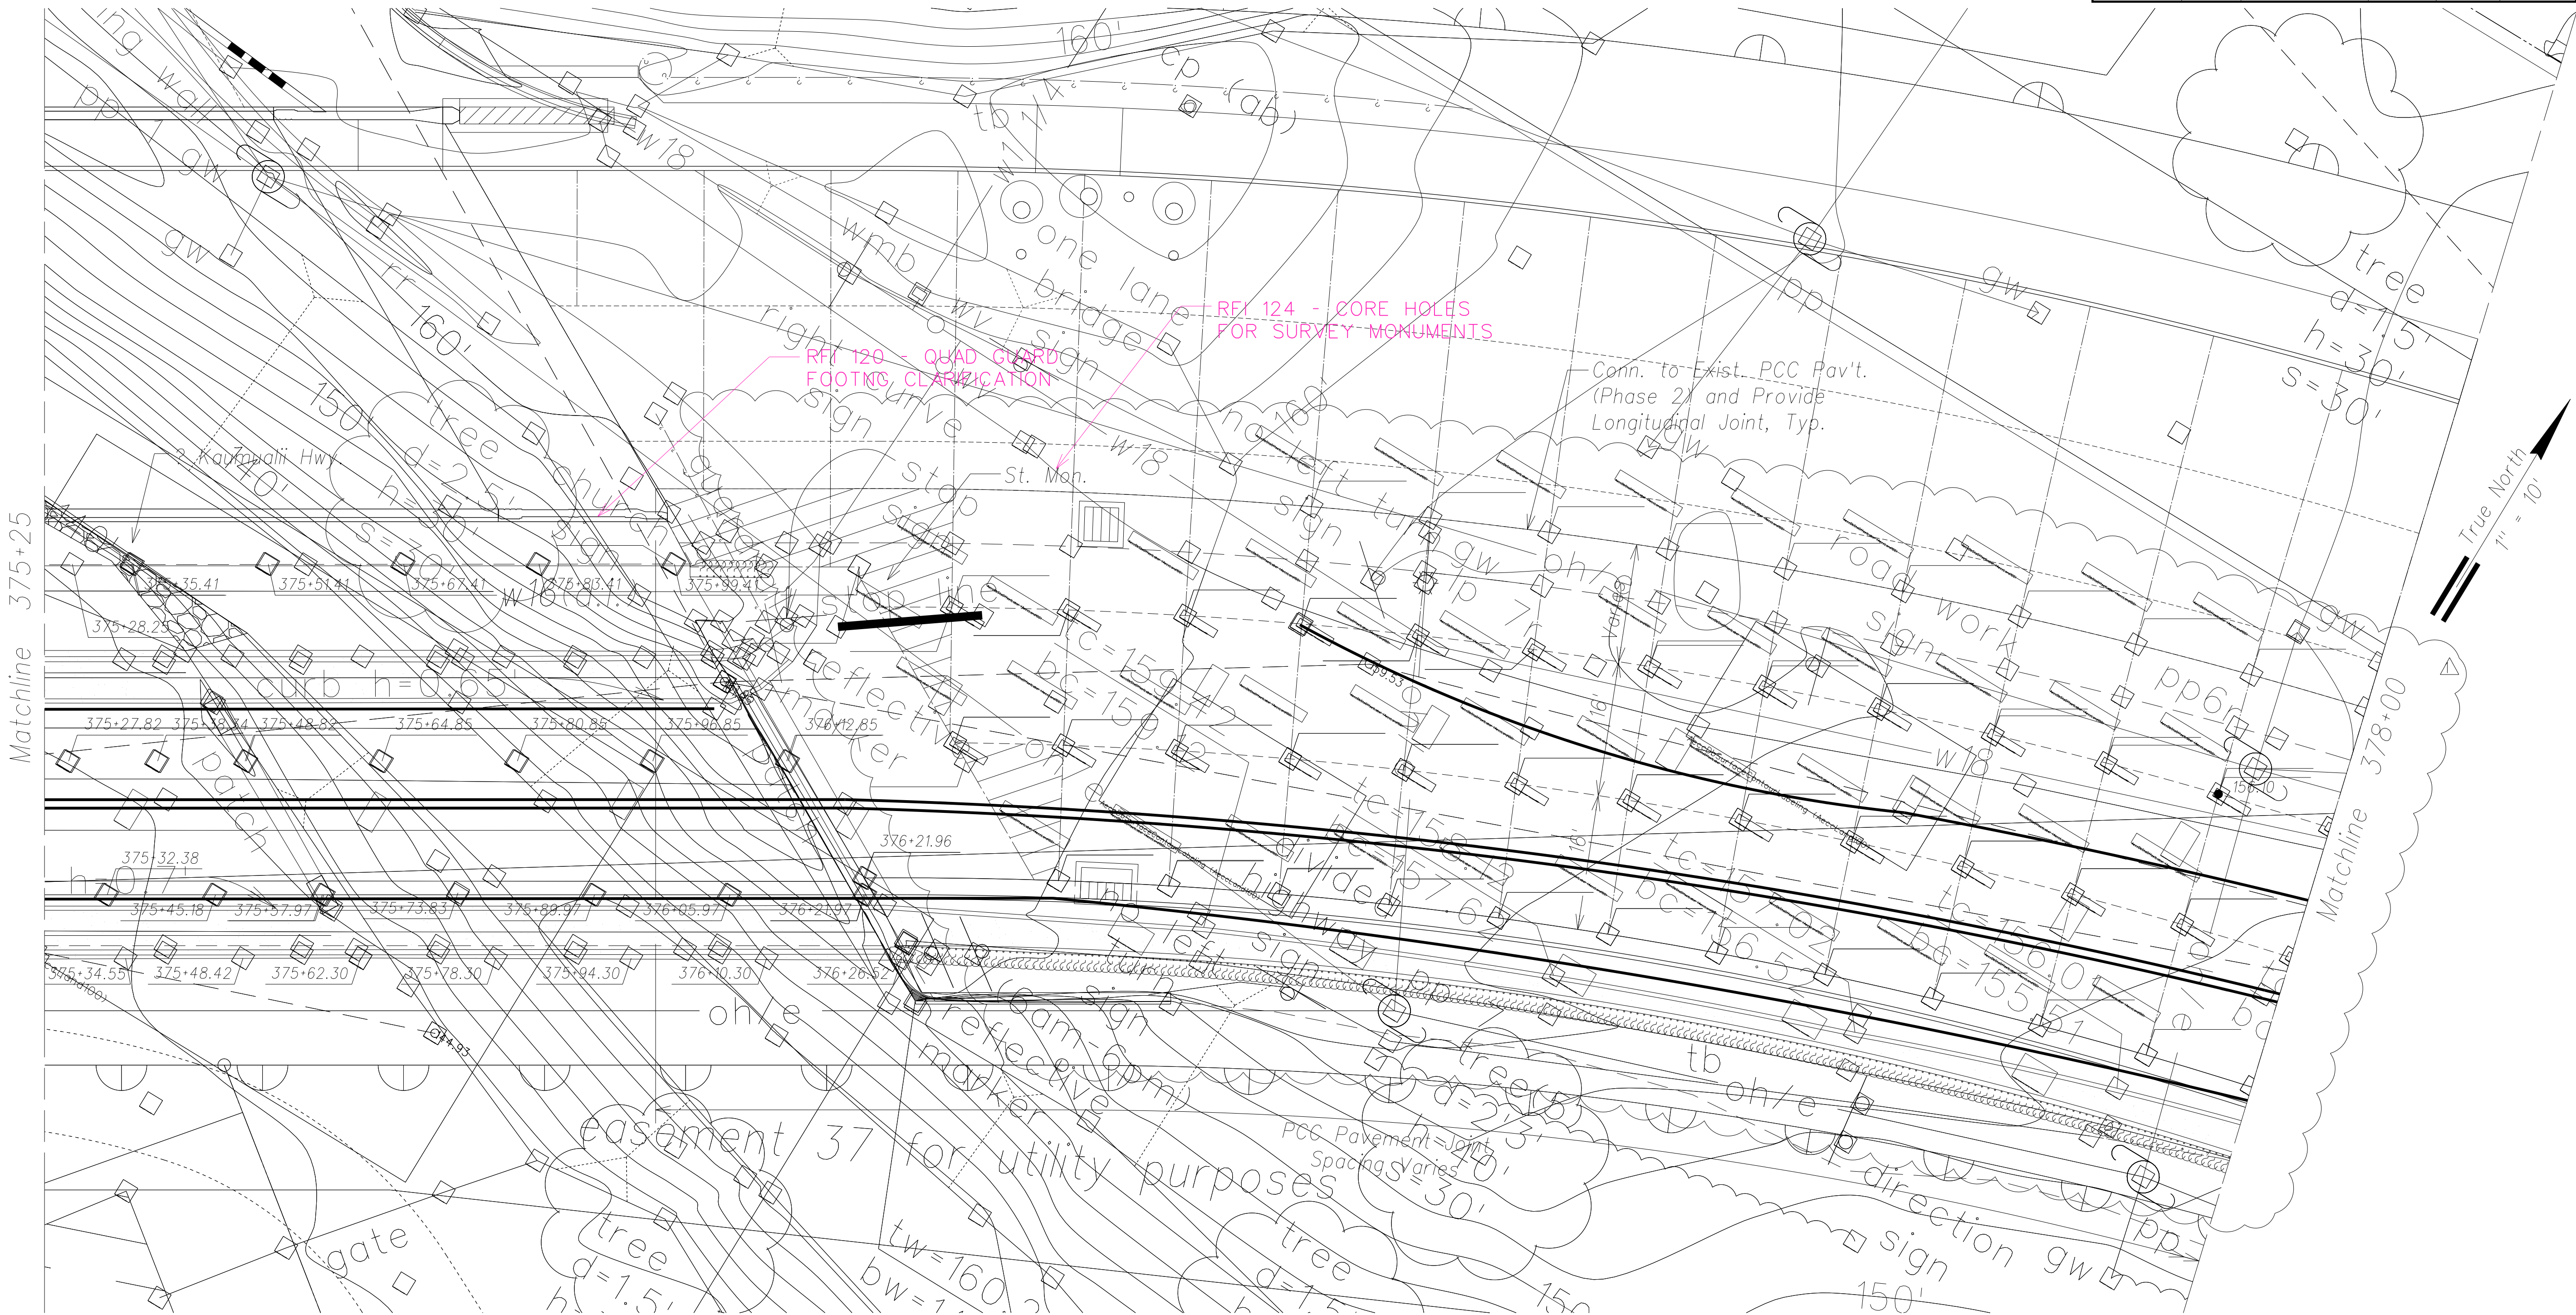

Legend:



- Proposed Existing
- Typical Transverse Joint
- Typical Longitudinal Joint
- Odd Shaped Slabs

LEGEND FOR AS-BUILT POSTINGS

- Squiggly line for as-built deletion
- Double line for as-built deletion
- Text for as-built posting

Paving Plan
Scale: 1" = 10'

- RFI 124 - CORE HOLES FOR SURVEY MONUMENTS
- RFI 121 - GDI TOP DETAILS
- RFI 120 - QUAD GUARD FG
- RFI 101 - INLET TOP DETAIL

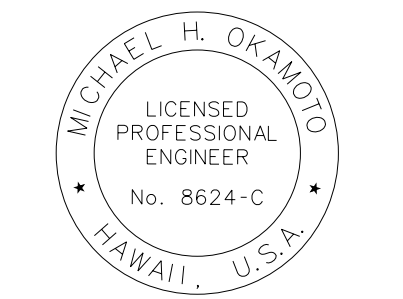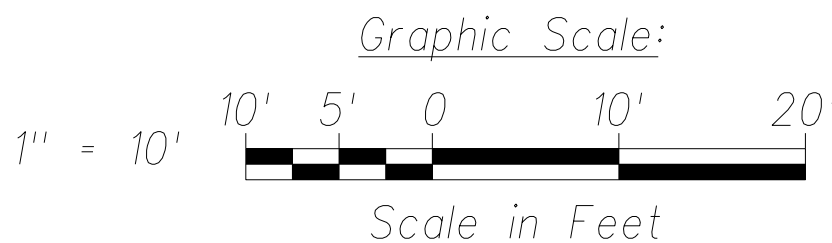

THIS WORK WAS PREPARED BY ME OR UNDER MY SUPERVISION AND CONSTRUCTION OF THIS PROJECT WILL BE UNDER MY OBSERVATION.

SIGNATURE
EXPIRATION DATE OF THE LICENSE


4/6/15
Date
Rev. for add'l PCC pav't and sidewalk. Add st. mon.
Revision
STATE OF HAWAII
DEPARTMENT OF TRANSPORTATION
HIGHWAYS DIVISION
PAVING PLAN
PHASE 1 - KAUMUALII HIGHWAY
LIHUE MILL BRIDGE TO RICE STREET
PHASE 3 - REHABILITATION OF LIHUE MILL BRIDGE AND MAKAI WIDENING
Scale: As Shown
Date: May 2, 2014
SHEET No. C-38 OF 82 SHEETS

ORIGINAL PLAN	SURVEY PLOTTED BY	DATE
	DRAWN BY	
	DESIGNED BY	
	CHECKED BY	
NOTE BOOK	No.	

"AS-BUILT"

MODEL S1


FED. ROAD DIST. NO.	STATE	FED. AID PROJ. NO.	FISCAL YEAR	SHEET NO.	TOTAL SHEETS
HAWAII	HAW.	ARR-050-1(036)	FY13/14	Model	141

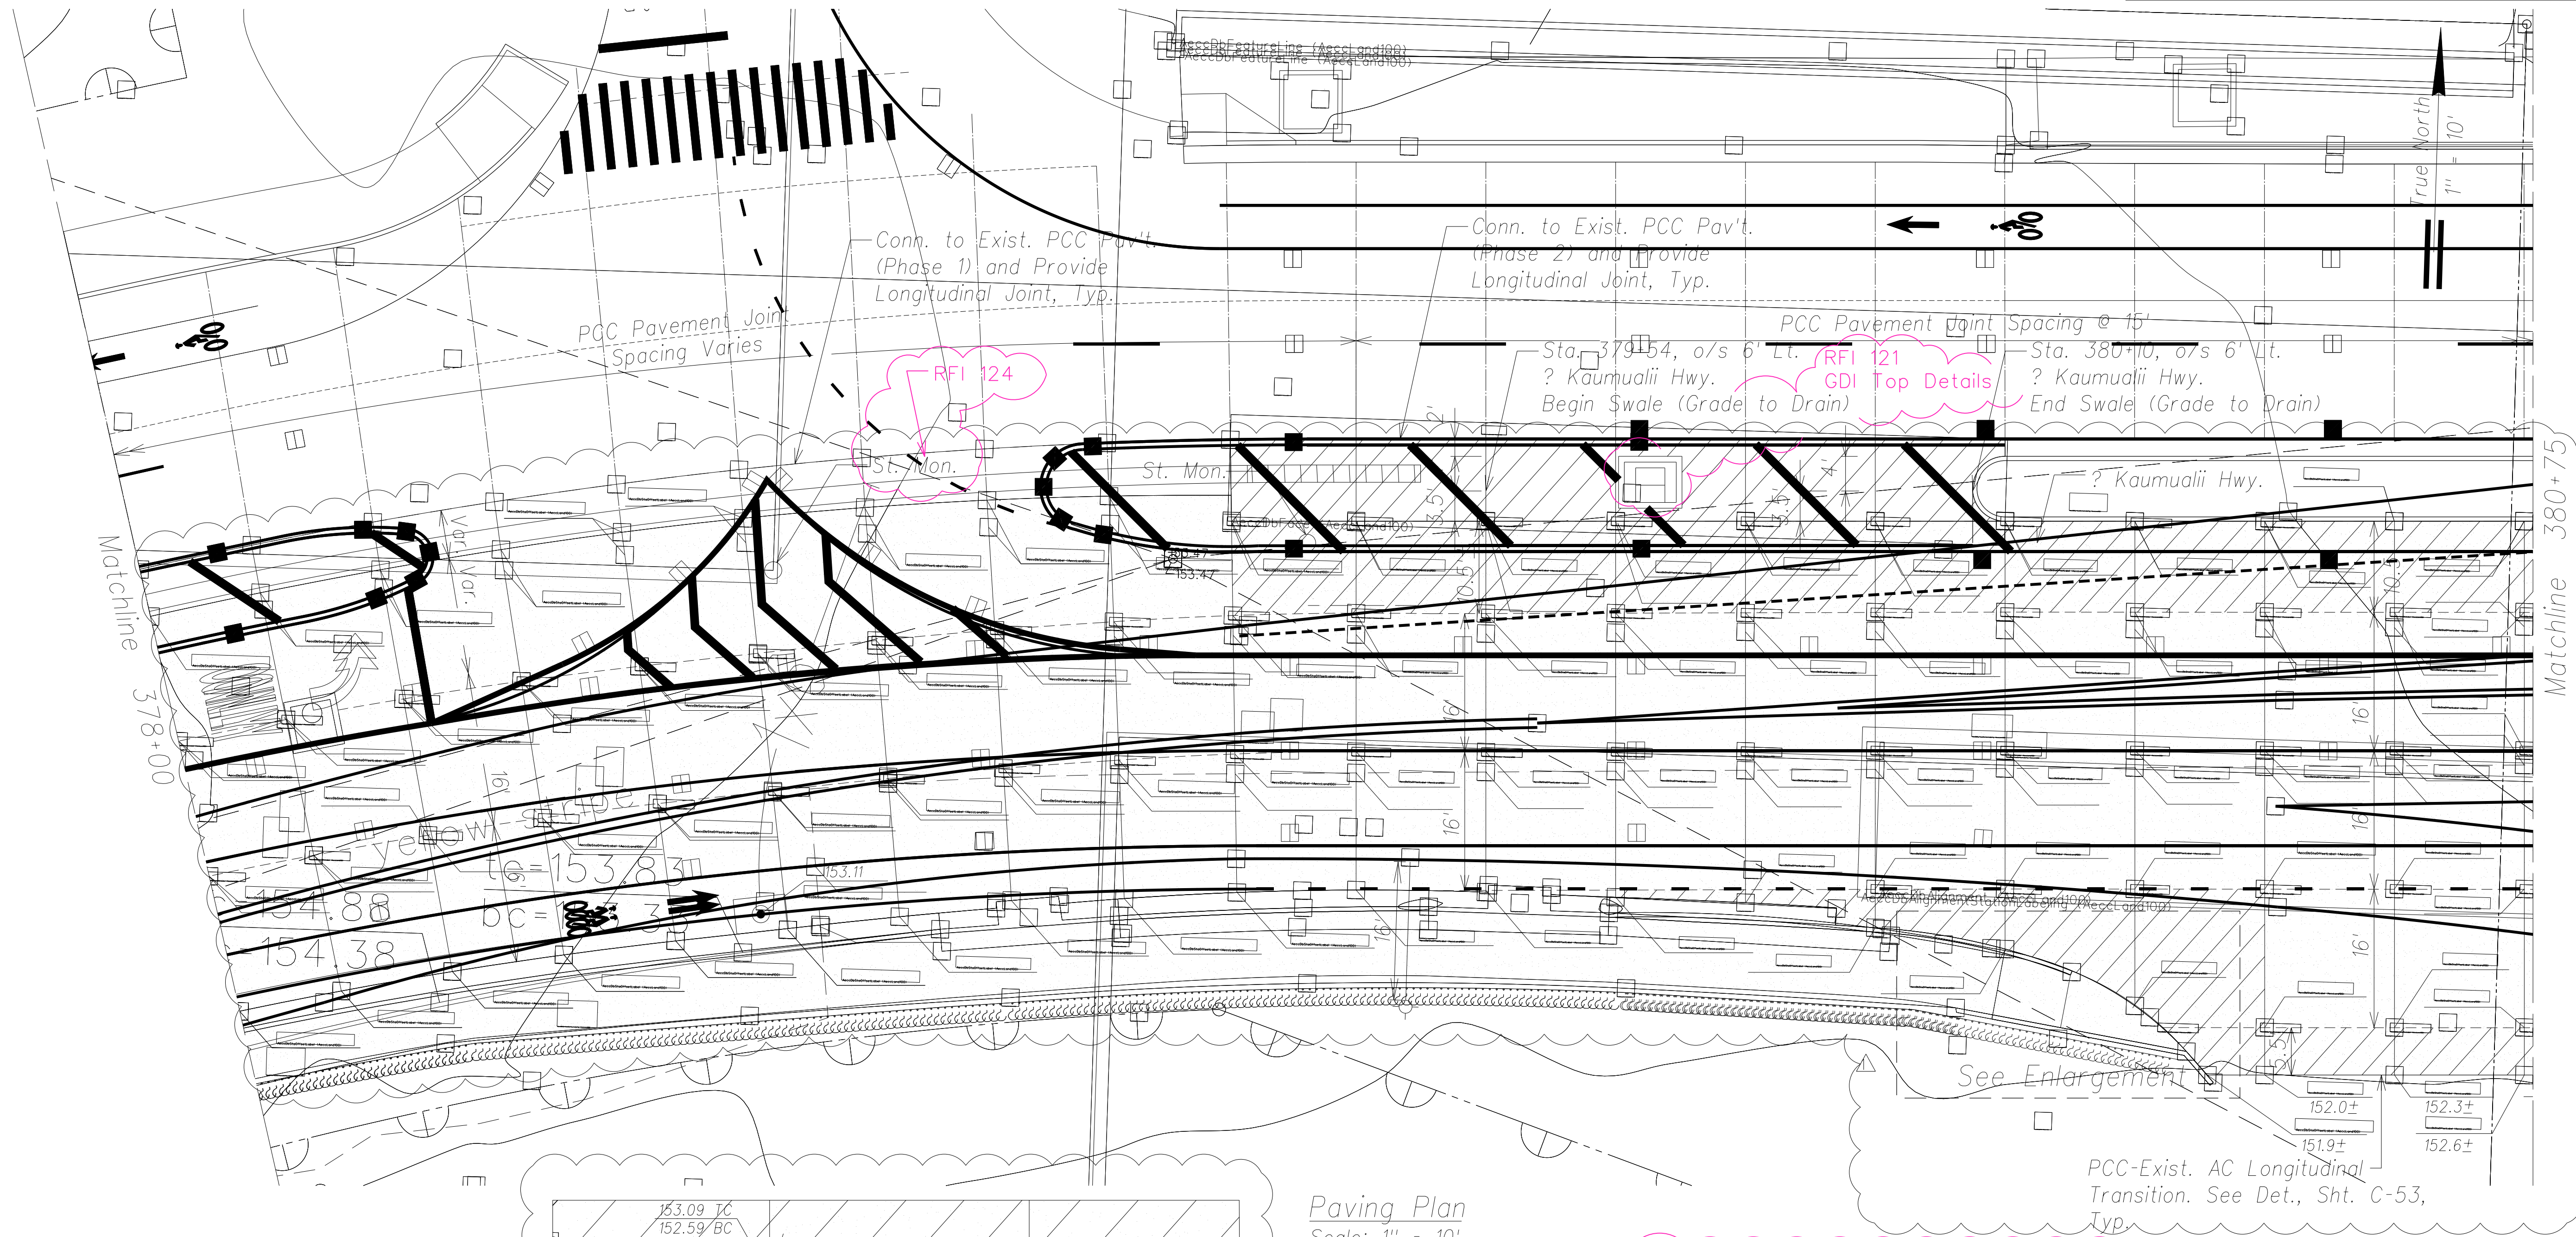

SURVEY PLOTTED BY	DATE
DESIGNED BY	
TRACED BY	
NOTE BOOK	
QUANTITIES BY	
CHECKED BY	
No.	

Legend:

Proposed	Existing	Typical Transverse Joint
-----	-----	Typical Longitudinal Joint
-----	-----	Odd Shaped Slabs

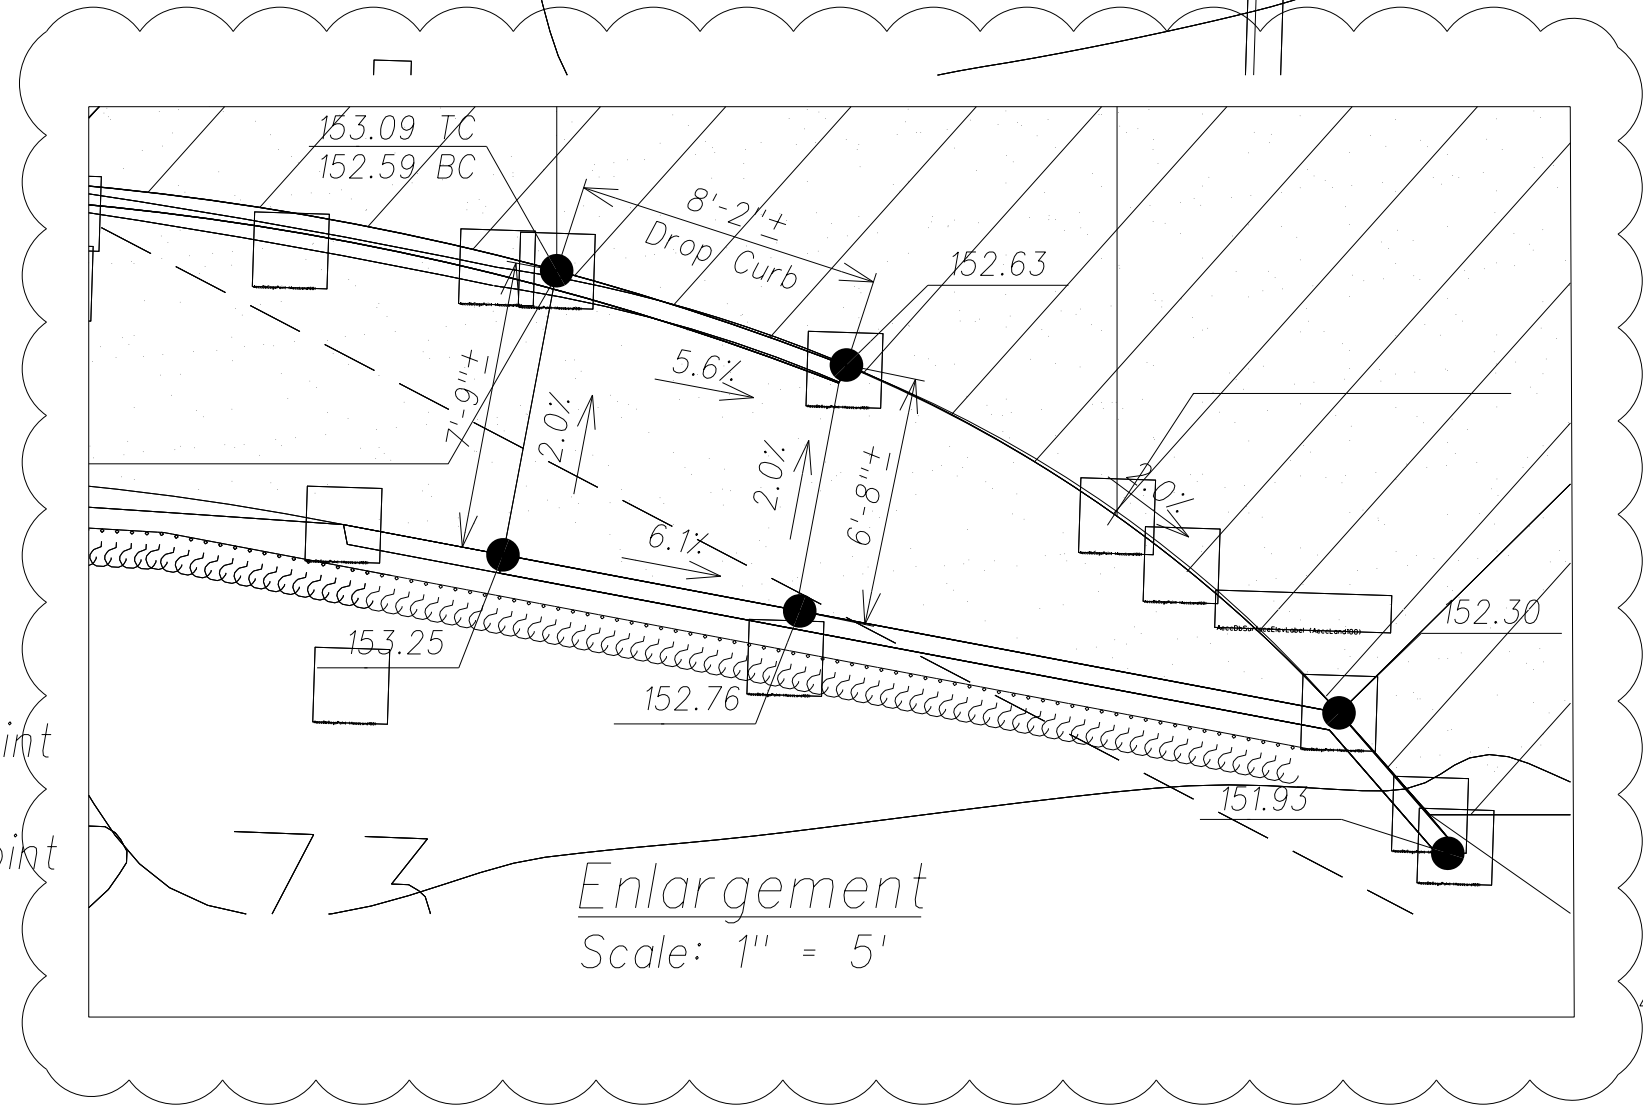

Paving Plan
Scale: 1" = 10'


LEGEND FOR
AS-BUILT POSTINGS

~~~~~ Squiggly line for as-built deletion

== Double line for as-built deletion

Roadway Text for as-built posting

- RFI 116 - PCC-AC Travelway Transition
- RFI 115 - Subbase Section Change From 380+14 to 384+384+58
- RFI 124 - Survey Monument Core Holes
- RFI 121 - GDI top Details

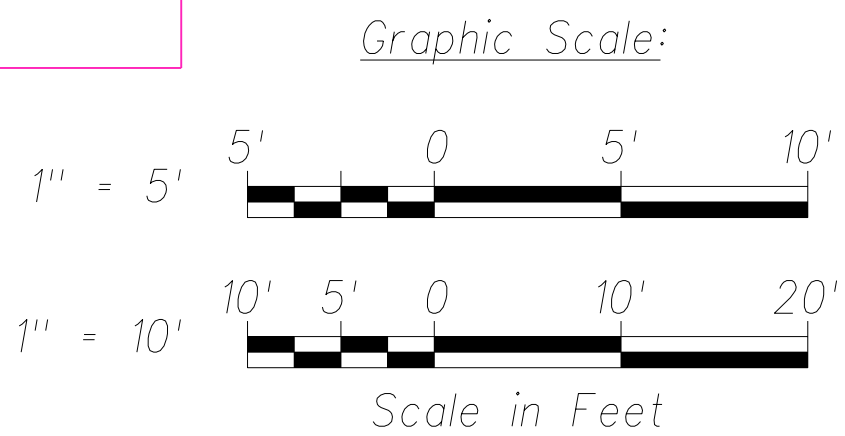

THIS WORK WAS PREPARED BY ME OR UNDER MY SUPERVISION AND CONSTRUCTION OF THIS PROJECT WILL BE UNDER MY OBSERVATION.

SIGNATURE

April 30, 2016  
EXPIRATION DATE OF THE LICENSE



|                                                                      |                                                     |
|----------------------------------------------------------------------|-----------------------------------------------------|
| 4/6/15                                                               | Rev. for add'l PCC pav't and sidewalk. Add st. mon. |
| Date                                                                 | Revision                                            |
| STATE OF HAWAII<br>DEPARTMENT OF TRANSPORTATION<br>HIGHWAYS DIVISION |                                                     |
| PAVING PLAN                                                          |                                                     |
| PHASE 1 - KAUMUALII HIGHWAY<br>LIHUE MILL BRIDGE TO RICE STREET      |                                                     |
| PHASE 3 - REHABILITATION OF LIHUE MILL<br>BRIDGE AND MAKAI WIDENING  |                                                     |
| Scale: As Shown                                                      | Date: May 2, 2014                                   |
| SHEET No. C-39 OF 82 SHEETS                                          |                                                     |

"AS-BUILT"

MODEL S1






| FED. ROAD DIST. NO. | STATE | FED. AID PROJ. NO. | FISCAL YEAR | SHEET NO. | TOTAL SHEETS |
|---------------------|-------|--------------------|-------------|-----------|--------------|
| HAWAII              | HAW.  | ARR-050-1(036)     | FY13/14     | Model     | 141          |

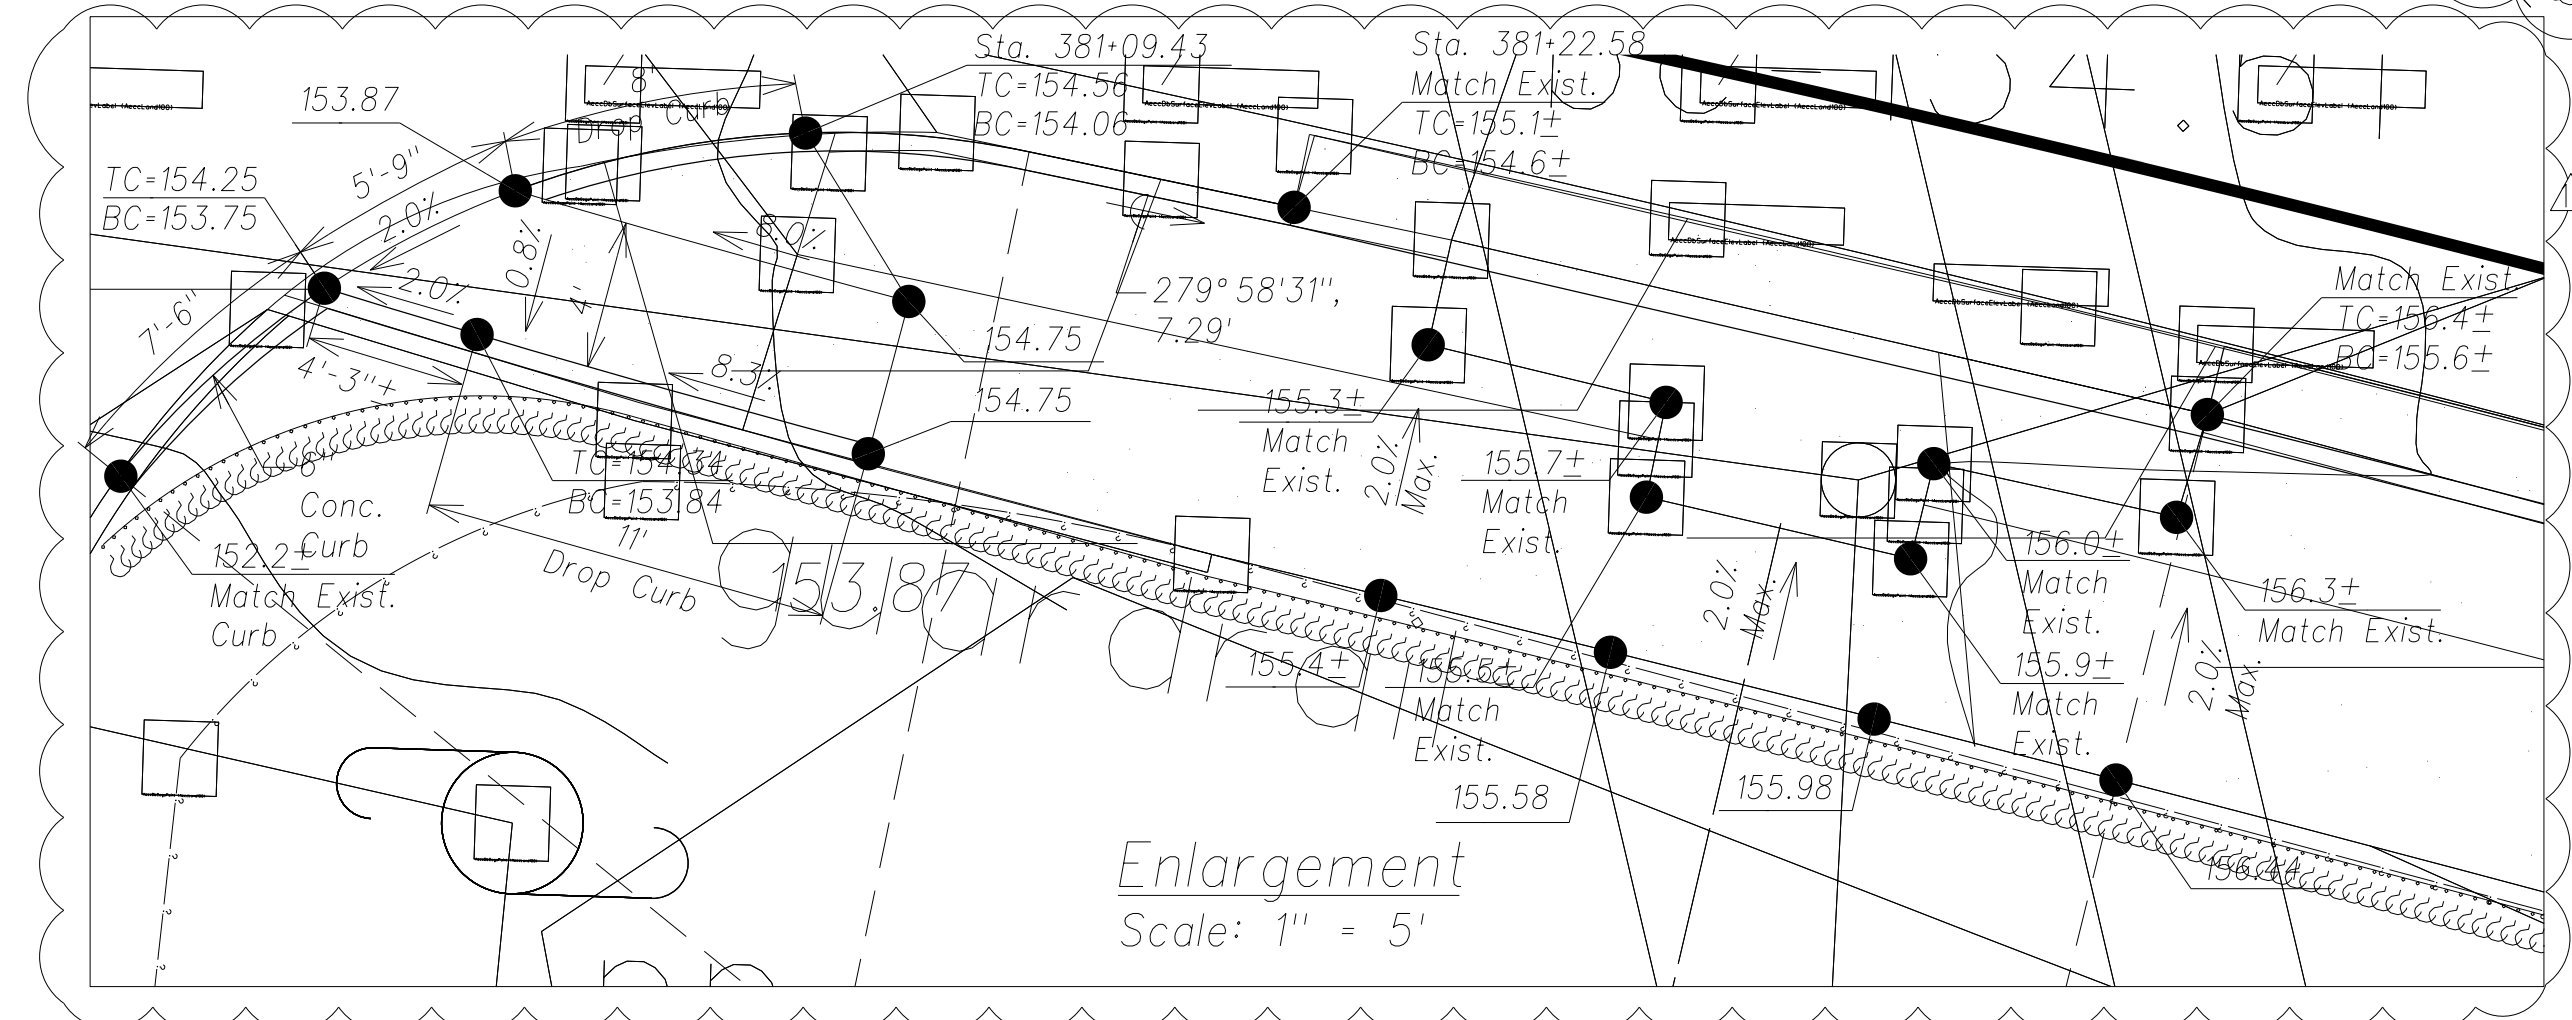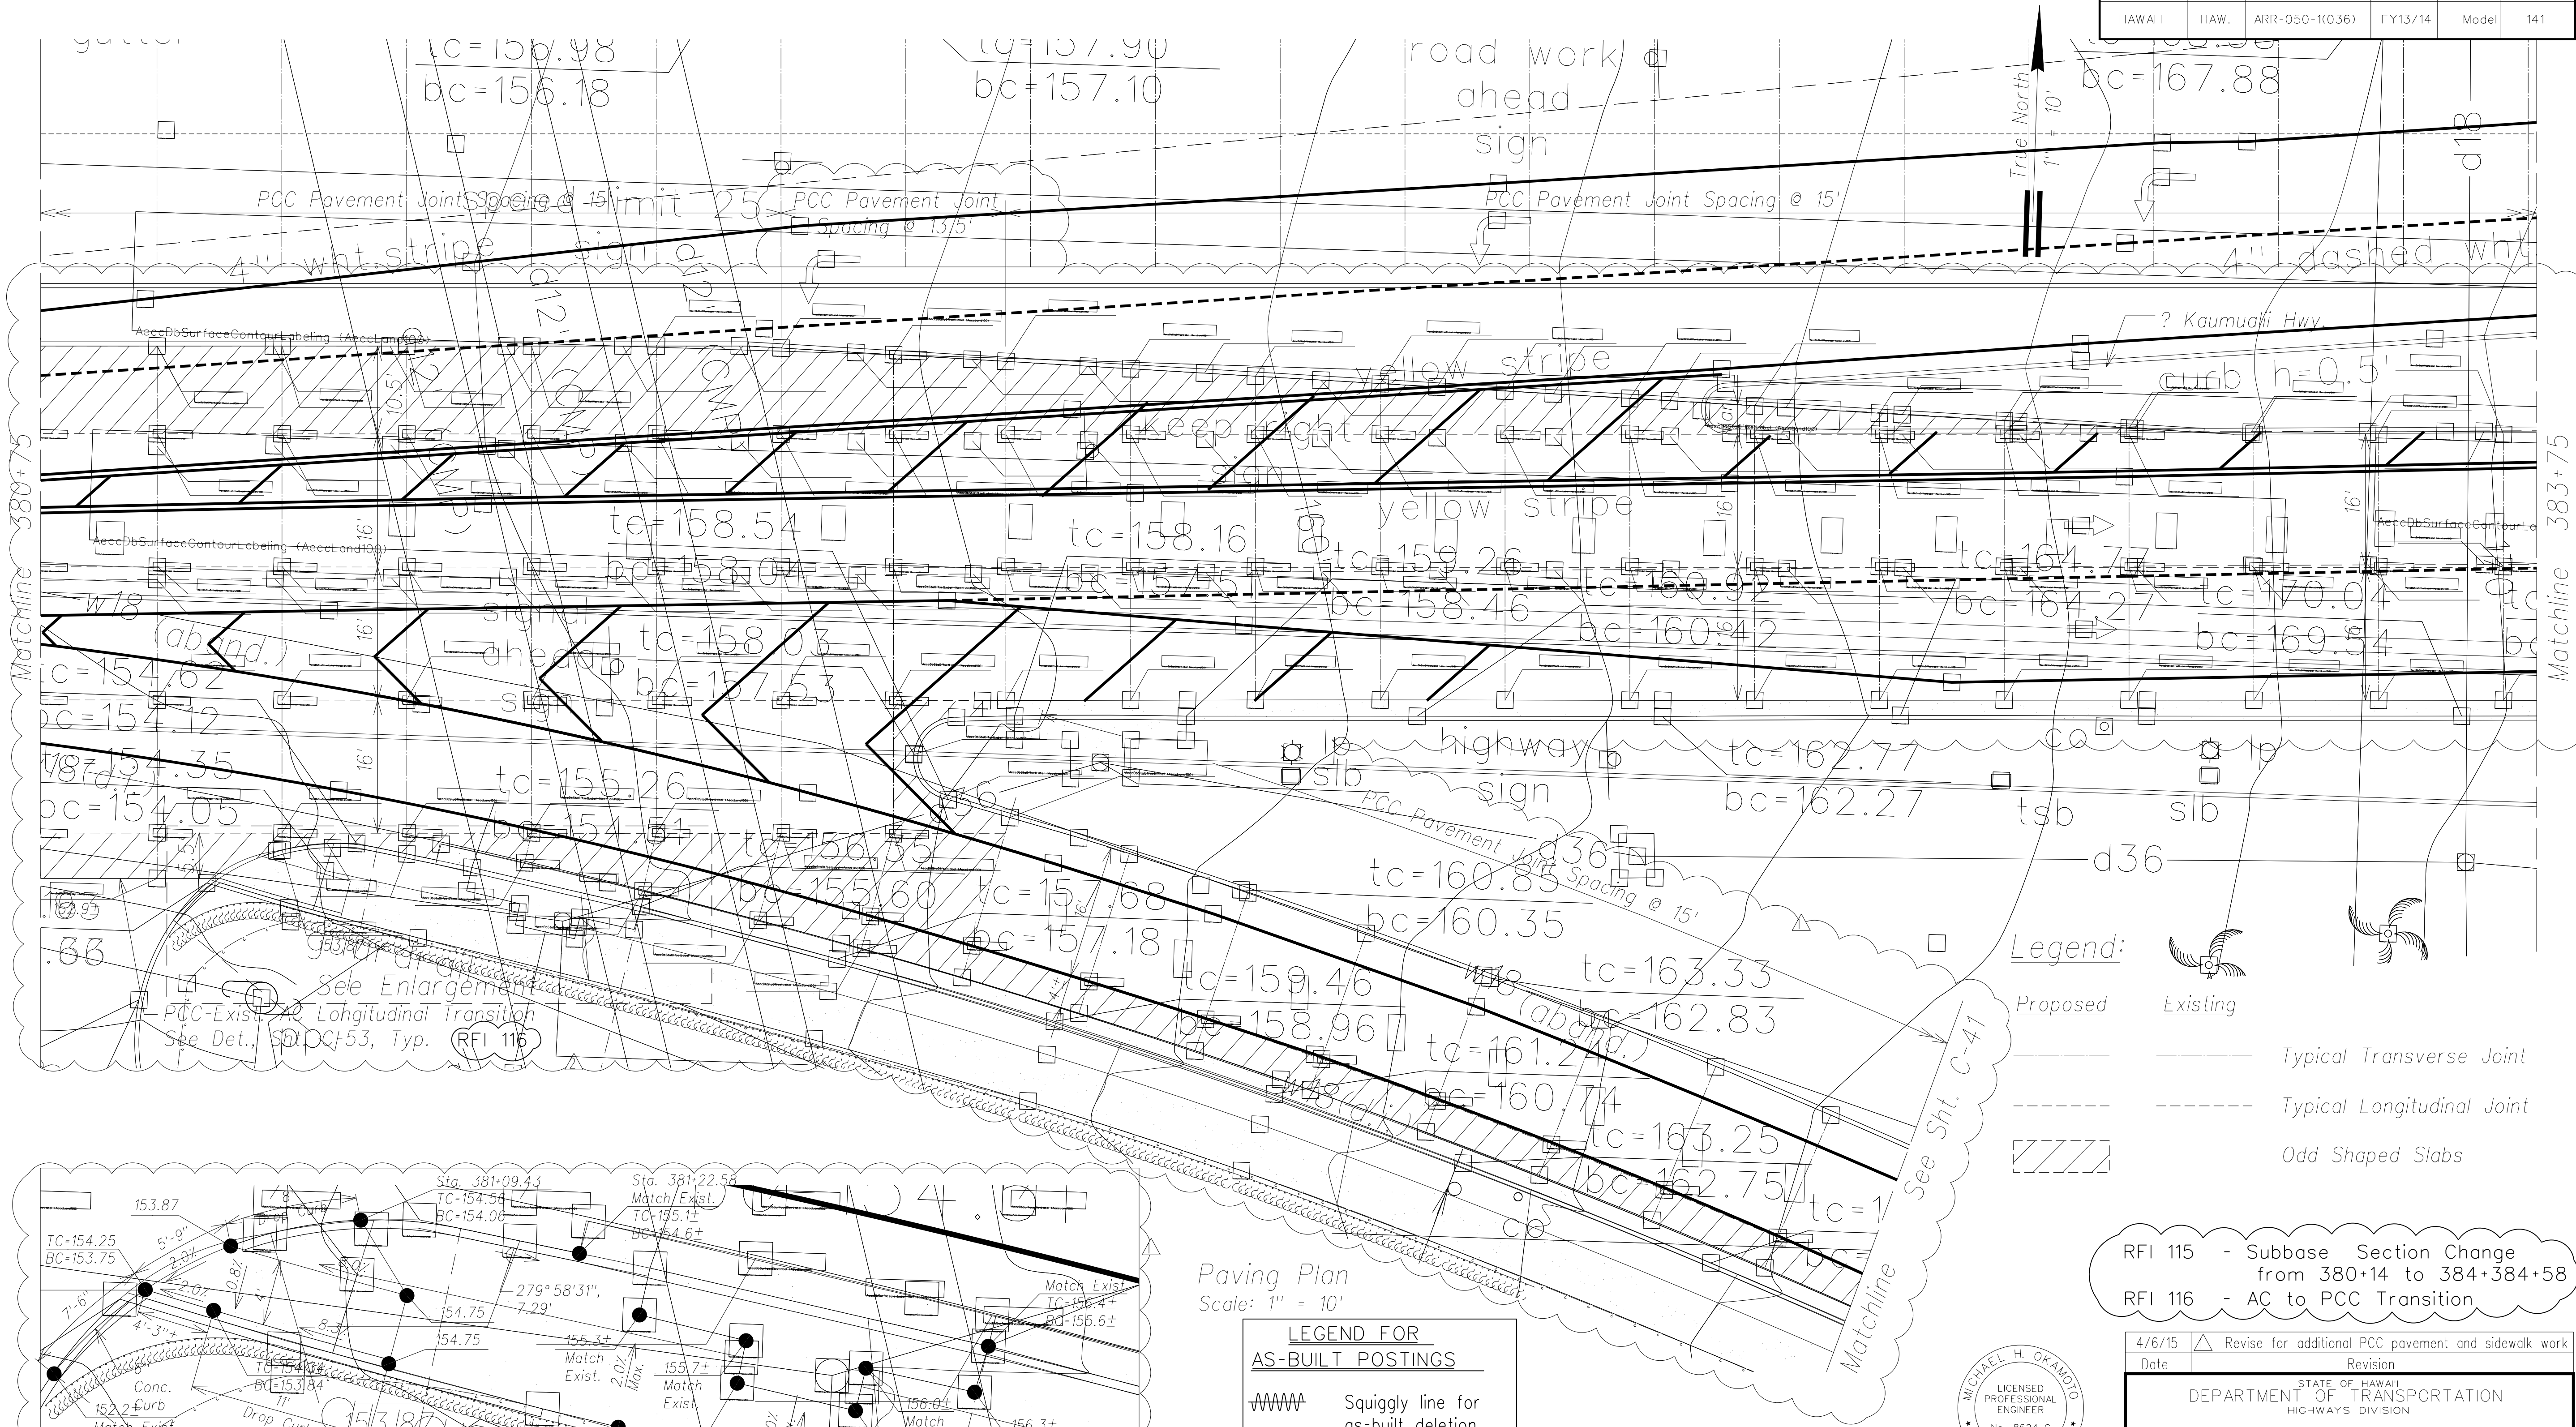



| FED. ROAD DIST. NO. | STATE | FED. AID PROJ. NO. | FISCAL YEAR | SHEET NO. | TOTAL SHEETS |
|---------------------|-------|--------------------|-------------|-----------|--------------|
| HAWAII              | HAW.  | ARR-050-1(036)     | FY13/14     | Model     | 141          |

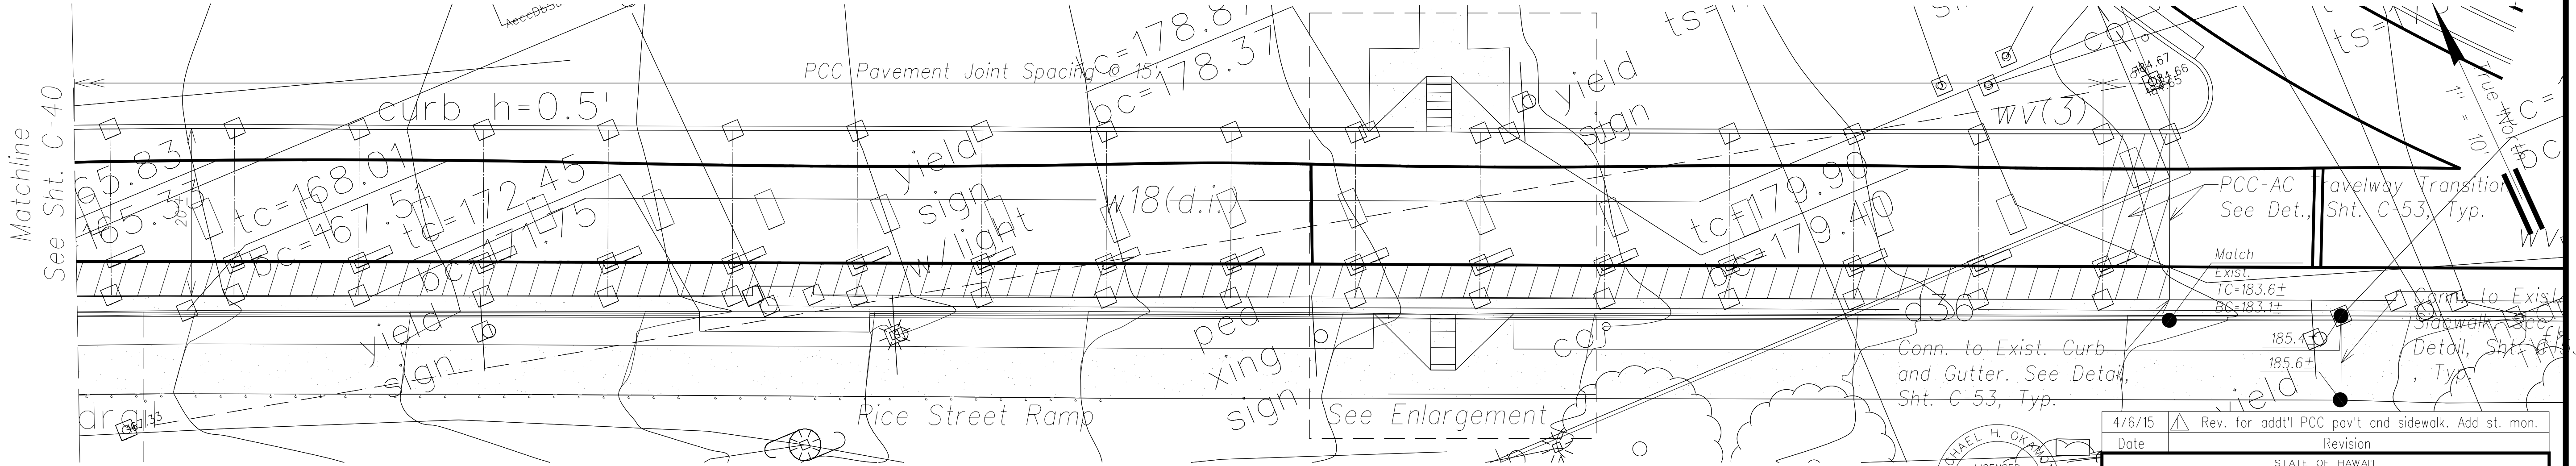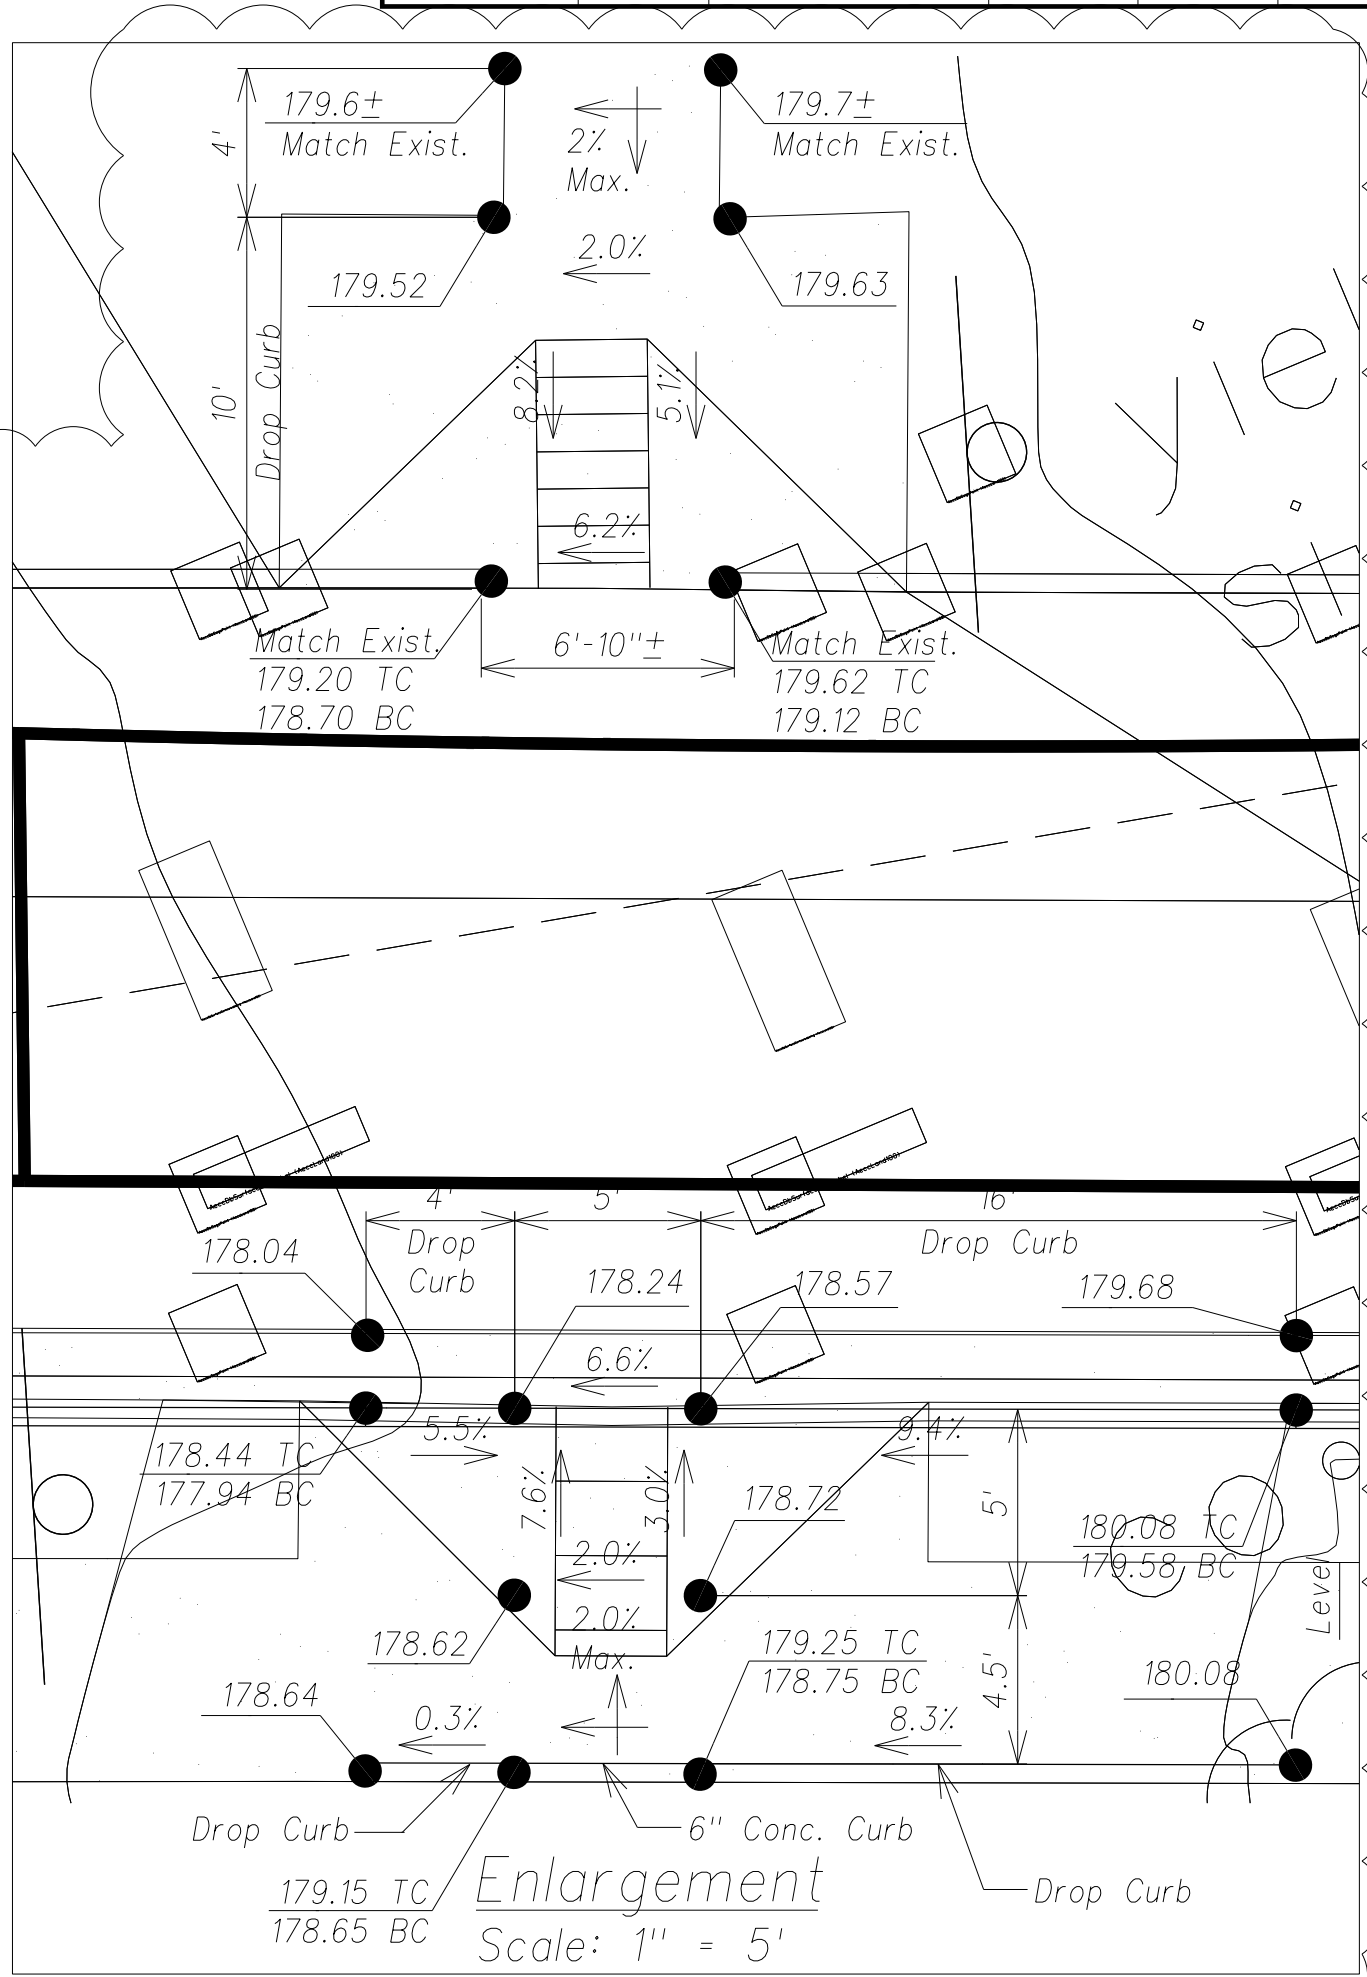
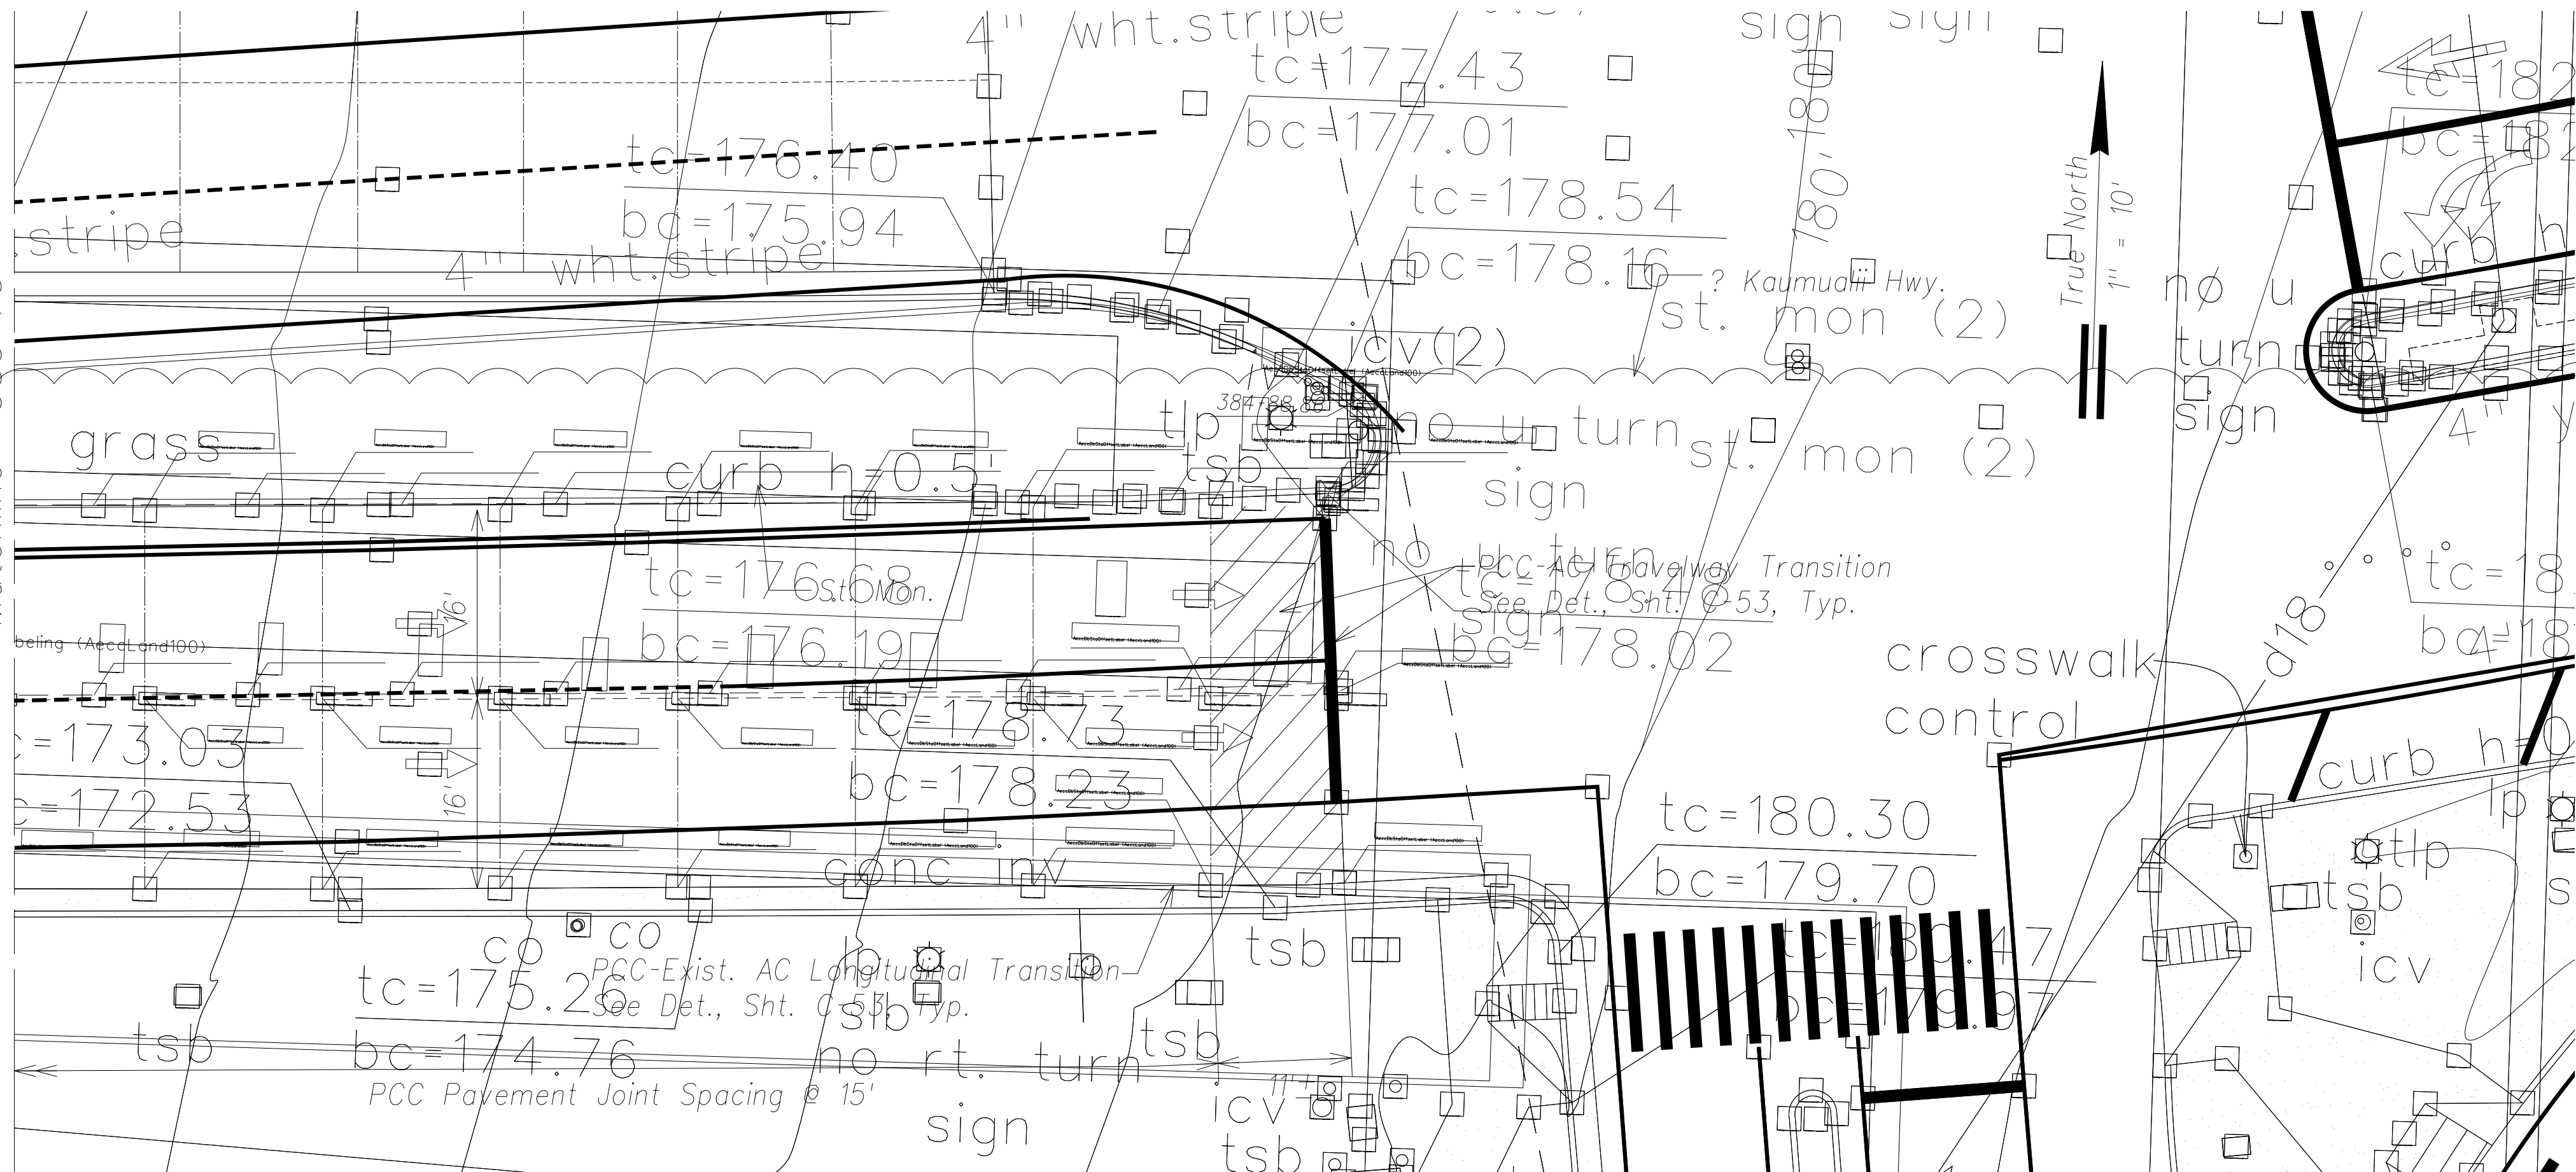


Legend:

| Proposed | Existing |                            |
|----------|----------|----------------------------|
| ---      | ---      | Typical Transverse Joint   |
| ---      | ---      | Typical Longitudinal Joint |
| ///      |          | Odd Shaped Slabs           |

Note:  
See Sht. C-31  
for Curb Data

Paving Plan  
Scale: 1" = 10'

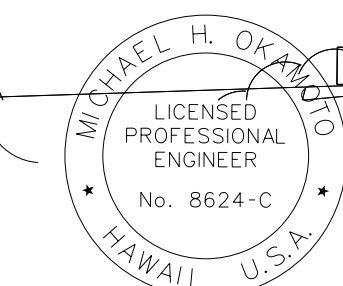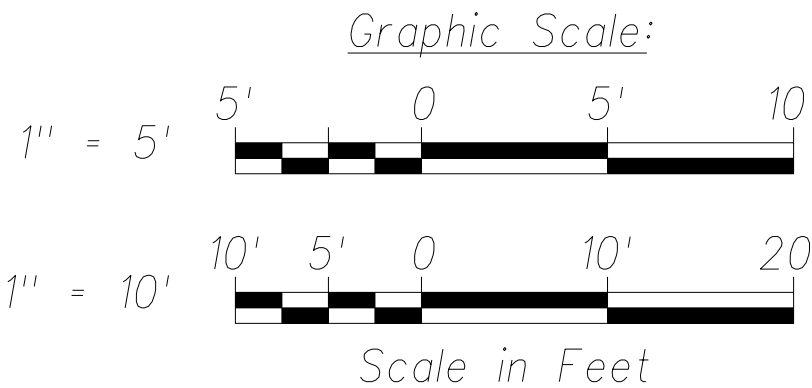

THIS WORK WAS PREPARED BY ME  
OR UNDER MY SUPERVISION AND  
CONSTRUCTION OF THIS PROJECT  
WILL BE UNDER MY OBSERVATION.

SIGNATURE  
April 30, 2016  
EXPIRATION DATE  
OF THE LICENSE

| Date   | Revision                                            |
|--------|-----------------------------------------------------|
| 4/6/15 | Rev. for add'l PCC pav't and sidewalk. Add st. mon. |

STATE OF HAWAII  
DEPARTMENT OF TRANSPORTATION  
HIGHWAYS DIVISION

PAVING PLAN

PHASE 1 - KAUMUALII HIGHWAY  
LIHUE MILL BRIDGE TO RICE STREET

PHASE 3 - REHABILITATION OF LIHUE MILL  
BRIDGE AND MAKAI WIDENING

Scale: As Shown      Date: May 2, 2014

SHEET No. C-41 OF 82      SHEETS

|                   |      |
|-------------------|------|
| SURVEY PLOTTED BY | DATE |
| DRAWN BY          |      |
| DESIGNED BY       |      |
| CHECKED BY        |      |
| ORIGINAL PLAN     | No.  |
| NOTE BOOK         | No.  |

"AS-BUILT"

CMODEL S1