

FED. ROAD DIST. NO.	STATE	FED. AID PROJ. NO.	FISCAL YEAR	SHEET NO.	TOTAL SHEETS
HAWAII	HAW.	ARR-050-1(036)	FY13/14	138	139

LEGEND FOR
AS-BUILT POSTINGS

- ~~~~~ Squiggly line for as-built deletion
~~100+00~~ Double line for as-built deletion
Roadway Text for as-built posting


NOTE:

Landscape contractor to provide 4" layer top soil, prepared per the specifications and the soil report recommendations on slopes less than 3:1.

Landscape contractor to install a temporary irrigation system to planting areas to insure germination and growth of the grass.

The landscape contractor shall irrigate planting areas in a way that will prevent erosion. Any erosion or rills shall be corrected by the landscape contractor.

Remove system after the final approval of the maintenance period.

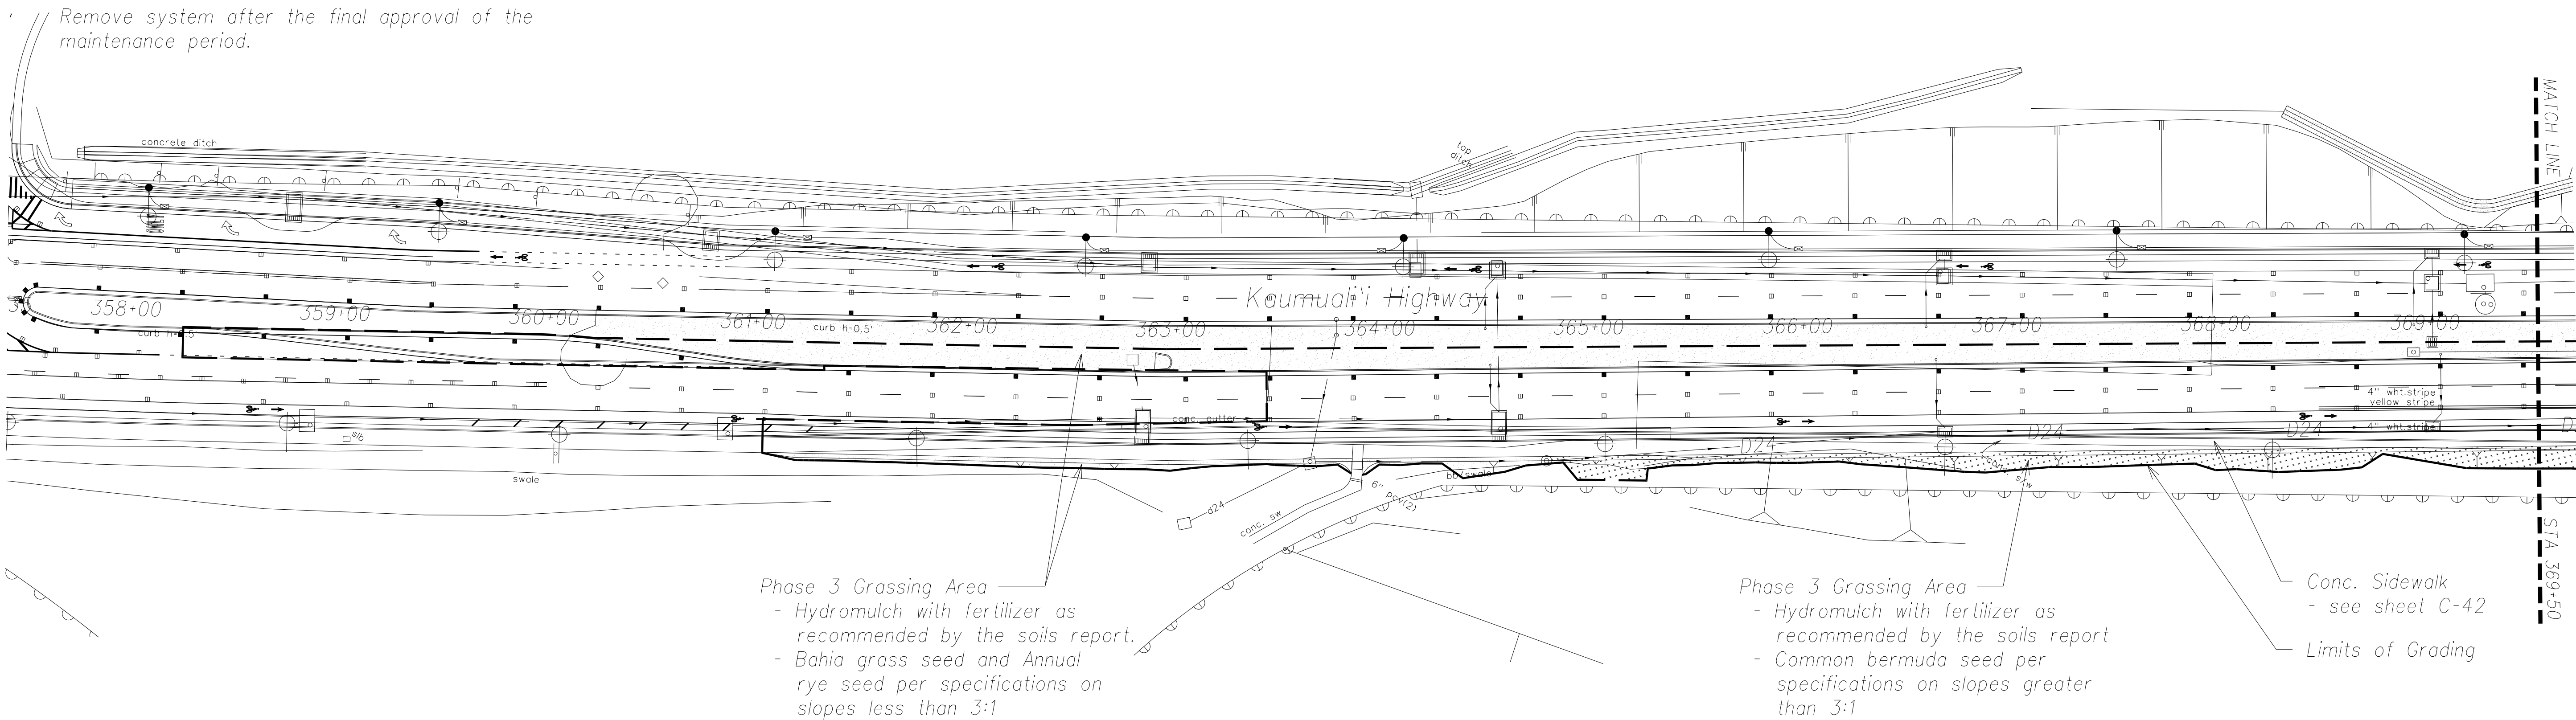

Planting Plan 1
Scale: 1" = 40'

PLANT SCHEDULE

BOTANICAL NAME	COMMON NAME	QTY.	REMARKS
<div><div></div><div>Paspalum notatum</div></div>	Bahia Grass	25,000 sq ft approx.	- Hydromulch with fertilizer as recommended by the soils report.
<div><div></div><div>Lolium multiflorum</div></div>	Annual Ryegrass		- Bahia grass and Annual rye seed per specifications on slopes less than 3:1.
<div><div></div><div>Cynodon dactylon</div></div>	Common Bermuda Grass	8,000 sq ft approx.	- Hydromulch with fertilizer as recommended by the soils report.
			- Common bermuda seed on slopes greater than 3:1.

Graphic Scales:



STATE OF HAWAII
DEPARTMENT OF TRANSPORTATION
HIGHWAYS DIVISION

PLANTING PLAN 1

PHASE 1 - KAUMUALII HIGHWAY
LIHUE MILL BRIDGE TO RICE STREET

PHASE 3 - REHABILITATION OF LIHUE MILL
BRIDGE AND MAKAI WIDENING

Scale: As Shown Date: September 18, 2013

SHEET No. L-1 OF 2 SHEETS

ORIGINAL PLAN	SURVEY PLOTTED BY	DATE
	DESIGNED BY	
NOTE BOOK	DESIGNED BY	
	QUANTITIES BY	
No.	CHECKED BY	

"AS-BUILT"

