




FED. ROAD DIST. NO.	STATE	FED. AID PROJ. NO.	FISCAL YEAR	SHEET NO.	TOTAL SHEETS
HAWAII	HAW.	ARR-050-1(036)	FY13/14	Model	141

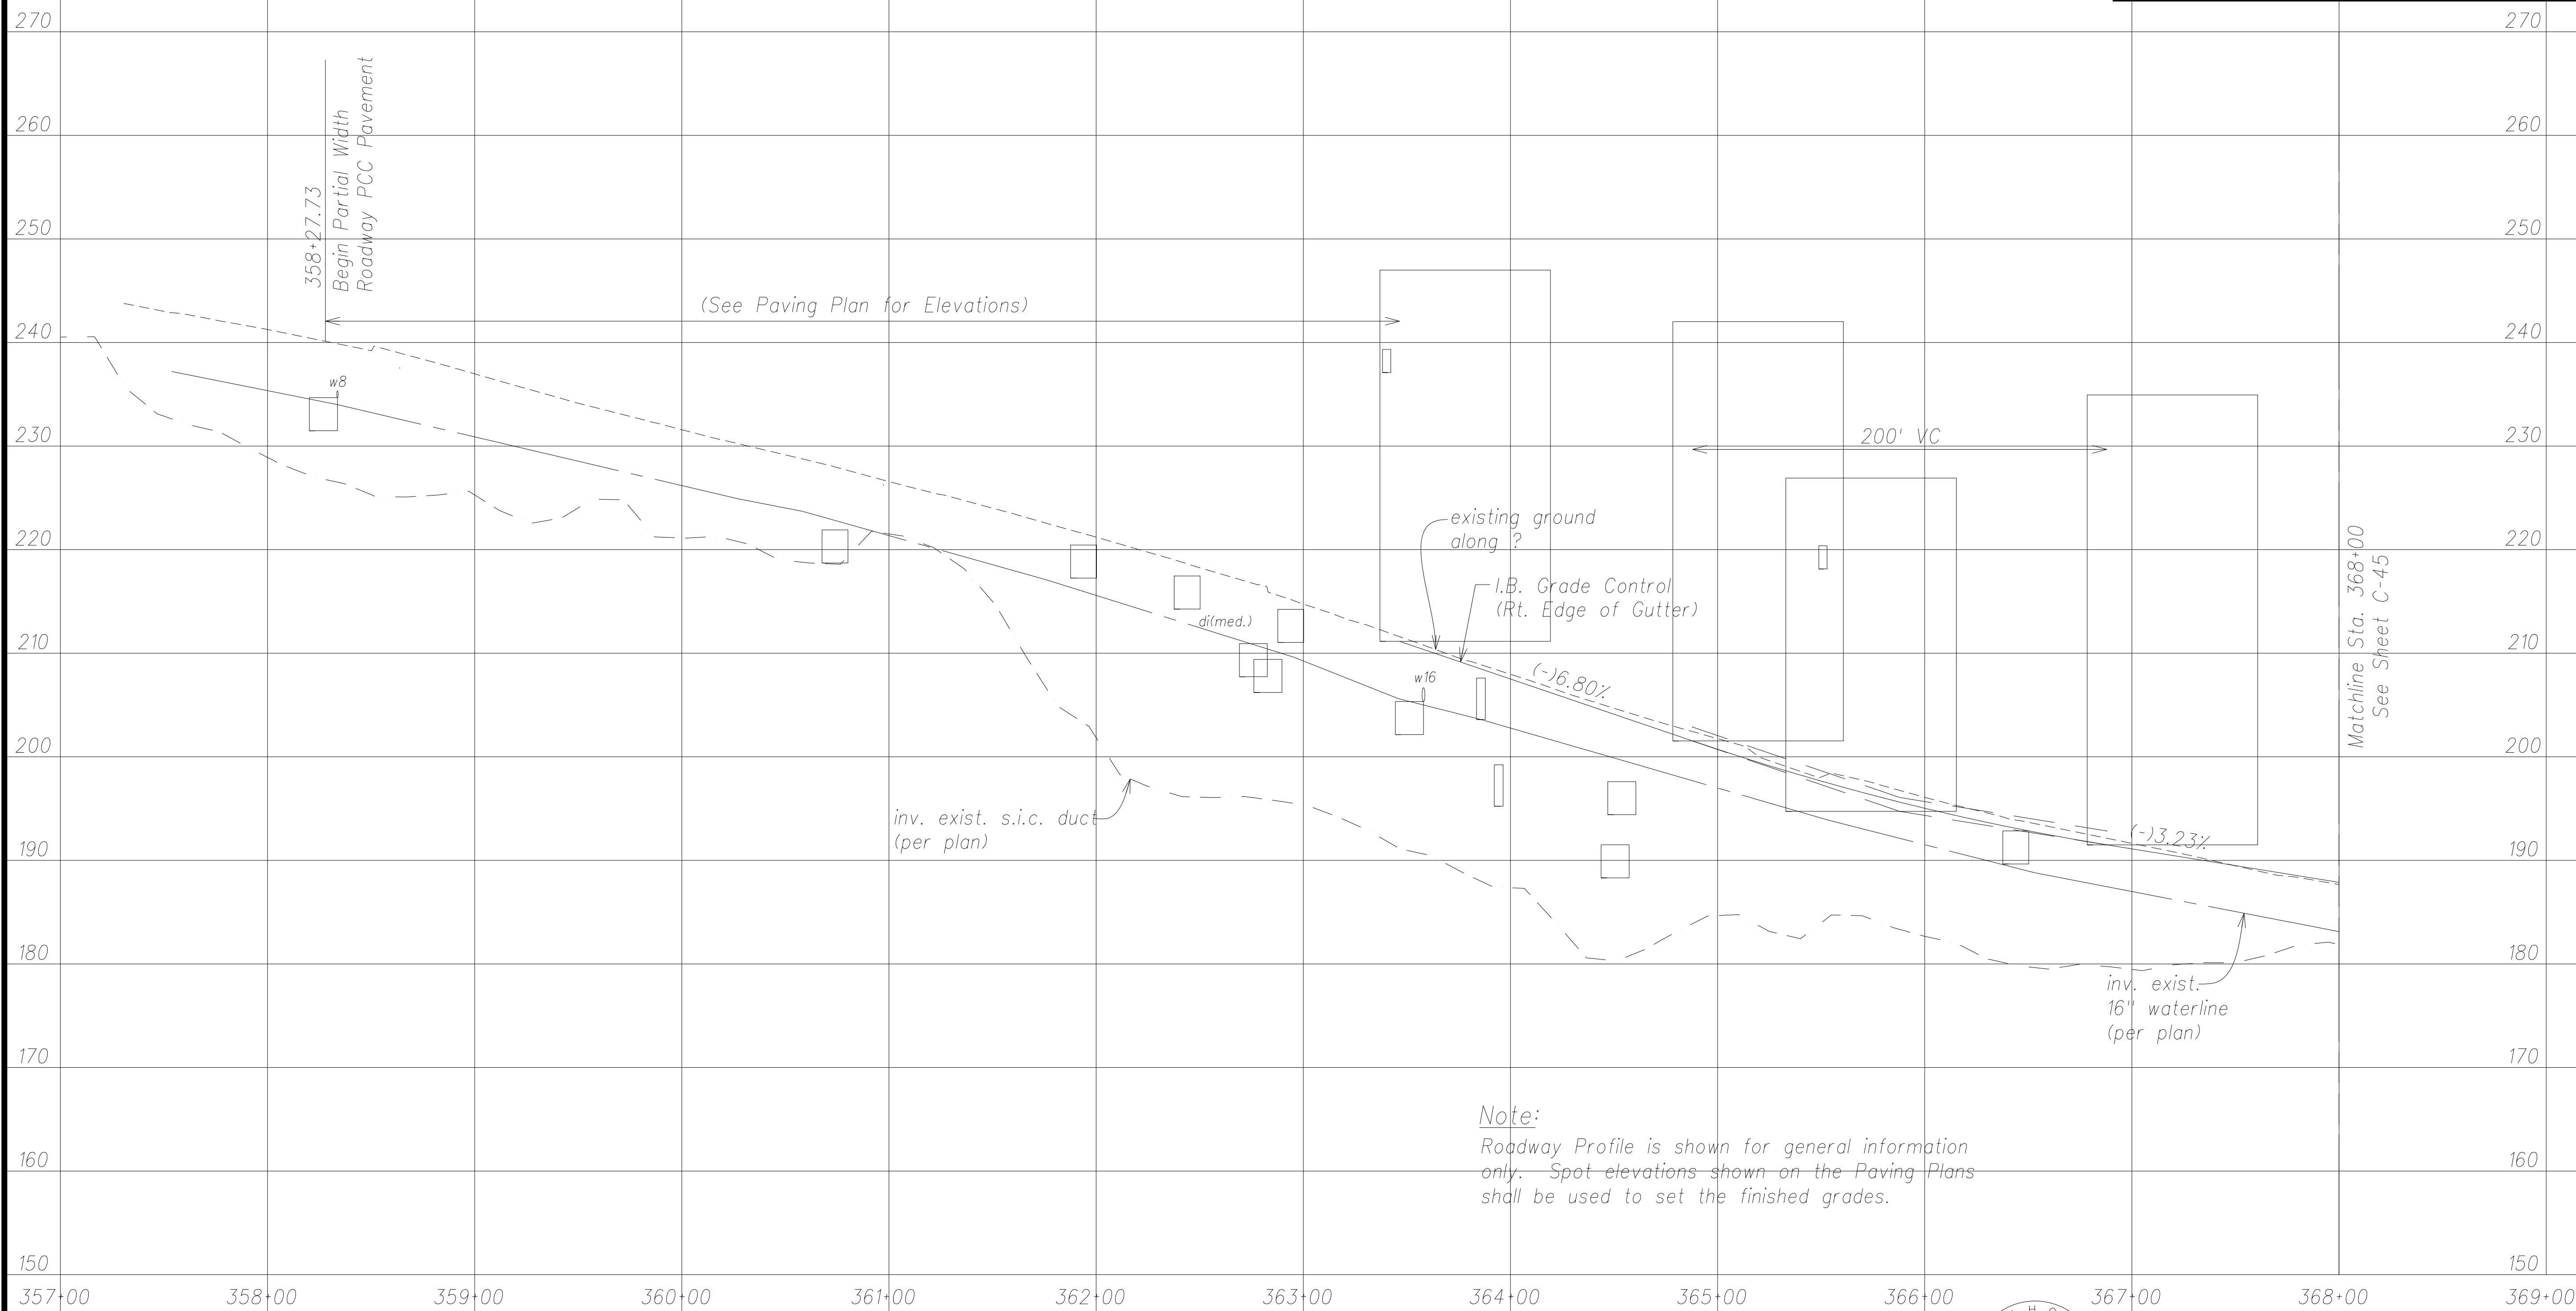

Profile: Kaumualii Highway (Sta. 358+27.73 to Sta. 368+00)
Scales: Hor.: 1" = 40'
Vert.: 1" = 8'

Note:
Roadway Profile is shown for general information only. Spot elevations shown on the Paving Plans shall be used to set the finished grades.

Graphic Scales:

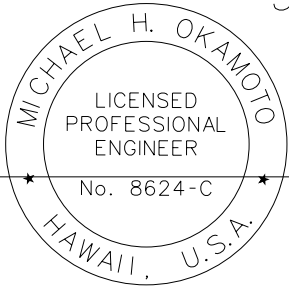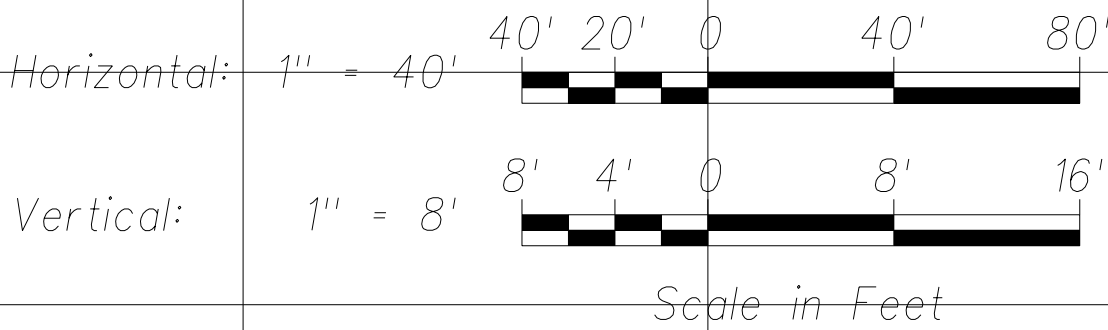

THIS WORK WAS PREPARED BY ME OR UNDER MY SUPERVISION AND CONSTRUCTION OF THIS PROJECT WILL BE UNDER MY OBSERVATION.

SIGNATURE
EXPIRATION DATE OF THE LICENSE

STATE OF HAWAII
DEPARTMENT OF TRANSPORTATION
HIGHWAYS DIVISION

ROADWAY PROFILES
(STA. 358+27.73 TO STA. 368+00)
PHASE 1 - KAUMUALII HIGHWAY
LIHUE MILL BRIDGE TO RICE STREET
PHASE 3 - REHABILITATION OF LIHUE MILL
BRIDGE AND MAKAI WIDENING


Scale: As Shown Date: May 2, 2014

SHEET No. C-44 OF 82 SHEETS

ORIGINAL PLAN NOTE BOOK No.	SURVEY PLOTTED BY	DATE
	DRAWN BY	
	DESIGNED BY	
	CHECKED BY	

FILE: C:\Users\lisa\Desktop\Drawing\cng saved Apr 7, 2016

ORIGINAL PLAN	SURVEY PLOTTED BY _____		DATE _____
	DRAWN BY _____		DESIGNED BY _____
NOTE BOOK No. _____	DESIGNED BY _____		QUANTITIES BY _____
	CHECKED BY _____		_____

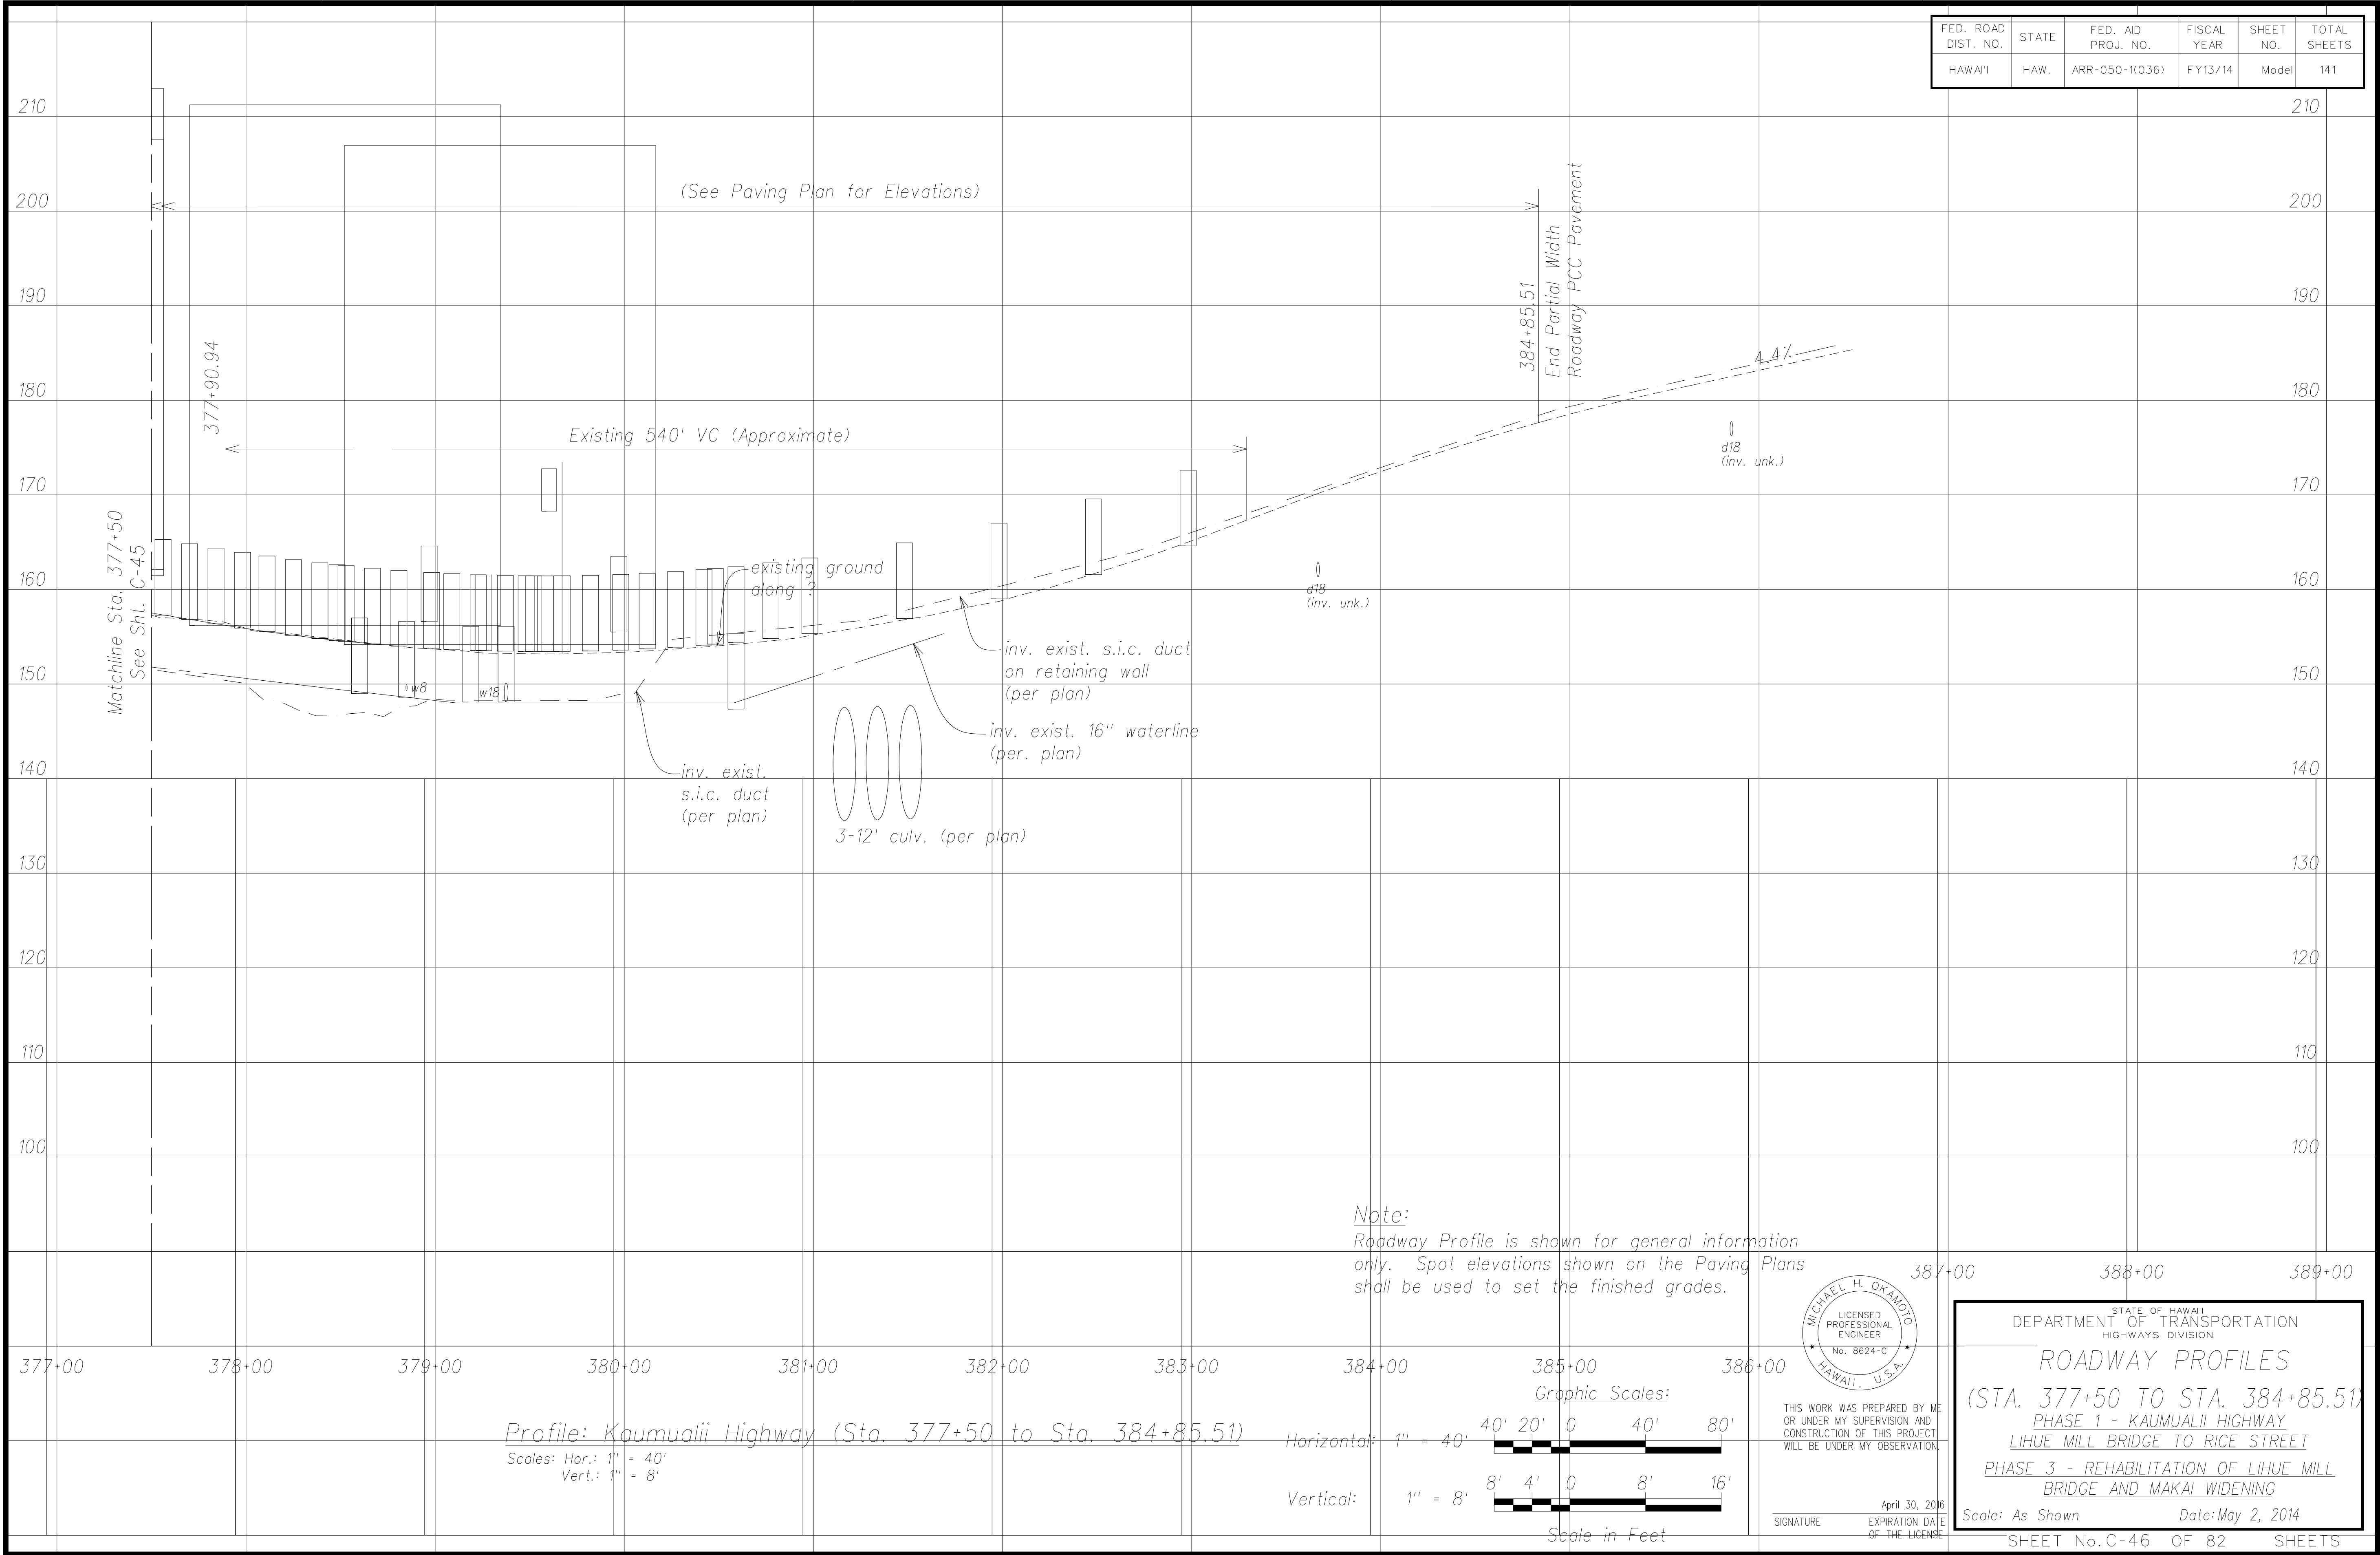

"AS-BUILT"

MODEL