



FED. ROAD DIST. NO.	STATE	FED. AID PROJ. NO.	FISCAL YEAR	SHEET NO.	TOTAL SHEETS
HAWAII	HAW.	ARR-050-1(036)	FY13/14	Model	141

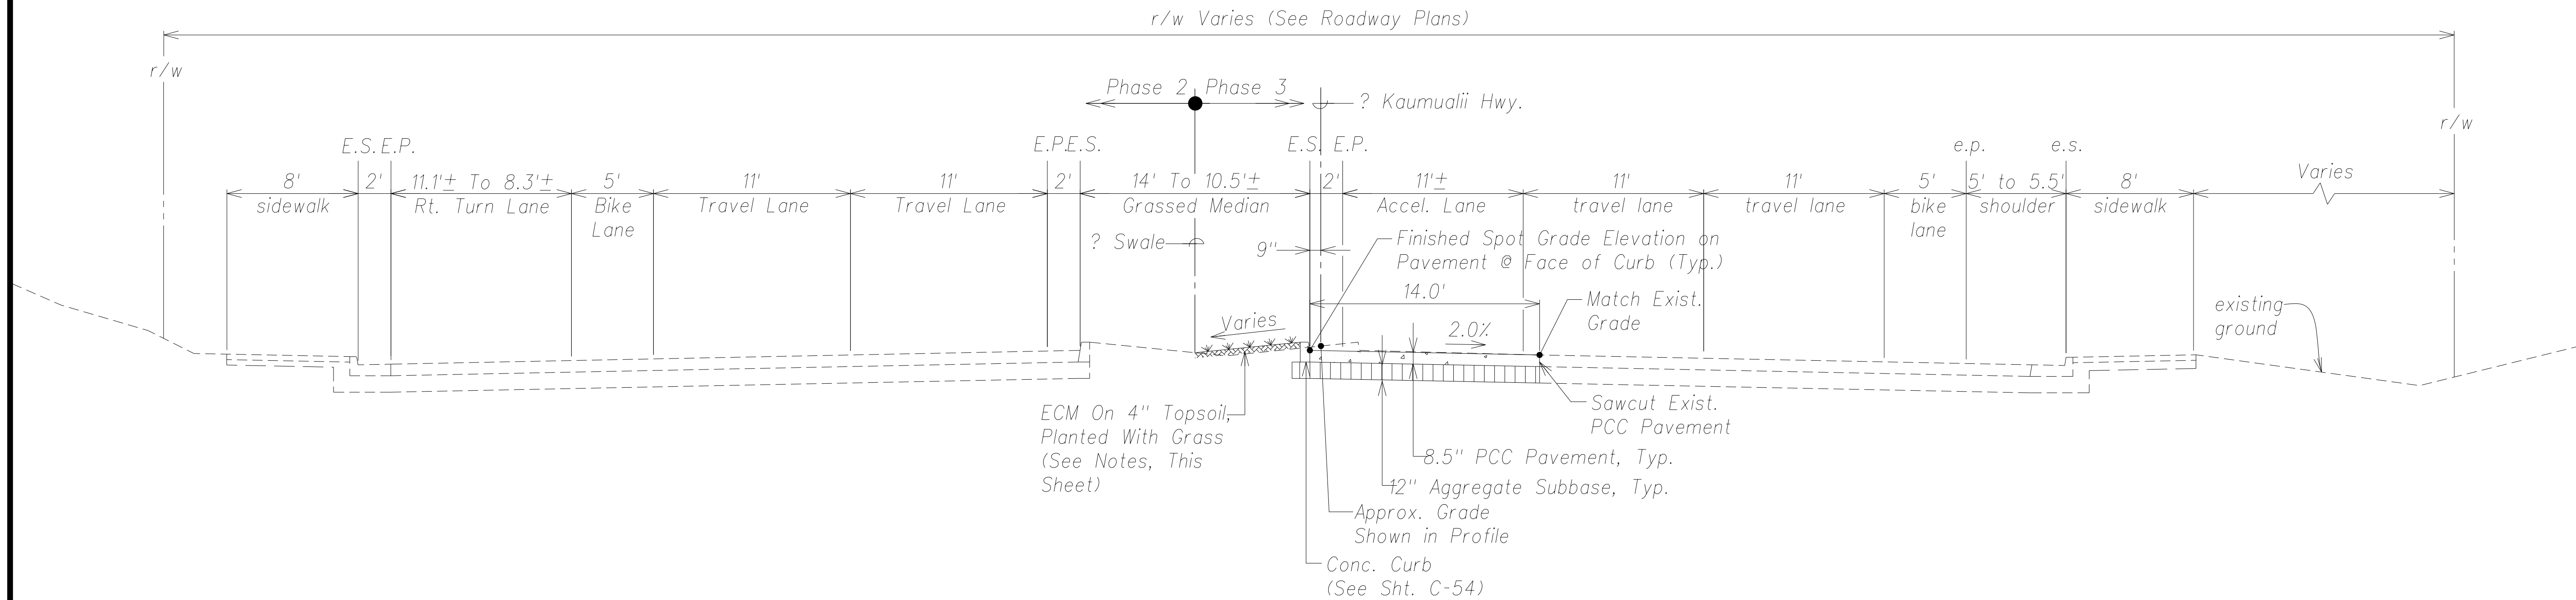

Typical Section - (Sta. 358+28± To Sta. 359+95.00)
Scale: 1" = 5'

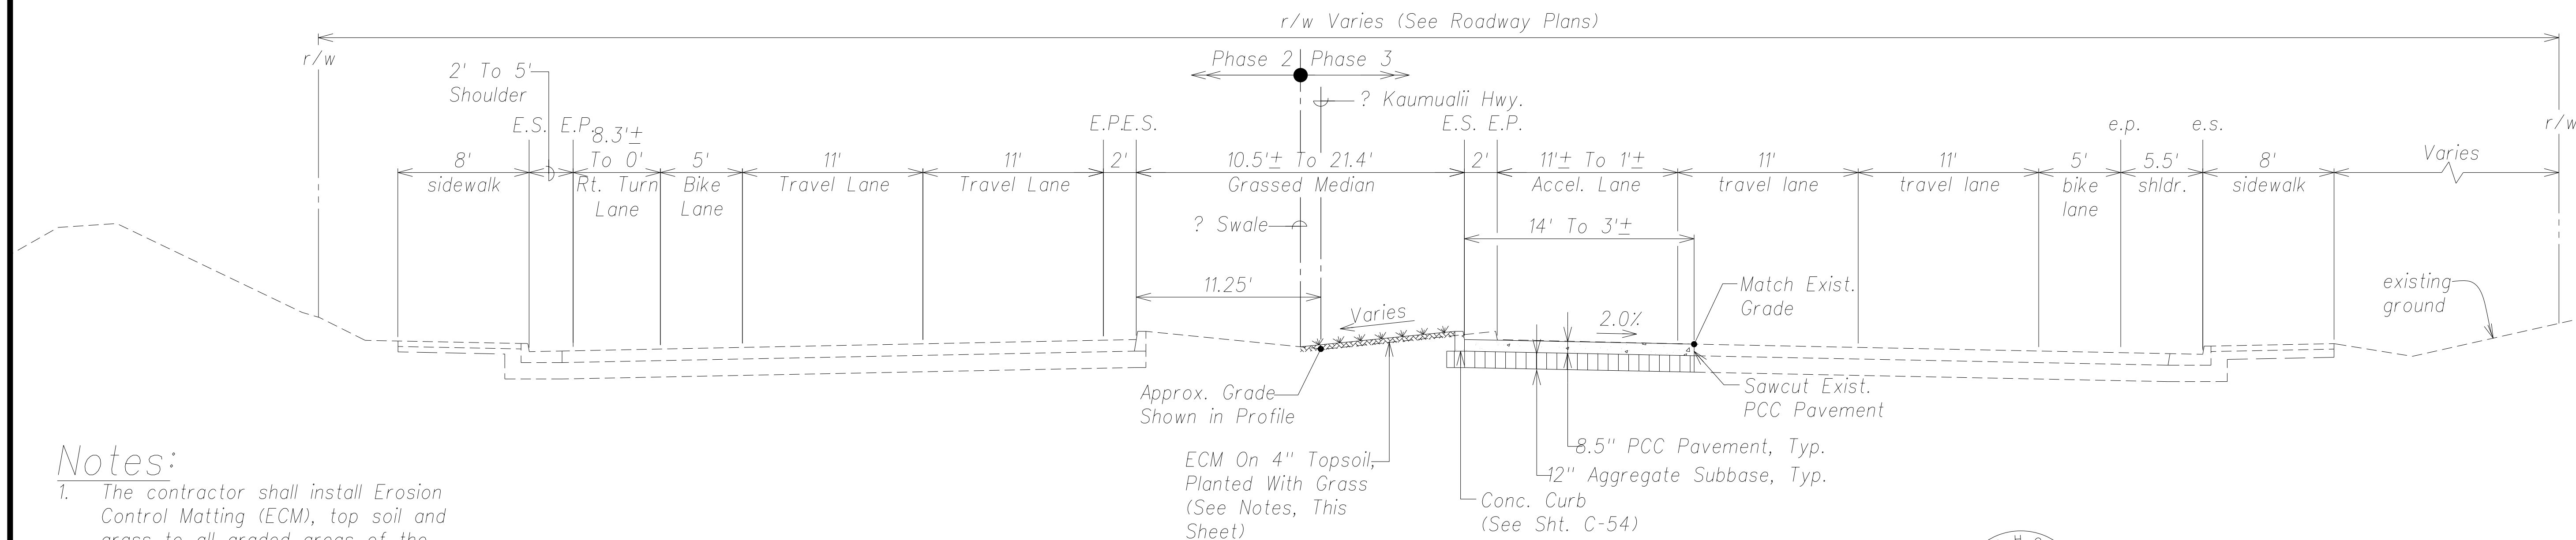

Typical Section - (Sta. 359+95.00 To Sta. 361+06±)
Scale: 1" = 5'

Notes:


1. The contractor shall install Erosion Control Matting (ECM), top soil and grass to all graded areas of the project that are to be permanent improvements, except top soil shall not be installed where slopes are 3H:1V or greater.
2. Erosion Control Matting (ECM) shall be installed per the manufacturer's recommendations.
3. See Landscaping Drawings for topsoil and planting requirements.

ORIGINAL PLAN	DATE	SURVEY PLOTTED BY	_____
		DRAWN BY	_____
NOTE BOOK	No.	DESIGNED BY	_____
		CHECKED BY	_____



THIS WORK WAS PREPARED BY ME
OR UNDER MY SUPERVISION AND
CONSTRUCTION OF THIS PROJECT
WILL BE UNDER MY OBSERVATION.

SIGNATURE _____
EXPIRATION DATE
OF THE LICENSE April 30, 2016

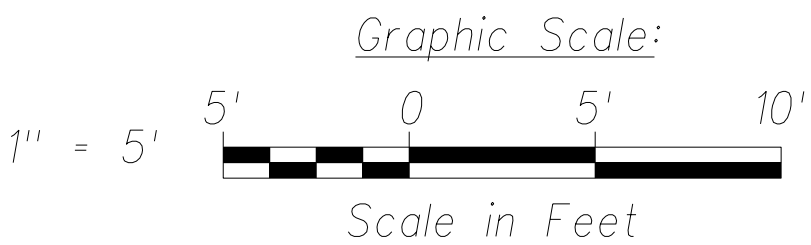

STATE OF HAWAII
DEPARTMENT OF TRANSPORTATION
HIGHWAYS DIVISION

TYPICAL SECTIONS

PHASE 1 - KAUMUALII HIGHWAY
LIHUE MILL BRIDGE TO RICE STREET

PHASE 3 - REHABILITATION OF LIHUE MILL
BRIDGE AND MAKAI WIDENING



Scale: As Shown Date: May 2, 2014

SHEET No. C-14 OF 82 SHEETS

"AS-BUILT"

Model


FED. ROAD DIST. NO.	STATE	FED. AID PROJ. NO.	FISCAL YEAR	SHEET NO.	TOTAL SHEETS
HAWAII	HAW.	ARR-050-1(036)	FY13/14	Model	141

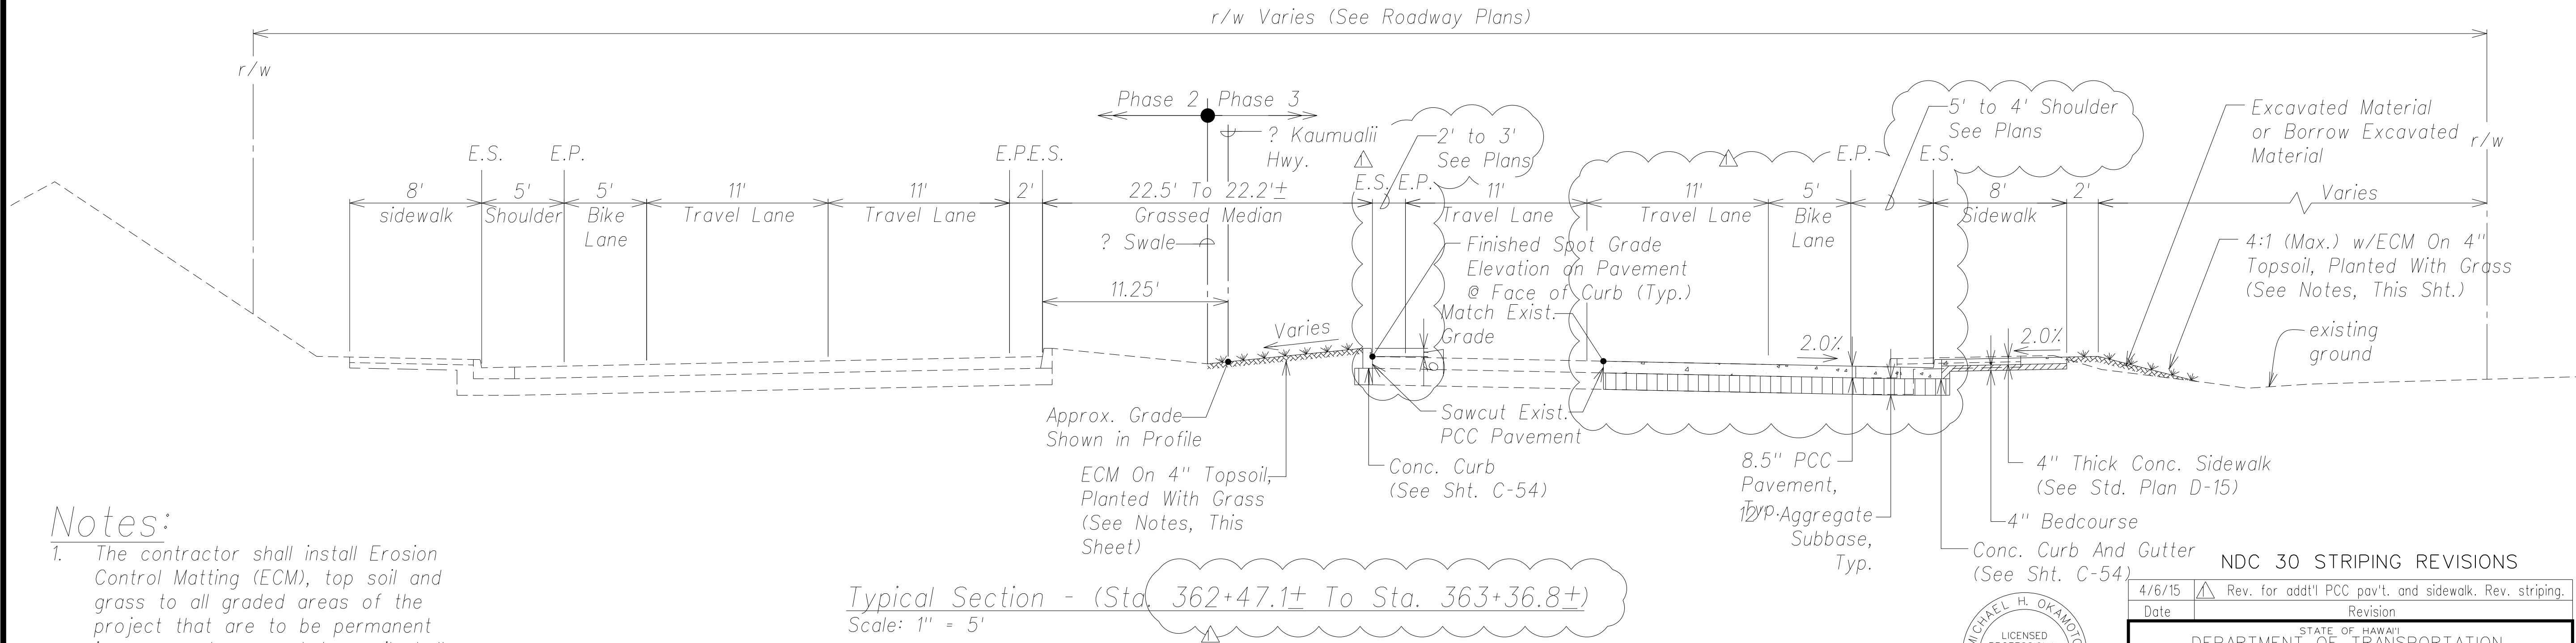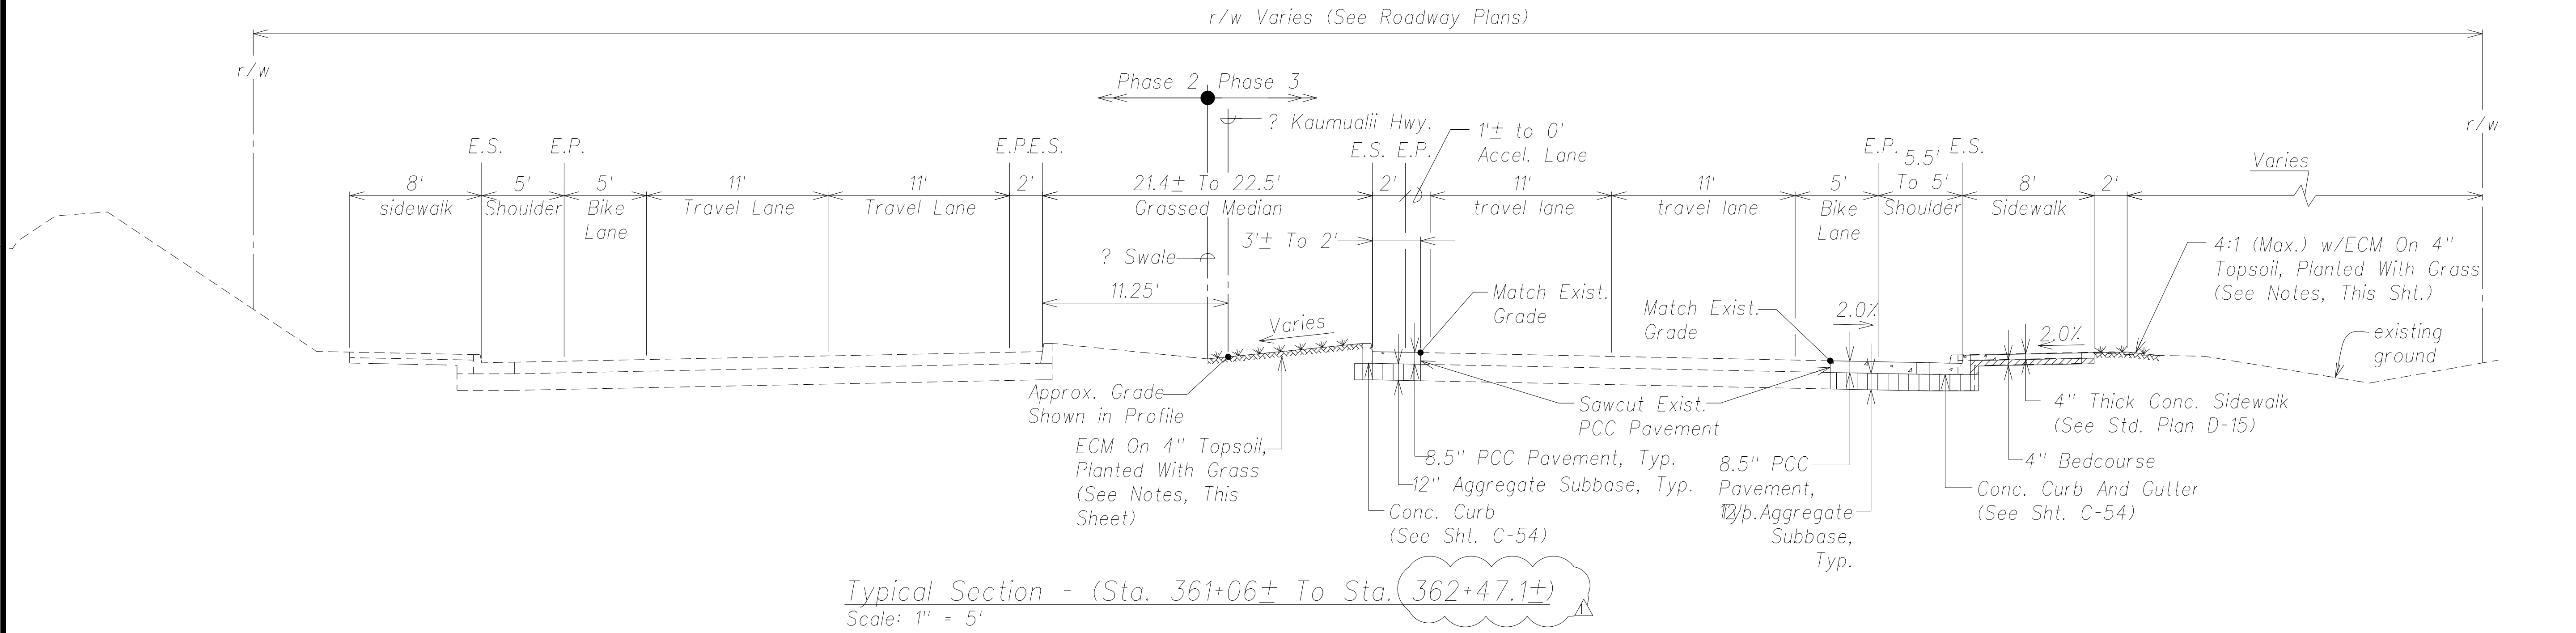

Notes:


- The contractor shall install Erosion Control Matting (ECM), top soil and grass to all graded areas of the project that are to be permanent improvements, except top soil shall not be installed where slopes are 3H:1V or greater.
- Erosion Control Matting (ECM) shall be installed per the manufacturer's recommendations.
- See Landscaping Drawings for topsoil and planting requirements.

SURVEY PLOTTED BY	DATE
DRAWN BY	
DESIGNED BY	
QUANTITIES BY	
CHECKED BY	
ORIGINAL PLAN	
NOTE BOOK	
No.	

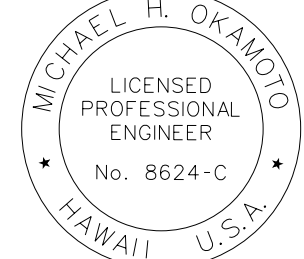

THIS WORK WAS PREPARED BY ME OR UNDER MY SUPERVISION AND CONSTRUCTION OF THIS PROJECT WILL BE UNDER MY OBSERVATION.

SIGNATURE
April 30, 2016
EXPIRATION DATE OF THE LICENSE


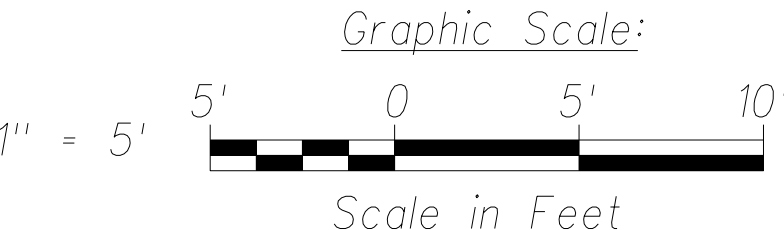


NDC 30 STRIPING REVISIONS	
4/6/15	Rev. for add'l PCC pav't. and sidewalk. Rev. striping.
Date	Revision
STATE OF HAWAII DEPARTMENT OF TRANSPORTATION HIGHWAYS DIVISION	
TYPICAL SECTIONS	
PHASE 1 - KAUMUALII HIGHWAY LIHUE MILL BRIDGE TO RICE STREET	
PHASE 3 - REHABILITATION OF LIHUE MILL BRIDGE AND MAKAI WIDENING	
Scale: As Shown	Date: May 2, 2014
SHEET No. C-15 OF 82 SHEETS	

"AS-BUILT"

C. Model S1


FED. ROAD DIST. NO.	STATE	FED. AID PROJ. NO.	FISCAL YEAR	SHEET NO.	TOTAL SHEETS
HAWAII	HAW.	ARR-050-1(K036)	FY13/14	Model	141

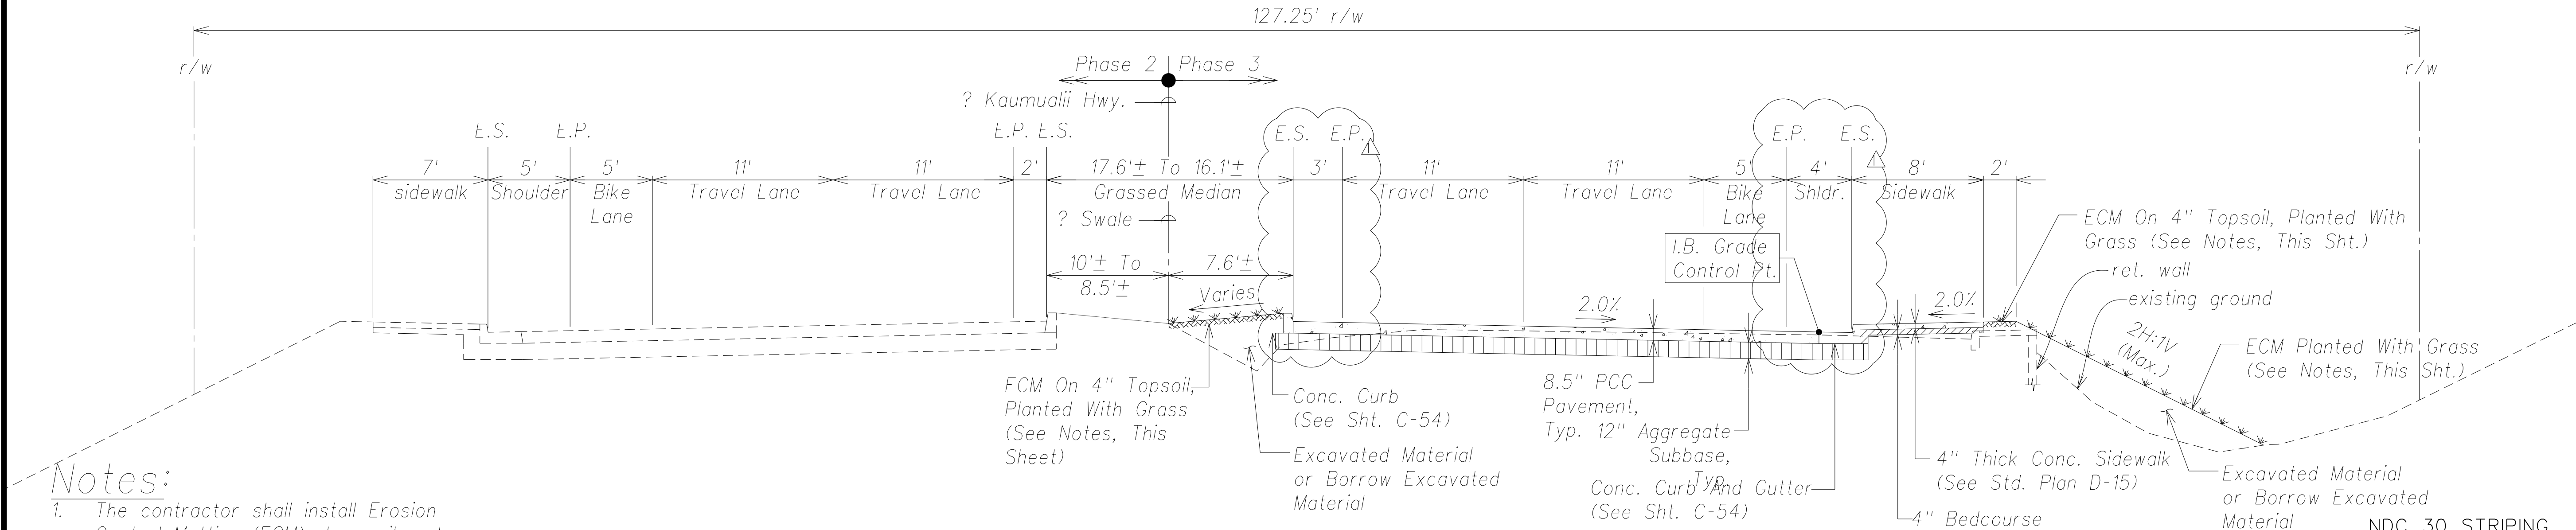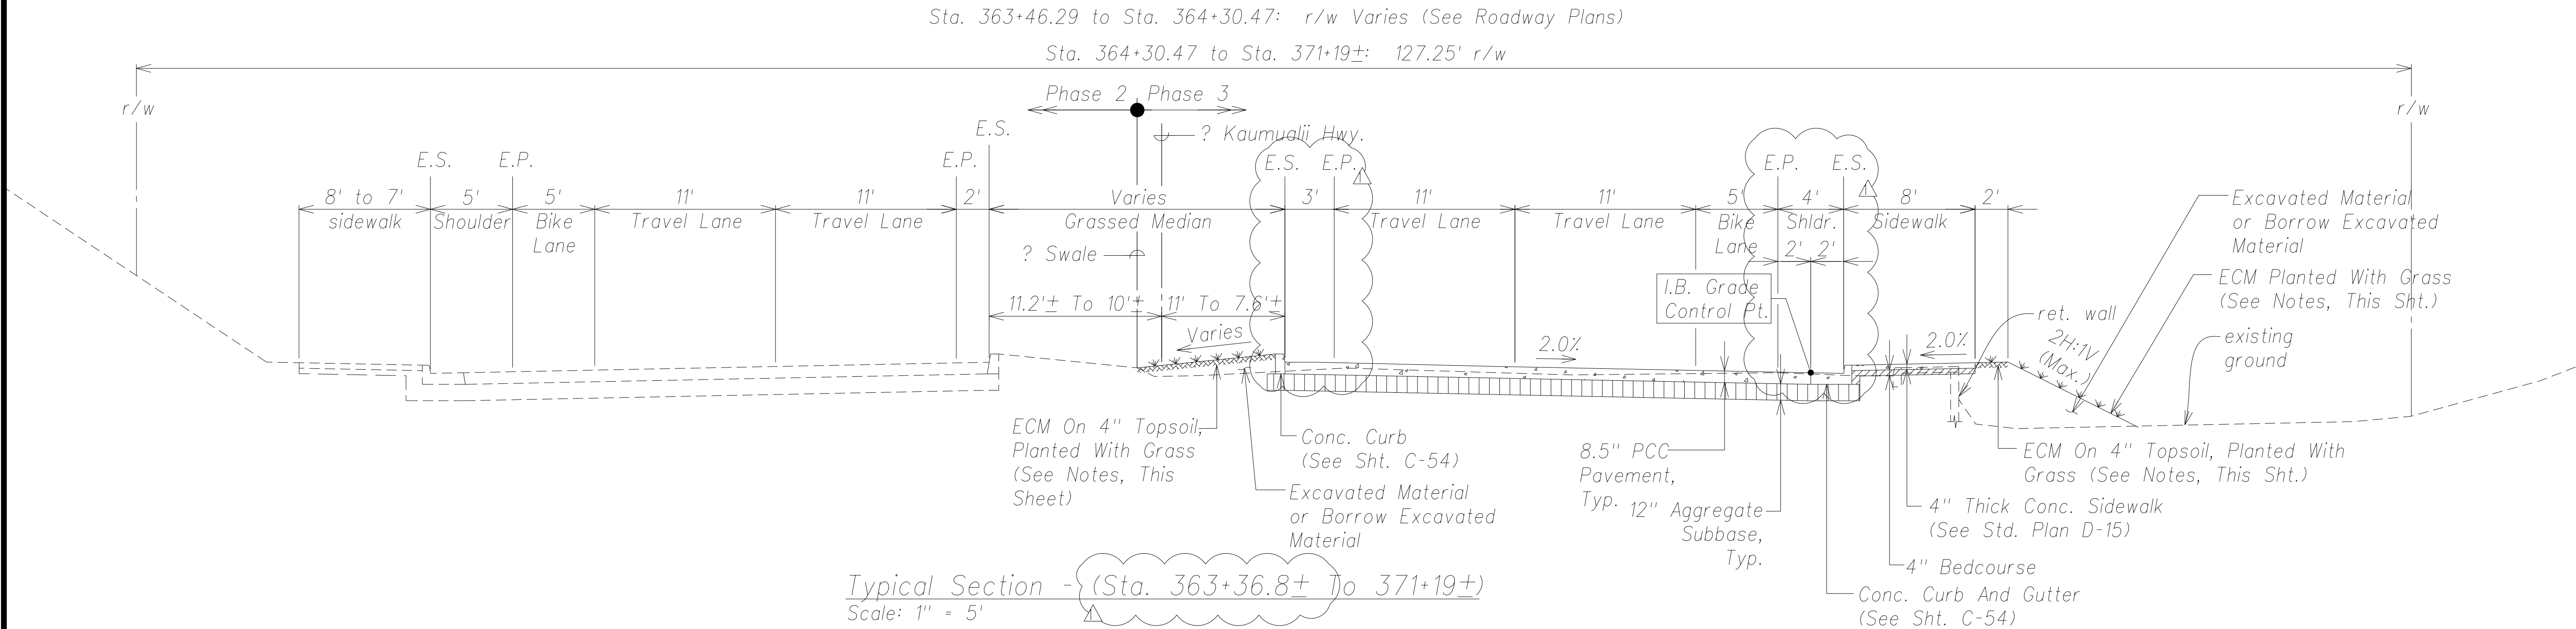

Notes:


- The contractor shall install Erosion Control Matting (ECM), top soil and grass to all graded areas of the project that are to be permanent improvements, except top soil shall not be installed where slopes are 3H:1V or greater.
- Erosion Control Matting (ECM) shall be installed per the manufacturer's recommendations.
- See Landscaping Drawings for topsoil and planting requirements.

SURVEY PLOTTED BY	DATE
DRAWN BY	
DESIGNED BY	
QUANTITIES BY	
CHECKED BY	
ORIGINAL PLAN	
NOTE BOOK	
No.	

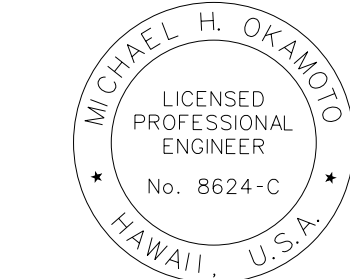

THIS WORK WAS PREPARED BY ME OR UNDER MY SUPERVISION AND CONSTRUCTION OF THIS PROJECT WILL BE UNDER MY OBSERVATION.

SIGNATURE
EXPIRATION DATE OF THE LICENSE

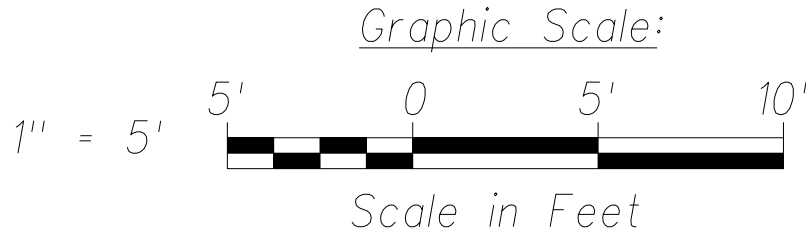

NDC 30 STRIPING REVISIONS	
4/6/15	Revise striping.
Date	Revision
DEPARTMENT OF TRANSPORTATION HIGHWAYS DIVISION	
TYPICAL SECTIONS	
PHASE 1 - KAUMUALII HIGHWAY LIHUE MILL BRIDGE TO RICE STREET	
PHASE 3 - REHABILITATION OF LIHUE MILL BRIDGE AND MAKAI WIDENING	
Scale: As Shown	Date: May 2, 2014
SHEET No. C-16 OF 82 SHEETS	

"AS-BUILT"

C.Model S1

FED. ROAD DIST. NO.	STATE	FED. AID PROJ. NO.	FISCAL YEAR	SHEET NO.	TOTAL SHEETS
HAWAII	HAW.	ARR-050-1(036)	FY13/14	Model	141

Notes:

- The contractor shall install Erosion Control Matting (ECM), top soil and grass to all graded areas of the project that are to be permanent improvements, except top soil shall not be installed where slopes are 3H:1V or greater.
- Erosion Control Matting (ECM) shall be installed per the manufacturer's recommendations.
- See Landscaping Drawings for topsoil and planting requirements.

APPROVED BY:

NDC 30 STRIPING REVISIONS

Typical Section - (Lihue Mill Bridge)
Scale: 1" = 5'

Graphic Scale:
1" = 5'

Scale in Feet

SANDWICH ISLES COMMUNICATIONS, INC.

DATE

4/6/15

Revise striping.

STATE OF HAWAII
DEPARTMENT OF TRANSPORTATION
HIGHWAYS DIVISION

TYPICAL SECTIONS

PHASE 1 - KAUMUALII HIGHWAY
LIHUE MILL BRIDGE TO RICE STREET

PHASE 3 - REHABILITATION OF LIHUE MILL
BRIDGE AND MAKAI WIDENING

Scale: As Shown Date: May 2, 2014

SHEET No. C-17 OF 82 SHEETS



File: C:\Users\scinibh\S\Desktop\Growing1.docx saved April 7 2016

ORIGINAL PLAN	SURVEY PLOTTED BY _____ DATE _____
NOTE BOOK	DRAWN BY _____
	TRACED BY _____
	DESIGNED BY _____
	QUANTITIES BY _____
No. _____	CHECKED BY _____

"AS-BUILT"

C.Model | S1

FED. ROAD DIST. NO.	STATE	FED. AID PROJ. NO.	FISCAL YEAR	SHEET NO.	TOTAL SHEETS
HAWAII	HAW.	ARR-050-1(036)	FY13/14	Model	141

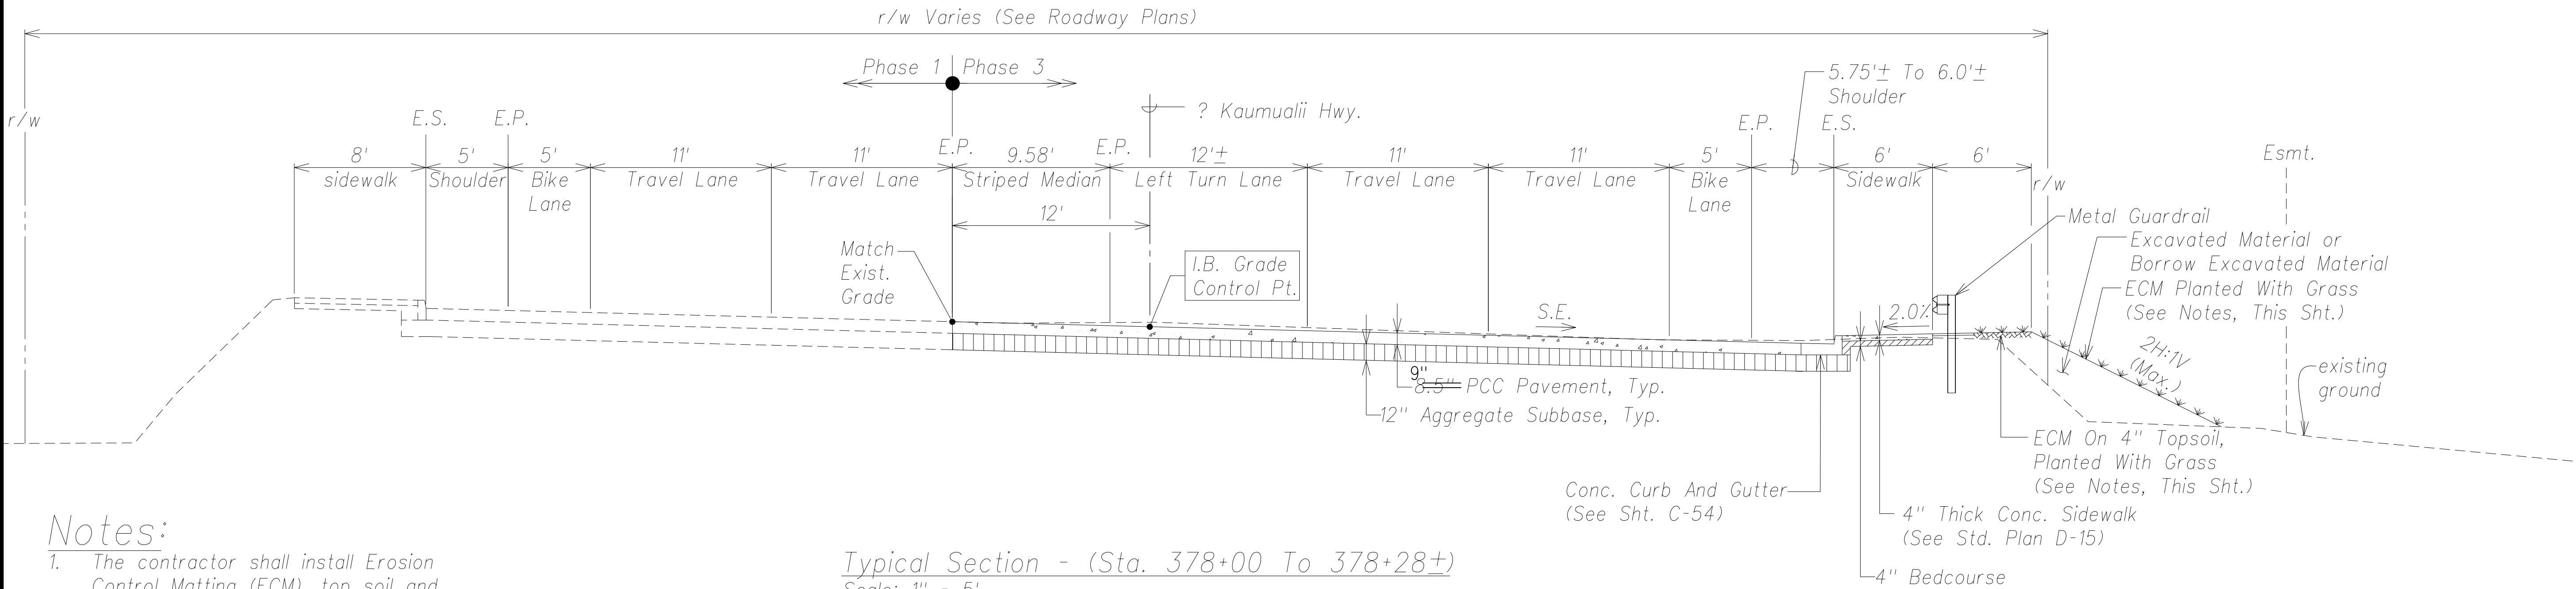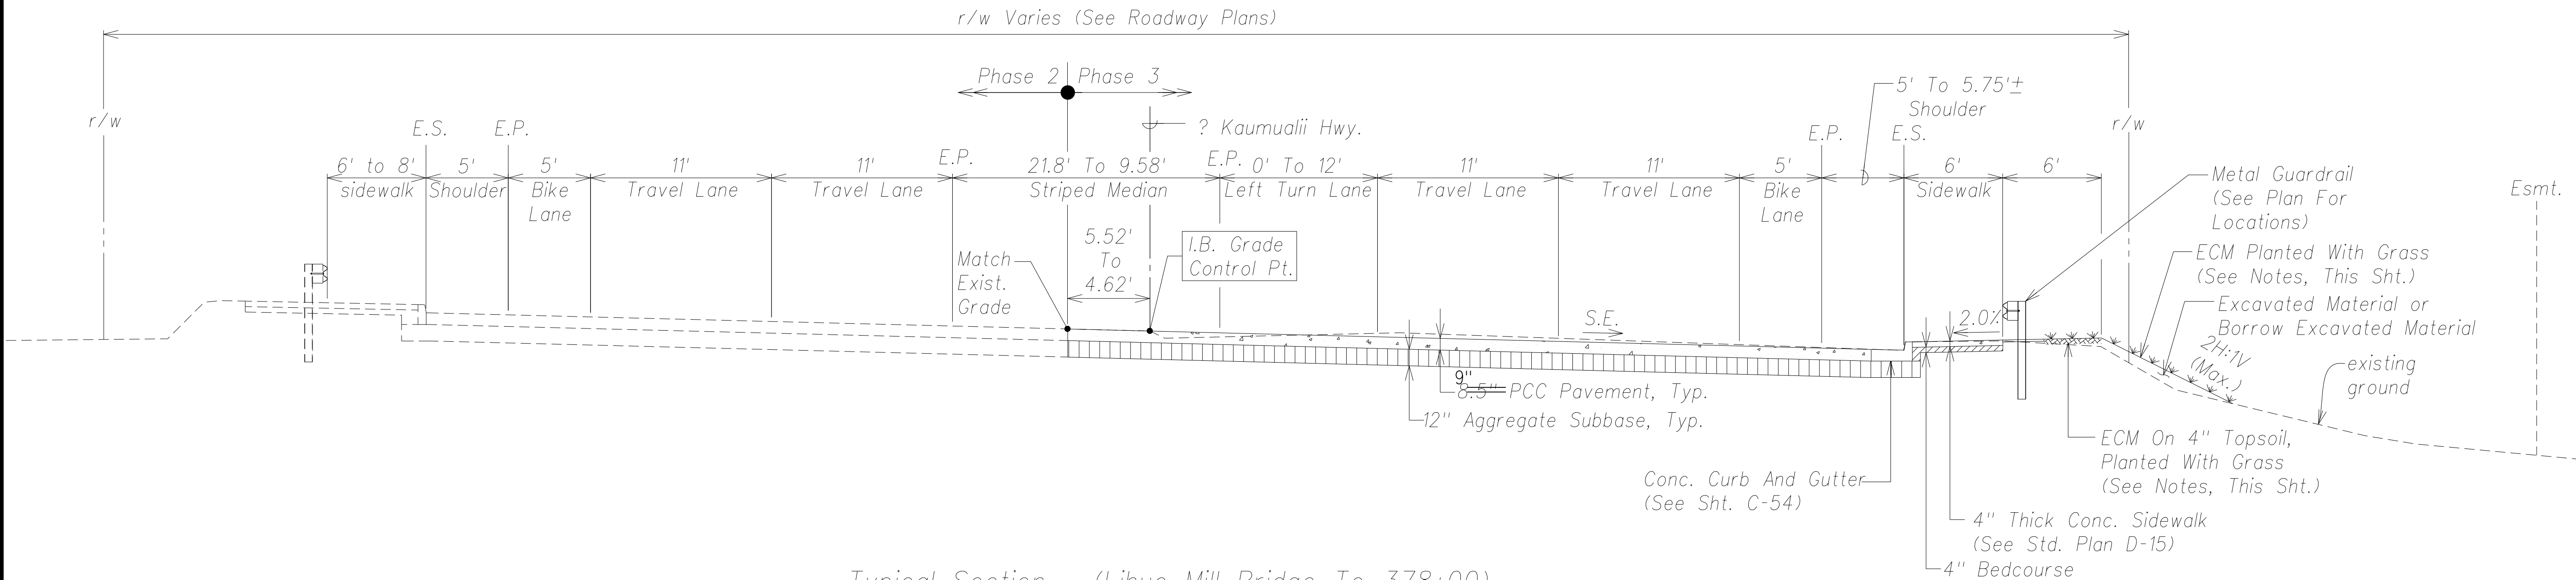


Notes:

- The contractor shall install Erosion Control Matting (ECM), top soil and grass to all graded areas of the project that are to be permanent improvements, except top soil shall not be installed where slopes are 3H:1V or greater.
- Erosion Control Matting (ECM) shall be installed per the manufacturer's recommendations.
- See Landscaping Drawings for topsoil and planting requirements.

LEGEND FOR AS-BUILT POSTINGS

- ~~~~~ Squiggly line for as-built deletion
~~100.00~~ Double line for as-built deletion
Roadway Text for as-built posting

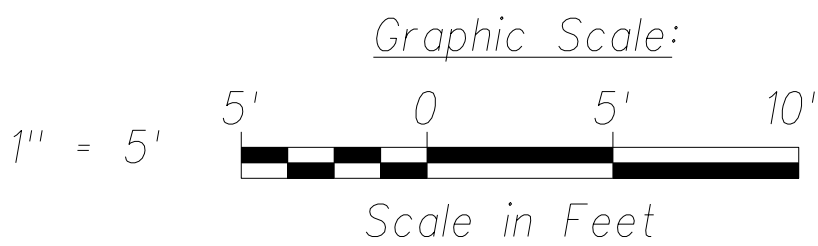

THIS WORK WAS PREPARED BY ME OR UNDER MY SUPERVISION AND CONSTRUCTION OF THIS PROJECT WILL BE UNDER MY OBSERVATION.

SIGNATURE
April 30, 2016
EXPIRATION DATE OF THE LICENSE

STATE OF HAWAII
DEPARTMENT OF TRANSPORTATION
HIGHWAYS DIVISION

TYPICAL SECTIONS


PHASE 1 - KAUMUALII HIGHWAY
LIHUE MILL BRIDGE TO RICE STREET
PHASE 3 - REHABILITATION OF LIHUE MILL
BRIDGE AND MAKAI WIDENING

Scale: As Shown Date: May 2, 2014
SHEET No. C-18 OF 82 SHEETS


"AS-BUILT"

Model

FED. ROAD DIST. NO.	STATE	FED. AID PROJ. NO.	FISCAL YEAR	SHEET NO.	TOTAL SHEETS
HAWAII	HAW.	ARR-050-1(036)	FY13/14	Model	141

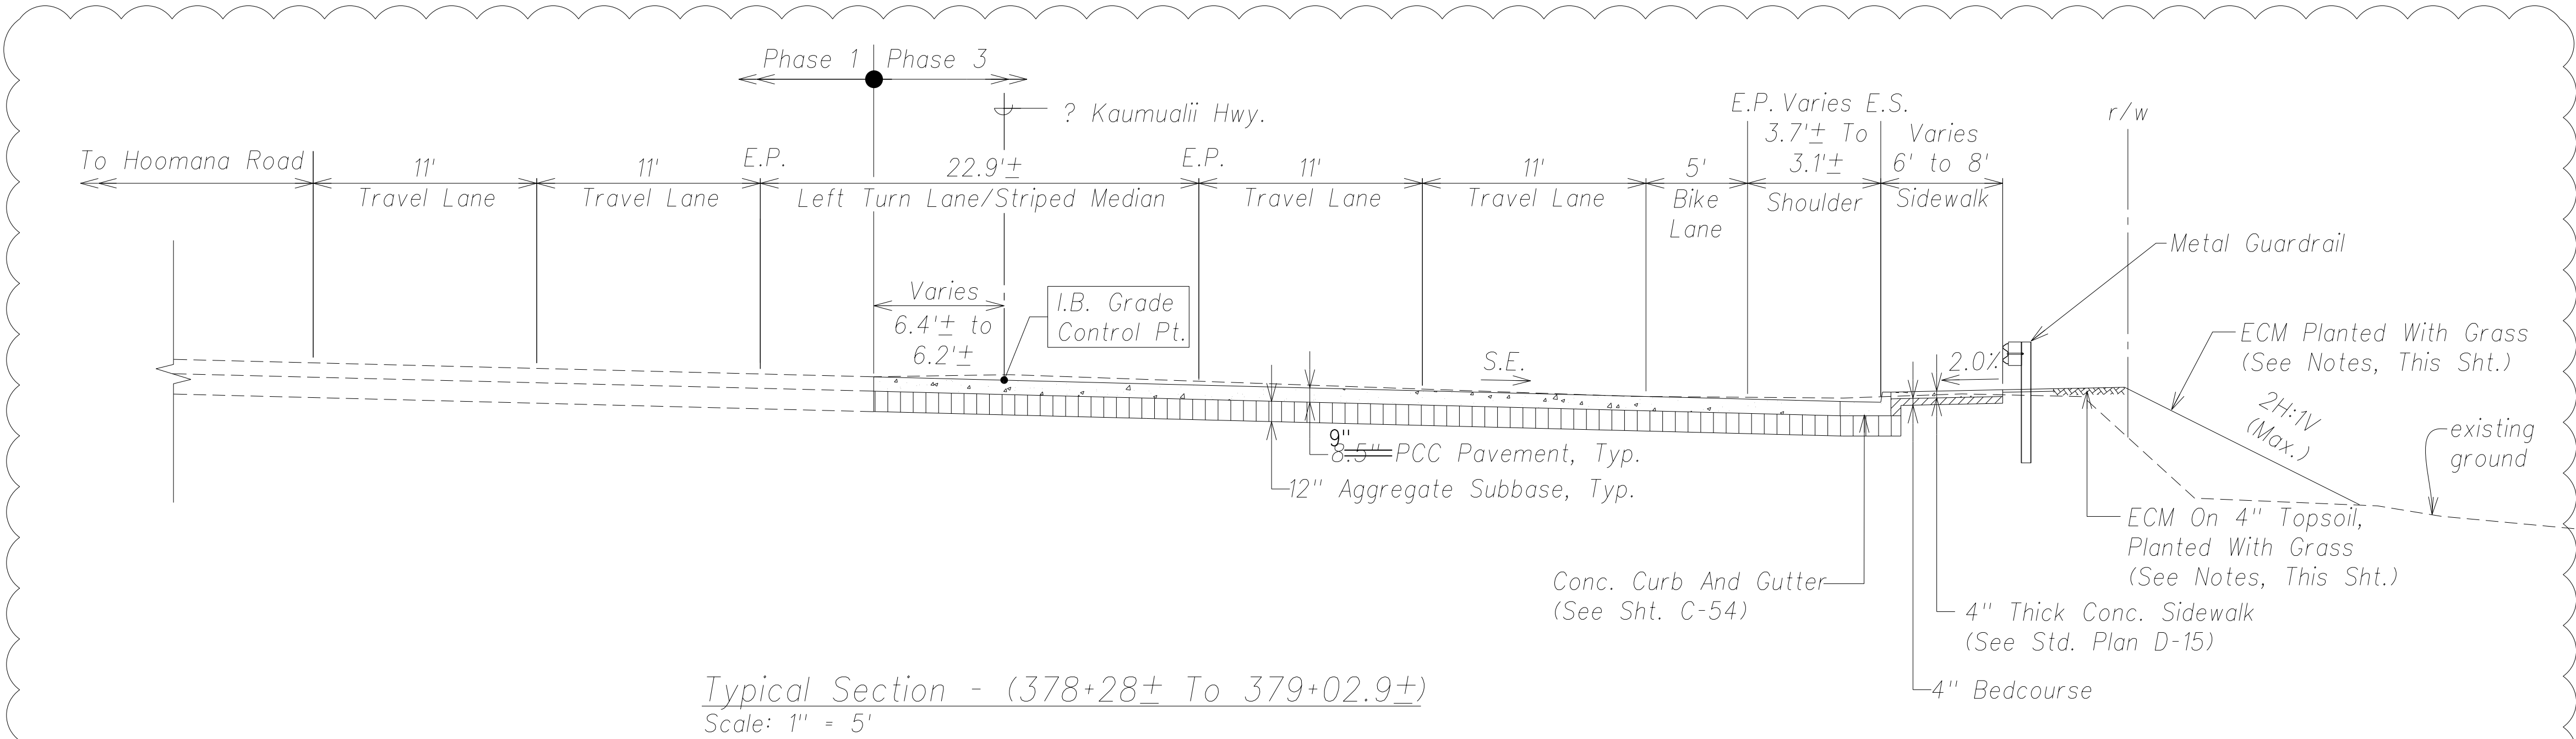


Typical Section - (378+28± To 379+02.9±)
Scale: 1" = 5'

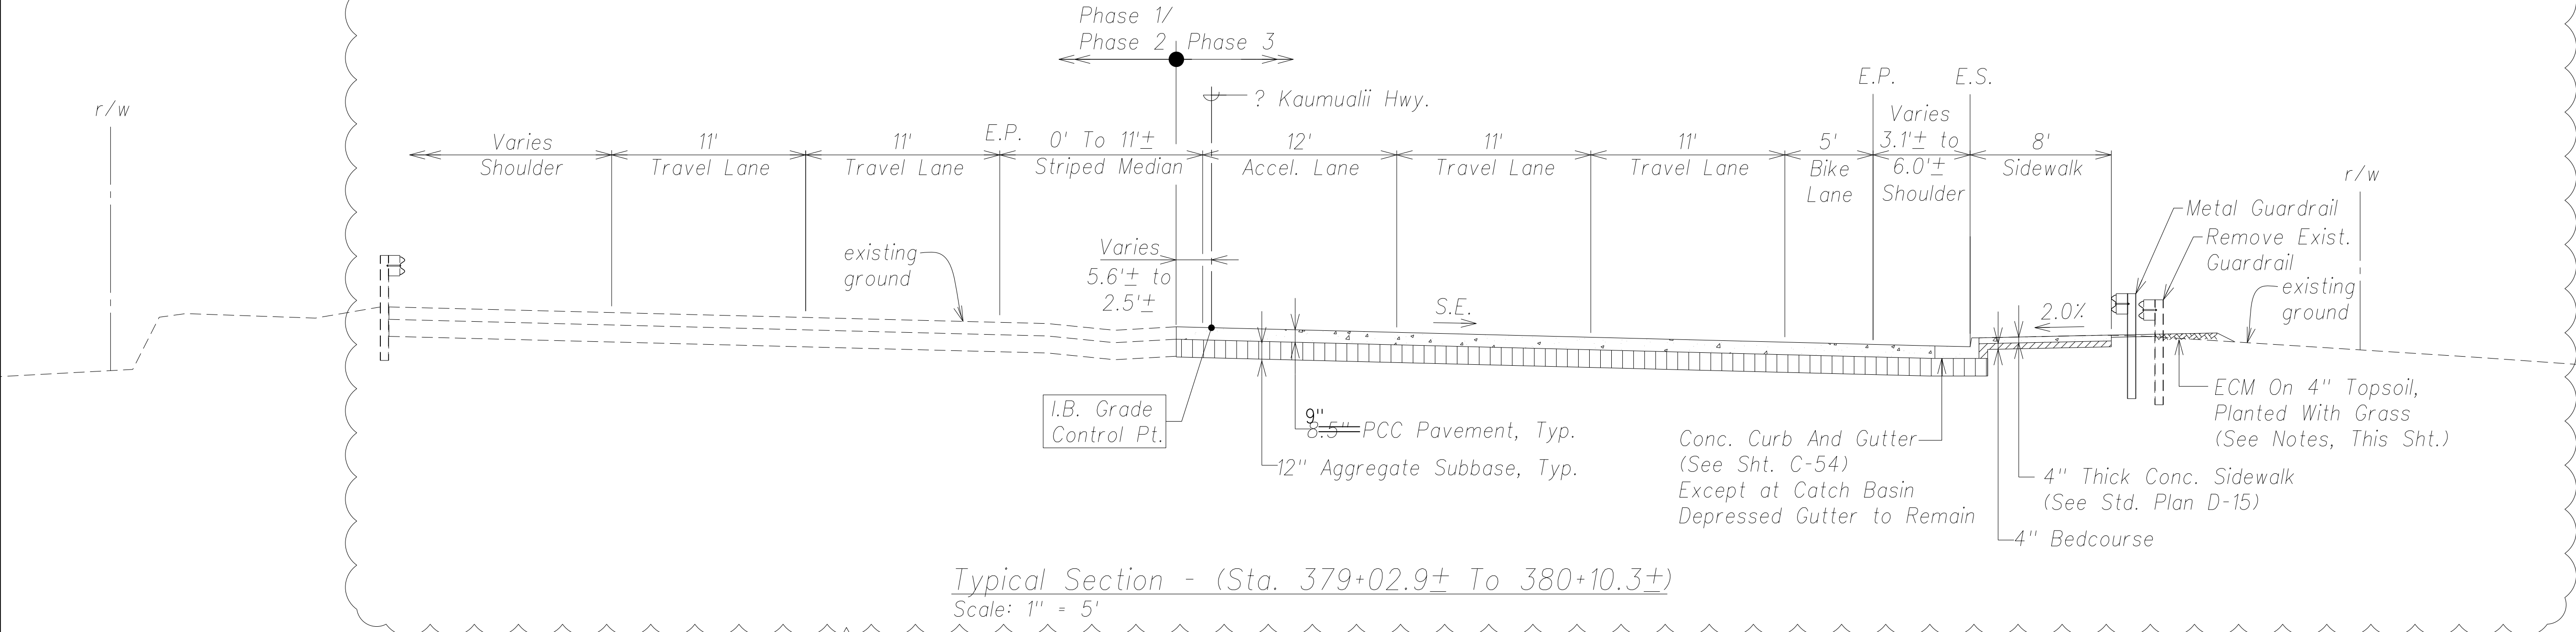


Typical Section - (Sta. 379+02.9± To 380+10.3±)
Scale: 1" = 5'

ORIGINAL PLAN	SURVEY PLOTTED BY	DATE
	DESIGNED BY	
	NOTED BY	
	CHECKED BY	

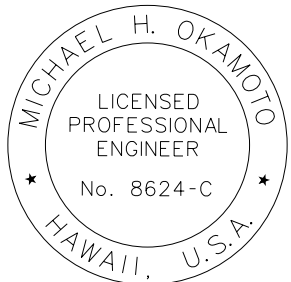

THIS WORK WAS PREPARED BY ME OR UNDER MY SUPERVISION AND CONSTRUCTION OF THIS PROJECT WILL BE UNDER MY OBSERVATION.

SIGNATURE _____
APRIL 30, 2016
EXPIRATION DATE OF THE LICENSE

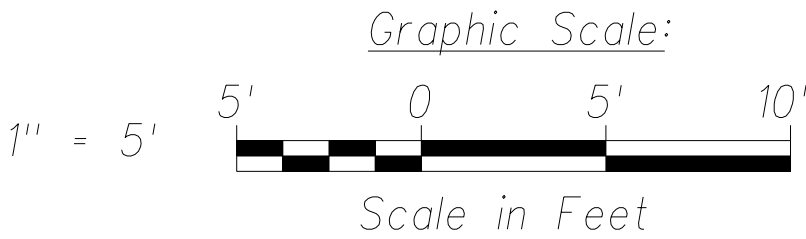

4/6/15	Revise for additional PCC pavement and sidewalk work
Date	Revision

STATE OF HAWAII
DEPARTMENT OF TRANSPORTATION
HIGHWAYS DIVISION

TYPICAL SECTIONS

PHASE 1 - KAUMUALII HIGHWAY
LIHUE MILL BRIDGE TO RICE STREET

PHASE 3 - REHABILITATION OF LIHUE MILL
BRIDGE AND MAKAI WIDENING


Scale: As Shown Date: May 2, 2014

SHEET No. C-19 OF 82 SHEETS

"AS-BUILT"


C. Model S1

FED. ROAD DIST. NO.	STATE	FED. AID PROJ. NO.	FISCAL YEAR	SHEET NO.	TOTAL SHEETS
HAWAII	HAW.	ARR-050-1(0.36)	FY13/14	Model	141

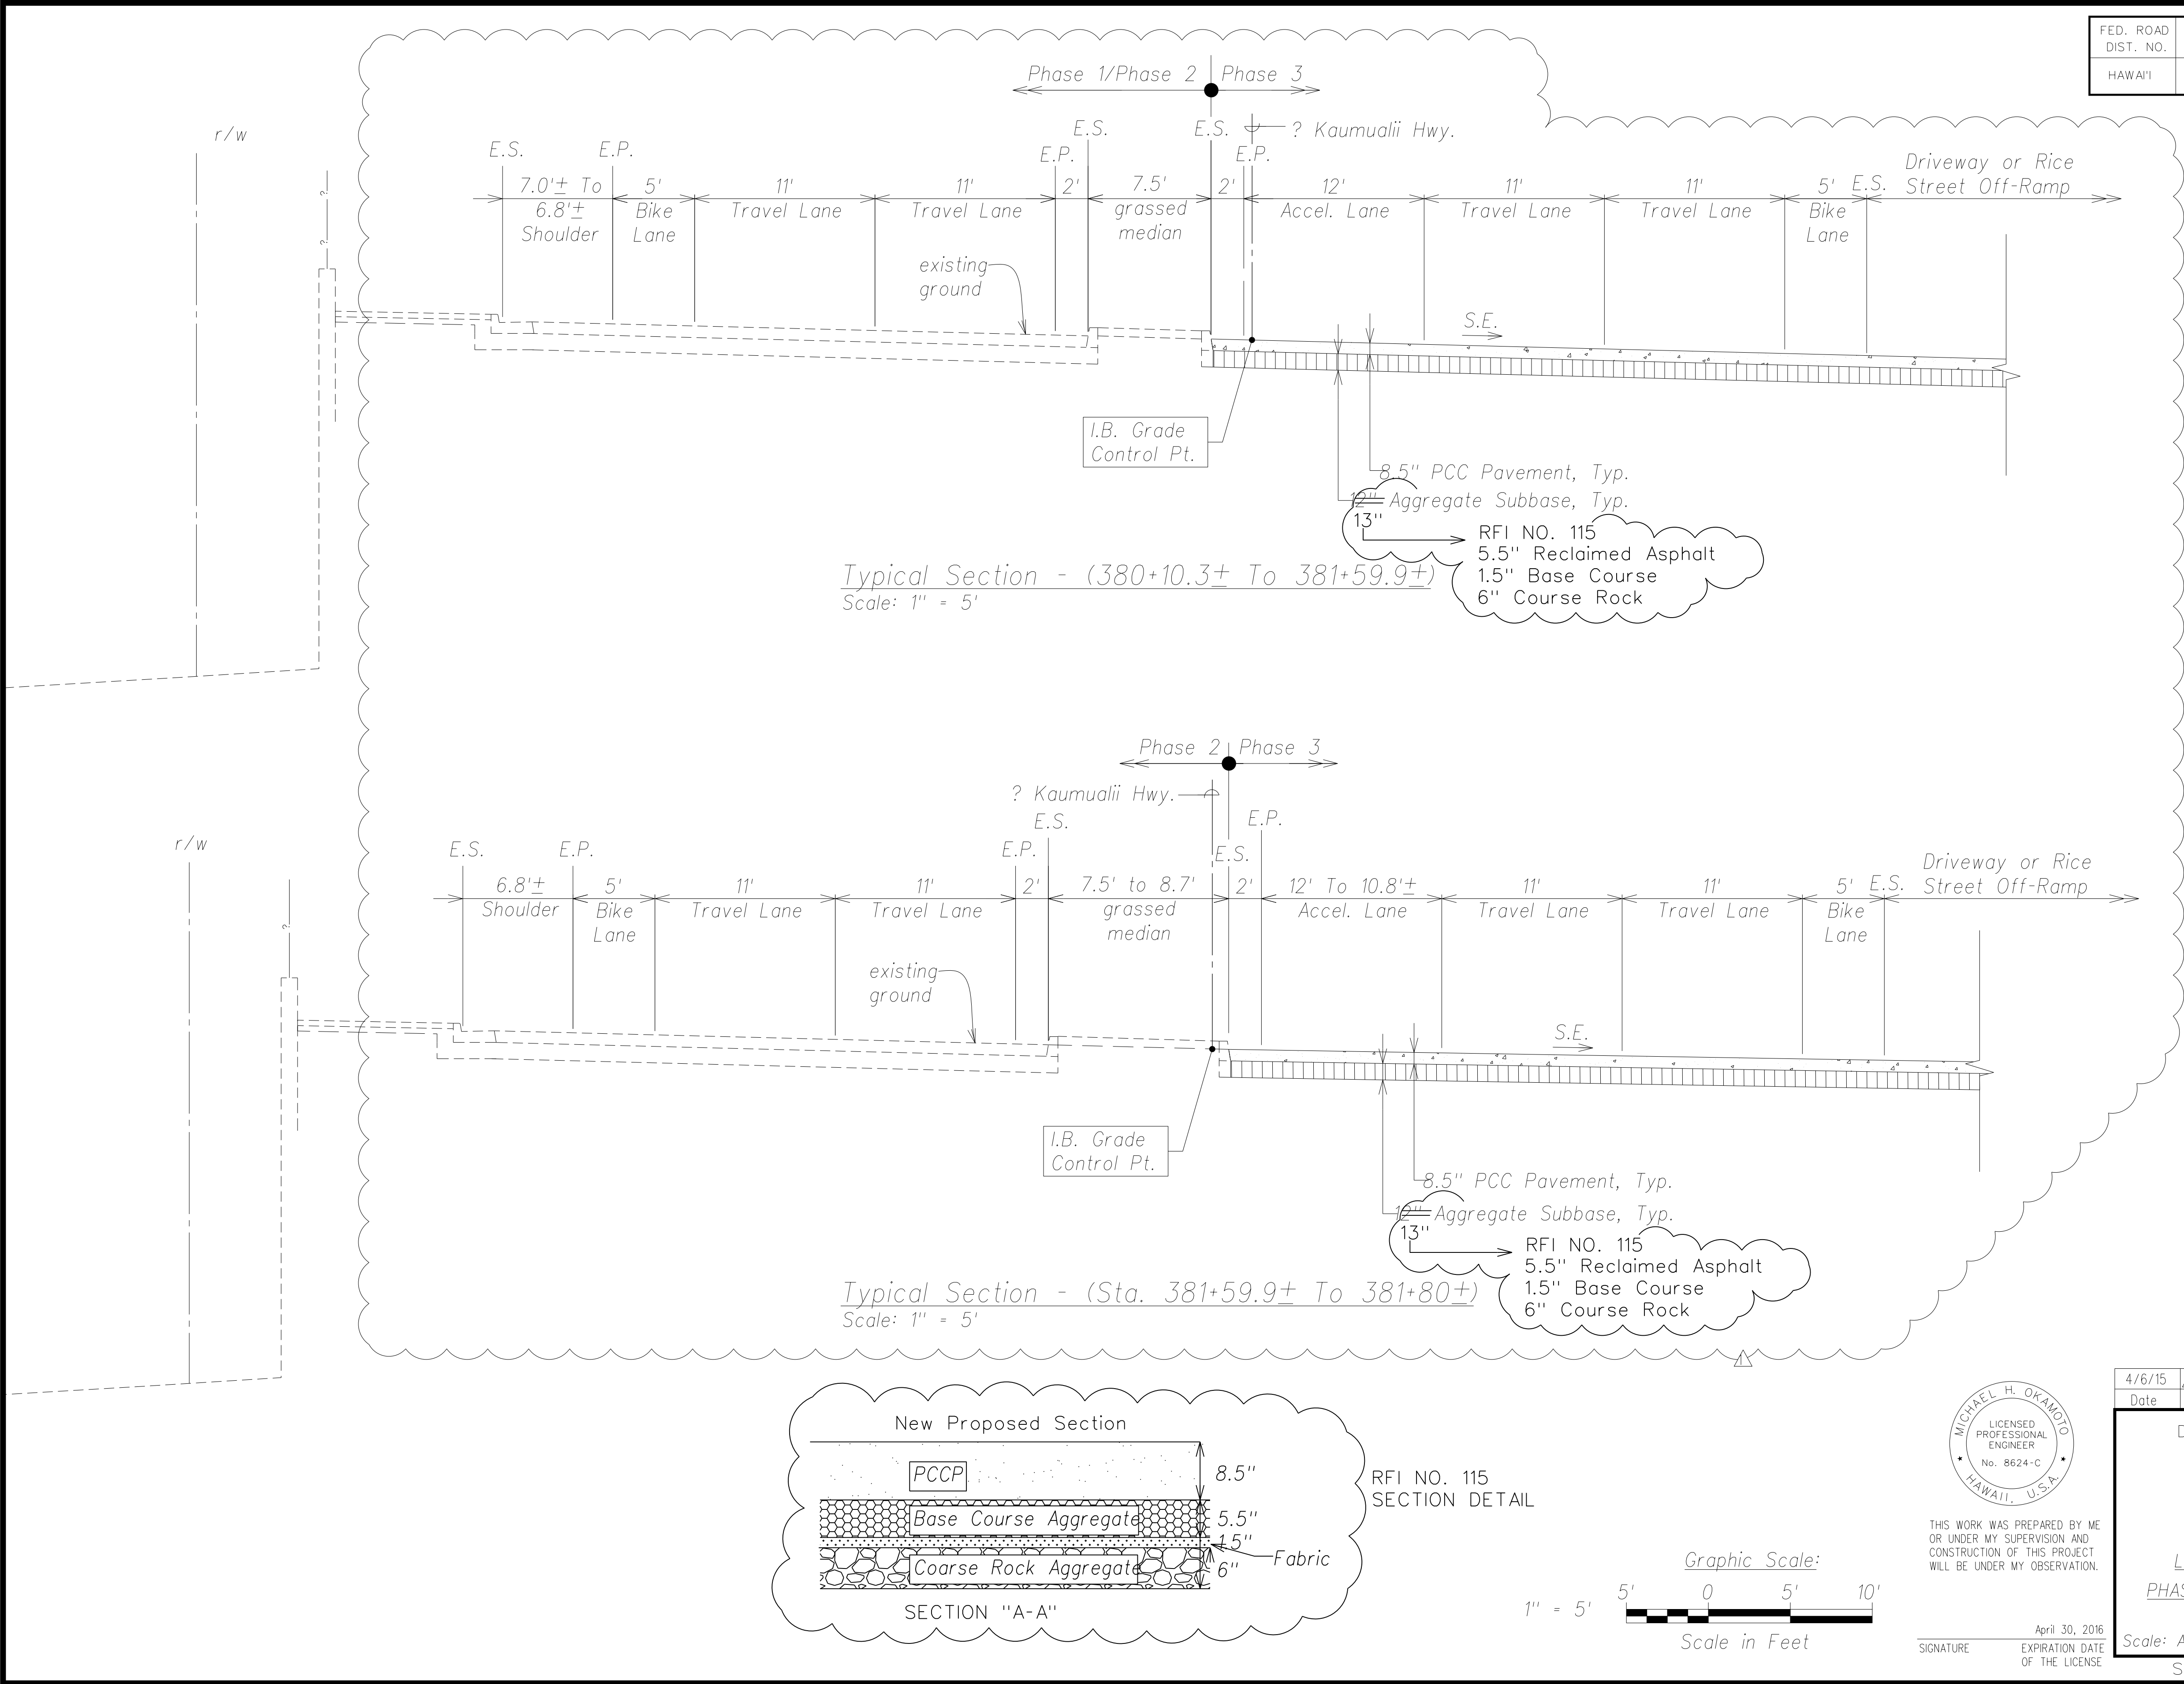

SURVEY PLOTTED BY	DATE
DRAWN BY	
CHECKED BY	
QUANTITIES BY	
CHECKED BY	
ORIGINAL PLAN	
NOTE BOOK	
No.	

LEGEND FOR AS-BUILT POSTINGS	
	Squiggly line for as-built deletion
	Double line for as-built deletion
Roadway	Text for as-built posting

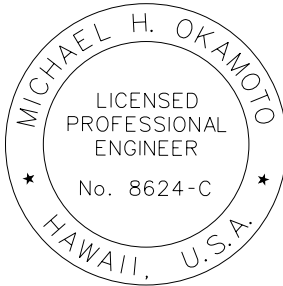

THIS WORK WAS PREPARED BY ME OR UNDER MY SUPERVISION AND CONSTRUCTION OF THIS PROJECT WILL BE UNDER MY OBSERVATION.

SIGNATURE
APRIL 30, 2016
EXPIRATION DATE OF THE LICENSE


4/6/15	Revise for additional PCC pavement and work
Date	Revision
STATE OF HAWAII DEPARTMENT OF TRANSPORTATION HIGHWAYS DIVISION	
TYPICAL SECTIONS	
PHASE 1 - KAUMUALII HIGHWAY LIHUE MILL BRIDGE TO RICE STREET	
PHASE 3 - REHABILITATION OF LIHUE MILL BRIDGE AND MAKAI WIDENING	
Scale: As Shown	Date: May 2, 2014
SHEET No. C-20 OF 82 SHEETS	

"AS-BUILT"

C. Model S1


FED. ROAD DIST. NO.	STATE	FED. AID PROJ. NO.	FISCAL YEAR	SHEET NO.	TOTAL SHEETS
HAWAII	HAW.	ARR-050-1(036)	FY13/14	Model	141

r/w


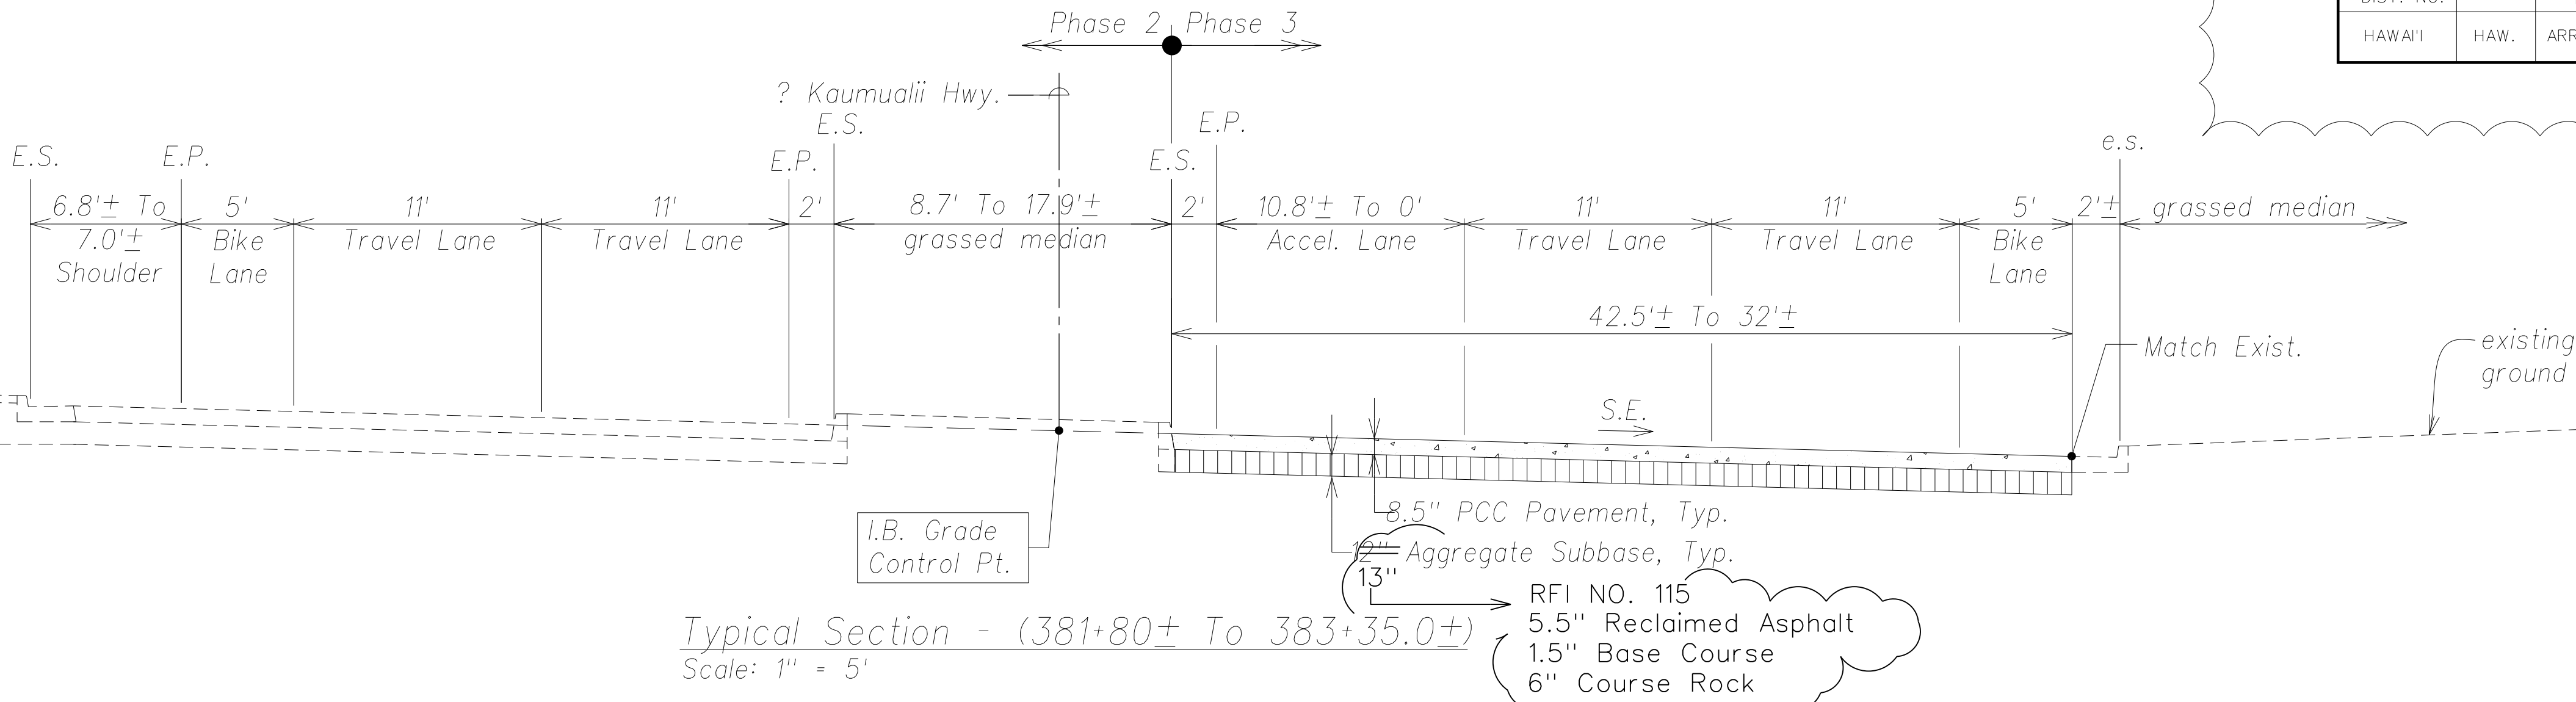


LEGEND FOR AS-BUILT POSTINGS	
	Squiggly line for as-built deletion
	Double line for as-built deletion
	Text for as-built posting

r/w

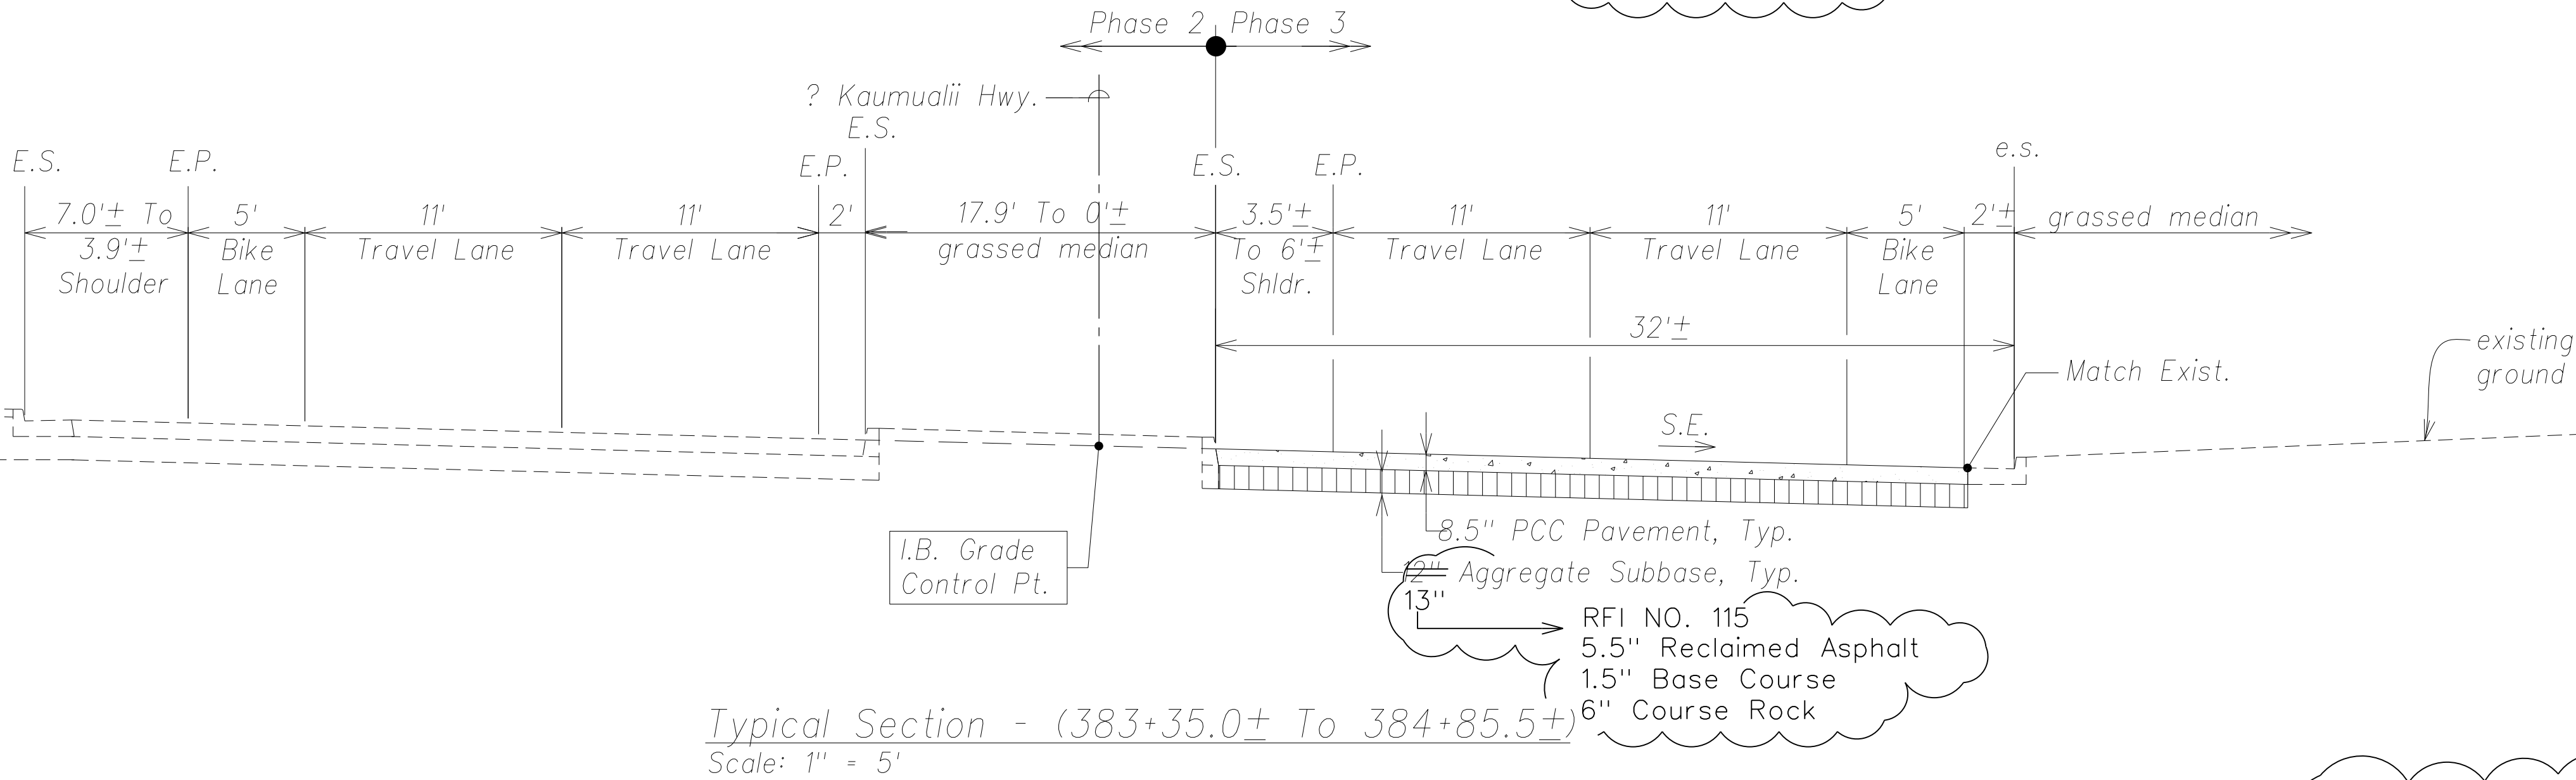


RFI NO. 115
SECTION DETAIL

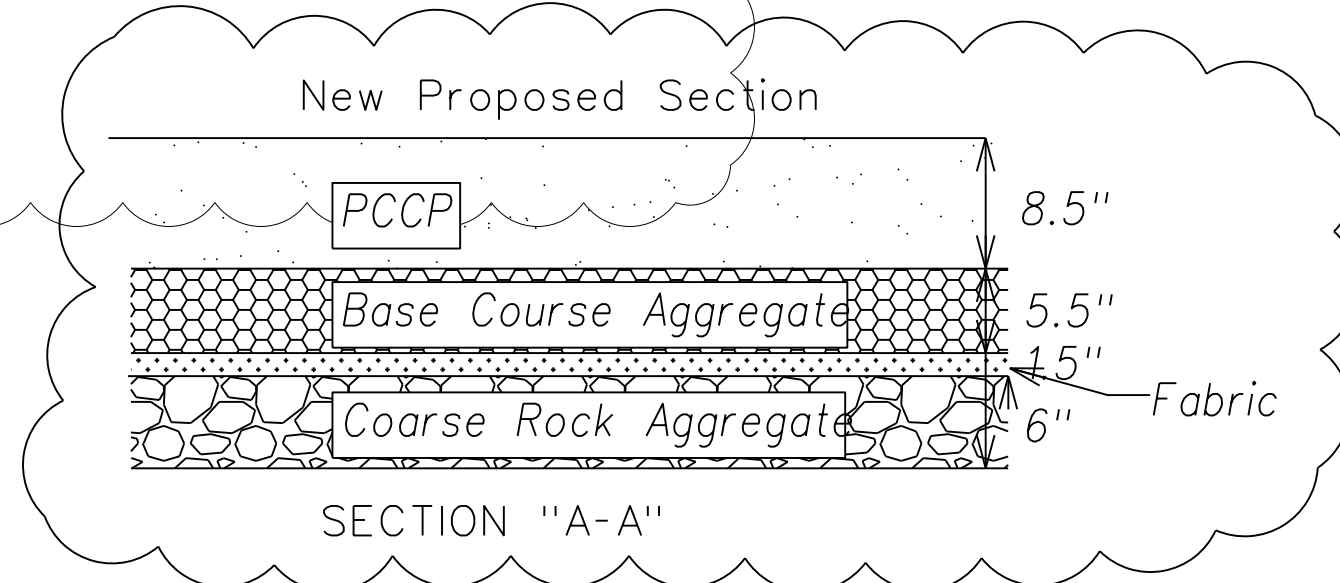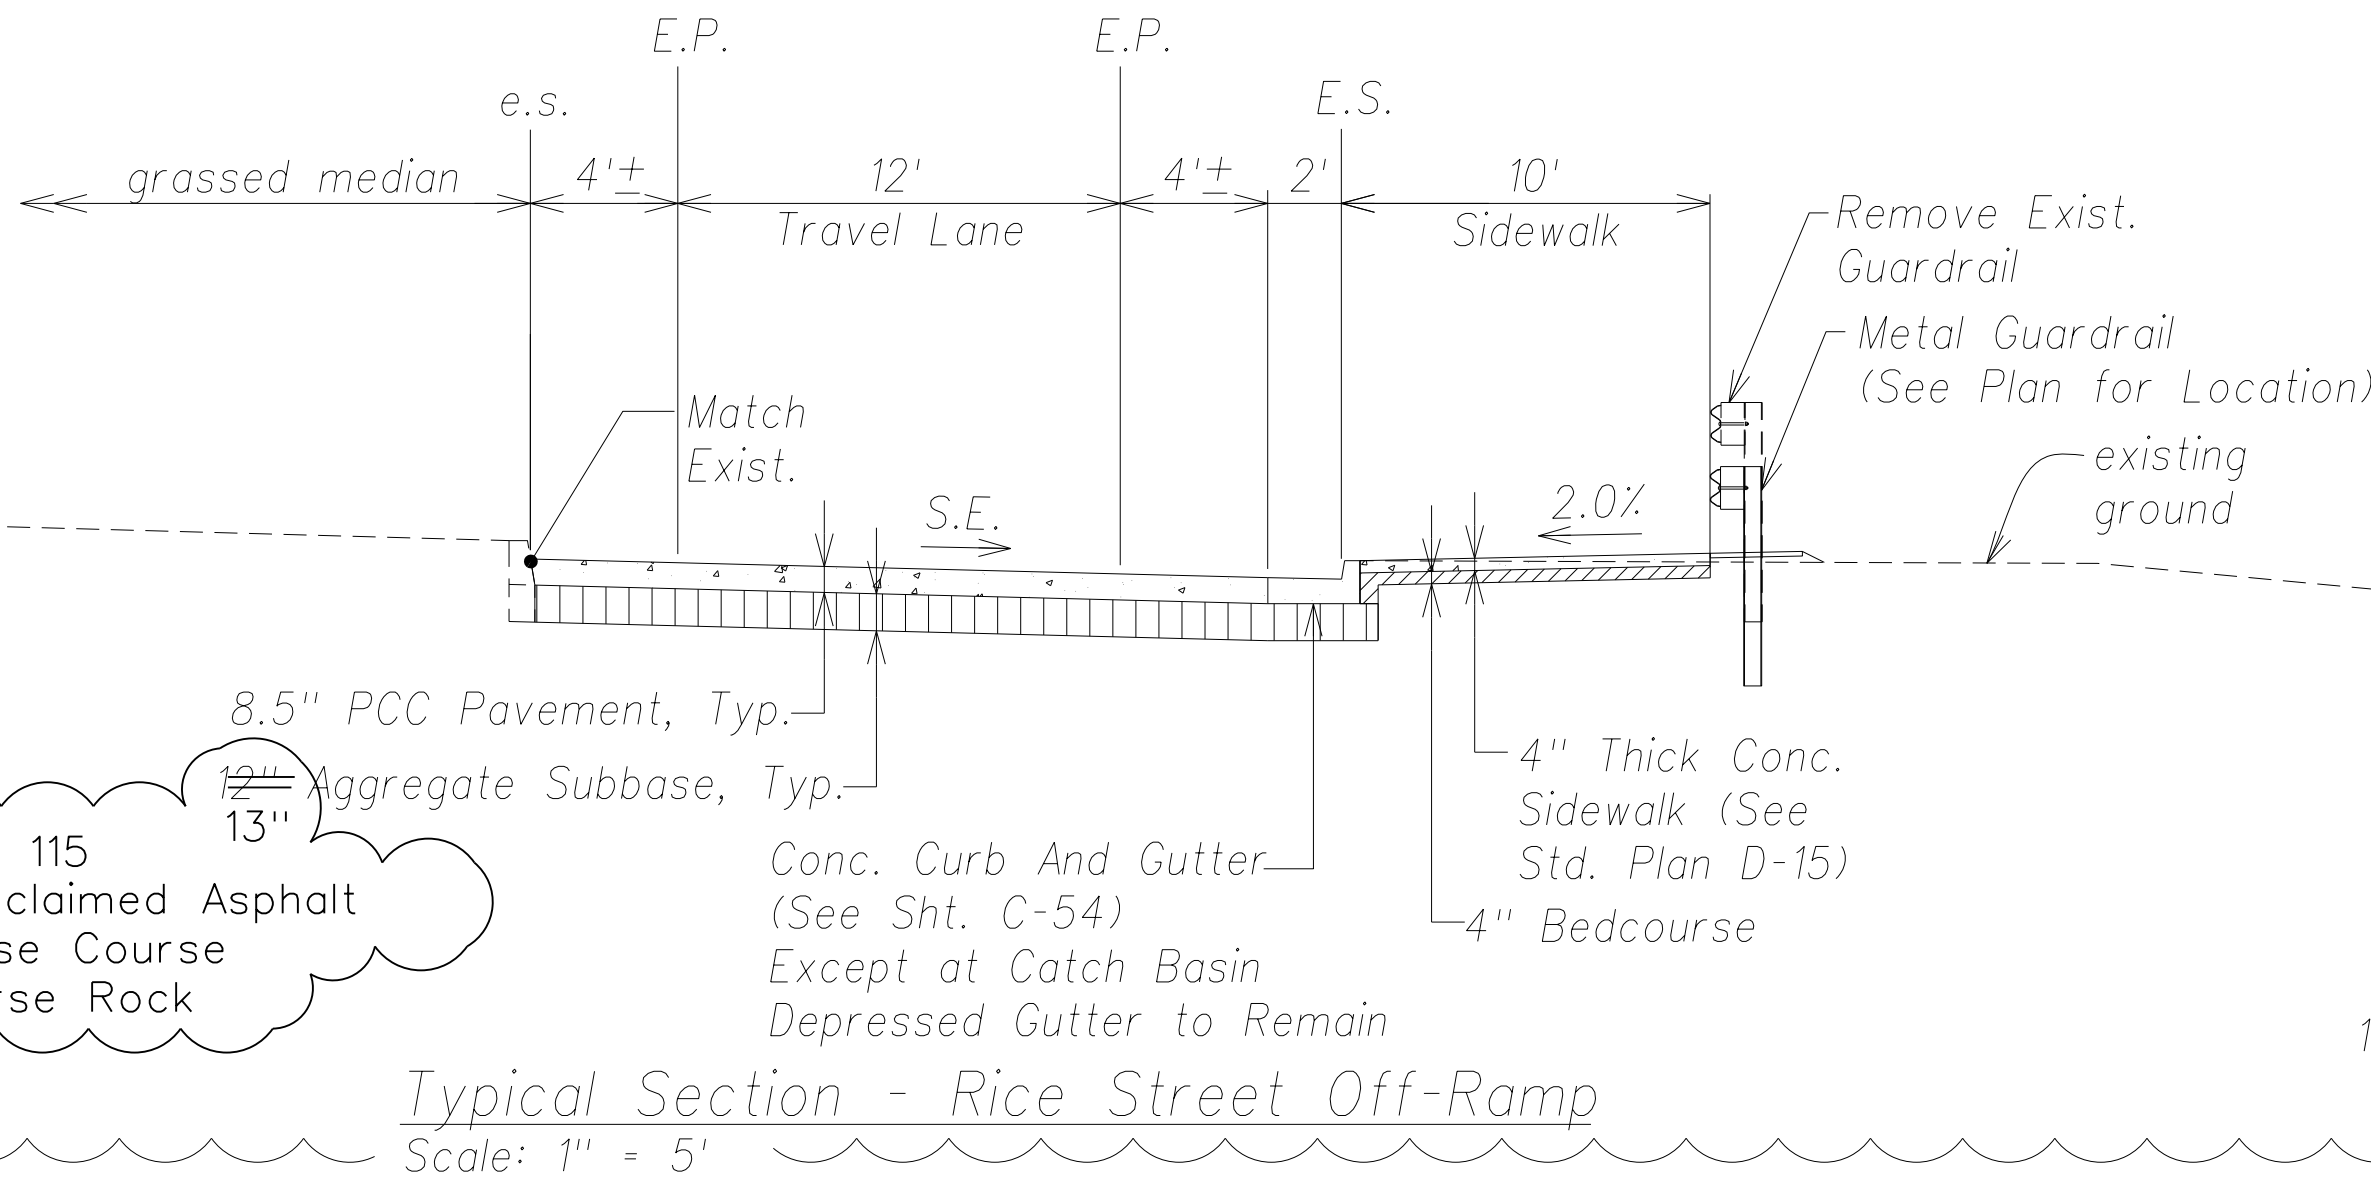

THIS WORK WAS PREPARED BY ME OR UNDER MY SUPERVISION AND CONSTRUCTION OF THIS PROJECT WILL BE UNDER MY OBSERVATION.

SIGNATURE Date: April 30, 2016
EXPIRATION DATE OF THE LICENSE

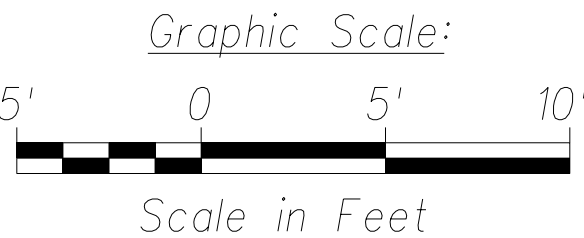

4/6/15	Revise for additional PCC pavement and sidewalk work
Date	Revision
STATE OF HAWAII DEPARTMENT OF TRANSPORTATION HIGHWAYS DIVISION	
TYPICAL SECTIONS	
PHASE 1 - KAUMUALII HIGHWAY LIHUE MILL BRIDGE TO RICE STREET	
PHASE 3 - REHABILITATION OF LIHUE MILL BRIDGE AND MAKAI WIDENING	
Scale: As Shown	Date: May 2, 2014
SHEET No. C-21 OF 82 SHEETS	

SURVEY PLOTTED BY	DATE
DRAWN BY	
DESIGNED BY	
NOTED BY	
CHECKED BY	
ORIGINAL PLAN	No.

"AS-BUILT"

C. Model S1