

SHEET NO.	INDEX TO DRAWINGS	REF. SHTS.	
	DESCRIPTION	FROM	TO
1	TITLE SHEET	T-1	T-1
2-82	CIVIL DRAWINGS	C-1	C-81
83-137	STRUCTURAL DRAWINGS	S0.1	S7.1
140-141	TEMPORARY TRAFFIC SIGNAL DRAWINGS	TS-1	TS-2
141-143	LANDSCAPE DRAWINGS	L-1	L-2

TOTAL SHEET COUNT after Addendum & "AS BUILT" postings is 144 sheets.

LEGEND FOR AS-BUILT POSTINGS	
	Squiggly line for as-built deletion
	Double line for as-built deletion
	Text for as-built posting

CHANGES MADE DURING CONSTRUCTION HAVE BEEN INCORPORATED ON THESE PLANS EXCEPT CHANGES IN THE ORIGINAL THEORETICAL QUANTITIES. FOR ACTUAL QUANTITIES, REFER TO PROJECT LEDGER AND/OR COMPUTATION BOOK.

RESIDENT ENGINEER
2/8/22
DATE



STATE OF HAWAII DEPARTMENT OF TRANSPORTATION

HIGHWAYS DIVISION
HONOLULU, HAWAII


PLANS FOR PHASE 1 - KAUMUALII HIGHWAY LIHUE MILL BRIDGE TO RICE STREET PHASE 3 - LIHUE MILL BRIDGE AND MAKAI HIGHWAY WIDENING PROJECT NO. ARR-050-1(036)

DISTRICT OF LIHUE
ISLAND OF KAUAI

FED. ROAD DIST. NO.	STATE	FED. AID PROJ. NO.	FISCAL YEAR	SHEET NO.	TOTAL SHEETS
HAWAII	HAW.	ARR-050-1(036)	FY13/14	1	143

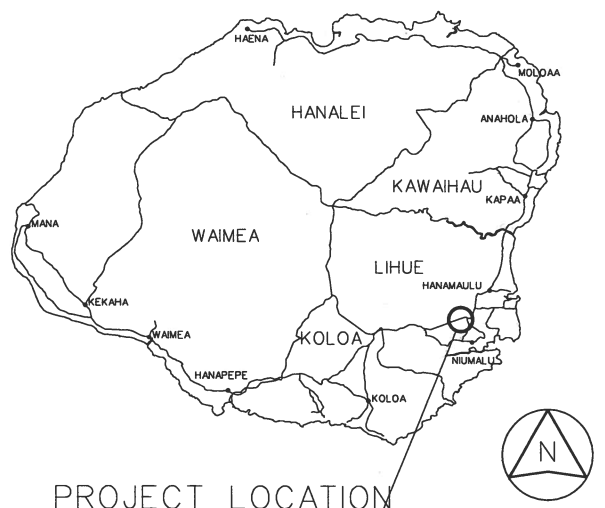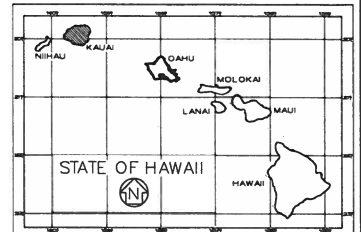

PROJECT LOCATION

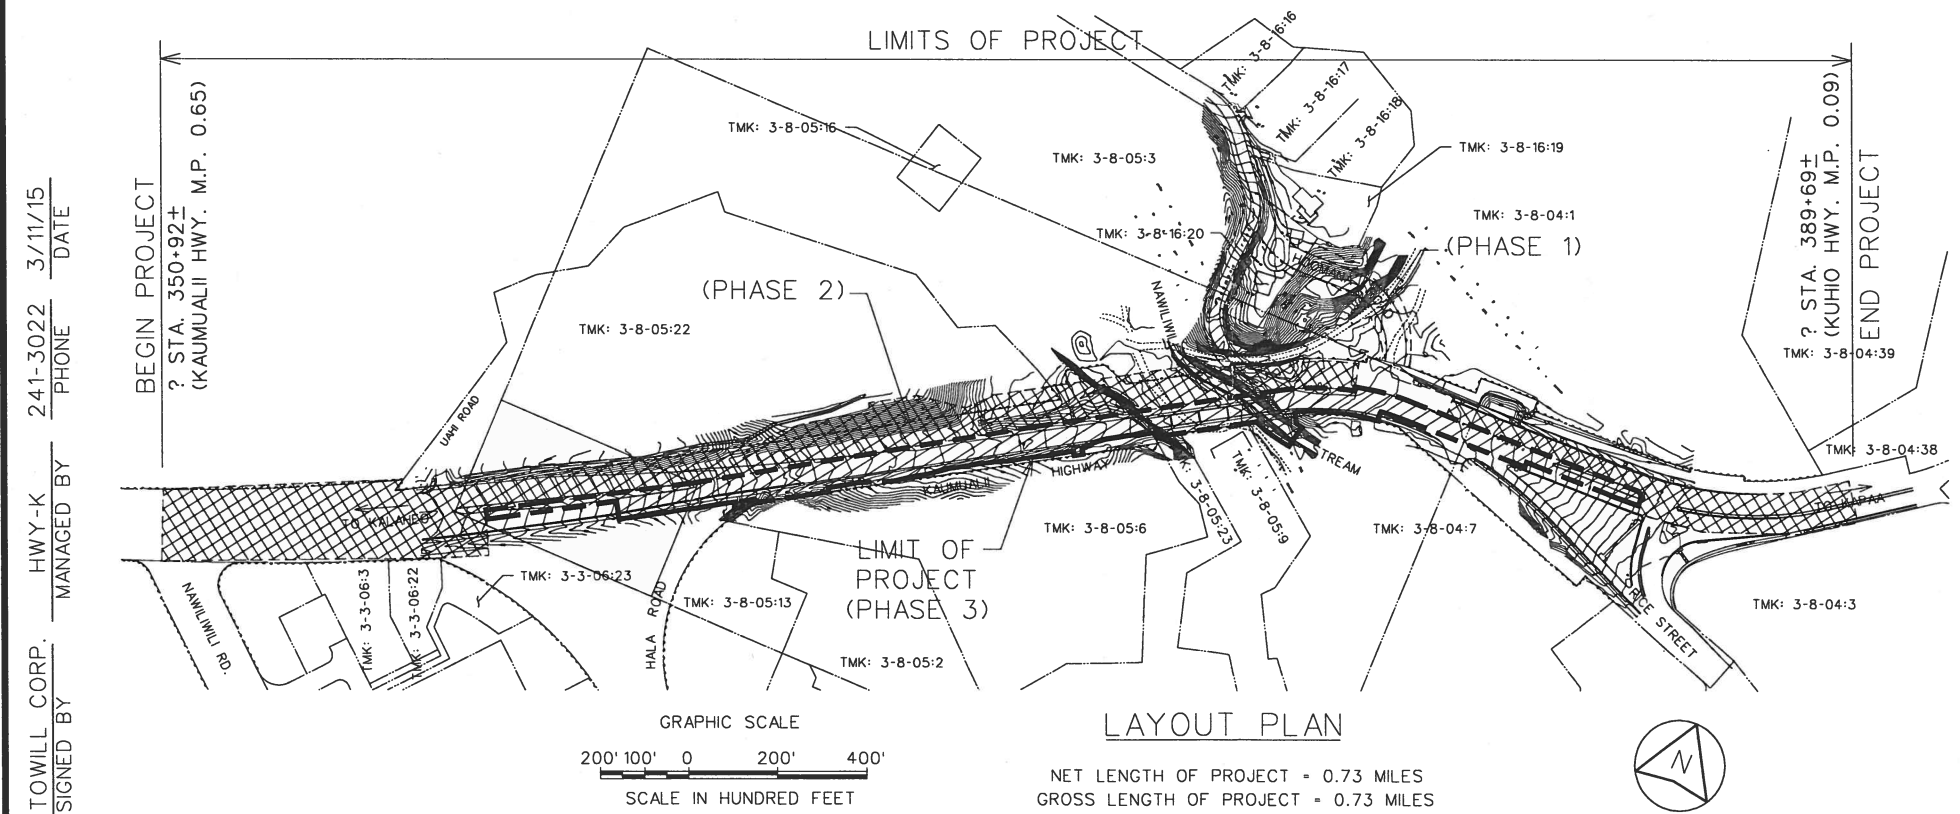

KAUMUALII HIGHWAY: MILE POST 0.65 TO MILE POST 0.00
KUHIU HIGHWAY: MILE POST 0.00 TO MILE POST 0.09

DESIGN DESIGNATION	
ADT (2012)	27,400 VPD
DESIGN ADT (2035)	37,800 VPD
DHV	3,080
D (DESIGN)	55/45
T (DESIGN)	3.0%
V	35 MPH

DEPARTMENT OF TRANSPORTATION STATE OF HAWAII
APPROVED:
DIR. OF TRANSPORTATION DATE

R.M. TOWILL CORP.
DESIGNED BY
HWY-K
MANAGED BY
241-3022
PHONE
3/11/15
DATE

"AS-BUILT"