



FED. ROAD DIST. NO.	STATE	FED. AID PROJ. NO.	FISCAL YEAR	SHEET NO.	TOTAL SHEETS
HAWAII	HAW.	STP-050-1(13)	1994	7	15

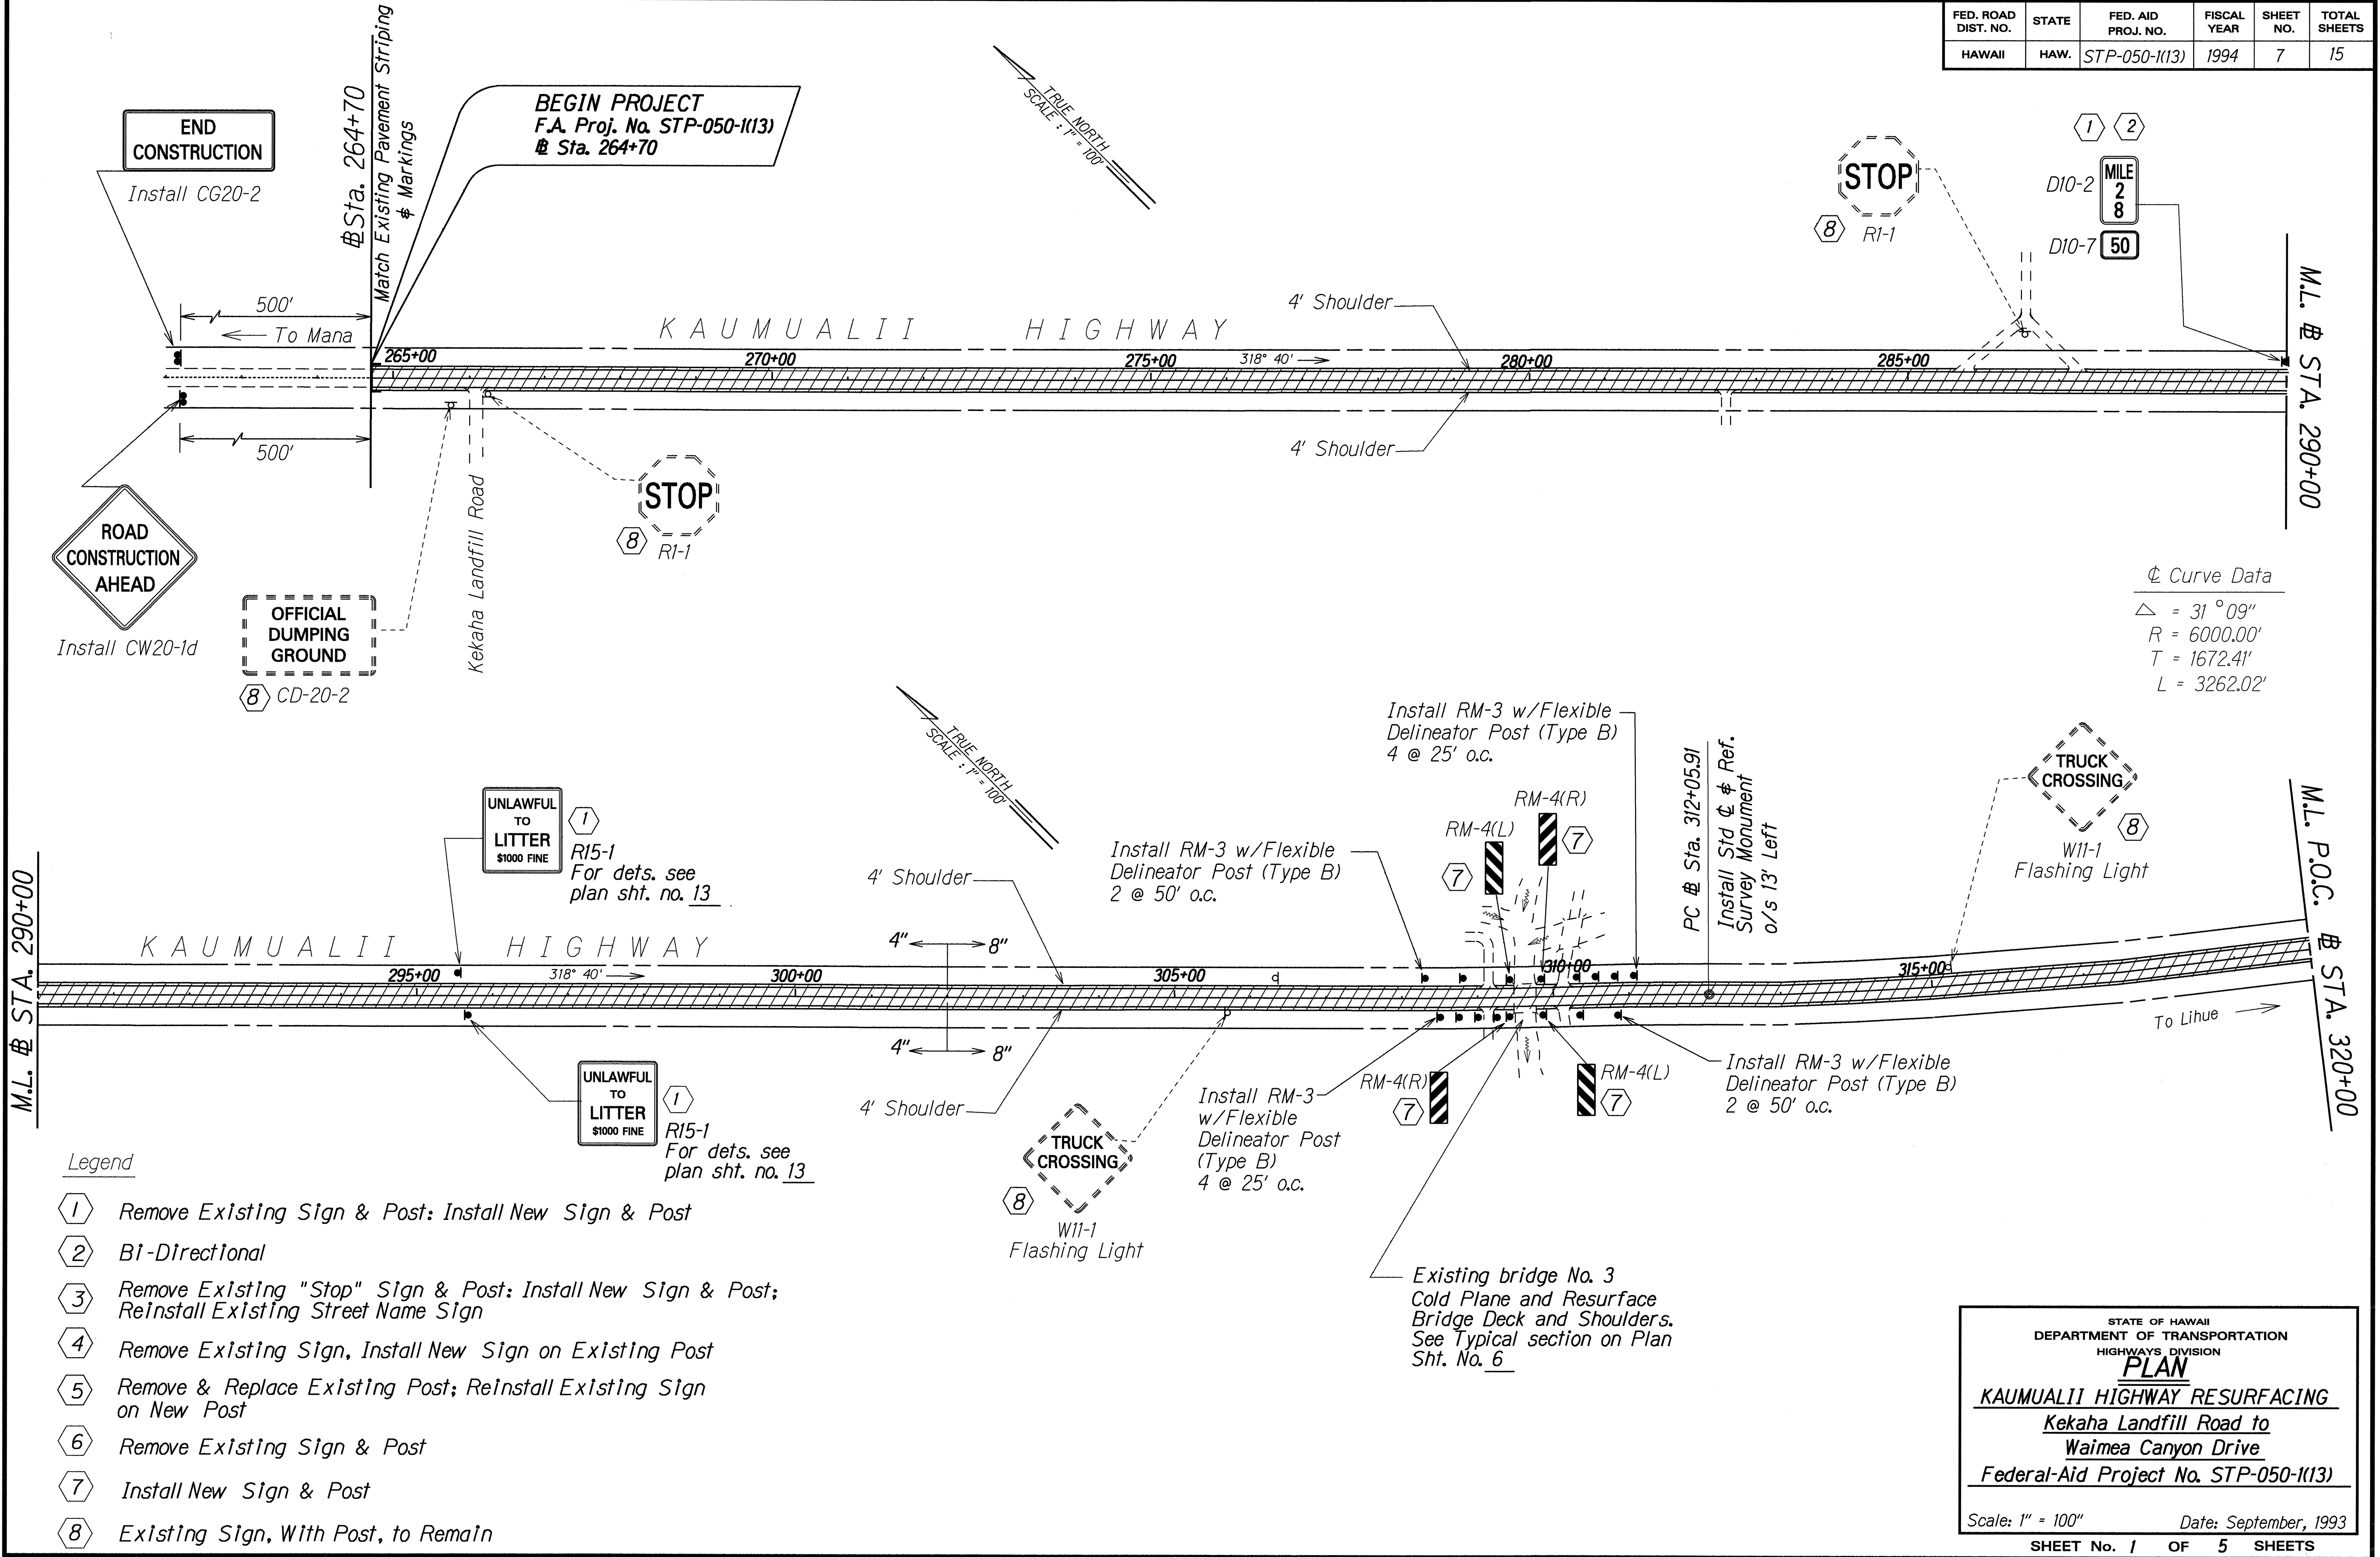

FED. ROAD DIST. NO.	STATE	FED. AID PROJ. NO.	FISCAL YEAR	SHEET NO.	TOTAL SHEETS
HAWAII	HAW.	STP-050-1(13)	1994	8	15

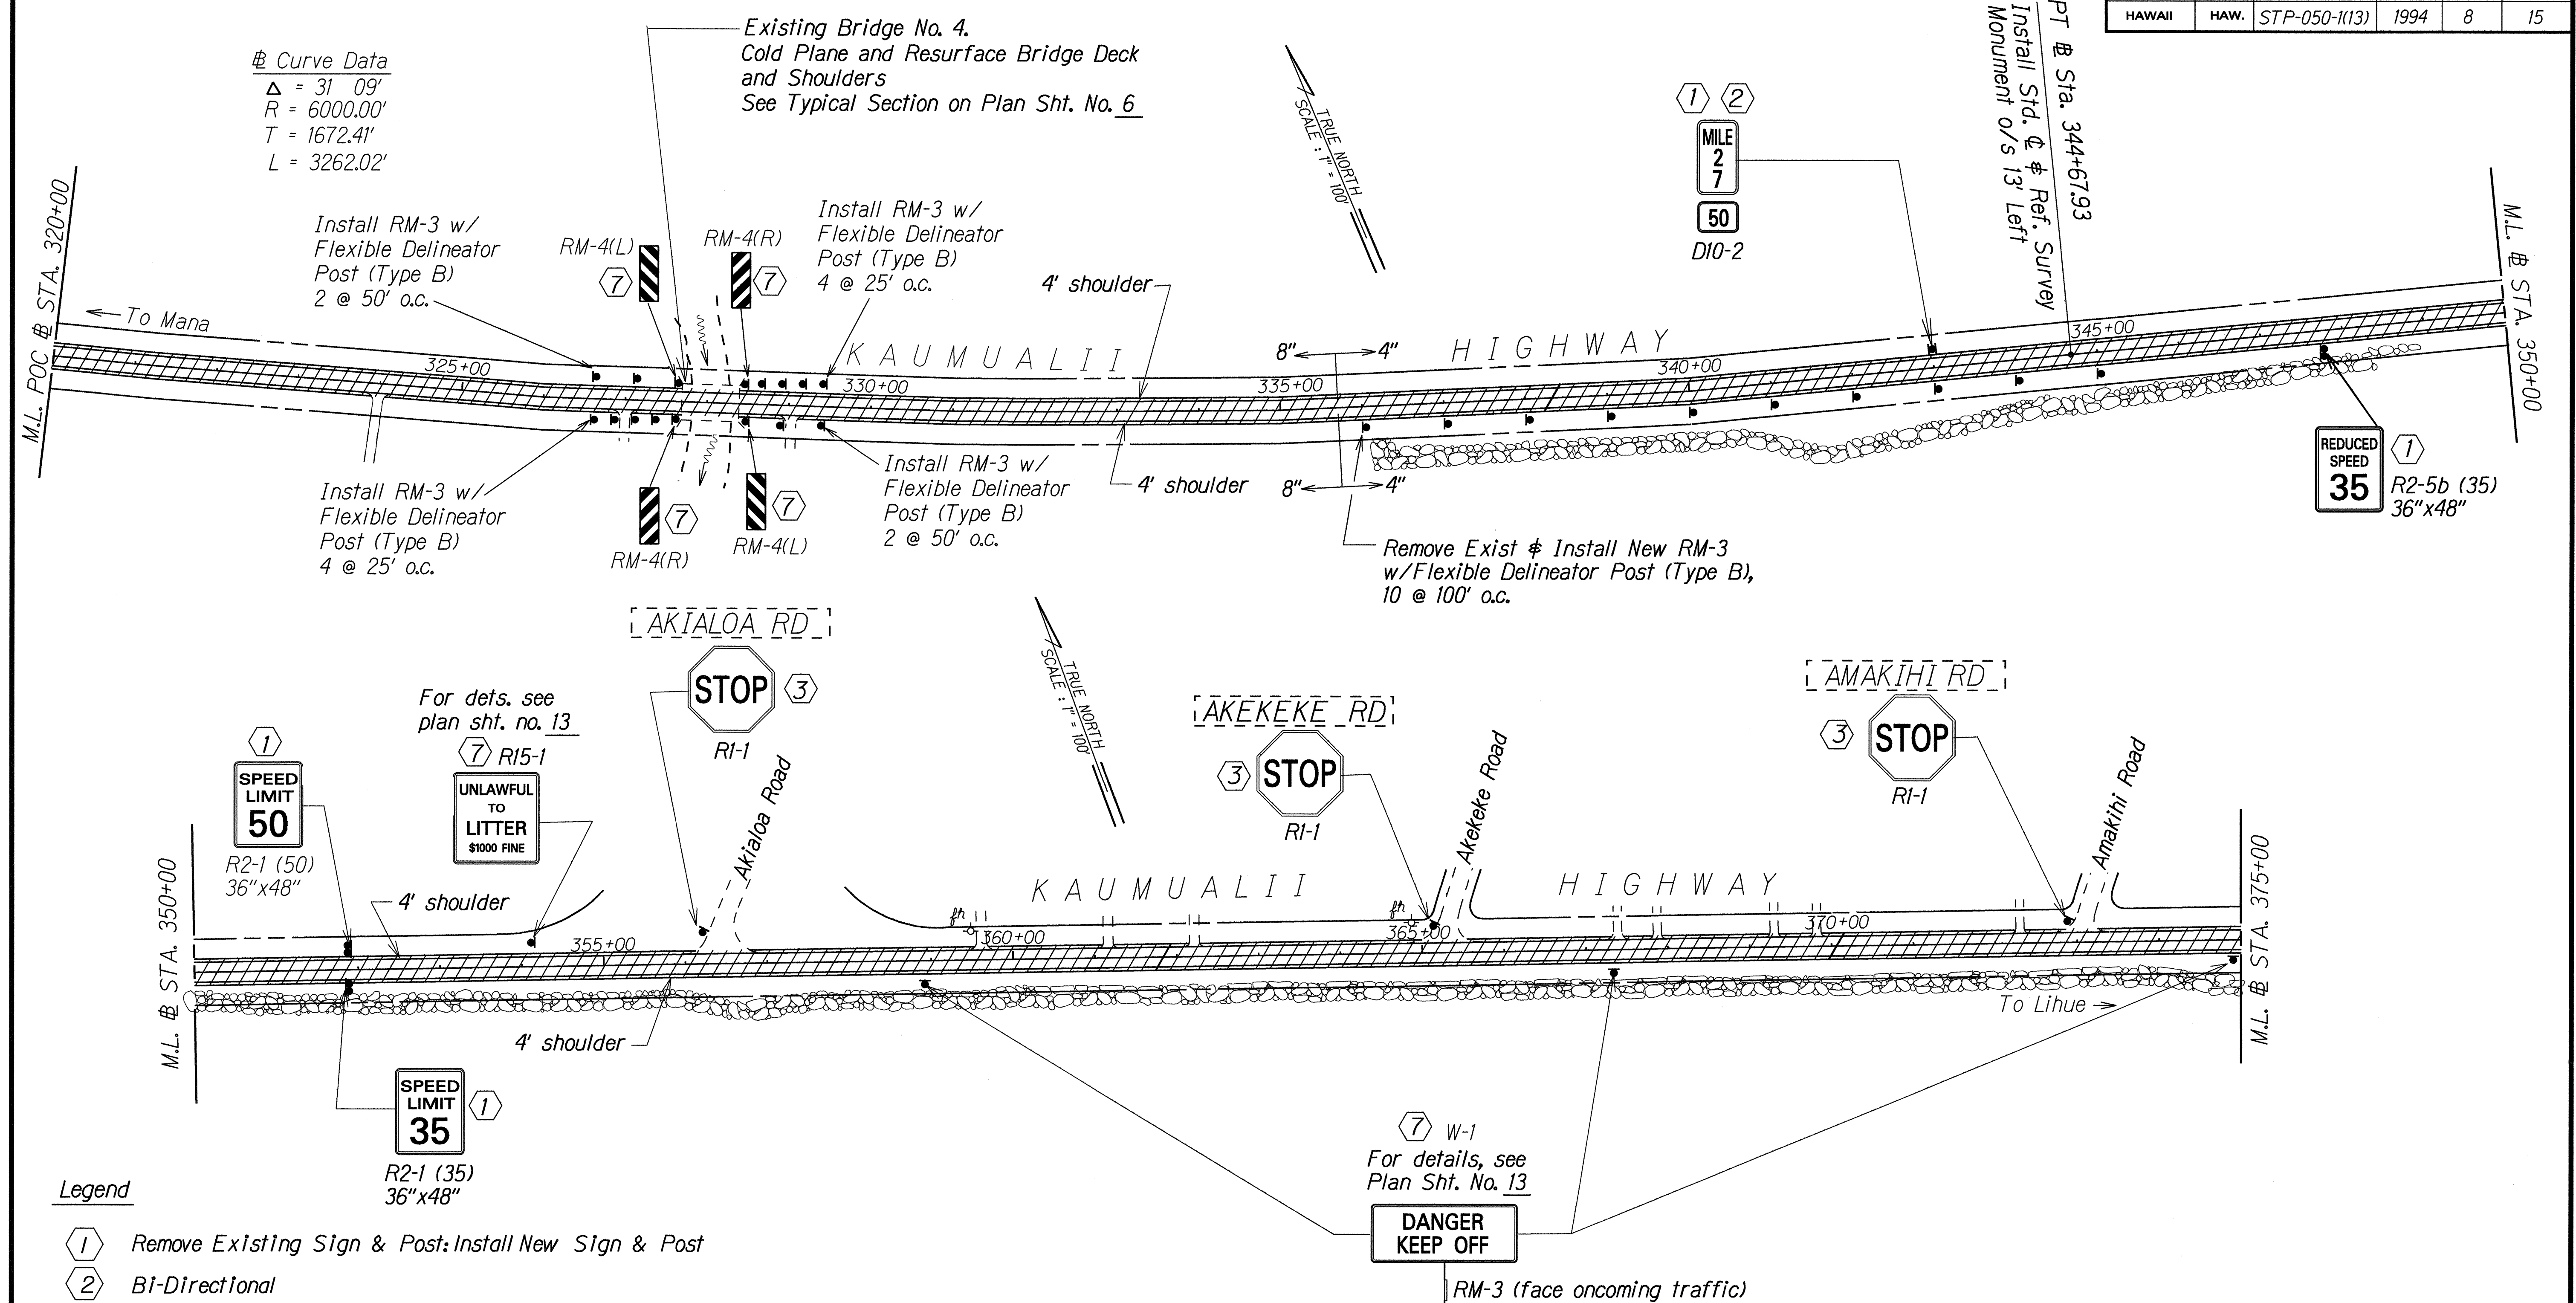

Legend

- 1 Remove Existing Sign & Post; Install New Sign & Post
- 2 Bi-Directional
- 3 Remove Existing "Stop" Sign & Post; Install New Sign & Post; Reinstall Existing Street Name Sign
- 4 Remove Existing Sign; Install New Sign on Existing Post
- 5 Remove & Replace Existing Post; Reinstall Existing Sign on New Post
- 6 Remove Existing Sign & Post
- 7 Install New Sign & Post
- 8 Existing Sign Existing Sign, With Post, to Remain

STATE OF HAWAII
DEPARTMENT OF TRANSPORTATION
HIGHWAYS DIVISION
PLAN


KAUMUALII HIGHWAY RESURFACING
Kekaha Landfill Road to
Waimea Canyon Drive
Federal-Aid Project No. STP-050-1(13)

Scale: 1" = 100'
Date: September, 1993

SHEET No. 2 OF 5 SHEETS

FED. ROAD DIST. NO.	STATE	FED. AID PROJ. NO.	FISCAL YEAR	SHEET NO.	TOTAL SHEETS
HAWAII	HAW.	STP-050-1(13)	1994	9	15

- Legend**
- 1 Remove Existing Sign & Post; Install New Sign & Post
 - 2 BI-Directional
 - 3 Remove Existing "Stop" Sign & Post; Install New Sign & Post; Reinstall Existing Street Name Sign
 - 4 Remove Existing Sign, Install New Sign on Existing Post
 - 5 Remove & Replace Existing Post; Reinstall Existing Sign on New Post
 - 6 Remove Existing Sign & Post
 - 7 Install New Sign & Post
 - 8 Existing Sign, With Post, to Remain

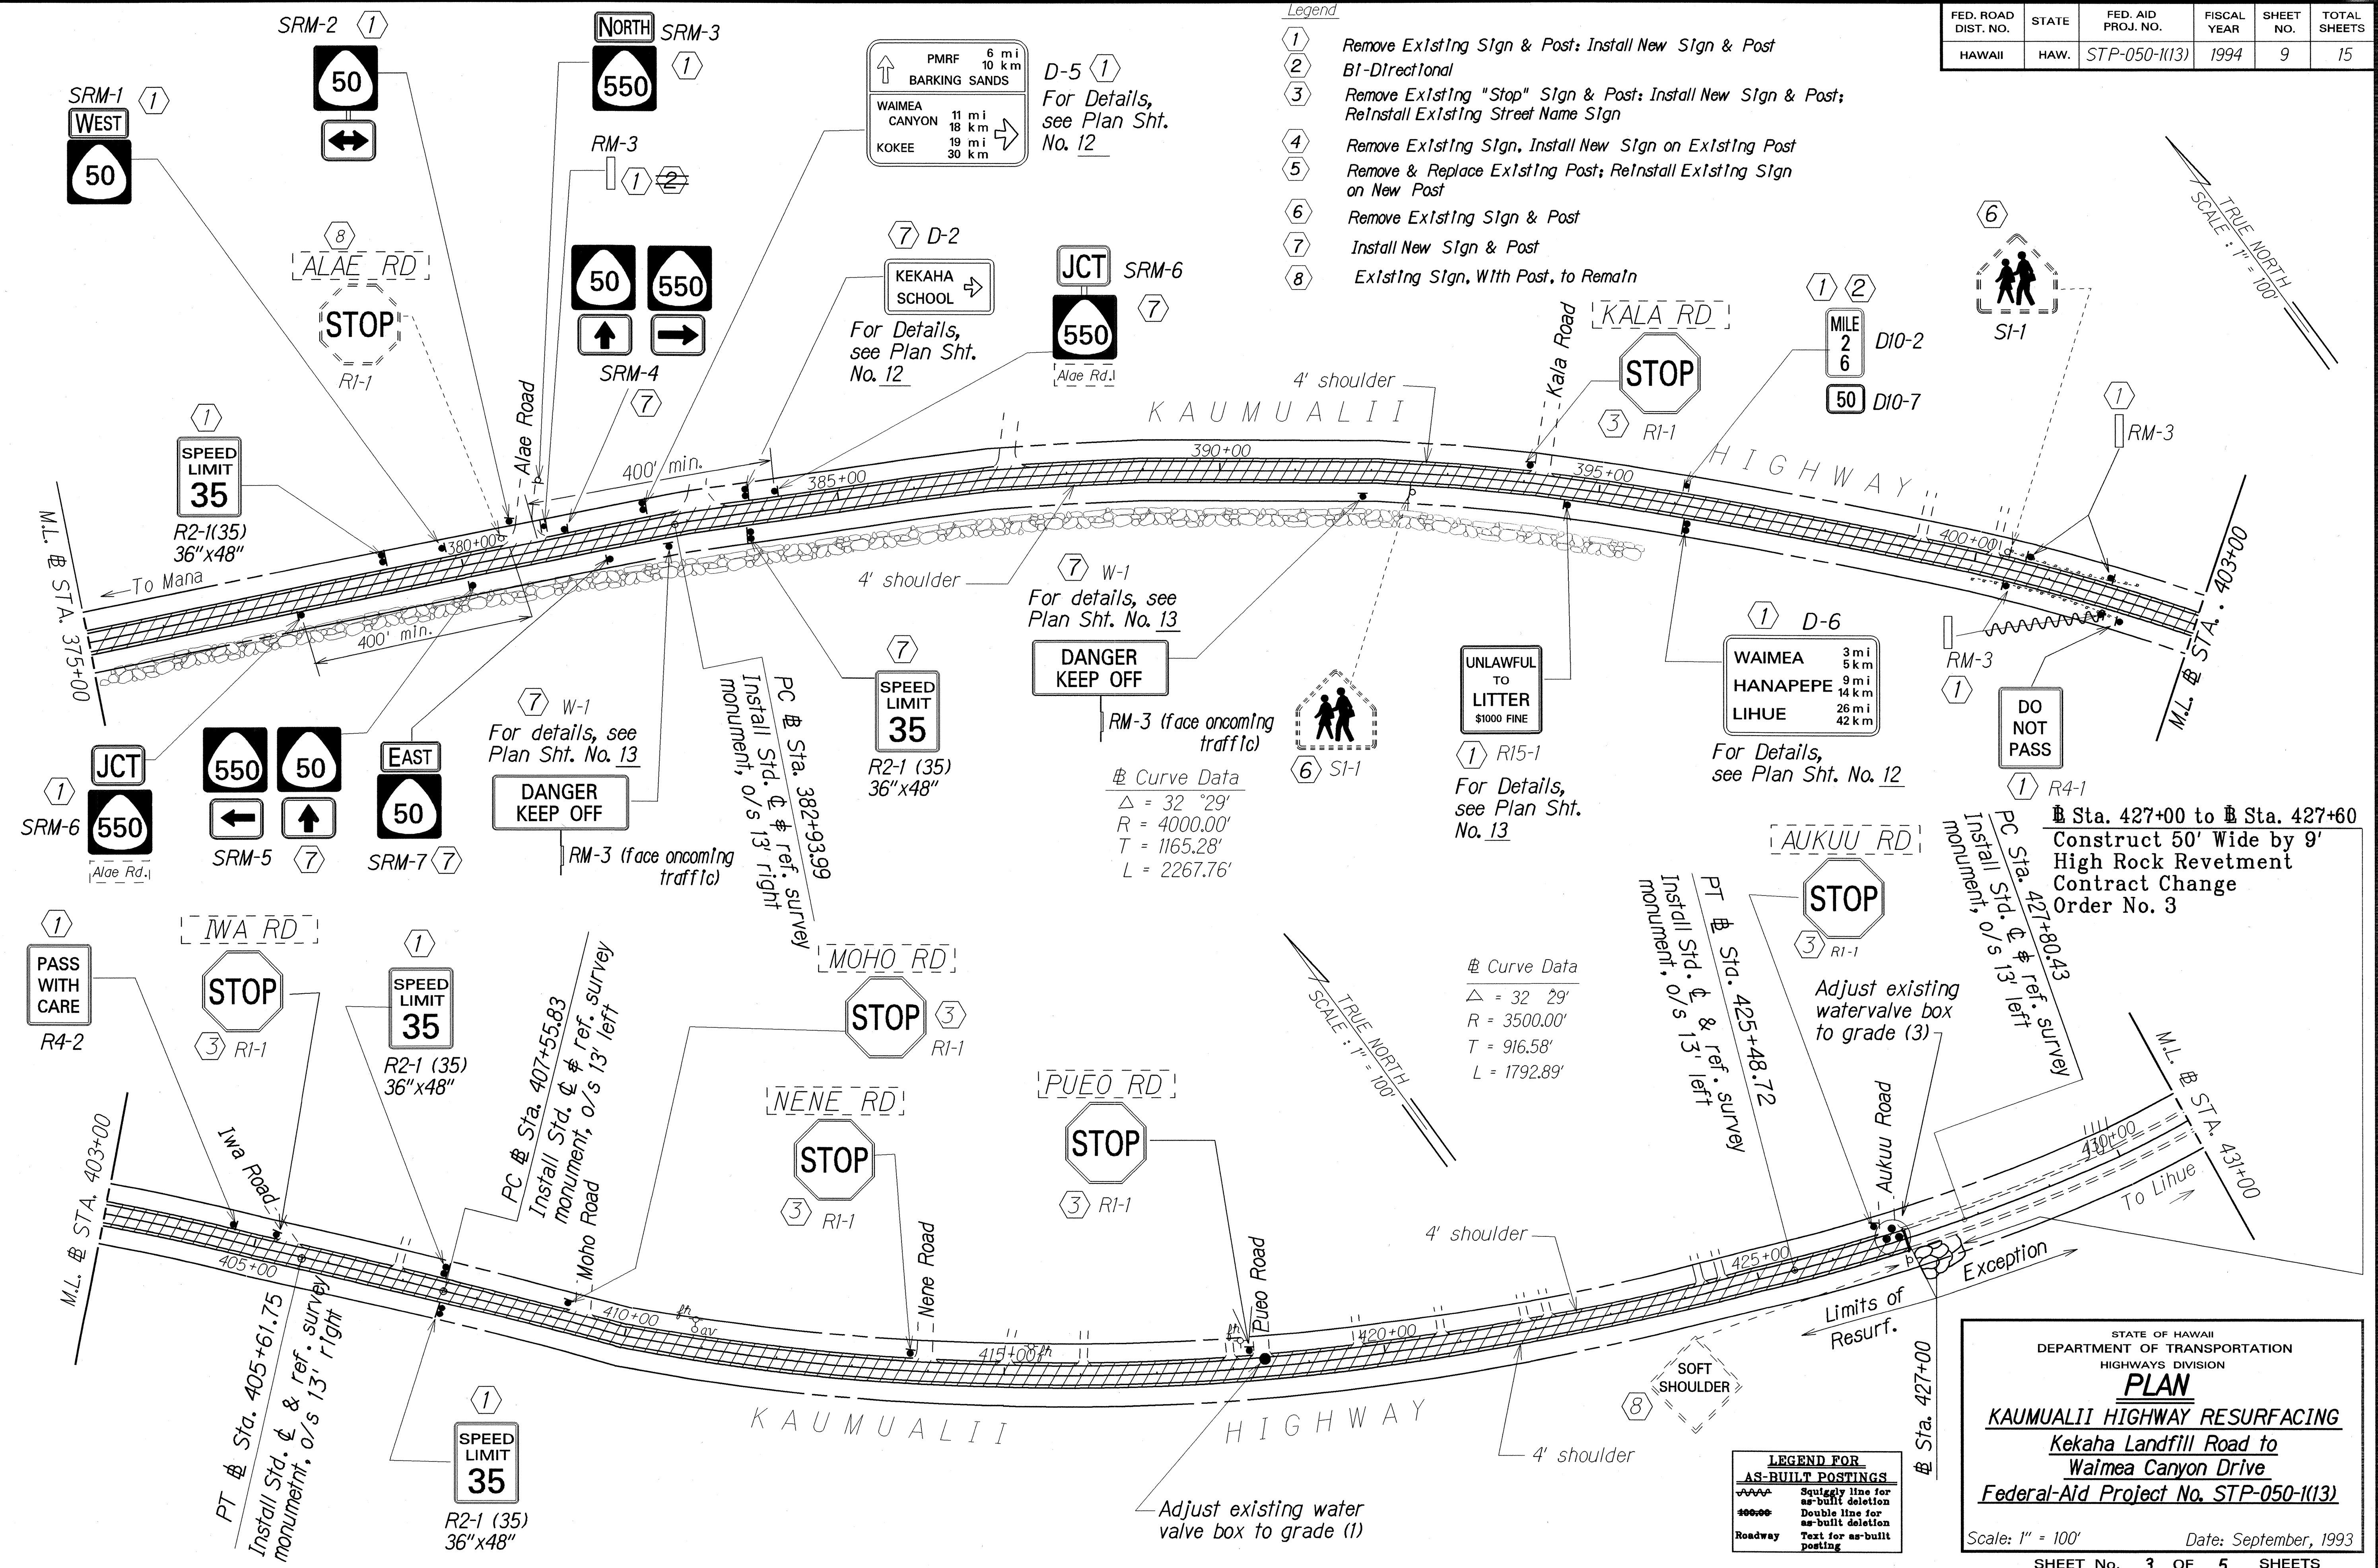

DATE	_____
SURVEY PLOTTED BY	_____
DRAWN BY	_____
DESIGNED BY	_____
QUANTITIES BY	_____
CHECKED BY	_____
ORIGINAL PLAN	_____
NOTE BOOK	_____
DESIGNED BY	_____
CHECKED BY	_____

STATE OF HAWAII
DEPARTMENT OF TRANSPORTATION
HIGHWAYS DIVISION

PLAN


KAUMUALII HIGHWAY RESURFACING
Kekaha Landfill Road to
Waimea Canyon Drive
Federal-Aid Project No. STP-050-1(13)

Scale: 1" = 100' Date: September, 1993

SHEET No. 3 OF 5 SHEETS


"AS-BUILT"

FED. ROAD DIST. NO.	STATE	FED. AID PROJ. NO.	FISCAL YEAR	SHEET NO.	TOTAL SHEETS
HAWAII	HAW.	STP-050-1(13)	1994	10	15

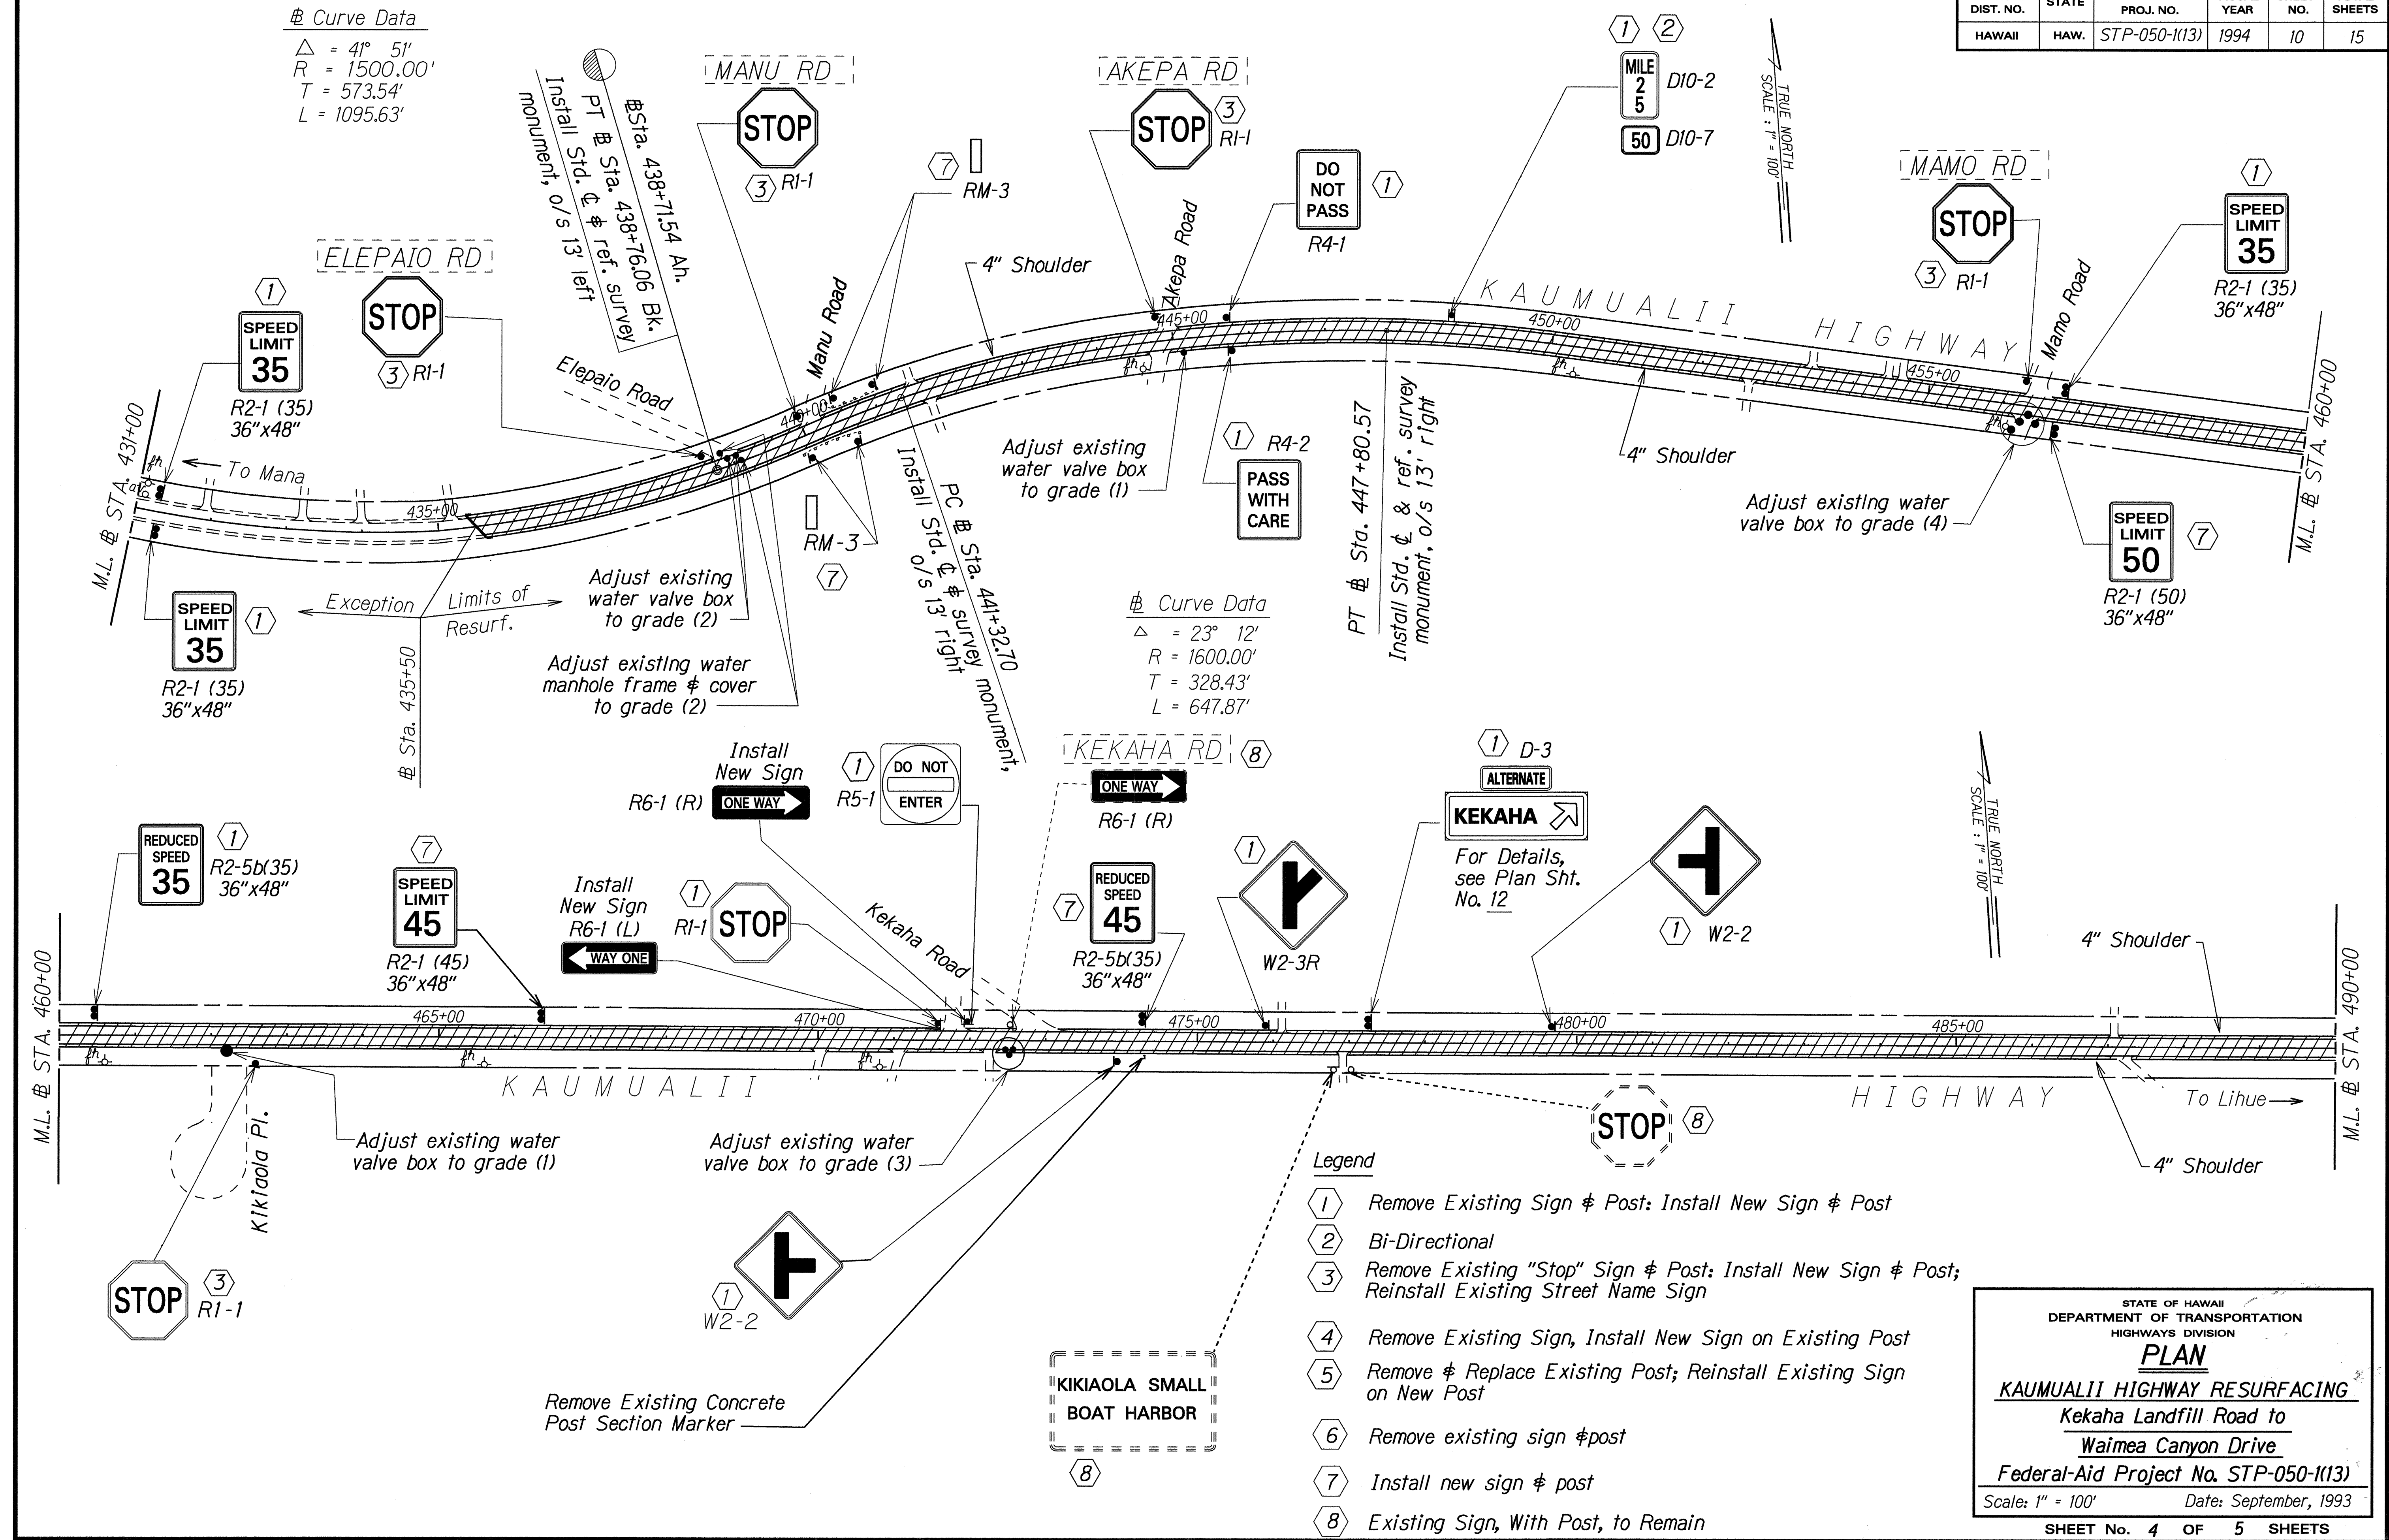

ORIGINAL PLAN	SURVEY PLOTTED BY	DATE
DESIGNED BY		
CHECKED BY		
NOTED BY		
DATE		

FED. ROAD DIST. NO.	STATE	FED. AID PROJ. NO.	FISCAL YEAR	SHEET NO.	TOTAL SHEETS
HAWAII	HAW.	STP-050-1(13)	1994	11	15

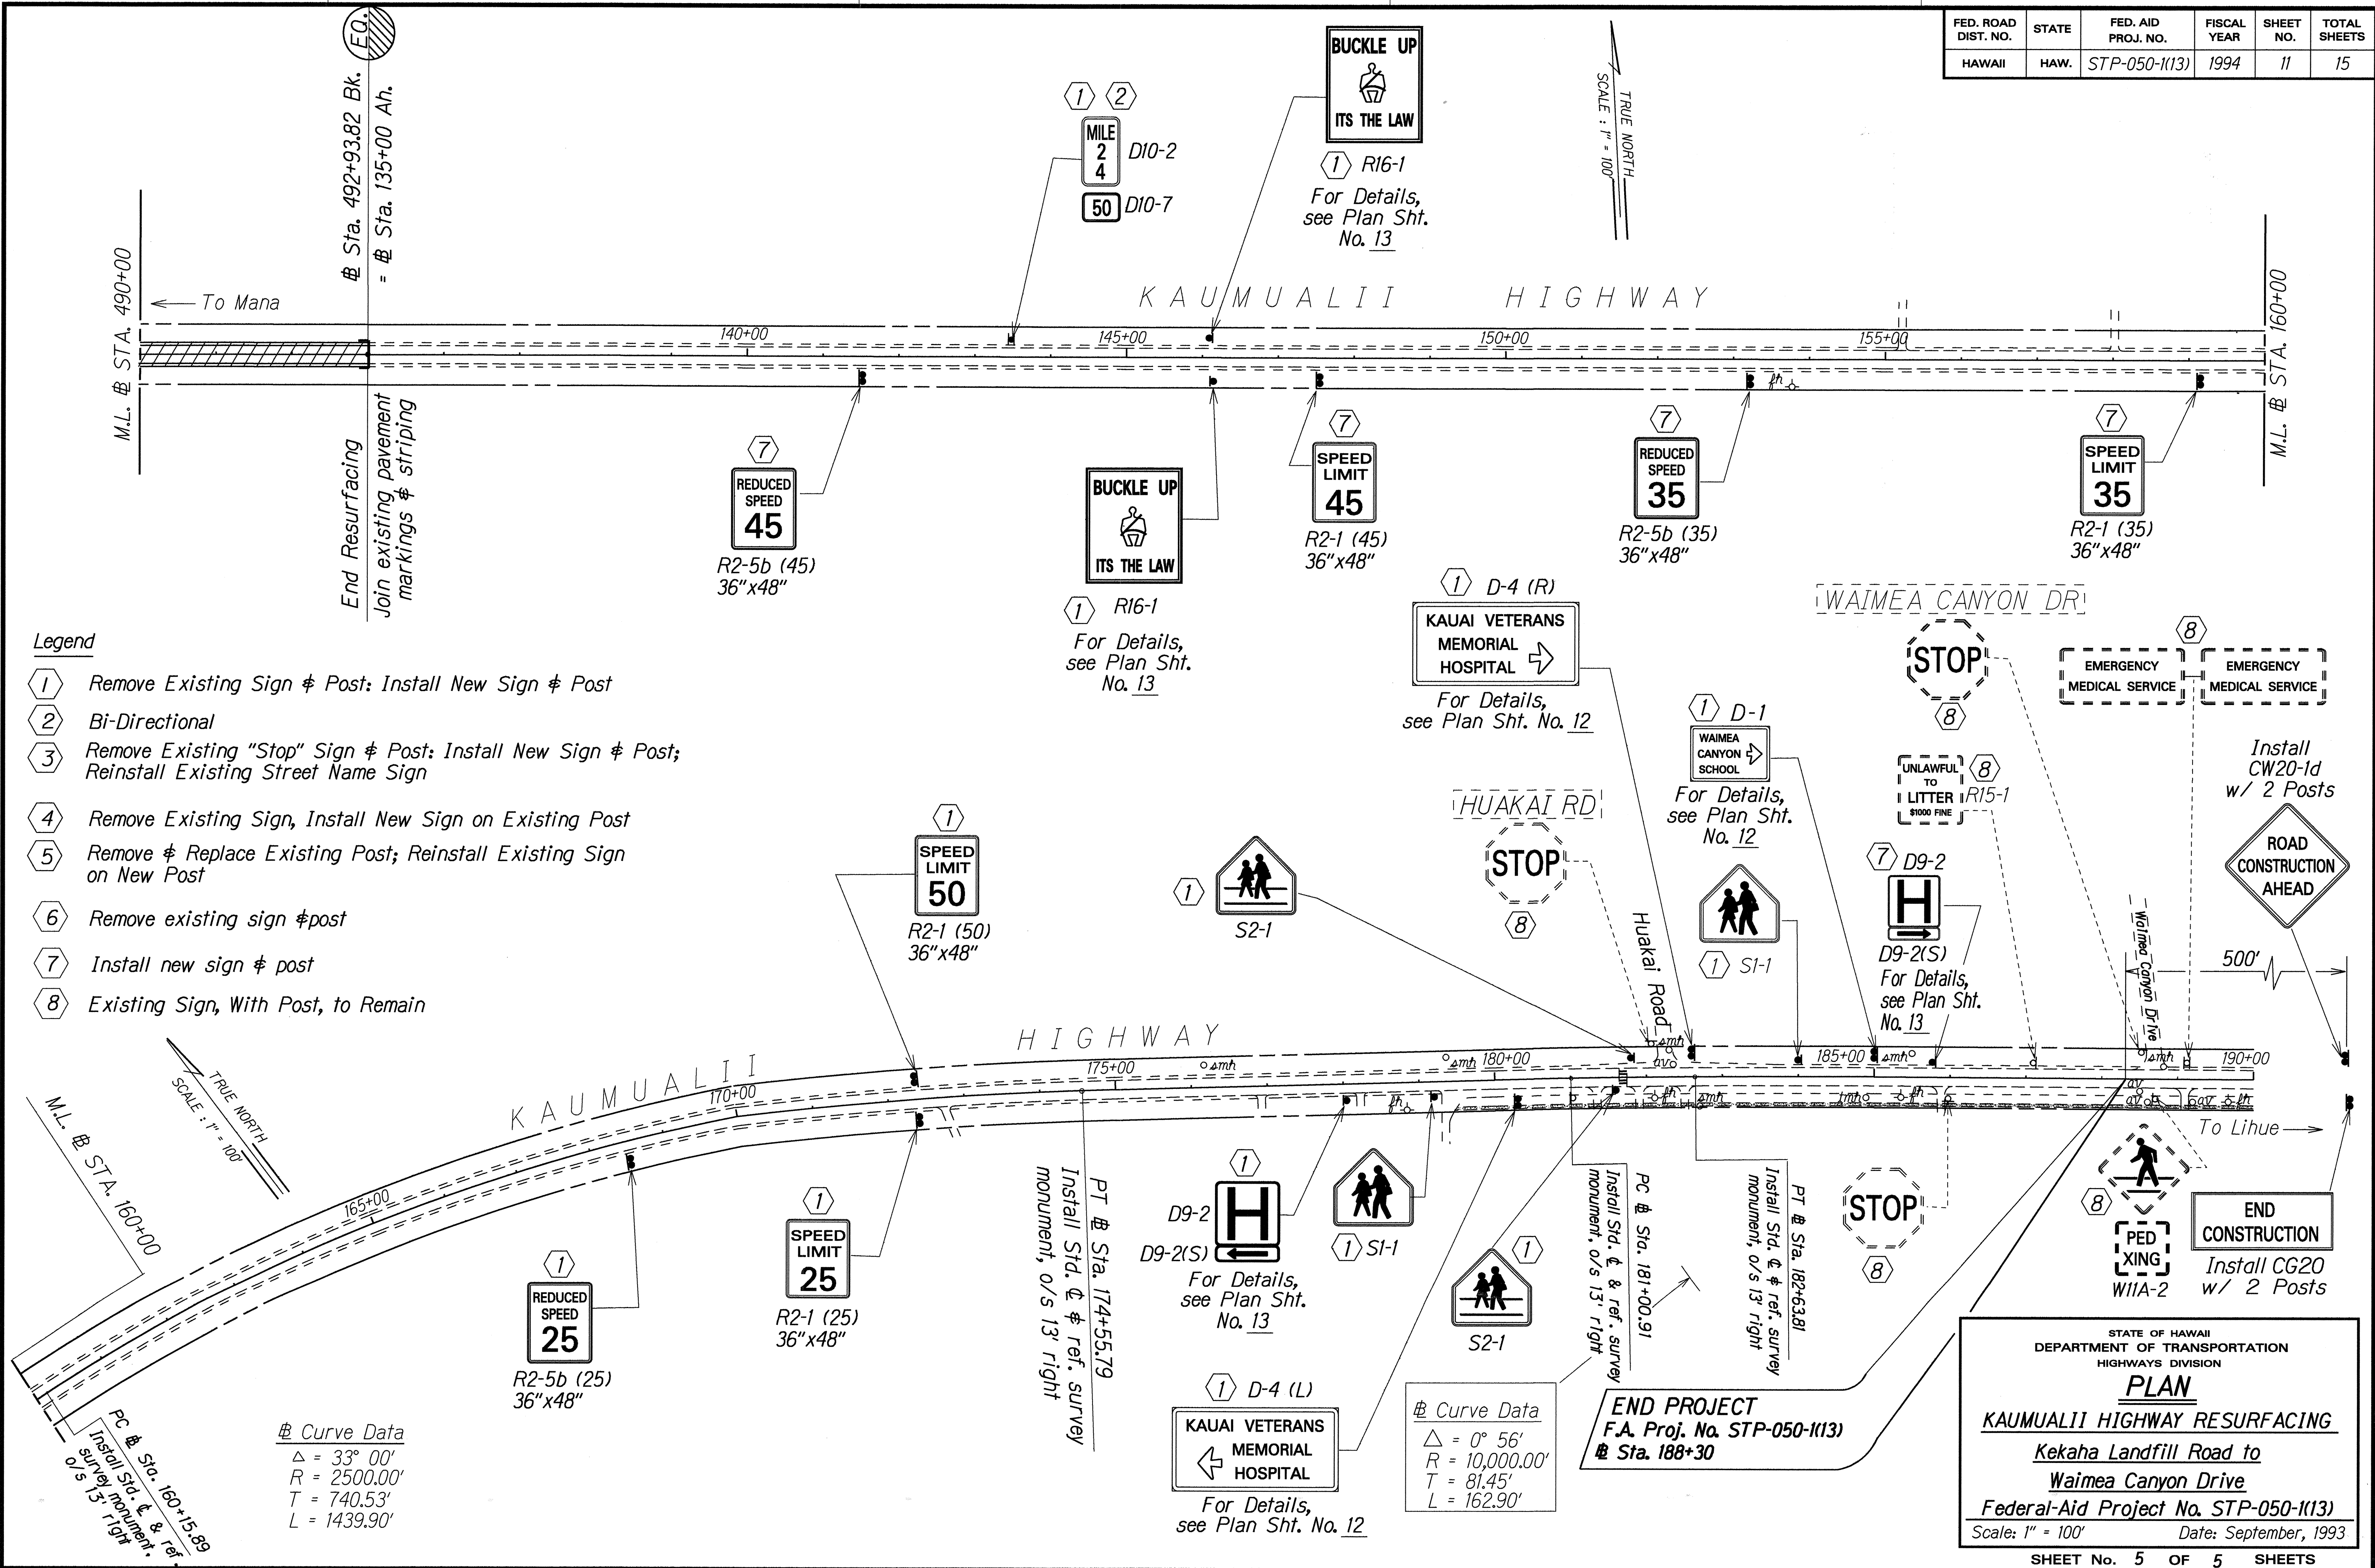

- Legend**
- 1 Remove Existing Sign & Post: Install New Sign & Post
 - 2 Bi-Directional
 - 3 Remove Existing "Stop" Sign & Post: Install New Sign & Post; Reinstall Existing Street Name Sign
 - 4 Remove Existing Sign, Install New Sign on Existing Post
 - 5 Remove & Replace Existing Post; Reinstall Existing Sign on New Post
 - 6 Remove existing sign & post
 - 7 Install new sign & post
 - 8 Existing Sign, With Post, to Remain

ORIGINAL PLAN	DATE
SURVEY PLOTTED BY	
DRAWN BY	
DESIGNED BY	
CHECKED BY	
NOTED BY	
QUANTITIES BY	
CHECKED BY	

Curve Data
 $\Delta = 33^{\circ} 00'$
 $R = 2500.00'$
 $T = 740.53'$
 $L = 1439.90'$

Curve Data
 $\Delta = 0^{\circ} 56'$
 $R = 10,000.00'$
 $T = 81.45'$
 $L = 162.90'$

STATE OF HAWAII
DEPARTMENT OF TRANSPORTATION
HIGHWAYS DIVISION

PLAN
KAUMUALII HIGHWAY RESURFACING
Kekaha Landfill Road to
Waimea Canyon Drive
Federal-Aid Project No. STP-050-1(13)
Scale: 1" = 100' Date: September, 1993

SHEET No. 5 OF 5 SHEETS