




FED. ROAD DIST. NO.	STATE	FED. AID PROJ. NO.	FISCAL YEAR	SHEET NO.	TOTAL SHEETS
HAWAII	HAW.	STP-050-1(13)	1994	ADD.5	15

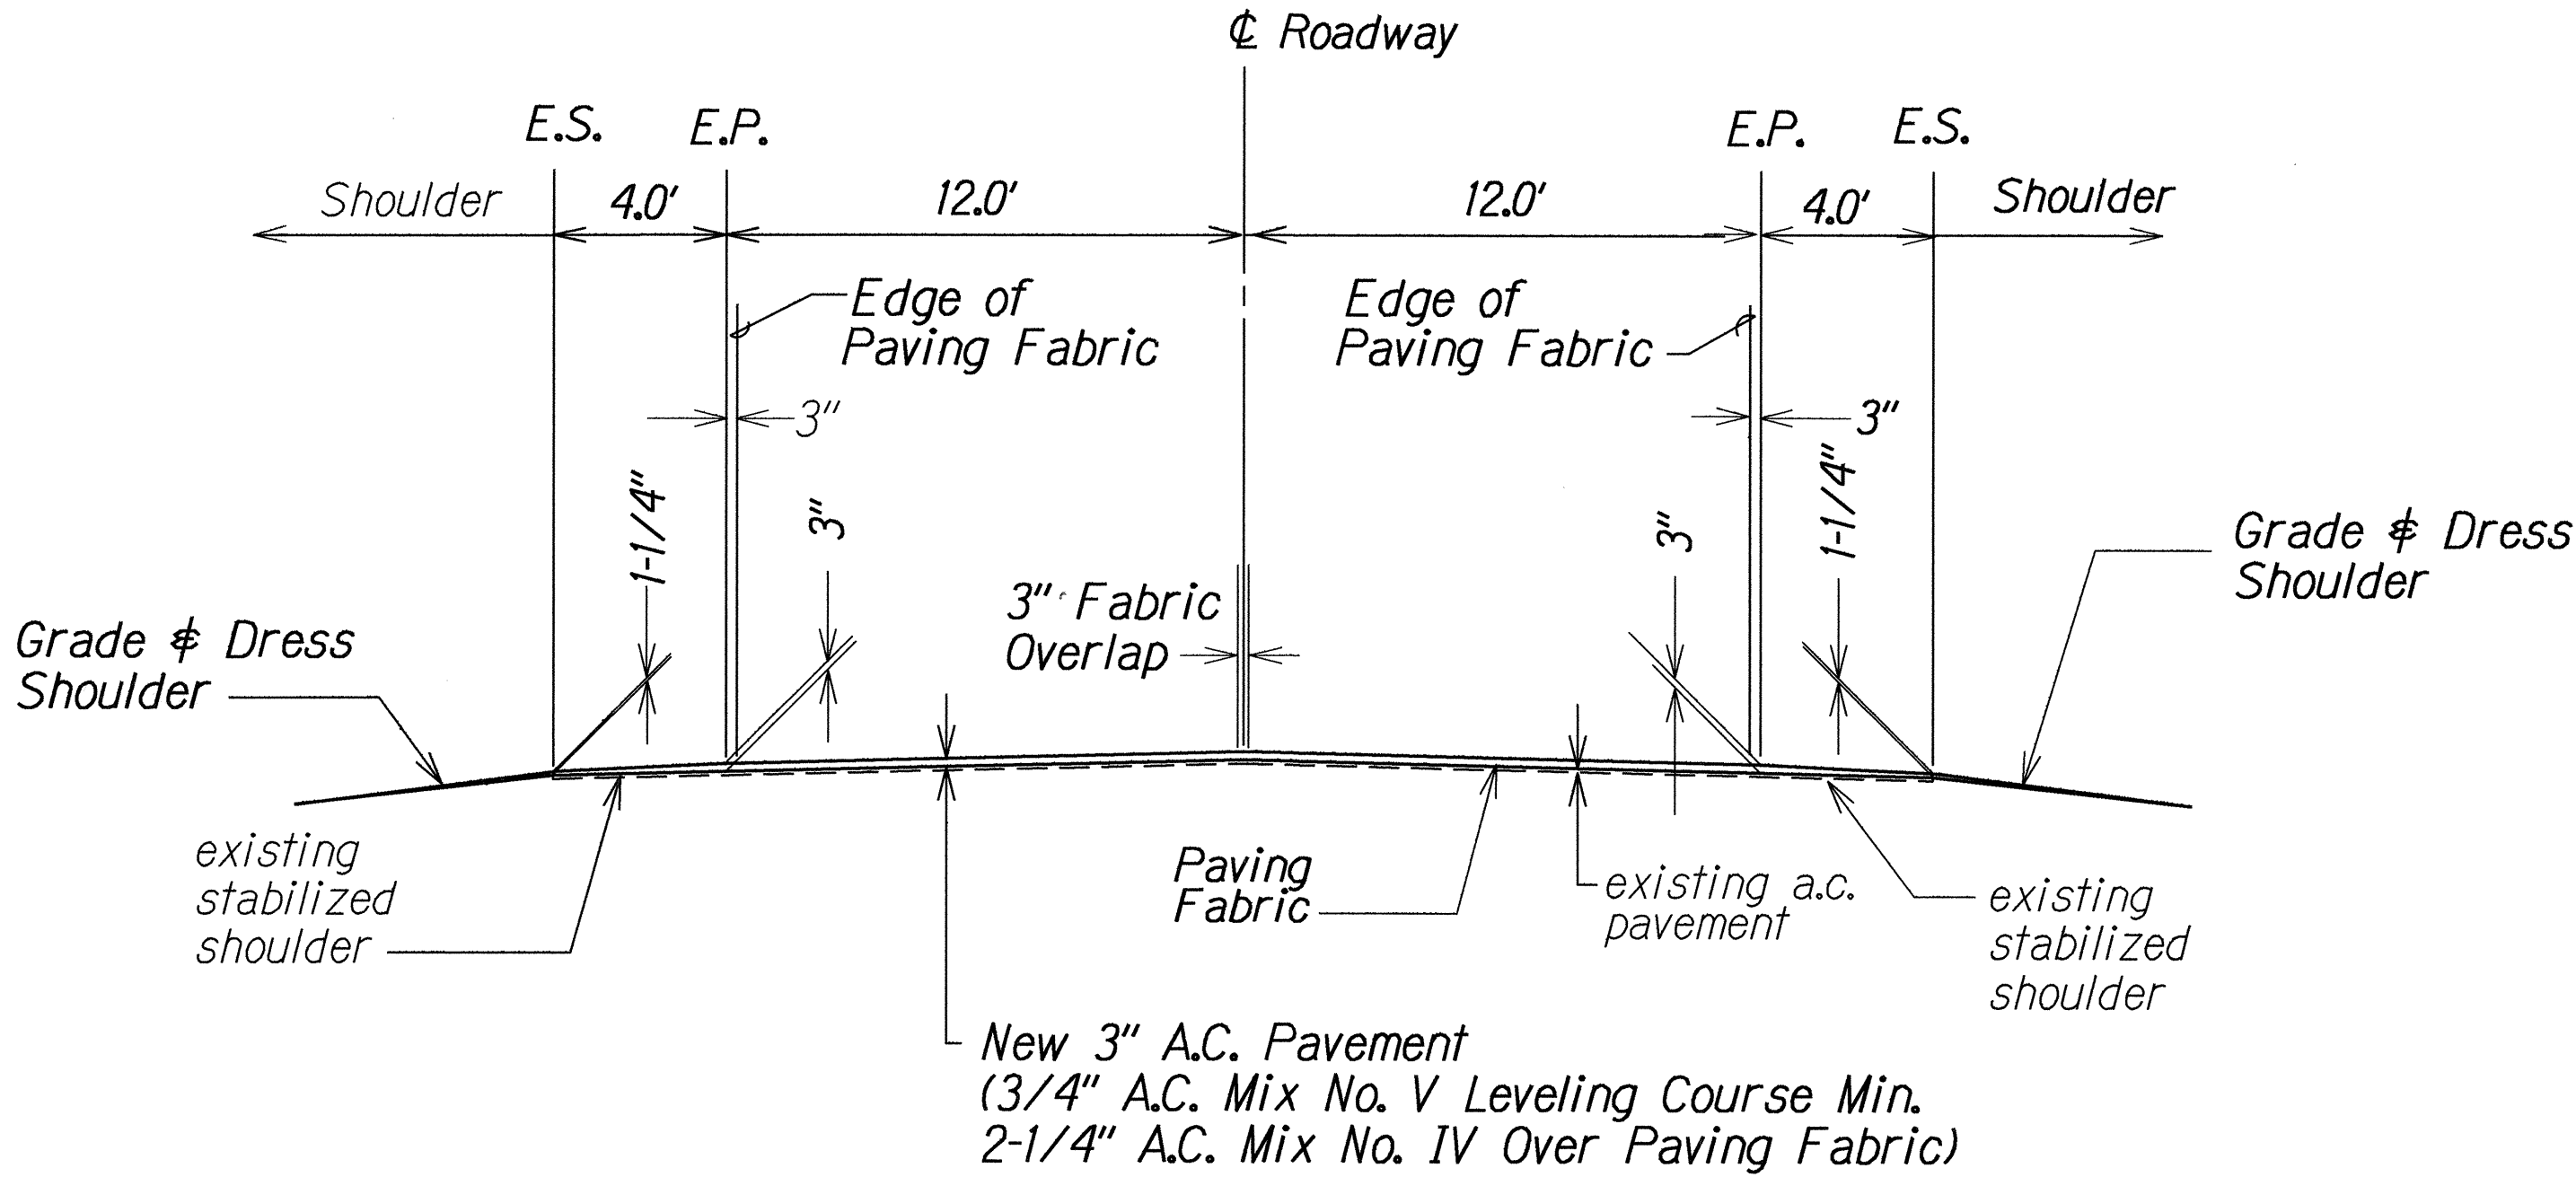

**TYPICAL SECTION ON TANGENTS**  
Scale: 1/4" = 1'-0"

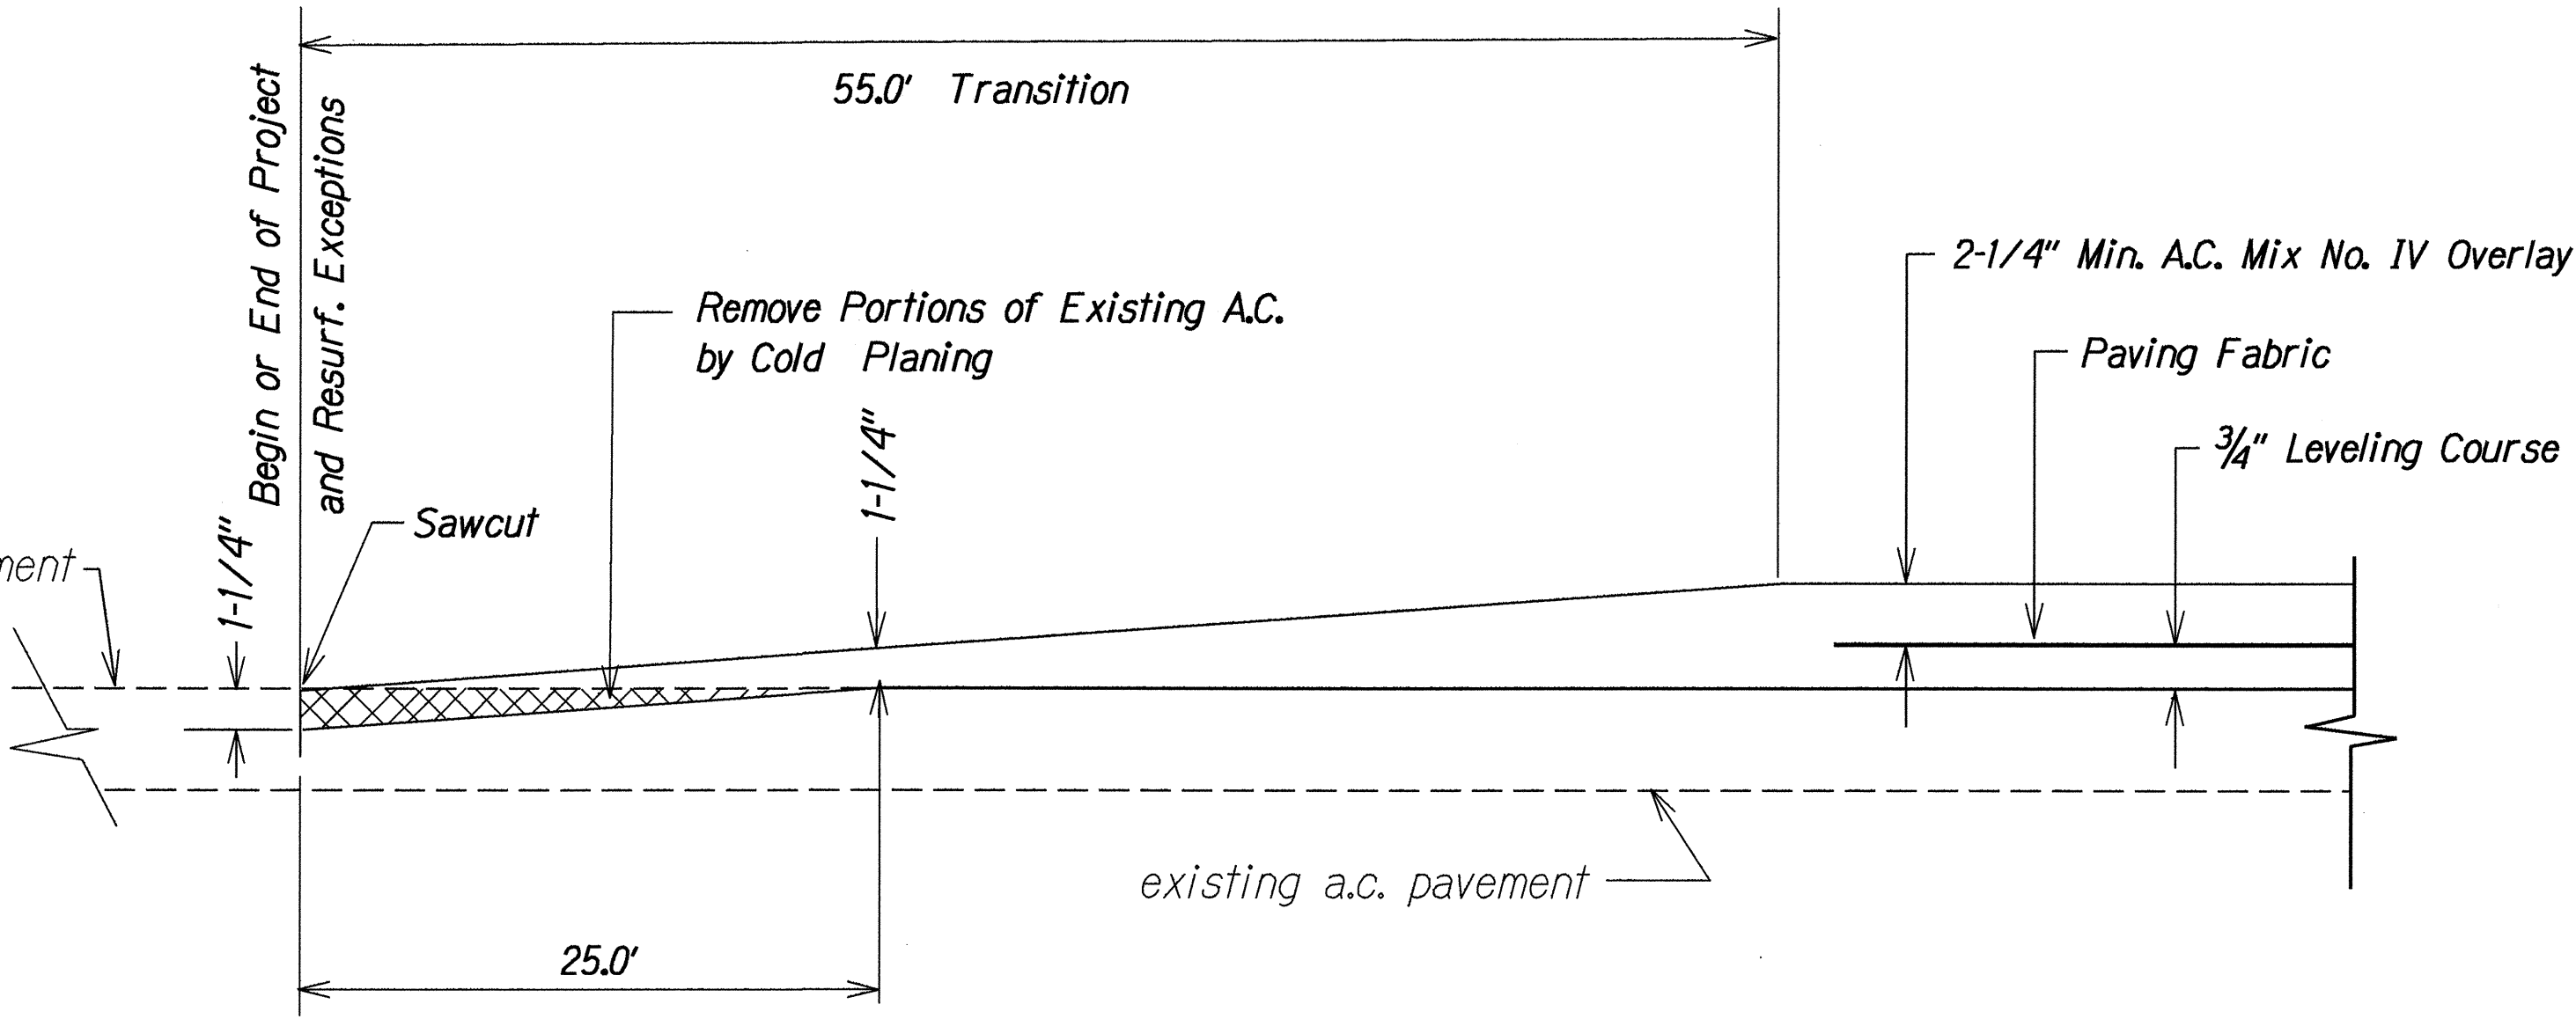

**TYPICAL SECTION AT TRANSITIONS**  
Not To Scale

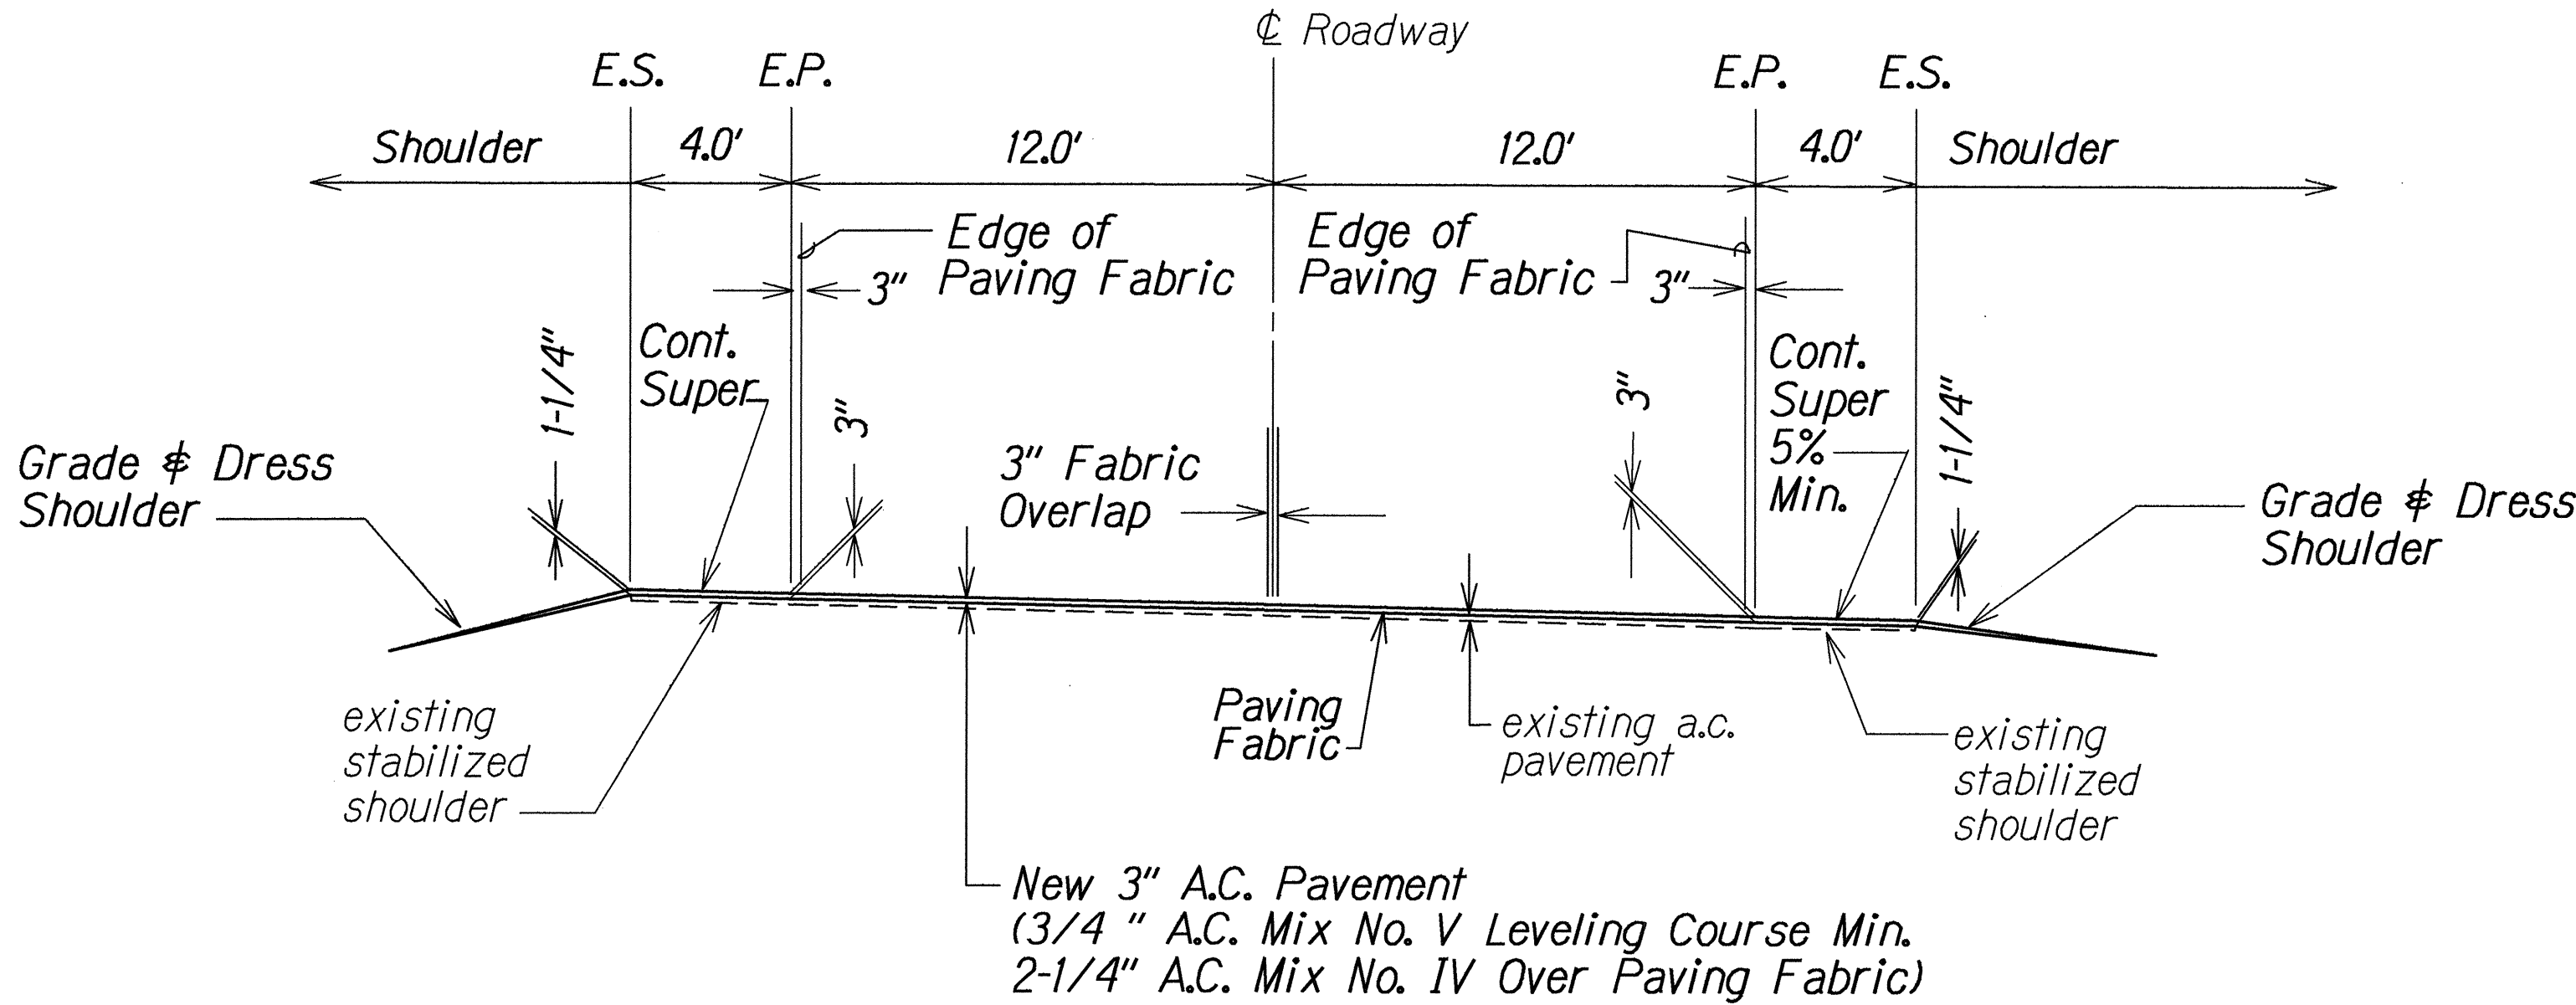

**TYPICAL SECTION ON CURVES**  
Scale: 1/4" = 1'-0"

Not: Sawcut Joint at 8° Skew Across Road

SURVEY PLOTTED BY	DATE
DRAWN BY	11-2-94
TRACED BY	
CHECKED BY	
QUANTITIES BY	
NOTES	
ORIGINAL PLAN	
NOTE BOOK	
DATE	
CHECKED BY	
DATE	

6-2-94	Revised Typical Sections
DATE	REVISION
STATE OF HAWAII DEPARTMENT OF TRANSPORTATION HIGHWAYS DIVISION	
<b>TYPICAL SECTIONS</b>	
KAUMUALII HIGHWAY RESURFACING	
Kekaha Landfill Road to	
Waimea Canyon Drive	
Federal-Aid Project No. STP-050-1(13)	
Scale: As Noted	Date: September, 1993
SHEET No. 1	OF 1 SHEETS