


| FED. ROAD DIST. NO. | STATE | FED. AID PROJ. NO. | FISCAL YEAR | SHEET NO. | TOTAL SHEETS |
|---------------------|--------|--------------------|-------------|-----------|--------------|
| KAUAI | HAWAII | ER-14(8) | 2007 | 11 | 21 |



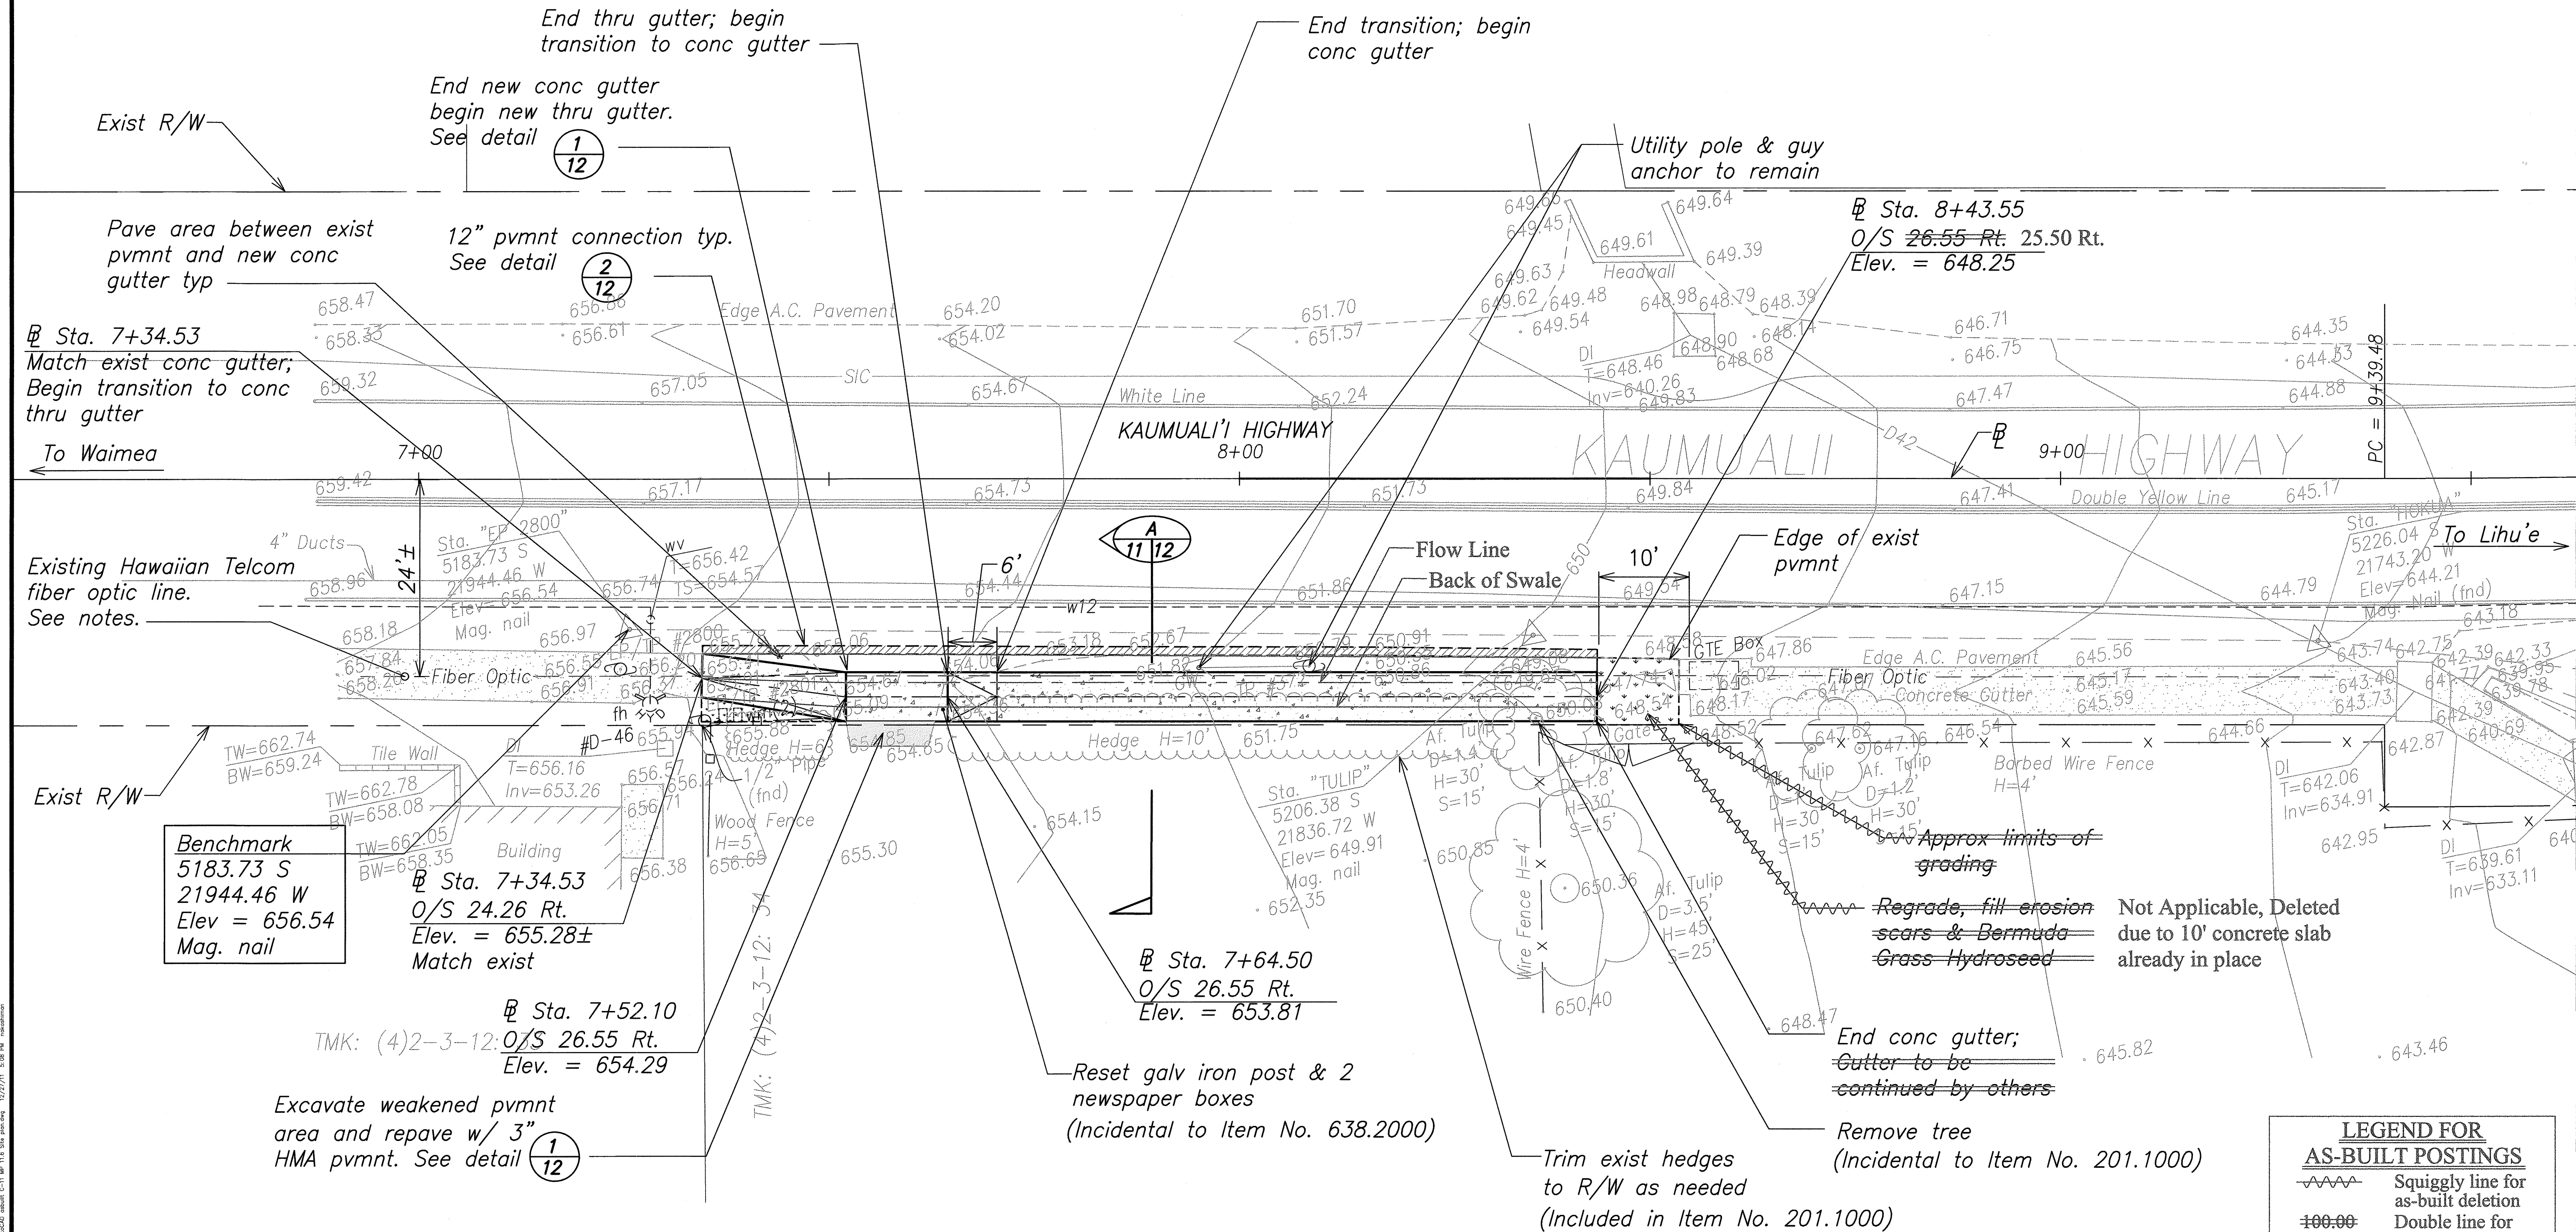


Notes:

- The location the Fiber Optic Line shown is approximate.
- Work within this area should be coordinated with Hawaiian Telcom. See Hawaiian Telcom Facilities Notes on sheet 5 for contact information.
- Contractor may encounter concrete slurry encasement during excavation. See section A on sheet 12.

SITE PLAN

SCALE: 1" = 10'

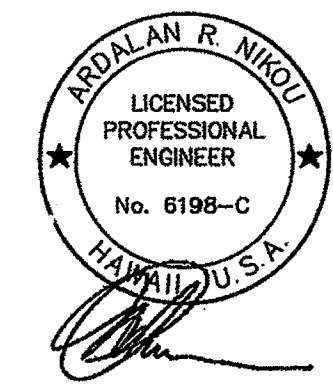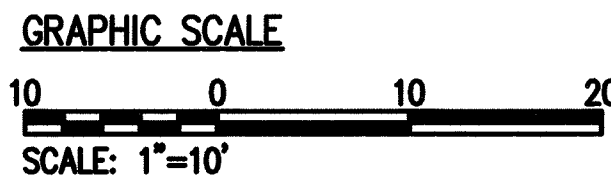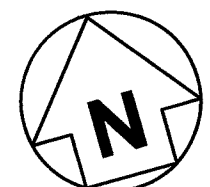


EXPIRATION DATE OF THE LICENSE 4/30/2008
THIS WORK WAS PREPARED BY ME OR UNDER MY SUPERVISION.


STATE OF HAWAII
DEPARTMENT OF TRANSPORTATION
HIGHWAYS DIVISION
MP 11.6
GENERAL SITE PLAN
KAUMUALI' HIGHWAY, EMERGENCY REPAIRS AND DRAINAGE IMPROVEMENTS
FEDERAL-AID PROJECT NO. ER-14(8)
Scale: As Noted Date: Feb 2007
SHEET No. 1 OF 2 SHEETS

"AS-BUILT"


| FED. ROAD DIST. NO. | STATE | FED. AID PROJ. NO. | FISCAL YEAR | SHEET NO. | TOTAL SHEETS |
|---------------------|--------|--------------------|-------------|-----------|--------------|
| KAUAI | HAWAII | ER-14(8) | 2007 | 12 | 21 |

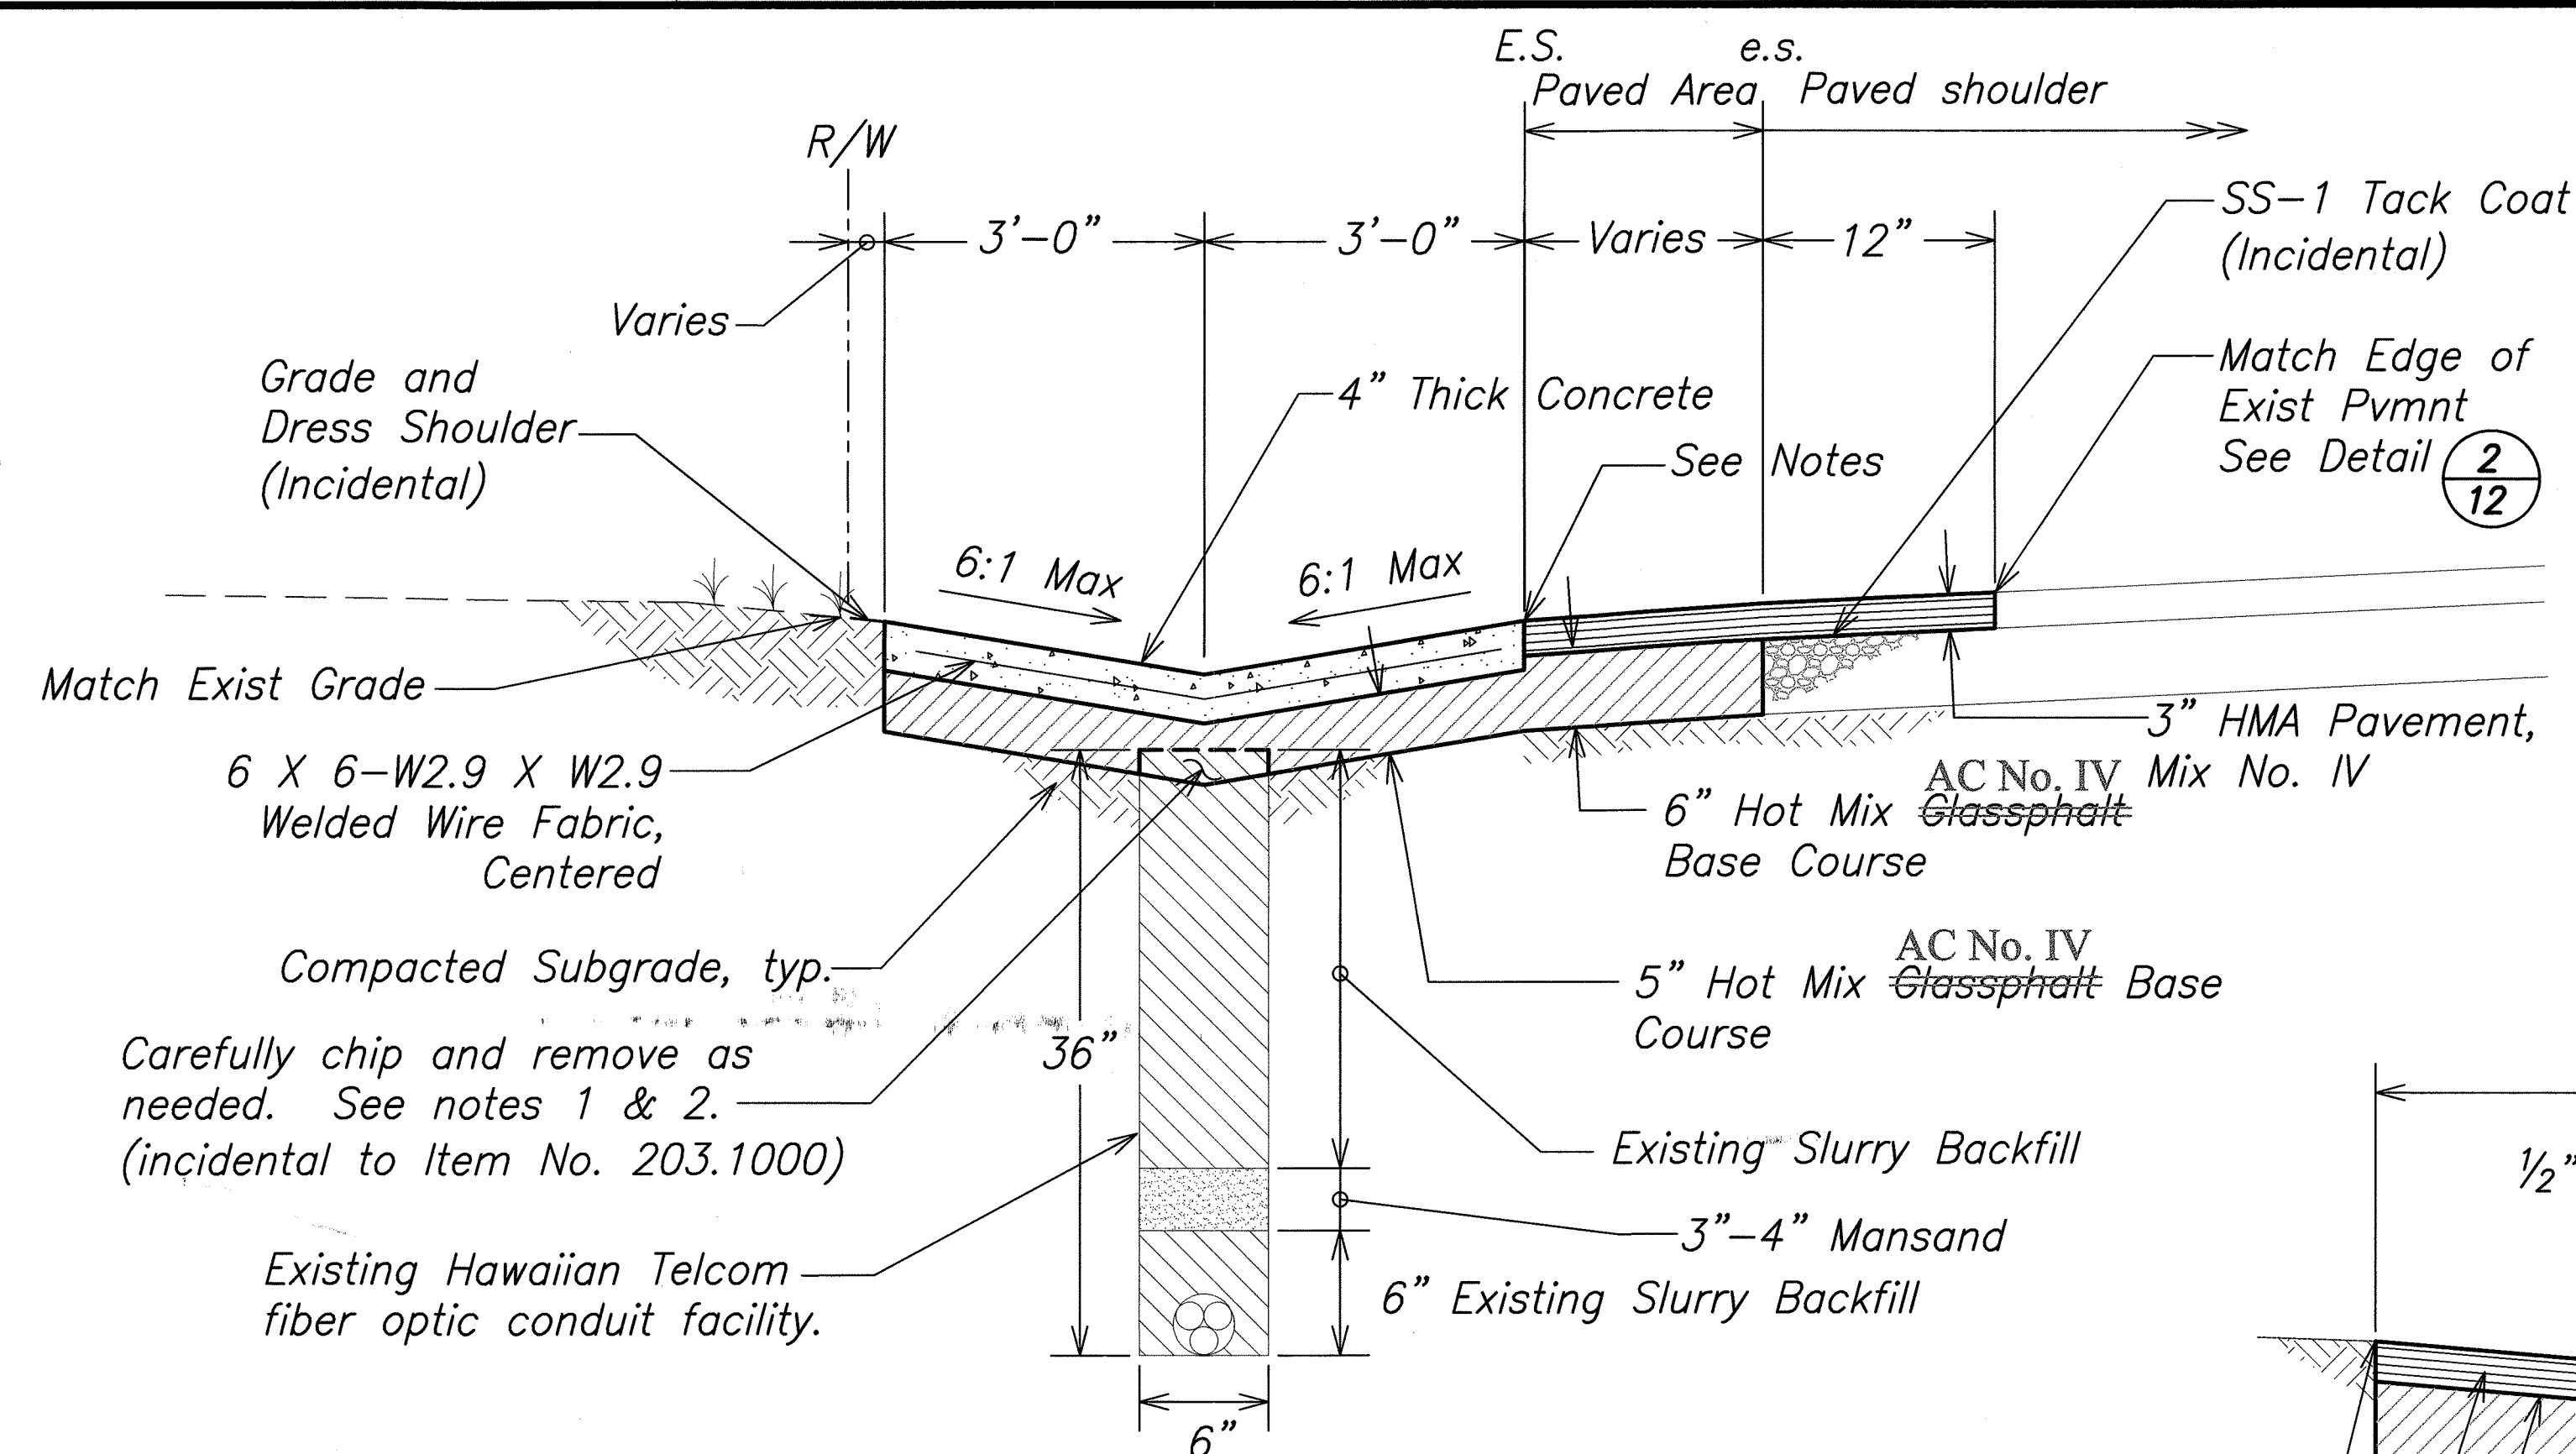

TYPICAL GUTTER SECTION A
NOT TO SCALE

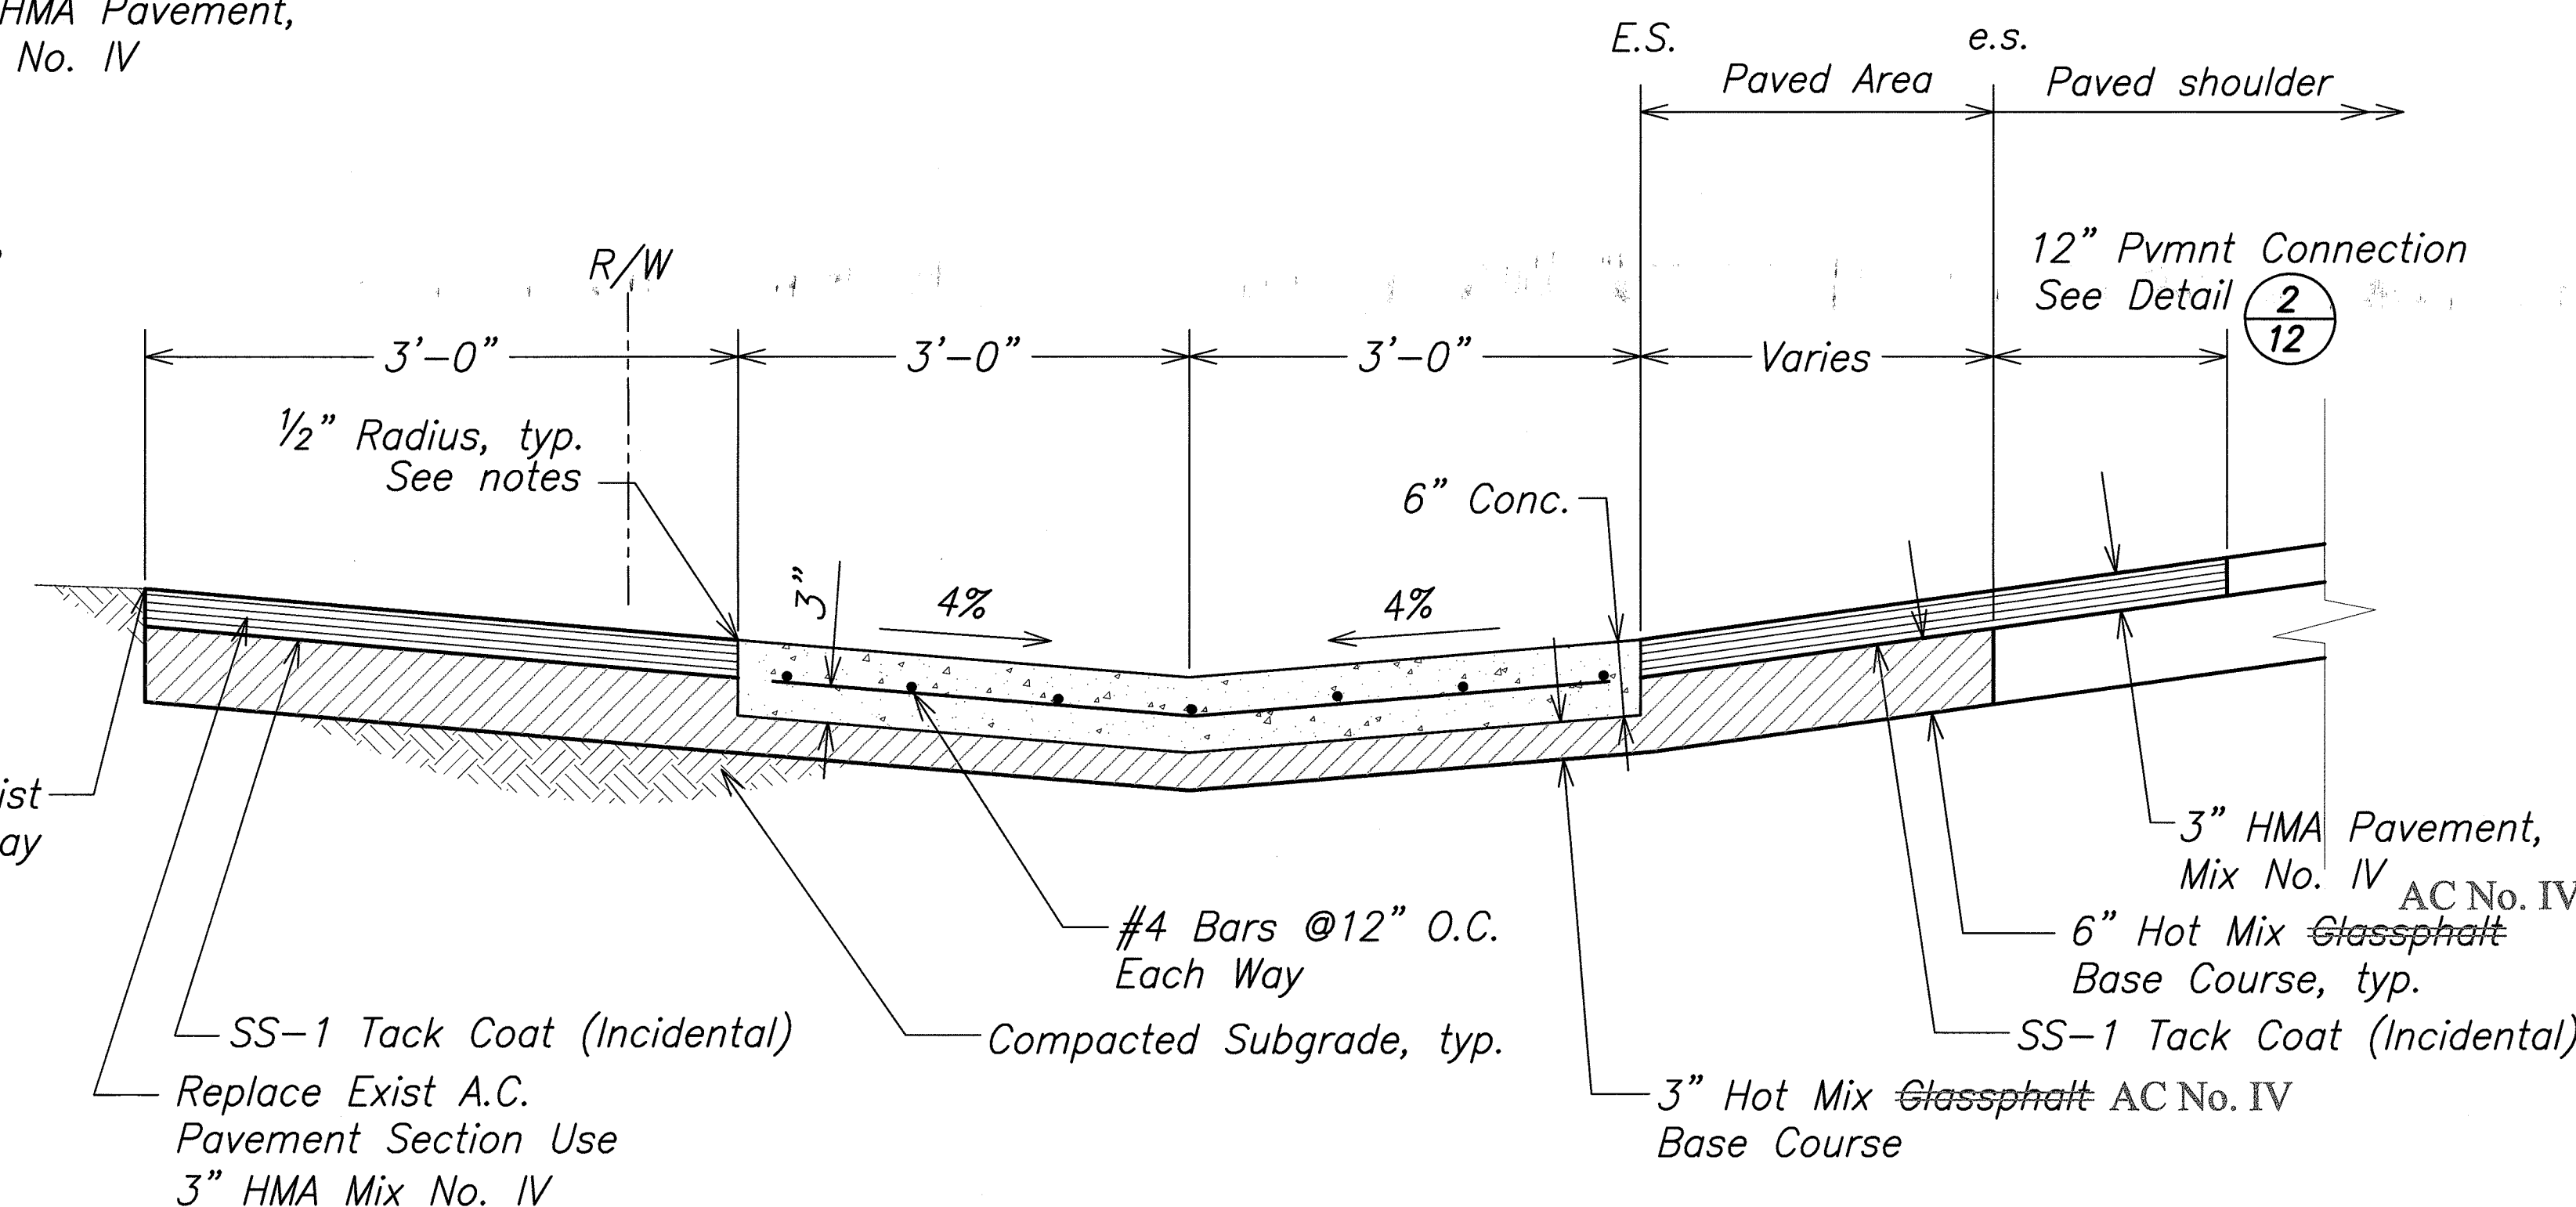

1/12 THRU GUTTER DETAIL
NOT TO SCALE

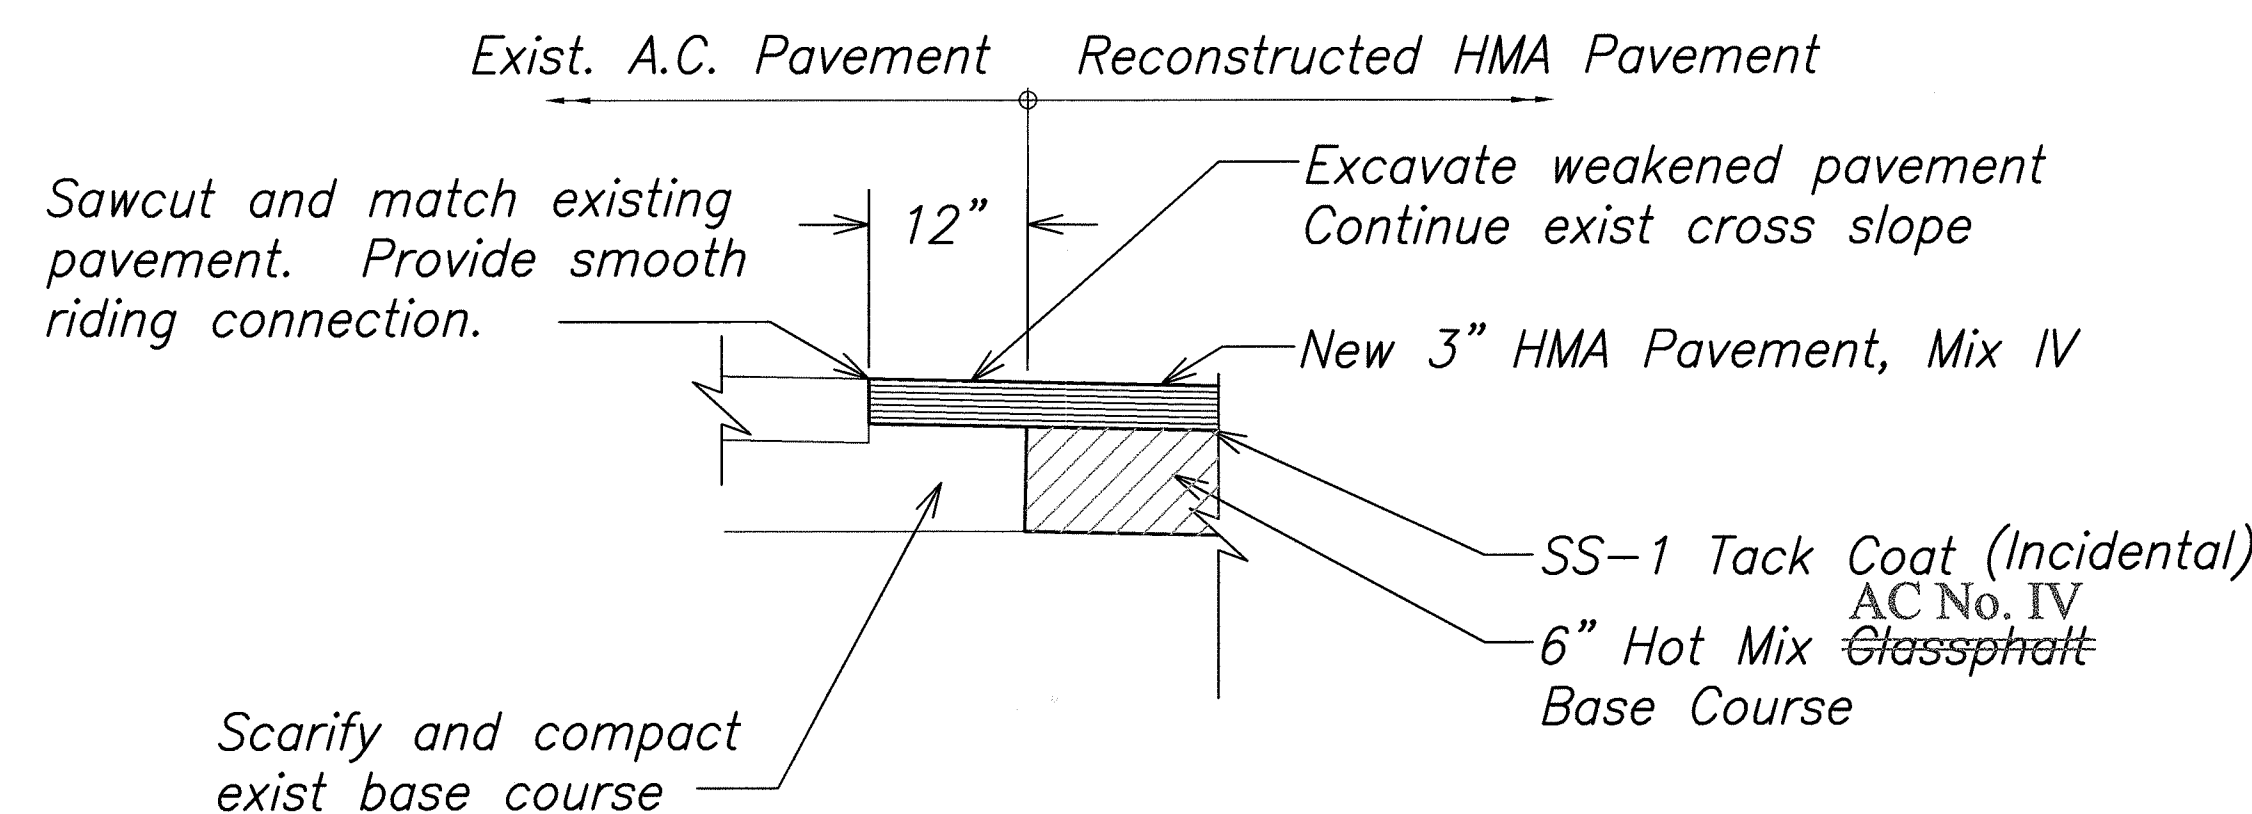


2/12 PAVEMENT CONNECTION DETAIL
NOT TO SCALE

Notes:

- The location and depth of bury of the Fiber Optic Line shown is approximate. Contractor shall use caution while working near fiber optic line. See Hawaiian Telcom Facilities Notes on sheet 5 for further information.
- The Contractor may encounter the top of concrete slurry backfill line during excavation. The Contractor shall carefully demolish the top of the slurry as needed for concrete gutter and base course installation.
- Concrete Shall Be Cast With Formed Edges. A.C. Pavement shall not be used as formwork.
- All Edges Shall Have 1/2" Radius, Unless Otherwise Noted

| LEGEND FOR AS-BUILT POSTINGS | |
|------------------------------|-------------------------------------|
| | Squiggly line for as-built deletion |
| | Double line for as-built deletion |
| | Text for as-built posting |

EarthTech
A tyco International Ltd. Company

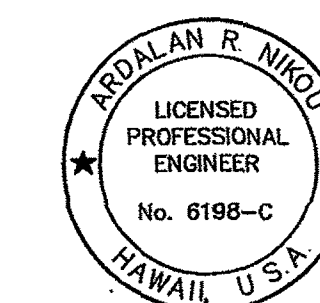

EXPIRATION DATE OF THE LICENSE 4/30/2008
THIS WORK WAS PREPARED BY ME OR UNDER MY SUPERVISION.

| |
|---|
| STATE OF HAWAII DEPARTMENT OF TRANSPORTATION HIGHWAYS DIVISION MP 11.6 DETAILS KAUMUALI' HIGHWAY, EMERGENCY REPAIRS AND DRAINAGE IMPROVEMENTS FEDERAL-AID PROJECT NO. ER-14(8) Scale: As Noted Date: Feb 2007 SHEET No. 2 OF 2 SHEETS |
|---|

"AS-BUILT"