
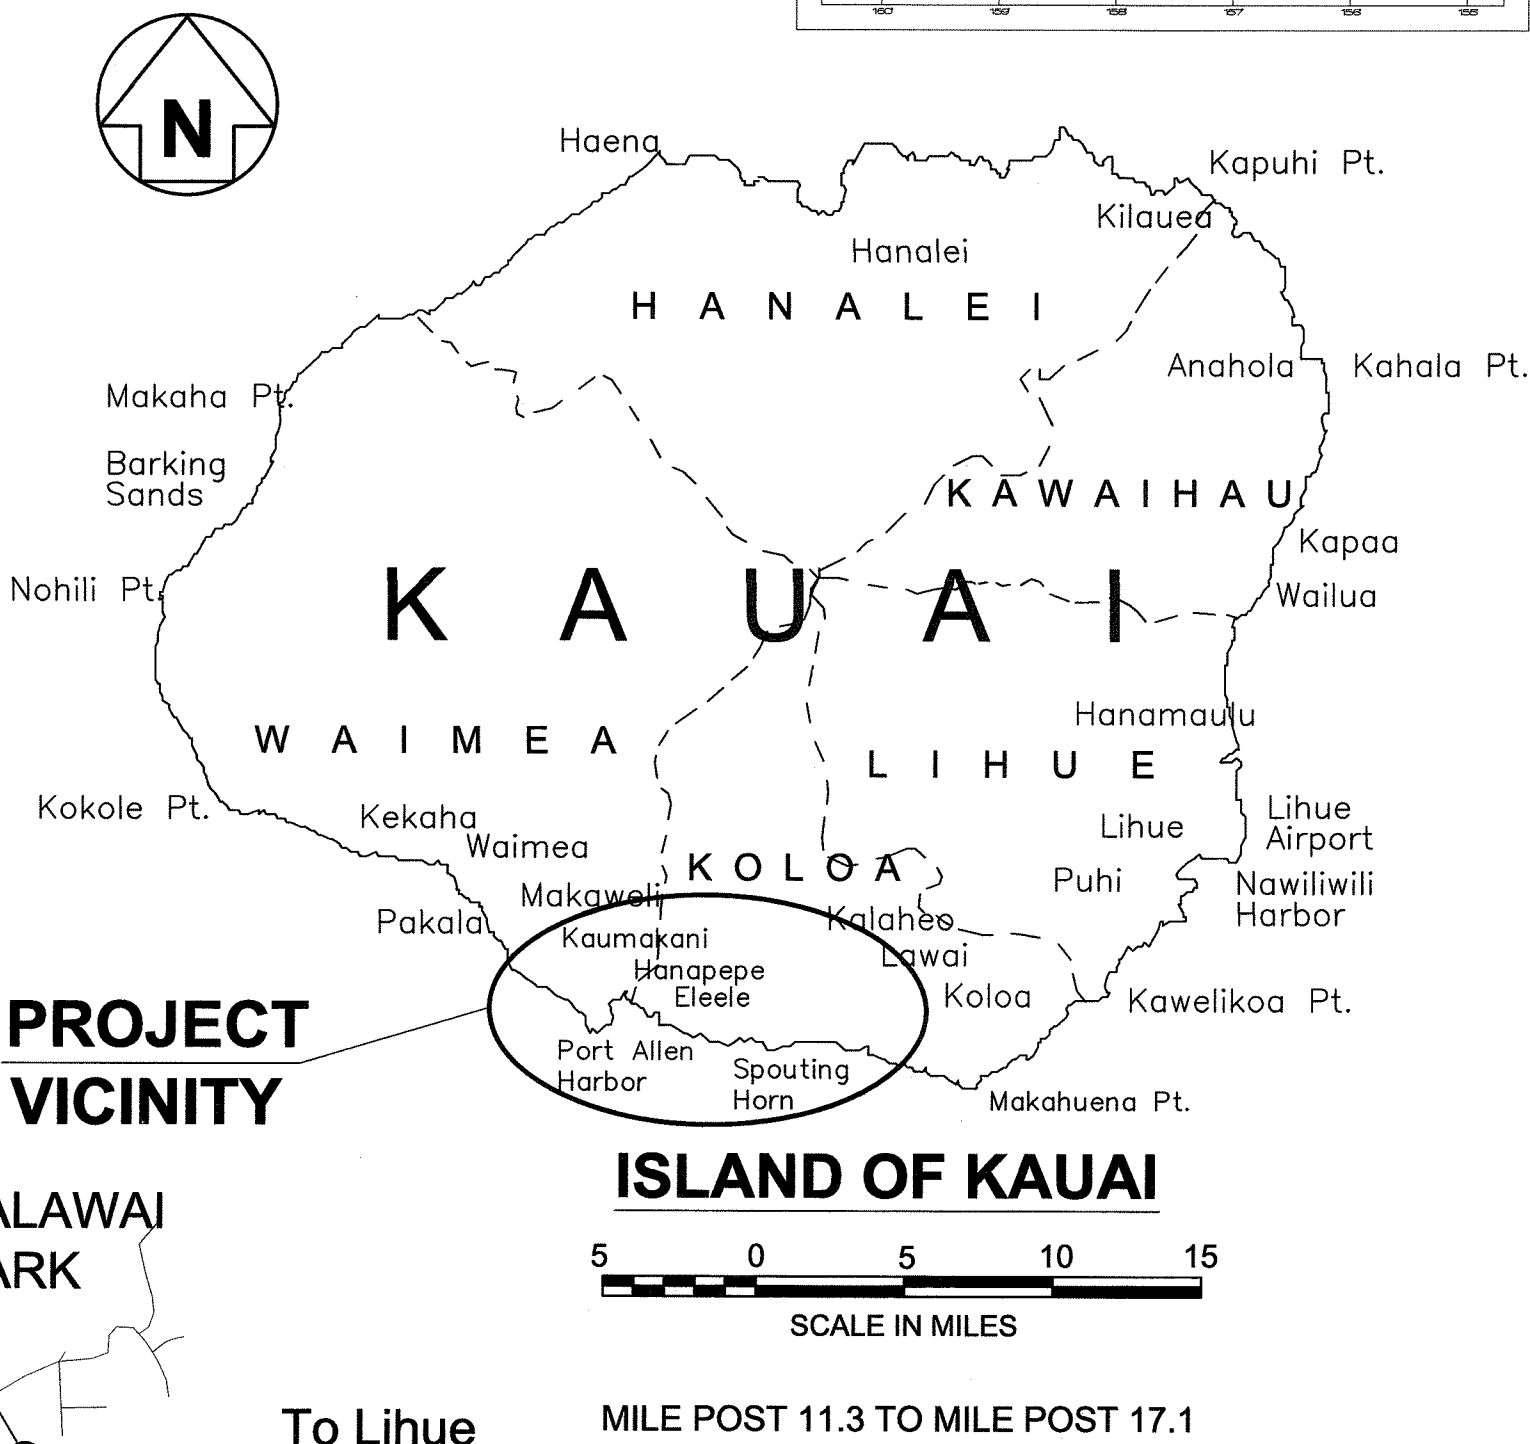


INDEX TO DRAWINGS	
SHEET NO.	DESCRIPTION
1	TITLE SHEET
2	STANDARD PLANS SUMMARY
3 - 5	GENERAL NOTES, UTILITY NOTES
6 - 8	WATER POLLUTION AND EROSION CONTROL
9 - 10	MP 11.3 DRAINAGE IMPROVEMENTS
11 - 12	MP 11.6 DRAINAGE IMPROVEMENTS
13 - 18	MP 17.1 DRAINAGE IMPROVEMENTS
19 - 21	TRAFFIC CONTROL


STATE OF HAWAII  
DEPARTMENT OF TRANSPORTATION  
HIGHWAYS DIVISION  
HONOLULU, HAWAII  
"AS-BUILT"  
PLANS FOR  
KAUMUALII HIGHWAY  
EMERGENCY REPAIRS AND  
DRAINAGE IMPROVEMENTS  
AT VARIOUS LOCATIONS  
FEDERAL-AID PROJECT NO. ER-14(8)  
DISTRICTS OF KOLOA AND WAIMEA  
ISLAND OF KAUAI

FED. ROAD DIST. NO.	STATE	FED. AID PROJ. NO.	FISCAL YEAR	SHEET NO.	TOTAL SHEETS
KAUAI	HAWAII	ER-14(8)	2007	1	21

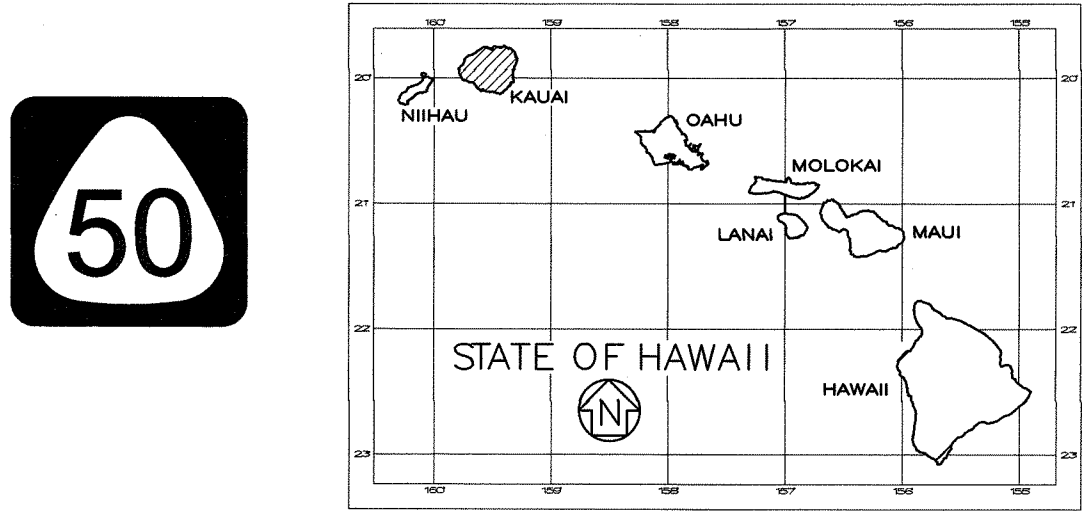

P:\USIG\SES\98092-DOT Kauai Emergency Flood Mitigation\400 Technical Drawings\As-Built - Drainage Improv\C-01.dwg 12/27/11 4:53 PM nokashiman

EARTH TECH DESIGNED BY  
HWY-K MANAGED BY  
(808) 241-3000 PHONE  
APRIL 2007 DATE

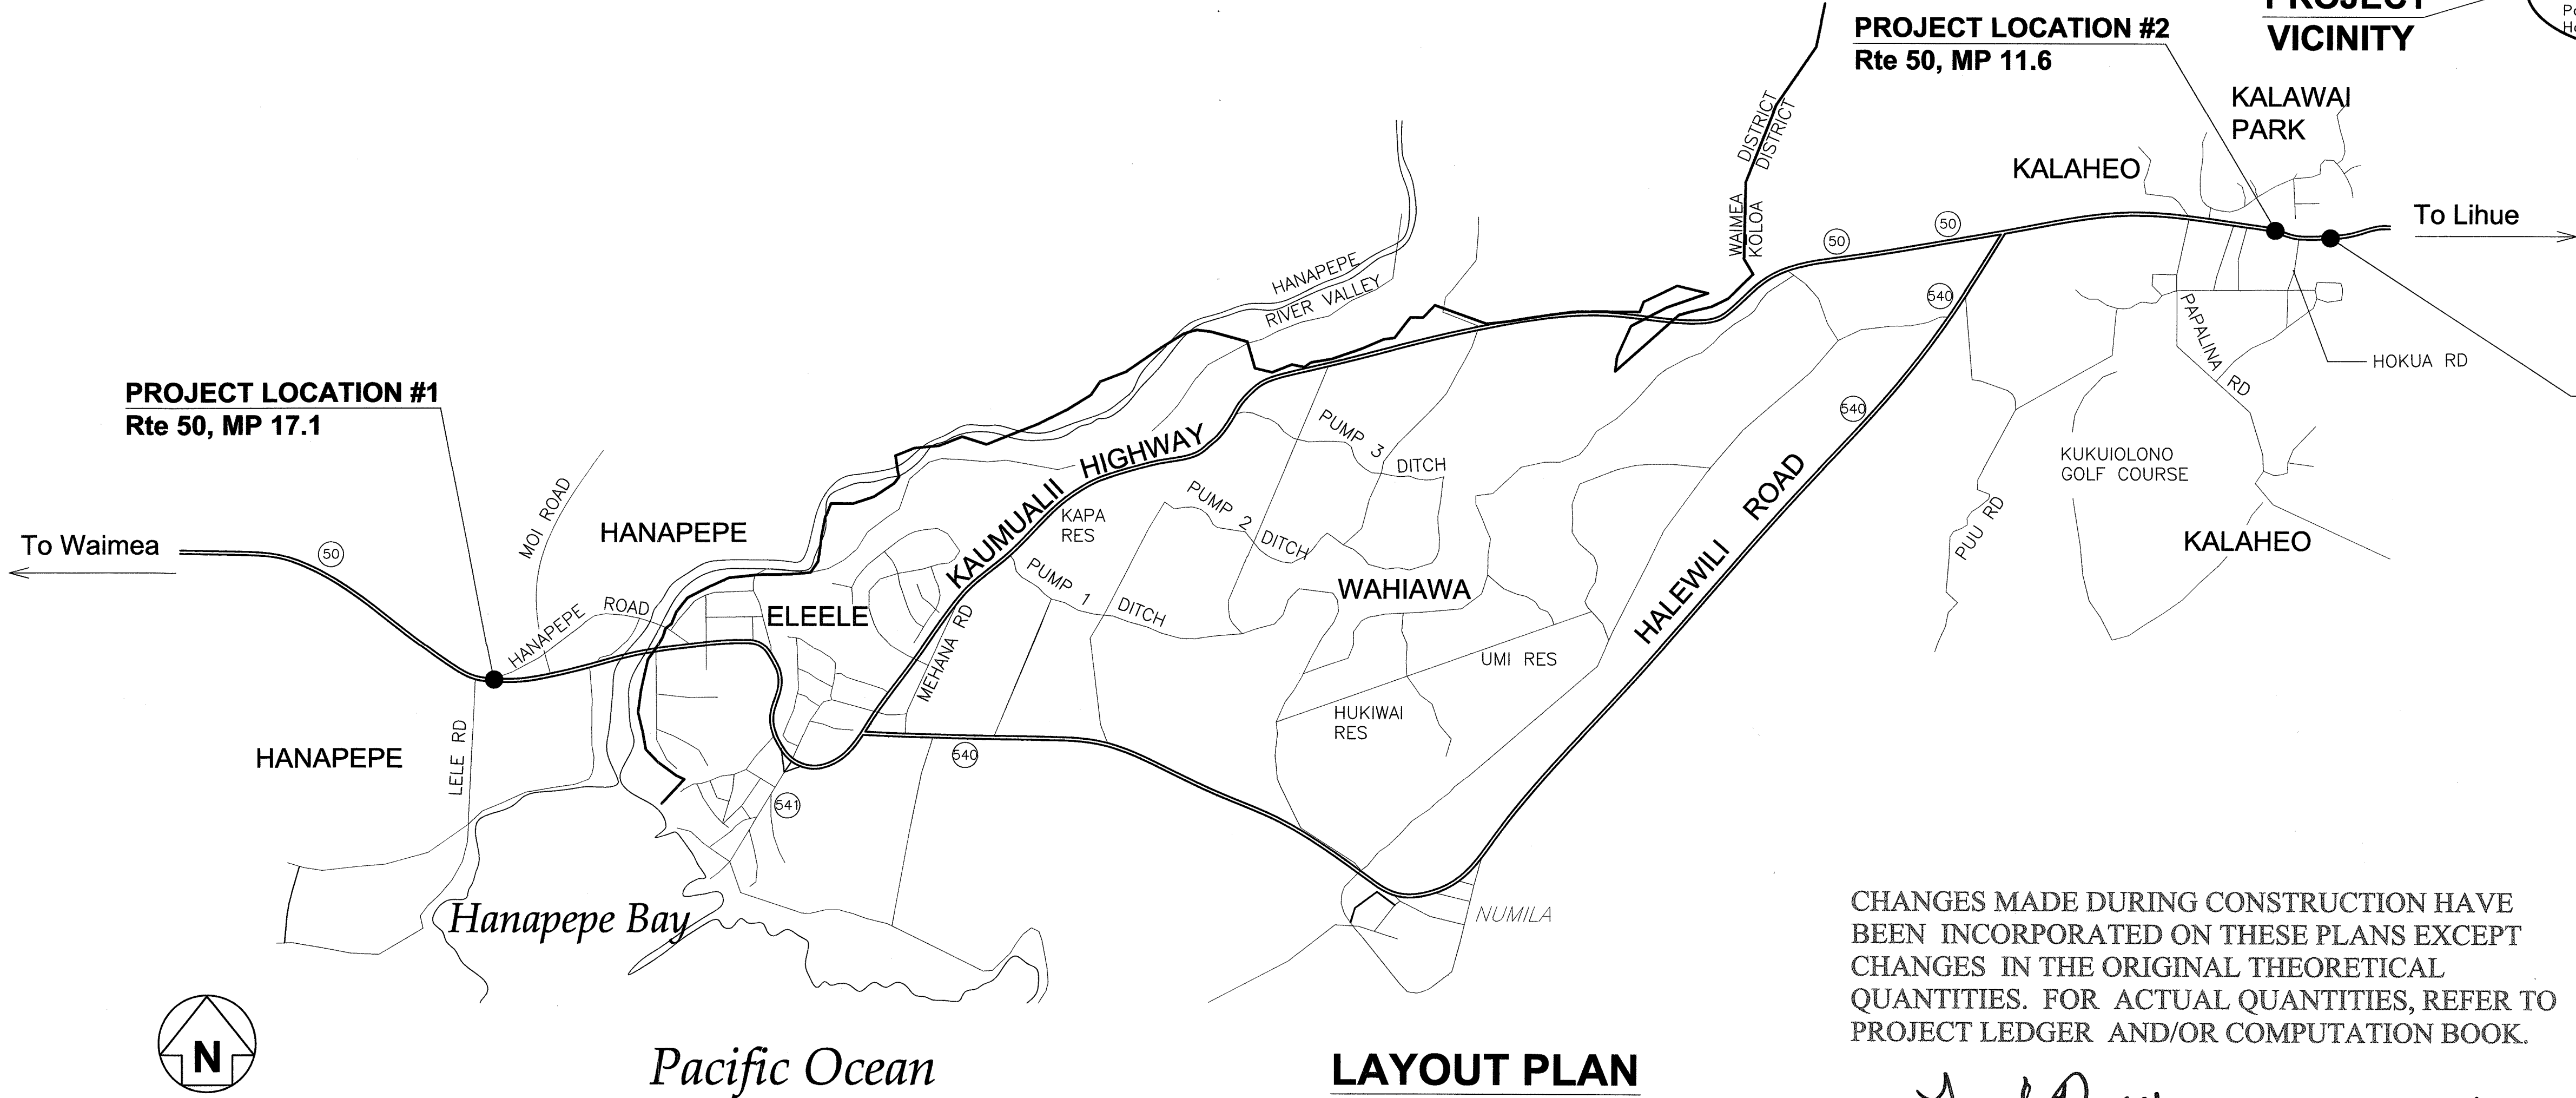

CHANGES MADE DURING CONSTRUCTION HAVE BEEN INCORPORATED ON THESE PLANS EXCEPT CHANGES IN THE ORIGINAL THEORETICAL QUANTITIES. FOR ACTUAL QUANTITIES, REFER TO PROJECT LEDGER AND/OR COMPUTATION BOOK.

*Fred Reyes*  
RESIDENT ENGINEER

1/7/12  
DATE

DEPARTMENT OF TRANSPORTATION STATE OF HAWAII	
APPROVED:	
<i>J. H. H.</i> DIR. OF TRANSPORTATION	<i>5/1/07</i> DATE