


FED. ROAD DIST. NO.	STATE	PROJ. NO.	FISCAL YEAR	SHEET NO.	TOTAL SHEETS
HAWAII	HAW.	50C-01-07M	2007	11	24

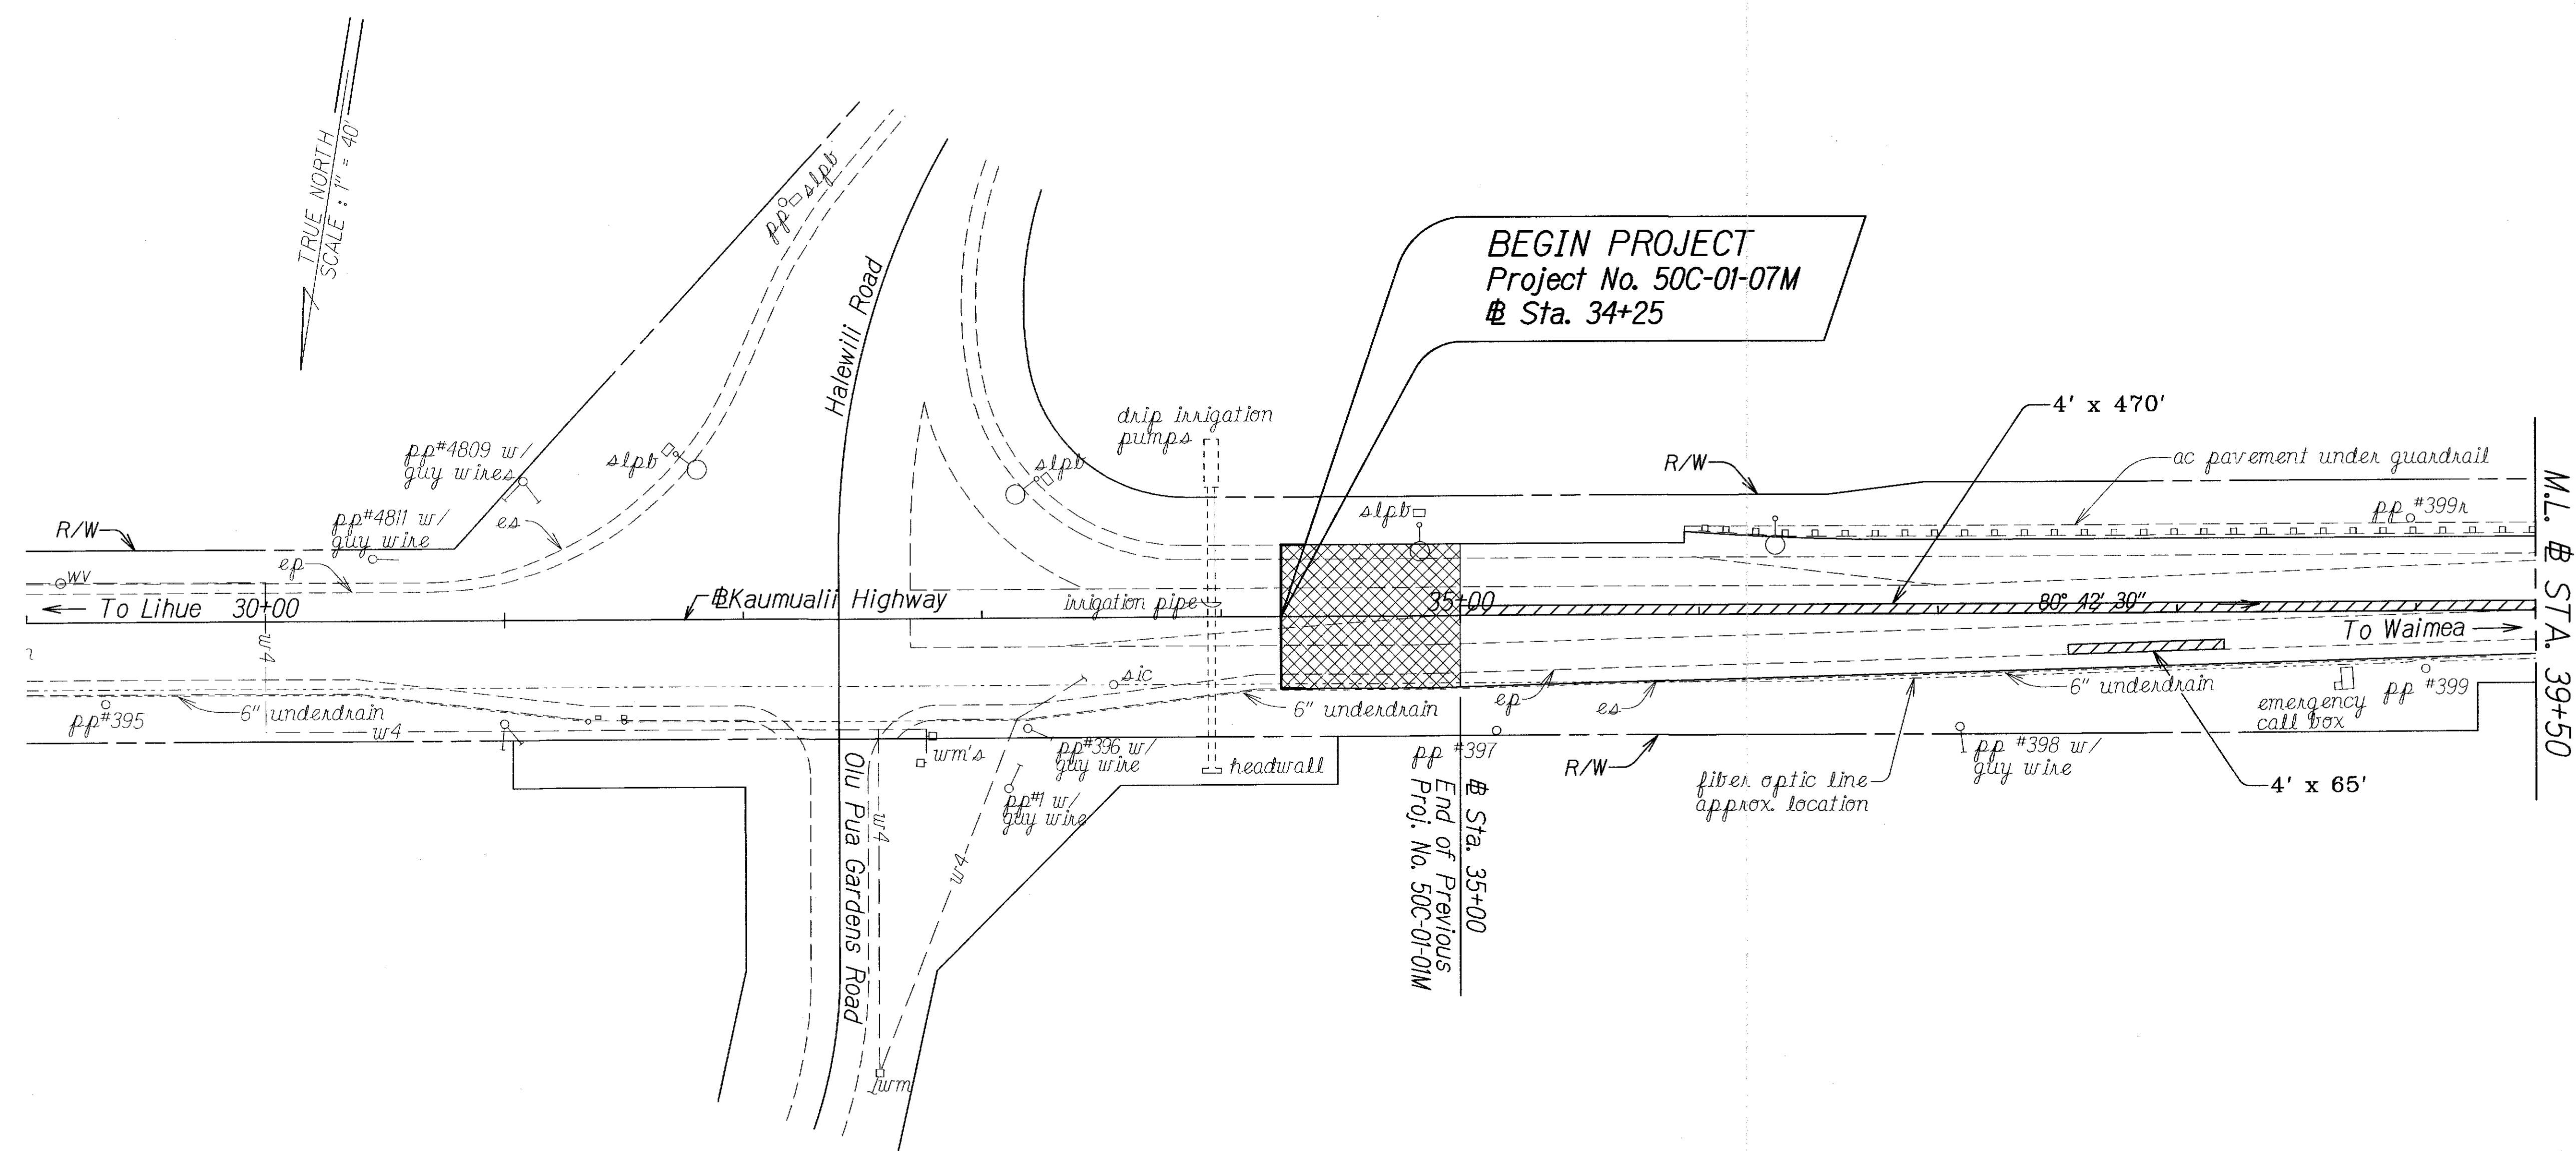

DATE	9/06
DESIGNED BY	
DRAWN BY	
CHECKED BY	
IN CHARGE	
NOTED	
REVISIONS	
BY	
DATE	

LEGEND FOR AS-BUILT POSTINGS	
	Squiggly line for as-built deletion
	Double line for as-built deletion
Roadway	Text for as-built posting

— Cold Plane RT. Pavement 2"

STATE OF HAWAII
DEPARTMENT OF TRANSPORTATION
HIGHWAYS DIVISION


ROADWAY PLAN

KAUMUALII HIGHWAY RESURFACING
Halewili Road to Vicinity of Wahiawa Bridge
Project No. 50C-01-07M


Scale: 1" = 40' Date: October 2006

SHEET No. 1 OF 4 SHEETS

FED. ROAD DIST. NO.	STATE	PROJ. NO.	FISCAL YEAR	SHEET NO.	TOTAL SHEETS
HAWAII	HAW.	50C-01-07M	2007	12	24

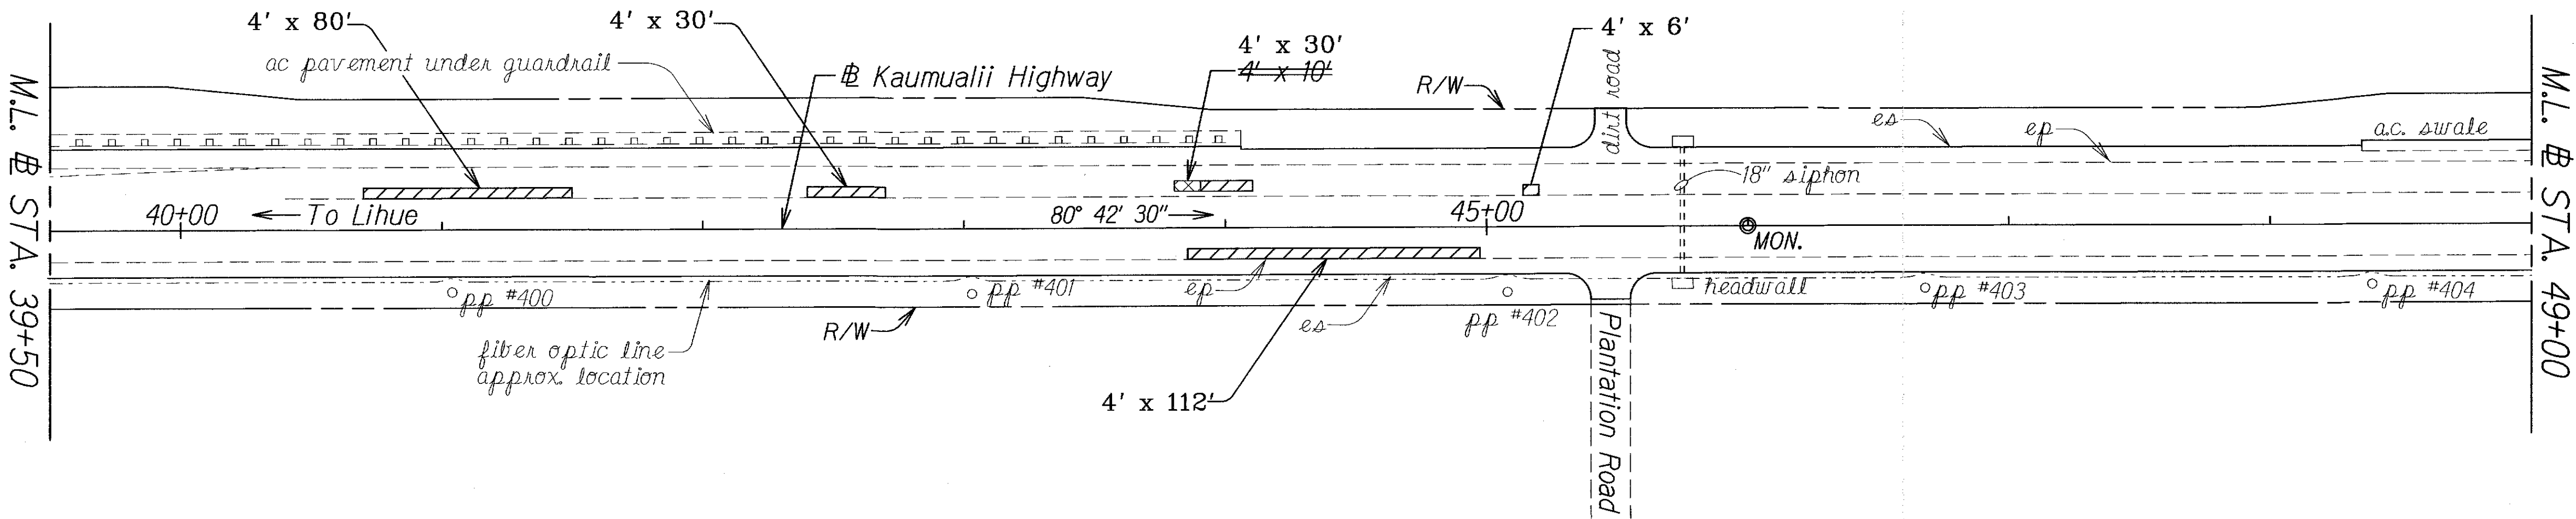

TRUE NORTH
SCALE: 1" = 40'

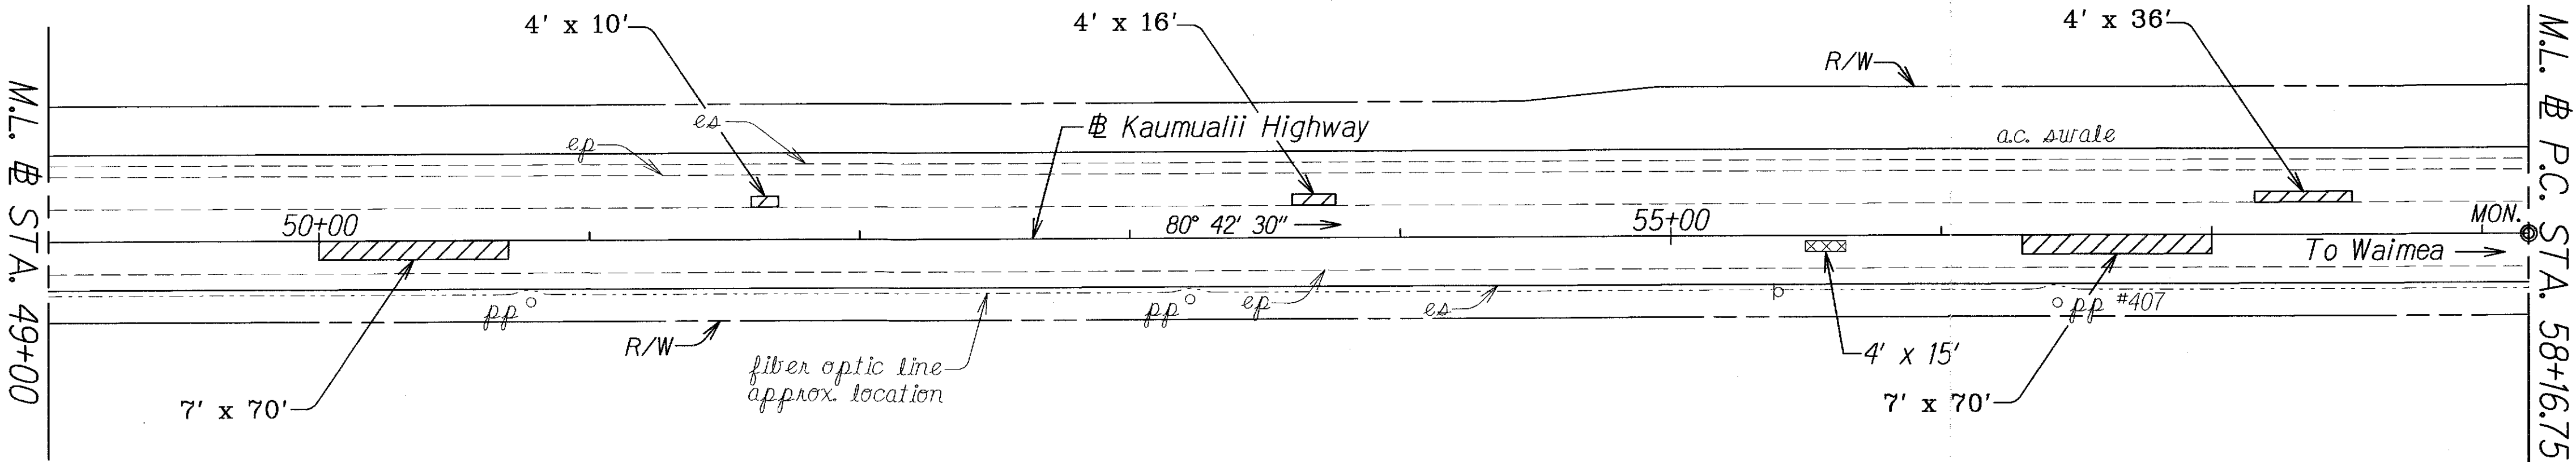

TRUE NORTH
SCALE: 1" = 40'

ORIGINAL PLAN	SURVEY PLOTTED BY	DATE
NOTE BOOK	DRAWN BY	8/06
DESIGNED BY	CHECKED BY	
QUANTITIES BY		
CHECKED BY		

LEGEND FOR AS-BUILT POSTINGS	
	Squiggly line for as-built deletion
	Double line for as-built deletion
Roadway	Text for as-built posting

STATE OF HAWAII
DEPARTMENT OF TRANSPORTATION
HIGHWAYS DIVISION

ROADWAY PLAN


KAUMUALII HIGHWAY RESURFACING
Halewili Road to Vicinity of Wahiawa Bridge
Project No. 50C-01-07M

Scale: 1" = 40'
Date: October 2006


SHEET No. 2 OF 4 SHEETS

"AS-BUILT"

FED. ROAD DIST. NO.	STATE	PROJ. NO.	FISCAL YEAR	SHEET NO.	TOTAL SHEETS
HAWAII	HAW.	50C-01-07M	2007	14	24

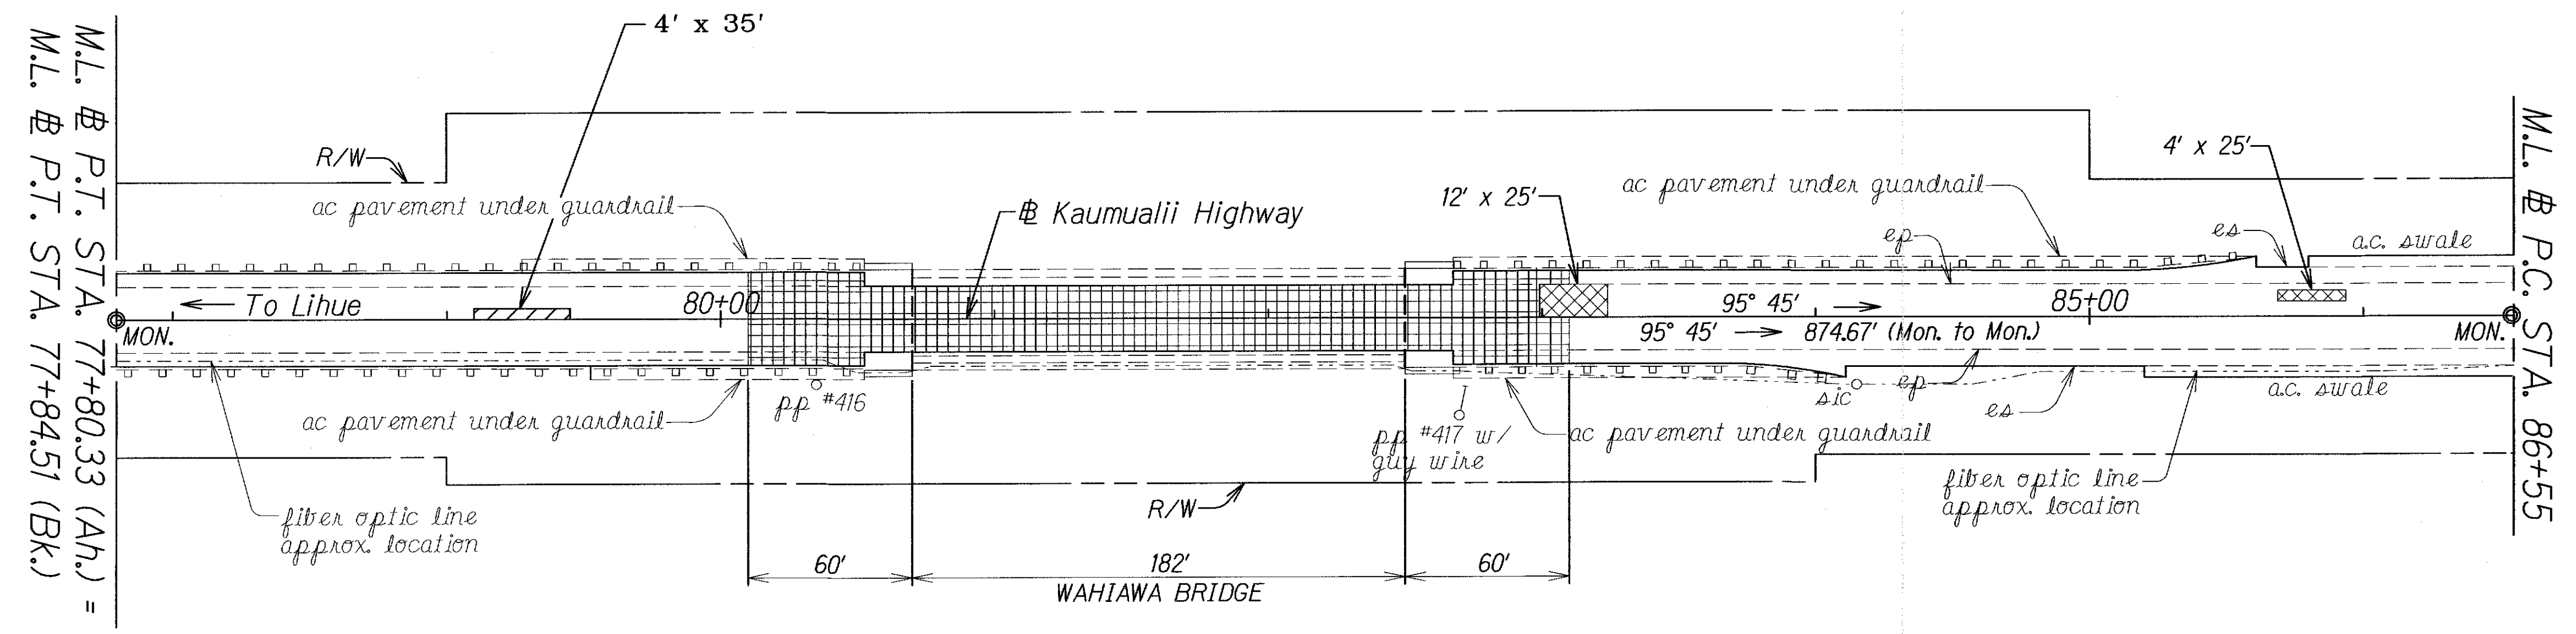

⊕ CURVE DATA
 $\Delta = 13^\circ 35' 00''$
 $R = 3,500.00$
 $T = 416.83$
 $C = 827.82$
 $L_c = 829.76$

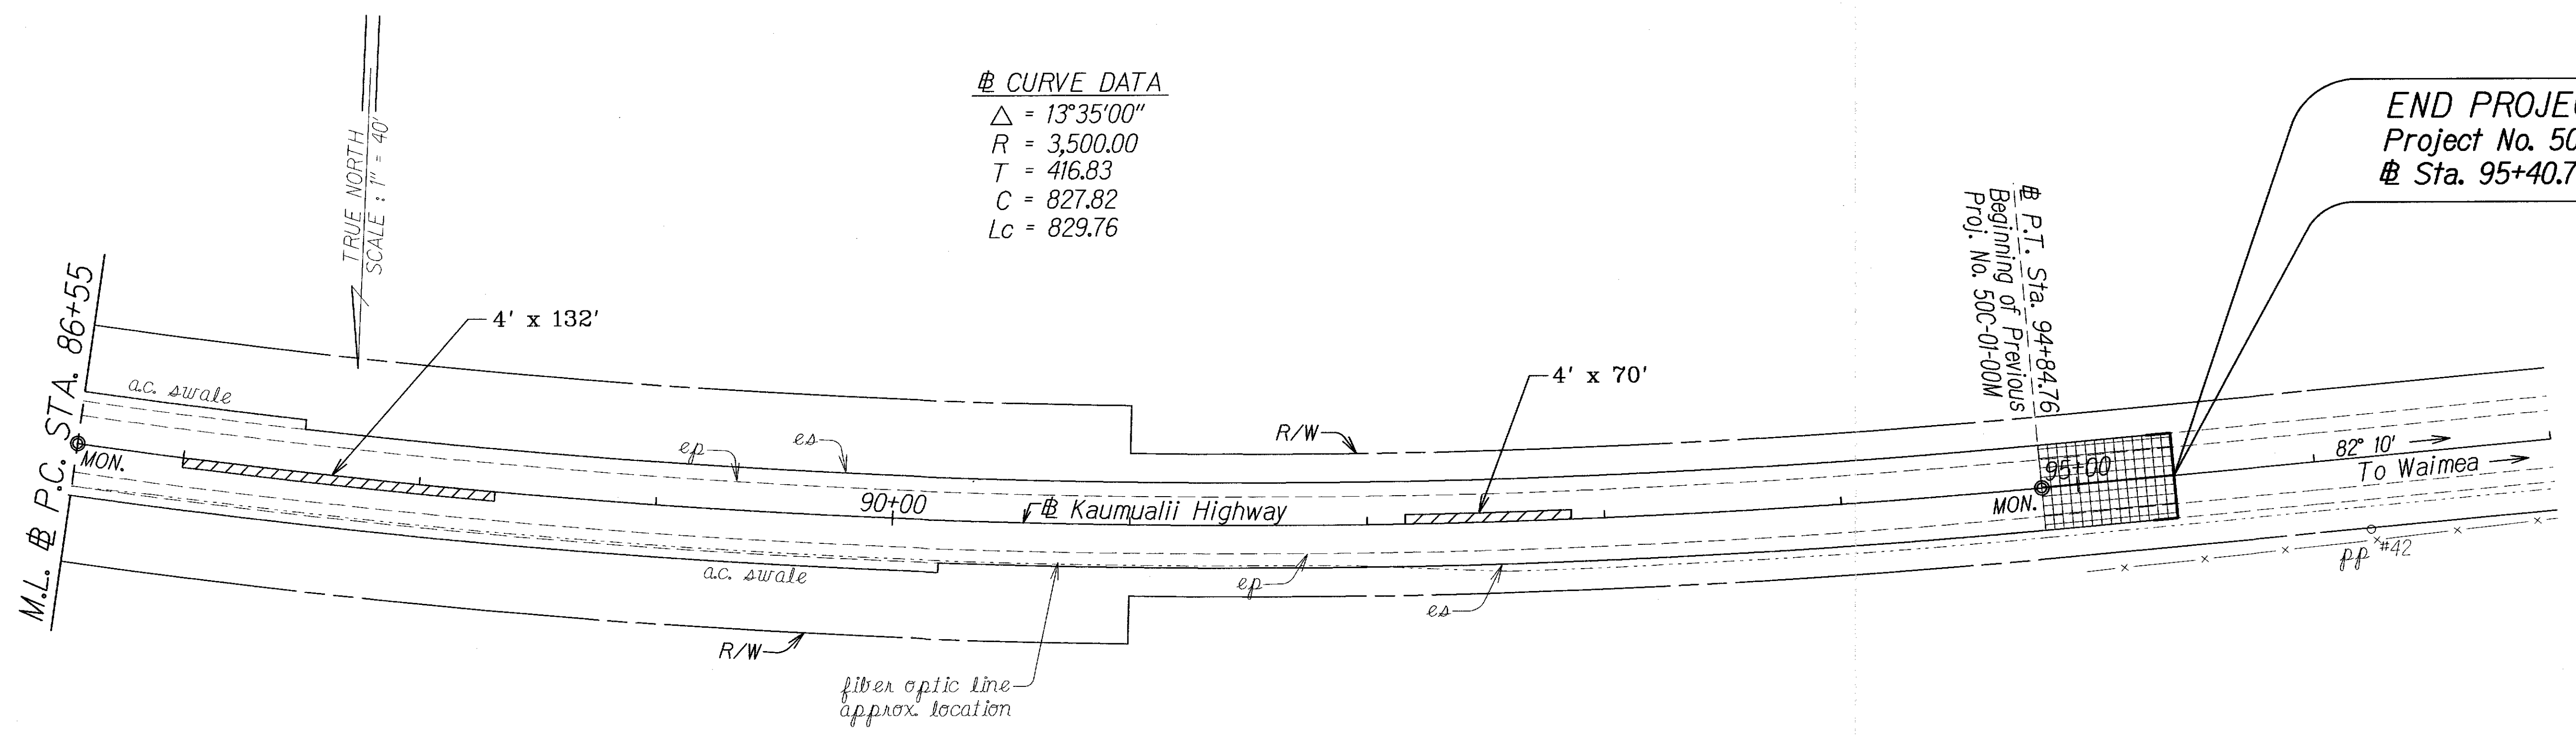

END PROJECT
 Project No. 50C-01-07M
 ⊕ Sta. 95+40.76

⊕ P.I. Sta. 94+84.76
 Beginning of Previous
 Proj. No. 50C-01-00M

LEGEND FOR AS-BUILT POSTINGS	
	Squiggly line for as-built deletion
	Double line for as-built deletion
Roadway	Text for as-built posting

STATE OF HAWAII
 DEPARTMENT OF TRANSPORTATION
 HIGHWAYS DIVISION

ROADWAY PLAN

KAUMUALII HIGHWAY RESURFACING
 Halewili Road to Vicinity of Wahiawa Bridge
 Project No. 50C-01-07M

Scale: 1" = 40' Date: October 2006

SHEET No. 4 OF 4 SHEETS

"AS-BUILT"

ORIGINAL PLAN	DATE: 2/06
SURVEY PLOTTED BY	
DRAWN BY	
DESIGNED BY	
CHECKED BY	
NOTED BY	
CONTRACT NO.	
PROJECT NO.	
SHEET NO.	
TOTAL SHEETS	