

INDEX TO DRAWINGS	
SHEET NO.	DESCRIPTION
1	TITLE SHEET
2	STANDARD PLANS SUMMARY
3	GENERAL NOTES AND LEGEND
4 - 5	WATER POLLUTION AND EROSION CONTROL NOTES
6	CONCRETE REPAIR DETAILS AND NOTES
7	TYPICAL BRIDGE SECTION
8 - 12	SPALL REPAIR PLANS
13	HIGH SPEED UNDIVIDED HIGHWAY WORK ZONE SIGNING PLAN, NOTES AND DETAILS

Sheet No. 113-1 is a supplementary sheet to this project.  
Total sheet count after "As-Built" posting, 15 sheets.

STATE OF HAWAII

DEPARTMENT OF TRANSPORTATION

HIGHWAYS DIVISION

HONOLULU, HAWAII

"AS-BUILT"

PLANS FOR

KAUMUALII HIGHWAY

SPALL REPAIRS AT WAHIAWA STREAM BRIDGE




VICINITY OF WAHIAWA

PROJECT NO. 50C-02-07M

DISTRICT OF KOLOA

ISLAND OF KAUAI

FED. ROAD DIST. NO.	STATE	PROJ. NO.	FISCAL YEAR	SHEET NO.	TOTAL SHEETS
HAWAII	HAW.	50C-02-07M	2008	1	13

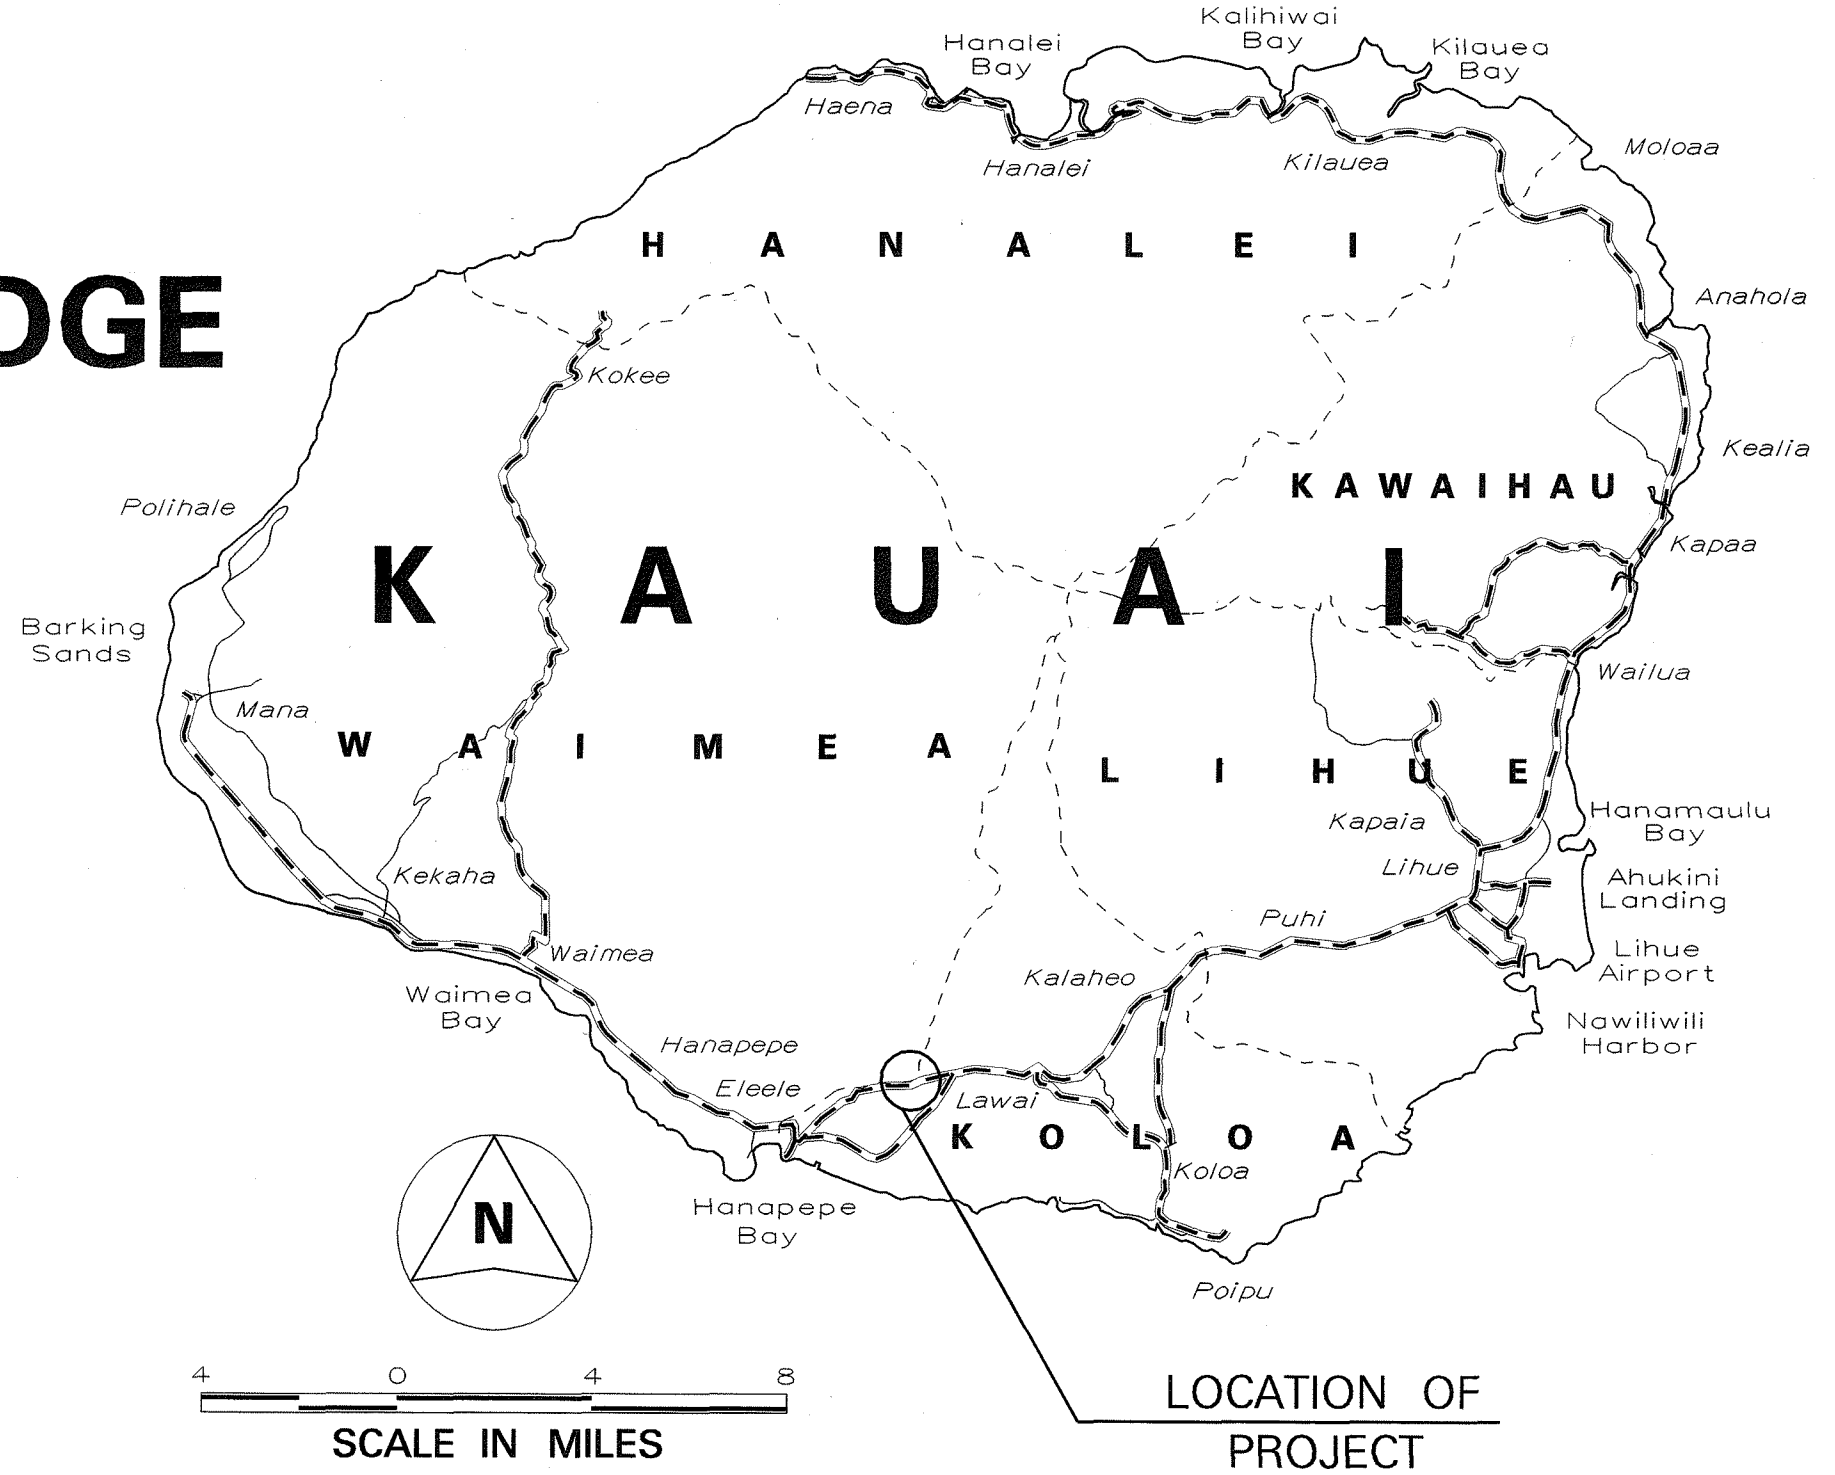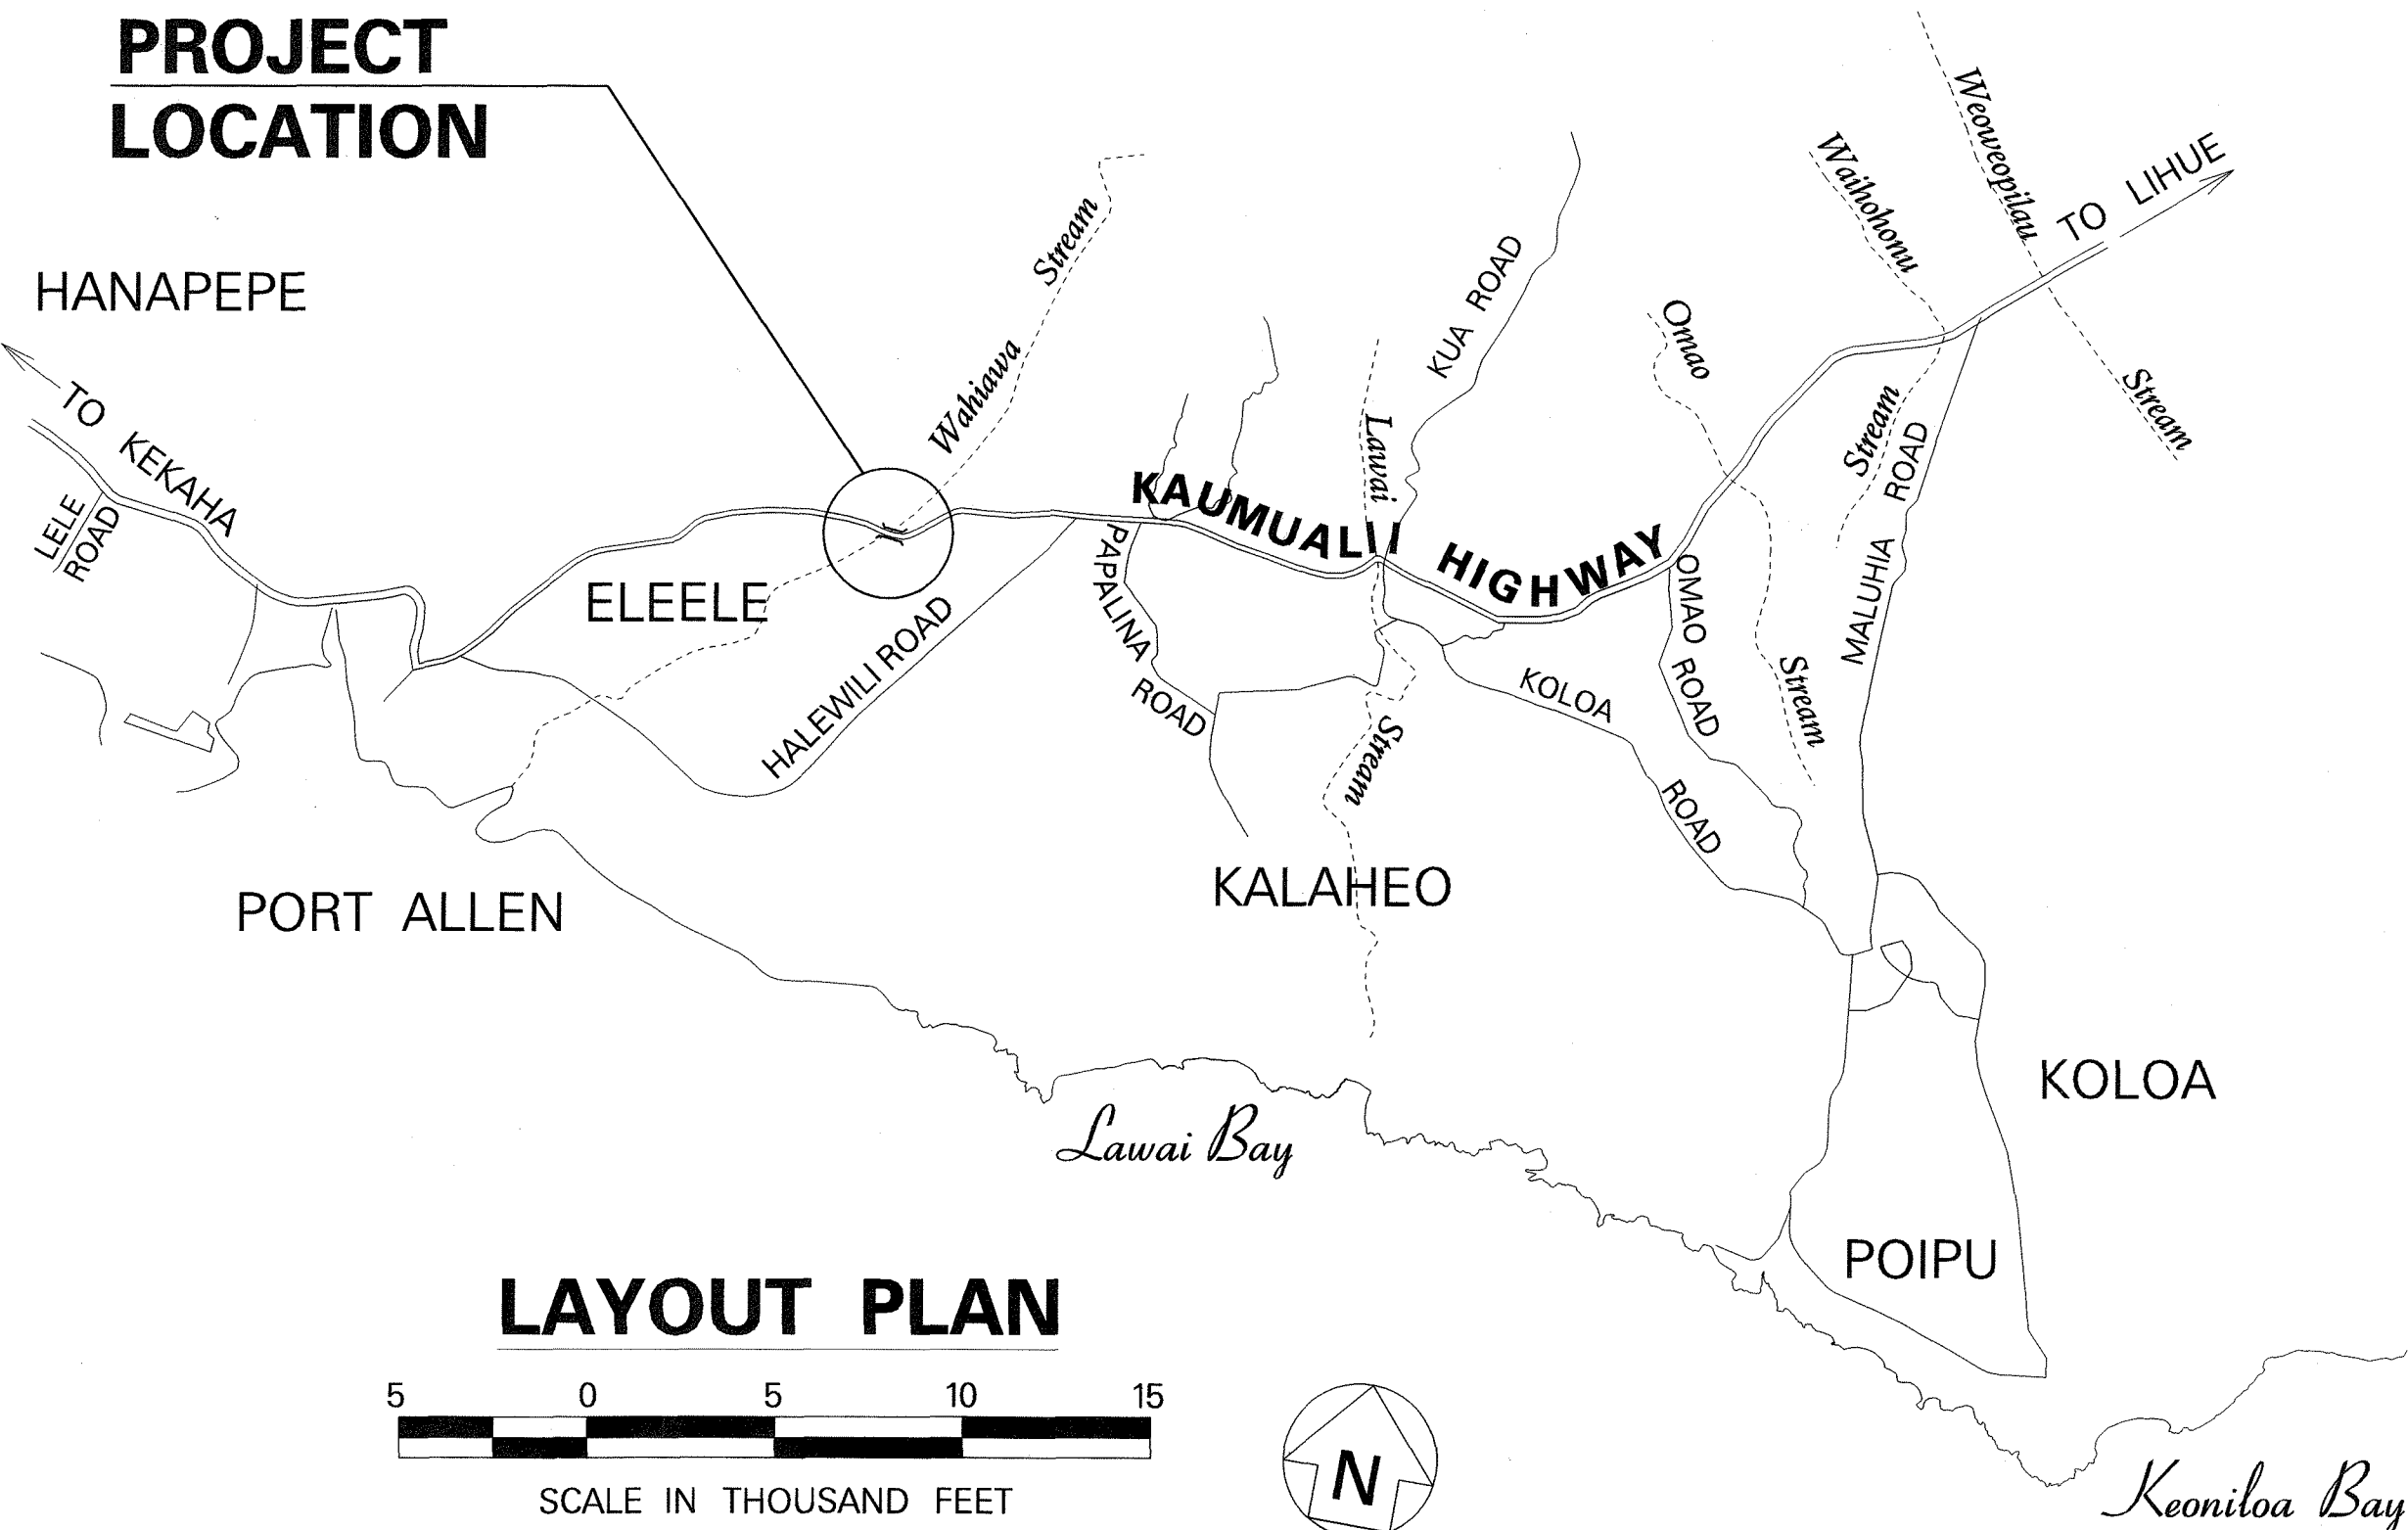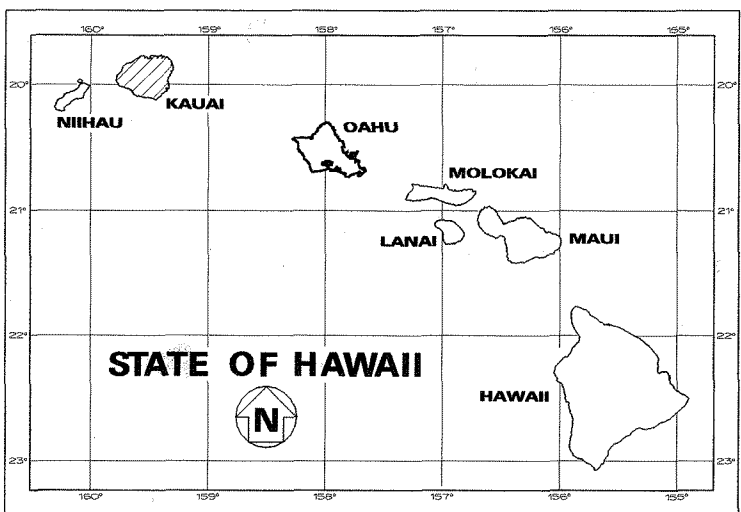

----- FEDERAL AID PROJECTS PREVIOUSLY CONSTRUCTED OR UNDER CONSTRUCTION

MILE POST 13.19 TO MILE POST 13.23

DESIGNED BY  
MANAGED BY  
HWY-KE  
HWY-K  
241-3000  
APRIL 2008  
PHONE  
DATE

CHANGES MADE DURING CONSTRUCTION HAVE BEEN INCORPORATED ON THESE PLANS EXCEPT CHANGES IN THE ORIGINAL THEORETICAL QUANTITIES. FOR ACTUAL QUANTITIES, REFER TO PROJECT LEADER'S COMPUTATION BOOK.

*John H. H.* 4/4/08

DEPARTMENT OF TRANSPORTATION STATE OF HAWAII	
APPROVED:	
<i>John H. H.</i>	4/4/08
DR. OF TRANSPORTATION	DATE