


FED. ROAD DIST. NO.	STATE	PROJ. NO.	FISCAL YEAR	SHEET NO.	TOTAL SHEETS
HAWAII	HAW.	50C-03-07M	2009	23	25

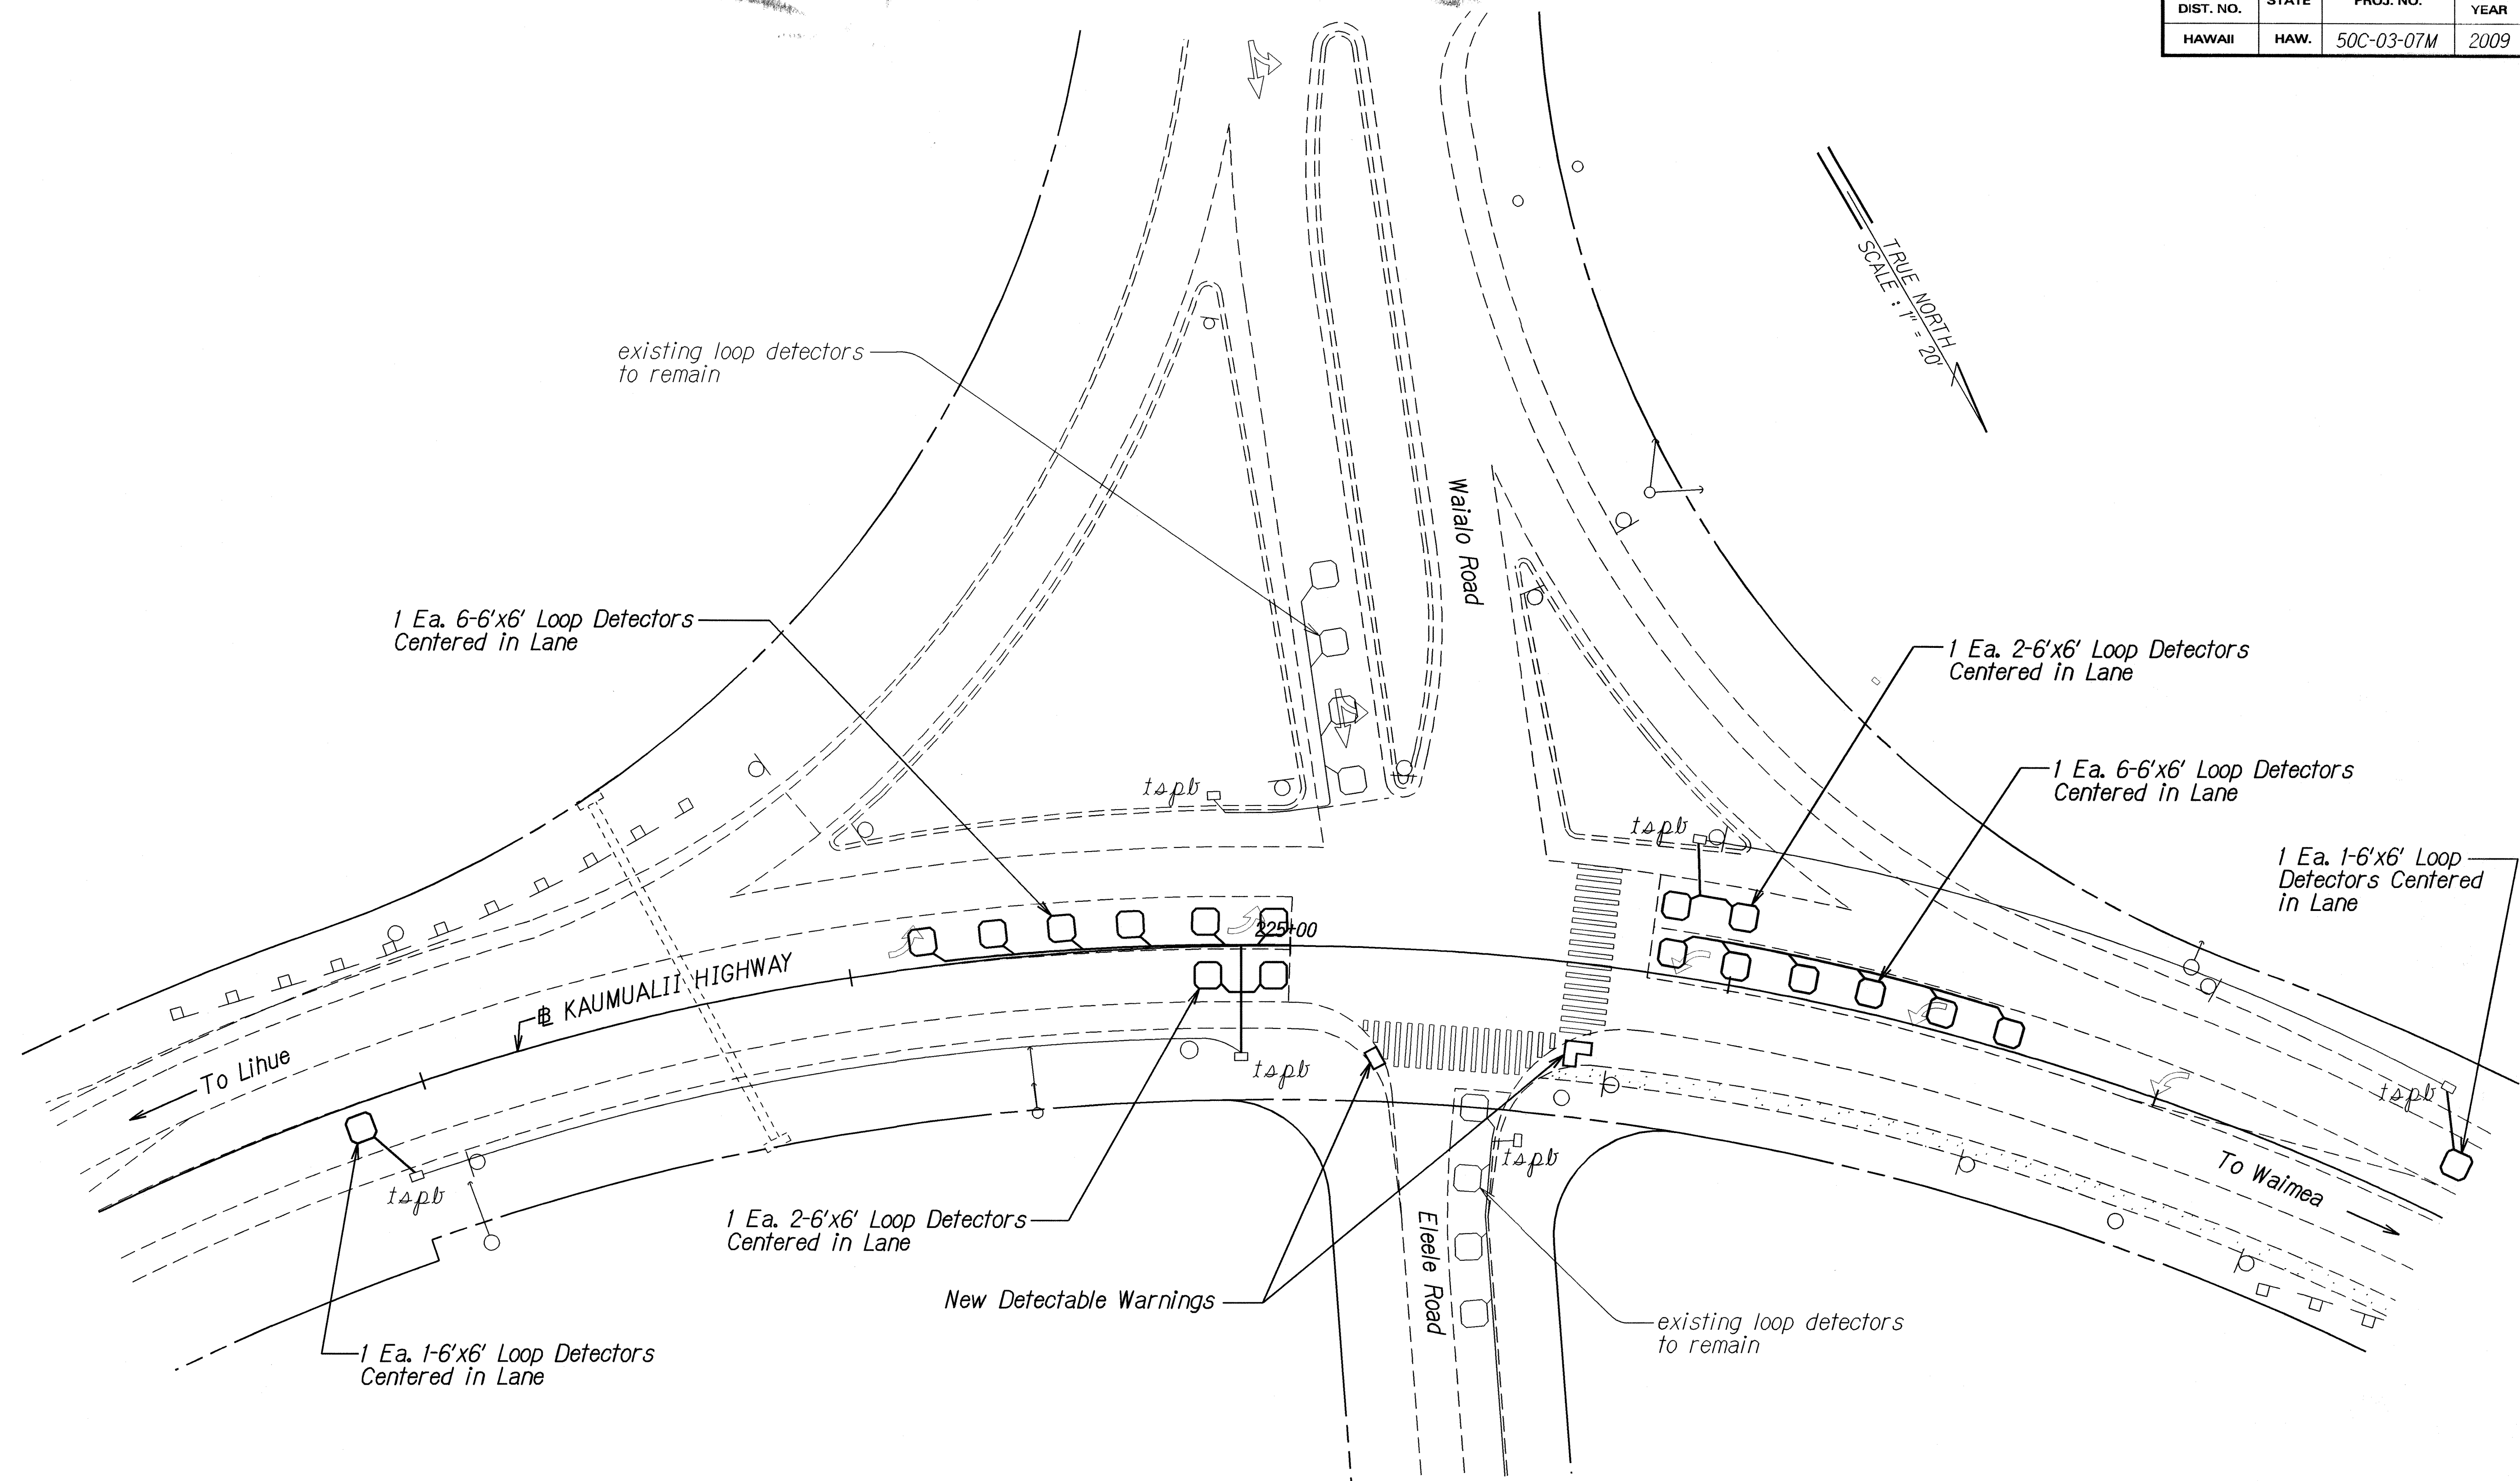

NOTE: Detectable warnings shall not be paid for separately but shall be considered incidental to the various contract items.

SURVEY PLOTTED BY	DATE
DRAWN BY	1/08
DESIGNED BY	
QUANTITIES BY	
CHECKED BY	

STATE OF HAWAII  
DEPARTMENT OF TRANSPORTATION  
HIGHWAYS DIVISION

**LOOP DETECTOR PLAN**  
**KAUMUALII HIGHWAY RESURFACING**  
**Halewili Road to Hanapepe Bridge**  
**Project No. 50C-03-07M**  
Scale: 1" = 20"      Date: November 2008  
SHEET No. **T10** OF **10** SHEETS