


FED. ROAD DIST. NO.	STATE	PROJ. NO.	FISCAL YEAR	SHEET NO.	TOTAL SHEETS
HAWAII	HAW.	50C-03-07M	2009	15	25

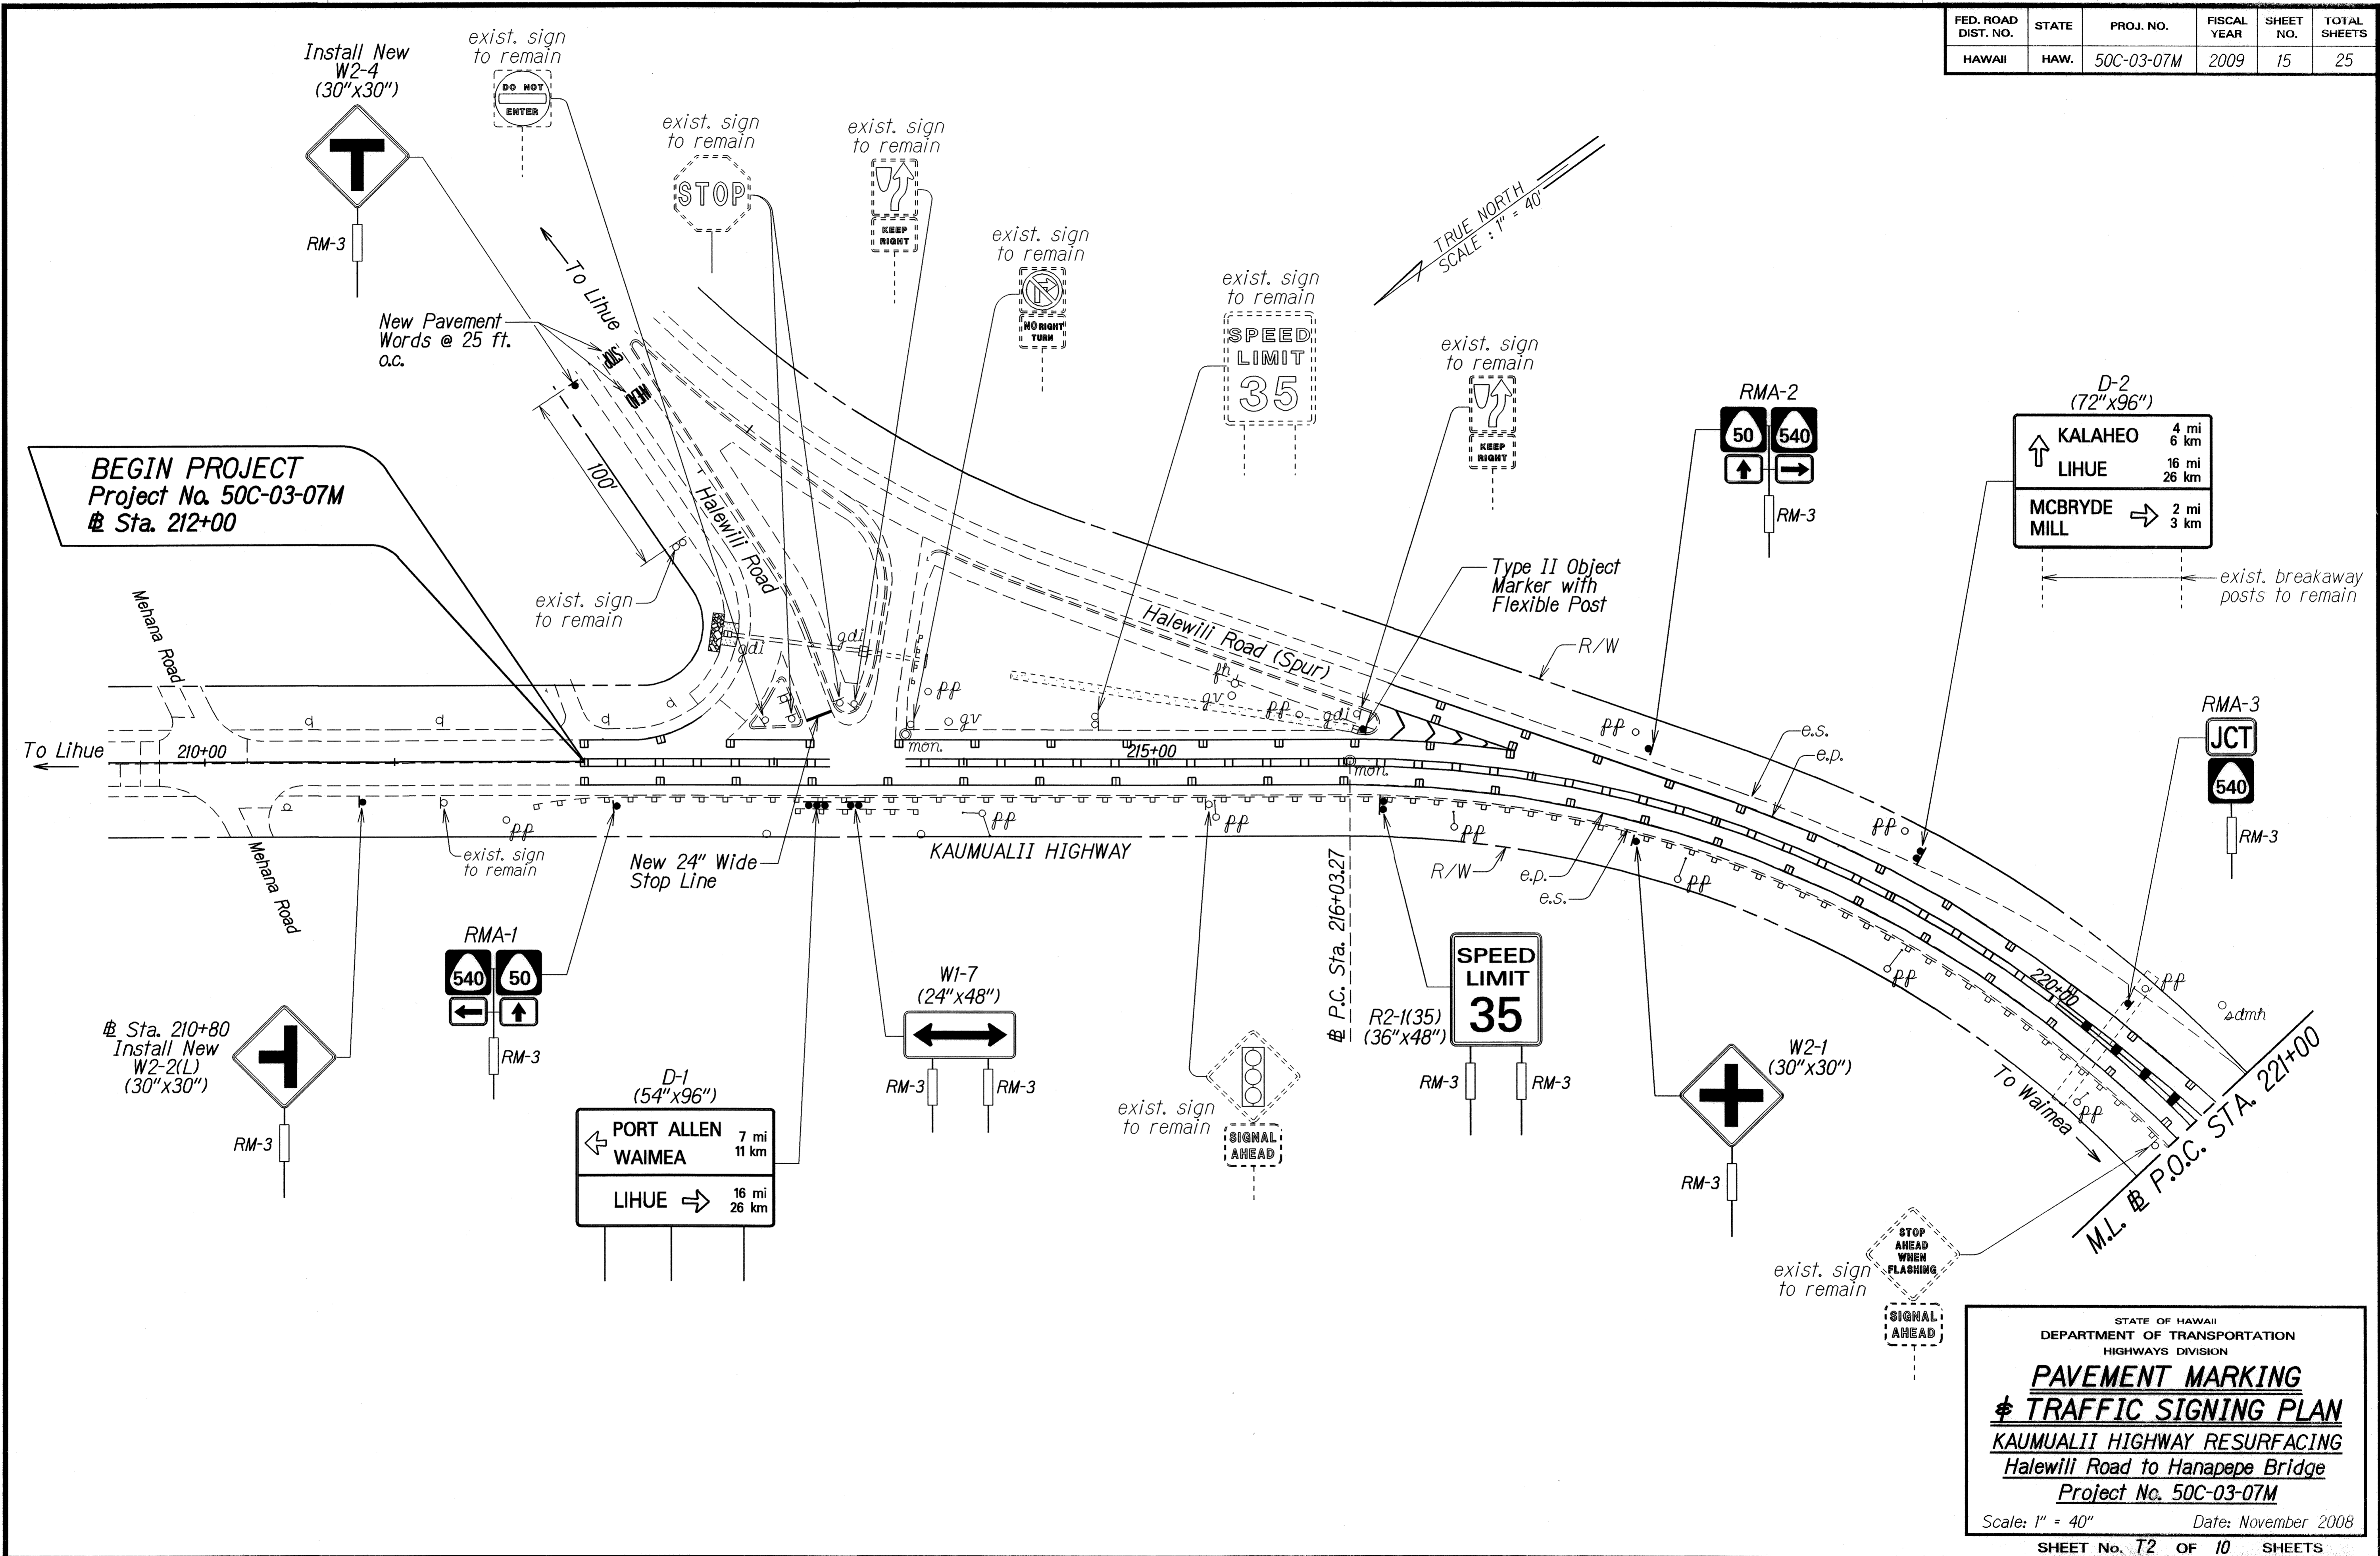

SURVEY PLOTTED BY	DATE
DRAWN BY	7/08
DESIGNED BY	
QUANTITIES BY	
CHECKED BY	
ORIGINAL PLAN	
NOTE BOOK	
3/28/08/2008	

STATE OF HAWAII
DEPARTMENT OF TRANSPORTATION
HIGHWAYS DIVISION


**PAVEMENT MARKING
& TRAFFIC SIGNING PLAN**

**KAUMUALII HIGHWAY RESURFACING
Halawili Road to Hanapepe Bridge
Project No. 50C-03-07M**

Scale: 1" = 40" Date: November 2008

SHEET No. T2 OF 10 SHEETS

FED. ROAD DIST. NO.	STATE	PROJ. NO.	FISCAL YEAR	SHEET NO.	TOTAL SHEETS
HAWAII	HAW.	50C-03-07M	2009	16	25

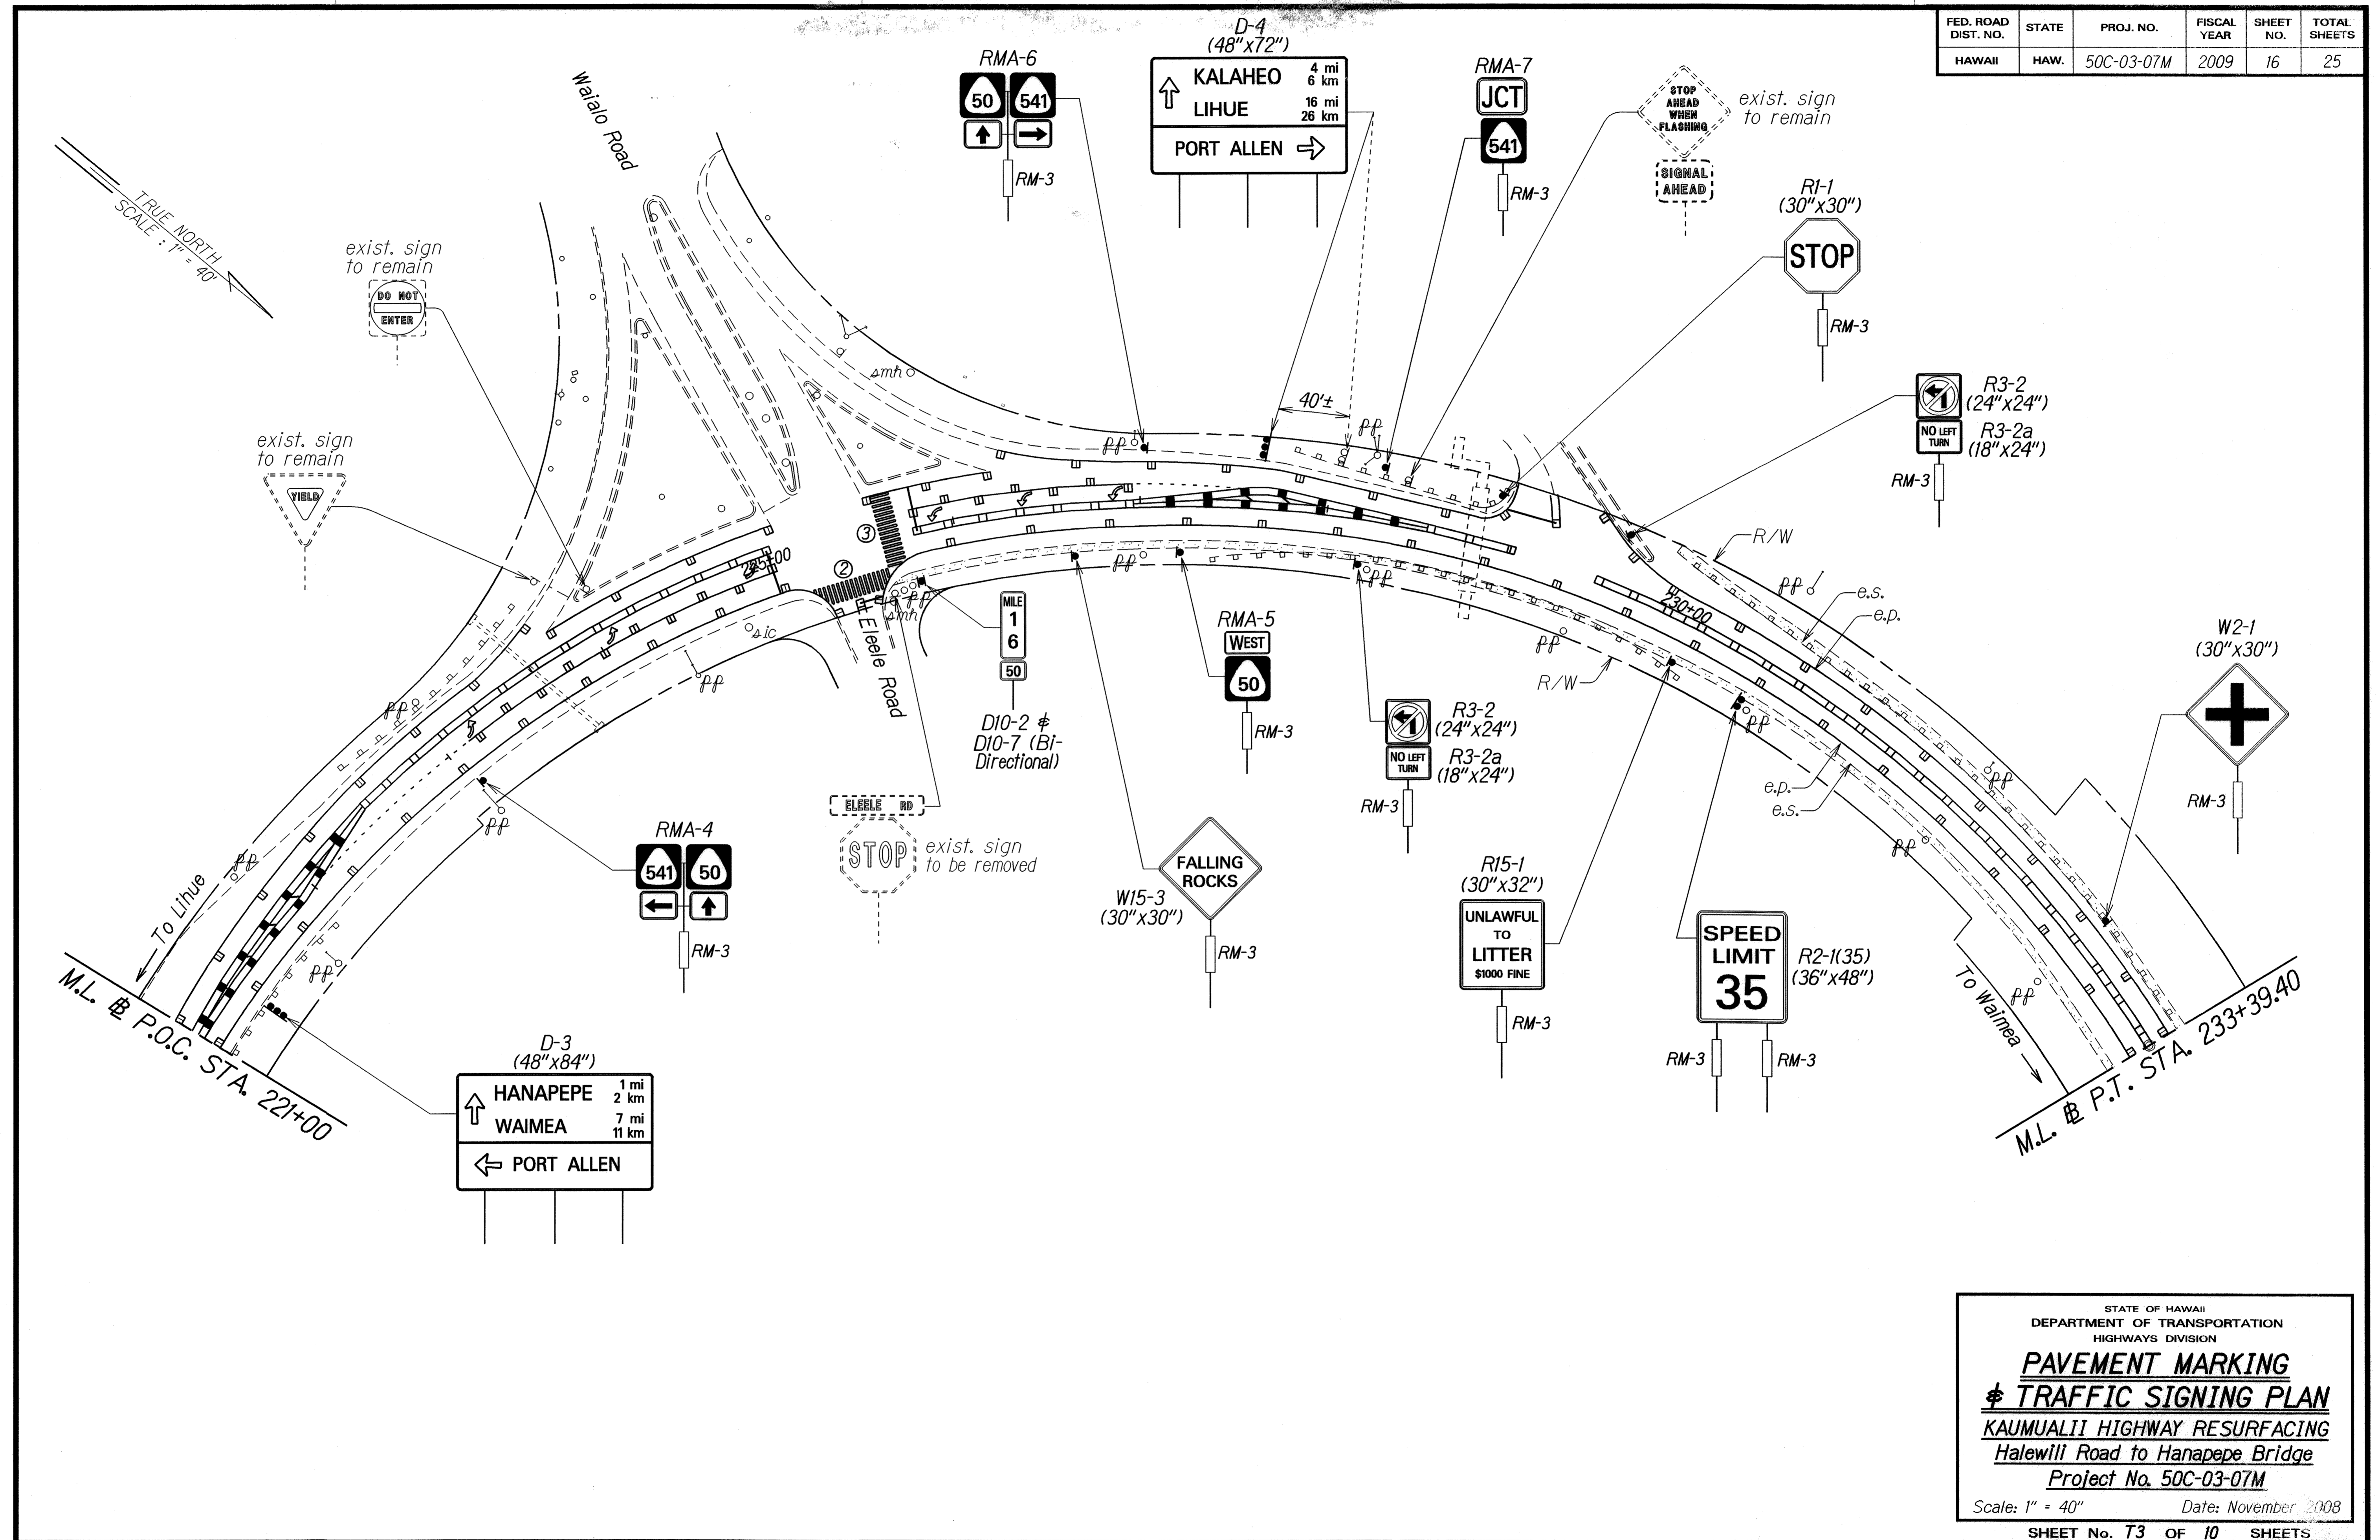

SURVEY PLOTTED BY	DATE
DRAWN BY	7/08
DESIGNED BY	
QUANTITIES BY	
CHECKED BY	
ORIGINAL PLAN	
NOTE BOOK	
3/10/08/2/2/07	
N.	

STATE OF HAWAII
DEPARTMENT OF TRANSPORTATION
HIGHWAYS DIVISION


**PAVEMENT MARKING
& TRAFFIC SIGNING PLAN**

KAUMUALII HIGHWAY RESURFACING
Halawili Road to Hanapepe Bridge
Project No. 50C-03-07M

Scale: 1" = 40" Date: November 2008

SHEET No. T3 OF 10 SHEETS

FED. ROAD DIST. NO.	STATE	PROJ. NO.	FISCAL YEAR	SHEET NO.	TOTAL SHEETS
HAWAII	HAW.	50C-03-07M	2009	17	25

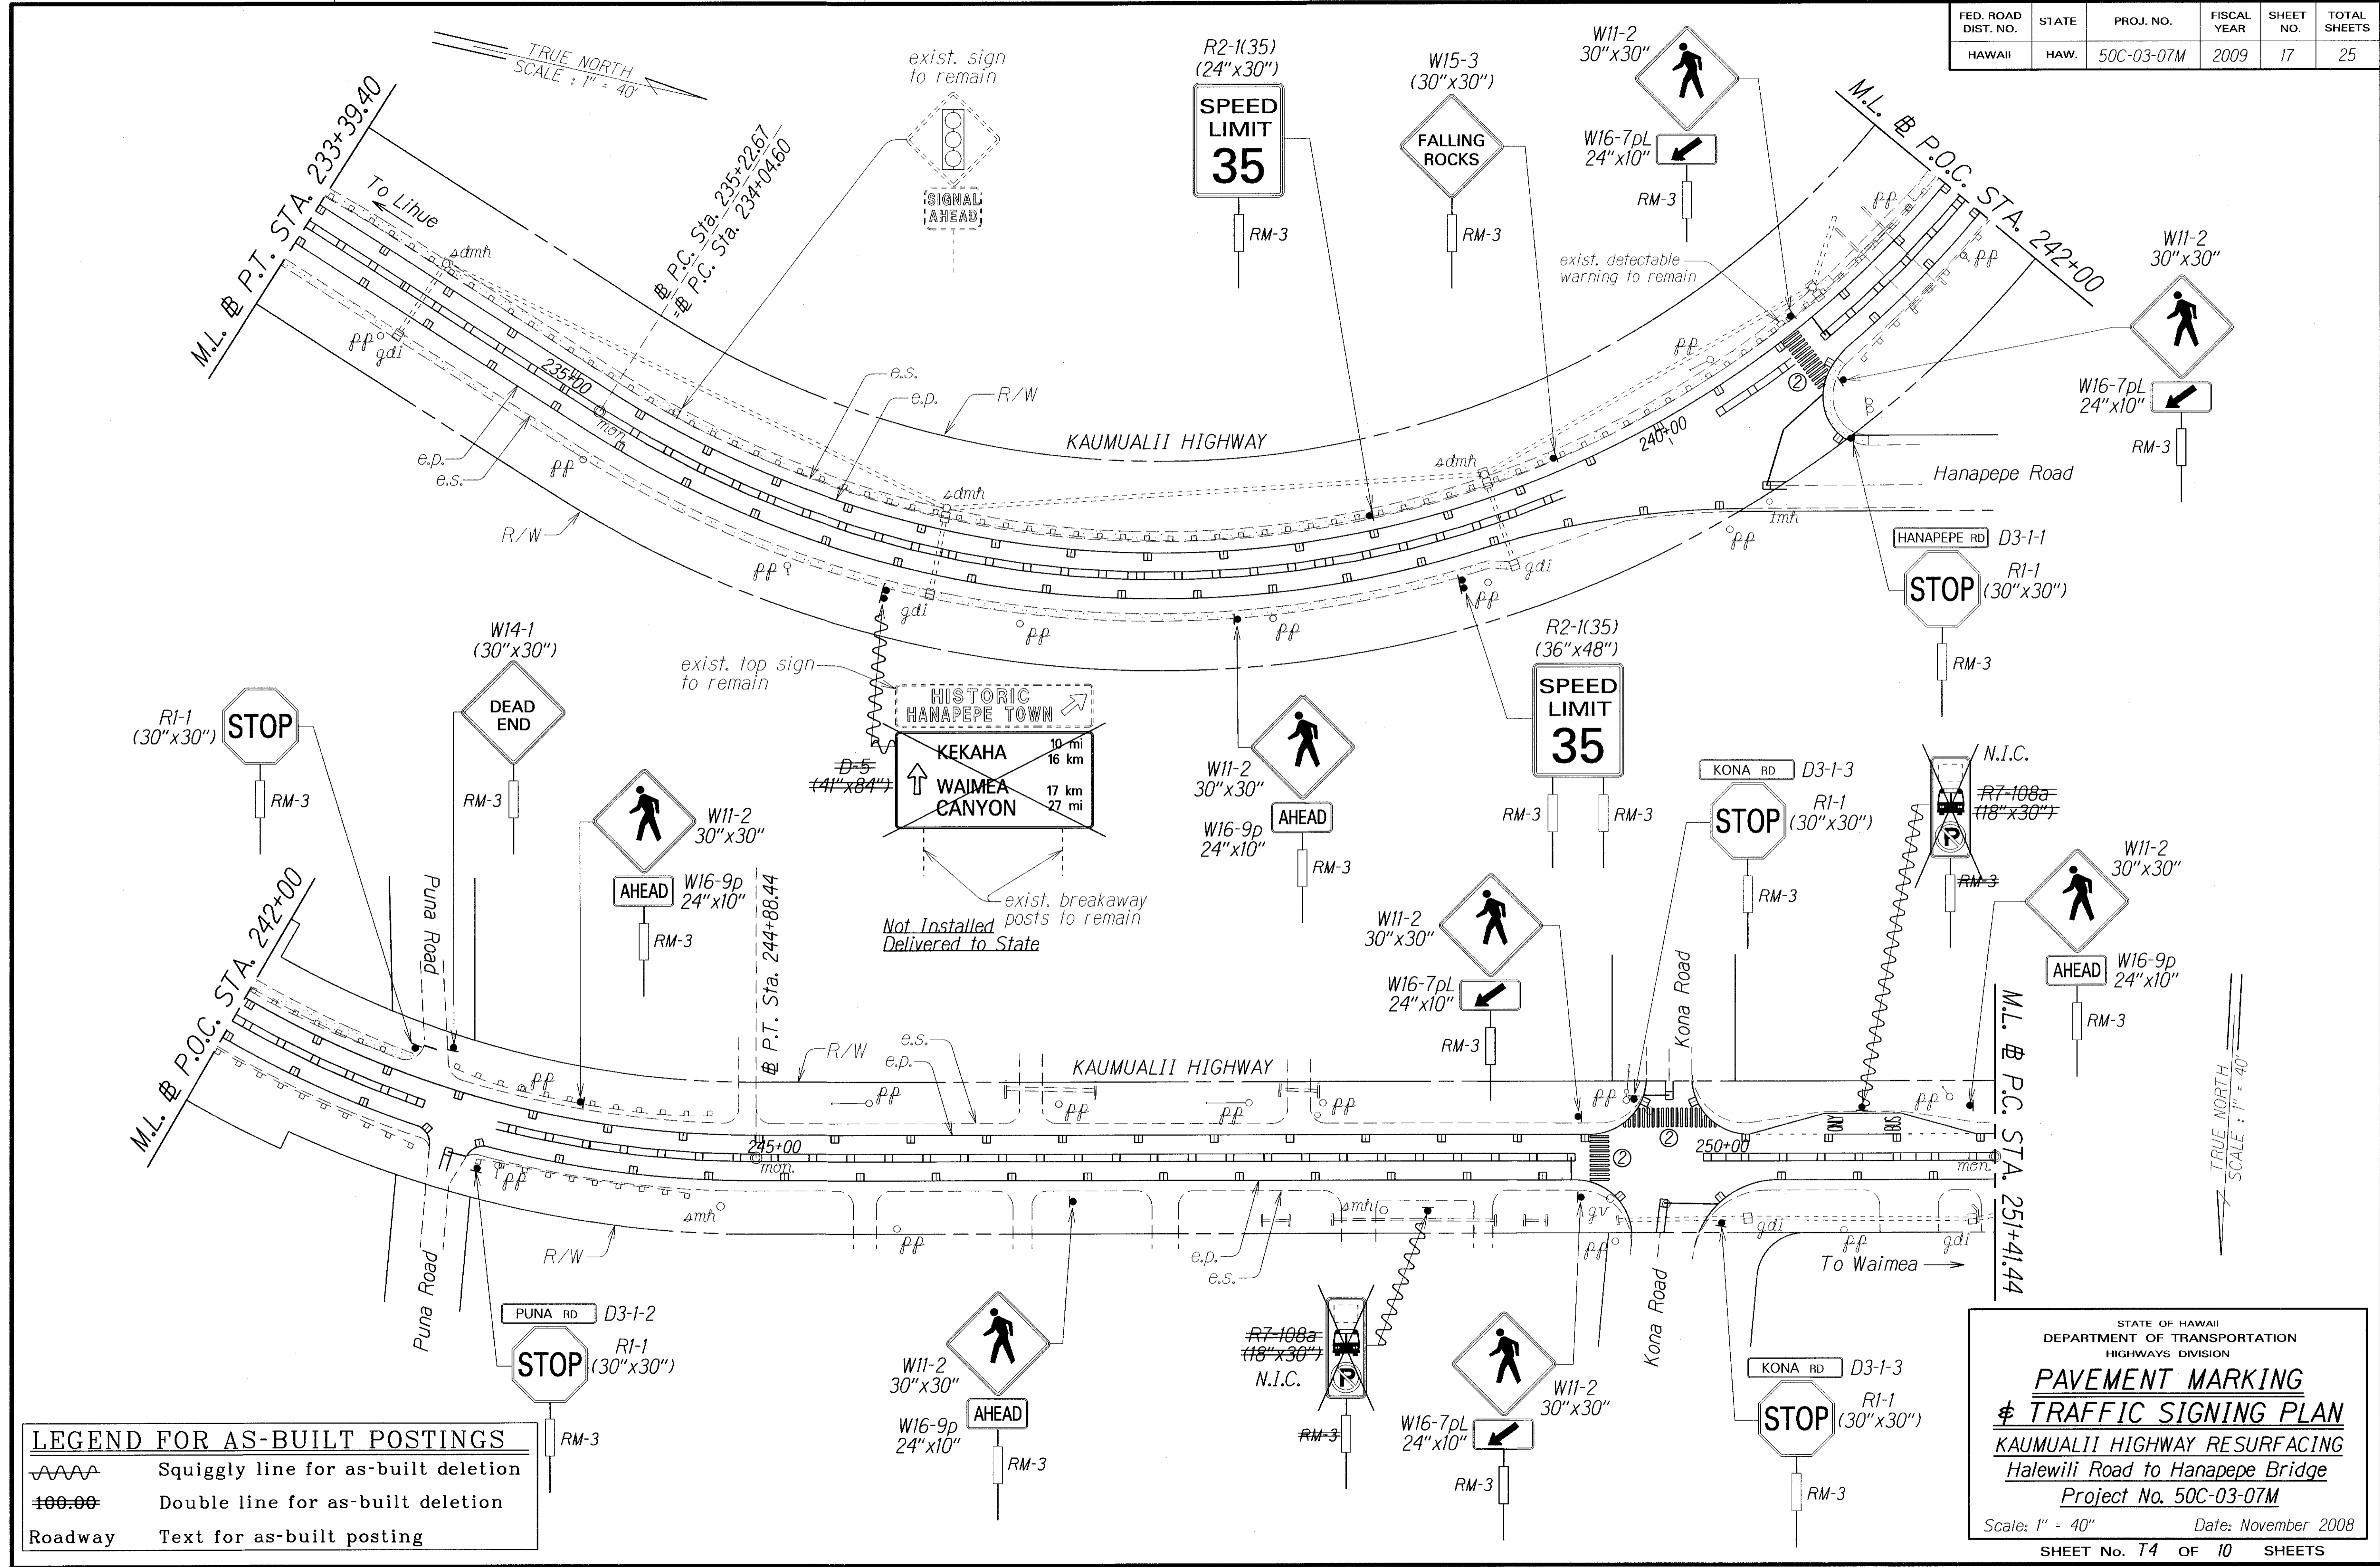

LEGEND FOR AS-BUILT POSTINGS	
	Squiggly line for as-built deletion
	Double line for as-built deletion
Roadway	Text for as-built posting

STATE OF HAWAII
DEPARTMENT OF TRANSPORTATION
HIGHWAYS DIVISION

**PAVEMENT MARKING
& TRAFFIC SIGNING PLAN**

**KAUMUALII HIGHWAY RESURFACING
Halewili Road to Hanapepe Bridge**

Project No. 50C-03-07M


Scale: 1" = 40" Date: November 2008

SHEET No. 74 OF 10 SHEETS

ORIGINAL PLAN	DATE
SURVEY PLOTTED BY	
DRAWN BY	
DESIGNED BY	
QUANTITIES BY	
CHECKED BY	

"AS-BUILT"

FED. ROAD DIST. NO.	STATE	PROJ. NO.	FISCAL YEAR	SHEET NO.	TOTAL SHEETS
HAWAII	HAW.	50C-03-07M	2009	18	25

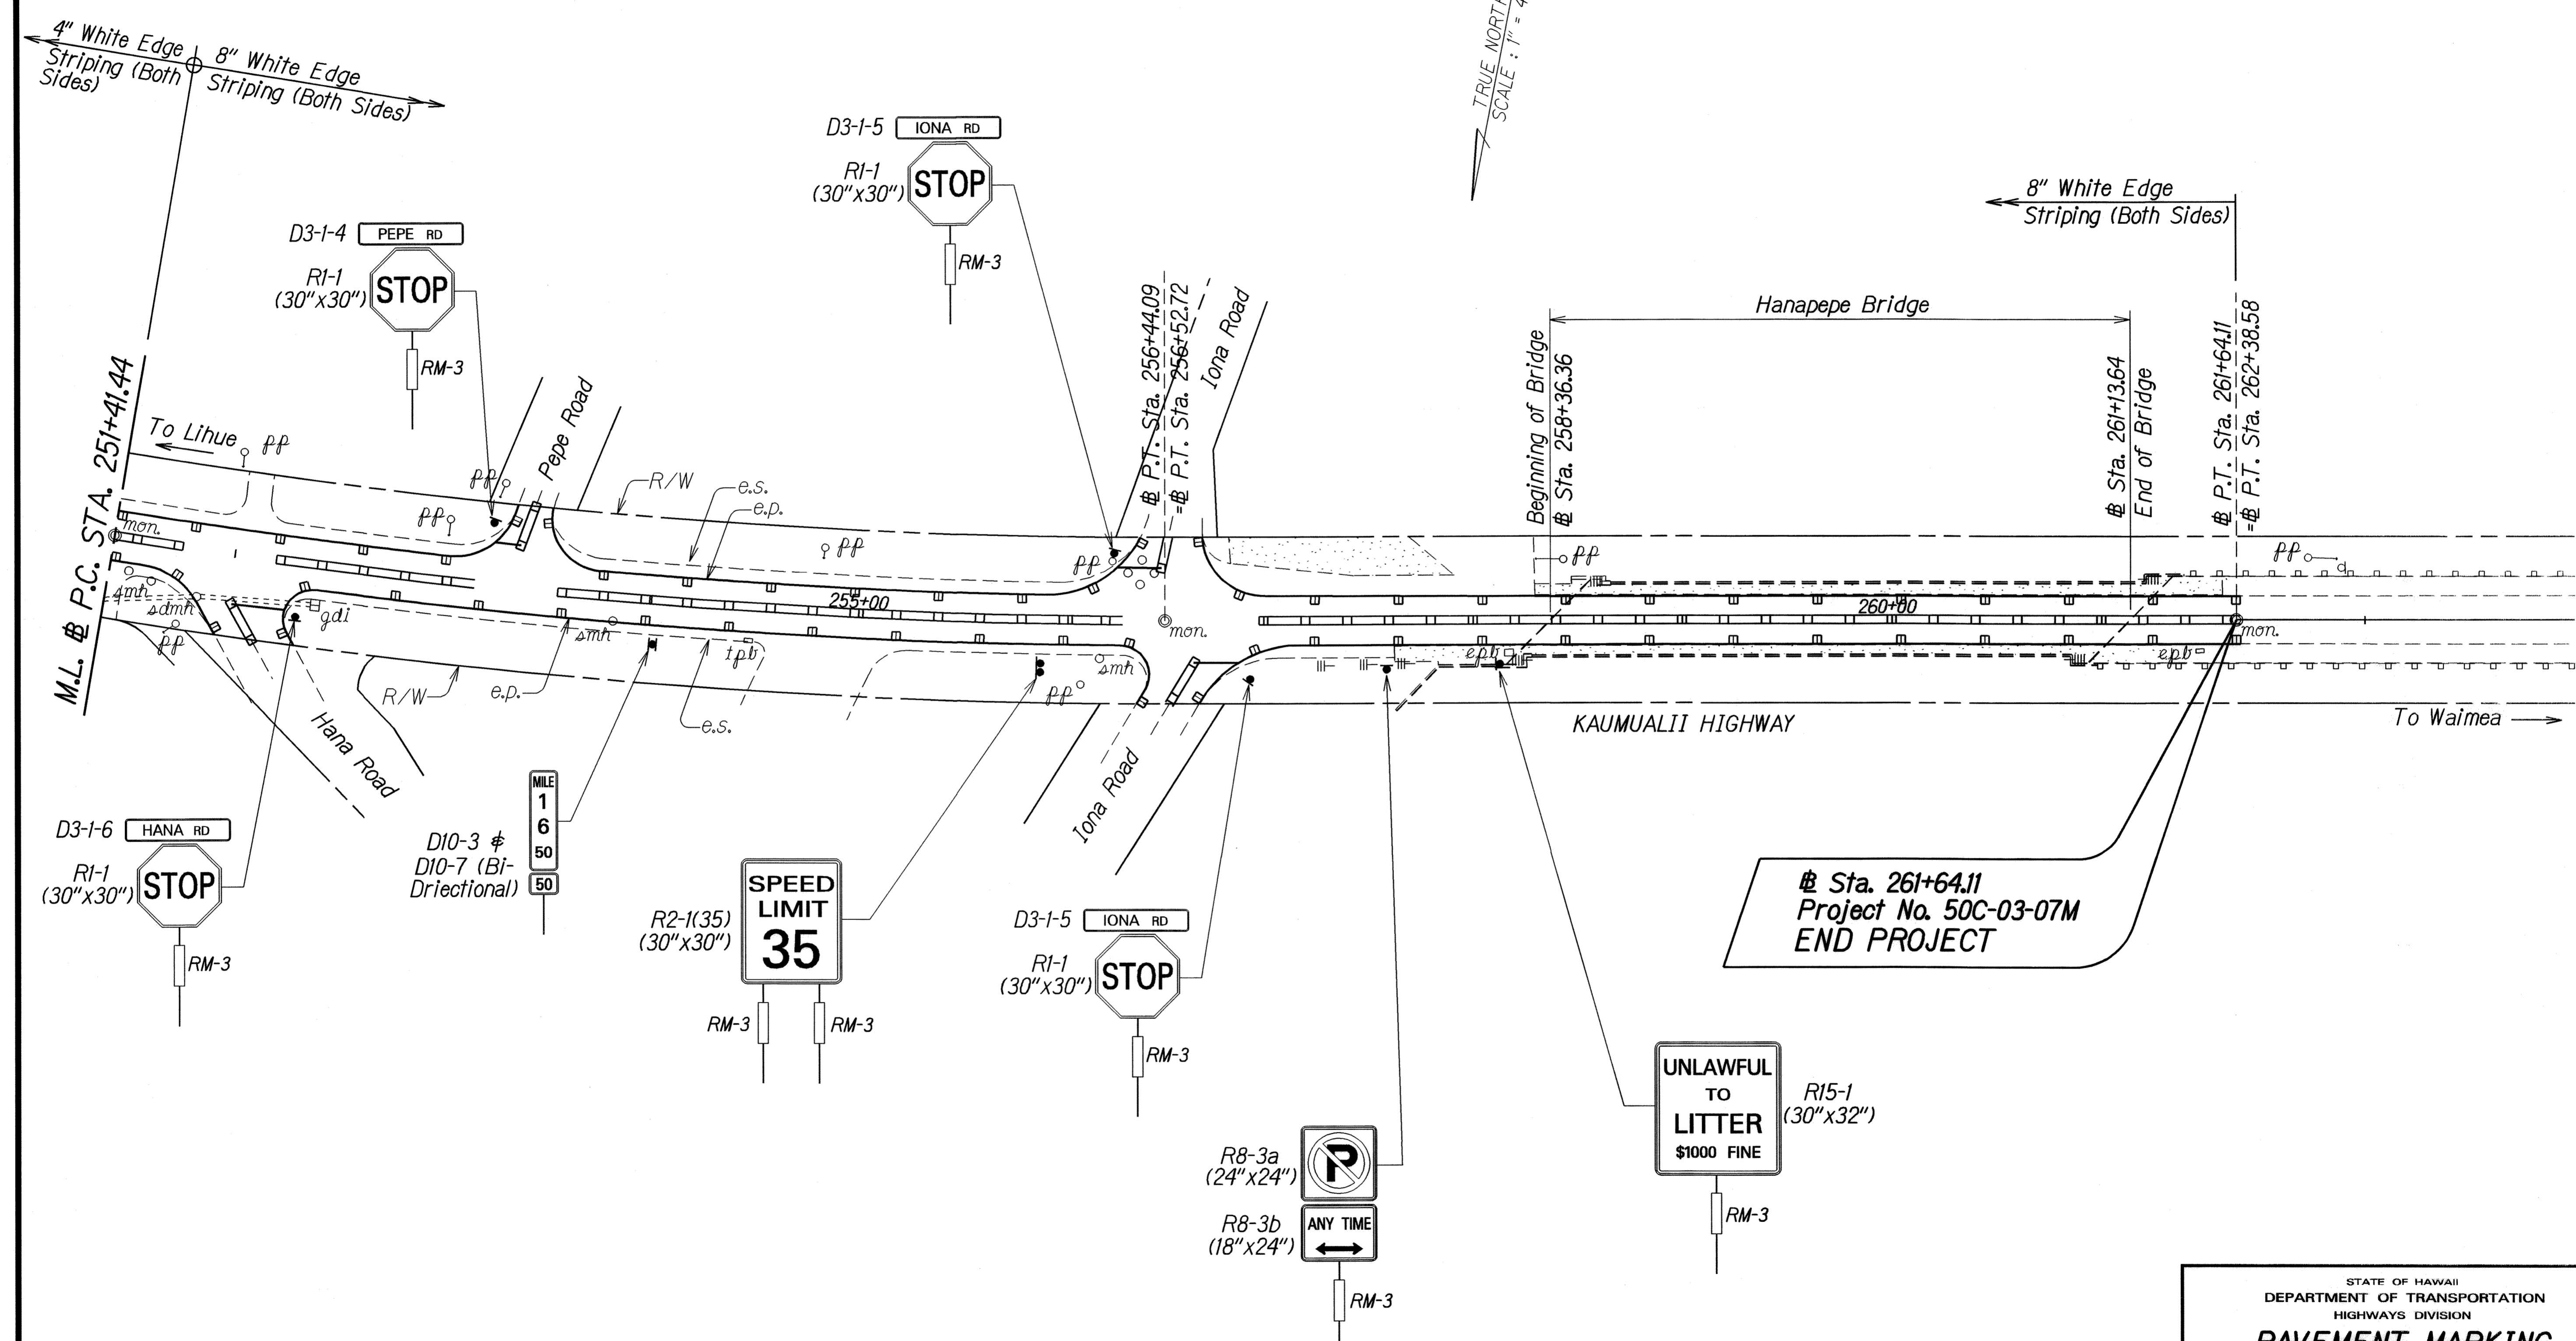

Sta. 261+64.11
 Project No. 50C-03-07M
 END PROJECT

SURVEY PLOTTED BY	DATE	7/08
DRAWN BY		
DESIGNED BY		
QUANTITIES BY		
CHECKED BY		
ORIGINAL PLAN		
NOTE BOOK		
NO.		

STATE OF HAWAII
 DEPARTMENT OF TRANSPORTATION
 HIGHWAYS DIVISION
PAVEMENT MARKING
TRAFFIC SIGNING PLAN
 KAUMUALII HIGHWAY RESURFACING
 Halewili Road to Hanapepe Bridge
 Project No. 50C-03-07M
 Scale: 1" = 40' Date: November 2008
 SHEET No. 18 OF 10 SHEETS