


FED. ROAD DIST. NO.	STATE	PROJ. NO.	FISCAL YEAR	SHEET NO.	TOTAL SHEETS
HAWAII	HAW.	50C-03-07M	2009	10	25

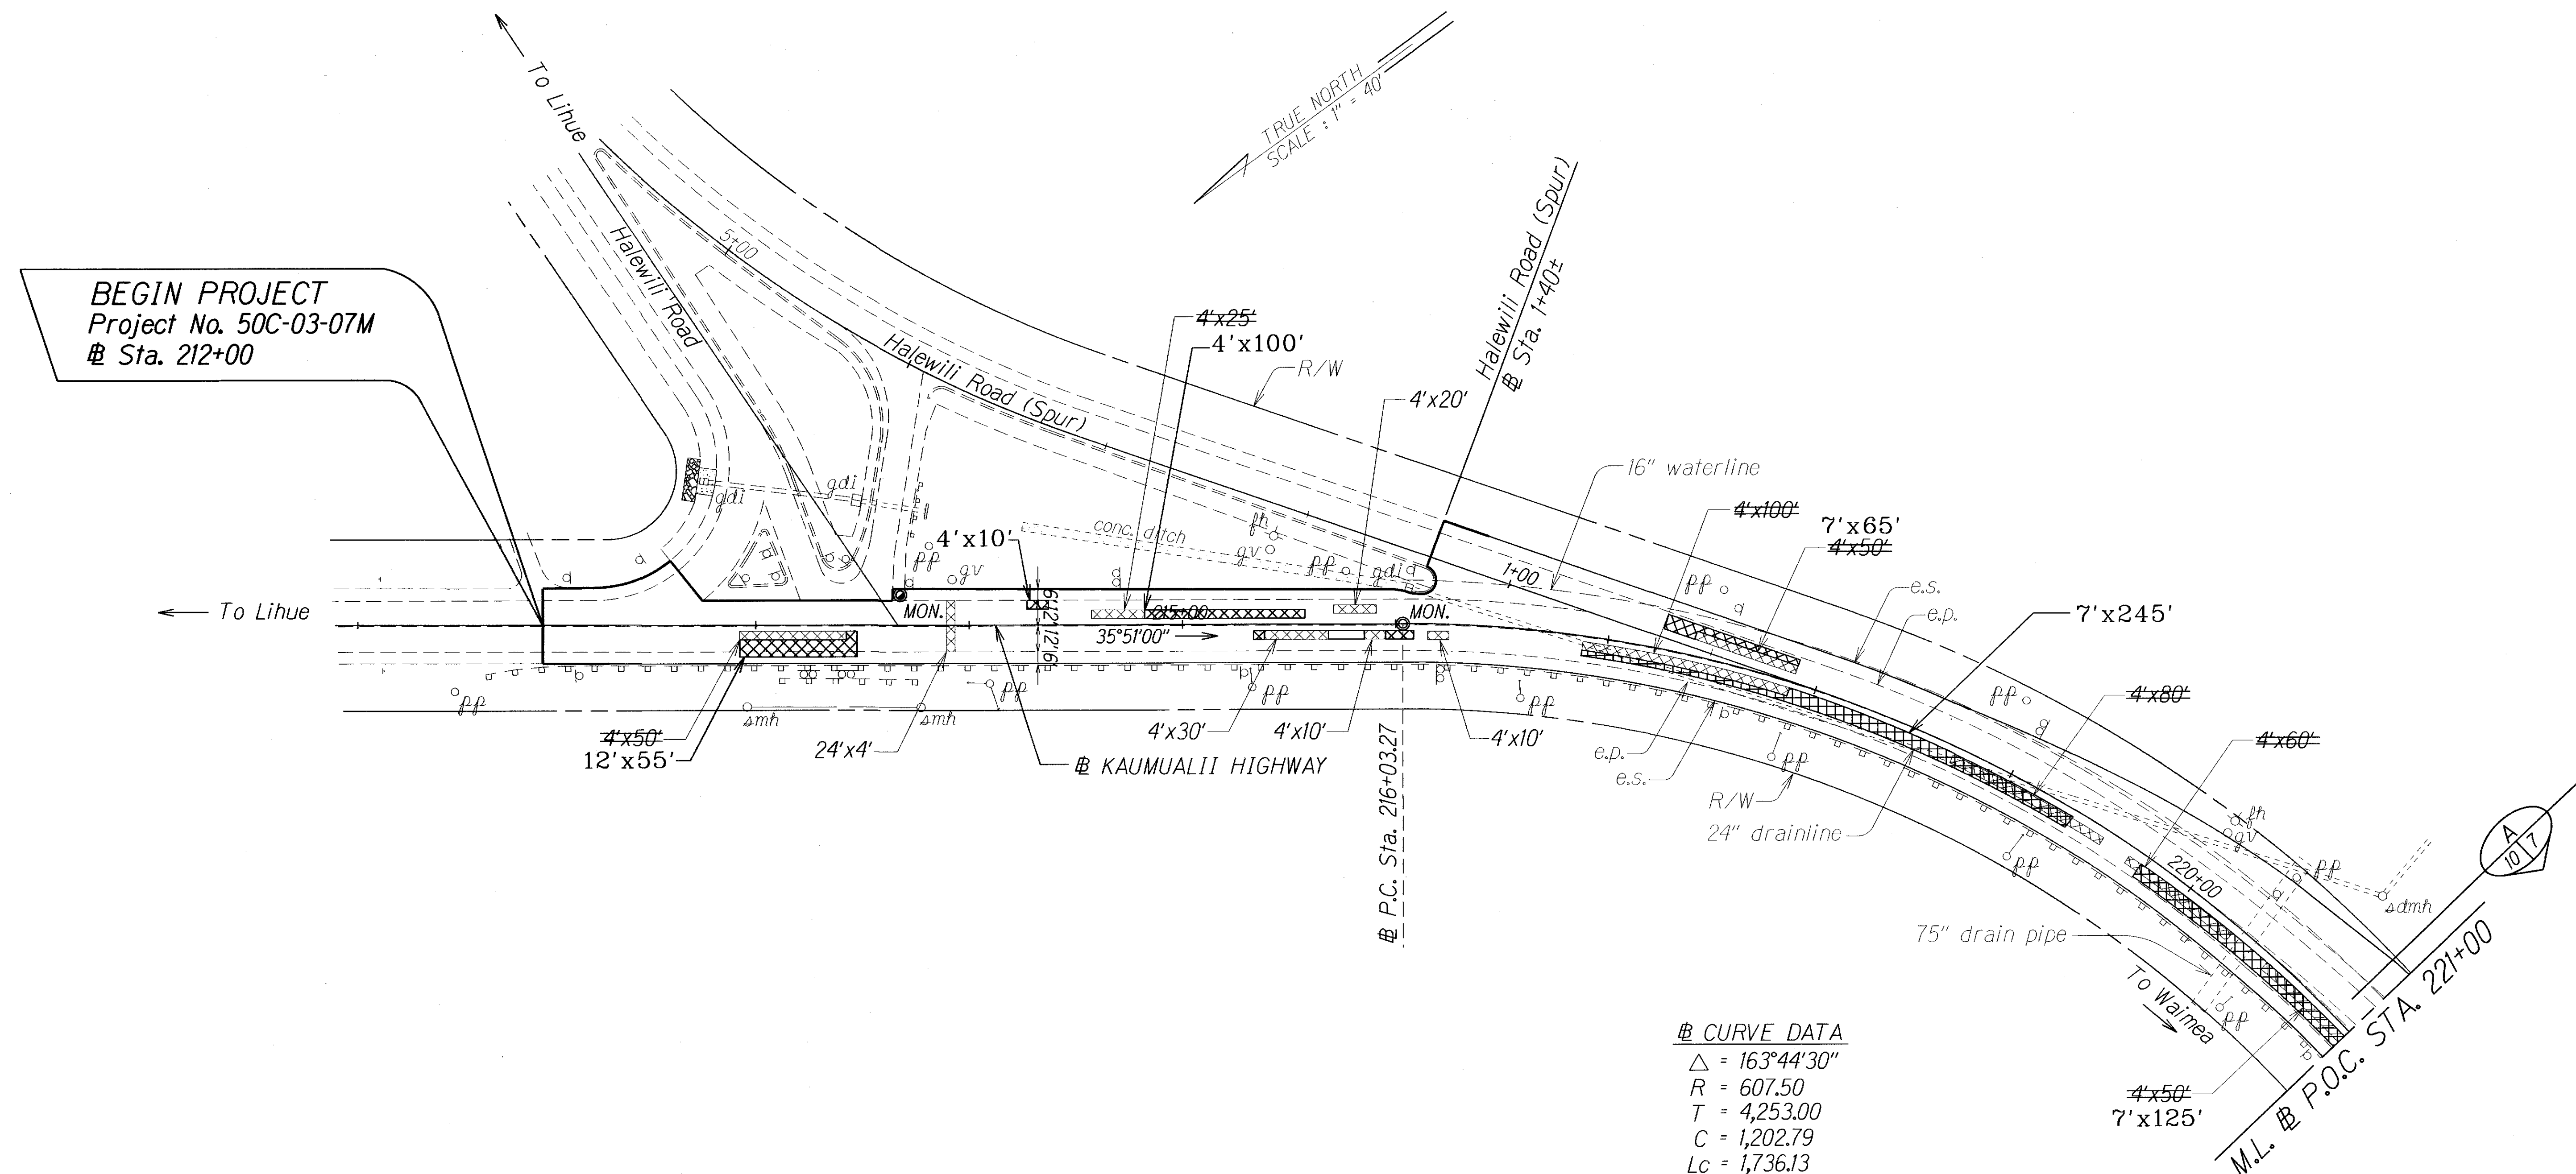

CURVE DATA
 $\Delta = 163^{\circ}44'30''$
 $R = 607.50$
 $T = 4,253.00$
 $C = 1,202.79$
 $L_c = 1,736.13$


ORIGINAL PLAN	DATE
SURVEY PLOTTED BY	7/08
DRAWN BY	
TRACED BY	
DESIGNED BY	
QUANTITIES BY	
CHECKED BY	

LEGEND FOR AS-BUILT POSTINGS	
	Squiggly line for as-built deletion
	Double line for as-built deletion
Roadway	Text for as-built posting

STATE OF HAWAII
 DEPARTMENT OF TRANSPORTATION
 HIGHWAYS DIVISION
ROADWAY PLAN
 KAUMUALII HIGHWAY RESURFACING
 Halewili Road to Hanapepe Bridge
 Project No. 50C-03-07M
 Scale: 1" = 40" Date: November 2008
 SHEET No. 1 OF 4 SHEETS

"AS-BUILT"

FED. ROAD DIST. NO.	STATE	PROJ. NO.	FISCAL YEAR	SHEET NO.	TOTAL SHEETS
HAWAII	HAW.	50C-03-07M	2009	11	25

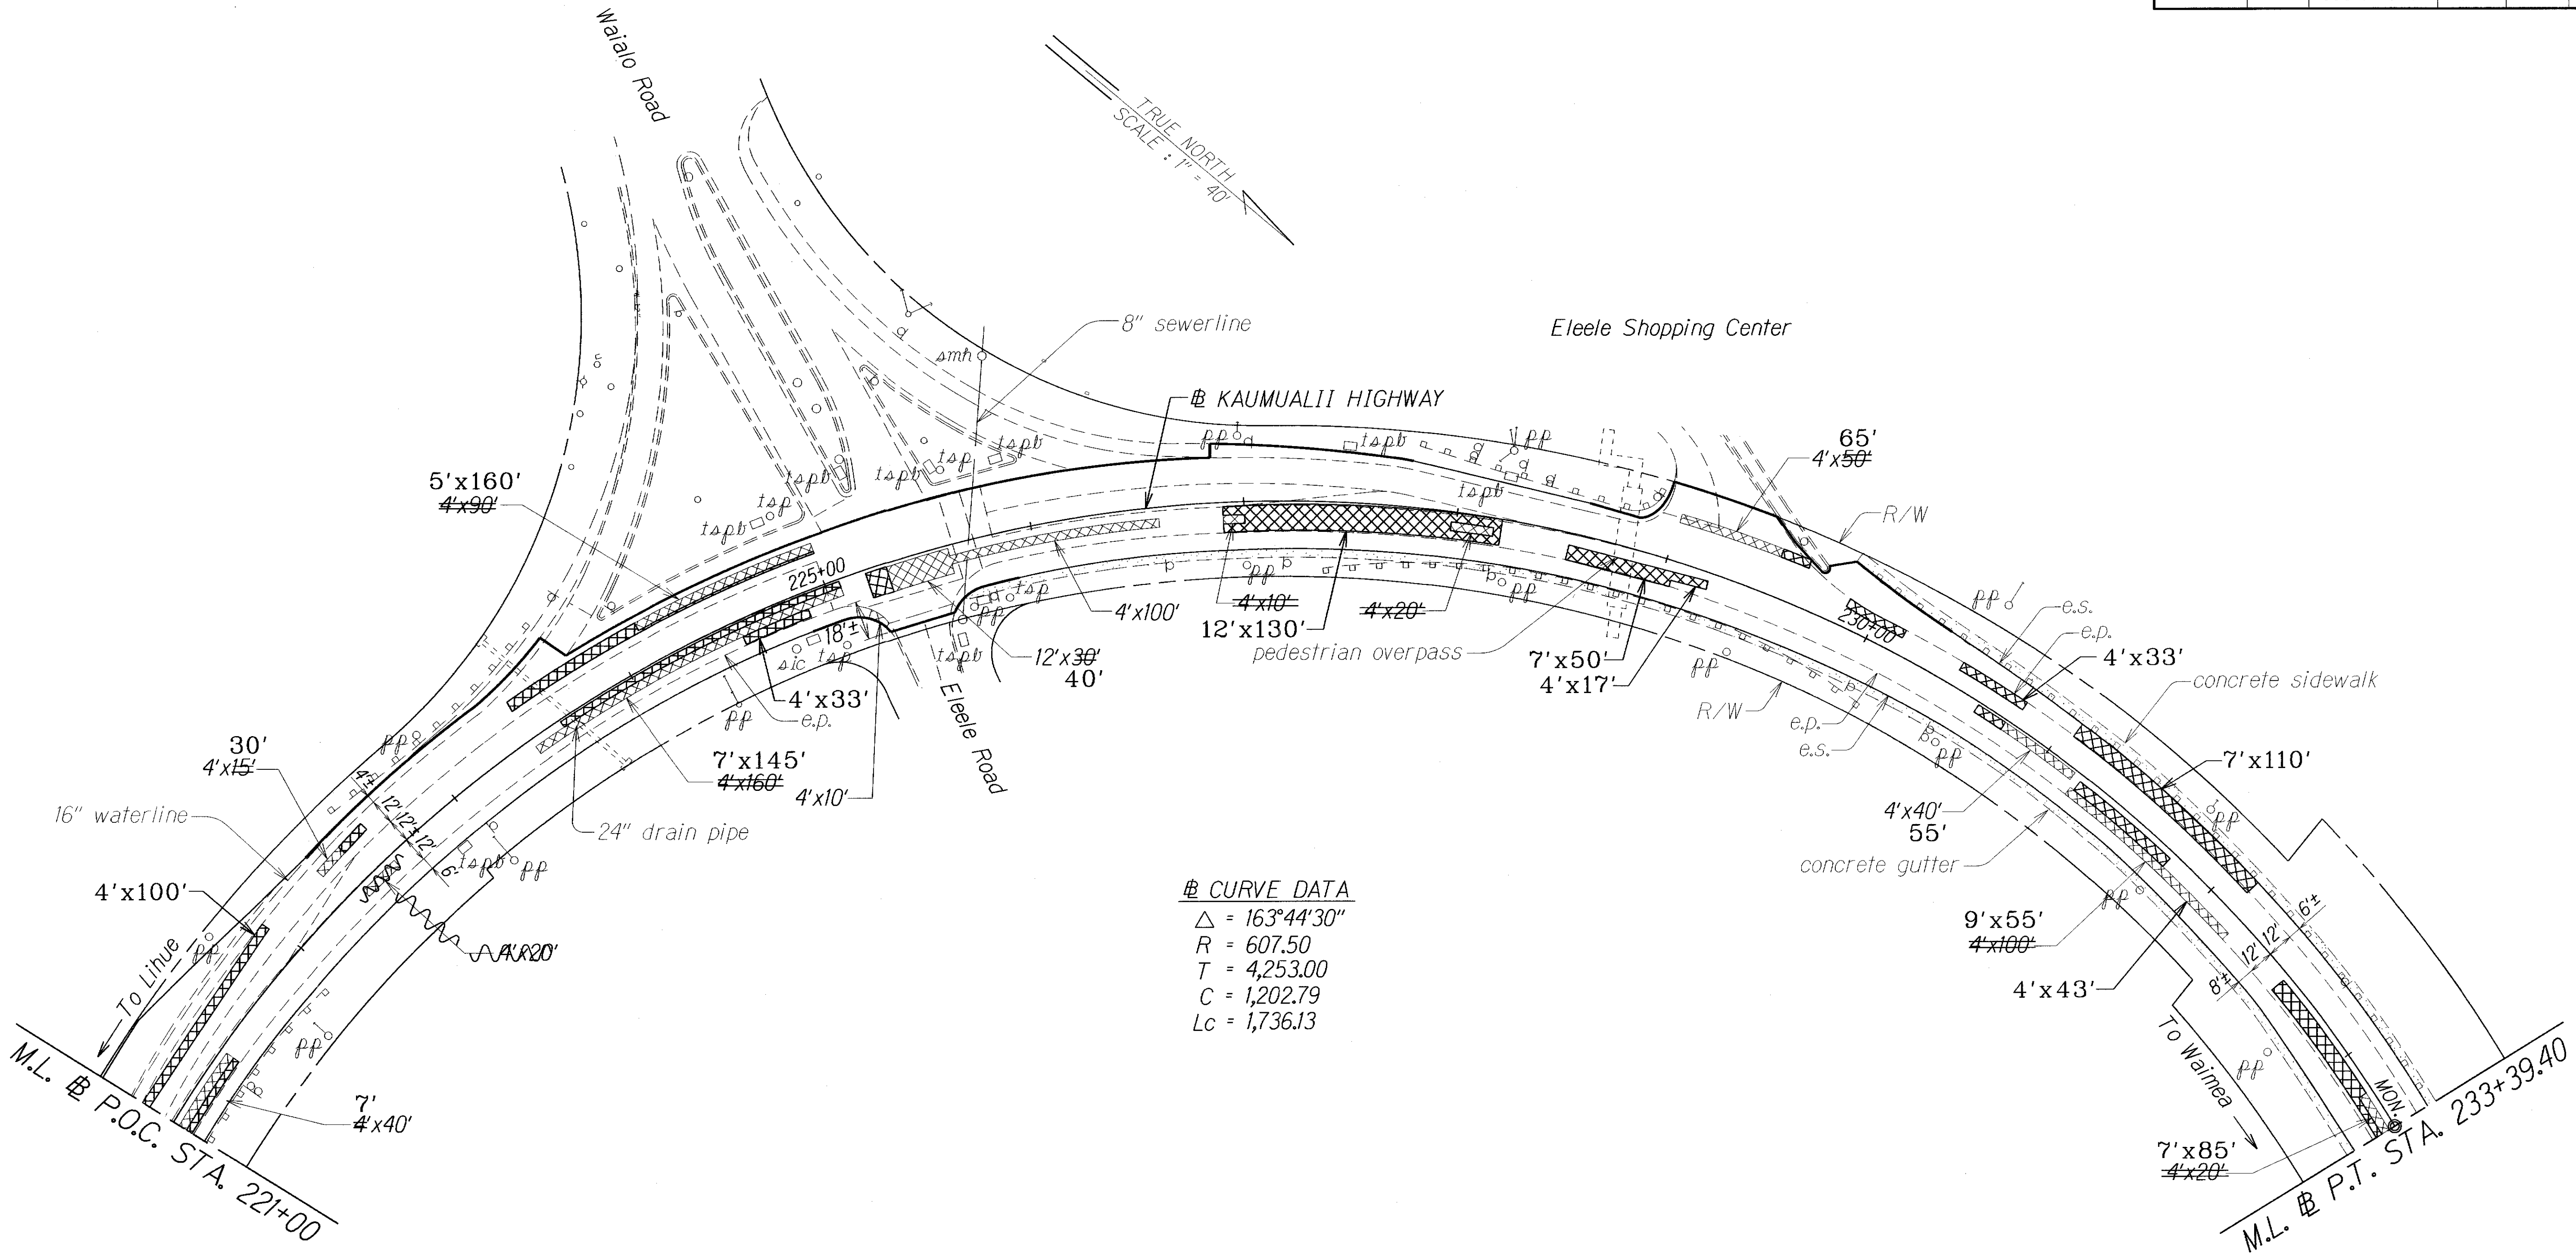

@ CURVE DATA
 $\Delta = 163^{\circ}44'30''$
 $R = 607.50$
 $T = 4,253.00$
 $C = 1,202.79$
 $Lc = 1,736.13$

ORIGINAL PLAN	SURVEY PLOTTED BY	DATE
NOTE BOOK	DESIGNED BY	
	QUANTITIES BY	
	CHECKED BY	

LEGEND FOR AS-BUILT POSTINGS	
	Squiggly line for as-built deletion
	Double line for as-built deletion
Roadway	Text for as-built posting

STATE OF HAWAII
DEPARTMENT OF TRANSPORTATION
HIGHWAYS DIVISION

ROADWAY PLAN

KAUMUALII HIGHWAY RESURFACING


Halewili Road to Hanapepe Bridge

Project No. 50C-03-07M

Scale: 1" = 40" Date: November 2008

SHEET No. 2 OF 4 SHEETS

FED. ROAD DIST. NO.	STATE	PROJ. NO.	FISCAL YEAR	SHEET NO.	TOTAL SHEETS
HAWAII	HAW.	50C-03-07M	2009	12	25

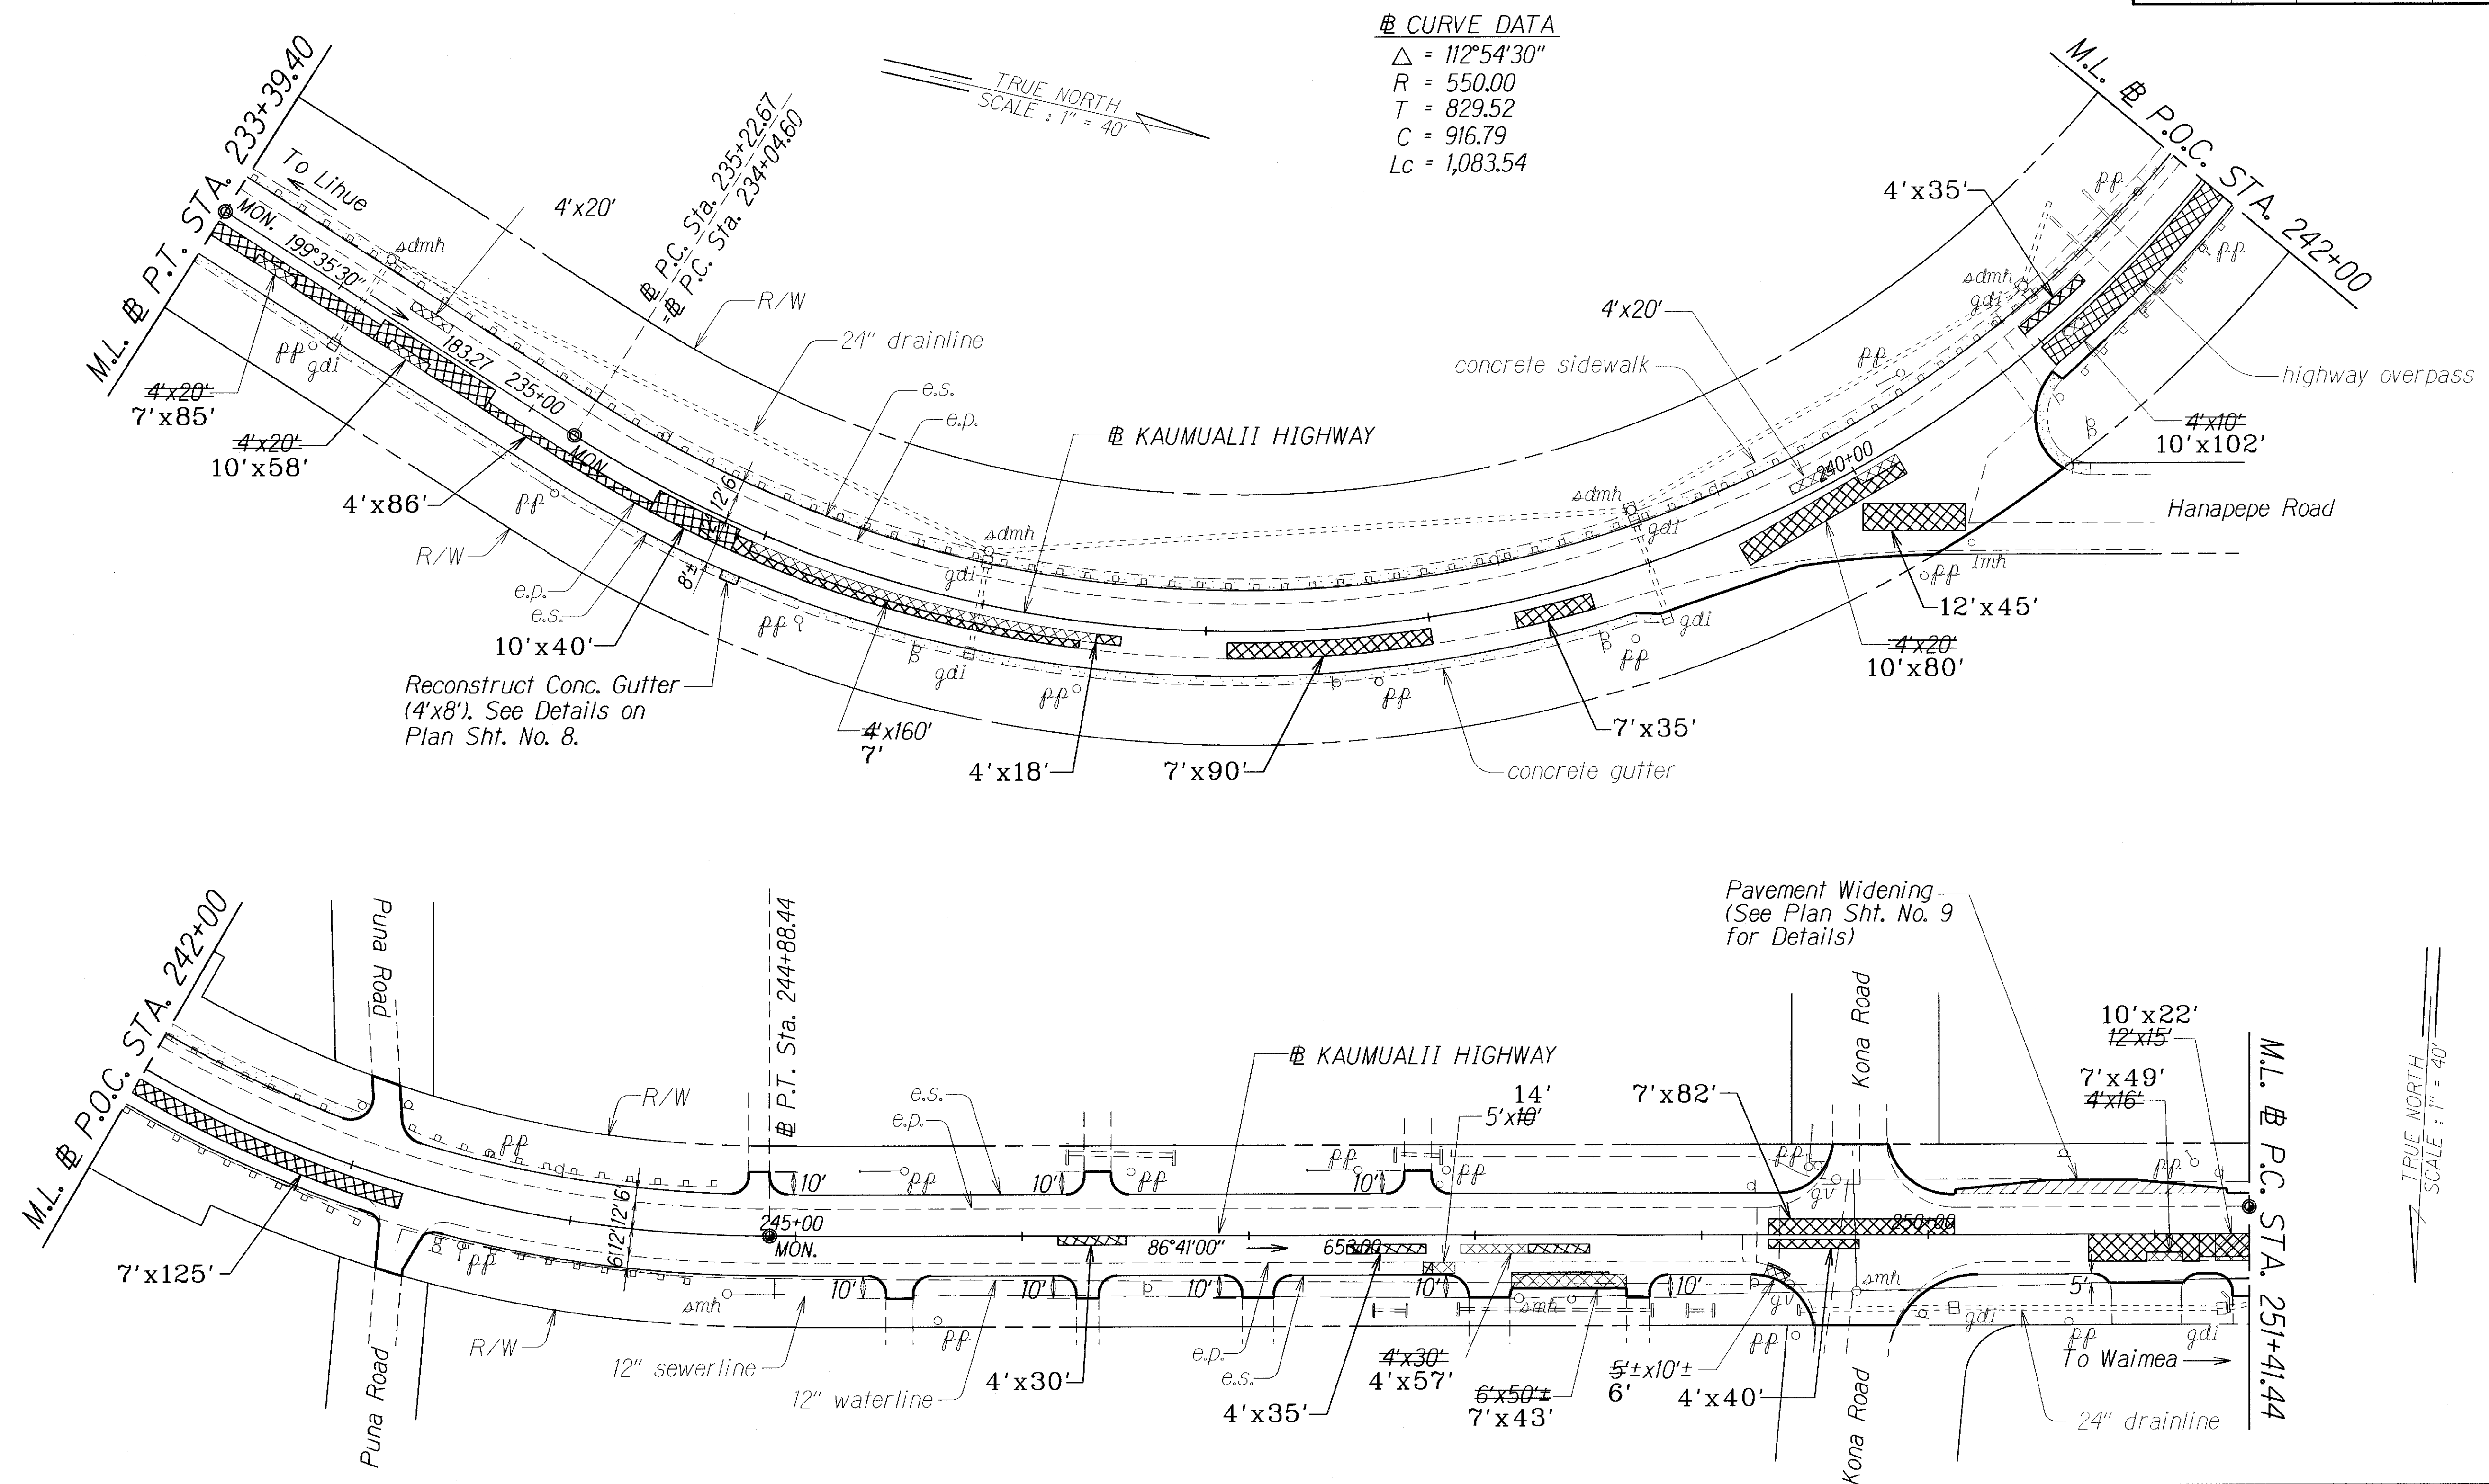

⊕ CURVE DATA
 $\Delta = 112^\circ 54' 30''$
 $R = 550.00$
 $T = 829.52$
 $C = 916.79$
 $L_c = 1,083.54$

DESIGNED BY	DATE
DRAWN BY	
CHECKED BY	
NOTED BY	
QUANTITIES BY	
CHECKED BY	

LEGEND FOR AS-BUILT POSTINGS	
	Squiggly line for as-built deletion
	Double line for as-built deletion
Roadway	Text for as-built posting

STATE OF HAWAII
DEPARTMENT OF TRANSPORTATION
HIGHWAYS DIVISION

ROADWAY PLAN

KAUMUALII HIGHWAY RESURFACING
Halewili Road to Hanapepe Bridge
Project No. 50C-03-07M

Scale: 1" = 40" Date: November 2008


SHEET No. 3 OF 4 SHEETS

"AS-BUILT"

FED. ROAD DIST. NO.	STATE	PROJ. NO.	FISCAL YEAR	SHEET NO.	TOTAL SHEETS
HAWAII	HAW.	50C-03-07M	2009	13	25

⊕ CURVE DATA

Δ = 9°36'00"
R = 3000.00
T = 251.92
C = 502.07
Lc = 502.65

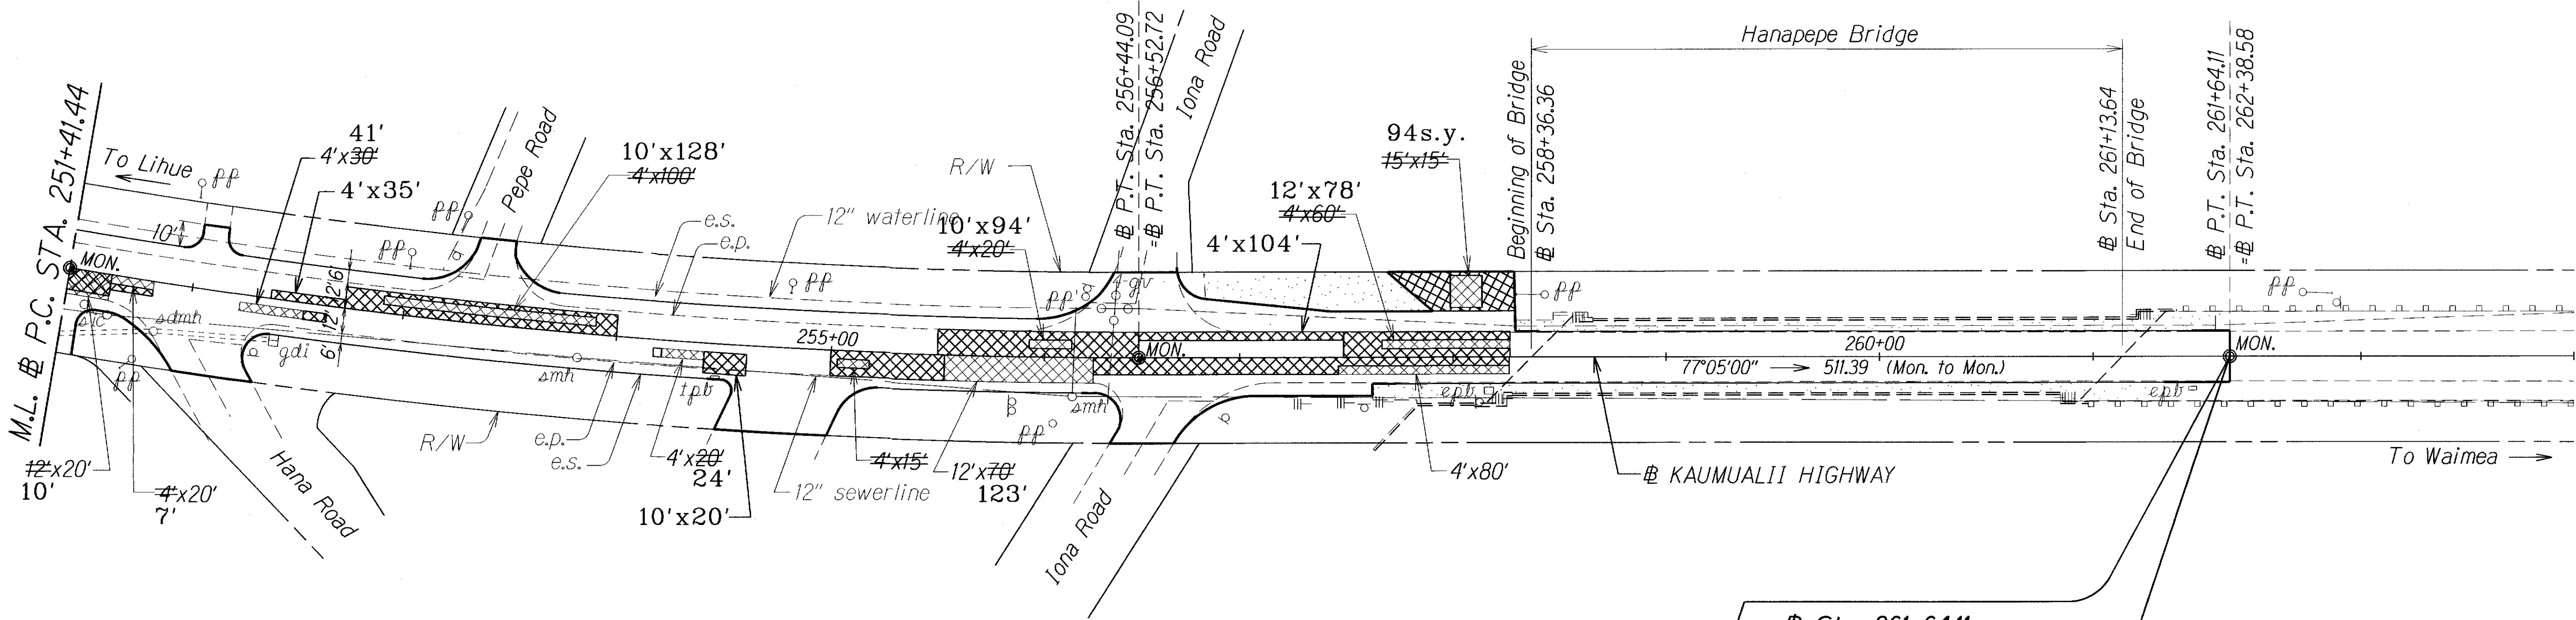

⊕ Sta. 261+64.11
Project No. 50A-03-07M
END PROJECT

ORIGINAL PLAN	SURVEY PLOTTED BY	DATE
NOTE BOOK	DESIGNED BY	
	QUANTITIES BY	
	CHECKED BY	

LEGEND FOR AS-BUILT POSTINGS	
	Squiggly line for as-built deletion
	Double line for as-built deletion
Roadway	Text for as-built posting

STATE OF HAWAII
DEPARTMENT OF TRANSPORTATION
HIGHWAYS DIVISION

ROADWAY PLAN
KAUMUALII HIGHWAY RESURFACING
Halewili Road to Hanapepe Bridge
Project No. 50C-03-07M
Scale: 1" = 40" Date: November 2008

SHEET No. 4 OF 4 SHEETS

"AS-BUILT"