
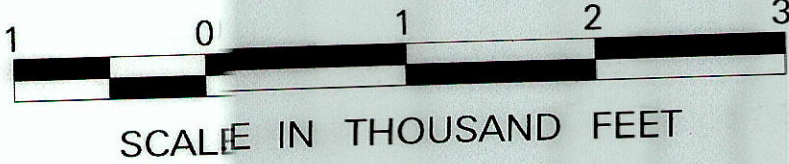




DRAWINGS	
INDEX TO DRAWINGS	
SHEET NO.	DESCRIPTION
1	TITLE SHEET
2	STANDARD PLANS SUMMARY
3	GENERAL NOTES AND LEGENDS
4 - 5	WATER POLLUTION AND EROSION CONTROL NOTES
6 - 9	TYPICAL SECTIONS
10 - 13	ROADWAY PLAN
14	PAVEMENT MARKING LEGEND, DETAILS AND NOTES
15 - 18	PAVEMENT MARKING AND TRAFFIC SIGNING PLAN
19 - 20	SIGN DETAILS
21	LOW SPEED UNDIVIDED HIGHWAY WORK ZONE SAFETY PLAN, NOTES AND DETAILS
22	LOOP DETECTOR DETAILS
23	LOOP DETECTOR PLAN
24 - 25	BRIDGE JOINT DETAILS

STATE OF HAWAII
DEPARTMENT OF TRANSPORTATION
HIGHWAYS DIVISION
HONOLULU, HAWAII
"AS-BUILT"
PLANS FOR
KAUMUALII HIGHWAY RESURFACING
HALEWILI ROAD TO HANAPEPE BRIDGE
PROJECT NO. 50C-03-07M
DISTRICT OF KOLOA
ISLAND OF KAUAI

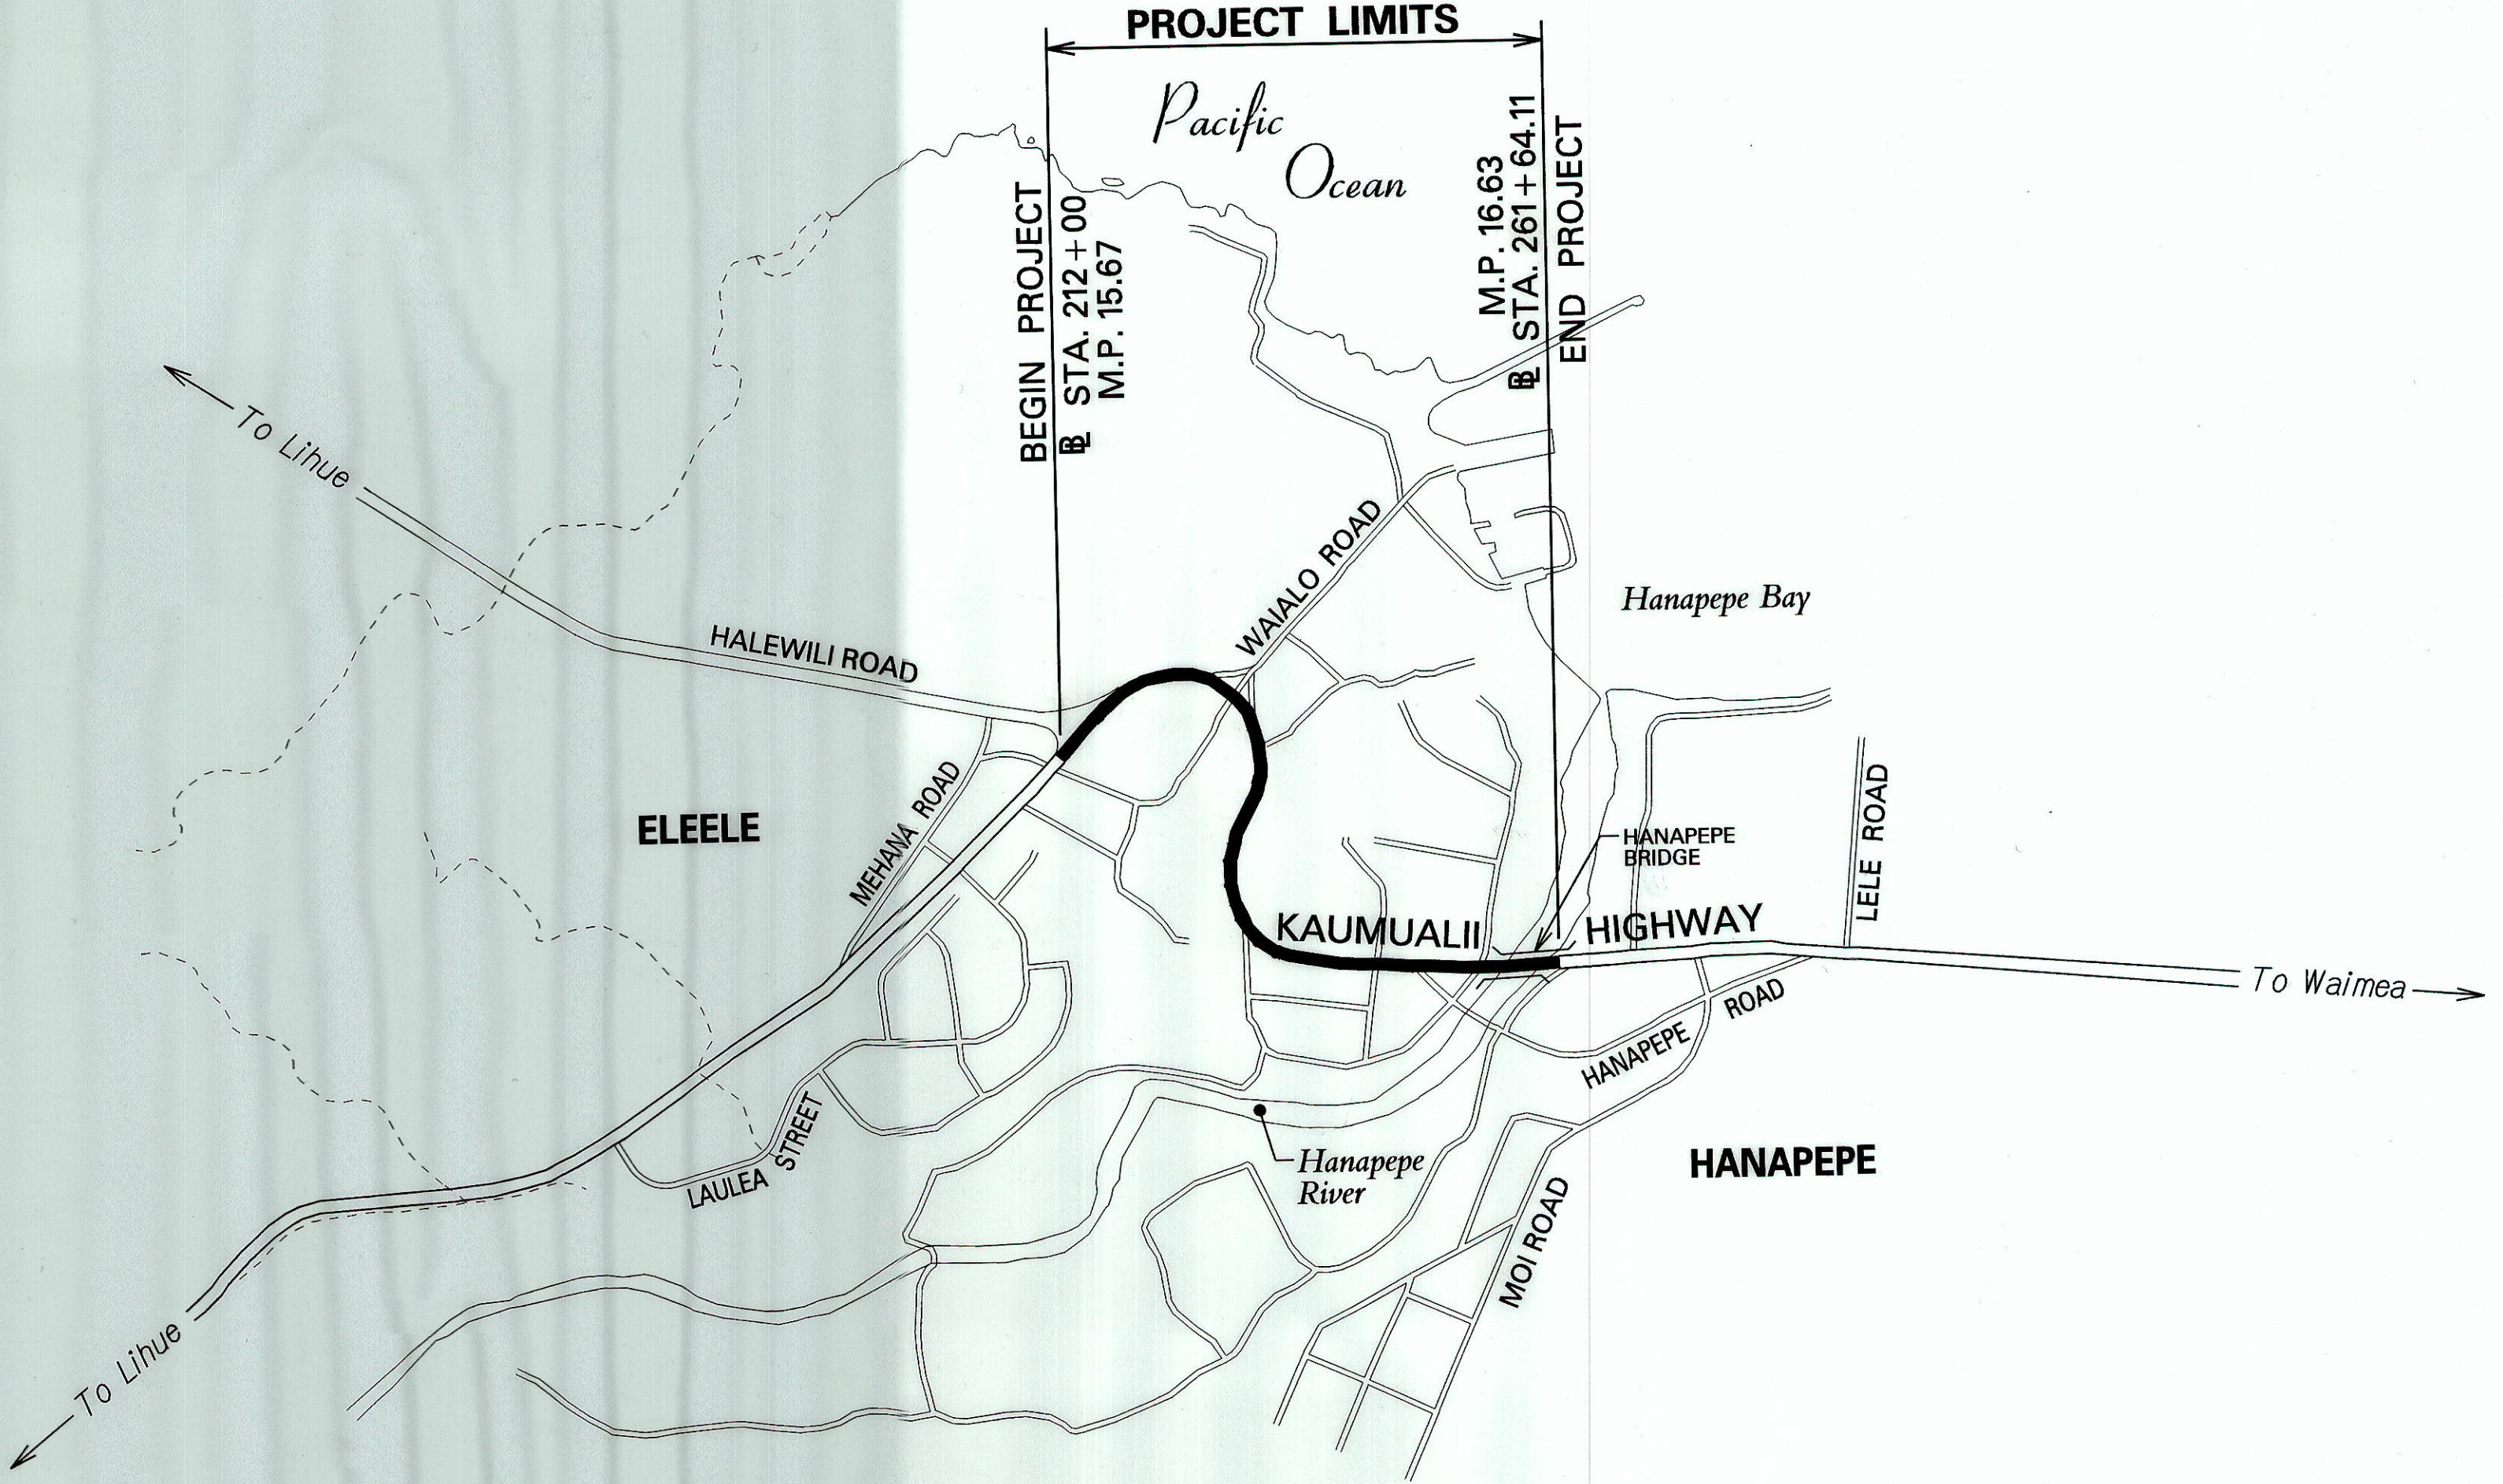

LAYOUT PLAN
GROSS LENGTH OF PROJECT.....0.96 MILES
NET LENGTH OF PROJECT.....0.96 MILES

FED. ROAD DIST. NO.	STATE	PROJ. NO.	FISCAL YEAR	SHEET NO.	TOTAL SHEETS
HAWAII	HAW.	50C-03-07M	2009	1	25

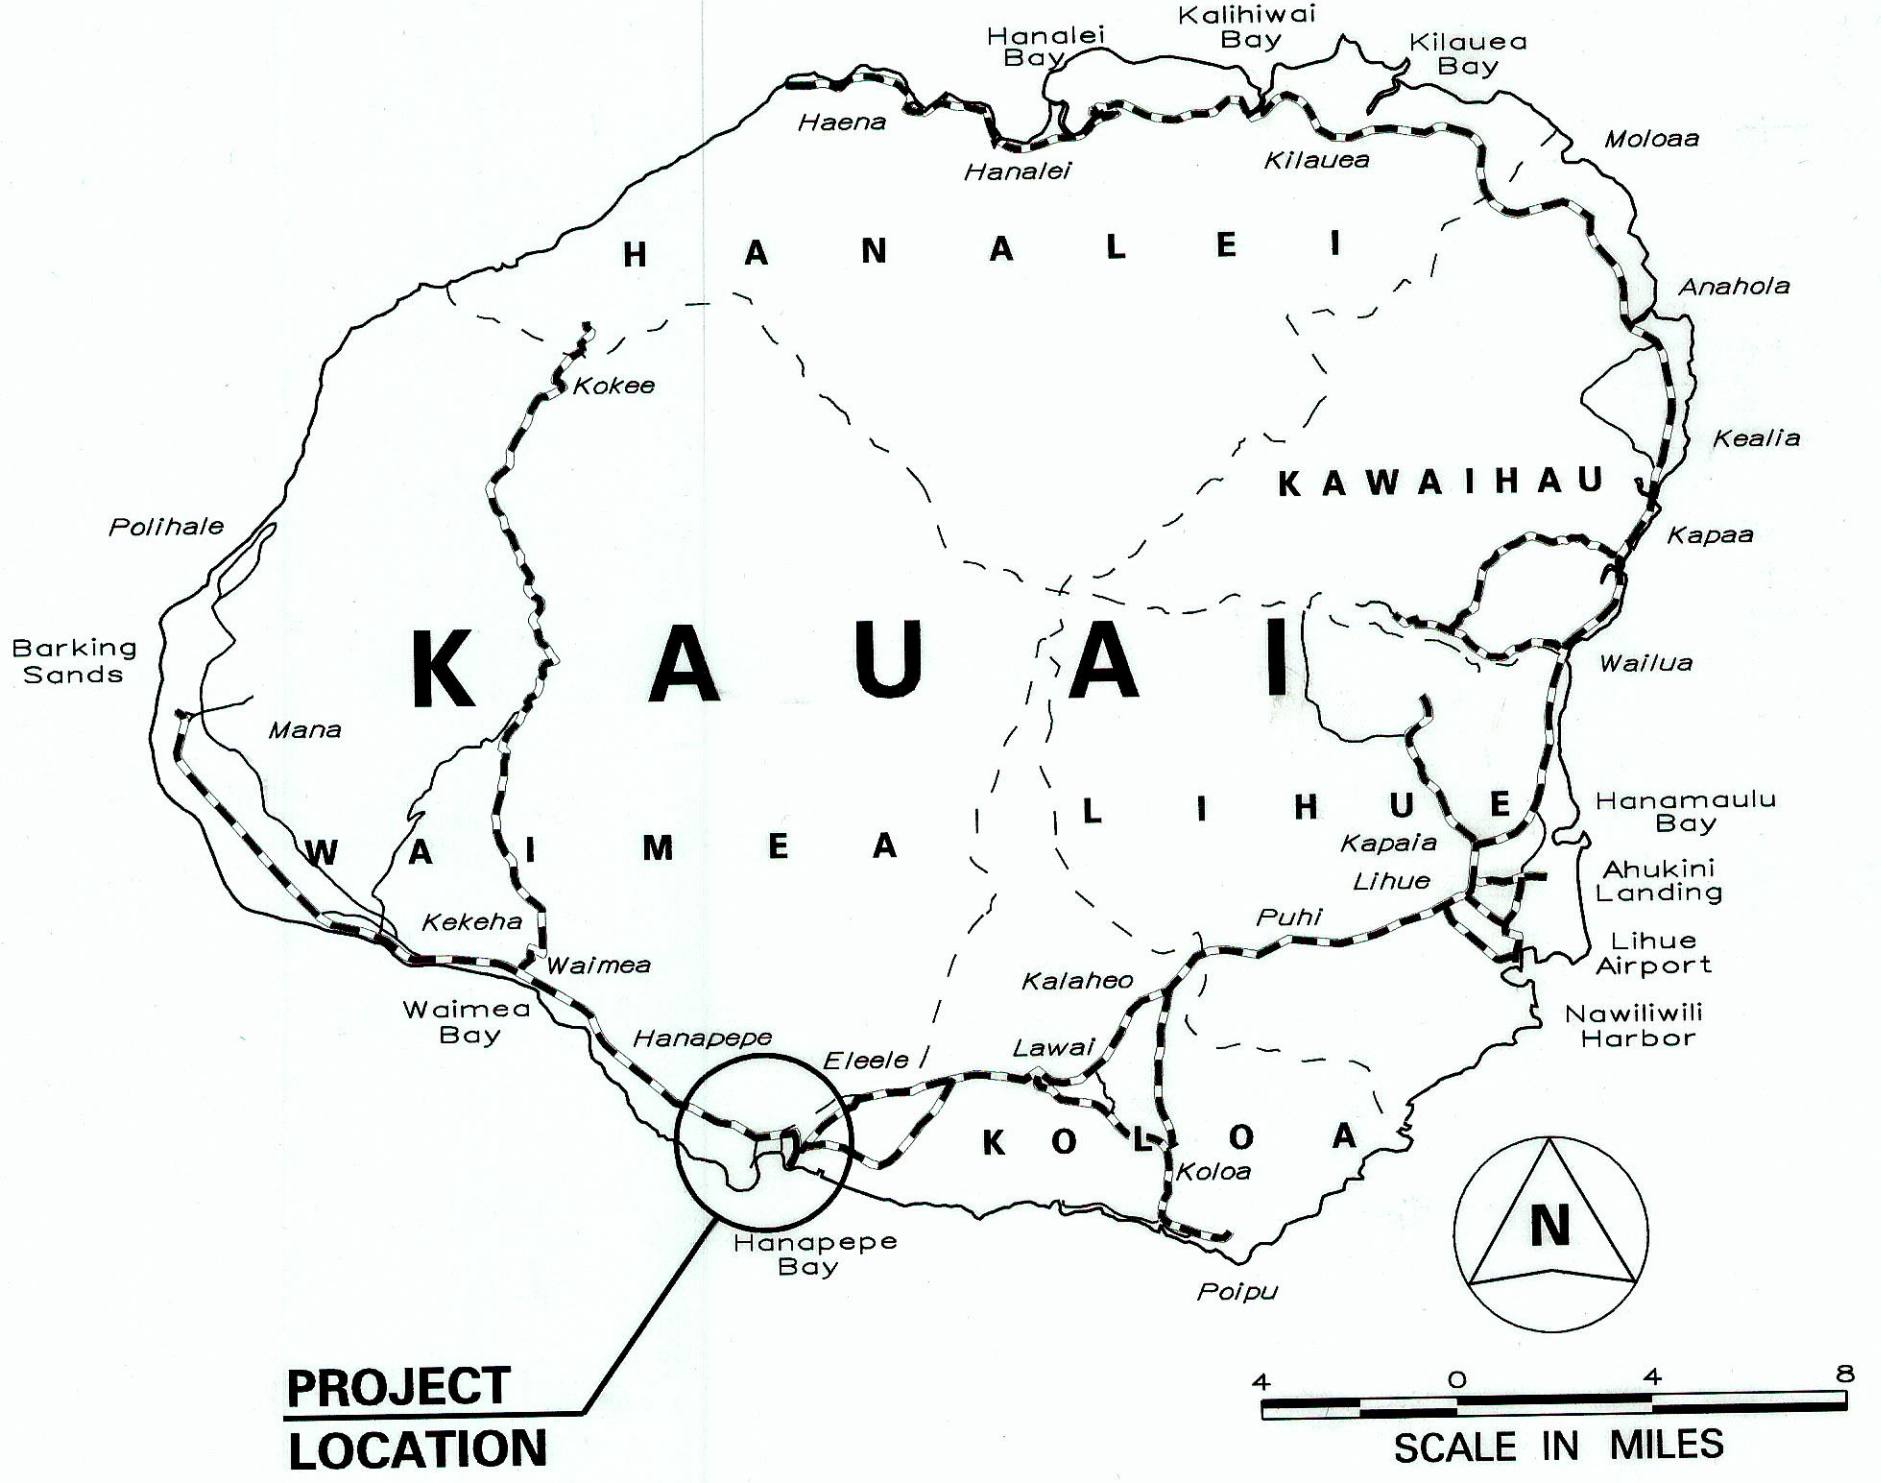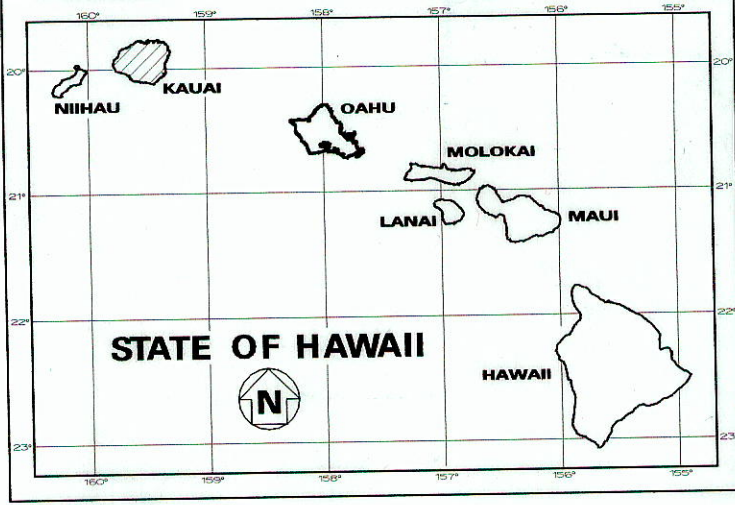

----- FEDERAL AID PROJECTS PREVIOUSLY CONSTRUCTED OR UNDER CONSTRUCTION

MILE POST 15.67 TO MILE POST 16.63

CHANGES MADE DURING CONSTRUCTION HAVE BEEN INCORPORATED ON THESE PLANS EXCEPT CHANGES IN THE ORIGINAL THEORETICAL QUANTITIES. FOR ACTUAL QUANTITIES, REFER TO PROJECT LEDGER AND/OR COMPUTATION BOOK.

[Signature] **9.3.16**
RESIDENT ENGINEER DATE

DEPARTMENT OF TRANSPORTATION
STATE OF HAWAII

APPROVED:
[Signature] 11-3-08
DIR. OF TRANSPORTATION DATE

DESIGNED BY
MANAGED BY
NOV. 2008 DATE
241-3016 PHONE