


FED. ROAD DIST. NO.	STATE	FED. AID PROJ. NO.	FISCAL YEAR	SHEET NO.	TOTAL SHEETS
HAWAII	HAW.	STP-050-1(10)	1993	11	12

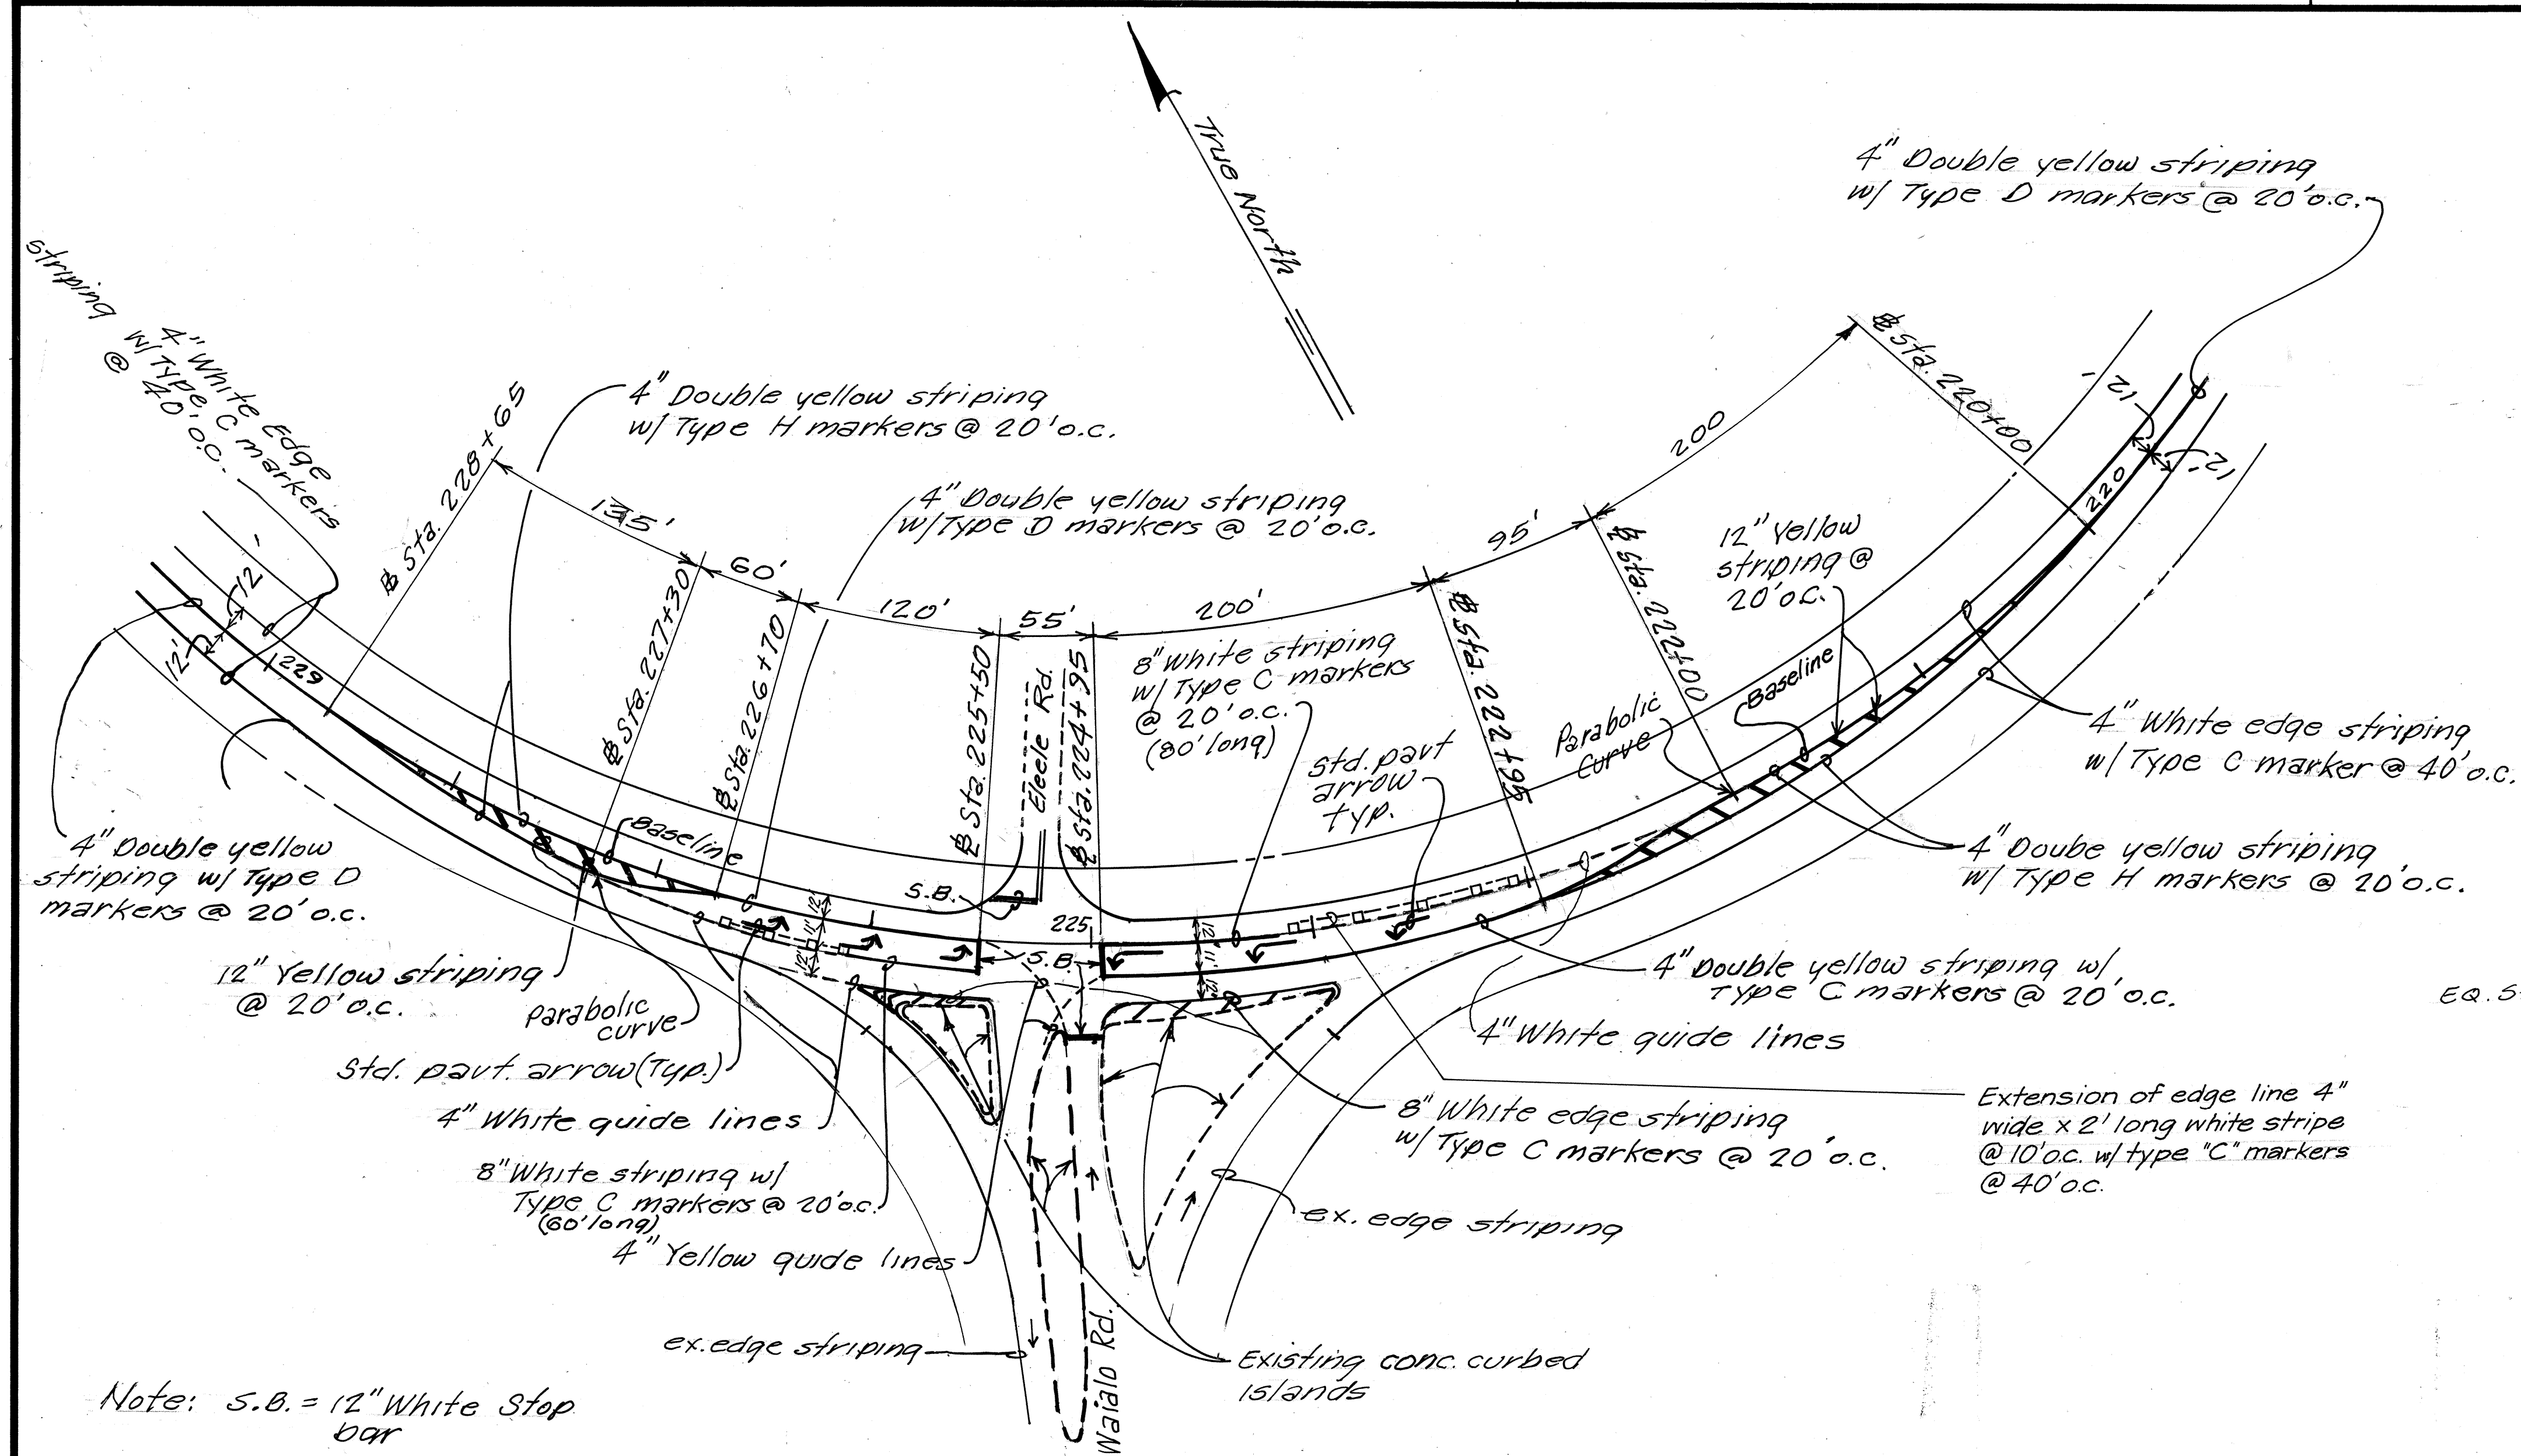

Pavement Striping & Marking Summary

Raised Pav't Markers					Pavement Striping & Markings										Remarks		
Type D	Type H	Type J	Type C	Type A	4" Yellow Guide Lines	4" Yellow Solid	4" Yellow Obl	12" Yellow Solid	White Pav't Arrow	Cross Walk	4" White Guide Lines	4" White Edge Line	8" White Solid	12" White Solid			
Waimea Canyon Drive to Waimea Bridge																	
188+30	2		4				*	25				**	60				
188+55							*	50								Waimea Cyn Drive	
188+95							*	295			***	4	*	37	***	36	
191+90	16						*	50							Makeke Rd.		
192+30	15						*	270				*	202				
195+00							*	50		***	4			***	36	Pokole Rd.	
195+50							*	250				*	56				
198+00	14						*	50		***	4			***	36	ola Rd.	
198+75	13						*	225				*	32				
201+00							*	50				*	3	***	12	Moana Rd	
201+40							*	250				*	29				
203+90	14						*	100		***	4			***	48	Menehune Rd	
204+70	8						*	131					**	77		Halepule Rd	
206+00.49 = 0+00							*	285				*	50	**	33		
2+85		16					*	100		***	4			***	48	Panako Rd	
3+75	22						*	415				*	49				
7+90							*	100						***	24	Alawai Rd.	
8+30							*	663						**	1346	Waimea Br.	
14+93	35			36													
Total	155			40			*	3359		***	20	*	458	**	1456	***	240


PAVEMENT STRIPING & MARKING PLAN
KAUMUALII HWY @ WAIALO RD.

Scale: 1" = 50'

PAVEMENT STRIPING & MARKING SUMMARY															
	Raised Pav't Markers					Pavement Striping & Markings								REMARKS	
	Type D	Type H	Type J	Type C	Type A	4" Yellow Guide Lines	4" Yellow Solid	4" Yellow Double	12" Yellow Solid	White Pav't Arrow	Cross Walk	4" White Guide Lines	4" White Edge Lines		8" White Solid
Waimea Canyon Drive to Kekaha (C.C.O. No. 2)															
135+00	86		344	171									6820		Pass/Pass
169+10	7	7	28	14				280					560		Pass/No Pass
171+90	*80			82					*1590				3280		No Pass
188+30															
								30				230		30	*Huakai St. 50 ft. Opening
											2 lane			24	Crosswalk
TOTALS	175	7	372	267				1620			2 lane	230	10660	54	

ADDED DURING AS-BUILT POSTING

(3 - 4 lbs/ft Channel Sign Posts)

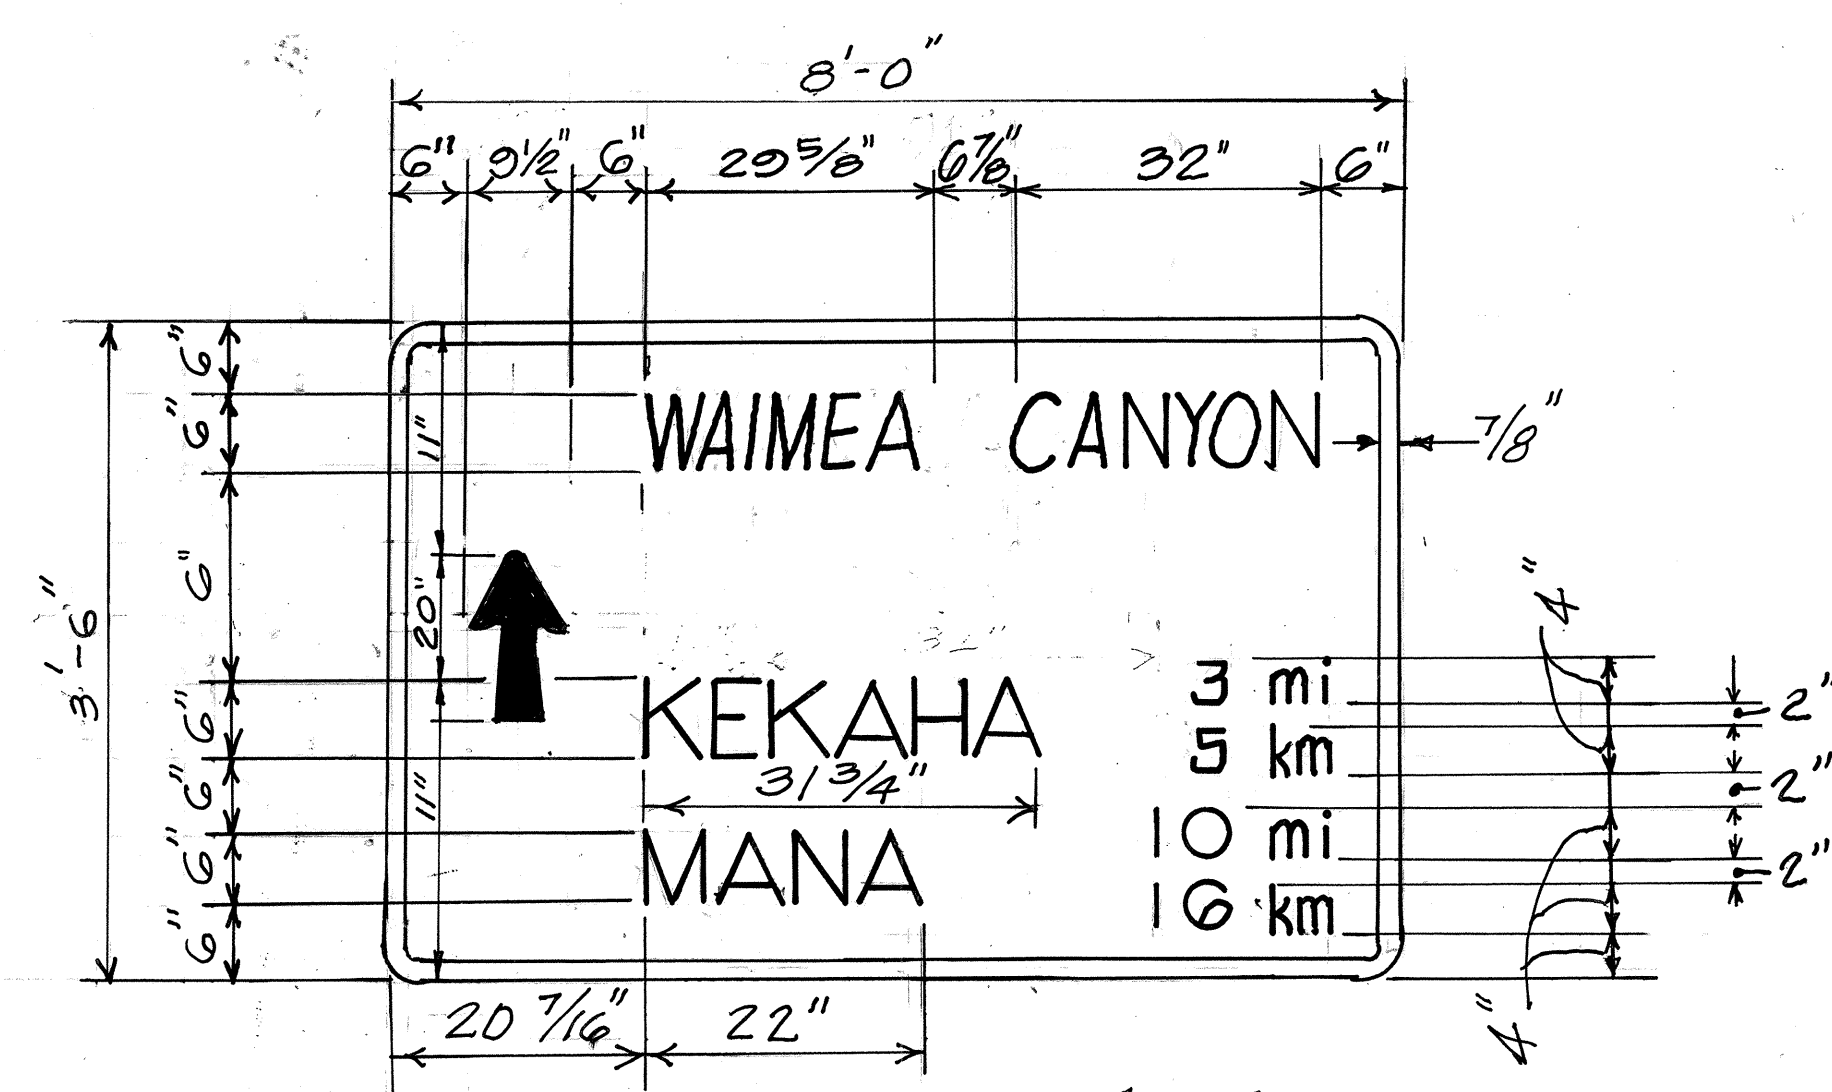

D-1 DESTINATION SIGN

Legend.

- * Tape, Type I, or Thermoplastic Extrusion (No passing zones, Channelizing lines, Solid Lines or Pavement arrows)
- ** Tape, Type II, or Thermoplastic Extrusion (Transverse Median marking, Transverse shoulder markings, Channelizing islands or Edge striping)
- *** Tape, Type III, or Thermoplastic Extrusion (Guide lines, Stop lines, Extension of edge lines or Crosswalk markings)

Note: See sheet 12 for Eleele-Hanapepe pavement striping & Marking Summary sheet.

STATE OF HAWAII
DEPARTMENT OF TRANSPORTATION
HIGHWAYS DIVISION

PAVEMENT STRIPING & MARKING PLAN
& SUMMARY

Kaumualii Highway Resurfacing
Waimea Canyon Drive to Waimea Bridge
& Eleele to Lele Road
Federal Aid Project No. STP-050-1 (10)
Scale: As Shown May 1993

SHEET No. 5 OF 5 SHEETS