


FED. ROAD DIST. NO.	STATE	FED. AID PROJ. NO.	FISCAL YEAR	SHEET NO.	TOTAL SHEETS
HAWAII	HAW.	STP-050-1(10)	1993	12	12

Station	Raised Pavt Markers					Pavement Striping & Markings										Remarks
	Type D	Type H	Type J	Type C	Type A	4" Yellow Guide Lines	4" Yellow Solid	4" Yellow Dbl	12" Yellow Solid	White Pavt Arrow	Cross Walk	4" White Guide Lines	4" White Solid	8" White Solid	12" White Solid	
Eleele to Lele Road																
212+30																
213+12	5				6				*82				**164			
213+52					6								**50		***24	Halewili Rd.
220+00	34				34				*648				**1296			
228+65	18	42			42	***90	*	320	**114	6		***270	**1620	**120	***48	Waialo/Eleele Rd
239+40	61				60			*	1193				**2386			
240+20					3						***2-lane		**100		***24	Hanapepe Rd.
242+80	14				14			*	260				**520			
243+20					4								**40		***20	Puna Rd.
249+35	32				32			*	615				**1230			
249+75					4						***2-lane		**40		***20	Kona Rd
251+55	10				10			*	180				**260			
252+15					4								**80		***12	Hana Rd.
256+44	22				22			*	429				**858			
256+92					4								**40		***20	Iona Rd.
265+50	40				40			*	715				0	**1648		
265+90					4								**75	**75	**12	Puulo Rd
266+55	4				4			*	65				**130			
266+95					4								**60		***12	Puulo Rd.
270+82	21				20			*	387			***2-lane	**774			
271+22					3								**60		***12	Moi Rd.
277+00	30				30			*	578			***2-lane	**1156			
277+40					3								**50		***12	
279+90	14				14			*	250				**500			
280+50					4								60		***15	Hanapepe Rd.
282+50	12				11			*	200				**400			
283+50					4								120			Lele Rd
284+00	4				4			*	50				100			
Totals	321	42			450	***90	*	6031	**980	**114	6	***8-lane	***270	**12,269	**120	***231


*, **, *** - See Sht. 11 for Notes.

- ① EQ Sta @ 235+22.67 (+118.07)
 ② EQ Sta @ 256+44.09 (-8.63)
 ③ EQ Sta @ 261+64.11 (-74.47)

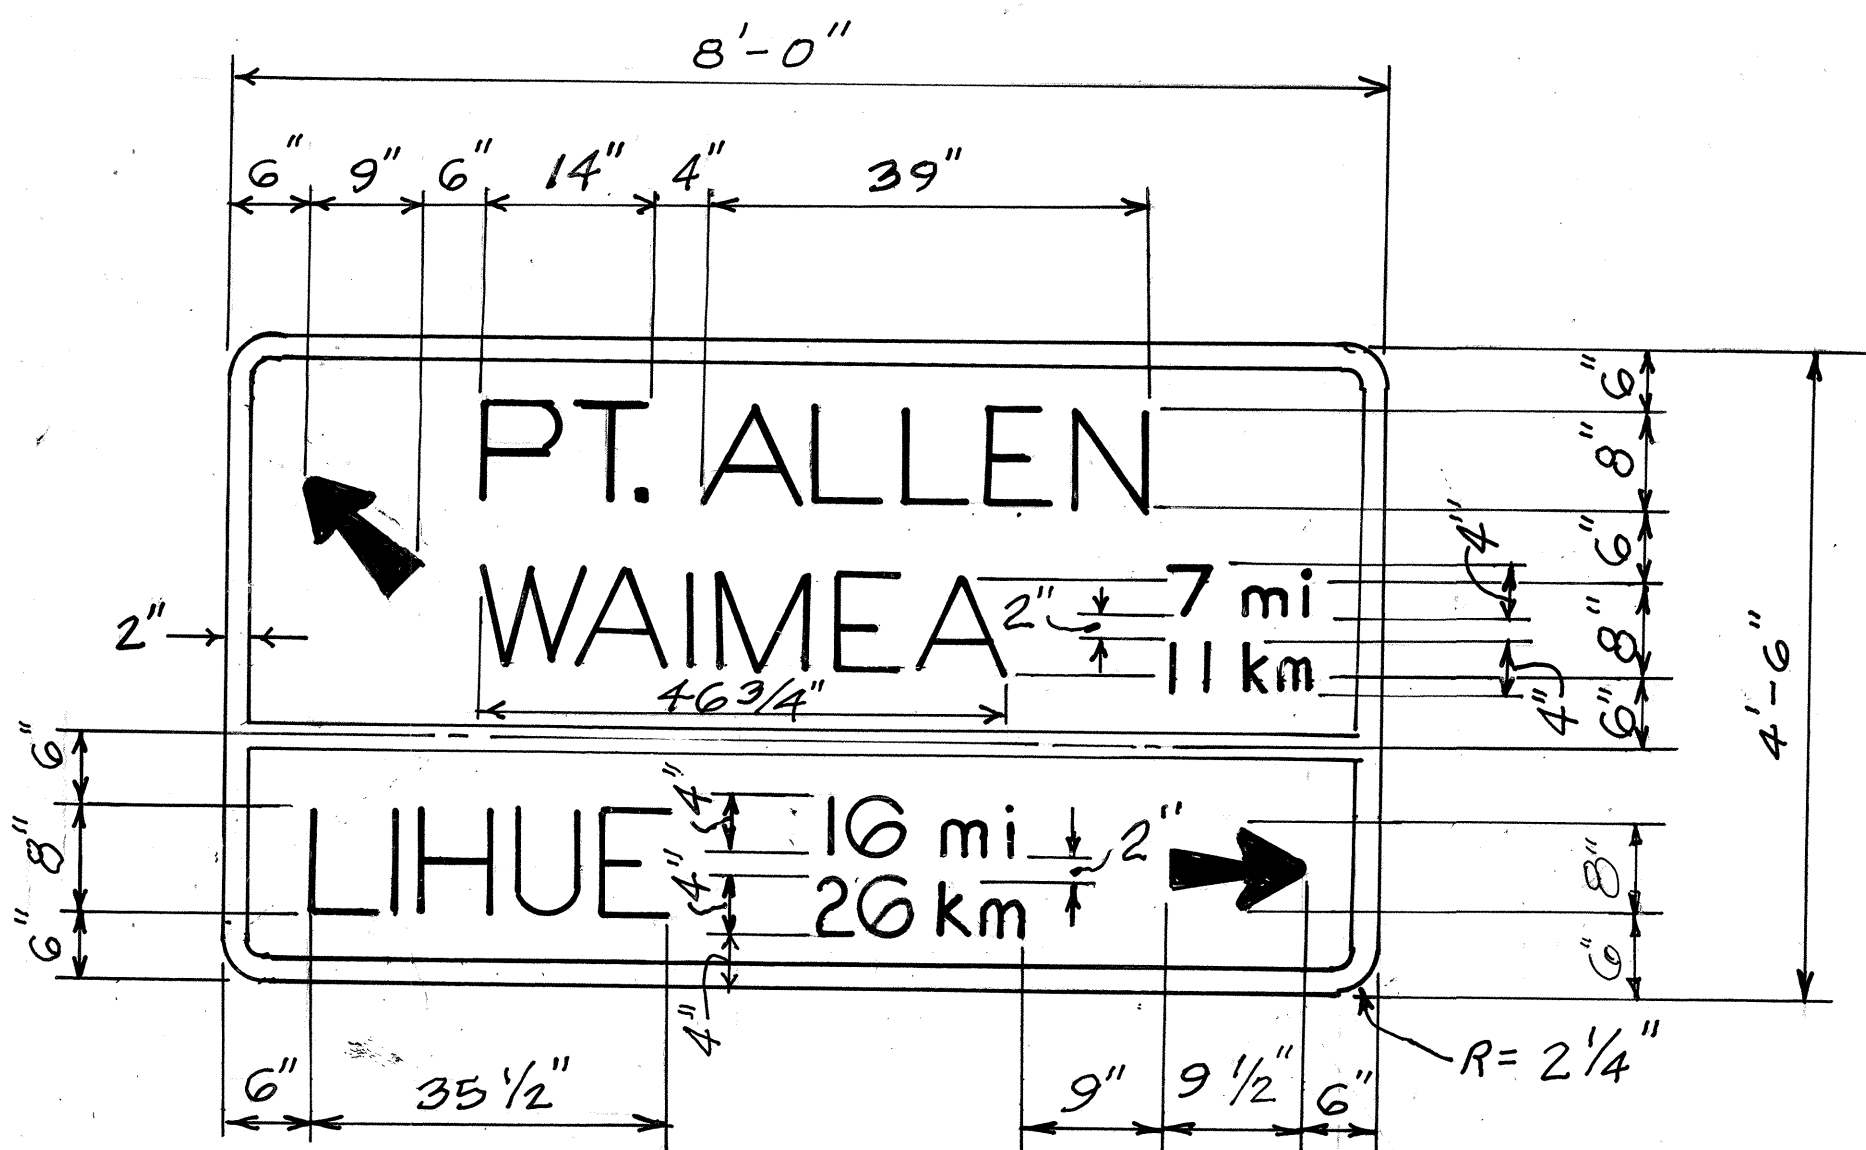


Letter size = 8EM

D-2 DESTINATION SIGN
 (3-Each - 4 lbs/Ft. Flanged Channel Sign Posts)
 N.T.S.

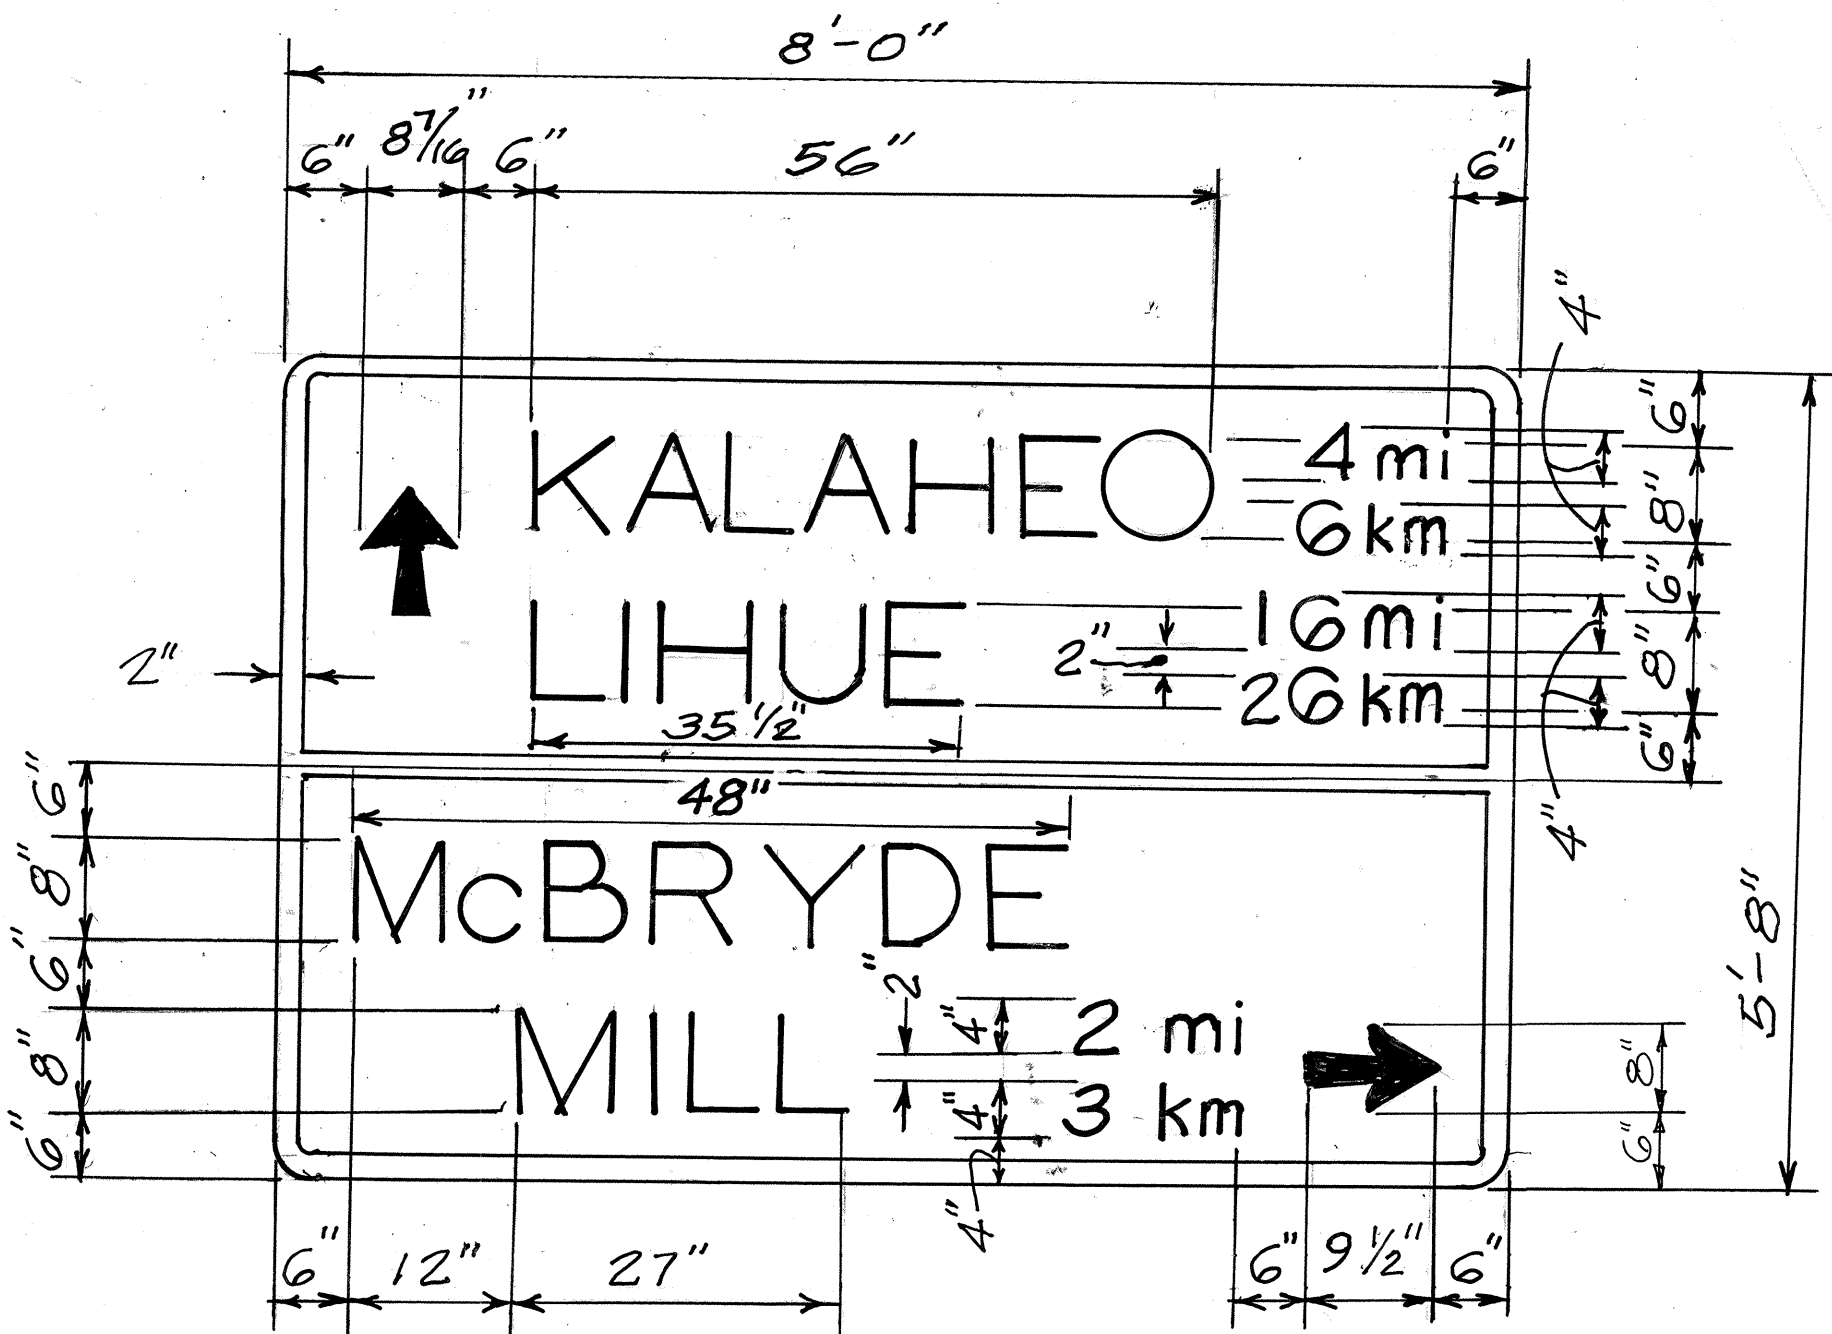


Letter size = 8EM

D-3 DESTINATION SIGN
 (2 - W6x9 sign posts)
 N.T.S.

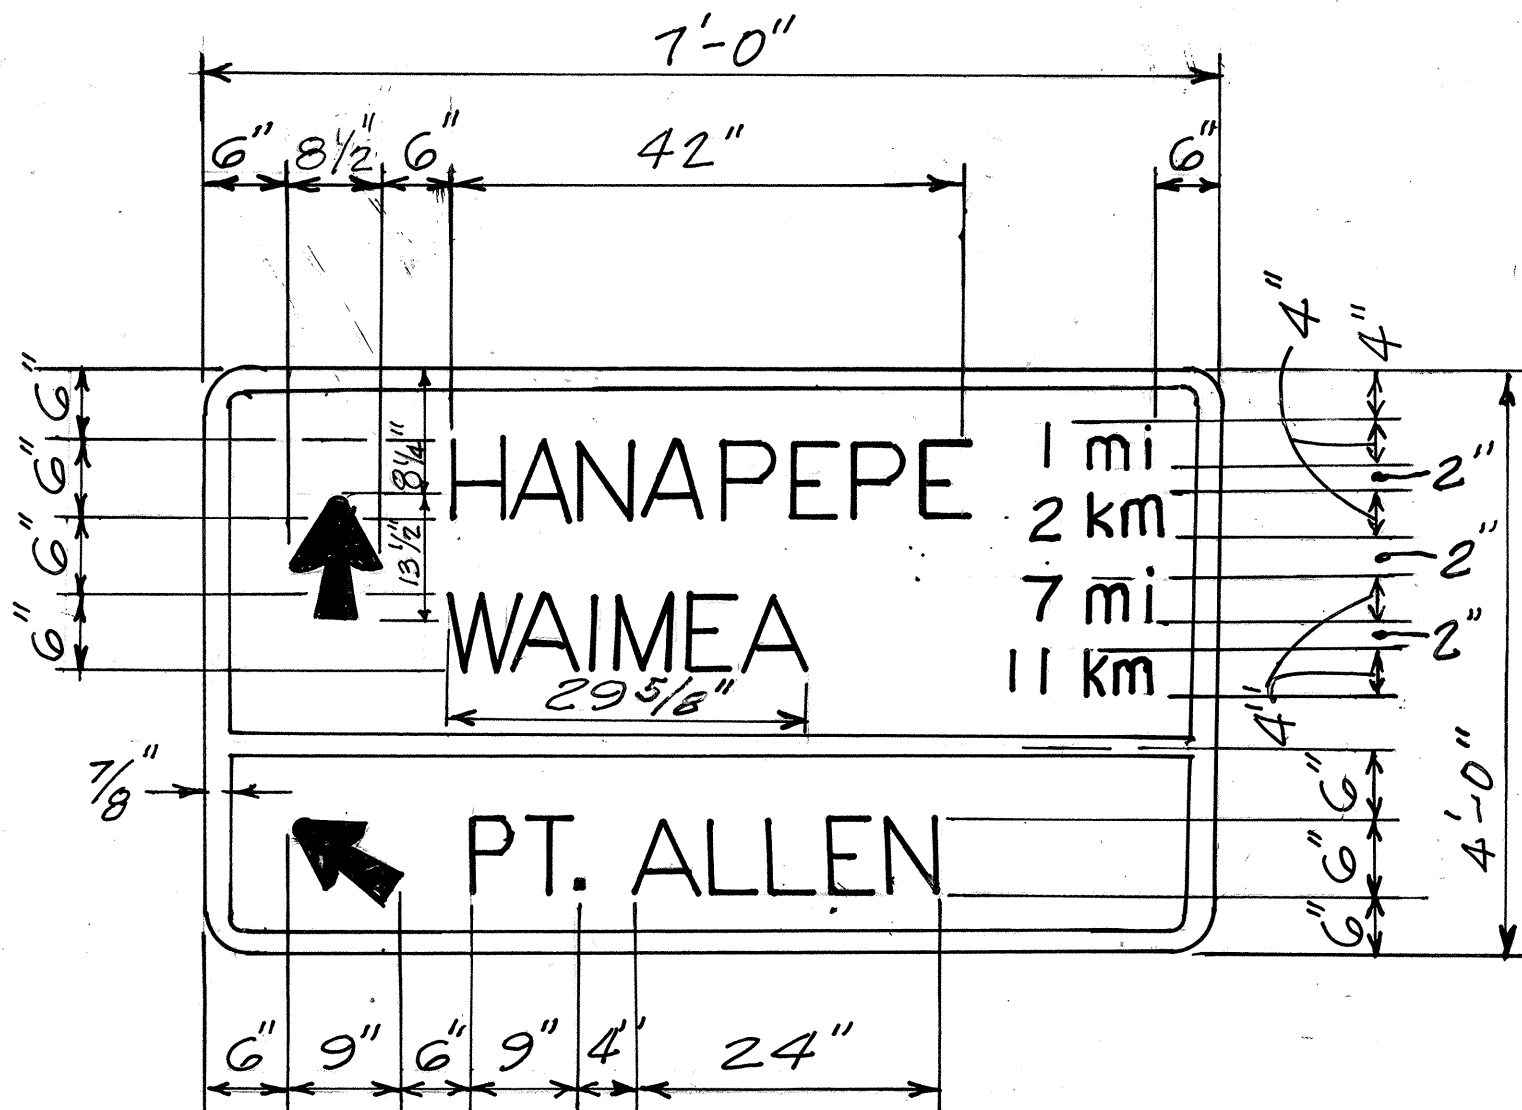


Letter size = 6D

D-4 DESTINATION SIGN
 (3-Each - 4 lbs/Ft. Flanged Channel Sign Post)
 N.T.S.

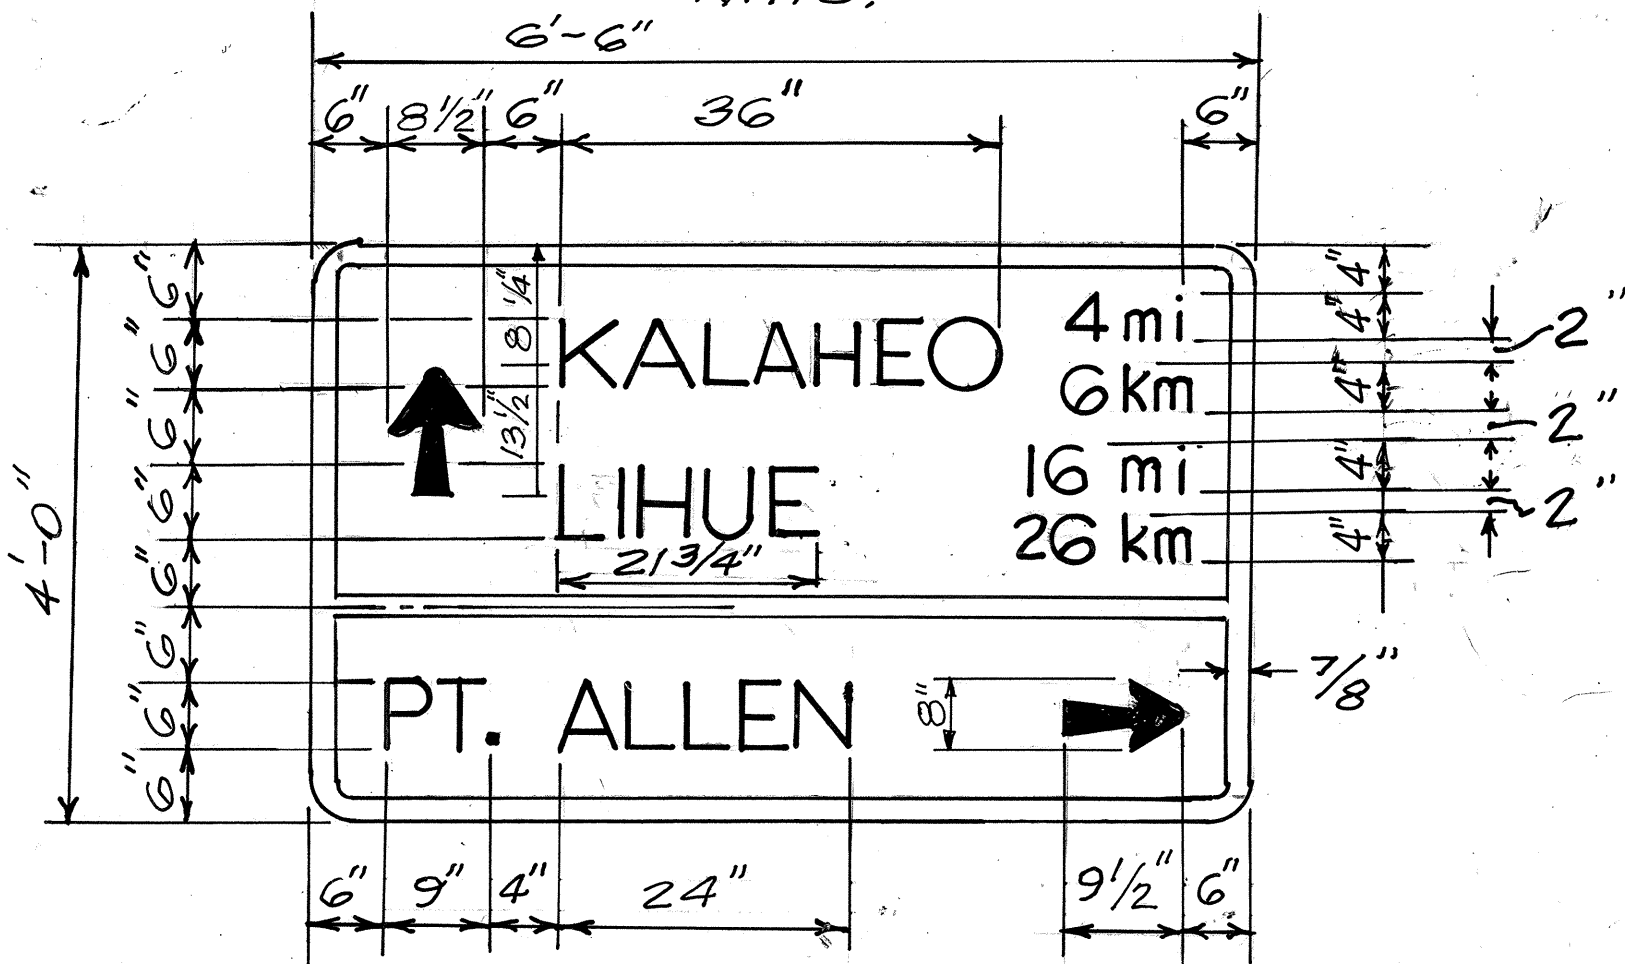

Letter size = 6D

D-5 DESTINATION SIGN
 (2 Each - 4 lbs/Ft. Flanged Channel Sign Post)
 N.T.S.

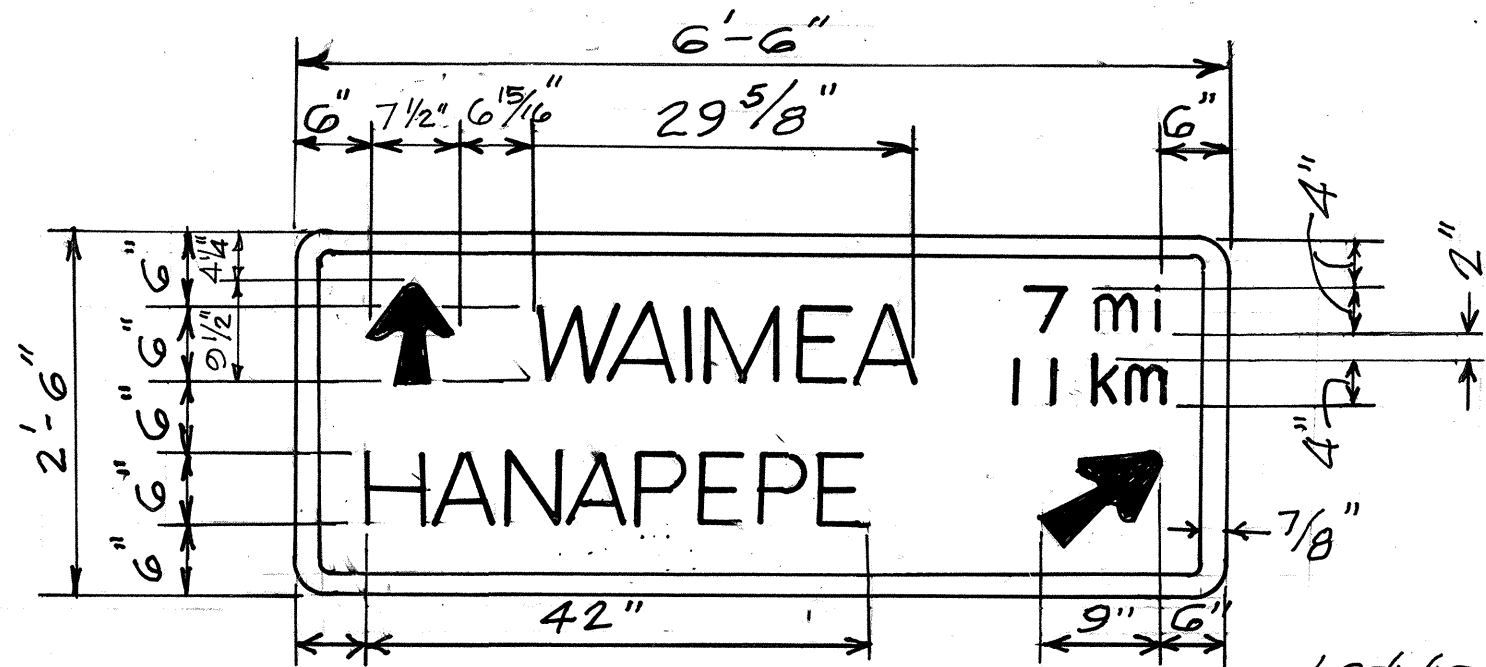

Letter size = 6D

D-6 DESTINATION SIGN
 N.T.S.

STATE OF HAWAII DEPARTMENT OF TRANSPORTATION HIGHWAYS DIVISION	
PAVEMENT STRIPING & MARKING SUMMARY & SIGN DETAILS	
Kauaualii Highway Resurfacing Waimea Canyon Drive to Waimea Bridge & Eleele to Lele Road	
Federal Aid Project No. STP-050-1 (10)	May 1993
SHEET No. 1 OF 1 SHEETS	