


FED. ROAD DIST. NO.	STATE	FED. AID PROJ. NO.	FISCAL YEAR	SHEET NO.	TOTAL SHEET
HAWAII	HAW.	STP-050-1(10)	1993	7	12

Note: 1.  Delineates resurfacing limits

2. See Typical Sections for cold planing & A.C. removal limits.

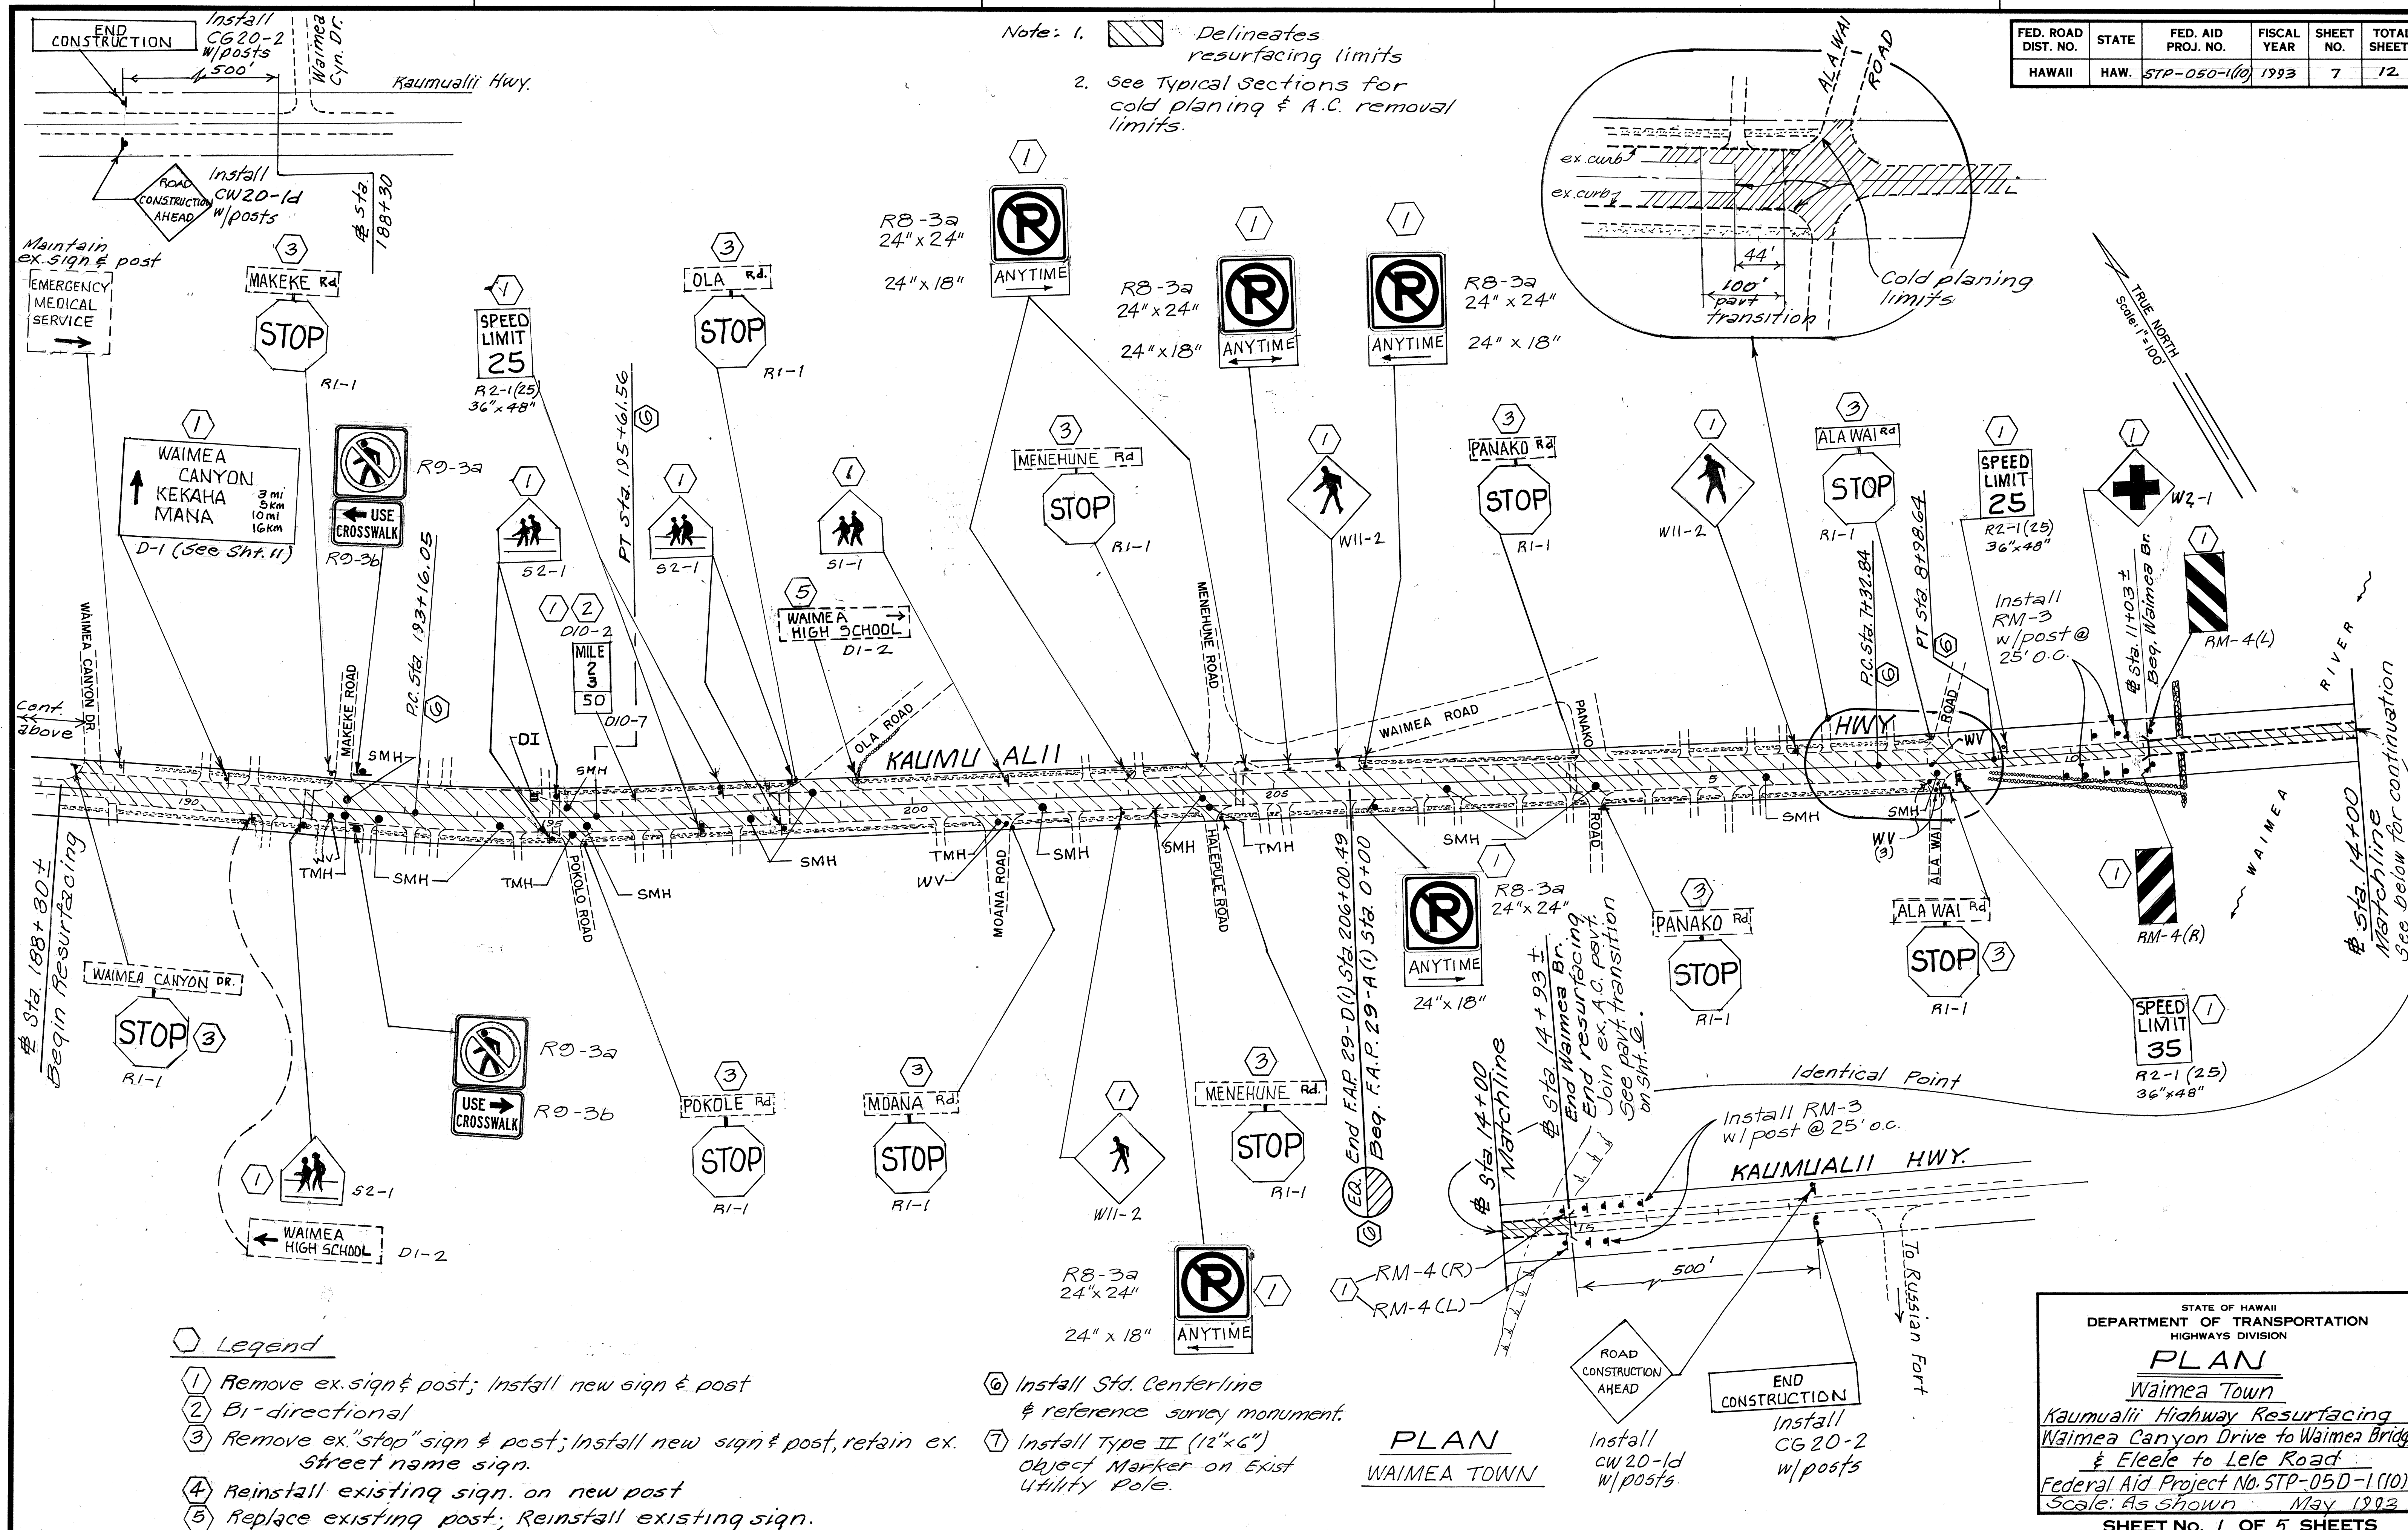

ORIGINAL PLAN	SURVEY PLOTTED BY _____ DATE _____
NOTE BOOK	DRAWN BY _____
	TRACED BY _____
	DESIGNED BY _____
	QUANTITIES BY _____
No. _____	CHECKED BY _____

PLAN
WAIMEA TOWN

STATE OF HAWAII
DEPARTMENT OF TRANSPORTATION
HIGHWAYS DIVISION

PLAN
Waimea Town
Kaumualii Highway Resurfacing
Waimea Canyon Drive to Waimea Bridge
& Eleele to Lele Road
Federal Aid Project No. STP-05D-1(10)
Scale: As Shown May 1993

SHEET No. 1 OF 5 SHEETS