


FED. ROAD DIST. NO.	STATE	FED. AID PROJ. NO.	FISCAL YEAR	SHEET NO.	TOTAL SHEETS
HAWAII	HAW.	STP-050-1(10)	1993	6S-1	12

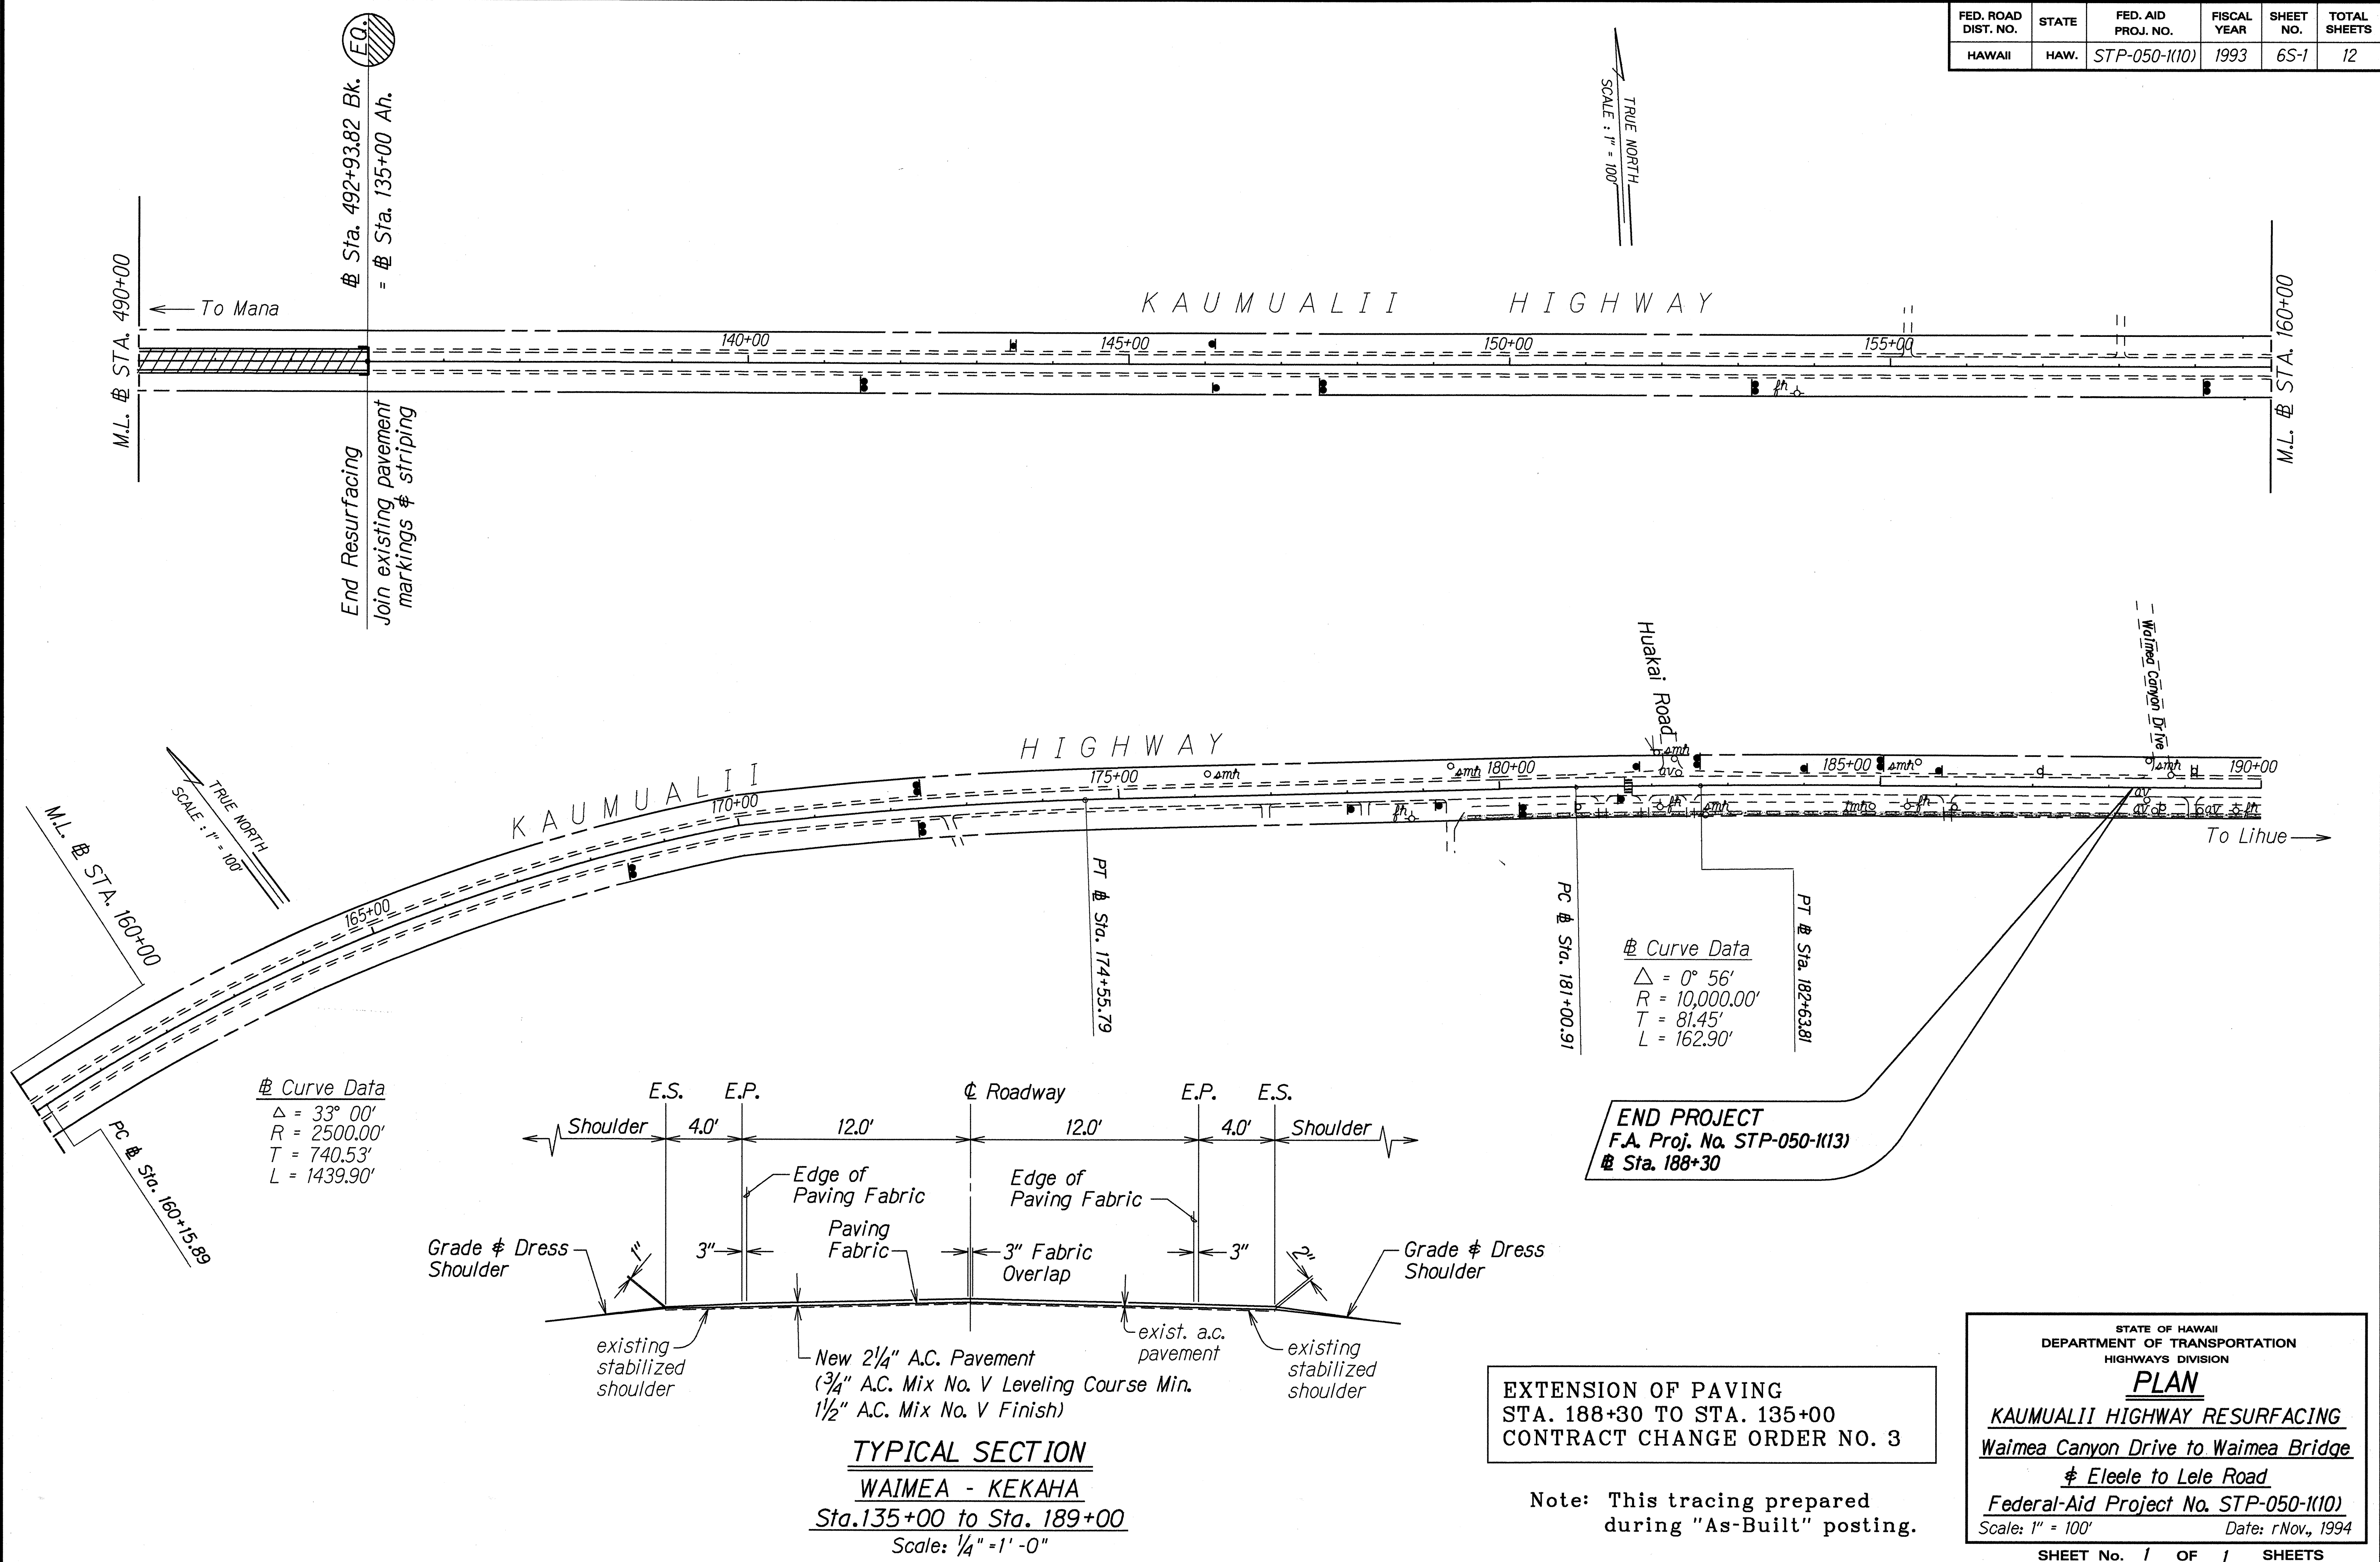

STATE OF HAWAII
DEPARTMENT OF TRANSPORTATION
HIGHWAYS DIVISION

PLAN

KAUMUALII HIGHWAY RESURFACING
Waimea Canyon Drive to Waimea Bridge
Elele to Lele Road
Federal-Aid Project No. STP-050-1(10)
Scale: 1" = 100' Date: rNov., 1994

SHEET No. 1 OF 1 SHEETS