

INDEX TO DRAWINGS	
SHEET NO.	DESCRIPTION
1	TITLE SHEET
2	STANDARD PLAN SUMMARY SHEET
3	GENERAL NOTES & LEGEND
4	TYPICAL SECTIONS
5	TYPICAL SECTIONS
6	TYPICAL PLANS, SECTIONS & DETAILS
* 7	PLAN - WAIMEA
8	PAVEMENT STRIPING & MARKING PLAN - WAIMEA
9-10	PLAN - ELEELE-HANAPEPE
11	PAVEMENT STRIPING & MARKING PLAN & SUMMARY
12	PAVEMENT STRIPING & MARKING SUMMARY & SIGN DETAILS

* 6S-1 IS A SUPPLEMENT SHEET TO THE CONTRACT PLANS.
NEW TOTAL = 13 SHEETS

STATE OF HAWAII

DEPARTMENT OF TRANSPORTATION

HIGHWAYS DIVISION

HONOLULU, HAWAII

"AS-BUILT"

PLANS FOR

RESURFACING

KAUMUALII HIGHWAY

WAIMEA CANYON DRIVE TO WAIMEA BRIDGE

AND


ELEELE TO LELE ROAD

PROJ. NO. STP-050-1(10)

DISTRICT OF WAIMEA

AND KOLOA

ISLAND OF KAUAI

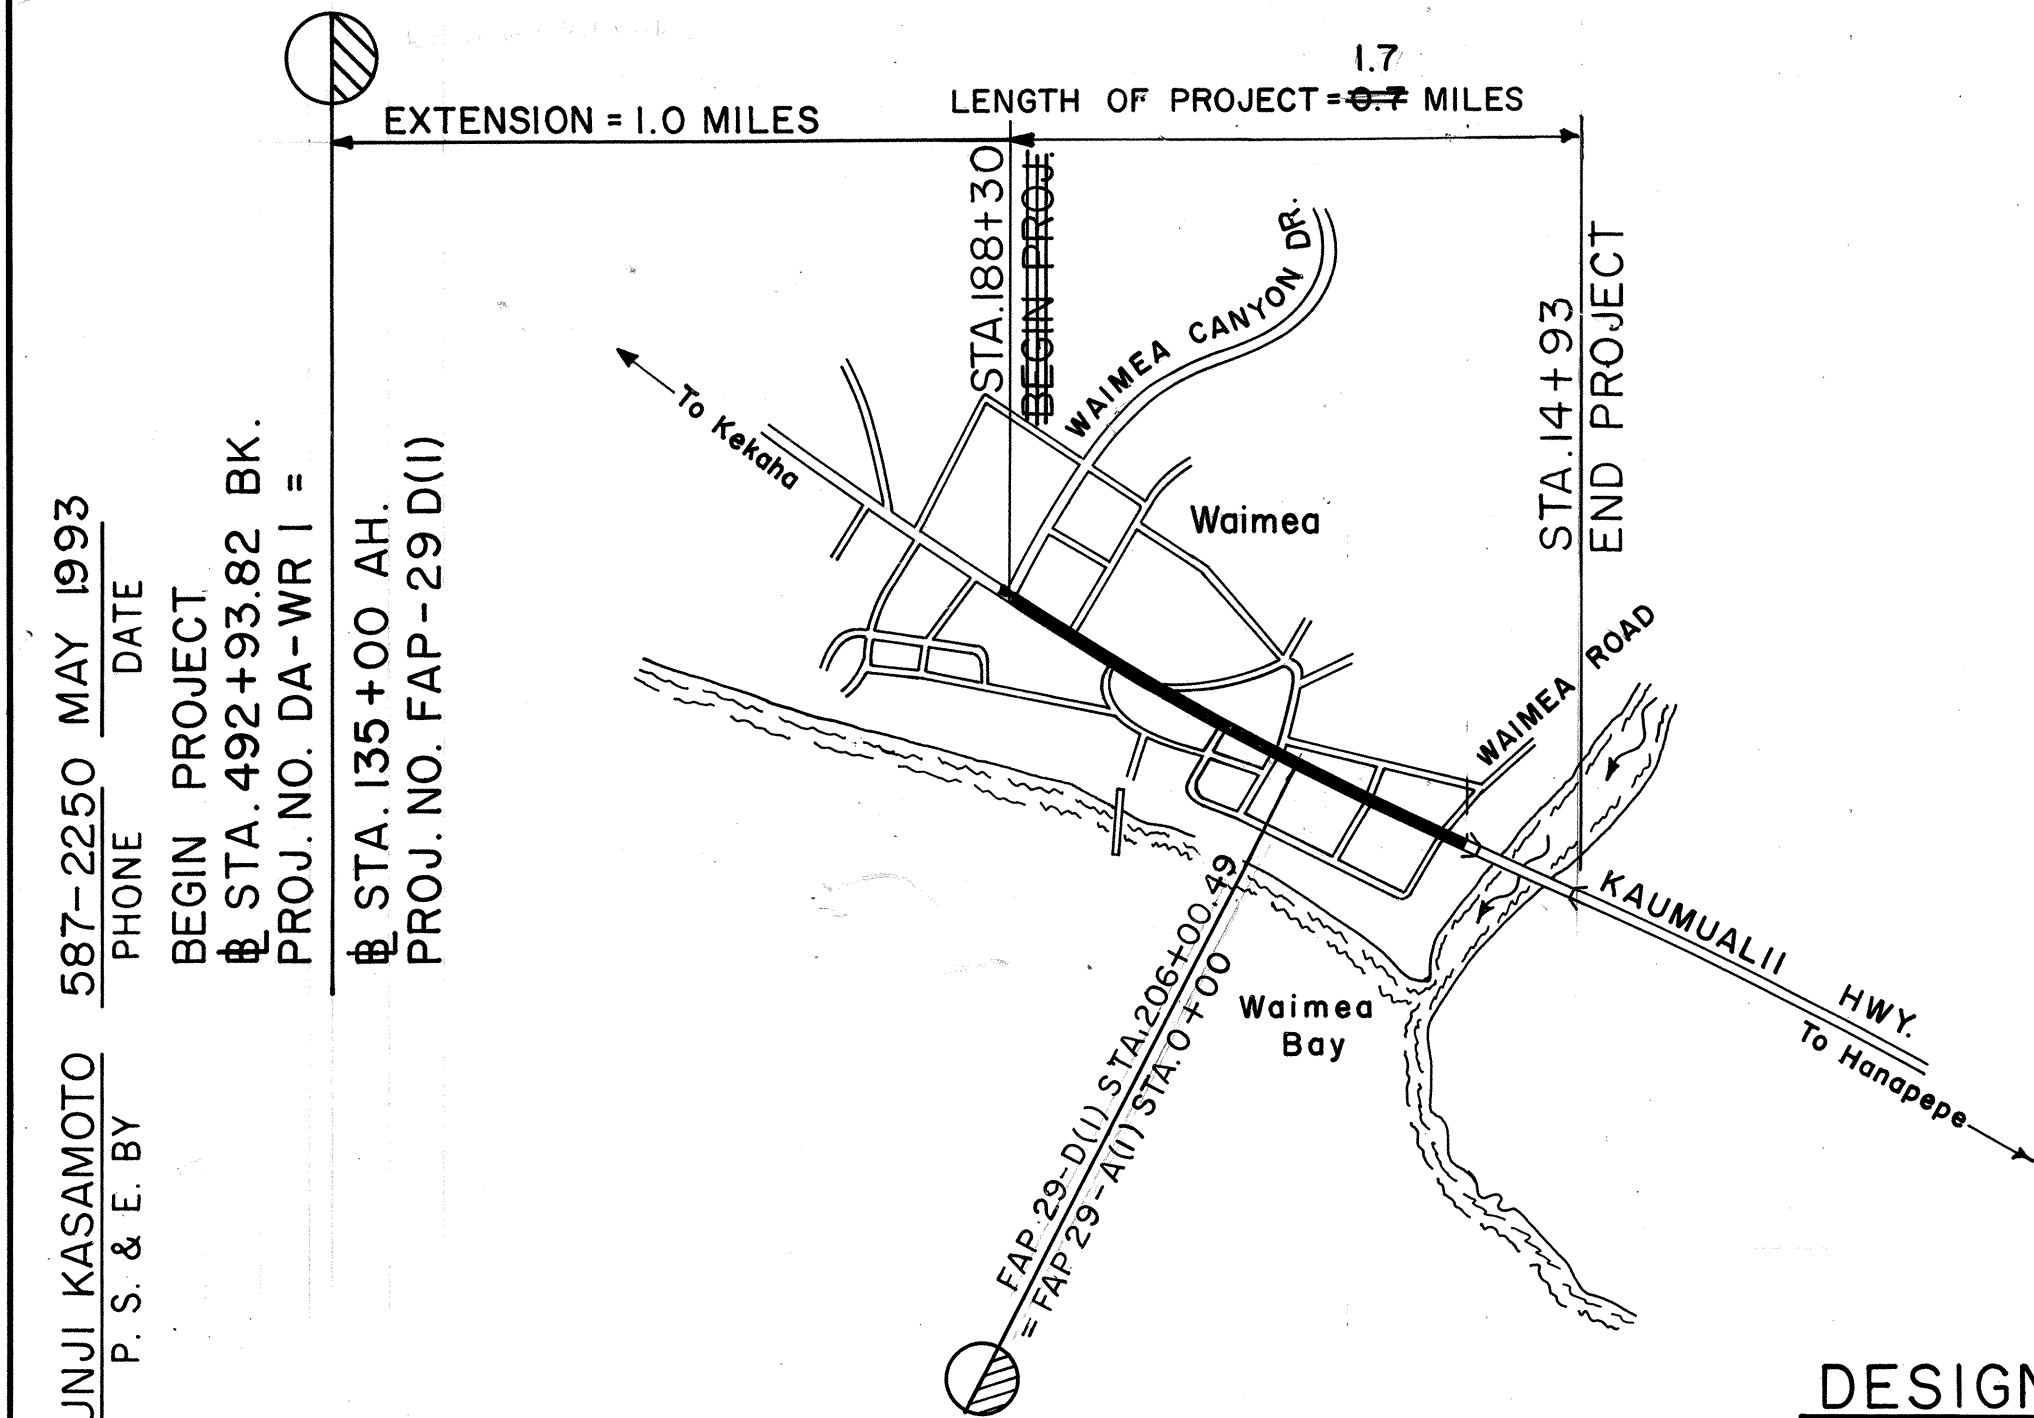


WAIMEA TOWN SECTION

LOCATION OF PROJECT

Scale: 1" = 500'

DESIGN	DESIGNATION
ADT (1993)	11,990
ADT (2003)	14,820
DHV	1,410
D	55/45
T	5.0%
T24	4.0%
V	25 MPH

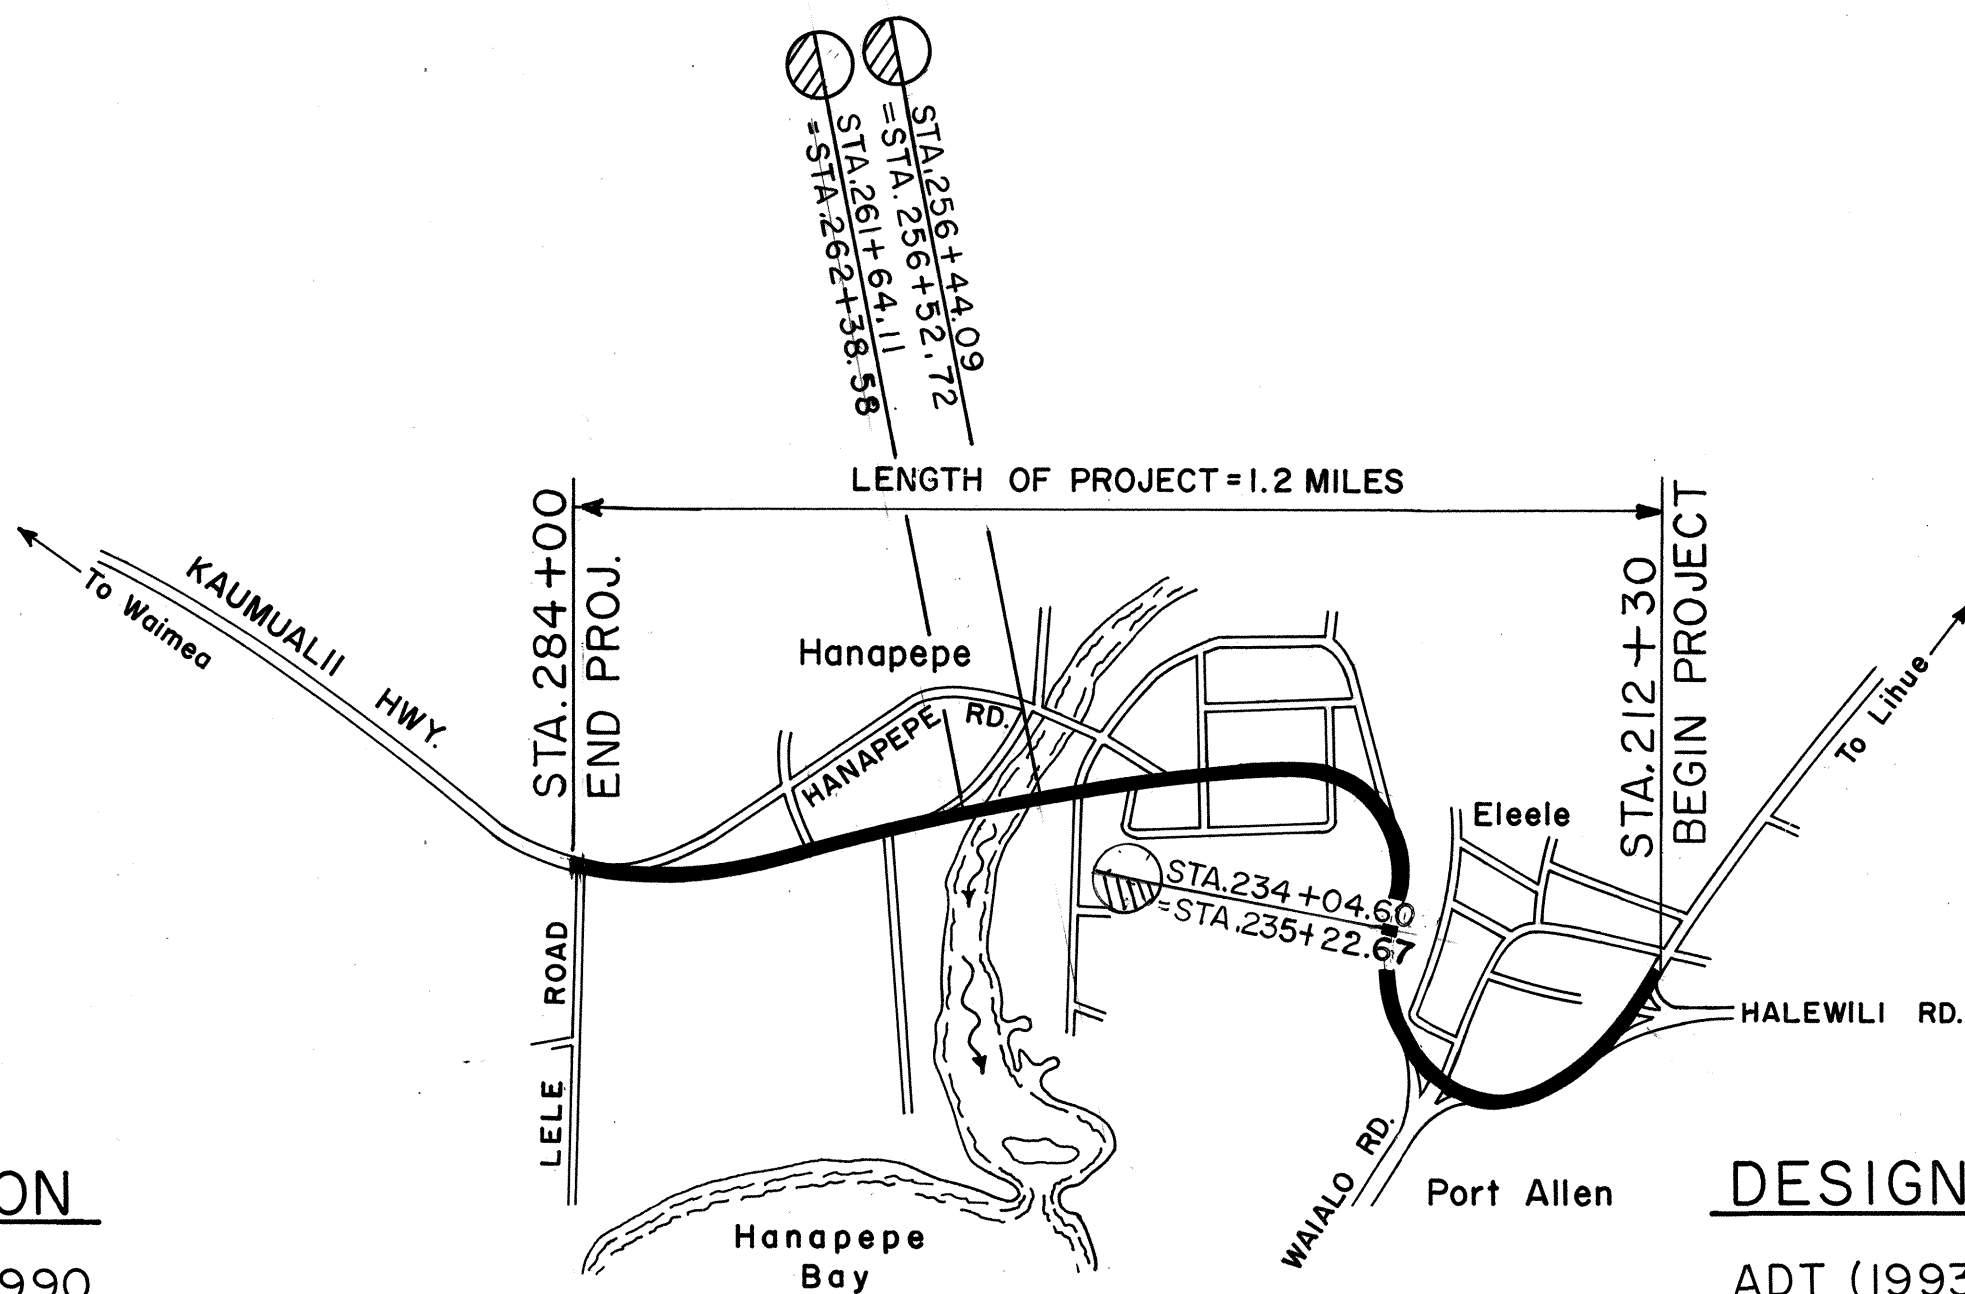



ELEELE TO LELE ROAD SECTION

LOCATION OF PROJECT

Scale: 1" = 500'

DESIGN	DESIGNATION
ADT (1993)	13,130
ADT (2003)	16,620
DHV	1,410
D	55/45
T	3.0%
T24	4.5%
V	35 MPH

FED. ROAD DIST. NO.	STATE	FED. AID PROJ. NO.	FISCAL YEAR	SHEET NO.	TOTAL SHEETS
HAWAII	HAW.	STP-050-1(10)	1993	1	12

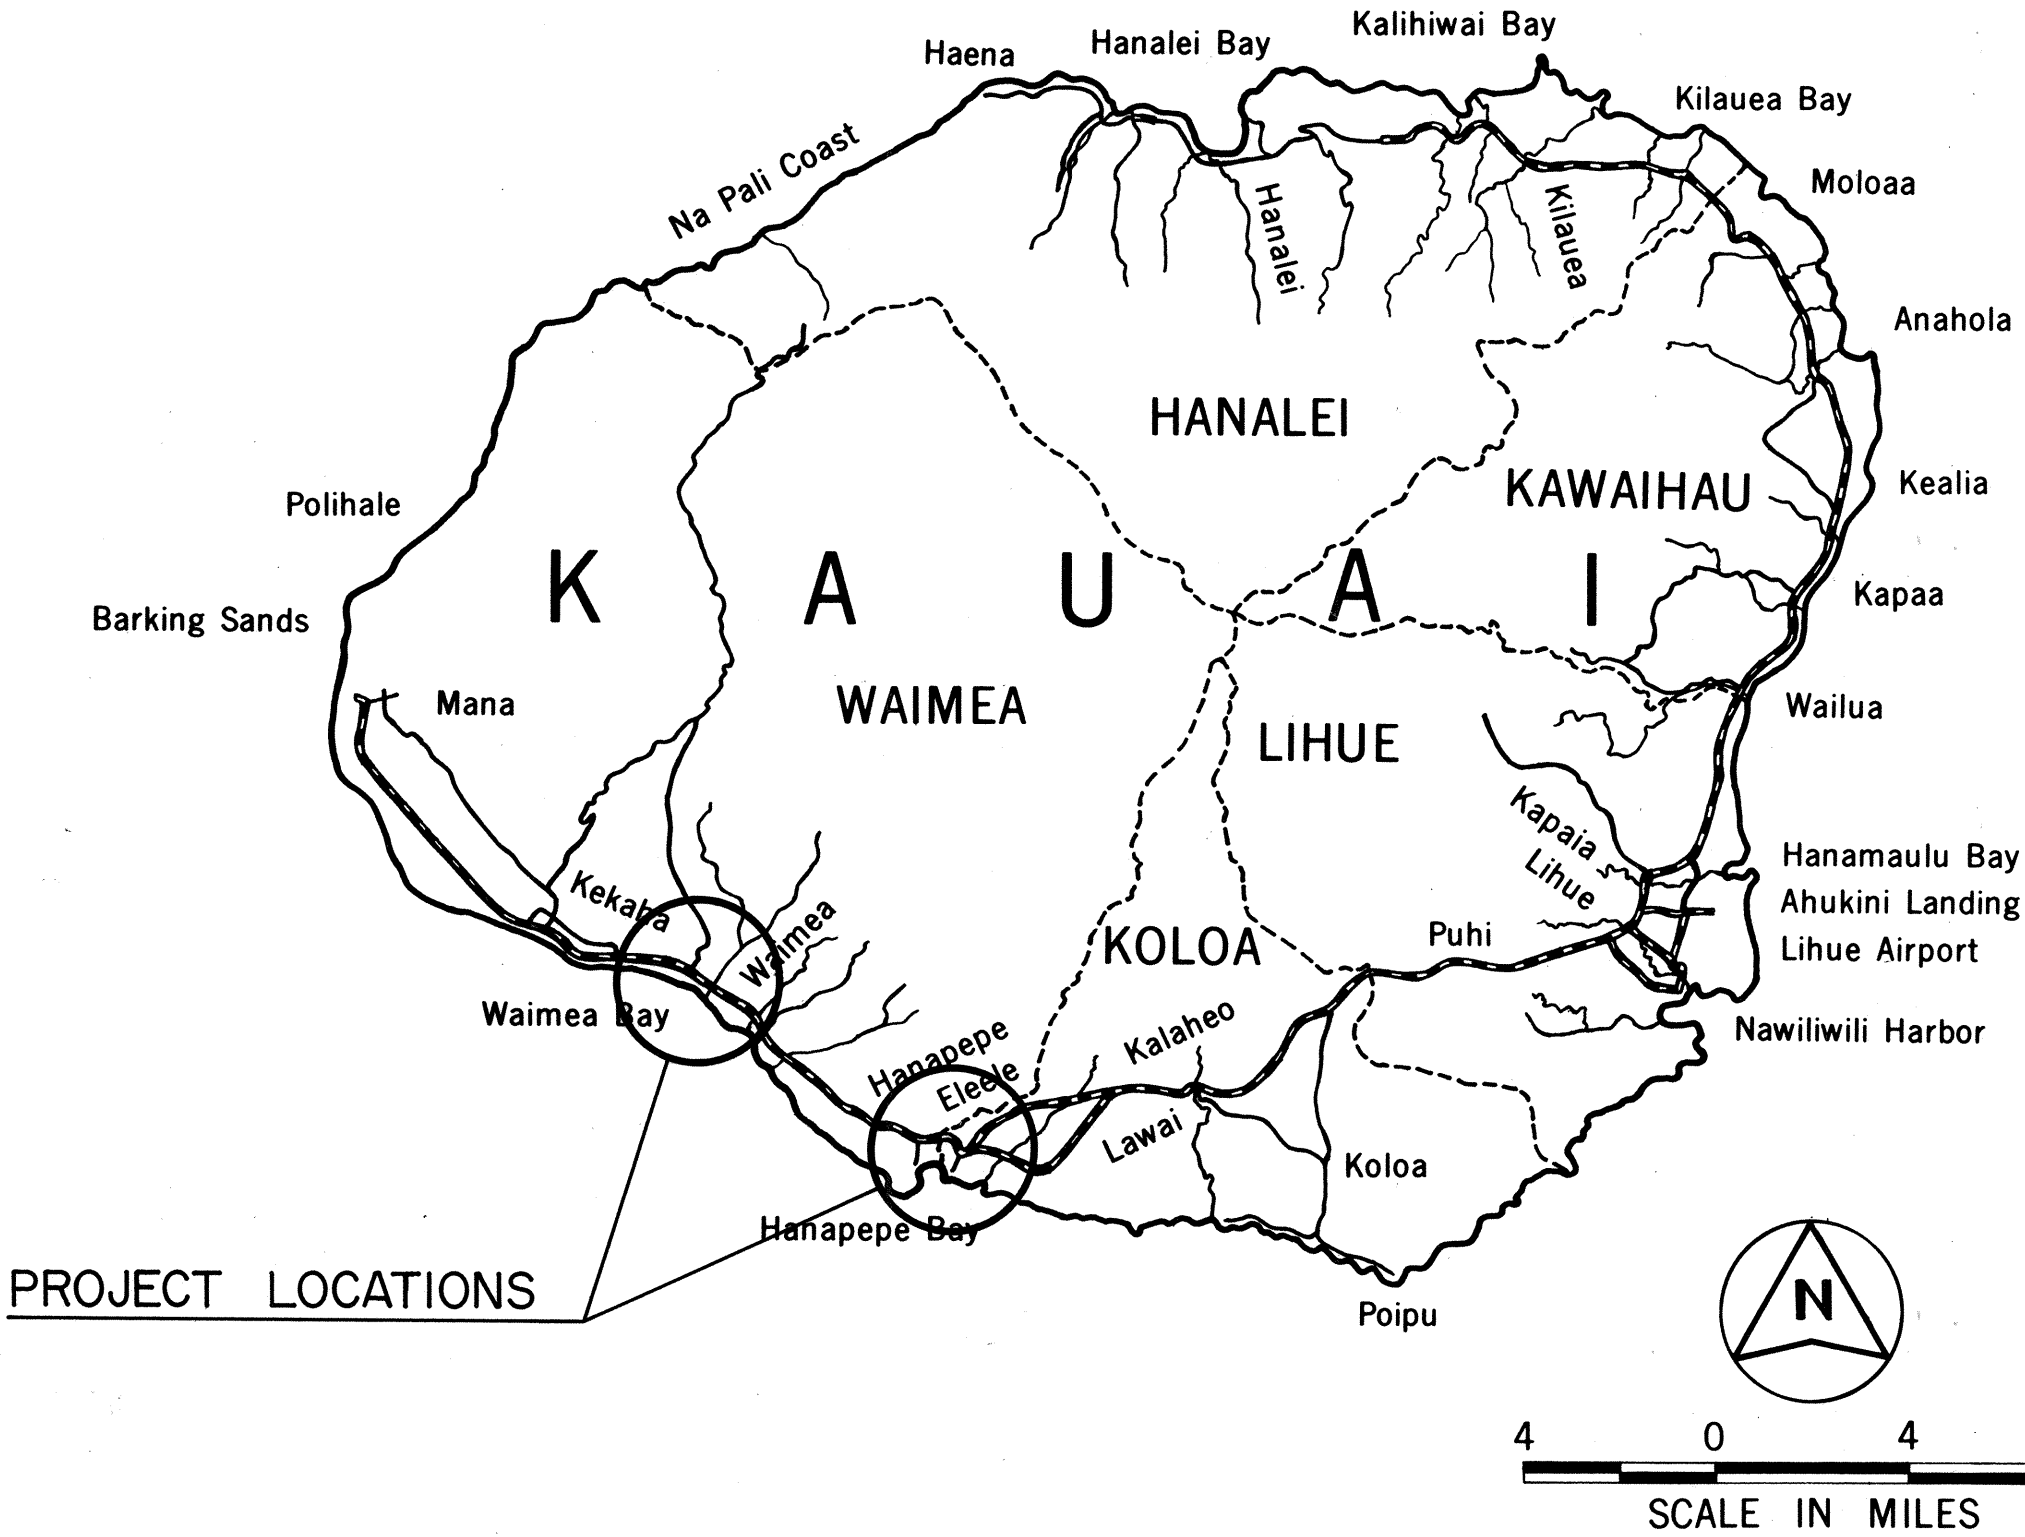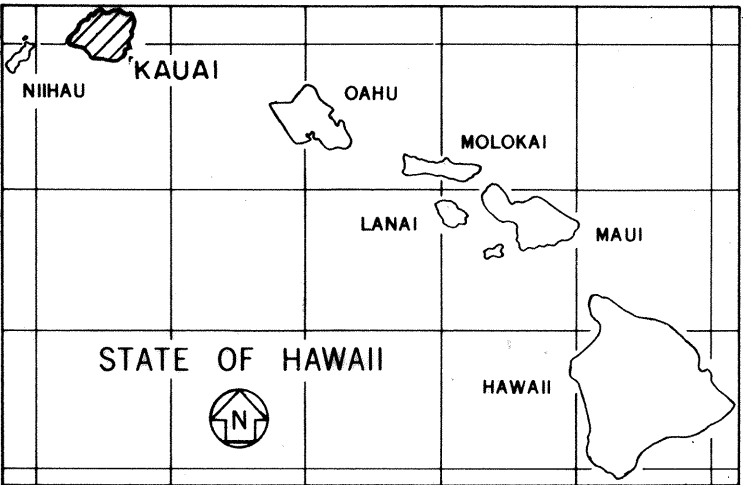

FEDERAL AID PROJECTS PREVIOUSLY CONSTRUCTED OR UNDER CONSTRUCTION

MILE POST 22.5 TO MILE POST 23.2
AND
MILE POST 15.8 TO MILE POST 17.0

CHANGES MADE DURING CONSTRUCTION HAVE BEEN INCORPORATED ON THESE PLANS EXCEPT CHANGES IN THE ORIGINAL THEORETICAL QUANTITIES. FOR ACTUAL QUANTITIES, REFER TO PROJECT LEDGER AND/OR COMPUTATION BOOK.

Donny H. Mada
RESIDENT ENGINEER

12/20/94
DATE

DEPARTMENT OF TRANSPORTATION STATE OF HAWAII	
APPROVED:	
<i>A. Harano</i>	5/20/93
DIR. OF TRANSPORTATION	DATE