
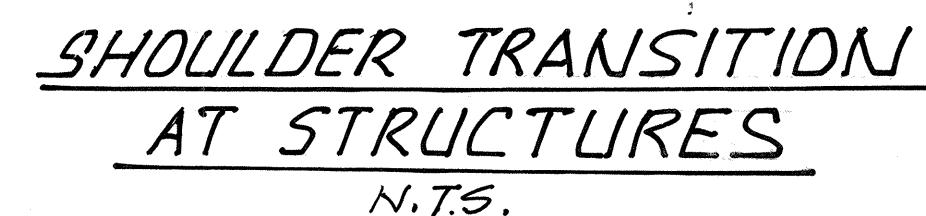
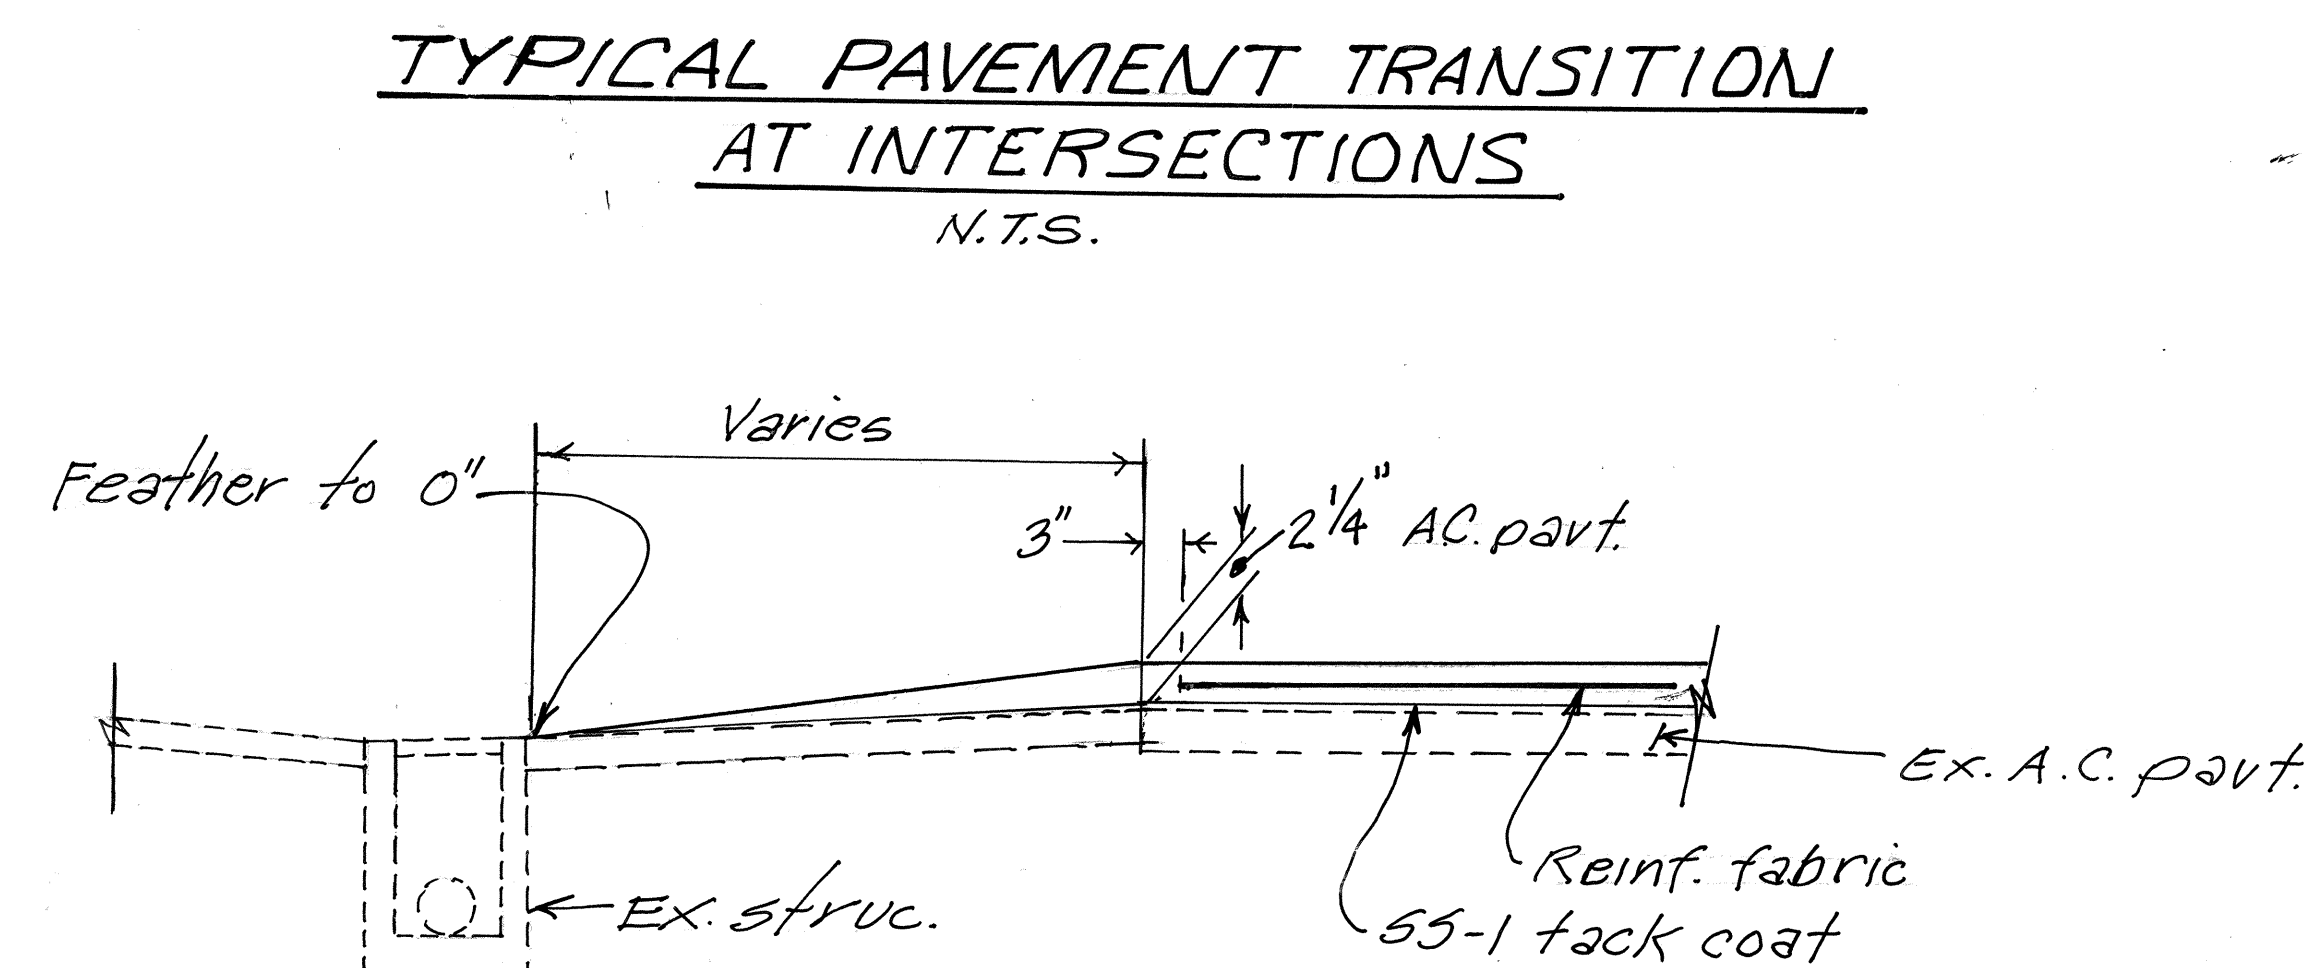
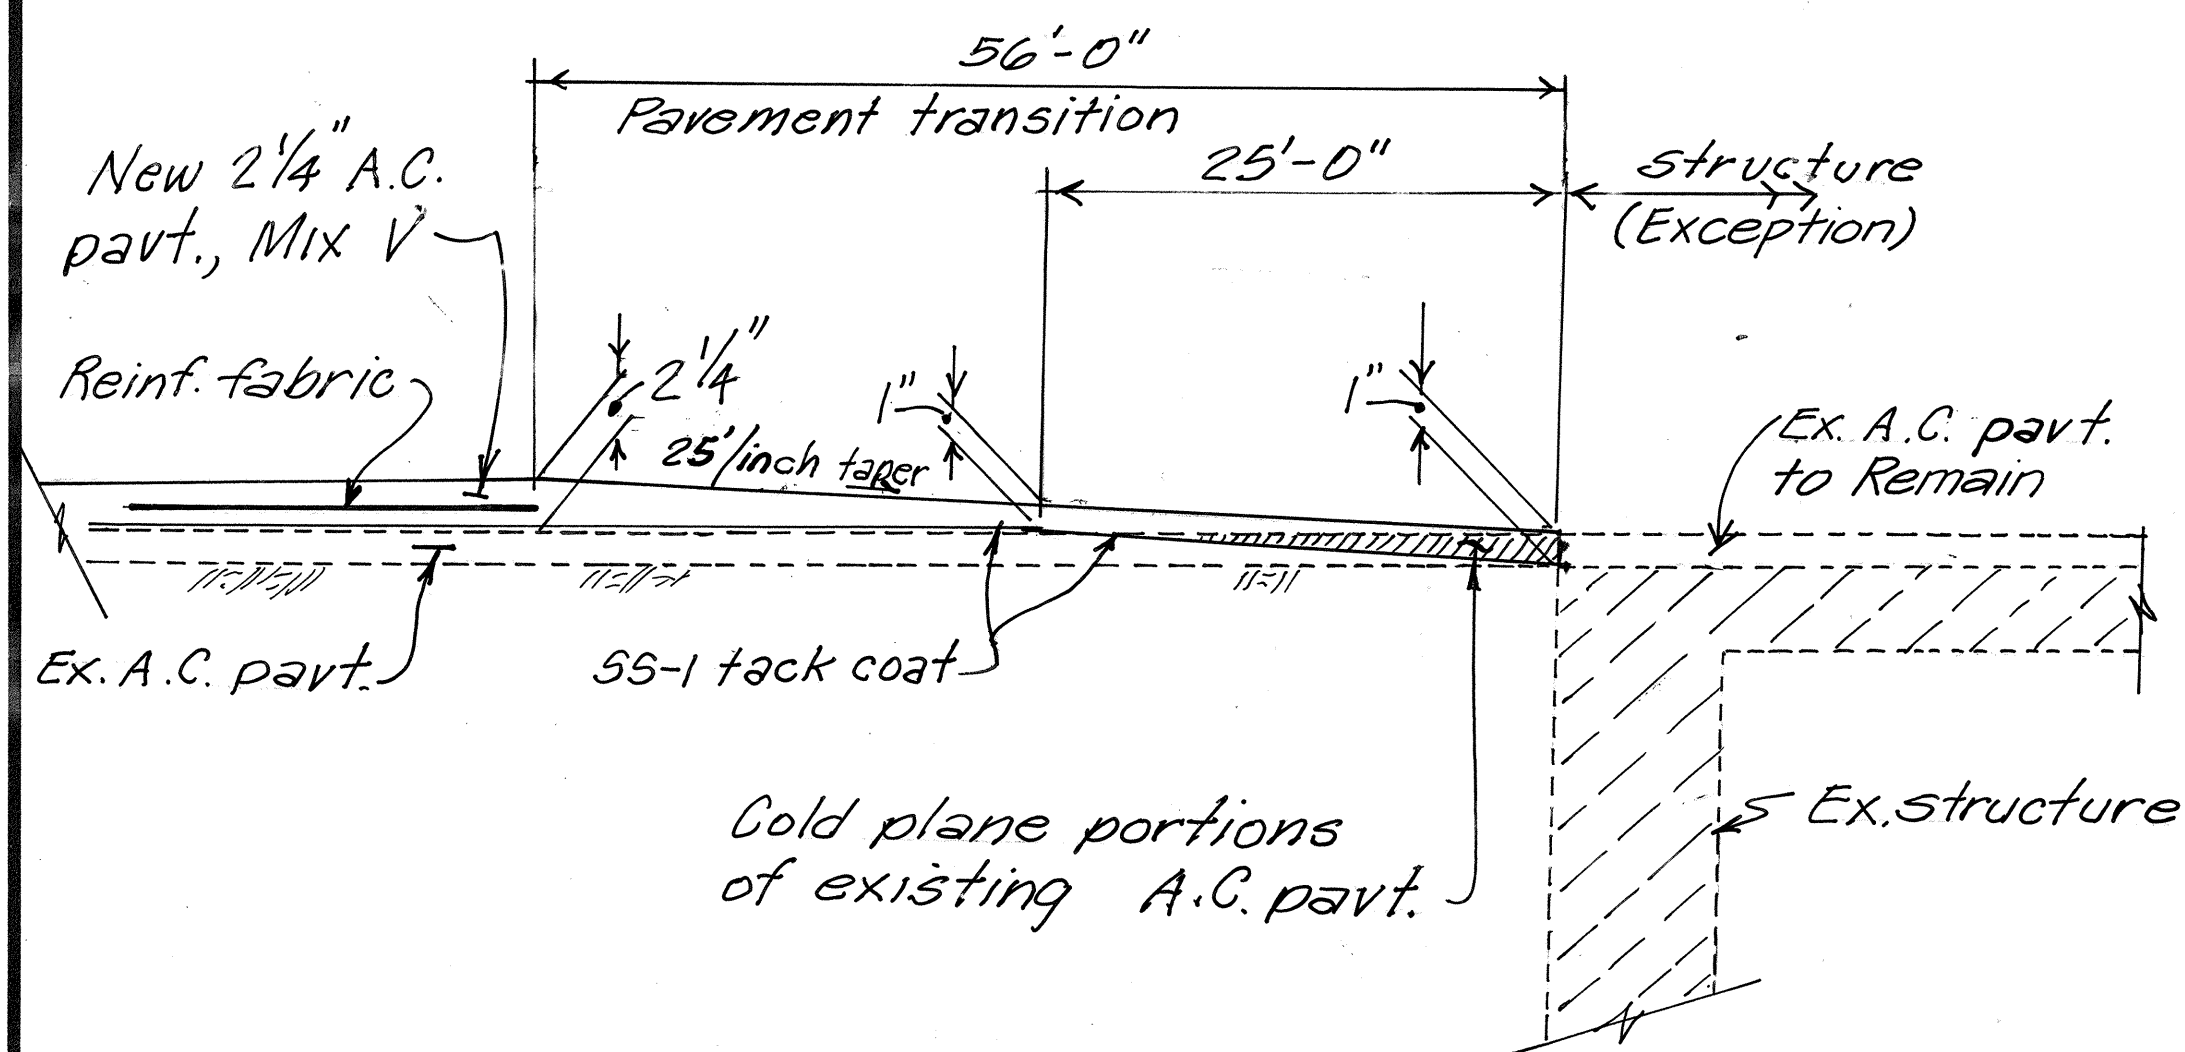
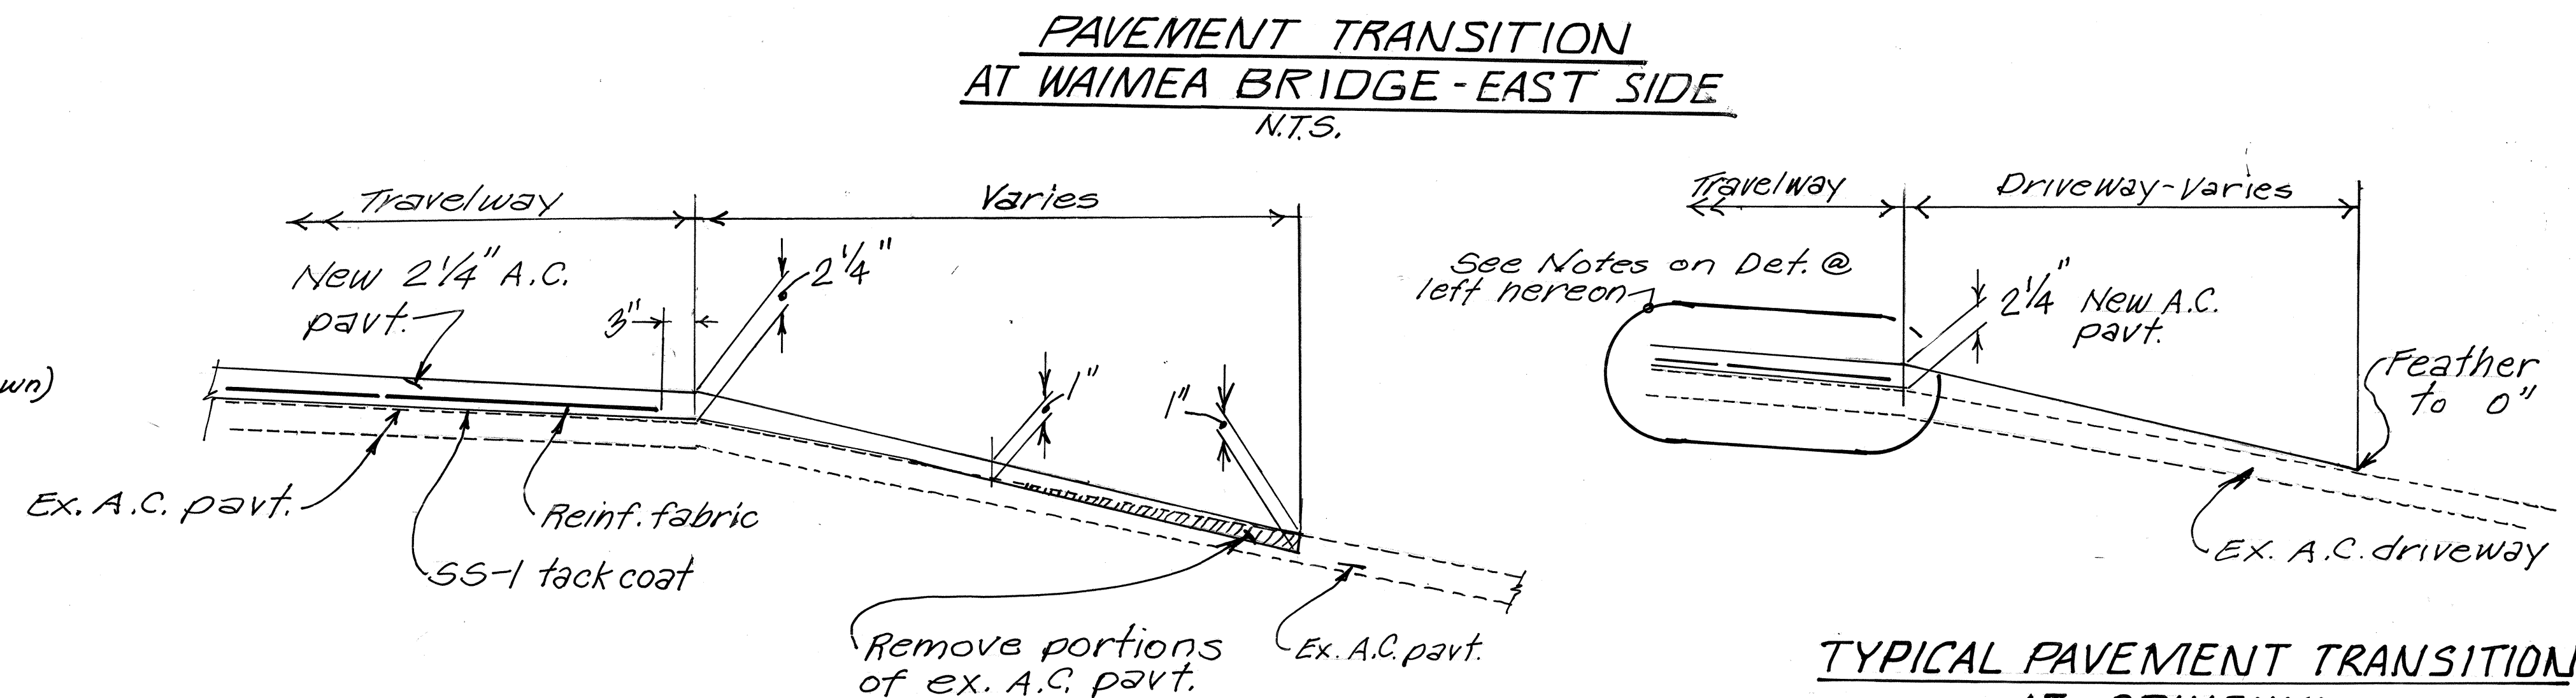
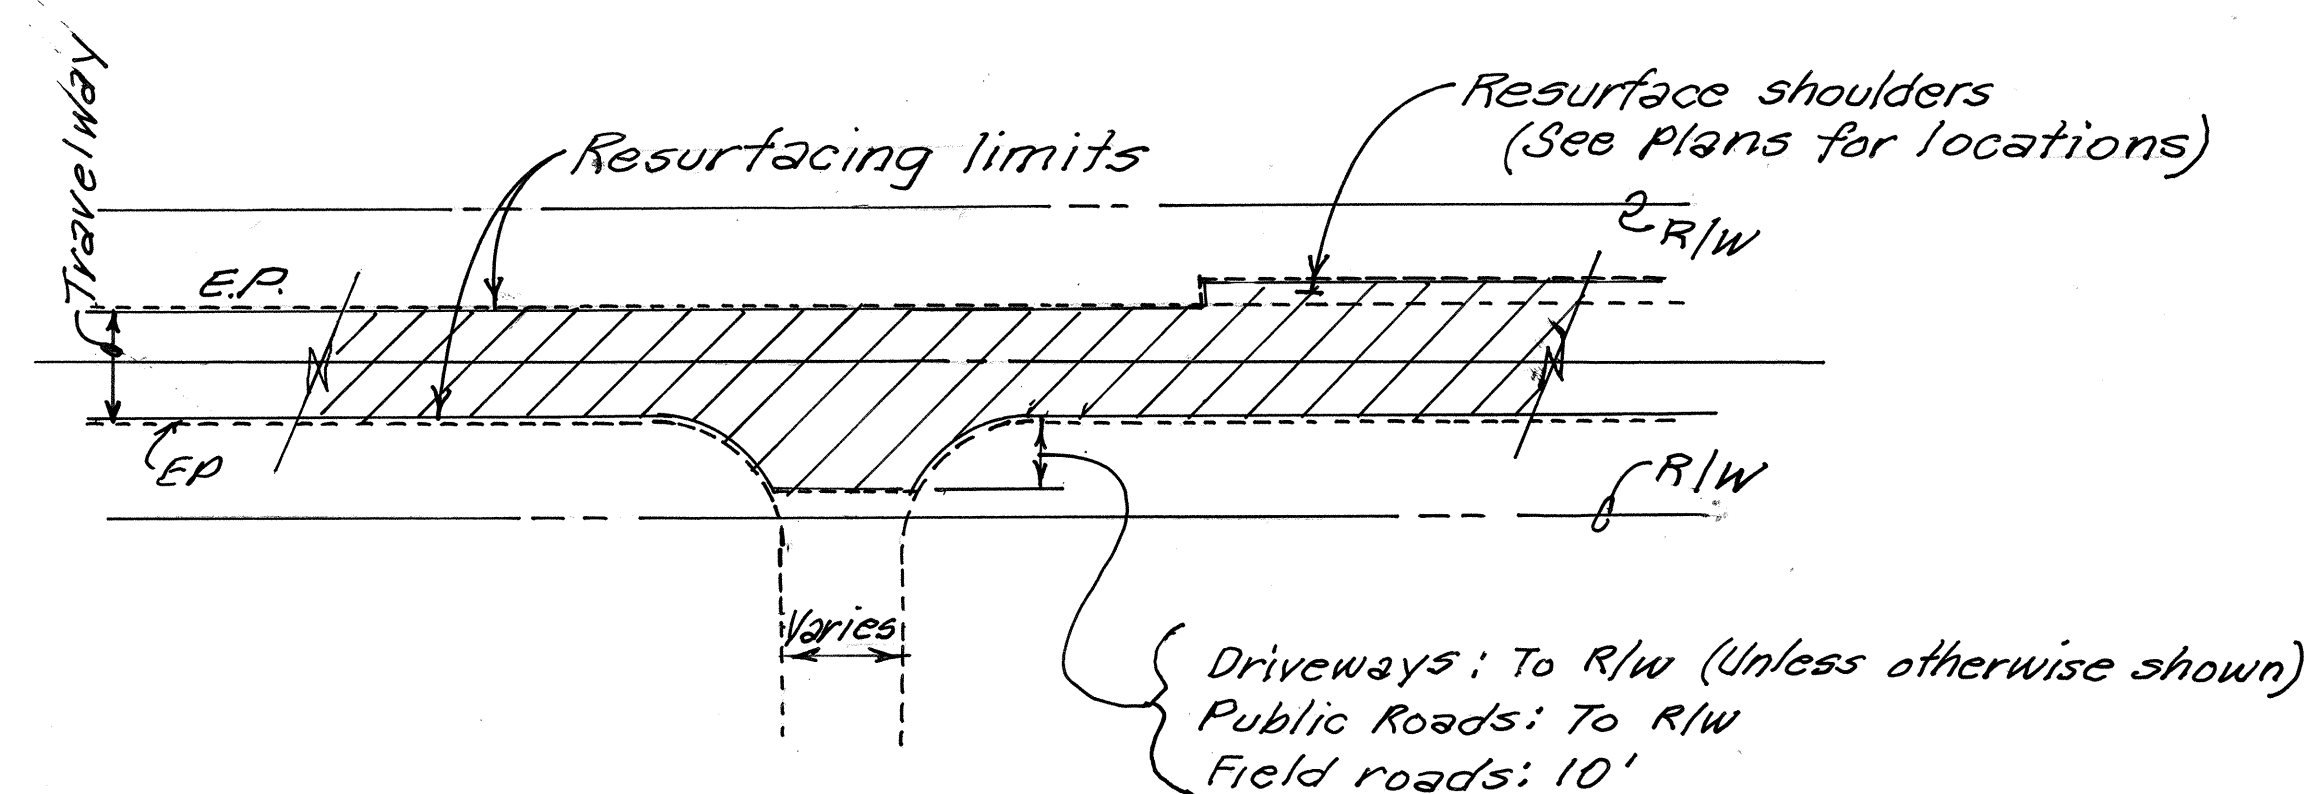
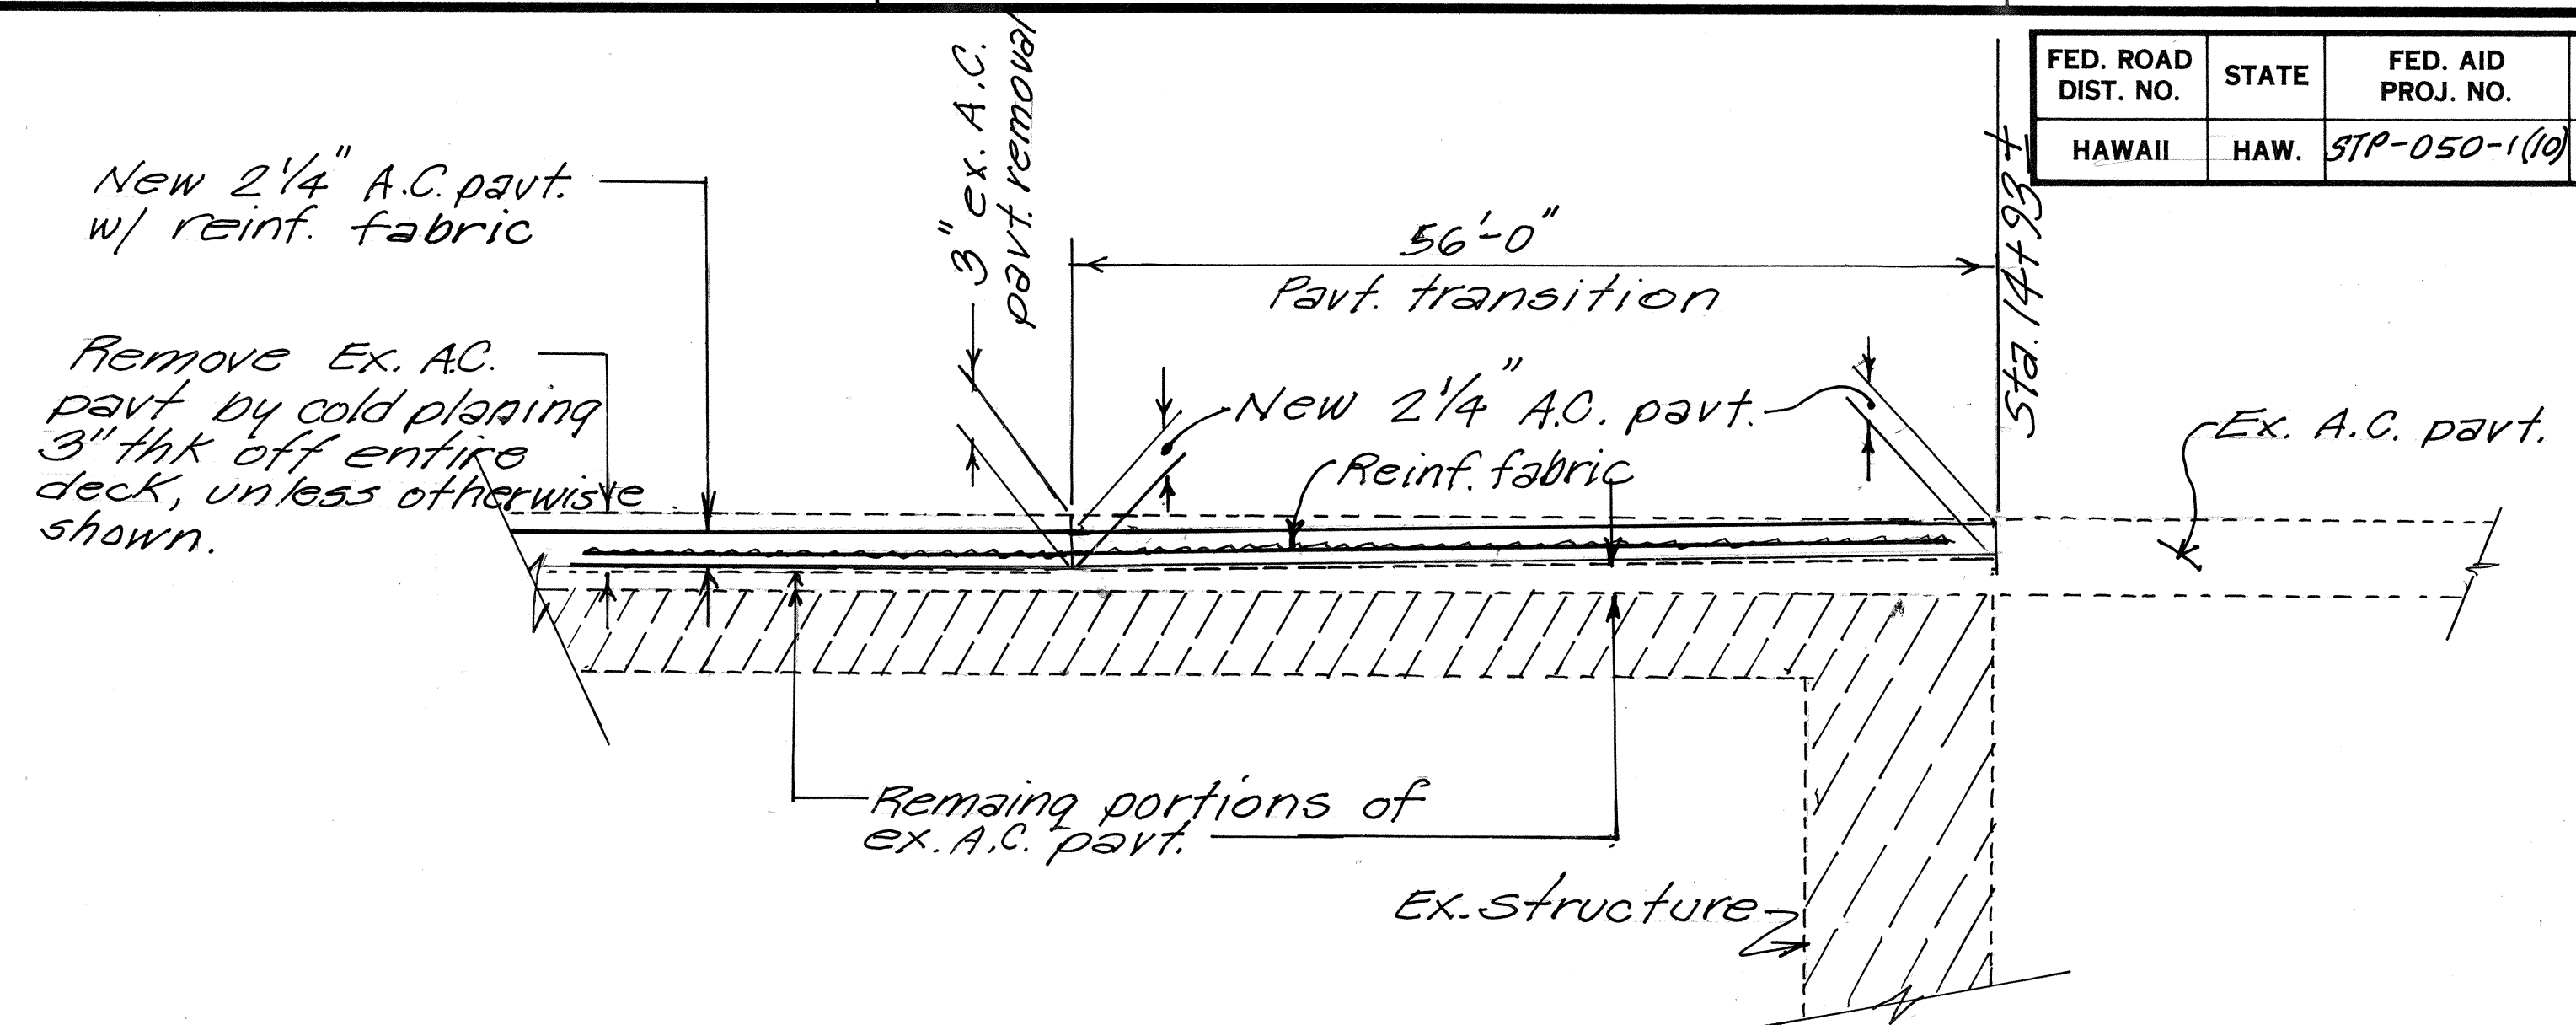


FED. ROAD DIST. NO.	STATE	FED. AID PROJ. NO.	FISCAL YEAR	SHEET NO.	TOTAL SHEETS
HAWAII	HAW.	STP-050-1(10)	1993	6	12

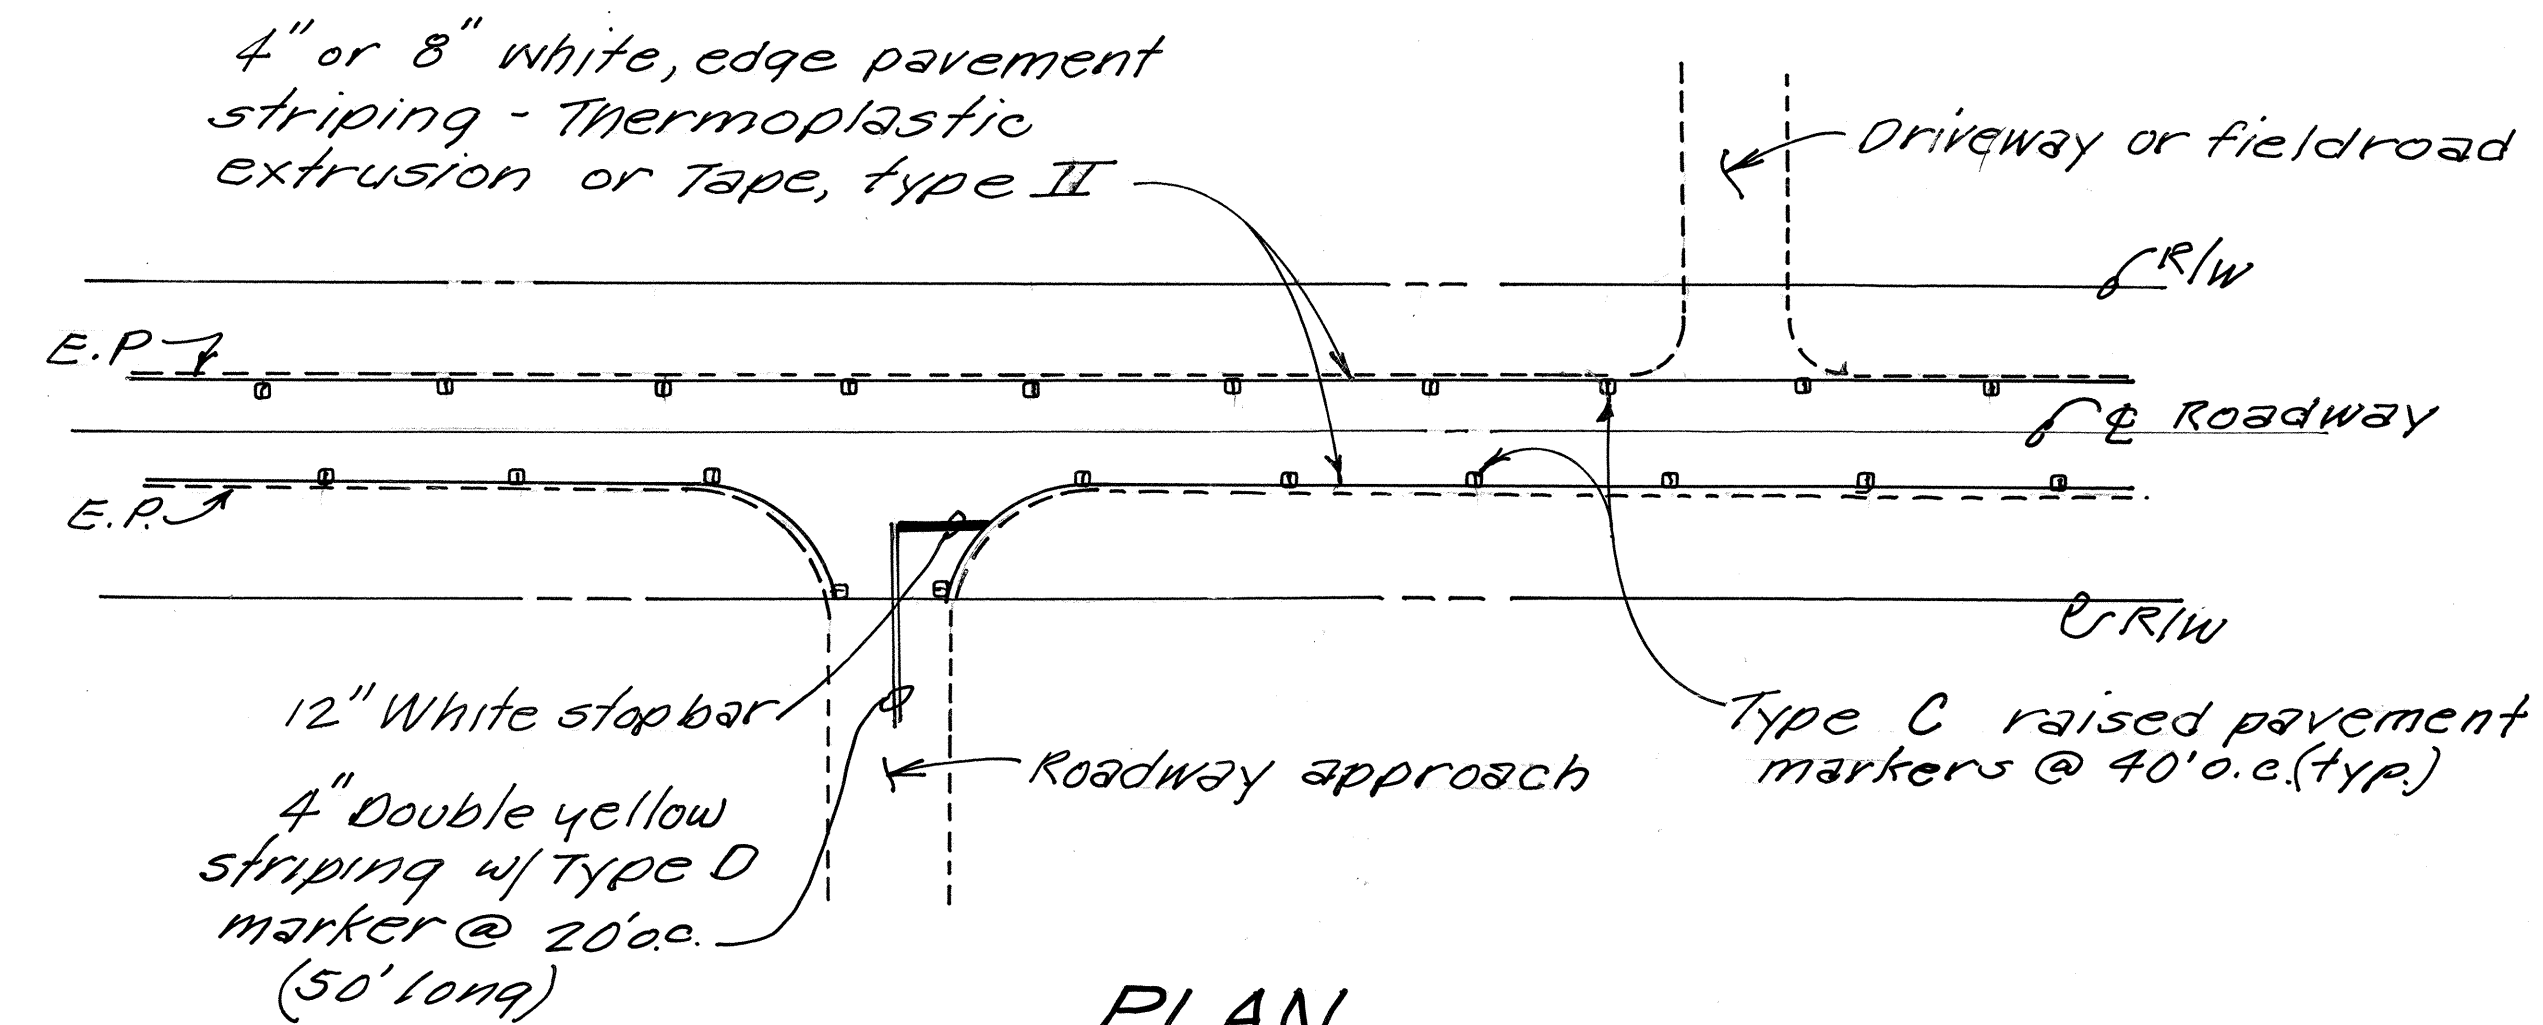

STATE OF HAWAII
DEPARTMENT OF TRANSPORTATION
HIGHWAYS DIVISION

TYPICAL PLANS, SECTIONS, &
DETAILS

Kaunualii Highway Resurfacing
Waimea Canyon Drive to Waimea Bridge
& Eleele to Lele Road
Federal Aid Project No. STP-050-1(10)

Scale: N.T.S. May 1943

SHEET No. 3 OF 3 SHEETS

ORIGINAL PLAN	SURVEY PLOTTED BY _____ DATE _____
NOTE BOOK	DRAWN BY _____ *
	TRACED BY _____ *
	DESIGNED BY _____ *
	QUANTITIES BY _____ *
No. _____	CHECKED BY _____