


INDEX TO DRAWINGS	
SHEET NO.	DESCRIPTION
1	TITLE SHEET
2	STANDARD PLANS SUMMARY
3	GENERAL NOTES AND LEGENDS
4	PAVEMENT MARKING LEGEND, DETAILS AND NOTES
5 - 6	WATER POLLUTION AND EROSION CONTROL NOTES
7 - 10	PAVEMENT MARKING PLAN
11 - 12	CRACK AND JOINT SEALING LOCATION

FED. ROAD DIST. NO.	STATE	PROJ. NO.	FISCAL YEAR	SHEET NO.	TOTAL SHEETS
HAWAII	HAW.	50AB-01-08M	2008	1	12

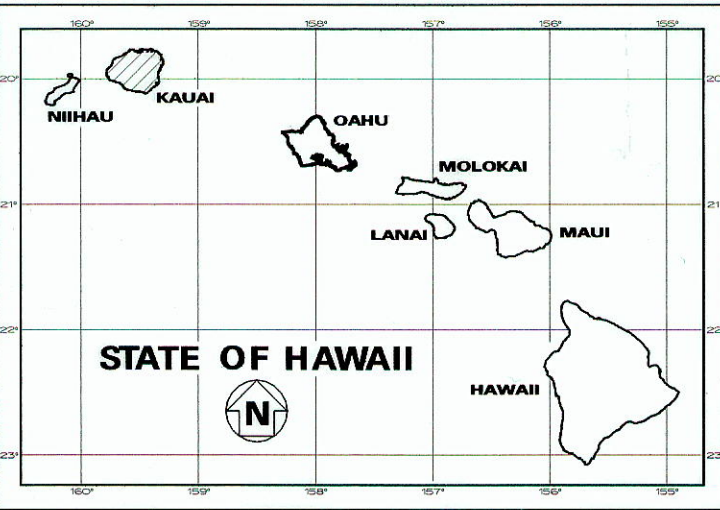

STATE OF HAWAII

DEPARTMENT OF TRANSPORTATION

HIGHWAYS DIVISION

HONOLULU, HAWAII

"AS-BUILT"

PLANS FOR




KAUMUALII HIGHWAY PAVEMENT MARKING

VICINITIES OF LELE ROAD AND KEKAHA LANDFILL

PROJECT NO. 50AB-01-08M

DISTRICT OF WAIMEA

ISLAND OF KAUAI

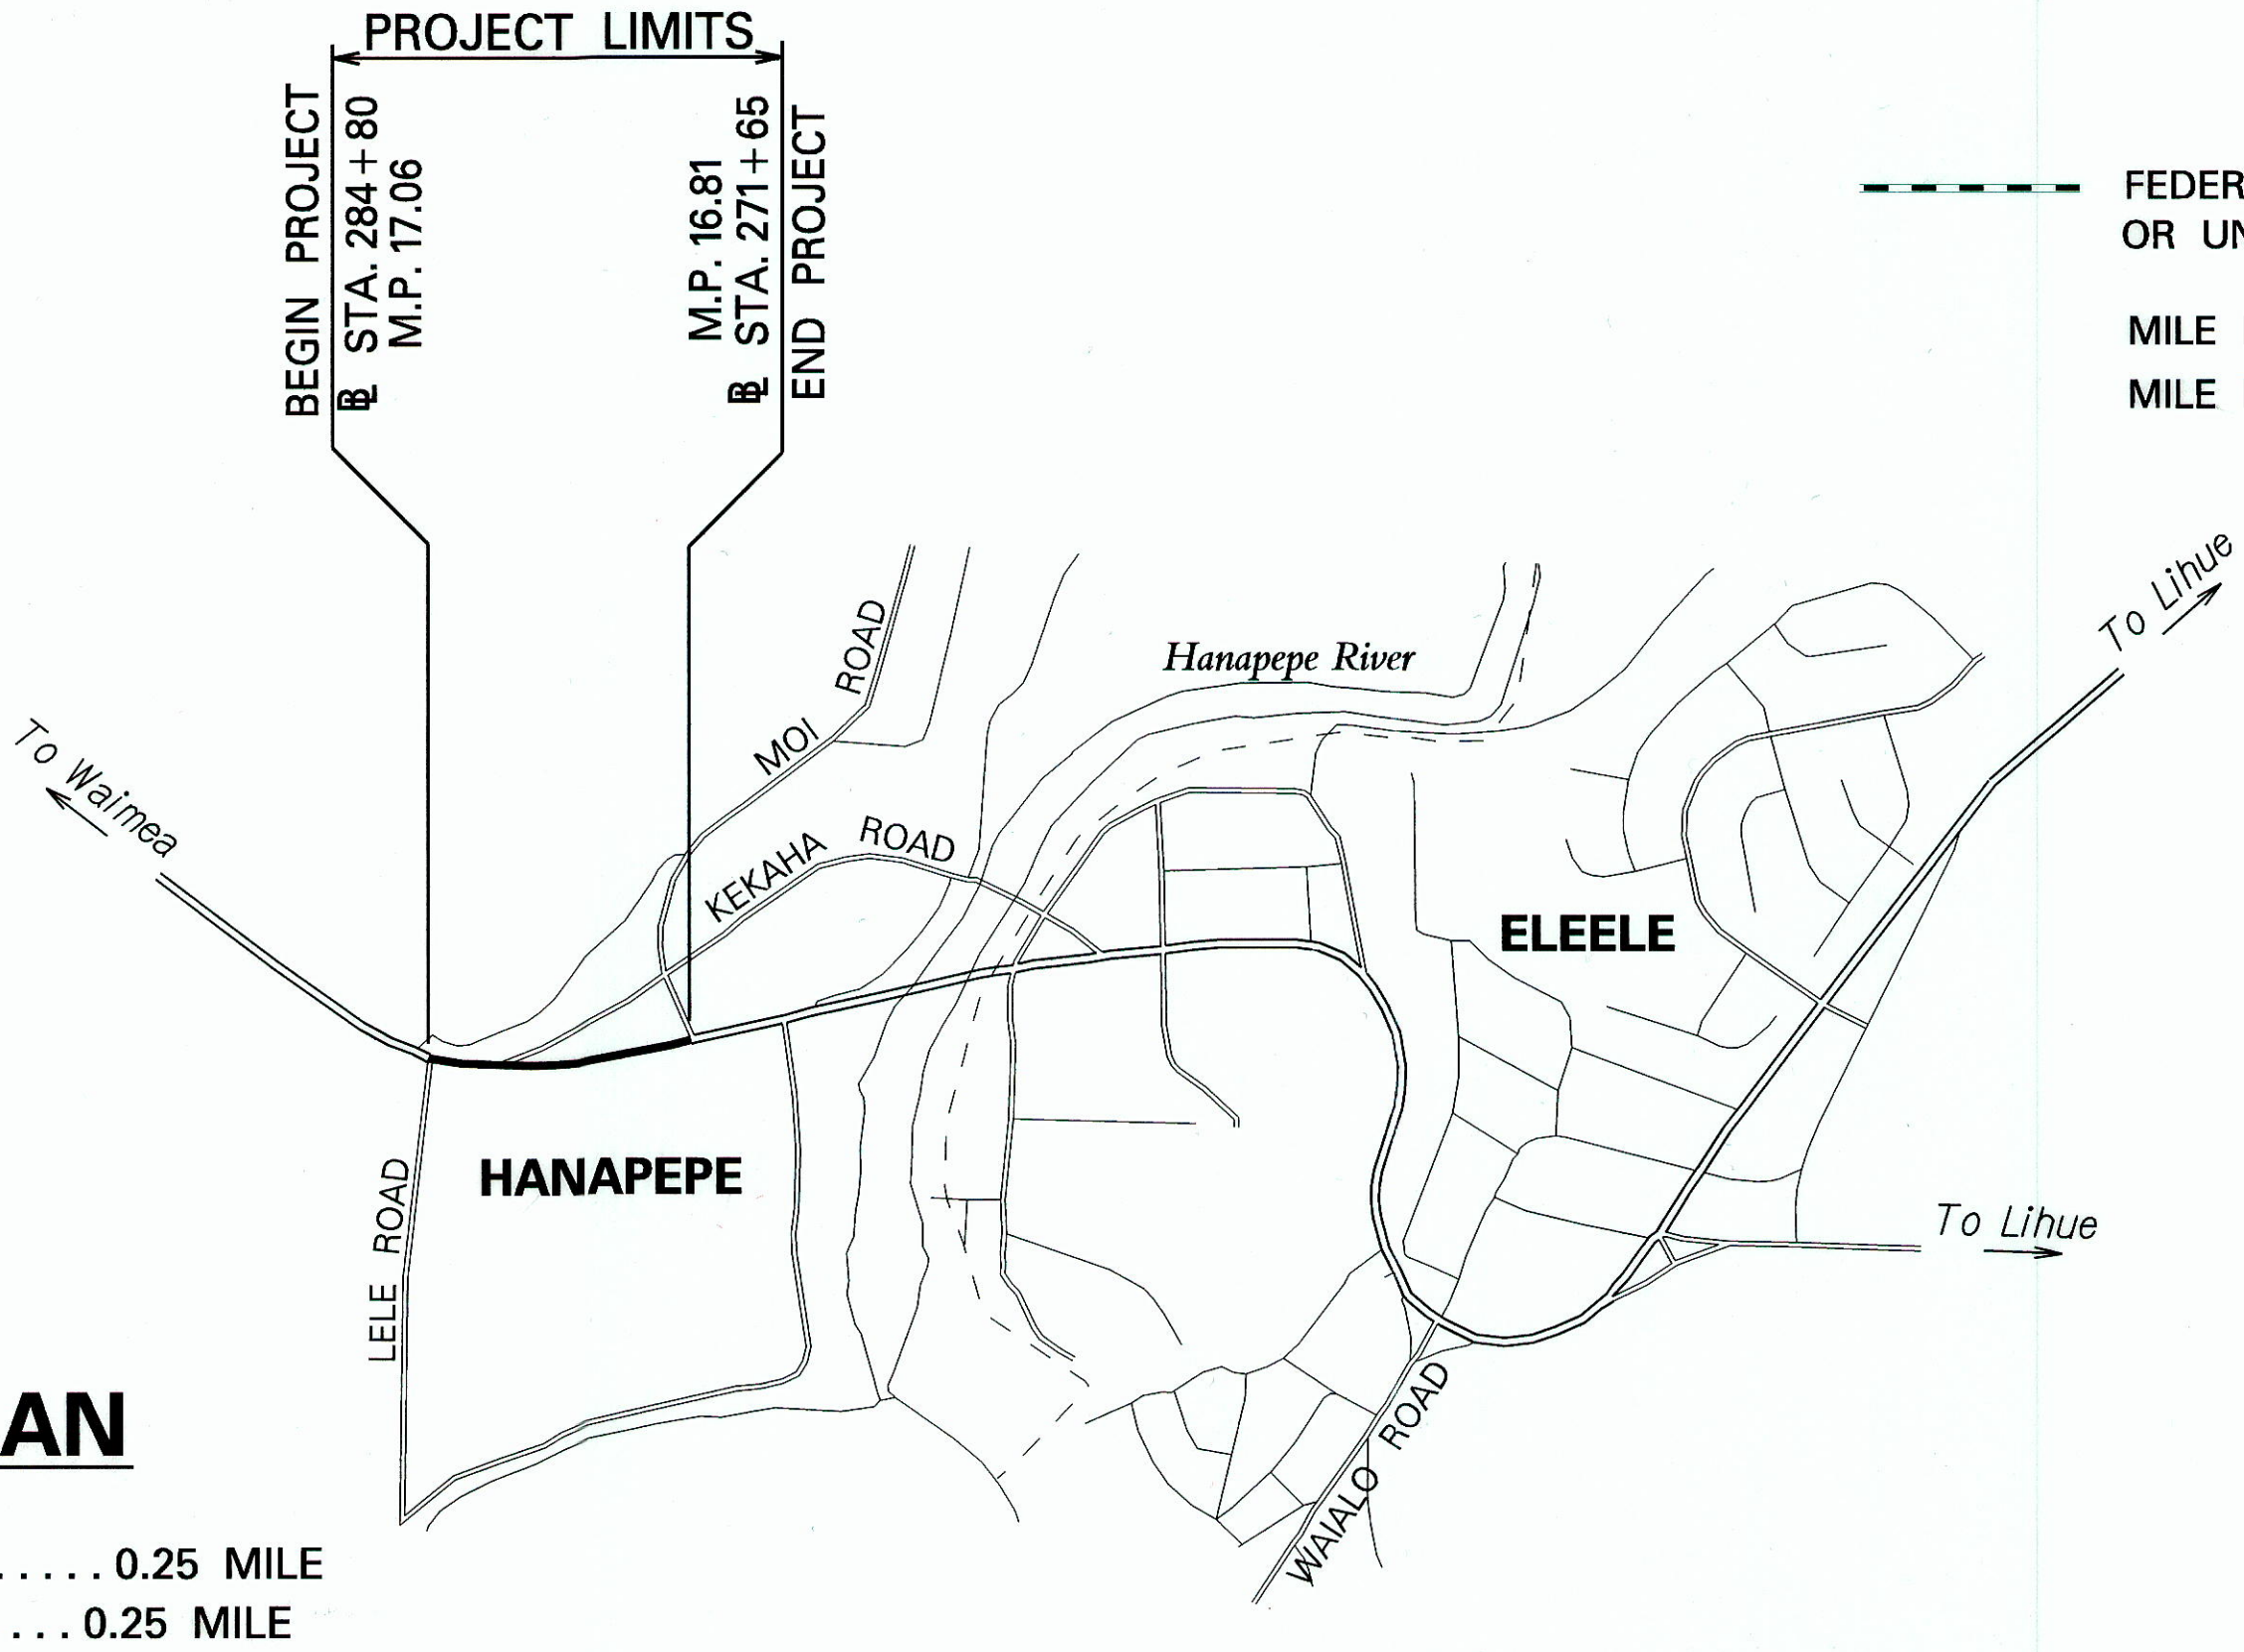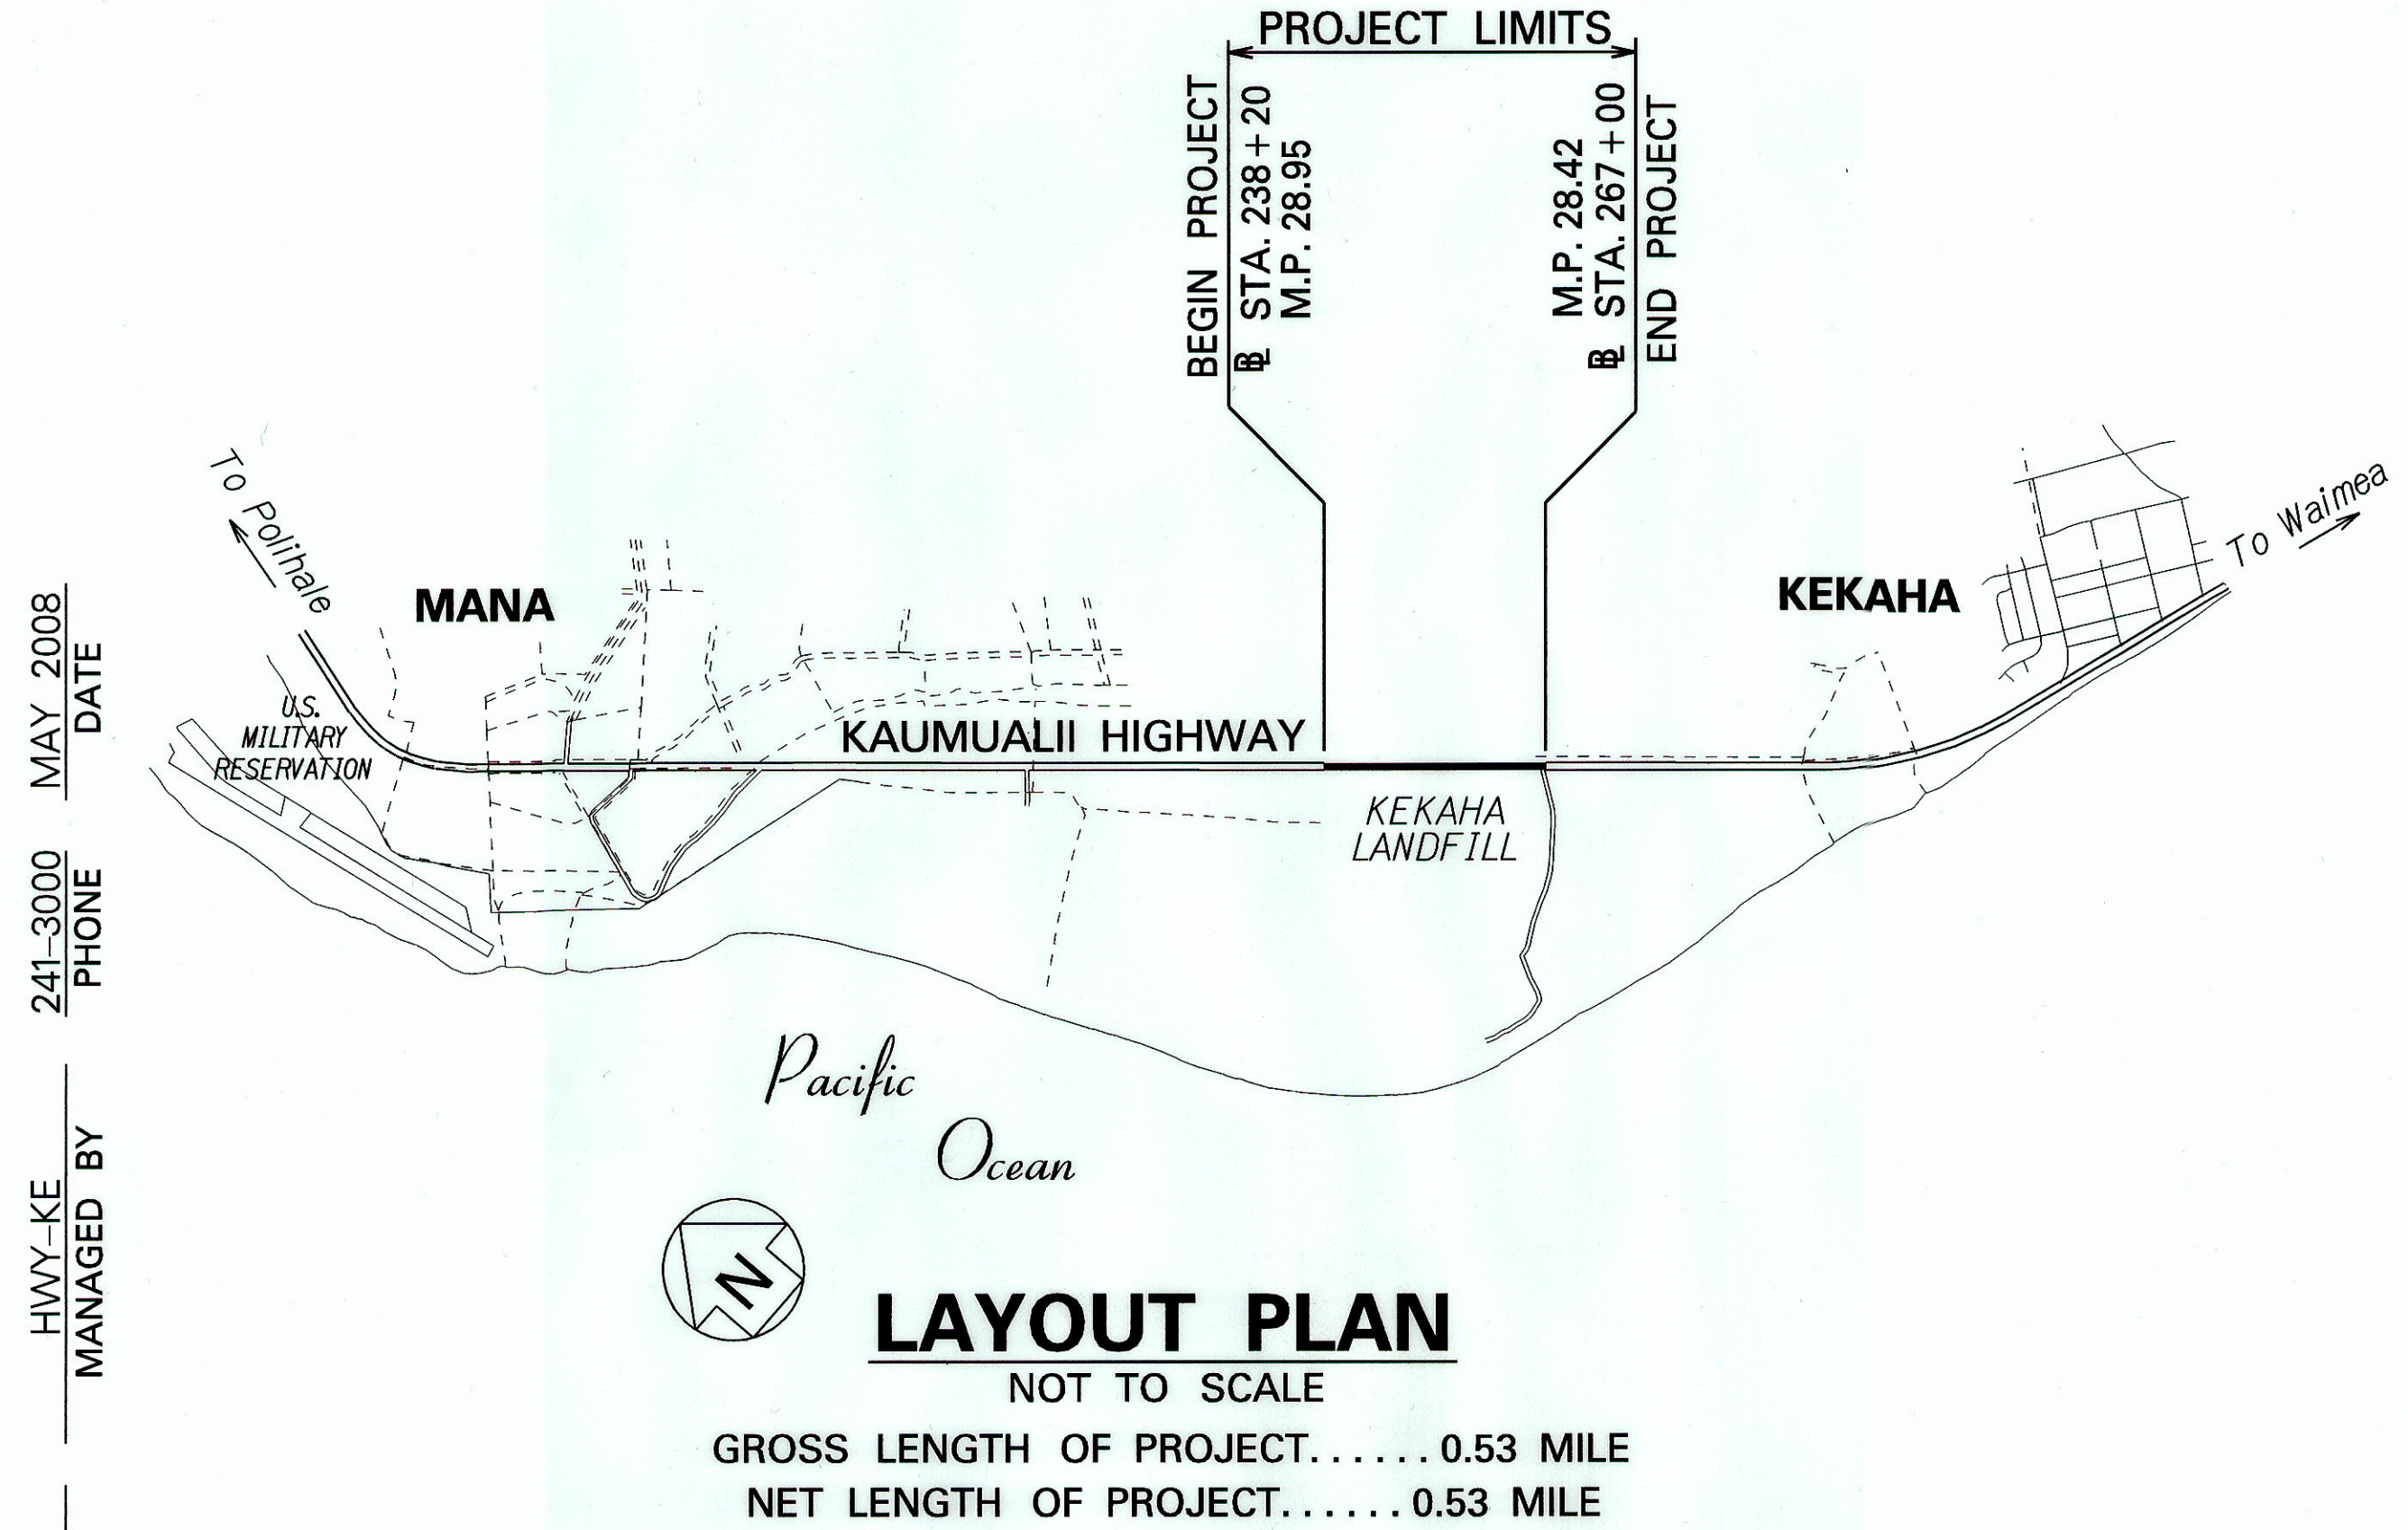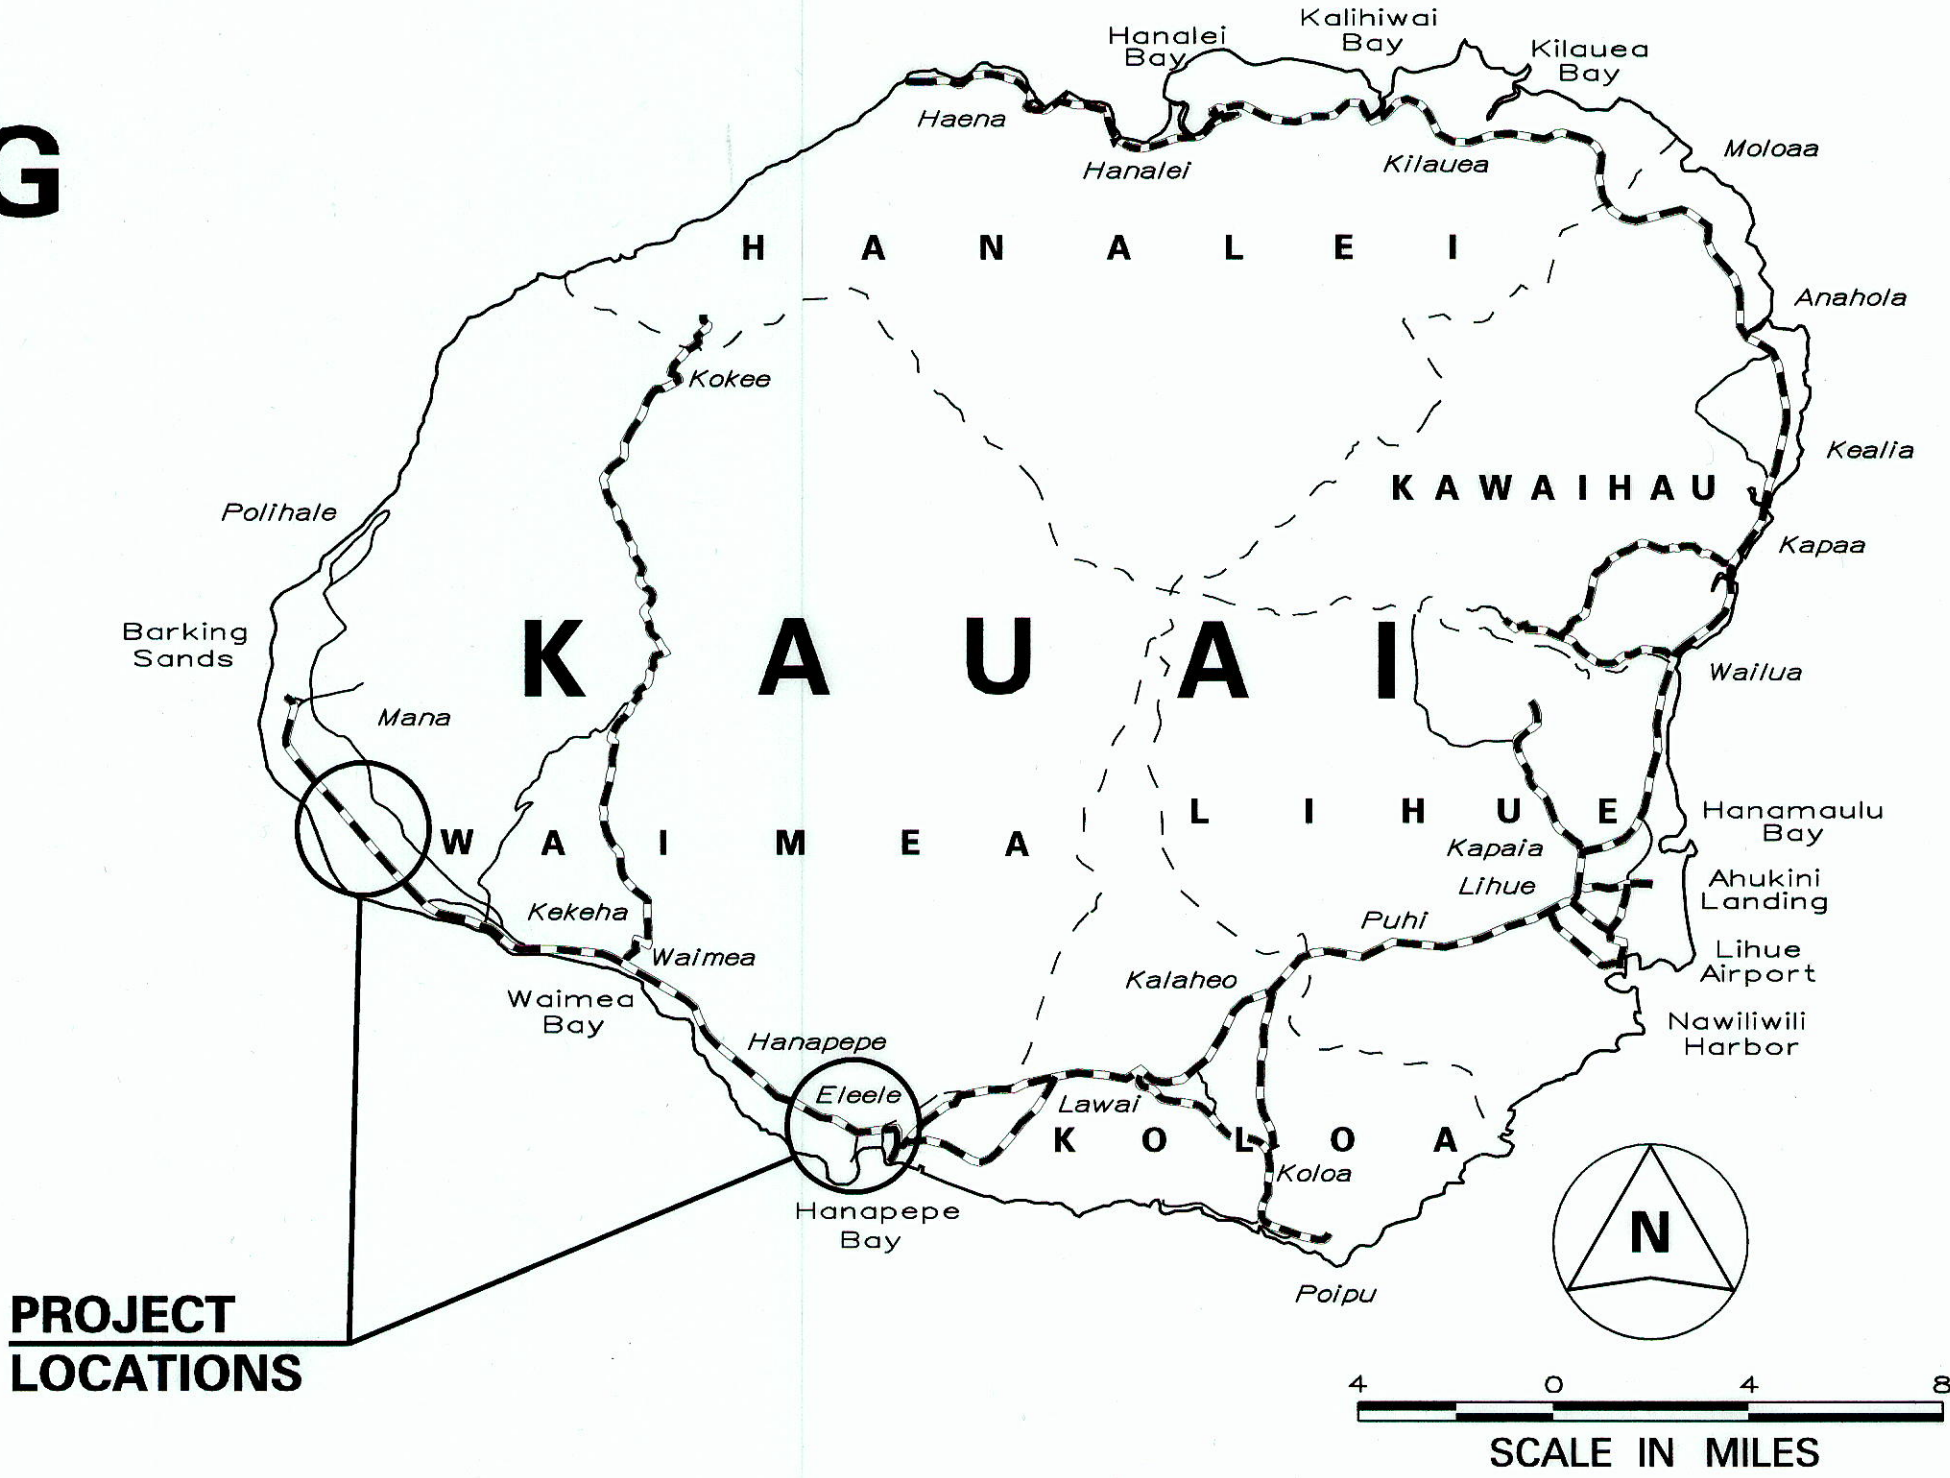

FEDERAL AID PROJECTS PREVIOUSLY CONSTRUCTED OR UNDER CONSTRUCTION

MILE POST 16.81 TO MILE POST 17.06

MILE POST 28.42 TO MILE POST 28.95

NO SIGNIFICANT CHANGES WERE MADE DURING CONSTRUCTION ON THESE PLANS EXCEPT CHANGES IN THE ORIGINAL THEORETICAL QUANTITIES FOR ACTUAL QUANTITIES. REFER TO PROJECT LOGS AND/OR CORRECTION BOOK.

2/10/15

DATE

DEPARTMENT OF TRANSPORTATION

STATE OF HAWAII

APPROVED:

5/6/08

DATE

DIR. OF TRANSPORTATION