



FED. ROAD DIST. NO.	STATE	PROJ. NO.	FISCAL YEAR	SHEET NO.	TOTAL SHEETS
HAWAII	HAW.	50C-01-18	2022	22	30

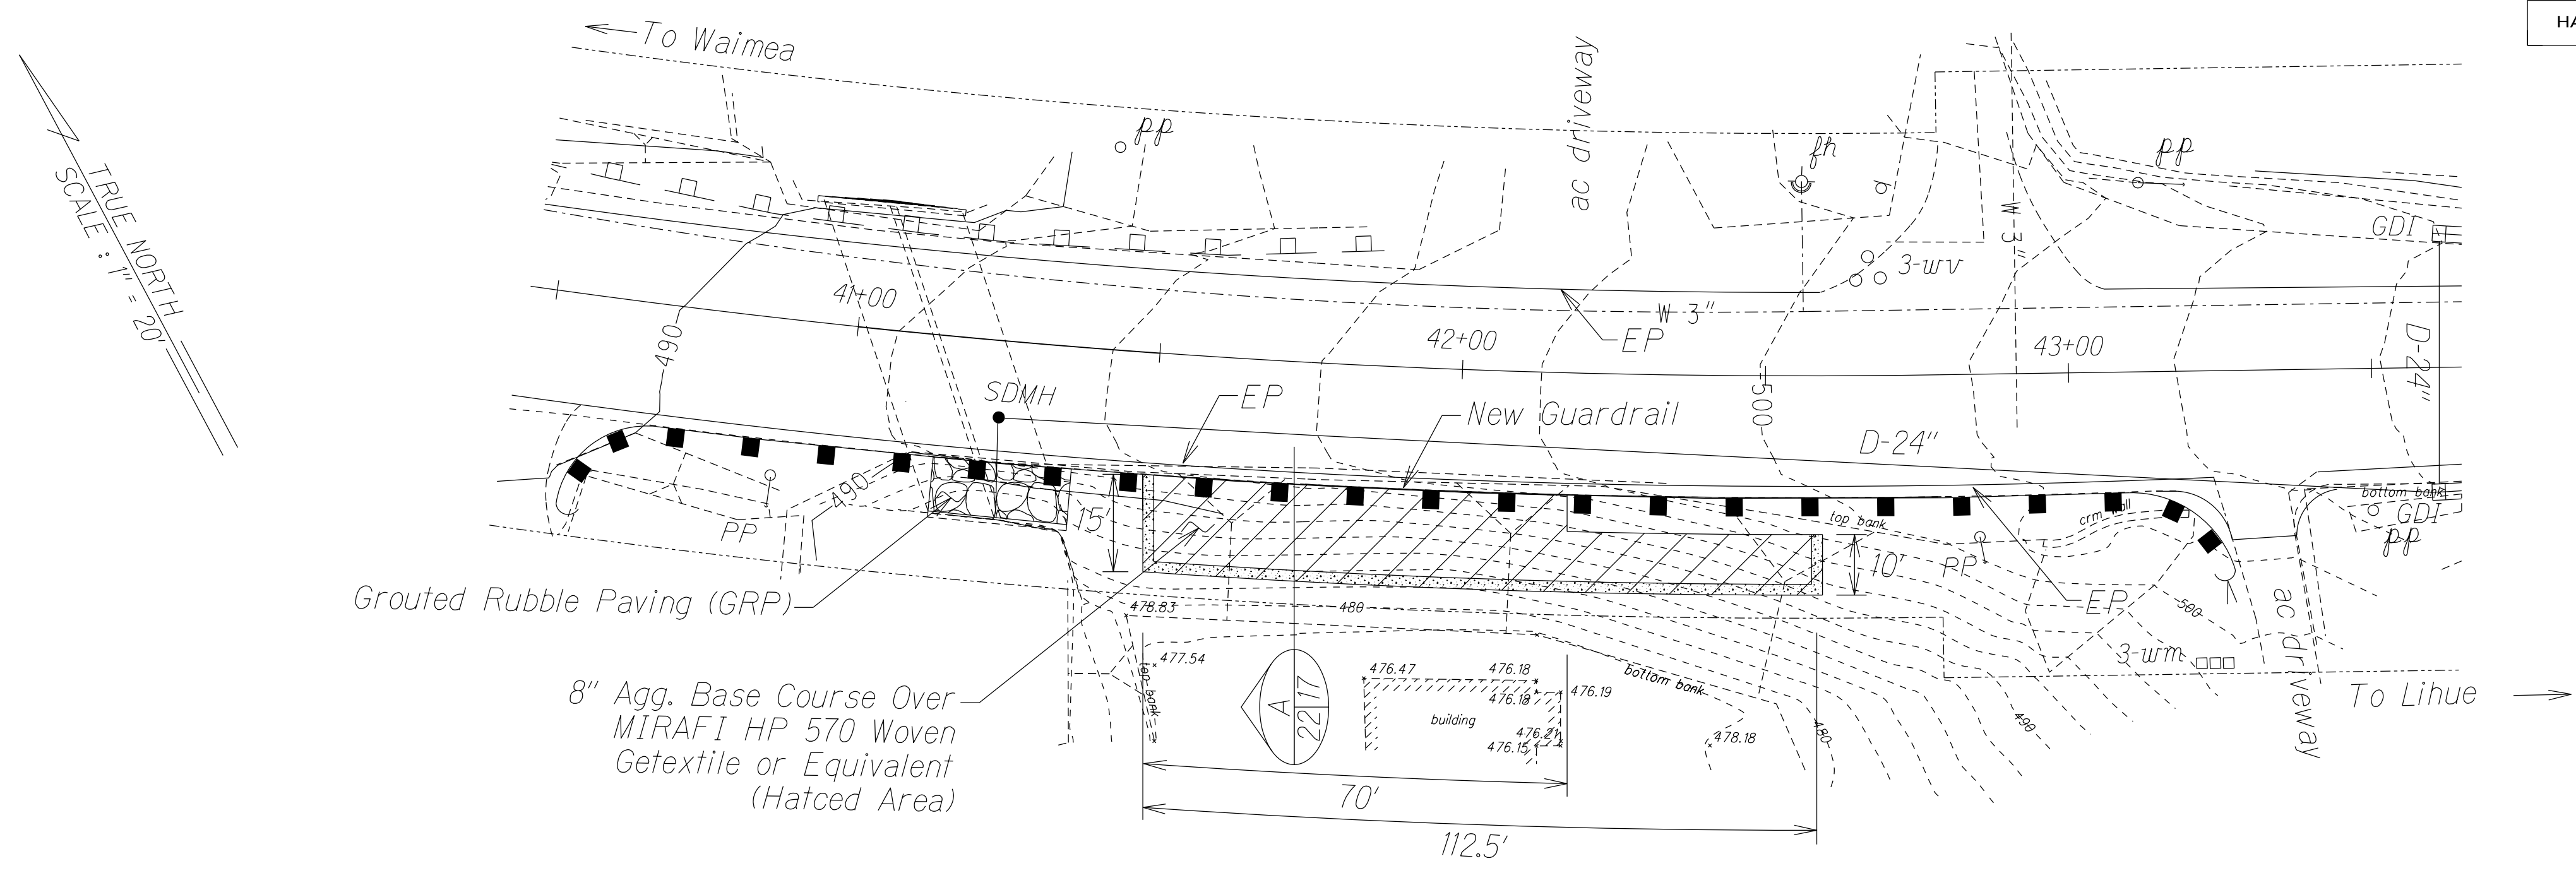

PLAN - RETAINING WALL NO. 2 AND PIPE CULVERT OUTLET
Scale 1" = 20'

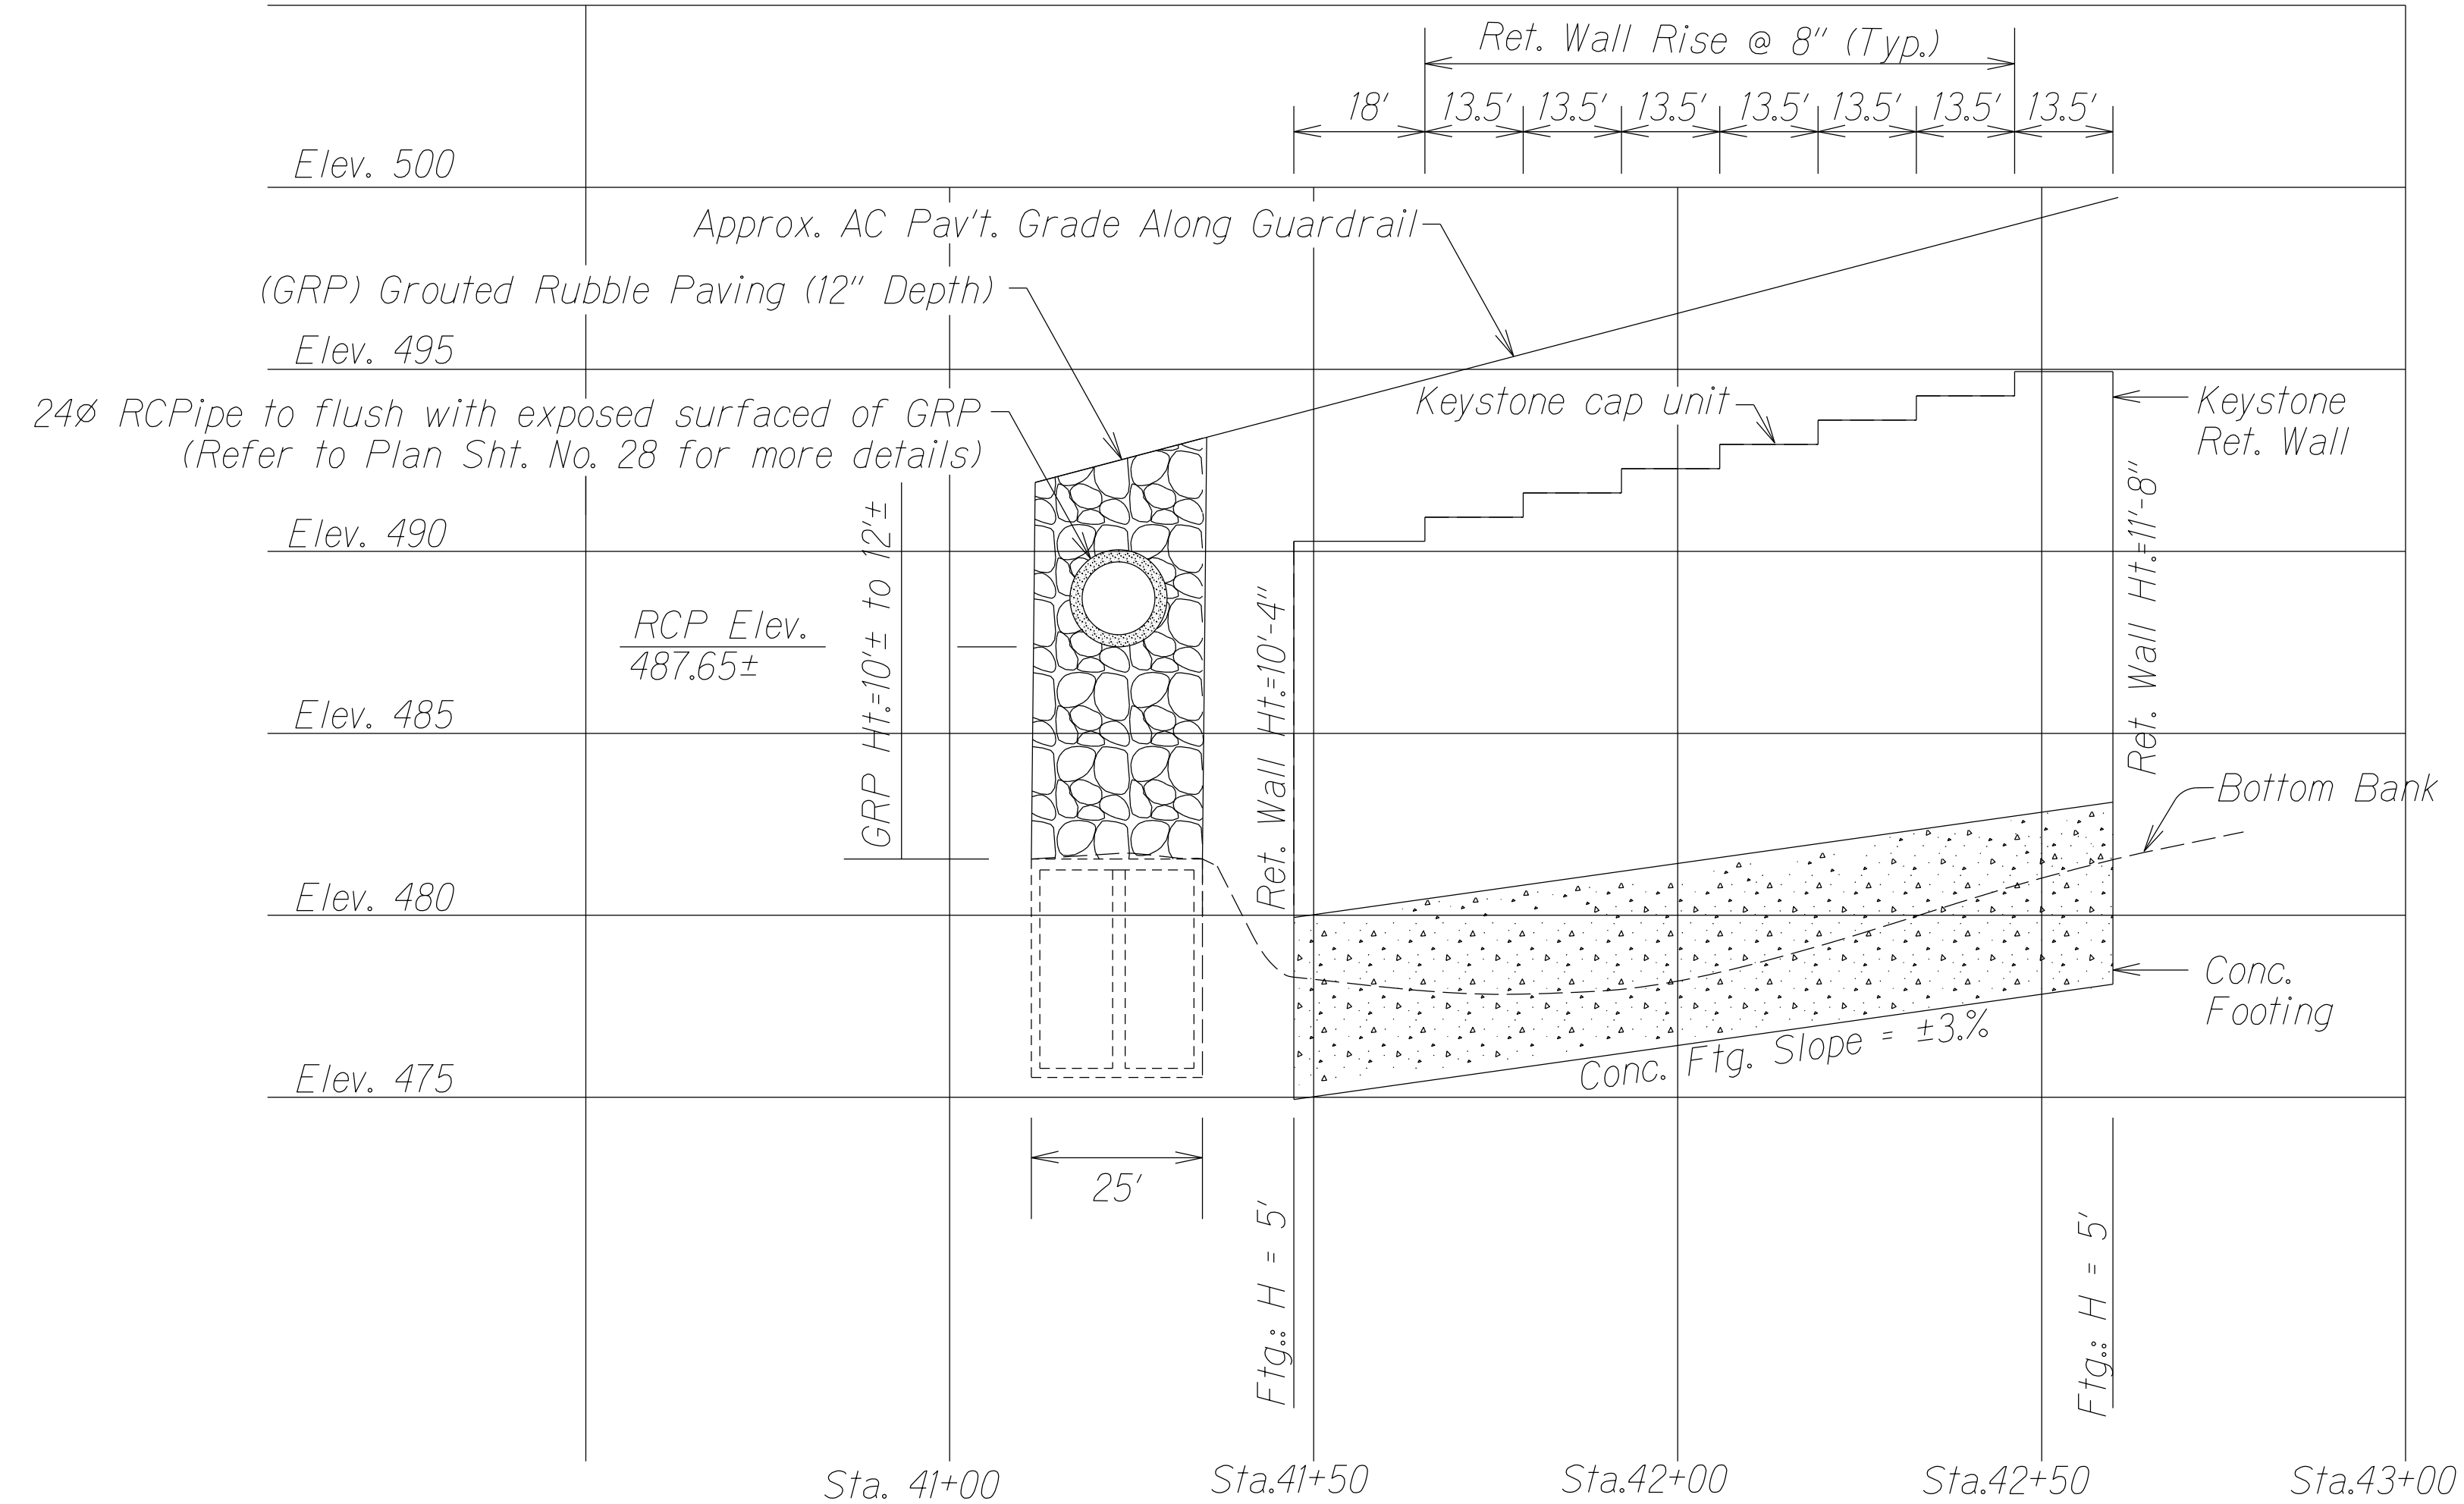

PROFILE - RETAINING WALL NO. 2 AND PIPE CULVERT OUTLET
Scales: Horiz. 1" = 20'; Vert. 1" = 4'

ORIGINAL PLAN	SURVEY PLOTTED BY	DATE
DESIGNED BY	DESIGNED BY	DATE
CHECKED BY	CHECKED BY	DATE
NOTED BY	NOTED BY	DATE
QUANTITIES BY	QUANTITIES BY	DATE
CHECKED BY	CHECKED BY	DATE

STATE OF HAWAII
DEPARTMENT OF TRANSPORTATION
HIGHWAYS DIVISION

RETAINING WALL NO. 2 AND PIPE
CULVERT PLAN AND PROFILE
KAUMUALII HIGHWAY INTERSECTION IMPROVEMENTS
at Lauoho Road and Kuli Road
Project No. 50C-01-18
Scale: 1" = 20' Date: January 2022